


General Notes:

1. All work on this project shall conform to the Standard Specifications for Storm Sewer Construction of the City of Wichita.
2. All areas disturbed by Contractor's operations shall be restored in accordance with City of Wichita Administrative Regulation AR-78.
3. The Contractor shall notify Kansas One-Call (867-2470) a minimum of 48 hours prior to any excavation.

NOTICE:

1" Cut on top of curb @ NE corner
Lot 4, Block 1, Whispering Pines Estates;
Elevation = 145.10 City Datum.

15' Maintenance Access
and Underground Util. Esm't

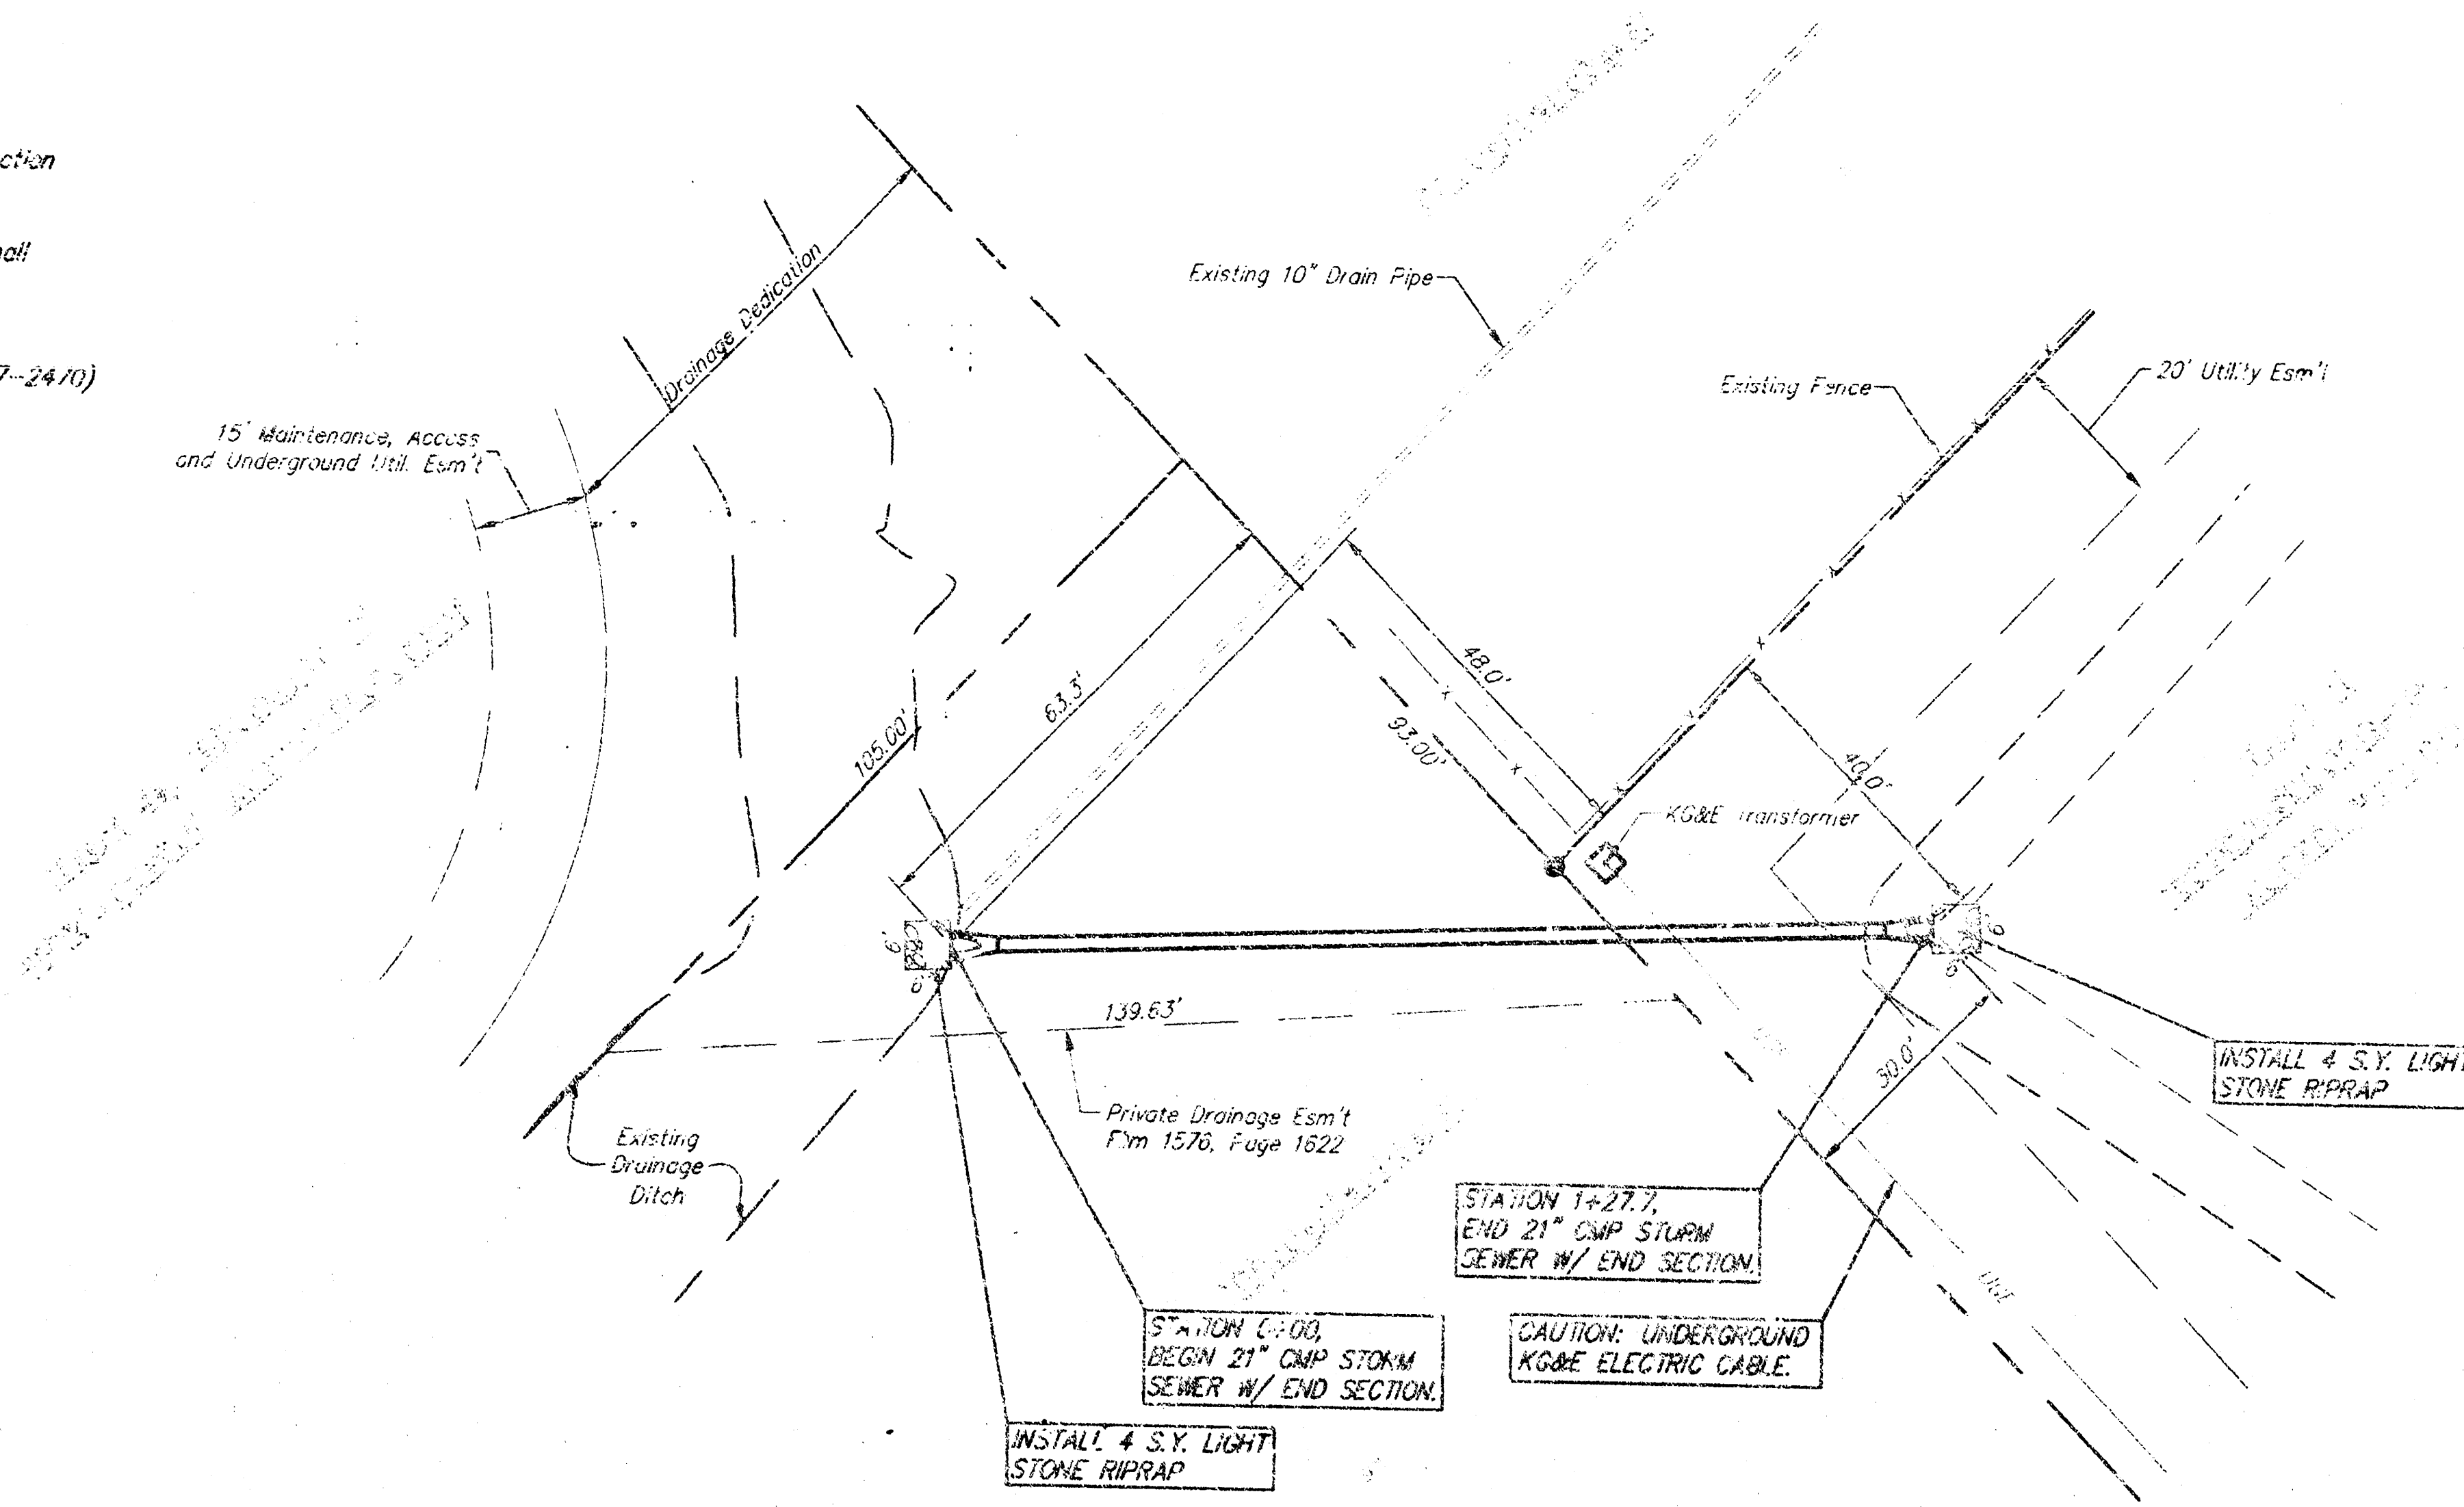



SCALE:
1"=20' PLAN
1"=5' PROFILE (V.)

APPROVED AS NOTED
BY CITY ENGINEER OF WICHITA

Sanitary Sewers	
Storm Sewers	VRP 1/12/16
Driveway Approaches	
Water Mains	
Paving	

NOTE TO CONTRACTORS

Inspection and testing for this project are to be provided by a Licensed Consulting Engineering Firm under contract with the City/Owner. Said Inspector to be in accordance with the City of Wichita standard construction engineering practices and certified by a Licensed Professional Engineer. No work shall be performed in dedicated easements or public right-of-way by the Contractor without such inspection, nor shall any work be commenced without written authorization by the City Engineer.

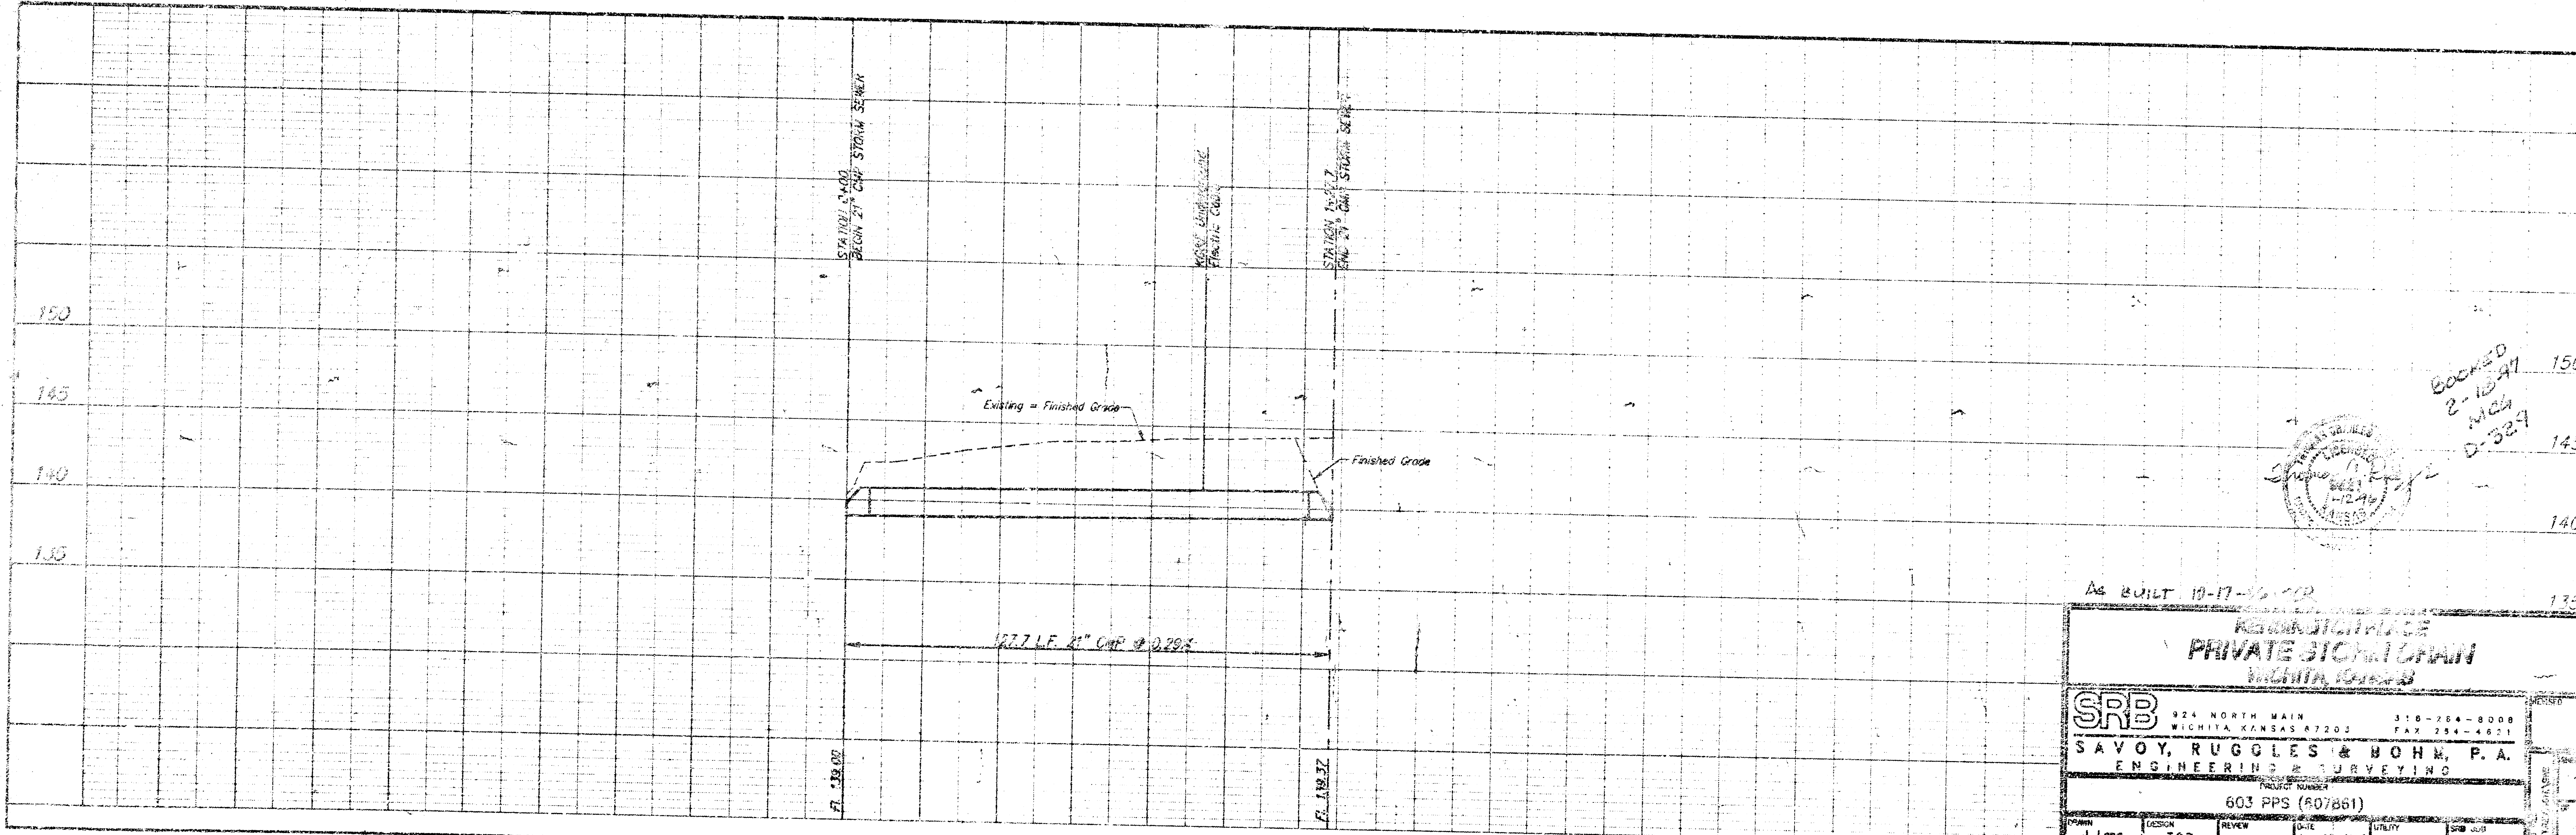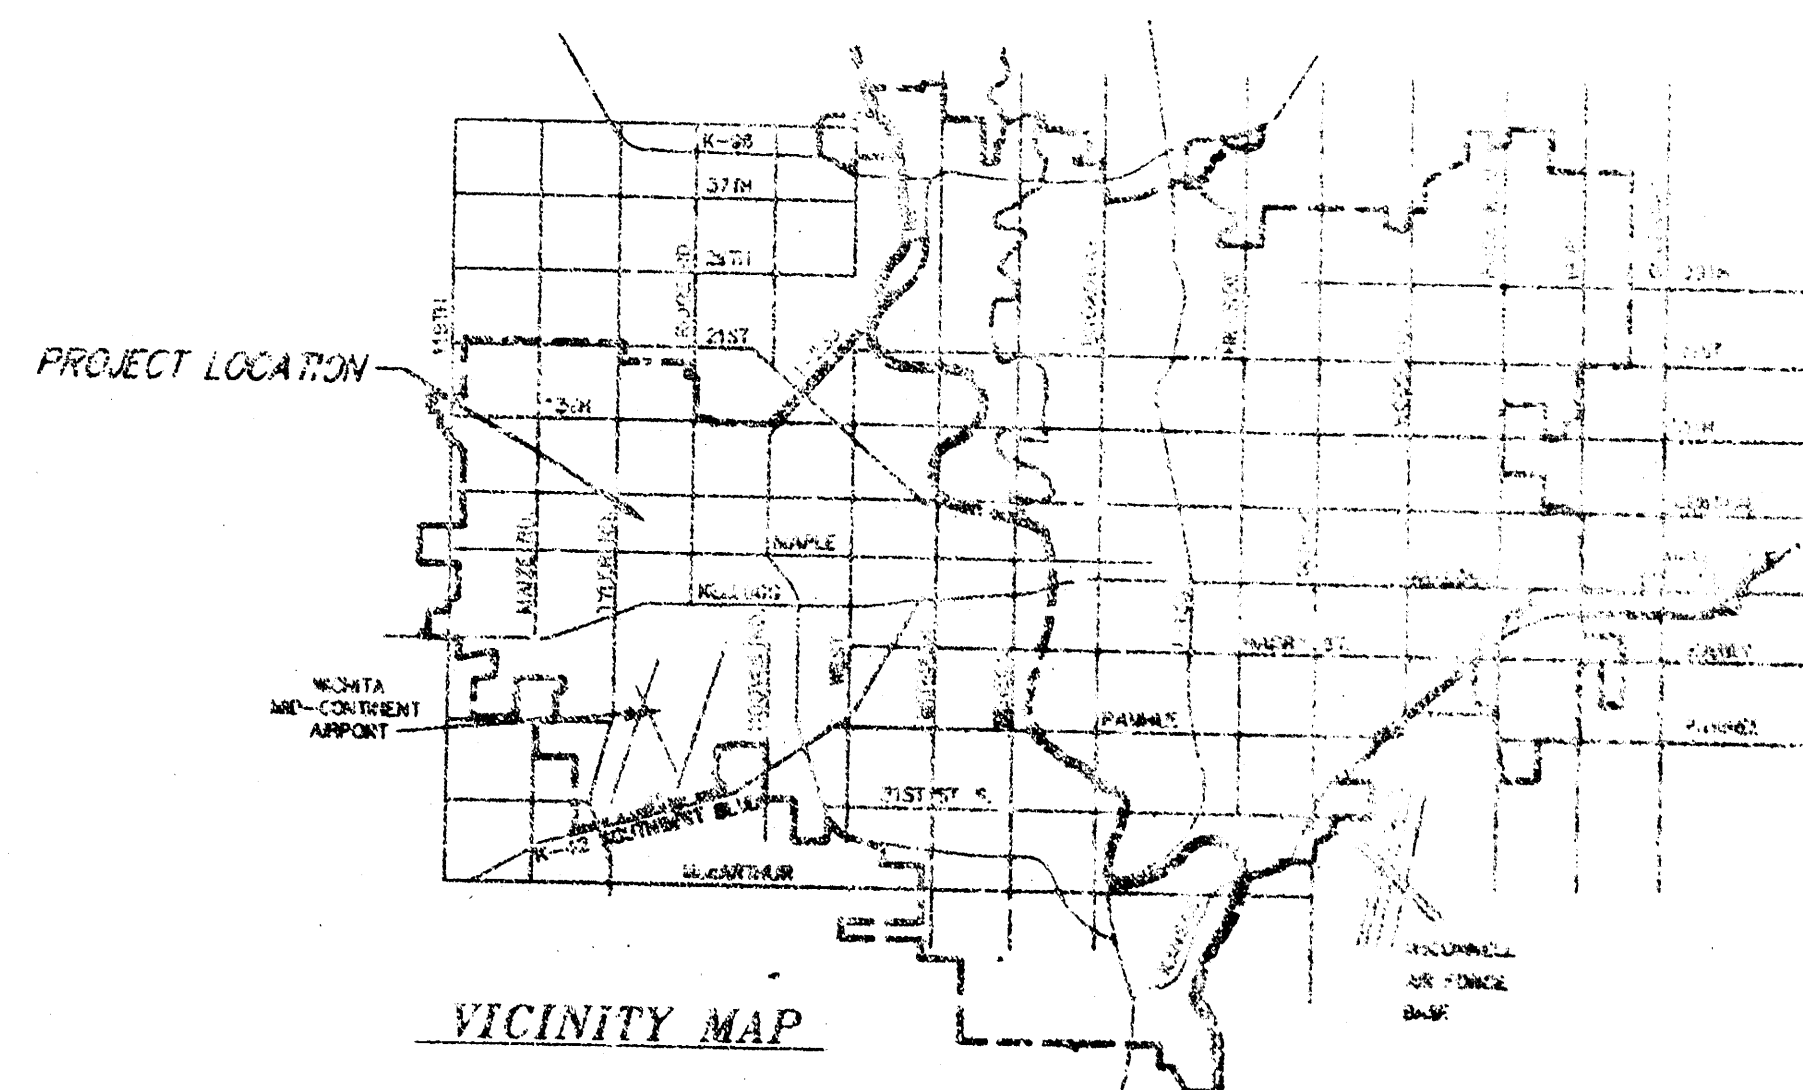

AS BUILT 10-17-16

PRIVATE STORM DRAIN

SRB 324 NORTH MAIN WICHITA, KANSAS 67203 316-264-8000 FAX 316-264-4651

SAVOY, RUGGLES & BOHM, P.A. ENGINEERS & SURVEYORS

PROJECT NUMBER 603 PPS (607861)

DESIGNER J. Long	CHECKED T.C.R.	INCHES 1/8"	DATE Jan. 12, 1996	SCALE 1"=5'	PROJECT 603 PPS
------------------	----------------	-------------	--------------------	-------------	-----------------