
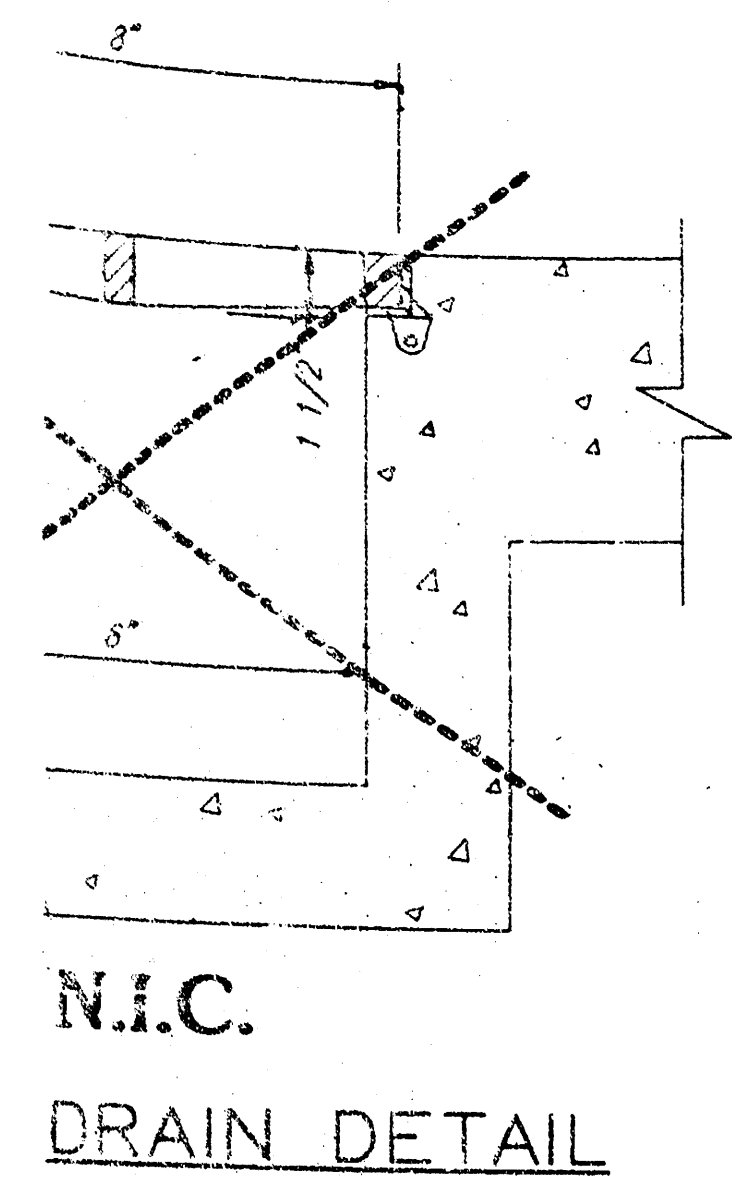


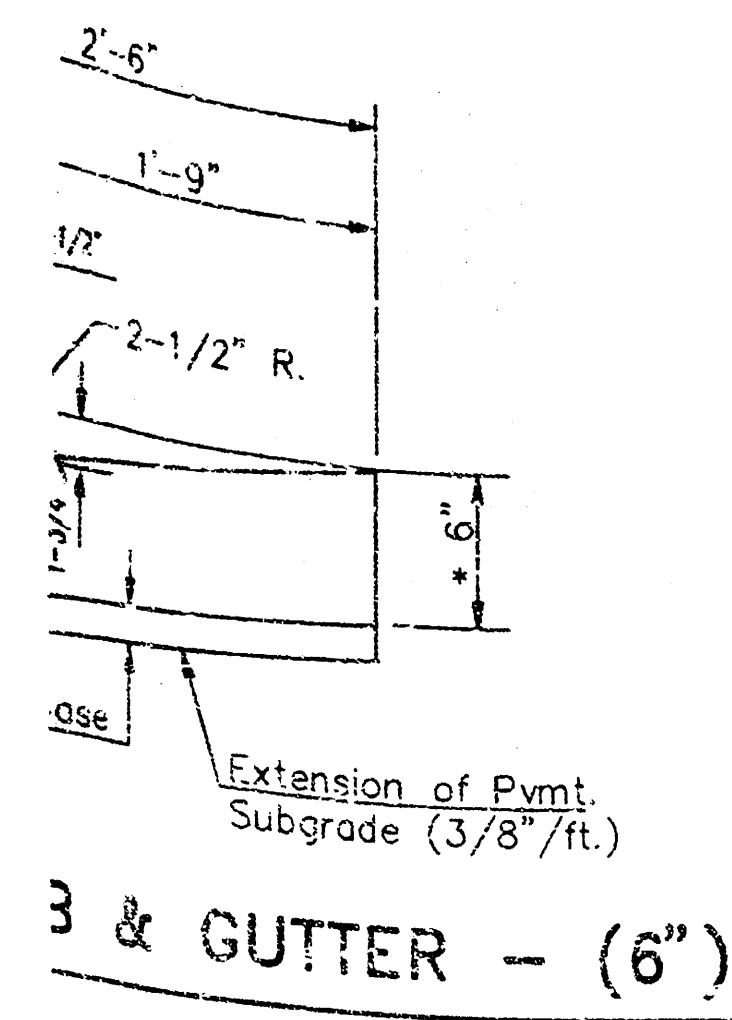

by all utility locations
construction.

DESCRIPTION

- H Addition, Wichita, Kansas

APPROVED AS NOTED
BY CITY ENGINEER OF WICHITA

Sanitary Sewers _____

Storm Sewers VRH 10/17/94

Driveway Approaches _____


Water Mains _____

Paving _____

NOTE TO CONTRACTORS

Inspection and testing for this project is to be provided by a Licensed Consulting Engineering Firm under contract with the Owner/Developer. Said inspection to be in accordance with the City of Wichita standard construction engineering practices and certified by a Licensed Professional Engineer. No work shall be performed in dedicated easements or public right-of-way by the Contractor without such inspection nor shall any work be commenced without written authorization by the City Engineer. All Construction and Materials shall comply with the City of Wichita Specifications and Standards (on file and available in the City Engineer's Office).


City of Wichita Private Project
No. 506 FPS (607861)

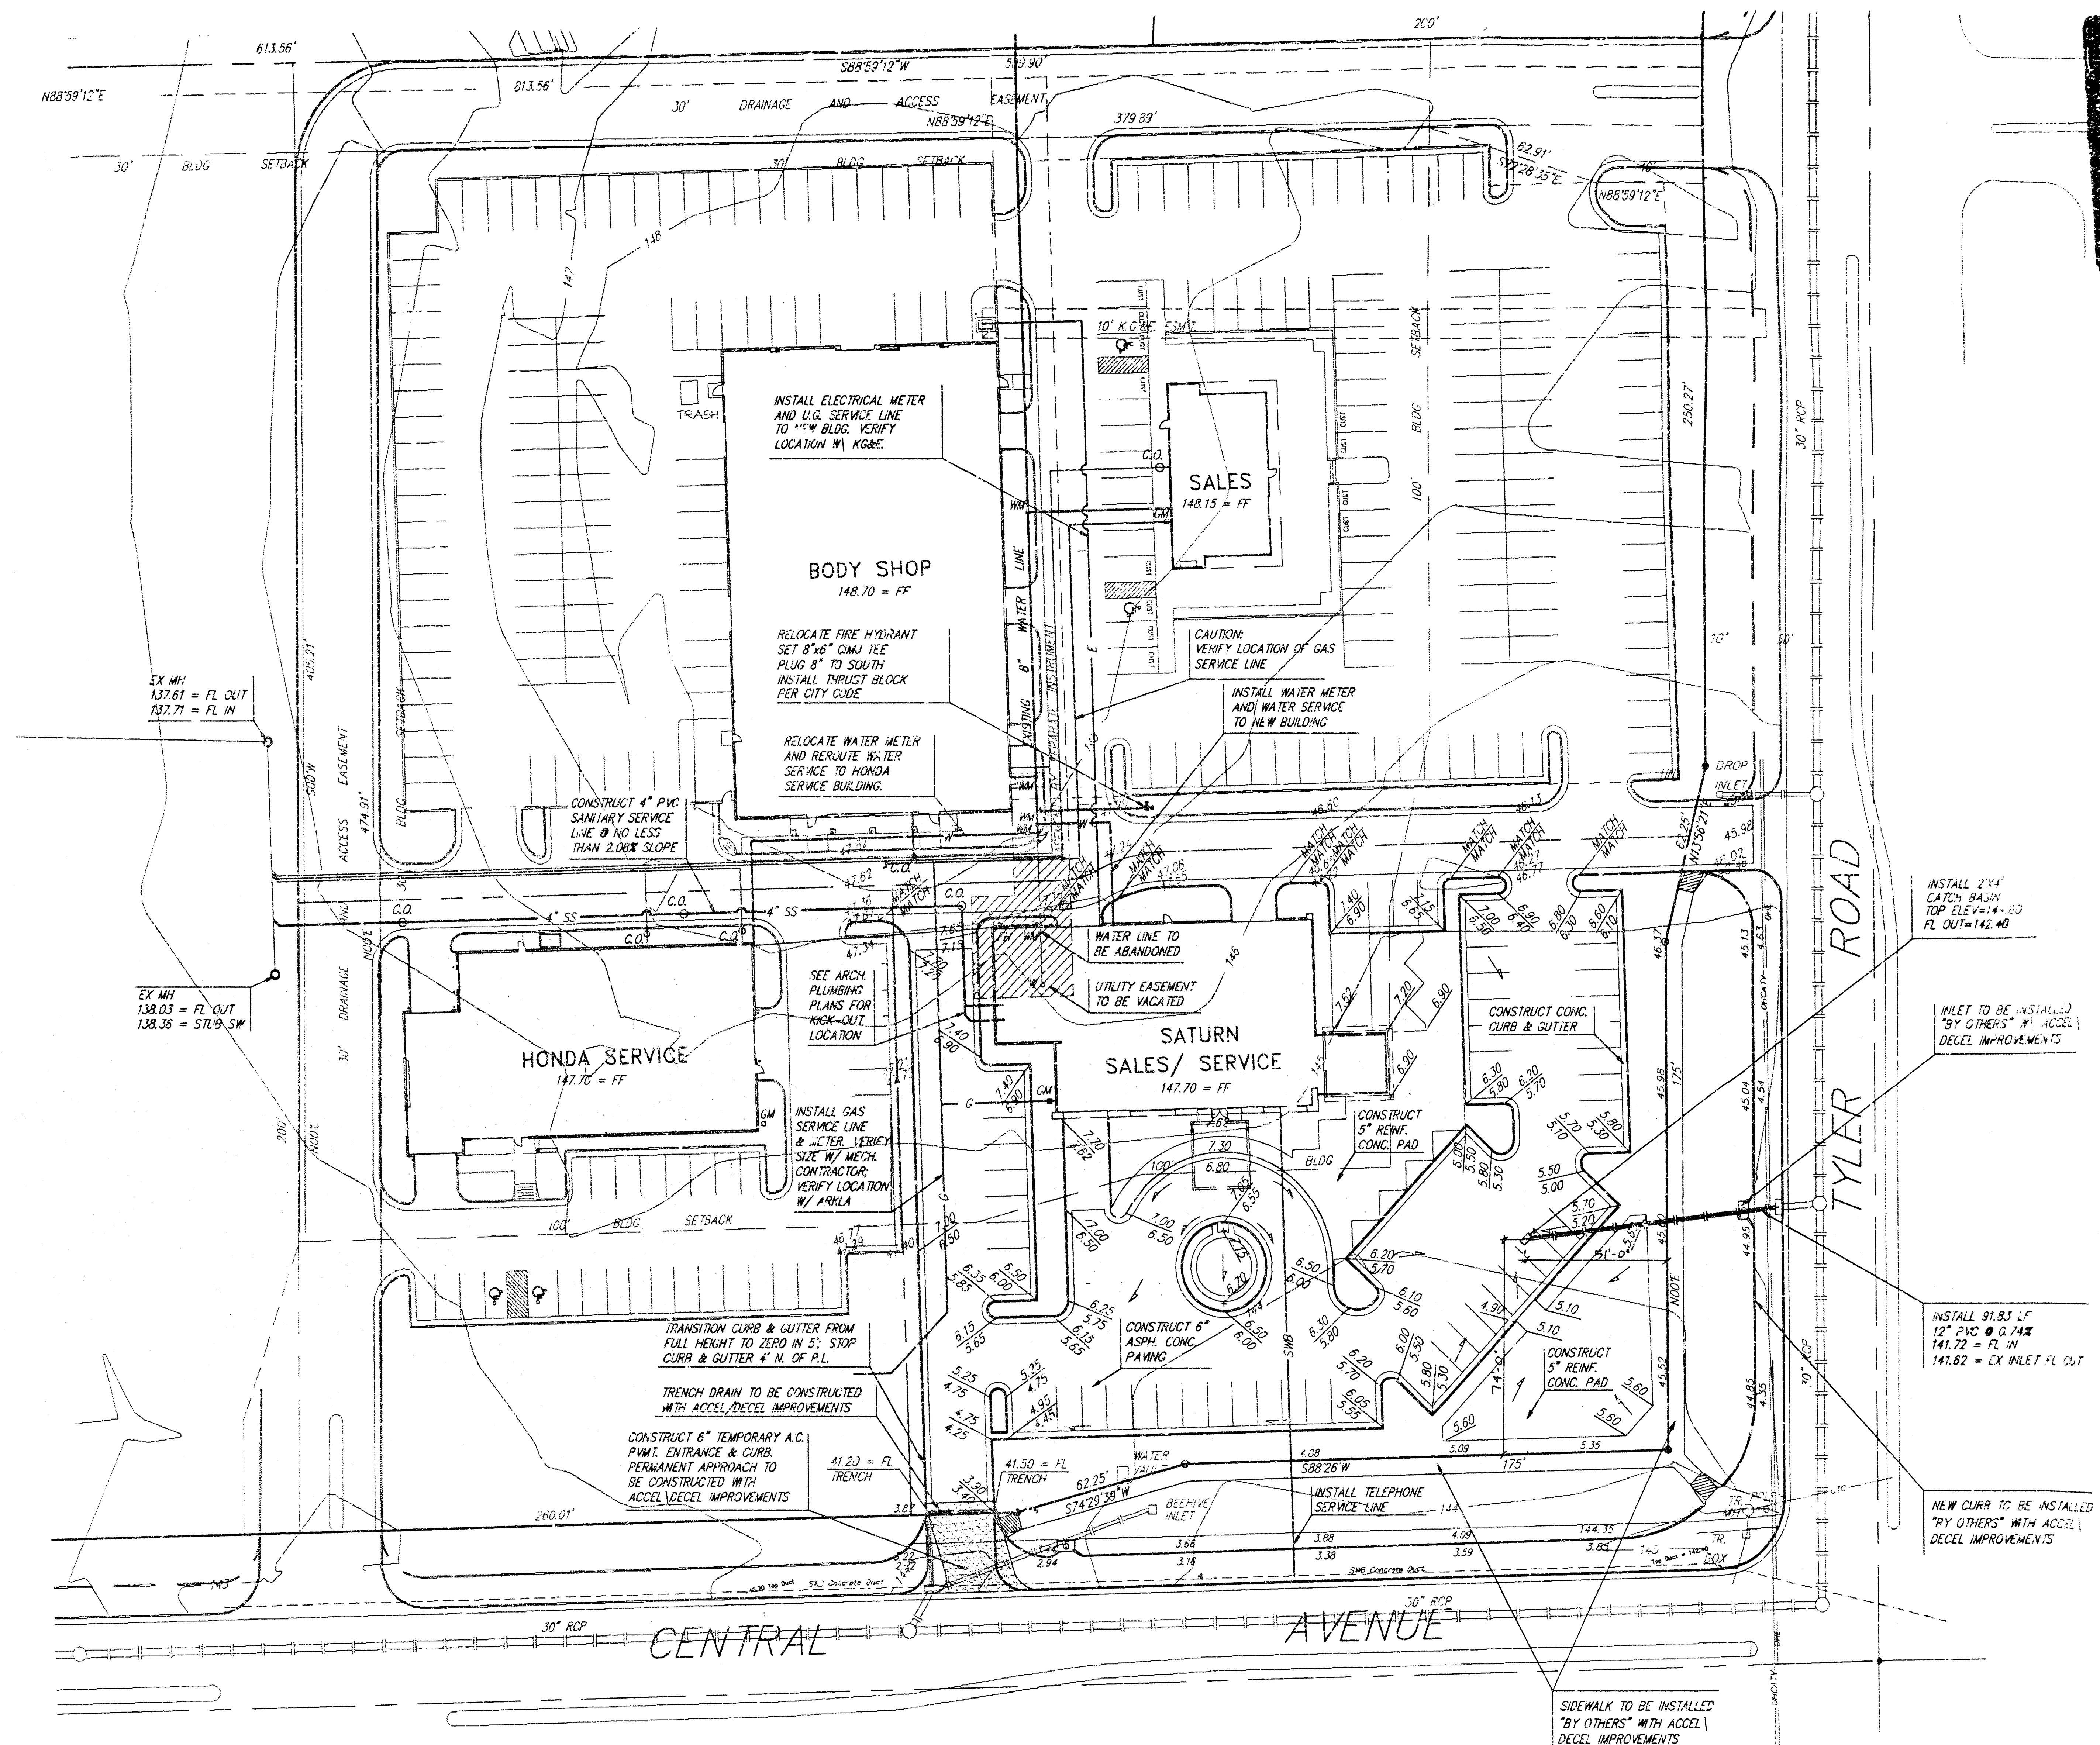

A SITE GRADING & UTILITY PLAN

SCALE: 1" = 30'-0"

BAUGHMAN COMPANY P. A.
ENGINEERING & SURVEYING
316/262-7271 • 315 ELLIS • WICHITA, KANSAS 67211

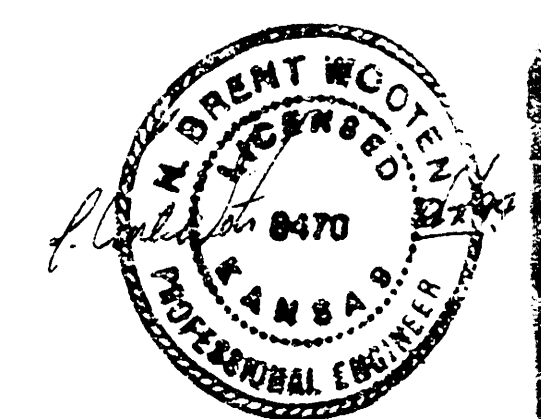

CREHBIEL ASSOCIATES
re • planning • interiors
Kc: 545 67211 (316) 267-8233 Fax: (316) 267-9566

date drawn 7-15-94
prints issued
revisions 10-6-94



SATURN OF WICHITA SERVICE CENTER
CENTRAL & TYLER
WICHITA, KANSAS

SG-1
of 10-4-5-2