


# STORMWATER SEWER IMPROVEMENTS TO SERVE Comotara Power Center 3rd Addition

Project Number  
710 PPS (607861)

CITY OF WICHITA, KANSAS  
Michael E. Lindebak, P. E., City Engineer

## GENERAL NOTES

- Contractor will be required to provide notice to utility companies a minimum of twenty-four (24) hours prior to any excavation, as follows:  
Kansas One-Call 687-2470  
The Contractor must notify the following in case of an emergency:  
Cablevision 262-4270  
or 263-2061  
K.P.L. Gas Service Company 383-8650  
Kansas Gas & Electric Company 383-8600  
Arkla Gas Company 942-8350  
Southwestern Bell Telephone Company 1-571-2611  
City of Wichita Water Department 268-4908  
City of Wichita Sewer Department 268-4071
- Exist. utilities and their locations, as shown on the plans, represent the best information obtainable for design. Location information has been obtained from the various utility companies and is either from company record drawings or company-provided field locations. The Contractor will be required to work around existing utilities which do not conflict with proposed construction.
- The Contractor to verify utility locations prior to construction of this project.
- Utility service and installation shall be coordinated with the respective utility owners. Contacts are:  
K&E Gas Steve Orth 261-6867  
K.G. & E. Miles Capers 261-6434  
Wichita Water Chuck S 268-4555  
Joe Botine, 268-4908  
Southwestern Bell Jim Tobin 268-2753
- All areas disturbed by construction shall be seeded with rye. Rebar if rescue grass at a rate of 350 lbs./acre immediately following construction in that area.
- Traffic affected by the construction of this project shall be handled in accordance with the latest edition of the Manual on Uniform Traffic Control Devices.

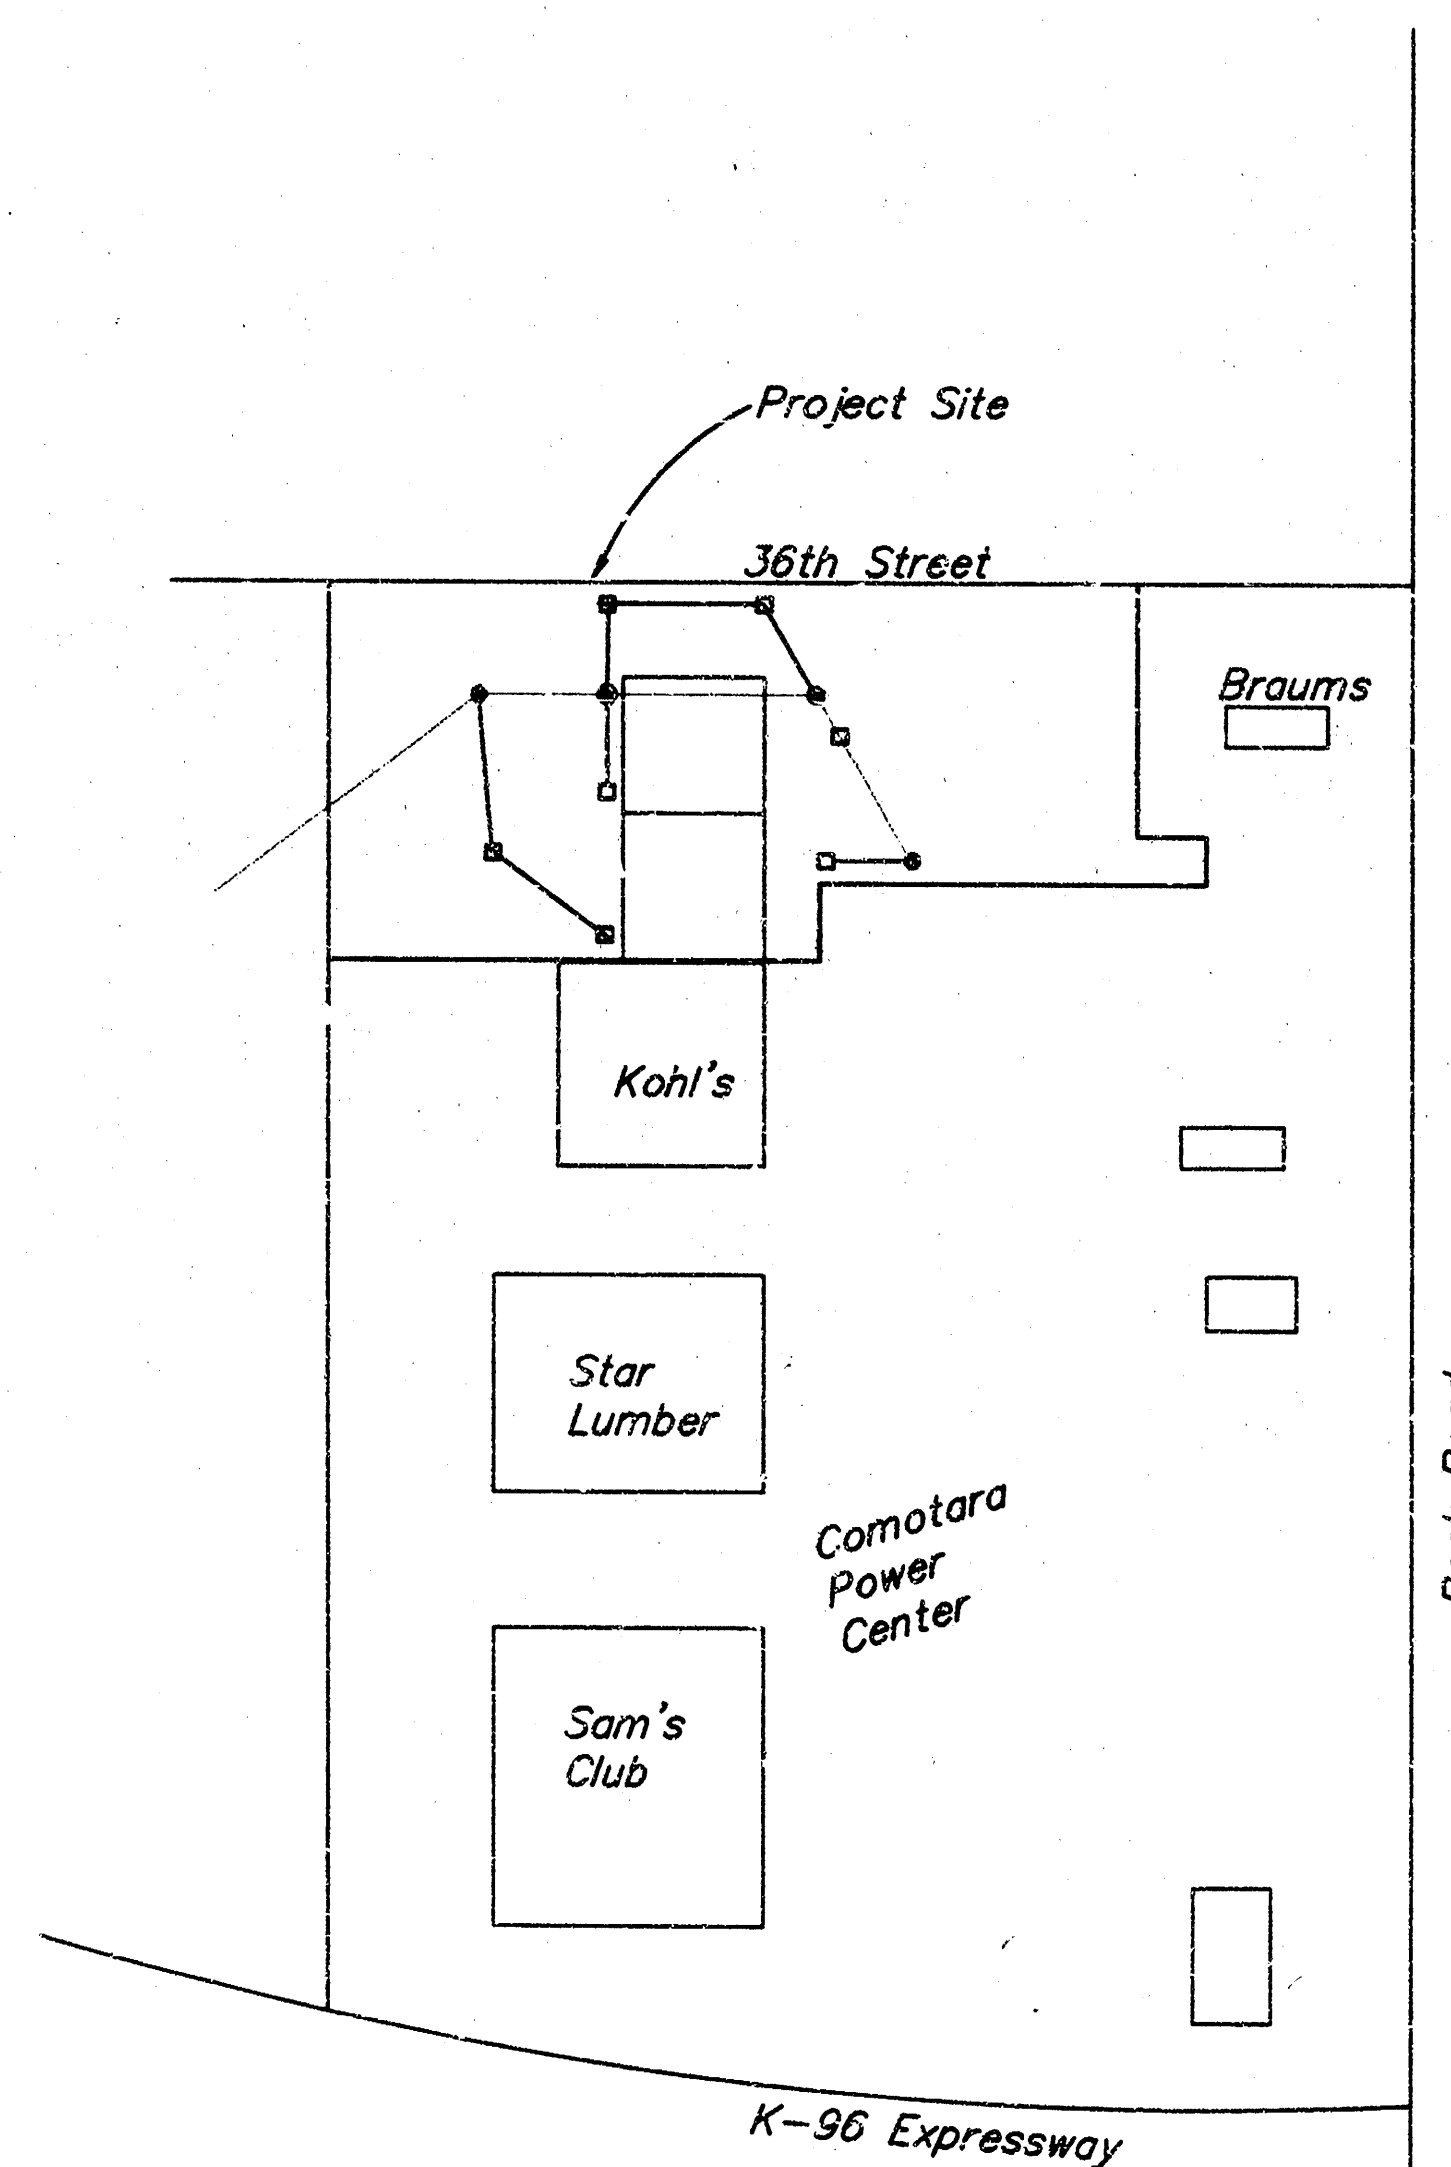


## BENCHMARK:

"□" Top of Curb @ W end of NW return  
Inwood and 36th St. N.  
Elev. = 1370.93 MSL

## INDEX

- Cover
- Plan and Profile

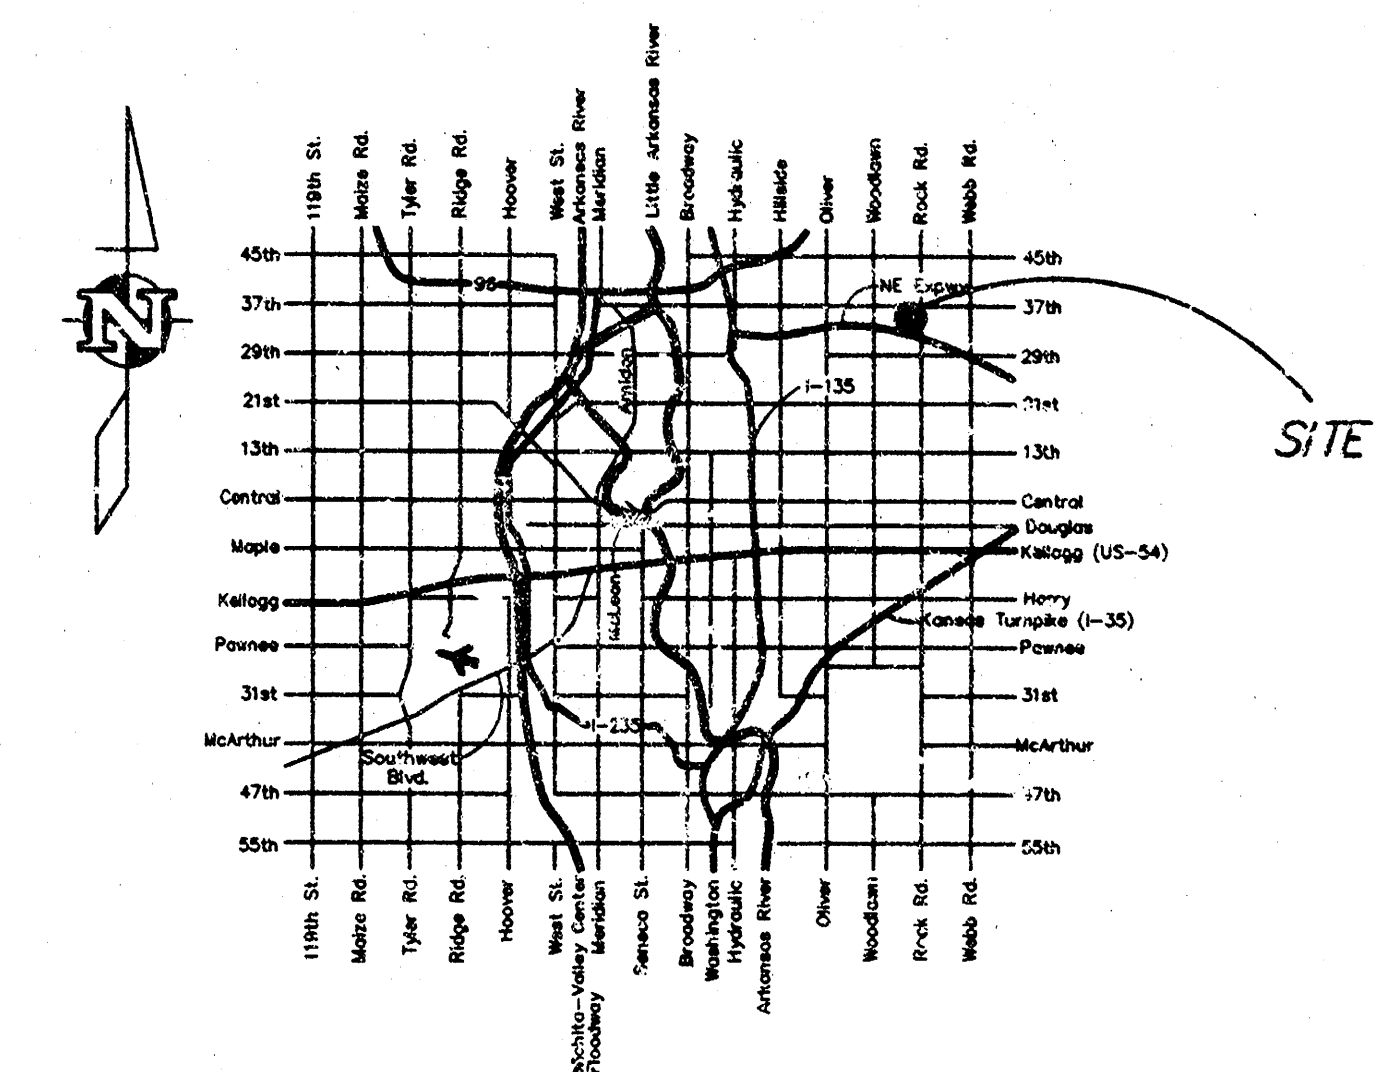

## LOCATION MAP

APPROVED AS NOTED BY CITY ENGINEER OF WICHITA

STORM SEWERS VRH 5/22/97

Inspection and testing for this project are to be provided by a Licensed Consulting Engineering Firm under contract with the Owner/Developer. Said inspection is to be in accordance with the City of Wichita standard construction engineering practices and certified by a Licensed Professional Engineer. No work shall be performed in dedicated easements or public right-of-way by the Contractor without such inspection nor shall work be commenced without written authorization by the City Engineer. All construction and materials shall comply with the City of Wichita Specifications and Standards (on file and available in the City Engineer's Office).

AS-BUILT  
Date: 3/10/98  
Signed: [Signature]



BOOKED  
9-13-99  
MCG  
D-434



K&M MILLER P.A.  
ENGINEERING SERVICES  
254 S. Laura, Suite 210 Wichita, KS 67211  
316/262-1281 fax: 316/262-6773

