

STORMWATER SEWER IMPROVEMENTS TO SERVE LOT 1, PARCEL B WESTVIEW 3rd ADDITION

Project Number
882 PPS 607861

CITY OF WICHITA, KANSAS
Michael E. Lindebak, P. E., City Engineer

GENERAL NOTES

- Contractor will be required to provide notice to utility companies a minimum of twenty-four (24) hours prior to any excavation, as follows:
Kansas One-Call 687-2470
The Contractor must notify the following in case of an emergency:
Cablevision 262-4270
or 263-2061
K.P.L. Gas Service Company 333-8830
Kansas Gas & Electric Company 333-8800
Peoples Natural Gas 942-8350
or 263-8161
Southwestern Bell Telephone Company 1-571-2611
City of Wichita Water Department 268-4908
City of Wichita Sewer Department 268-4071
- Exist. utilities and their locations, as shown on the plans, represent the best information obtainable for design. Location information has been obtained from the various utility companies and is either from company record drawings or company-provided field locations. The Contractor will be required to work around existing utilities which do not conflict with proposed construction.
- The Contractor to verify utility locations prior to construction of this project.
- Utility service and installation shall be coordinated with the respective utility owners. Contacts are:
K&E Gas Shane Price 261-6867
K.G. & E. Miles Capps 261-6434
Wichita Water Paul Bryant 268-4555
Joe Botively 268-4908
Southwestern Bell Jim Tobin 268-2759
- All areas disturbed by construction operations shall be seeded with rye grass at a rate of 300 lbs/acre immediately following construction in that area. Ground shall be prepared per City of Wichita specifications prior to seeding.
- Traffic affected by the construction of this project shall be handled in accordance with the latest edition of the Manual on Uniform Traffic Control Devices.
- All pipe shall be Reinforced Concrete CI IV, Contech Ultra Flo or approved equivalent, unless otherwise noted.

APPROVED AS NOTED BY CITY ENGINEER OF WICHITA

STORM SEWERS URH 2/3/99


Inspection and testing for this project are to be provided by a Licensed Consulting Engineering Firm under contract with the Owner/Developer. Said inspection is to be in accordance with the City of Wichita standard construction engineering practices and certified by a Licensed Professional Engineer. No work shall be performed in dedicated easements or public right-of-way by the Contractor without such inspection nor shall work be commenced without written authorization by the City Engineer. All construction and materials shall comply with the City of Wichita Specifications and Standards (on file and available in the City Engineer's Office).

BENCHMARK:

COW Bench Mark, SW Corner
Intersection, 69' South and 97'
West of Ctr. Line Both,
10.5' North of Face Sidewalk.


INDEX

- Cover Sheet
- Plan & Profile Sheets

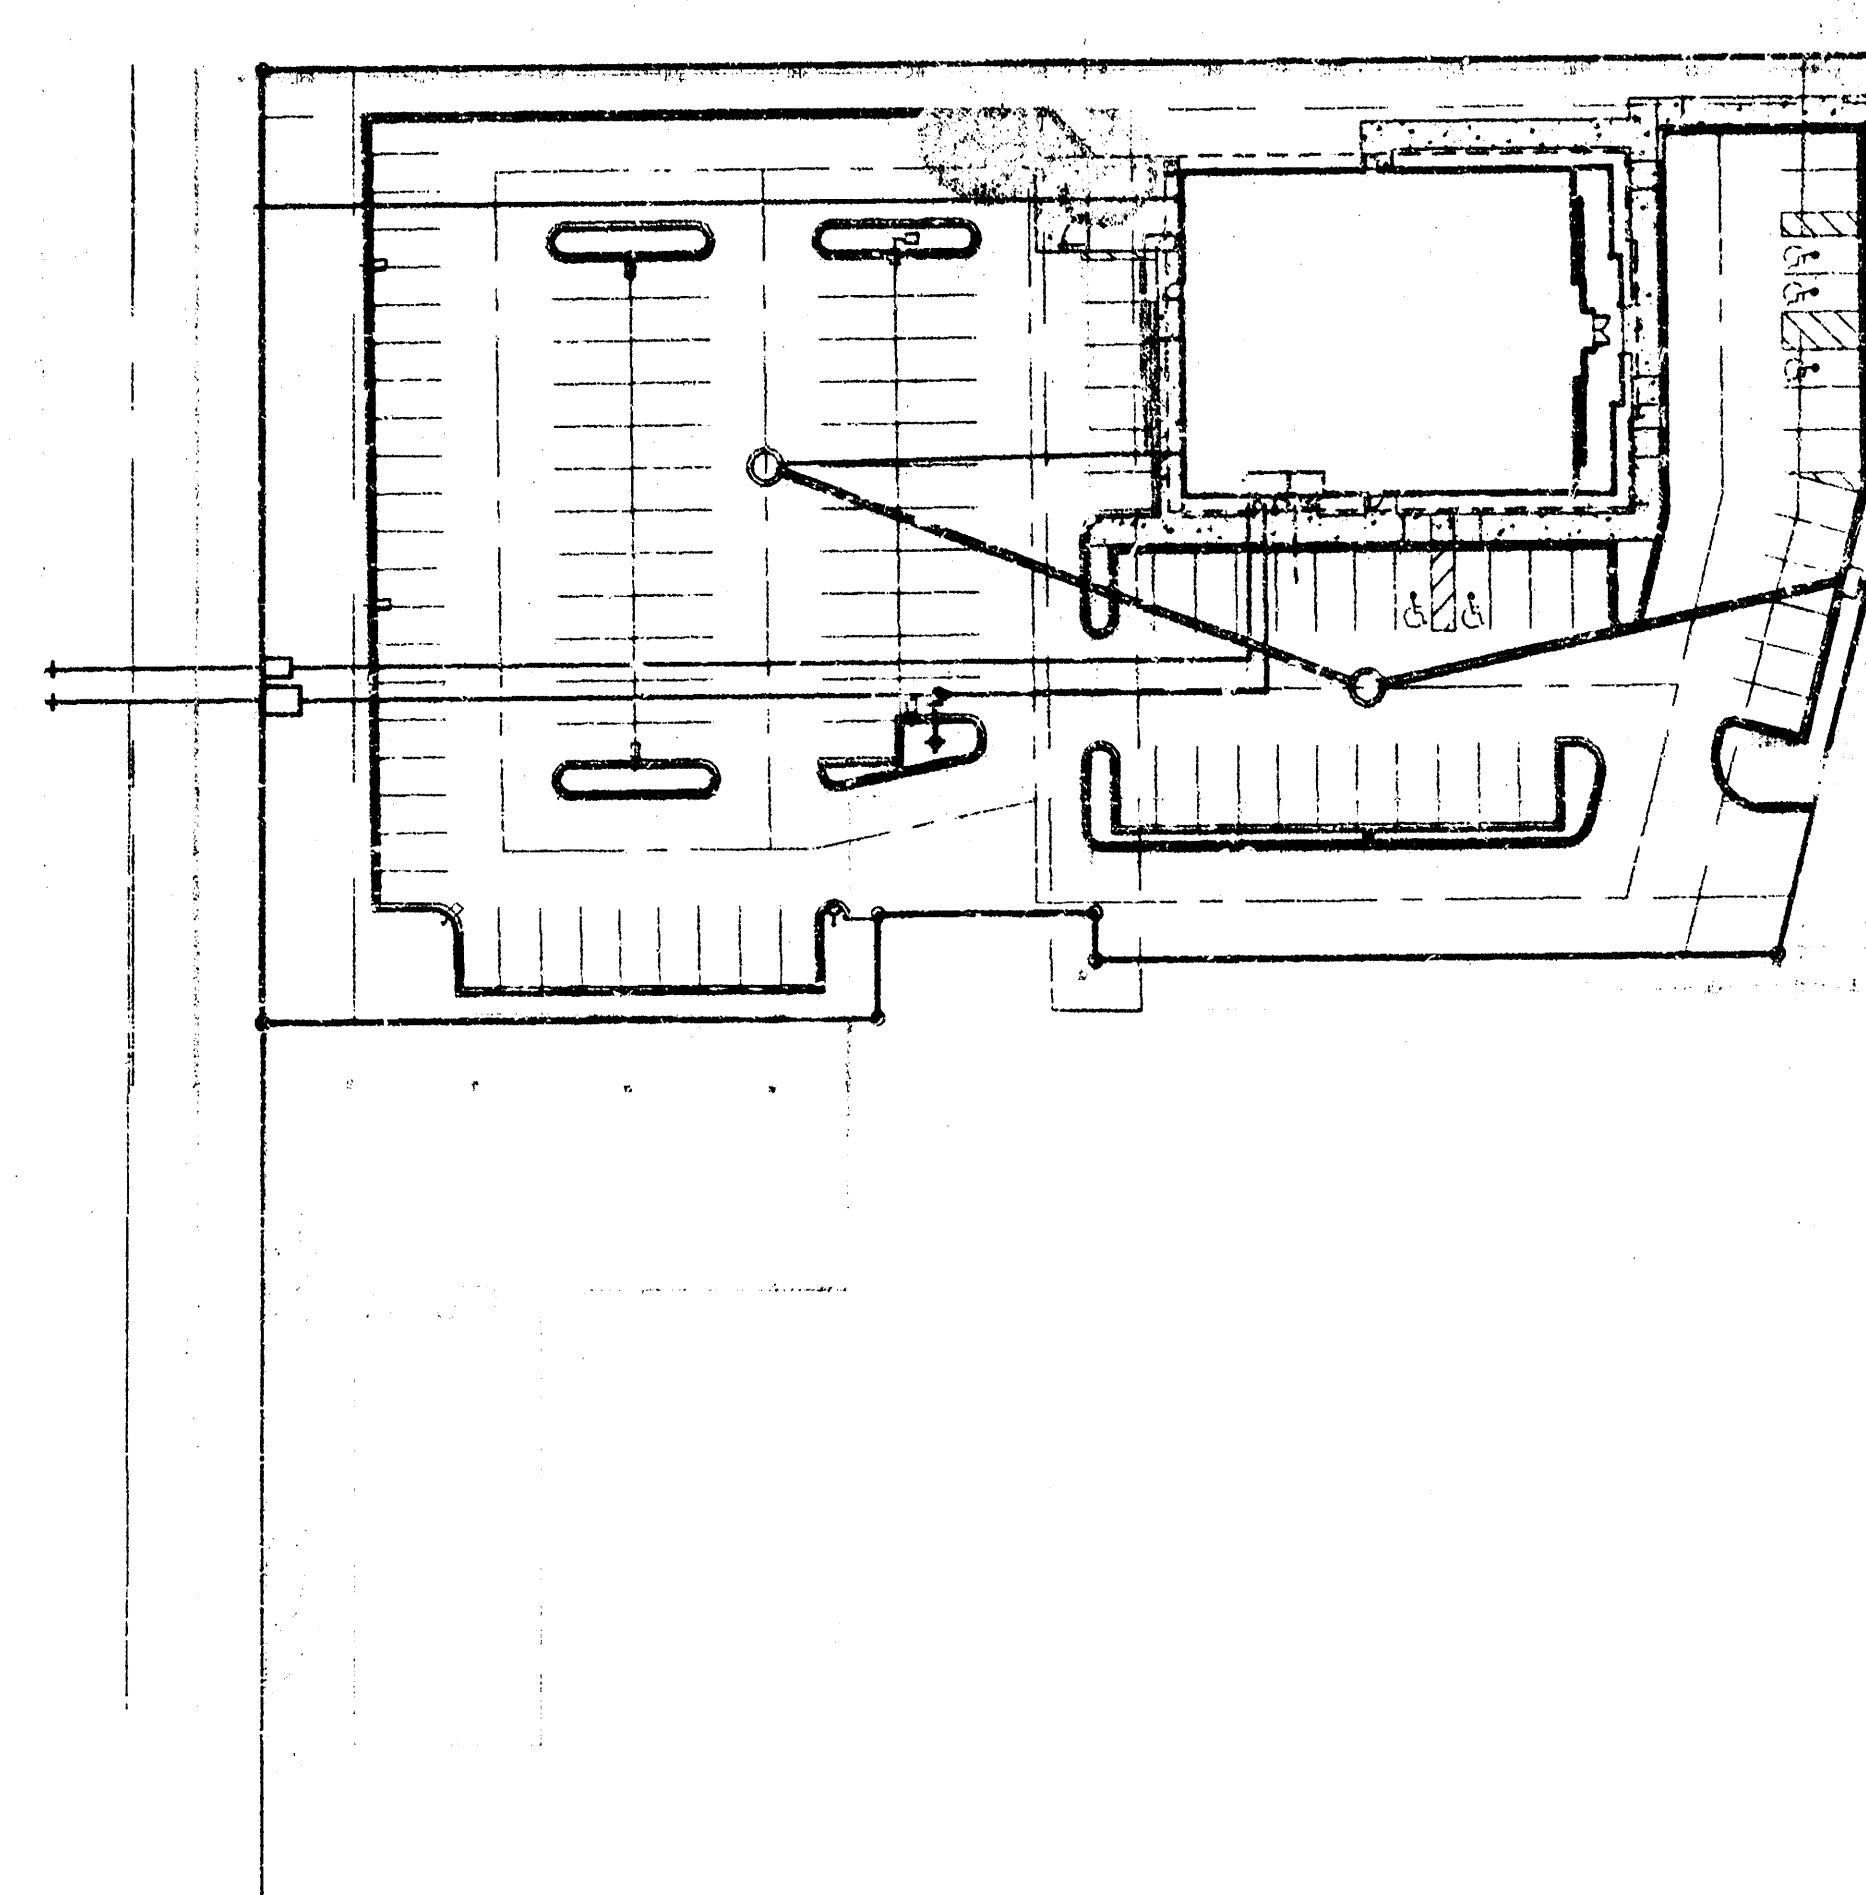

RIDGE ROAD

MAPLE

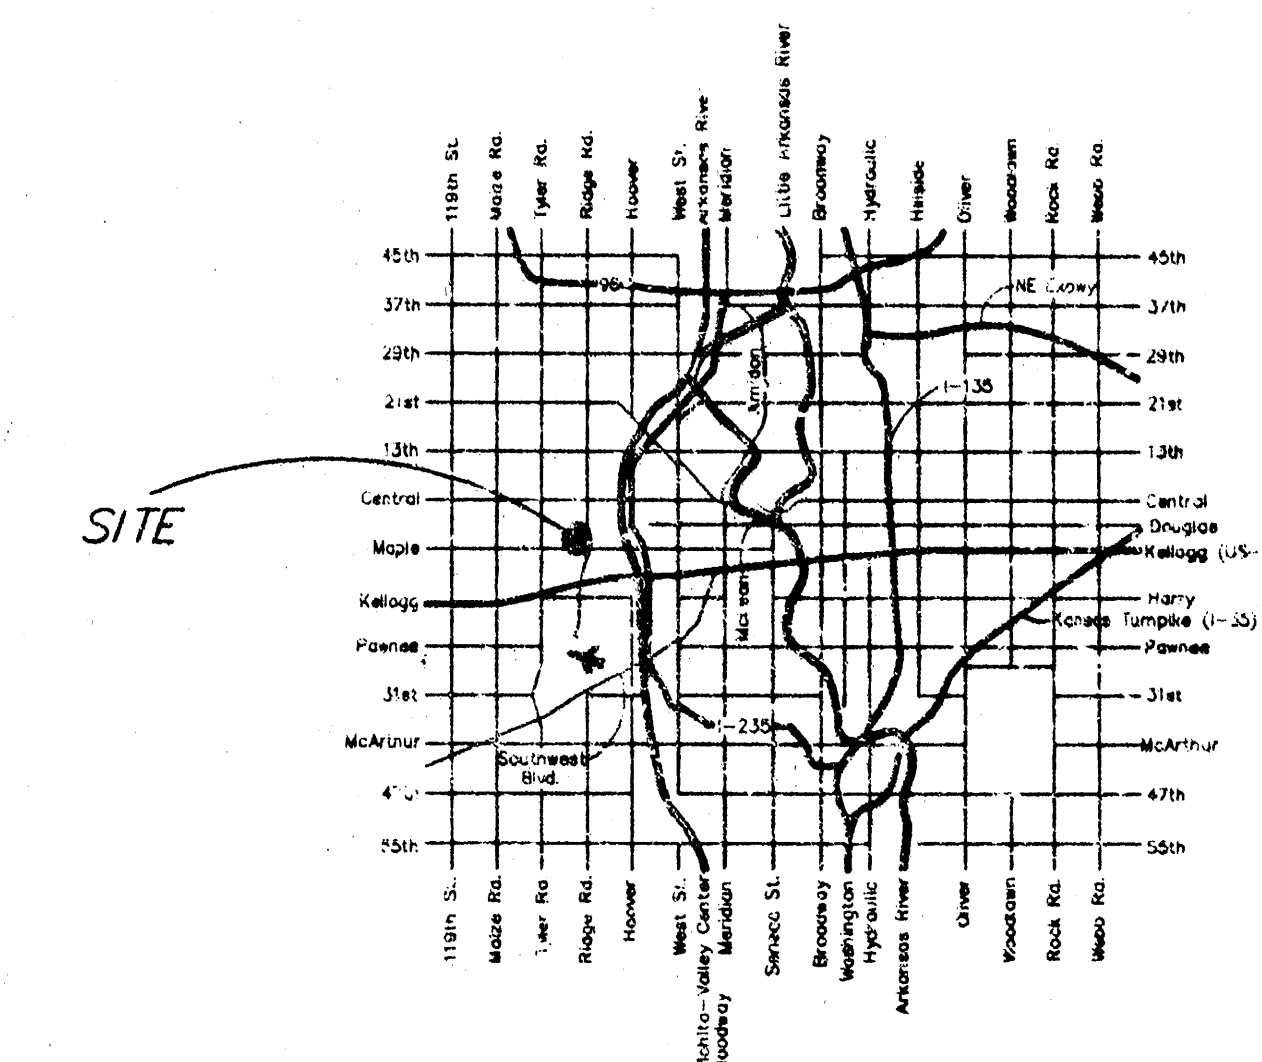

LOCATION MAP



BOOKED
8-31-99
MCG
D-432

AS-BUILT
Date: 3/8/99
Signed: MCG



MCG ENGINEERING SERVICES
254 S. Laura, Suite 210 Wichita, KS 67211
316/262-1281 fax 316/262-6773



CONTROL POINTS:

① SE Corner Lot 1
Westview Third Addn
N=1203.97
E=1336.98

② Property Corner
South Line of Lot 1
N=1202.19
E=1183.99

BENCHMARK:

COW Bench Mark, SW Corner
Intersection, 69' South and 97'
West of Ctr. Line Both.
10.5' North of Face Sidewalk.
Elev.= 142.07

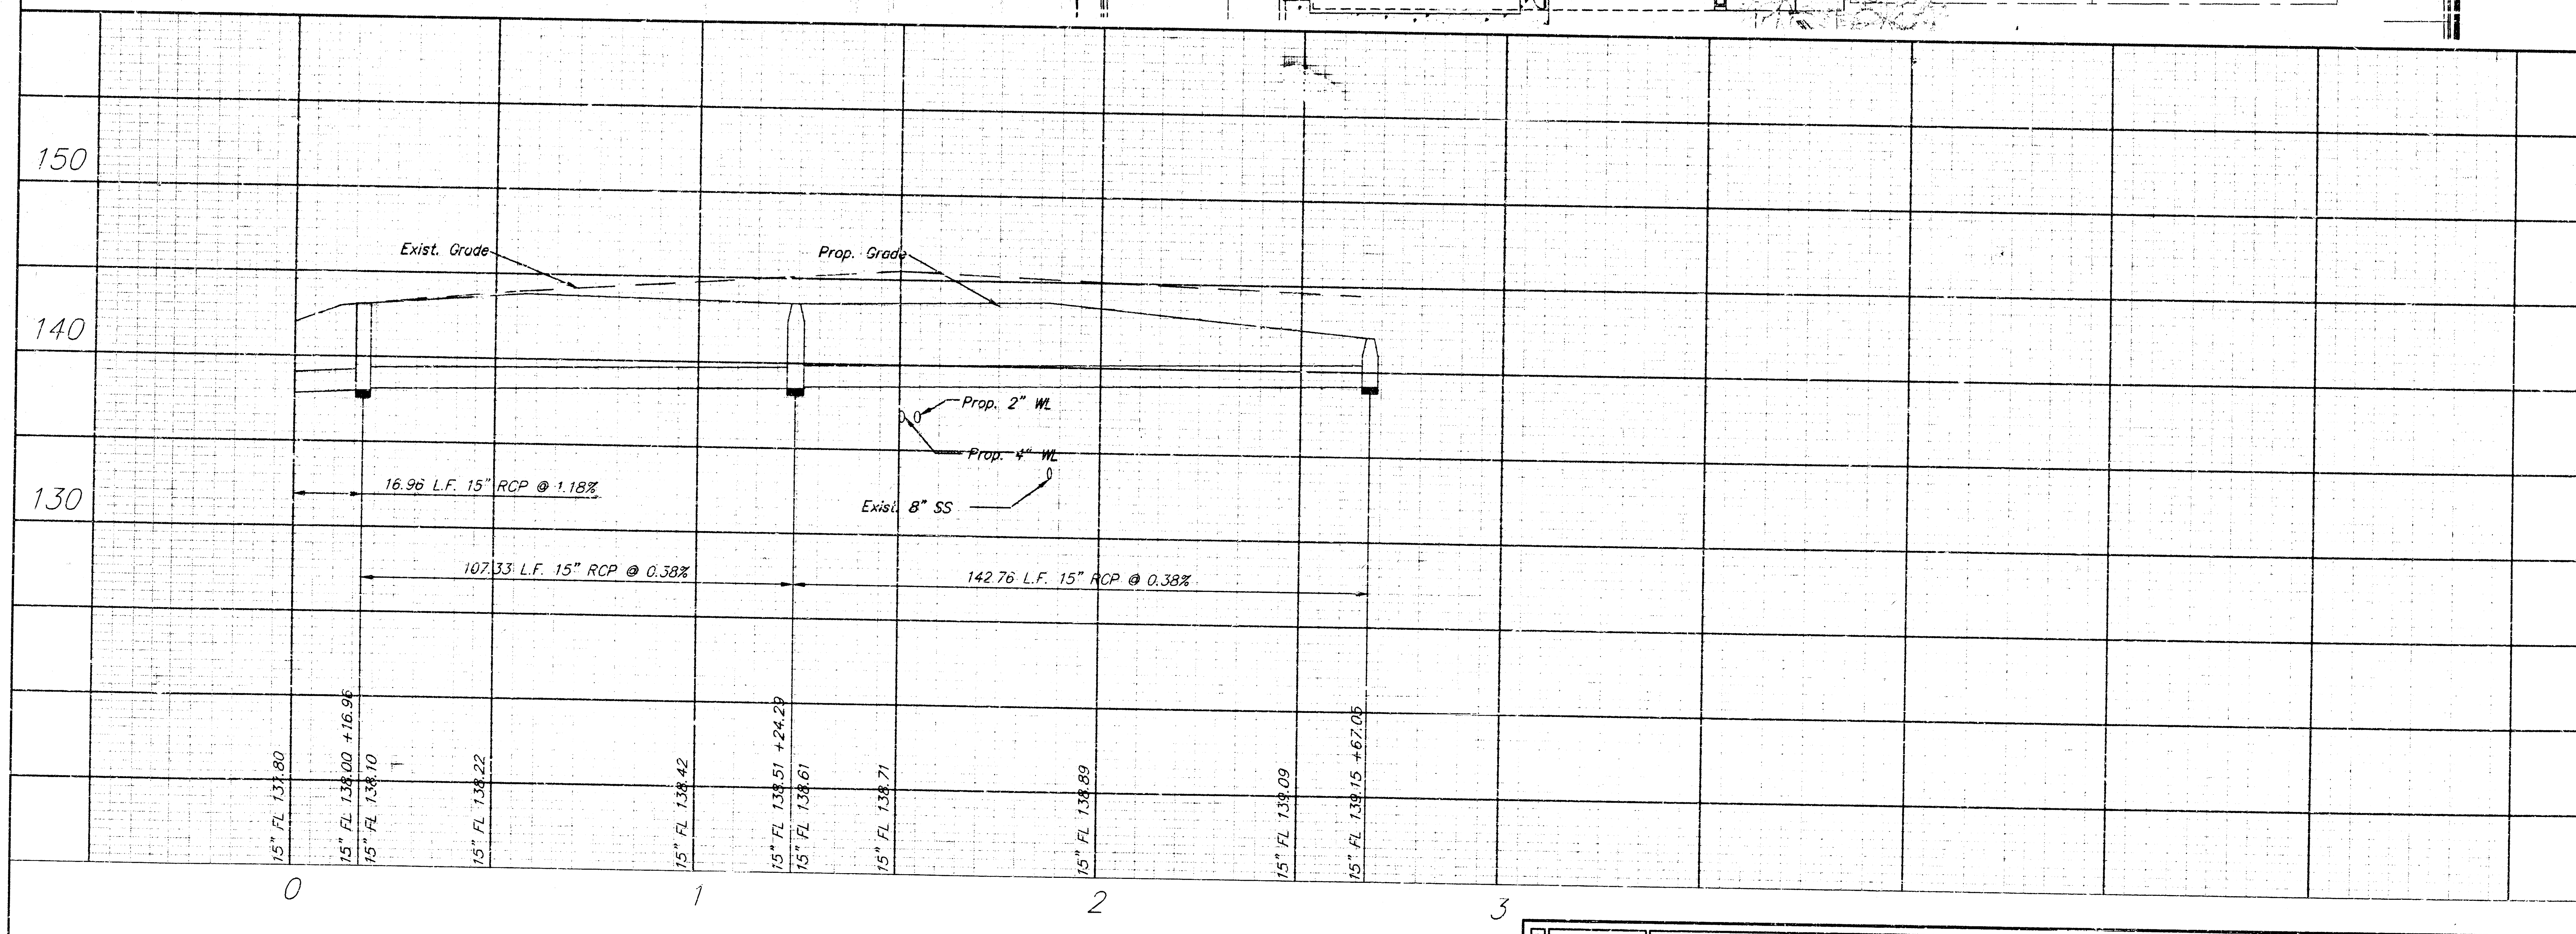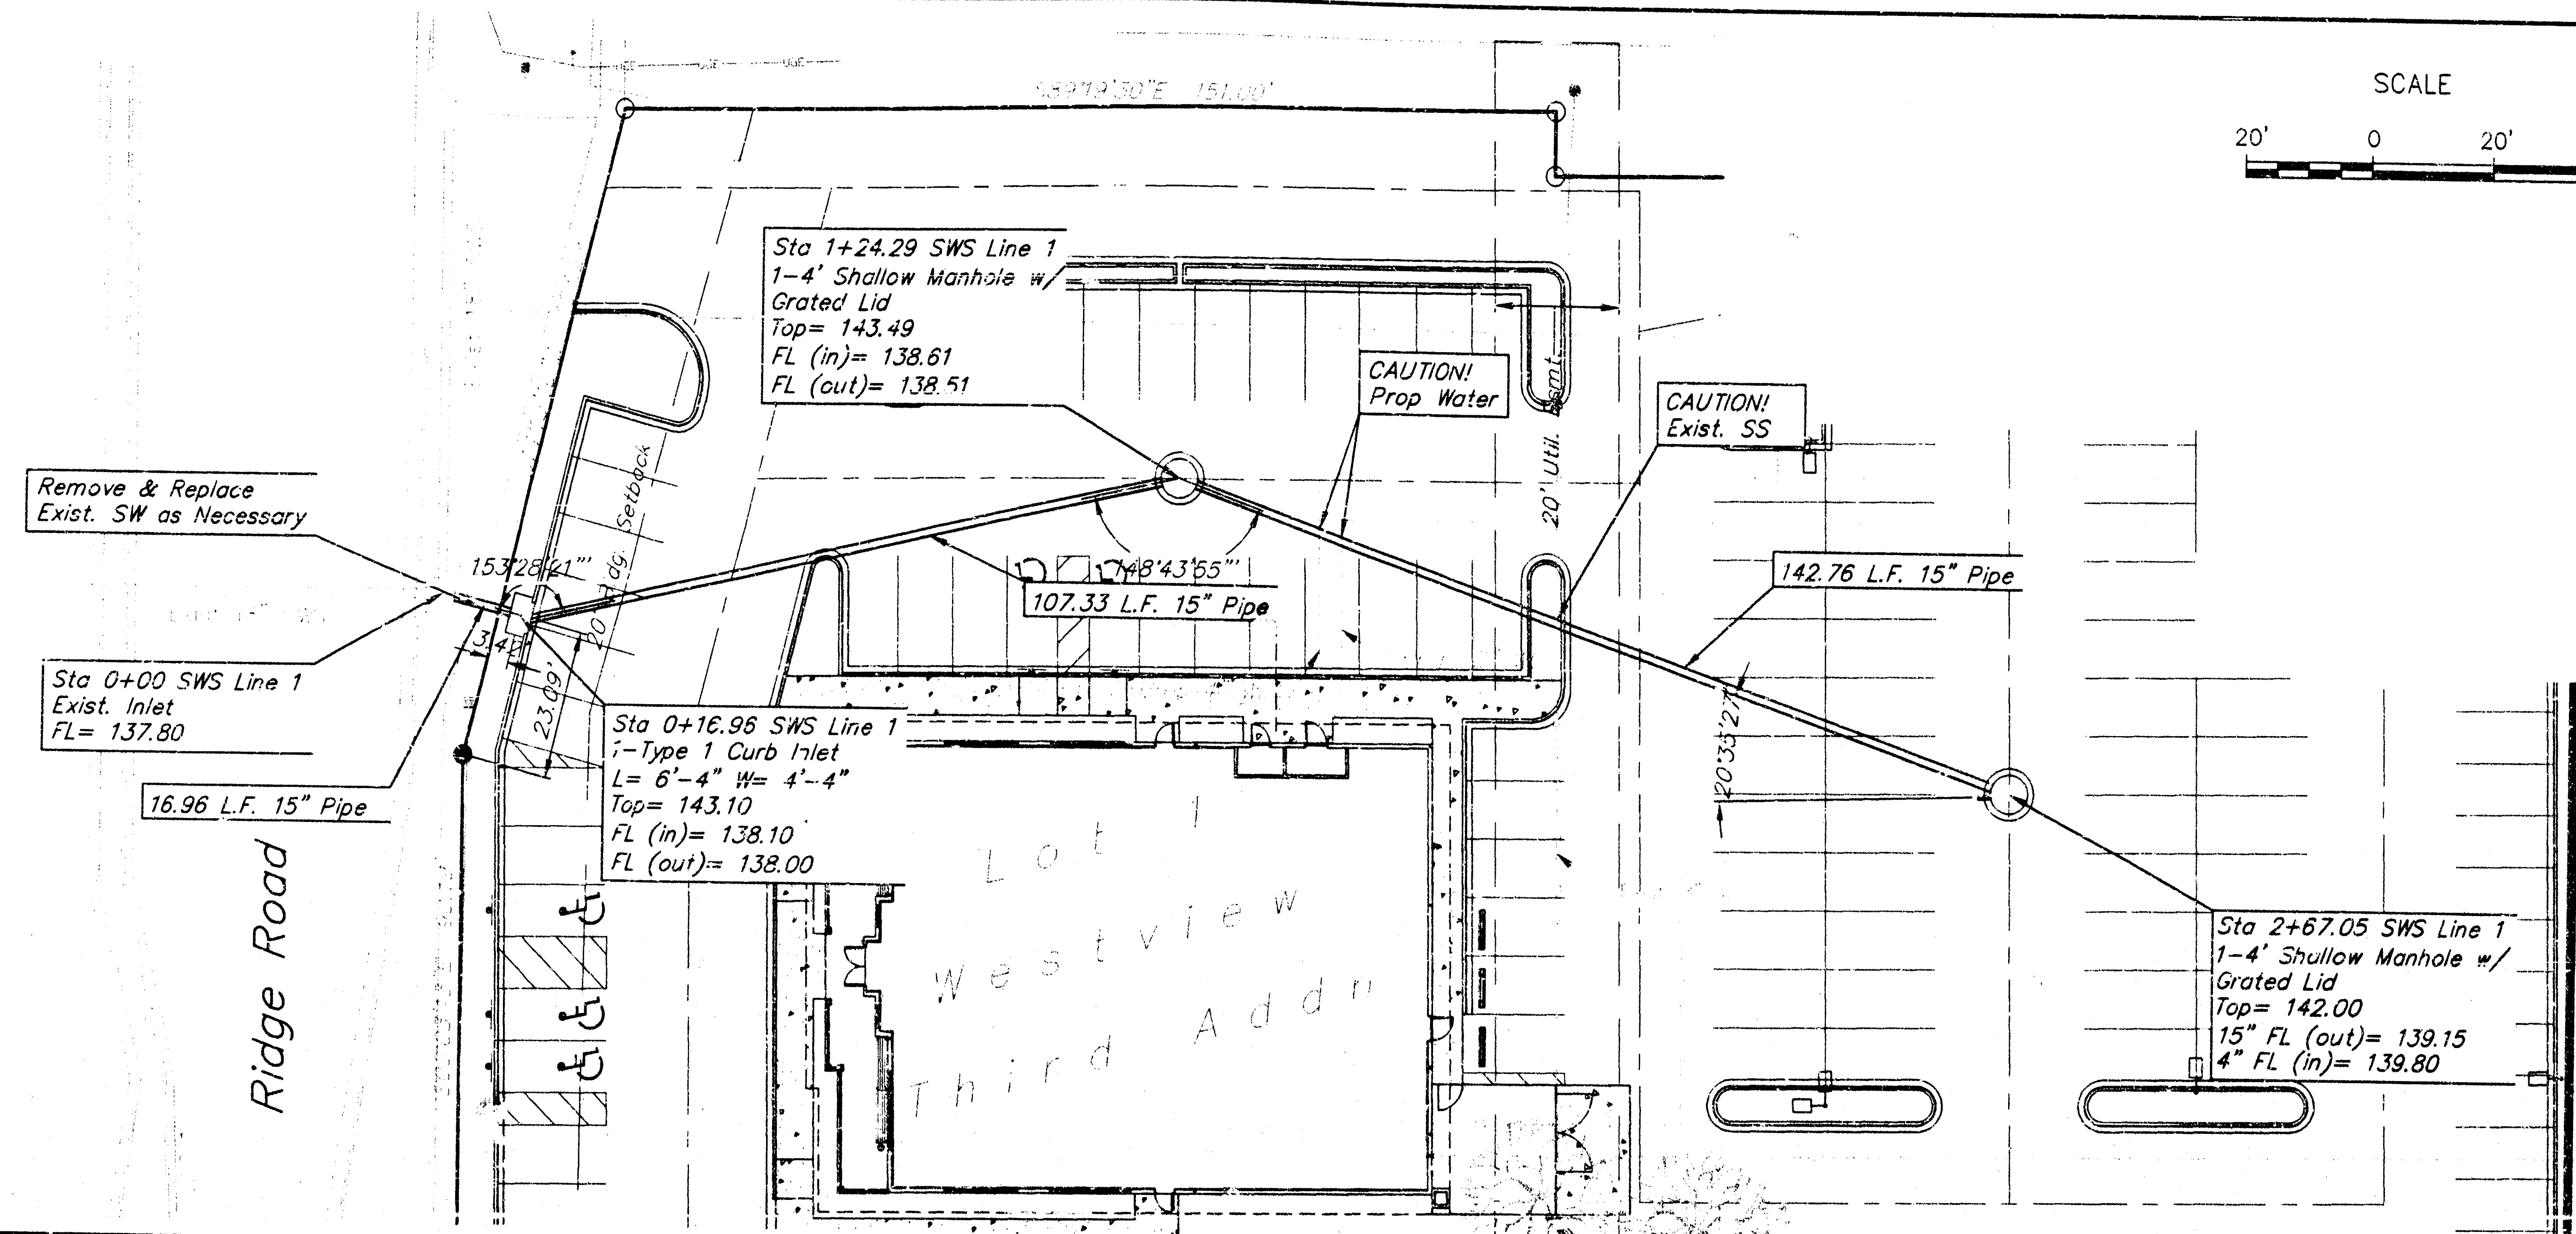

PROJECT NUMBER				AM NO	LOT 1, WESTVIEW 3RD ADDITION		SHEET
DESIGN	DRAWN	FILE	DATE	SCALE	STORM SEWER		2
RR	MY	SWSDP1	12/16/98	1"=20'	WICHITA, KS		2
							REVISION
							1/22/99

STORM SEWER