



1. ALL MANHOLE SLOTS MEET CURRENT ASTM GRADE PLANTING
2. ALL REINFORCING IS GRADE 60
3. JOINTS BETWEEN MANHOLE SECTIONS TO BE SEALED WITH TWO STRIPS OF EXPOSED BUTYL RUBBER JOINT MATS MEETING CITY OF WICHITA TYPE P MANHOLE SPECIFICATIONS

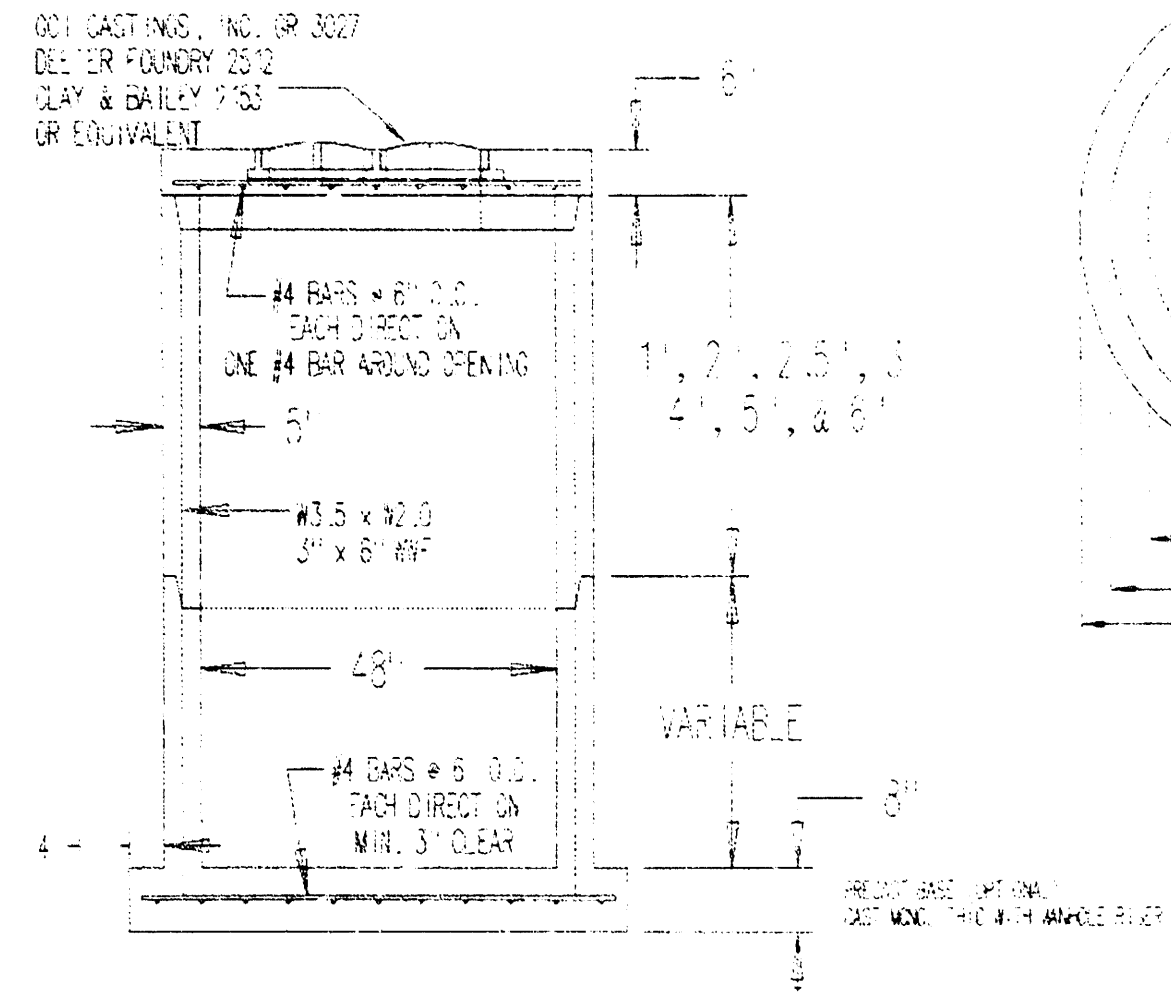

PRECAST DROP INLET DETAIL


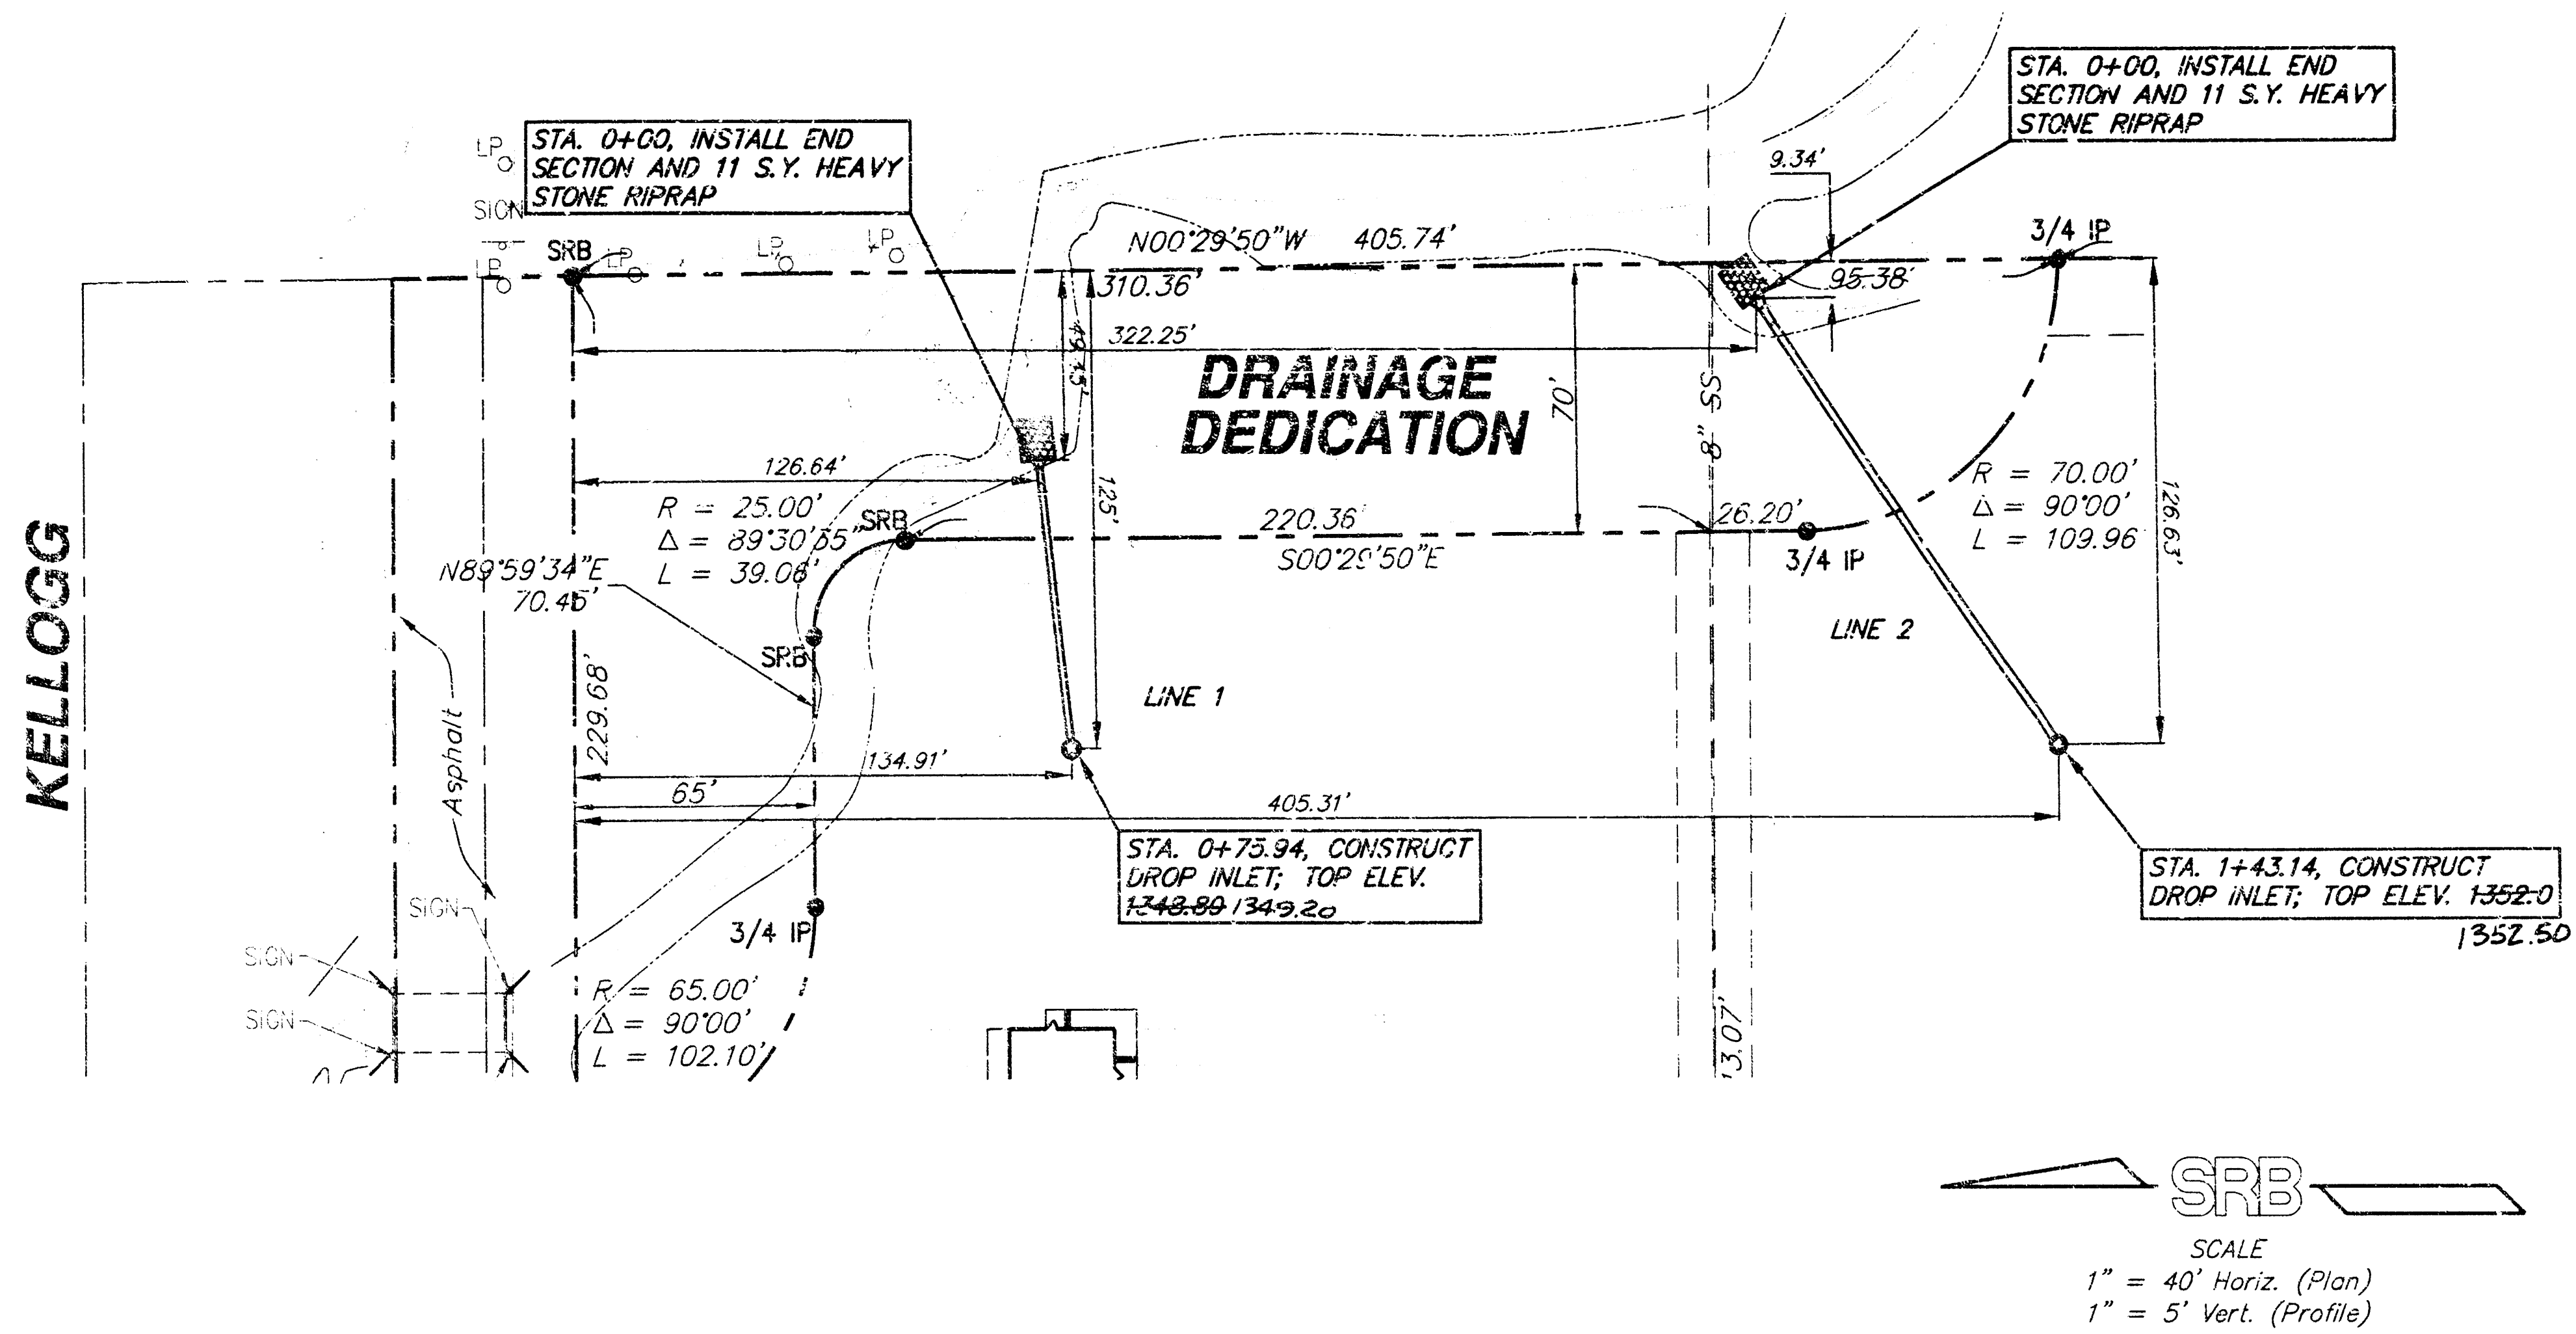


APPROVED AS NOTED
BY CITY ENGINEER OF WICHITA

Sanitary Sewers _____
Storm Sewers VRH 9/16/99
Driveway Approaches _____
Water Mains _____
Paving _____

NOTE TO CONTRACTORS

Inspection and testing for this project are to be provided by a Licensed Consulting Engineering Firm under contract with the Owner/Developer. Said inspection to be in accordance with the City of Wichita standard construction engineering practices and certified by a Licensed Professional Engineer. No work shall be performed in dedicated easements or public right-of-way by the Contractor without such inspection, nor shall any work be commenced without written authorization by the City Engineer.

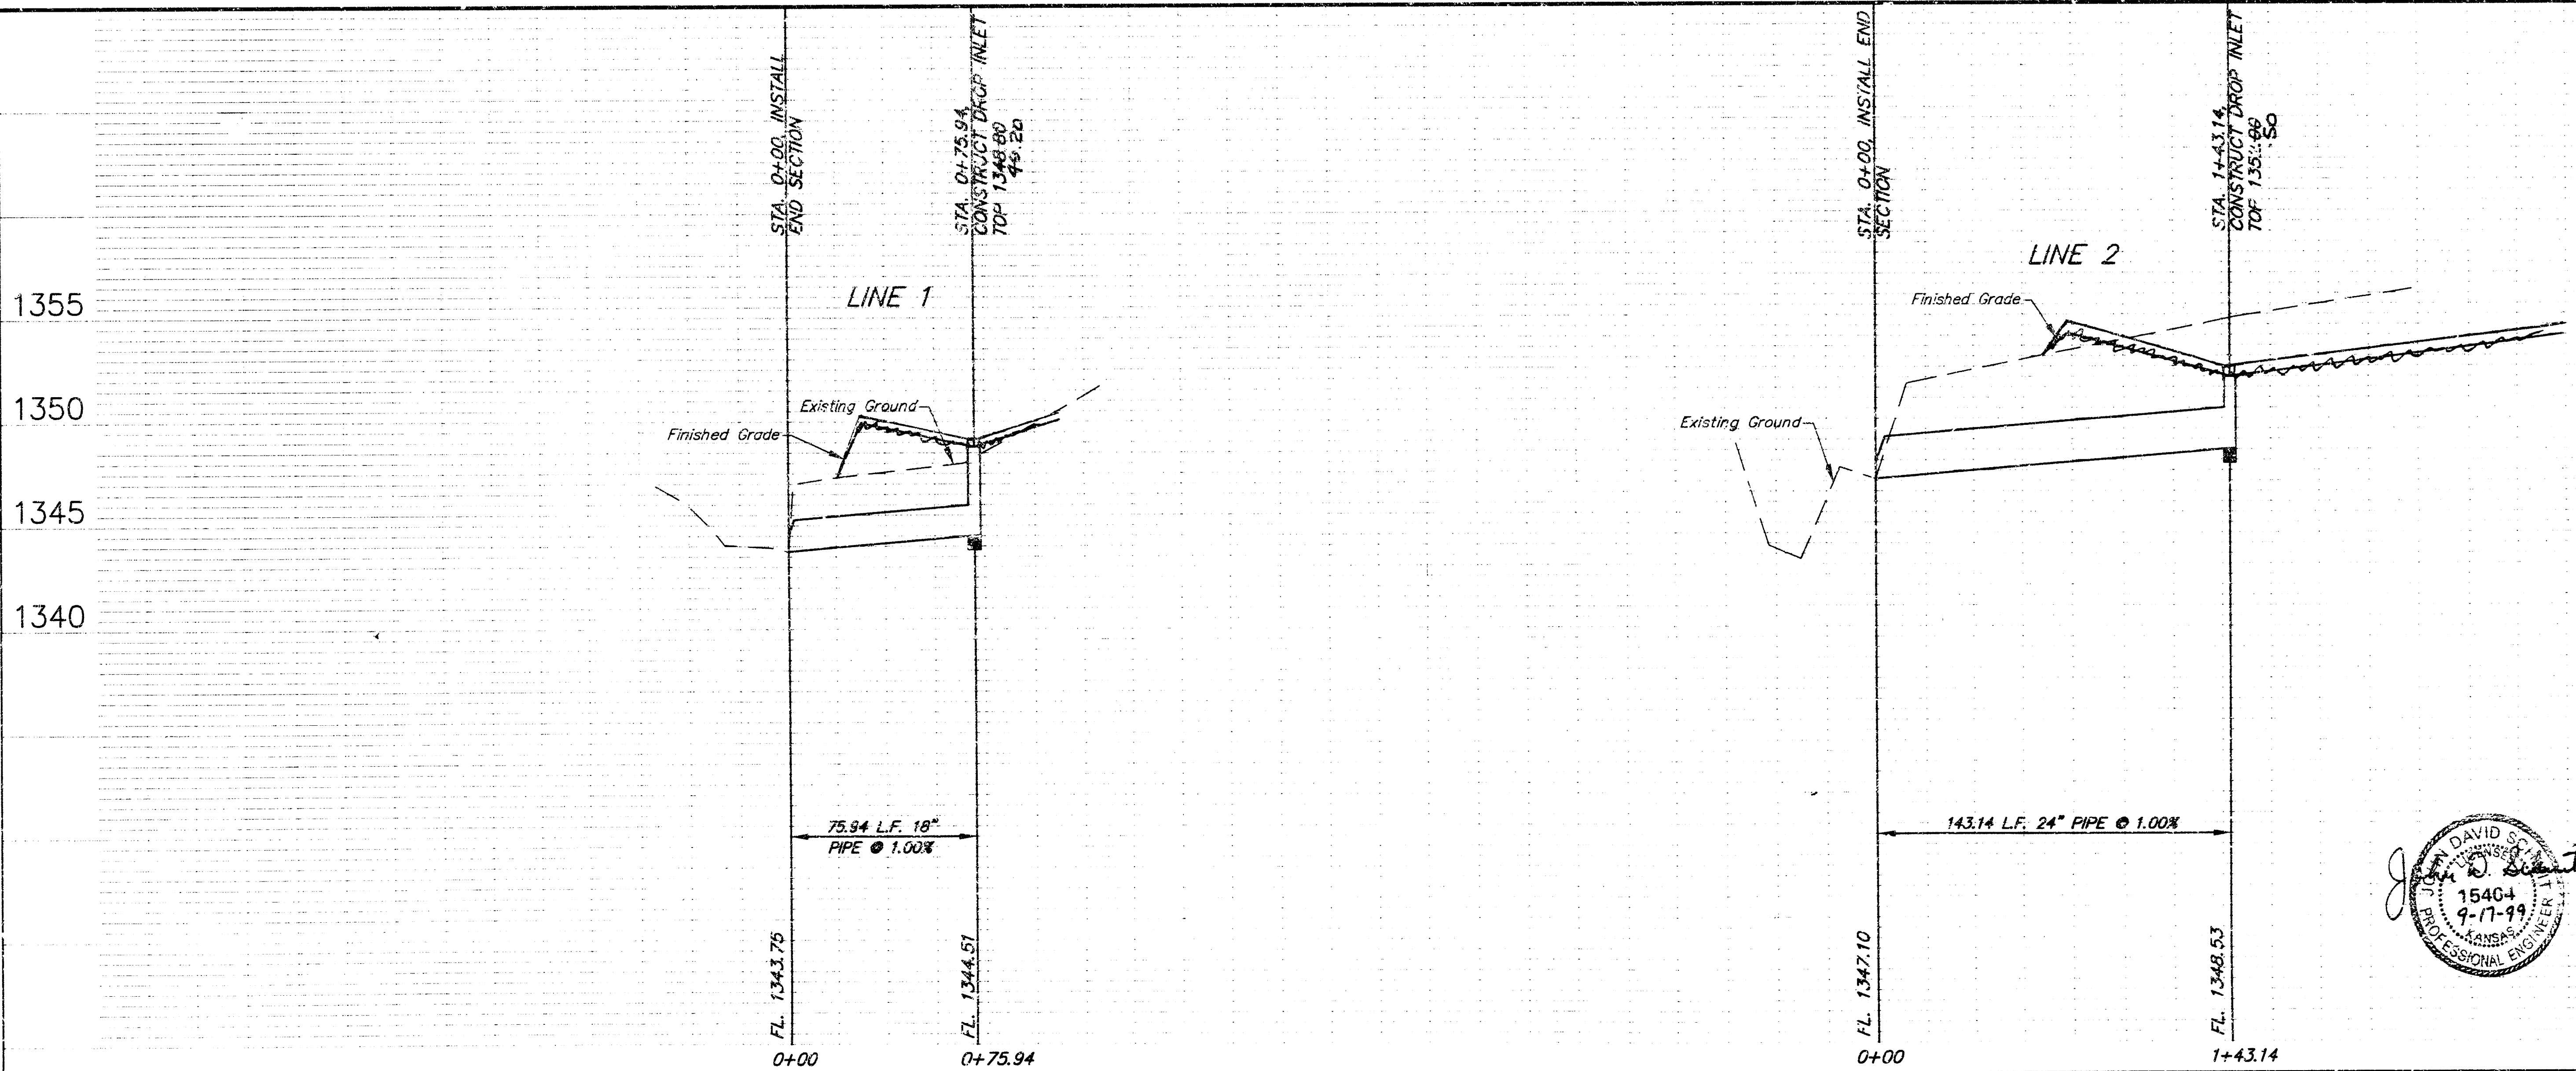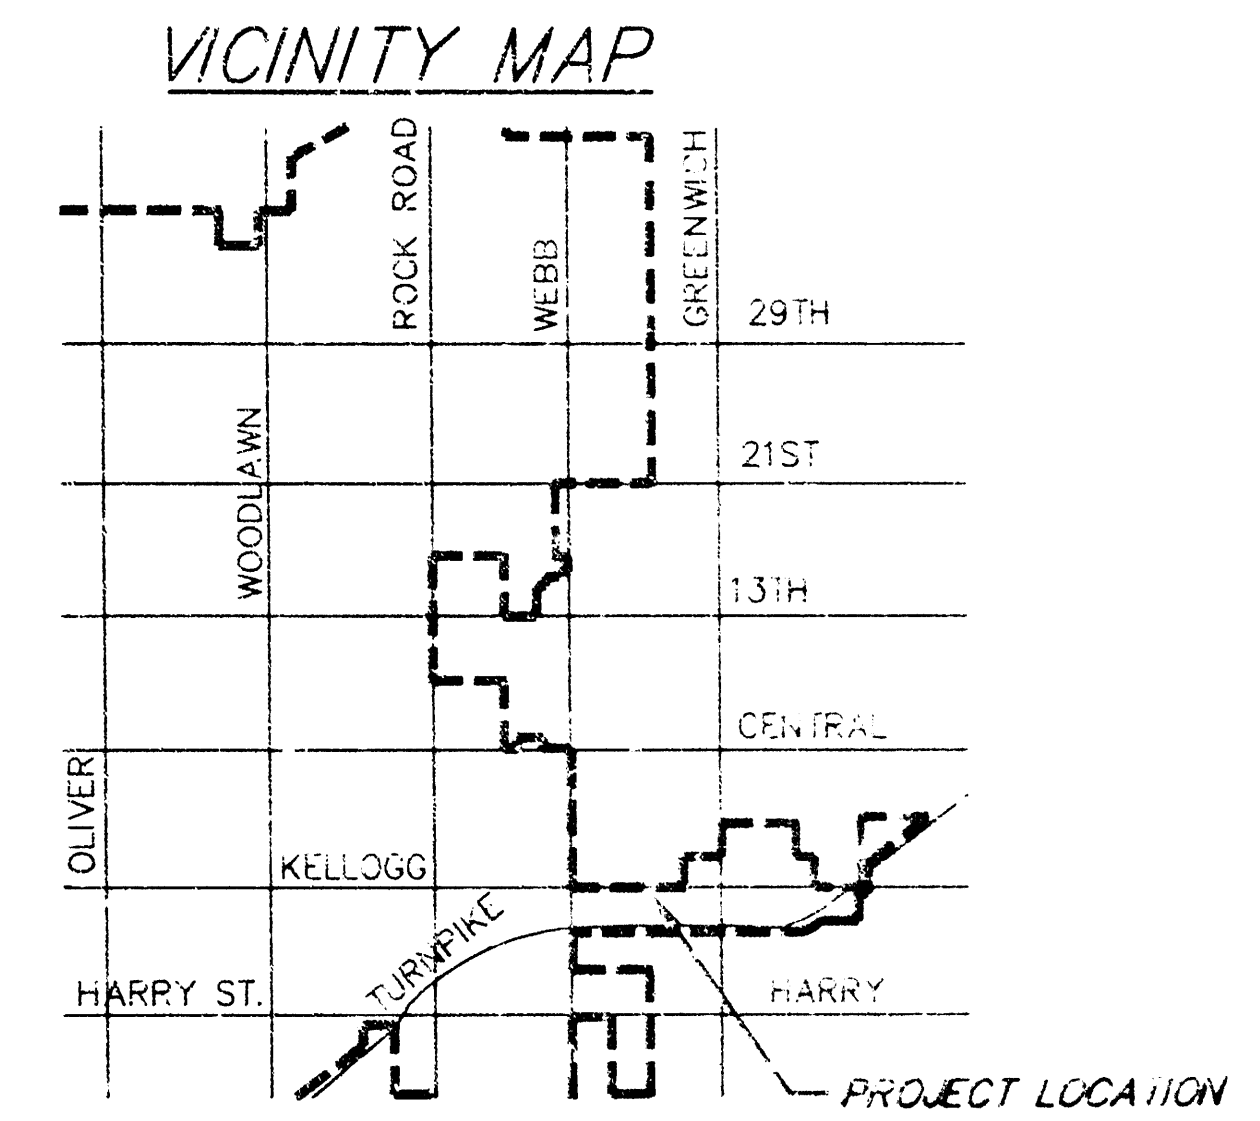

BOOKED
6-5-00
MCC
0-462

As-Built
11/20/99
M. Stump

REV. 9-16-99 TOP OF INLET SCR

**LOTS 1-3, BLK. 3, WIEDEMANN BUS. PARK
STORM SEWER PROFILES
WICHITA, KANSAS**

SRB 924 NORTH MAIN WICHITA, KANSAS 67203 316-264-8038 FAX 264-4621
http://www.fest.com/~srb E-Mail: srbs@fest.com

**SAVOY, RUGGLES & BOHM, P.A.
ENGINEERING & SURVEYING**

PROJECT NUMBER
936-PPS (607861)

DESIGN	TOR	DRAWN	JTS	UTILITY	REVIEW	DATE	Sept. 3, 1999	REVISED	9-16-99
--------	-----	-------	-----	---------	--------	------	---------------	---------	---------

12 04 05 51