



BROADWAY
(U.S. 81)

CAUTION: 3" PETROLEUM
PIPELINE (COASTAL)

CAUTION: 12" WATER MAIN

STA. 1+96
CONSTRUCT 2'X2' DROP INLET
TOP ELEV. 86.00
W/ SEDIMENT BARRIER


BENCH MARK:
47.5' E. & 41' S. OF THE SEC. COR.
ON, AT CUSTY & BROADWAY
ELEV. = 86.82 CITY DATUM

Sanitary Sewers _____
Storm Sewers URH 6/9/00
Driveway Approaches _____
Water Mains _____
Paving _____

NOTE TO CONTRACTORS

Inspection and testing for this project are to be provided by a Licensed Consulting Engineering Firm under contract with the Owner/Developer. Said inspection to be in accordance with the City of Wichita standard construction engineering practices and certified by a Licensed Professional Engineer. No work shall be performed in dedicated easements or public right-of-way by the Contractor without such inspection, nor shall any work be commenced without written authorization by the City Engineer.

SCALE
1" = 20' Horiz. (Plan)
1" = 5' Vert. (Profile)

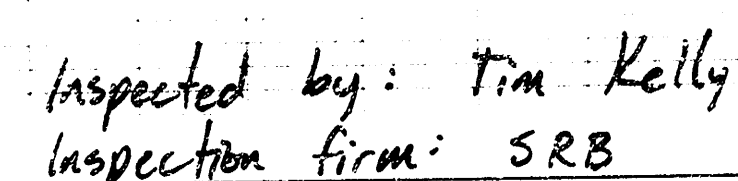

NOTES:

1. ALL STORM SEWER MATERIALS AND CONSTRUCTION TO COMPLY WITH CITY OF WICHITA STANDARD SPECIFICATIONS. PVC PIPE TO BE SDR26 OR THICKER WALL.
2. CONTRACTOR TO VERIFY DEPTH OF 3" PETROLEUM PIPELINE AND 12" WATER MAIN PRIOR TO BEGINNING ANY CONSTRUCTION.
3. THE CONTRACTOR SHALL RESTORE ALL AREAS DISTURBED BY CONSTRUCTION OPERATIONS IN CONFORMANCE WITH ADMINISTRATIVE REGULATION AR-78.
4. NOT MORE THAN ONE LANE OF TRAFFIC ON BROADWAY SHALL BE CLOSED FOR CONSTRUCTION.
5. CONTRACTOR SHALL BE RESPONSIBLE FOR PERMIT(S) FROM KANSAS DEPARTMENT OF TRANSPORTATION FOR ALL WORK WITHIN BROADWAY (U.S. 81) P/W

BENCH MARK:
47.5' E. & 41' S. OF THE SEC. COR.
ON, AT CUSTY & BROADWAY
ELEV. = 86.82 CITY DATUM

APPROVED AS NOTED
BY CITY ENGINEER OF WICHITA

Sanitary Sewers _____
Storm Sewers URH 6/9/00
Driveway Approaches _____
Water Mains _____
Paving _____

NOTE TO CONTRACTORS

Inspection and testing for this project are to be provided by a Licensed Consulting Engineering Firm under contract with the Owner/Developer. Said inspection to be in accordance with the City of Wichita standard construction engineering practices and certified by a Licensed Professional Engineer. No work shall be performed in dedicated easements or public right-of-way by the Contractor without such inspection, nor shall any work be commenced without written authorization by the City Engineer.

As-Builts = Built per plan 12-21-2000

**FLEETWOOD RETAIL CORPORATION
PRIVATE STORM SEWER
5255 S. BROADWAY, WICHITA, KANSAS**


SRB 924 NORTH MAI 316-264-8008
WICHITA, KANSAS 67203 FAX 264-4621
<http://www.fest.com/~srb> E-Mail: srb@fest.com

SAVOY, RUGGLES & BOHM, P. A.
ENGINEERING & SURVEYING

1011 PPS (607861)


DESIGN TCB	DRAWN JTS	UTILITY	REVIEW	DATE May 25, 2000	REVISED June 2, 2000
---------------	--------------	---------	--------	----------------------	-------------------------

90	
85	
80	


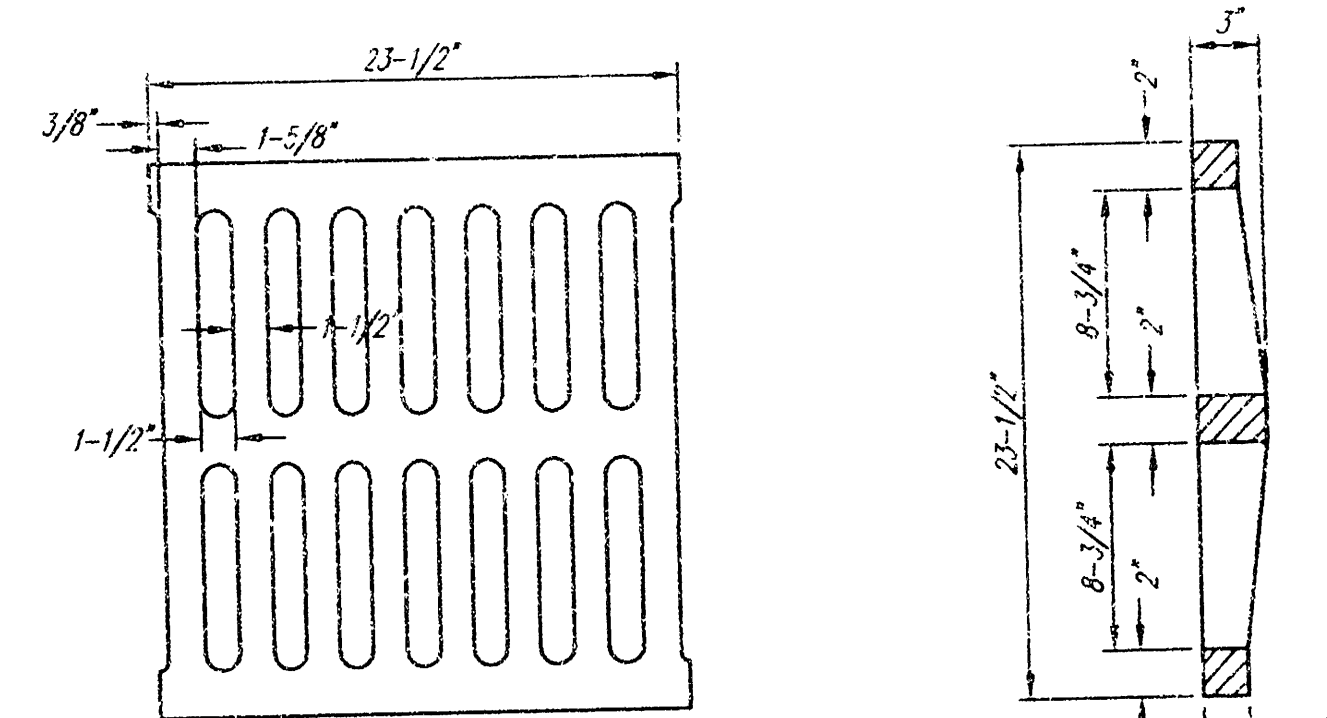


DEETER #2433 GRATE


24" x 24" Frame and Grate Detail

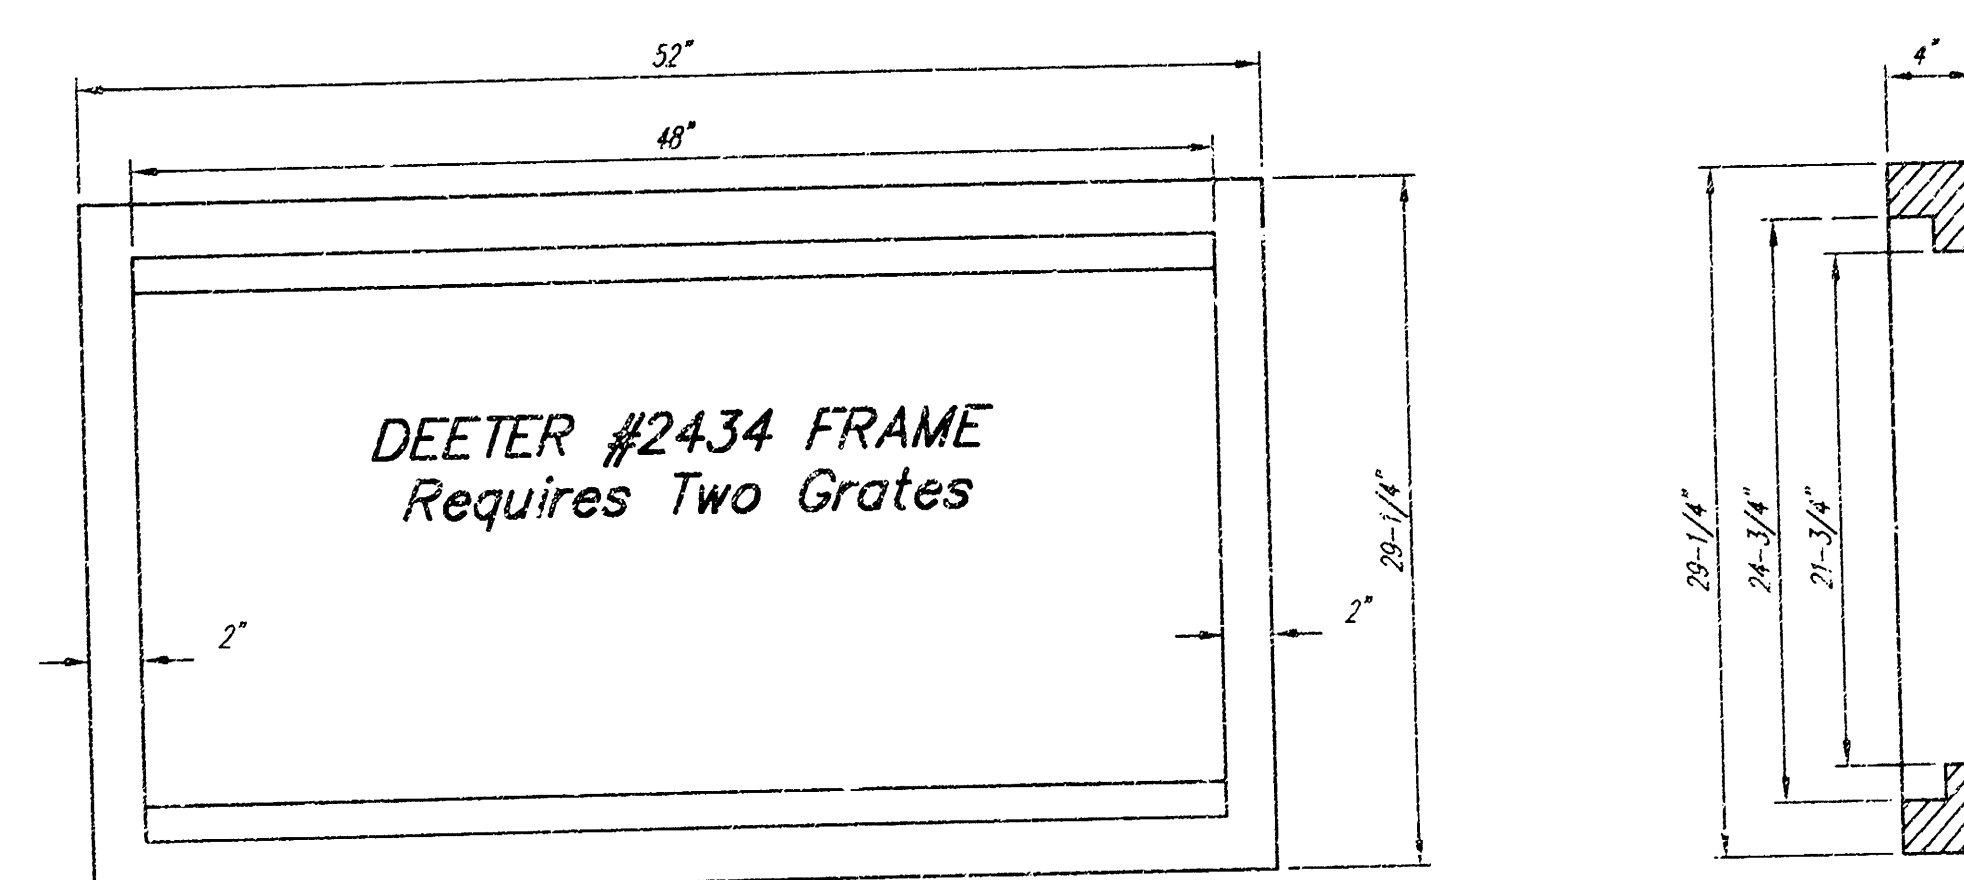

Double 24" x 24" Frame Detail

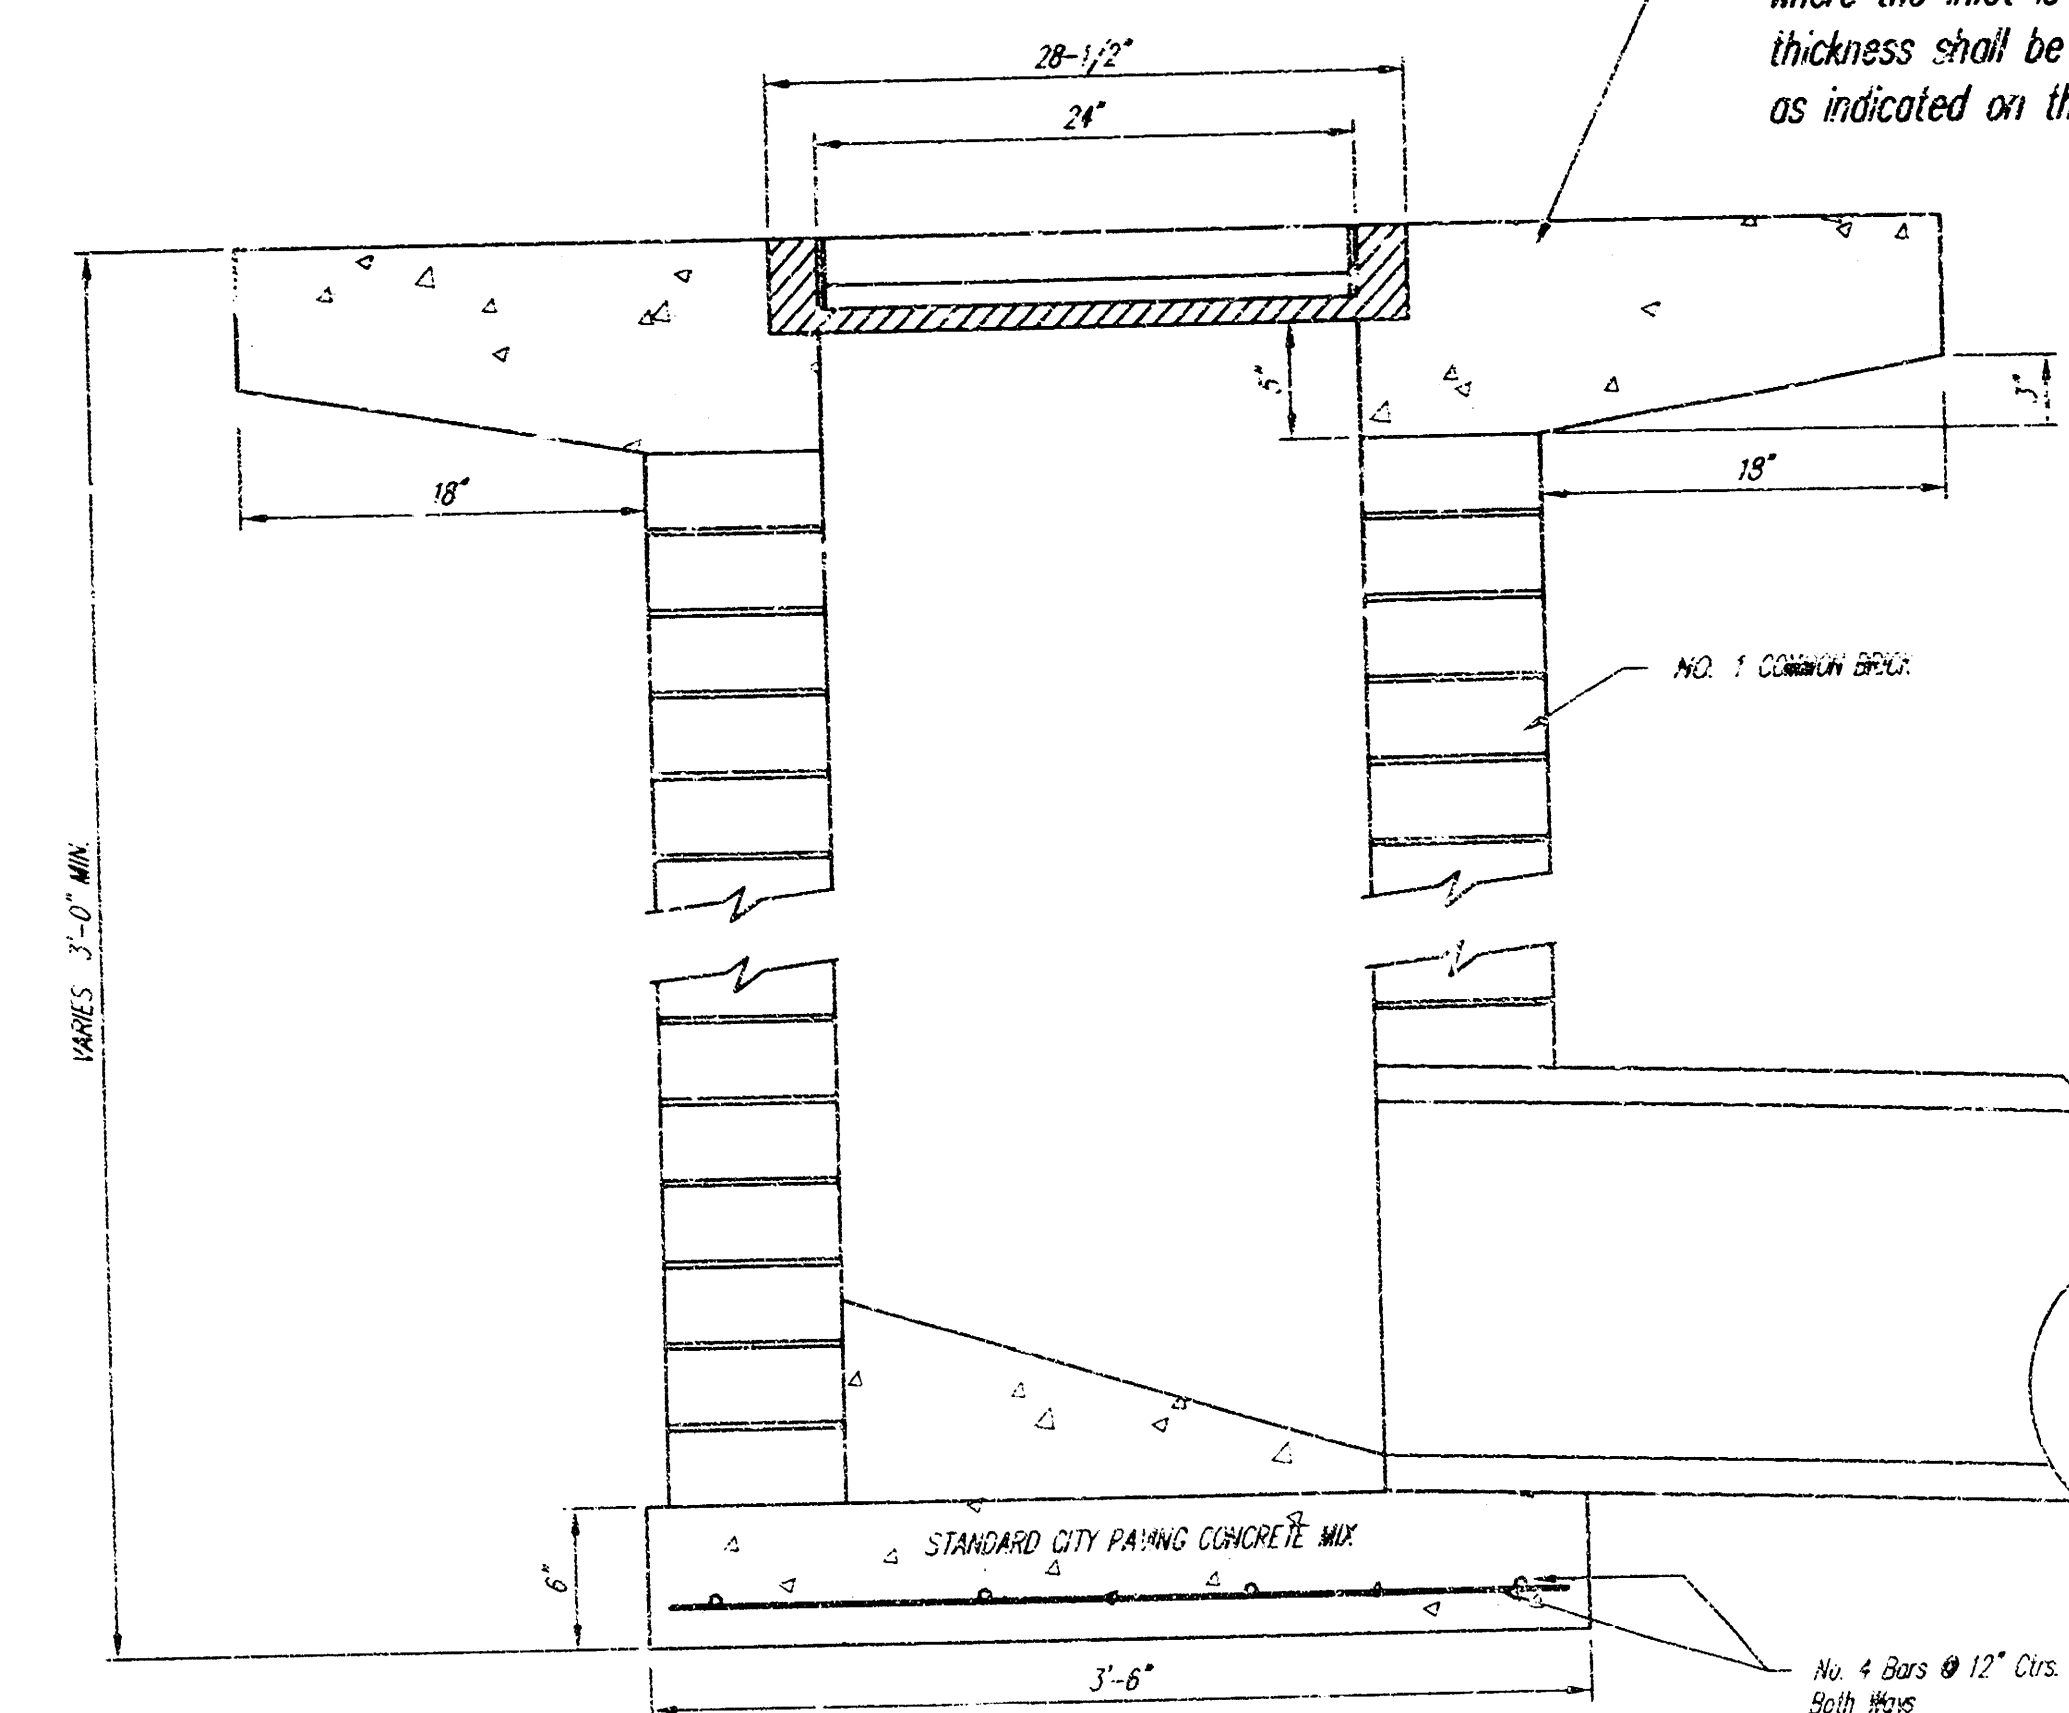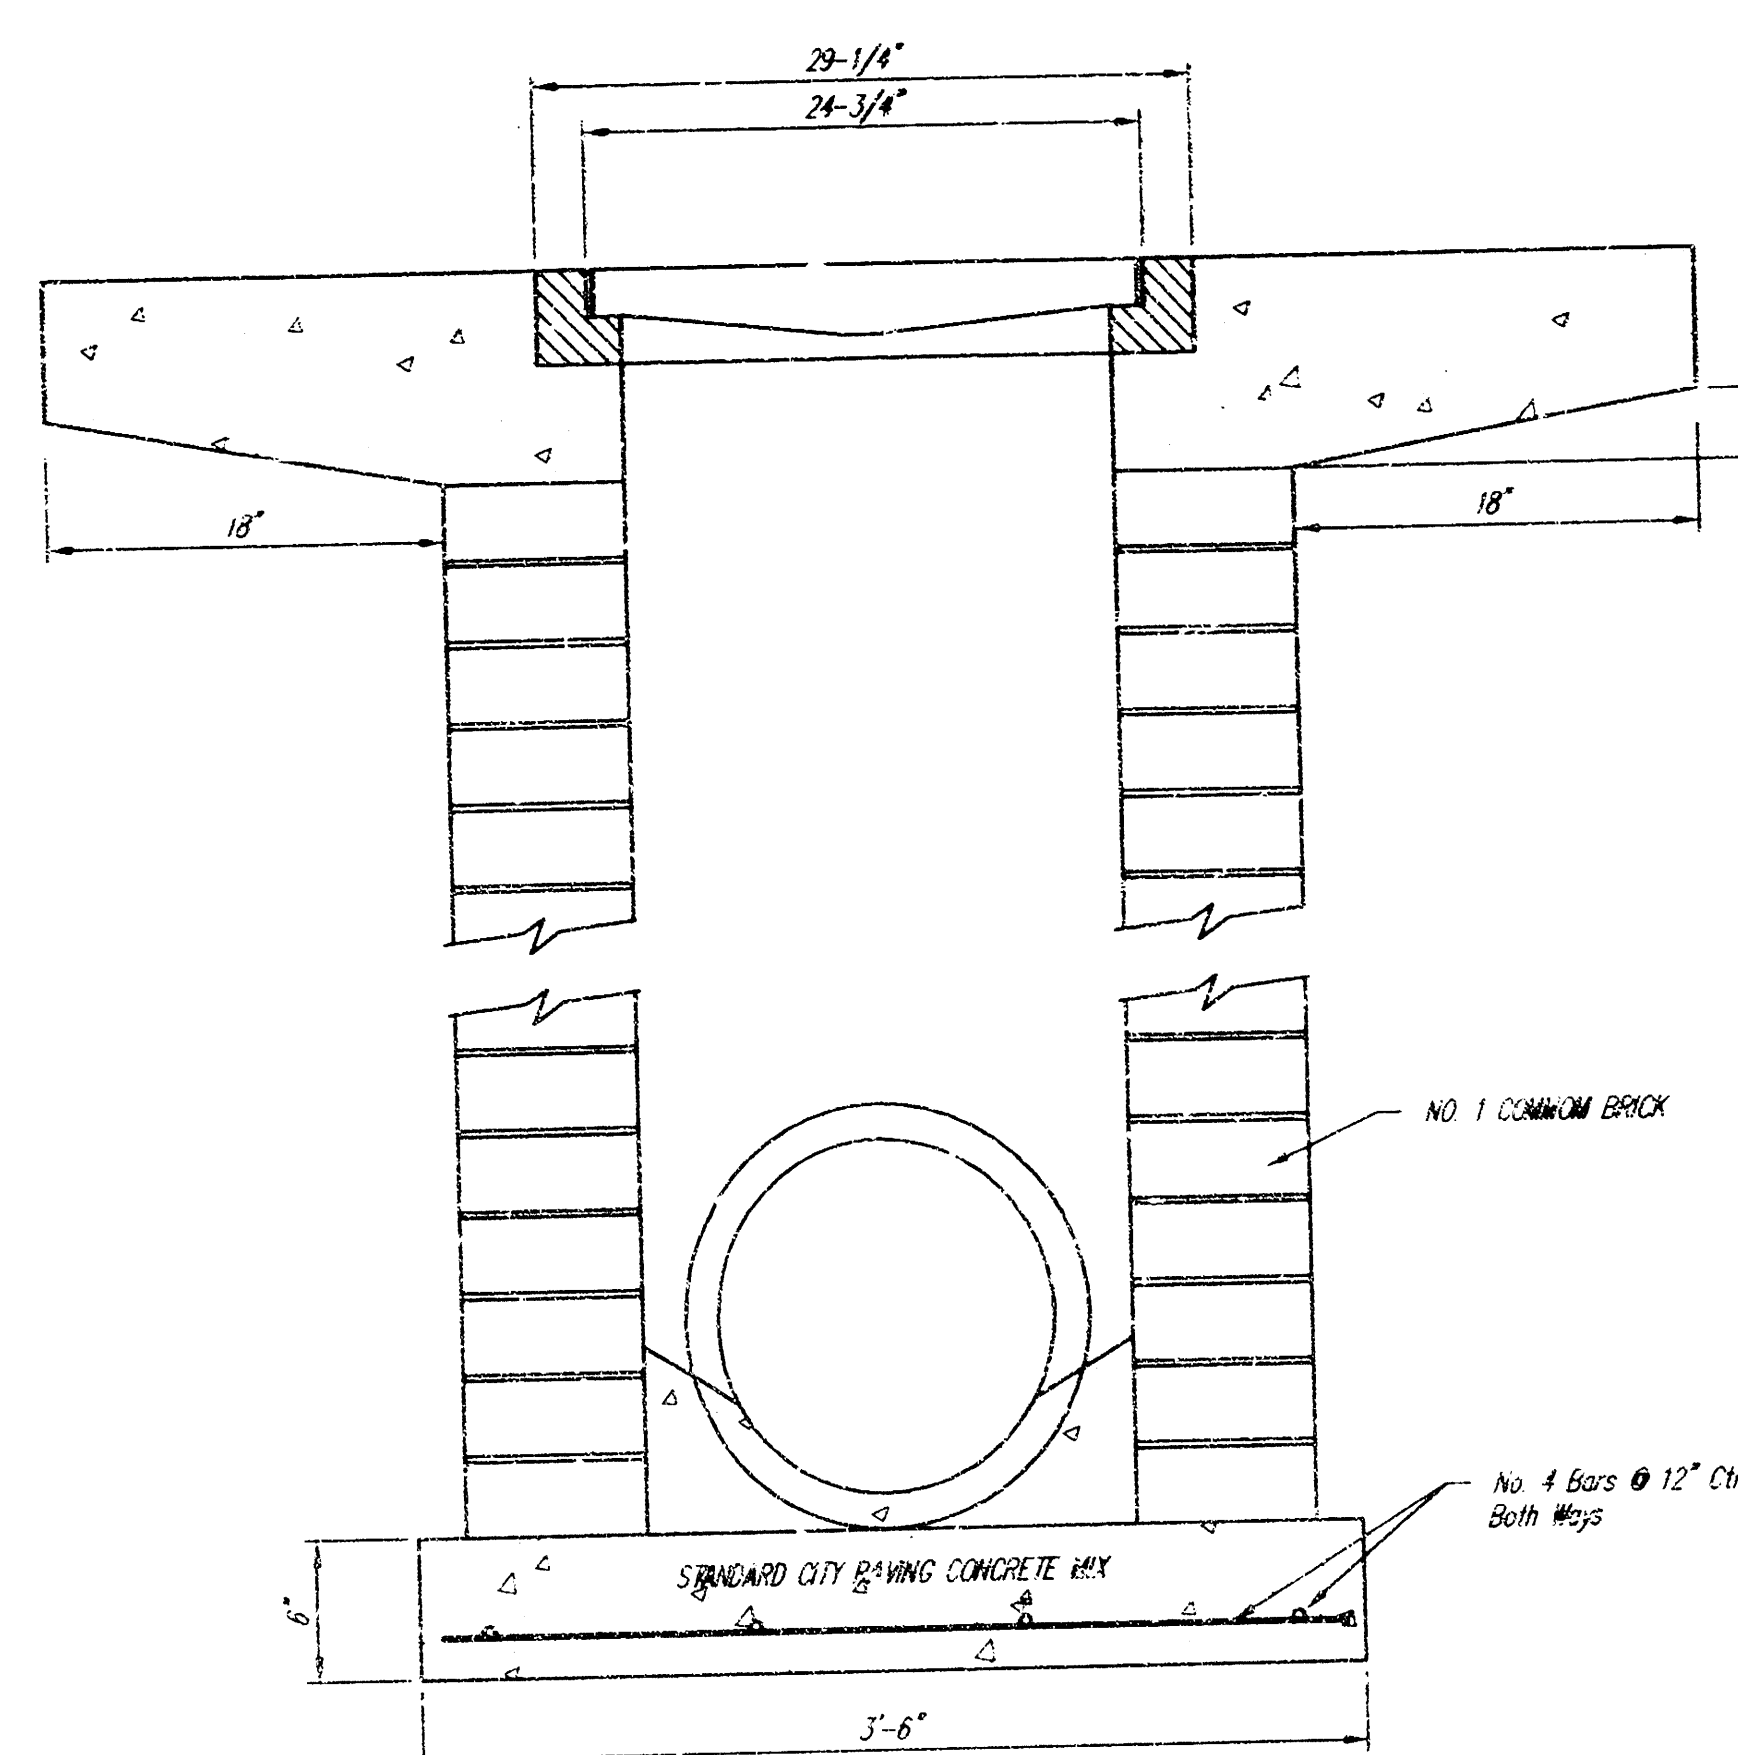

Note: Concrete apron shall be constructed around the inlet when inlet is located in an unpaved area. Where the inlet is adjacent to pavement, the pavement thickness shall be tapered to the inlet in 18 inches as indicated on the detail.

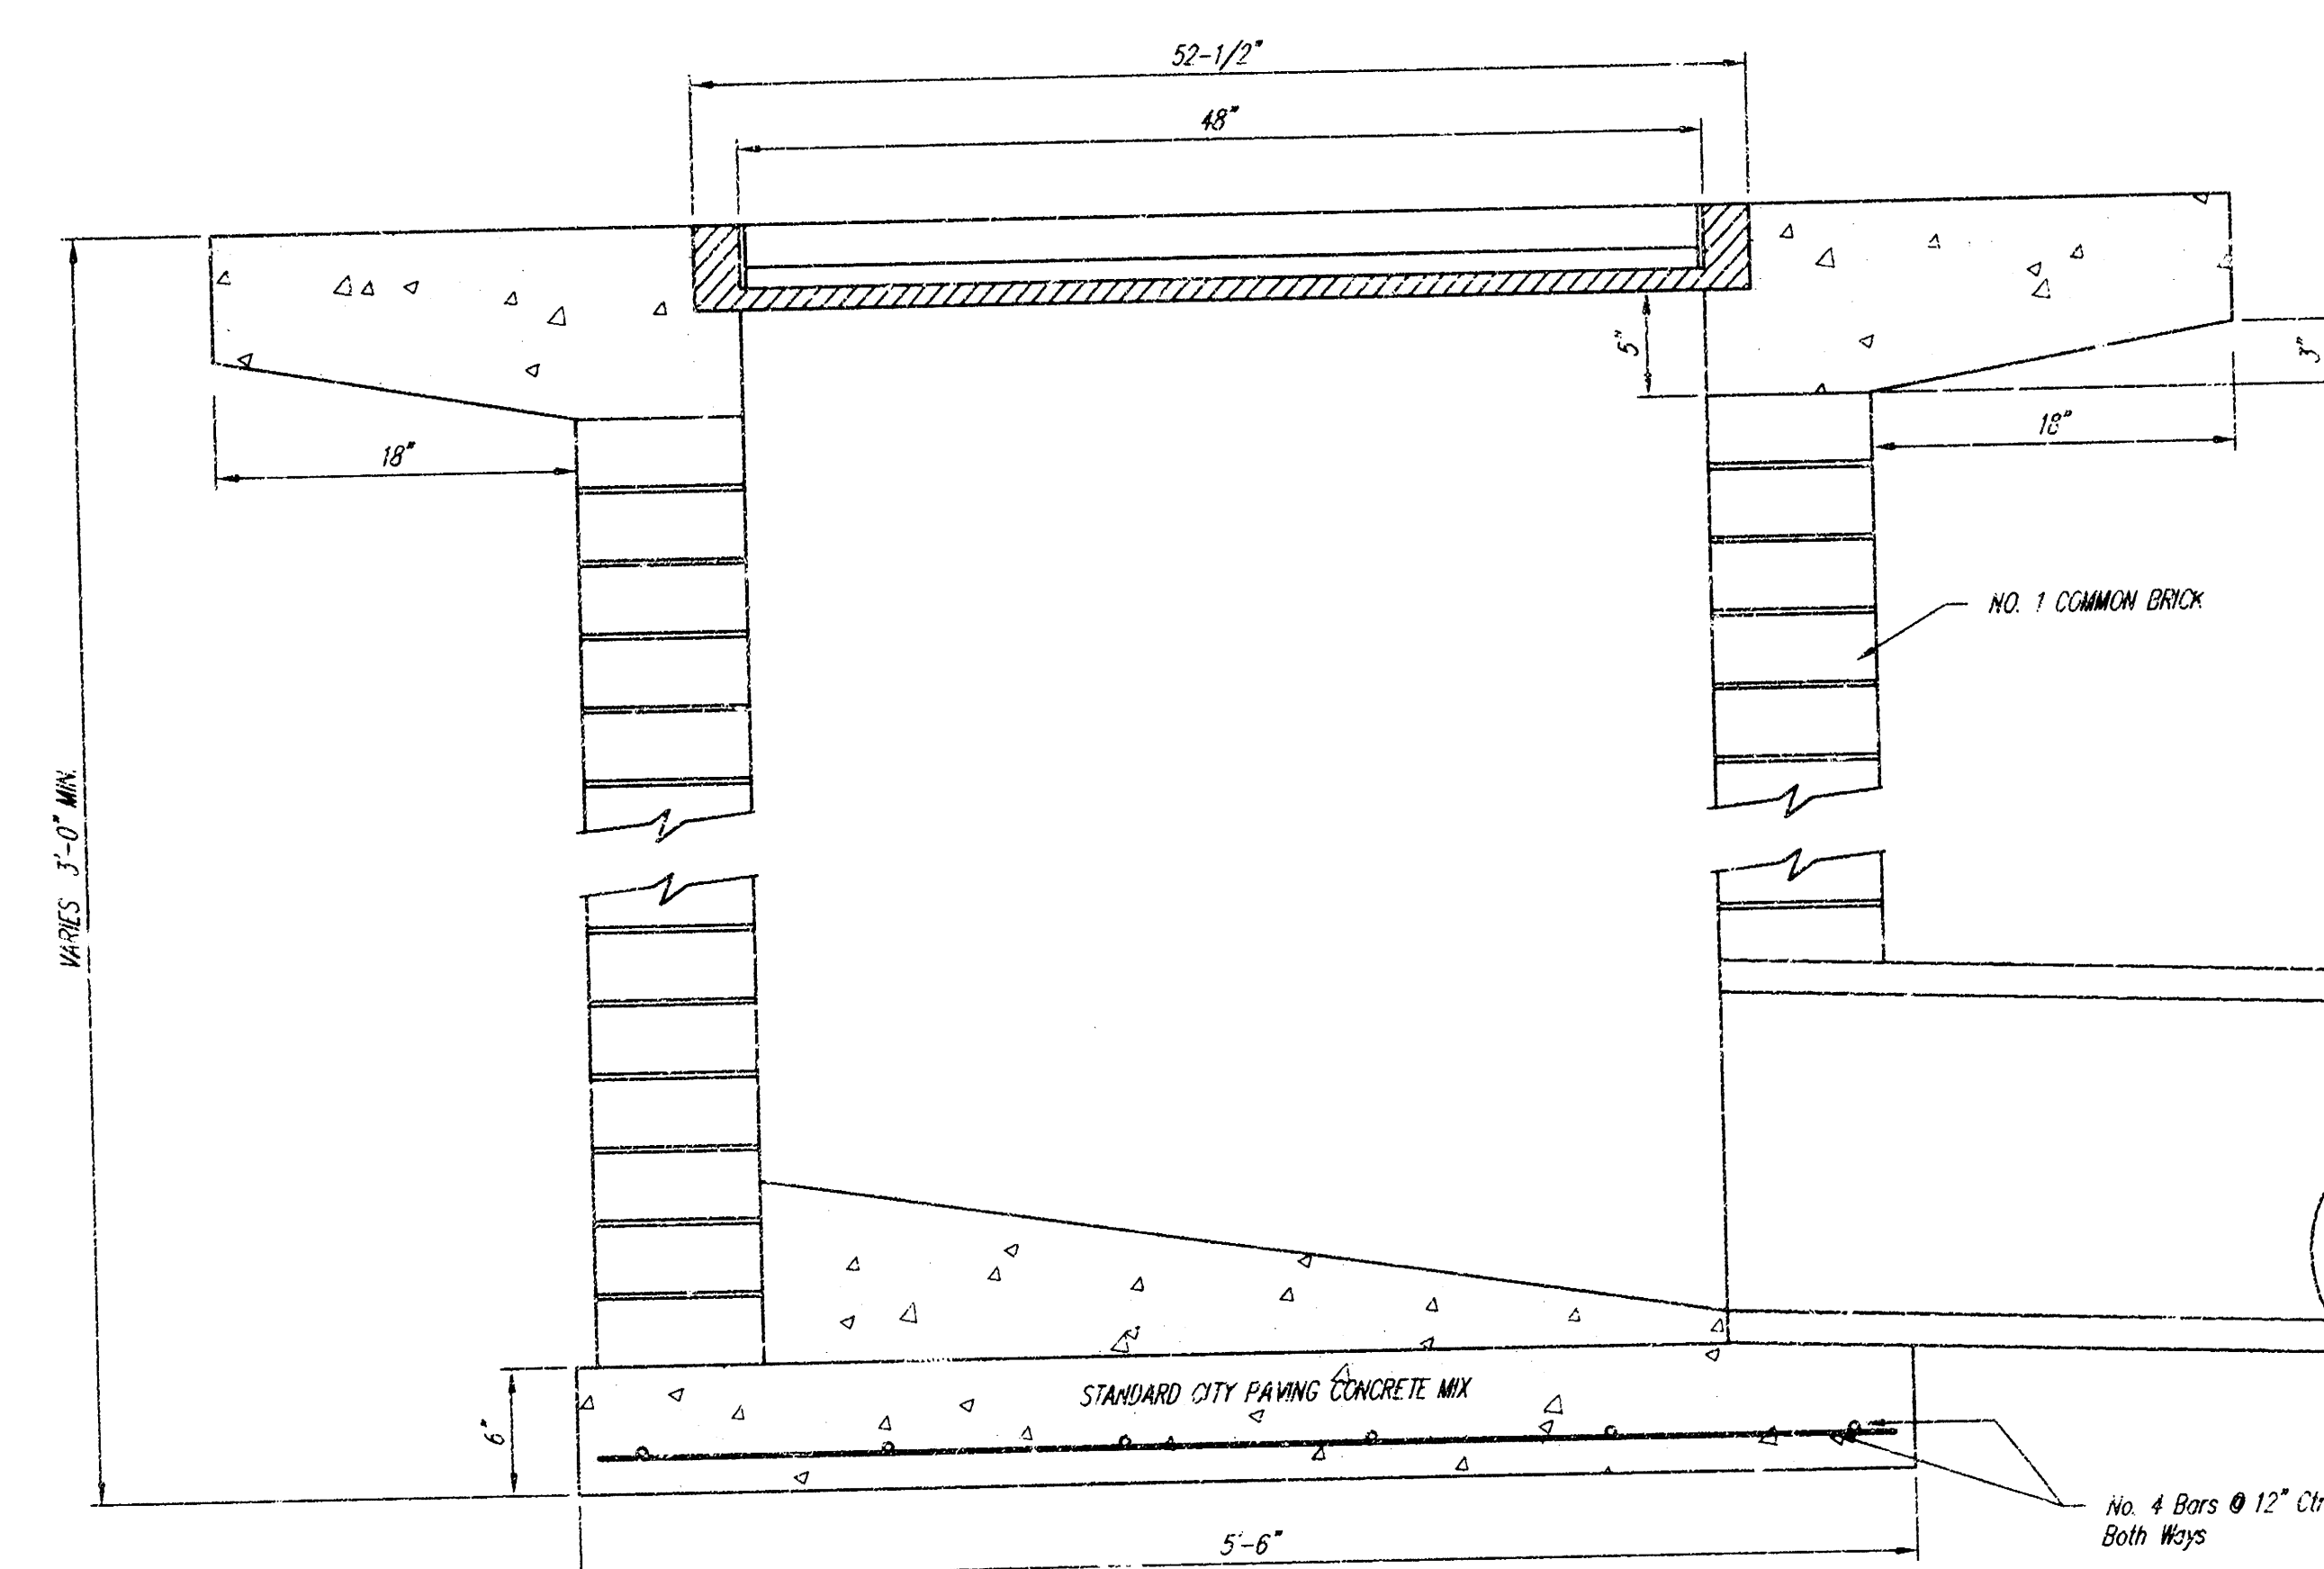

18 03 03 02