



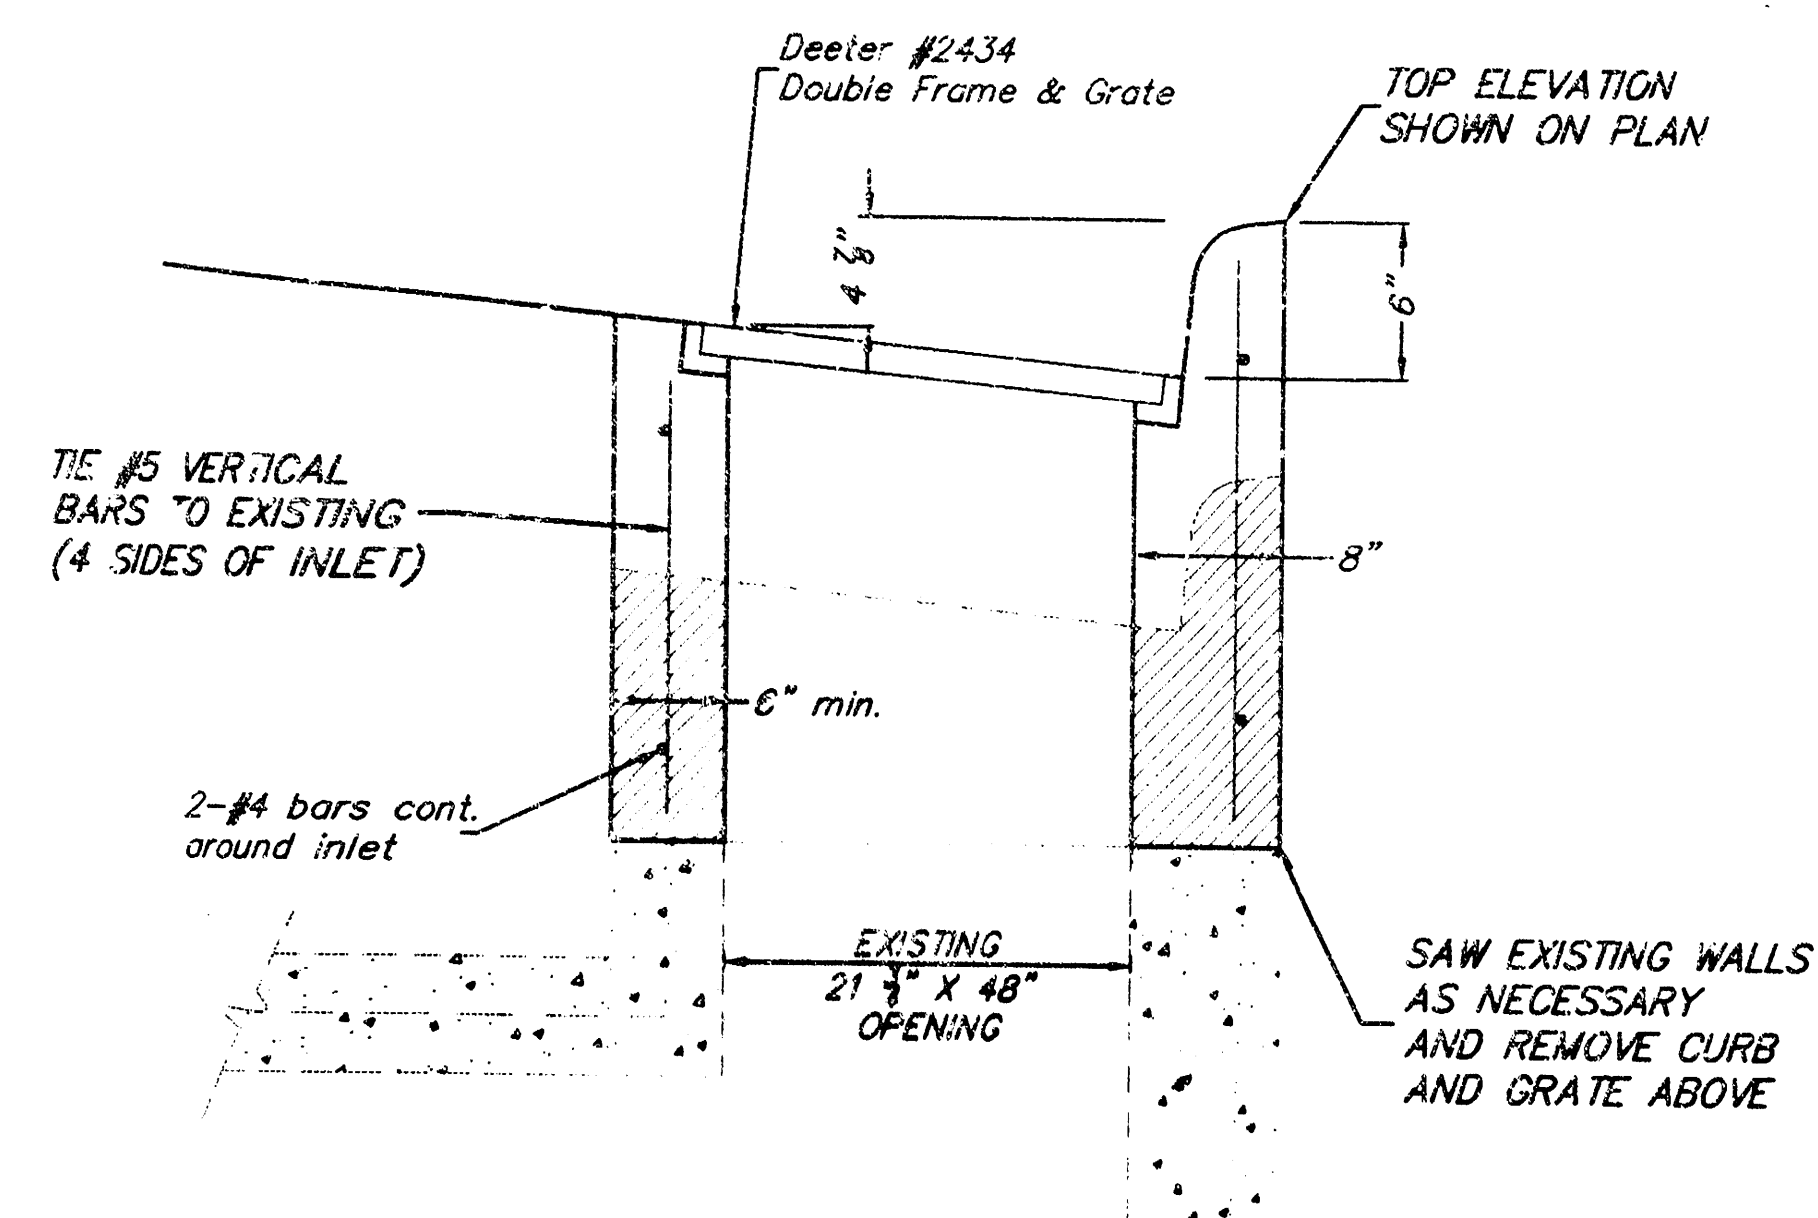

CURB INLET ADJUSTMENT DETAIL

BENCHMARK:
"1" CUT ON THE S. SIDE OF
CONCRETE LIGHT POLE BASE.
B.L. STA. 13+33.70, 178.82' LT.

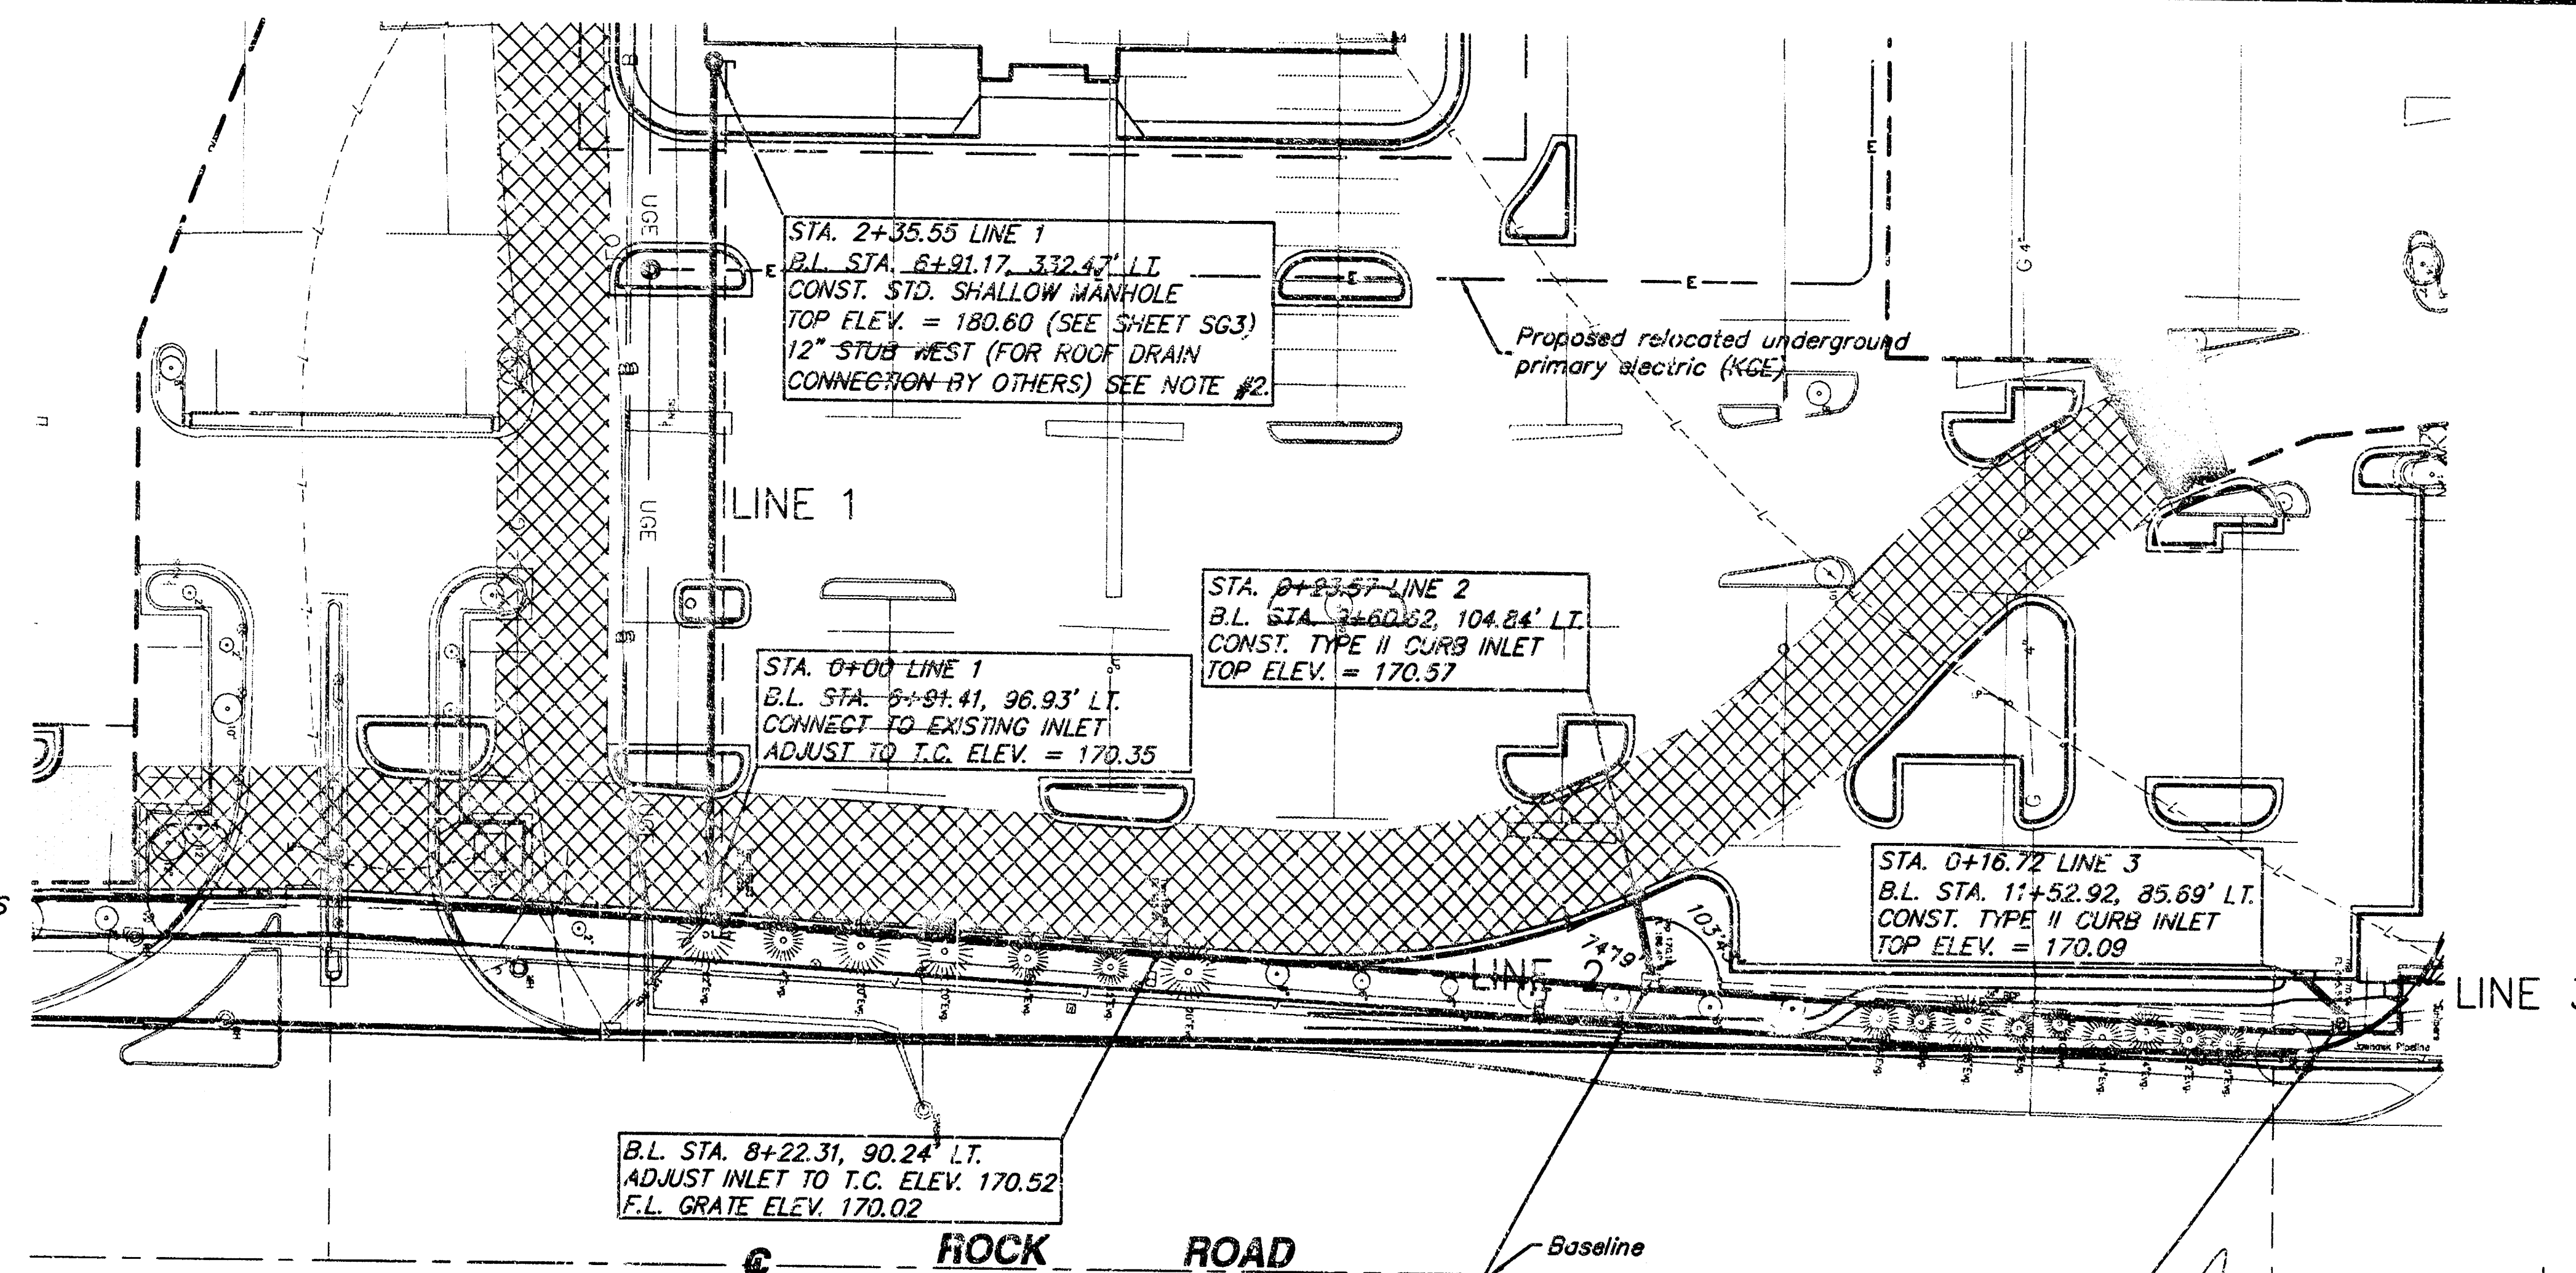

NOTES:

1. ALL STORM SEWER MATERIALS AND CONSTRUCTION TO COMPLY WITH CITY OF WICHITA STANDARD SPECIFICATIONS.
2. CONNECTION OF ROOF DRAIN TO STORM SEWER REQUIRES A PERMIT FROM CITY OF WICHITA.
3. INLET FRAMES AND GRATES MAY BE SALVAGED AND RE-USED IF, IN THE OPINION OF THE ENGINEER, THEY ARE IN GOOD CONDITION.
4. THIS PROJECT INCLUDES MODIFICATION OF MANHOLES AT B.L. STA. 6+58.25, 531.68' LT. AND B.L. STA. 9+17.45, 514.51' LT. AND CURB INLETS AT B.L. STA. 4+43.84, 101.20' LT. AND B.L. STA. 3+17.92, 99.17' LT. (NOT SHOWN ON THIS SHEET, SEE SITE GRADING PLAN).

SRB

SCALE
1" = 40' Horiz. (Plan)
1" = 5' Vert. (Profile)


APPROVED AS NOTED
BY CITY ENGINEER OF WICHITA

Sanitary Sewers	
Storm Sewers	VRH 6/13/00
Driveway Approaches	
Water Mains	
Paving	

NOTE TO CONTRACTORS


Inspection and testing for this project are to be provided by a Licensed Consulting Engineering Firm under contract with the Owner/Developer. Said inspection to be in accordance with the City of Wichita standard construction engineering practices and certified by a Licensed Professional Engineer. No work shall be performed in dedicated easements or public right-of-way by the Contractor without such inspection, nor shall any work be commenced without written authorization by the City Engineer.

N.E. Cor. SE1/4
Sec. 19, T-27S, R-2-E
=Baseline Sta. 20+00
(E. Douglas)

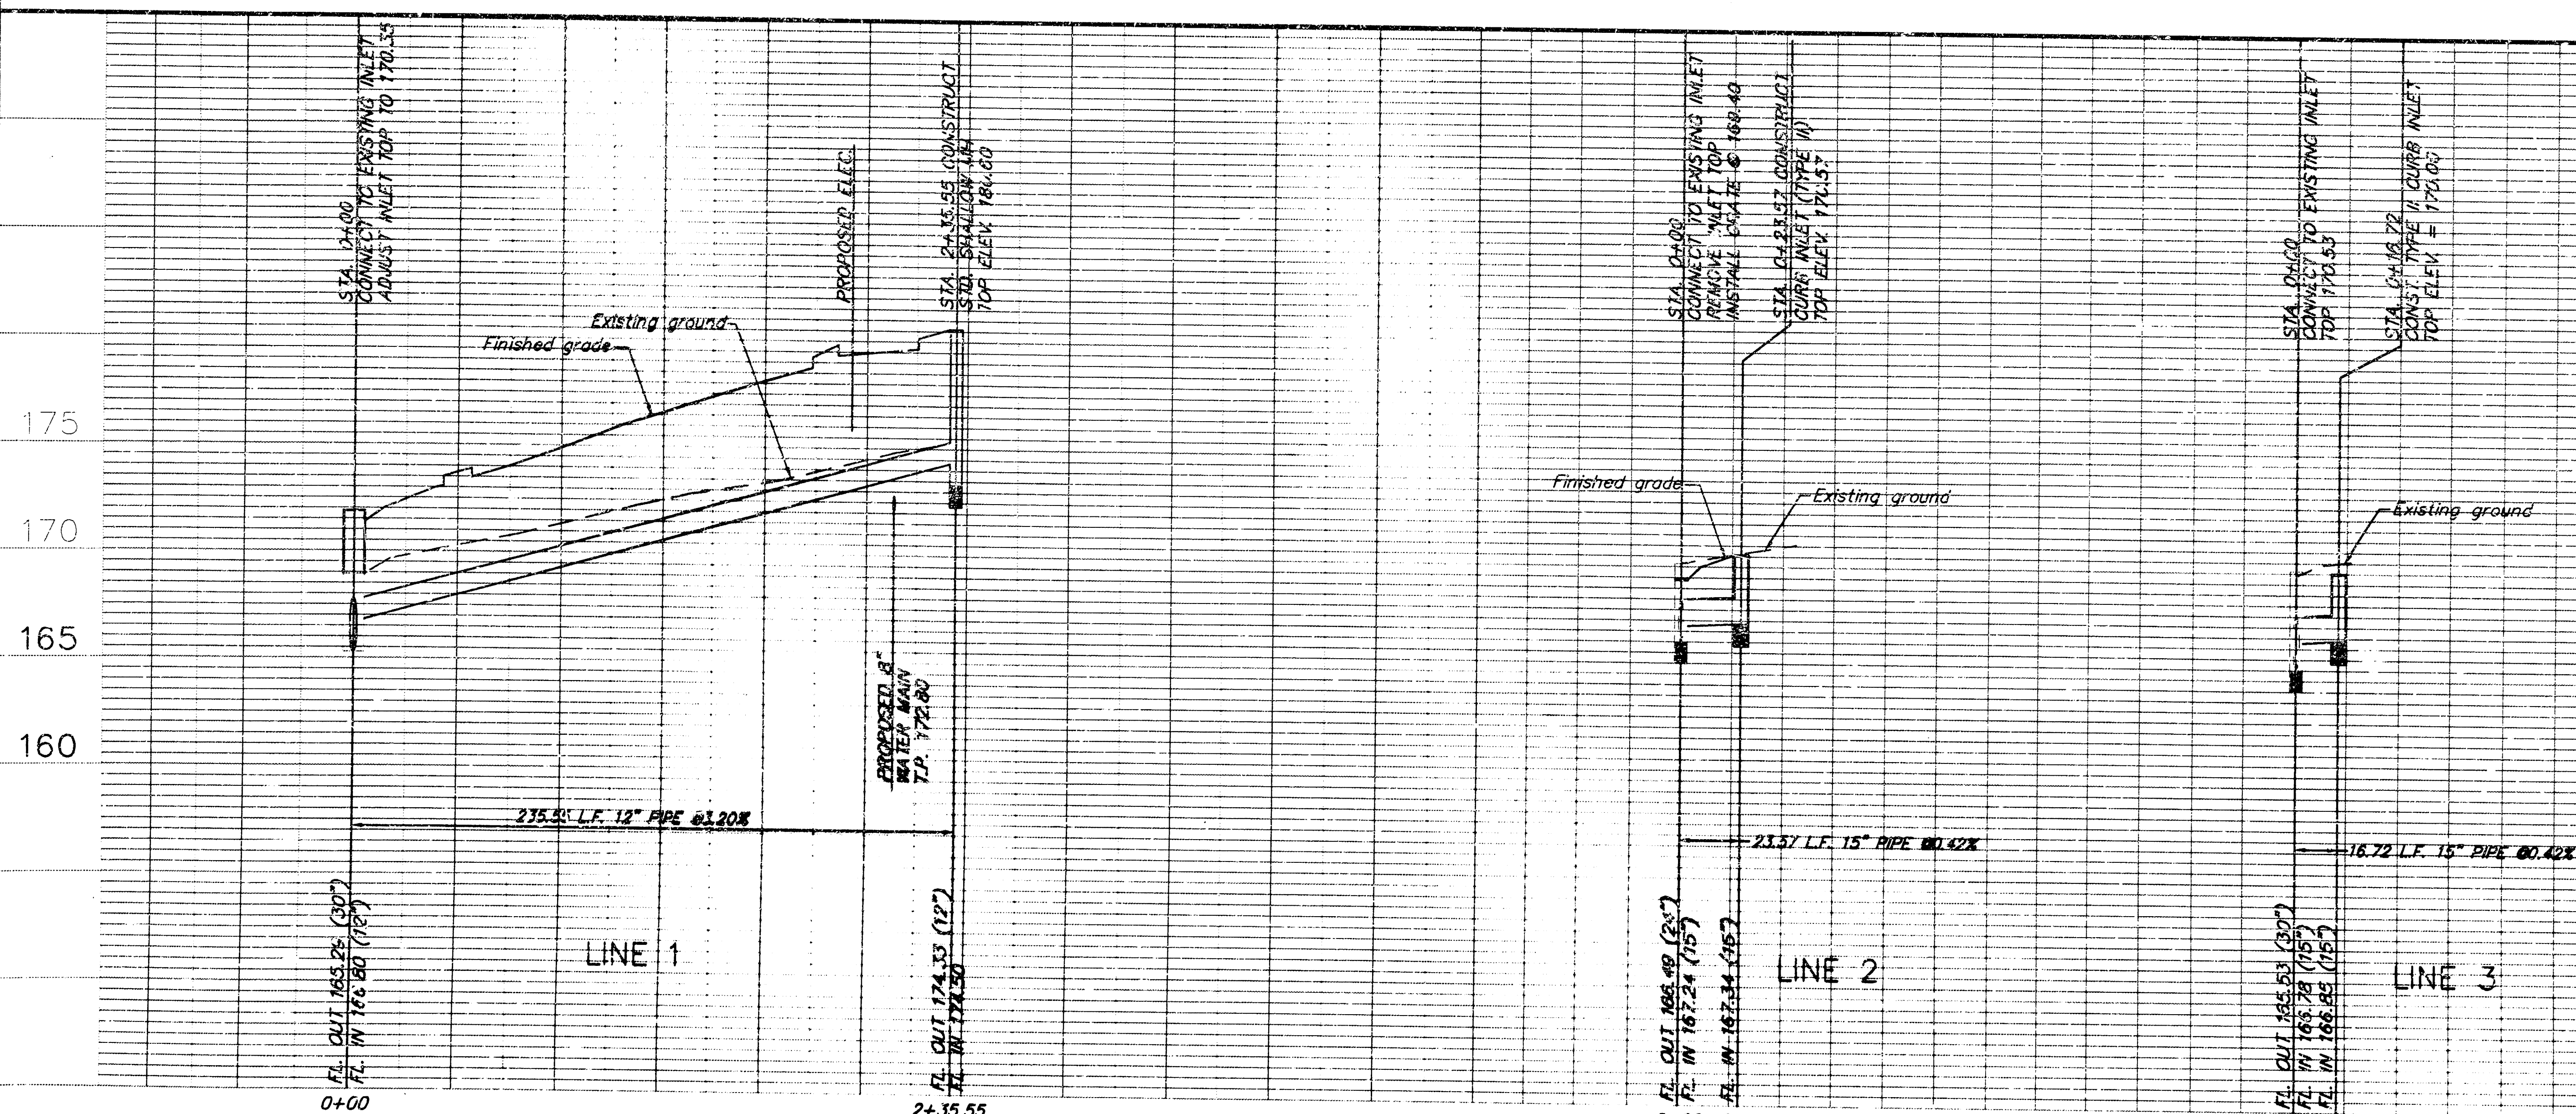



As-Built Information
Contractor: R. D. Carter (Gary Ladd)
Inspector: Tim Kelly (Mike Shum)
Asst. Firm: Savoy, Ruggles & Bohm
Start Const: 06/15/2000
End Const: 07/19/2001
TV'd: 07/19/2001 (Passed)
Material: 236 Lb. 12\"/>

Booked
E-8
12/30/03
R.D.

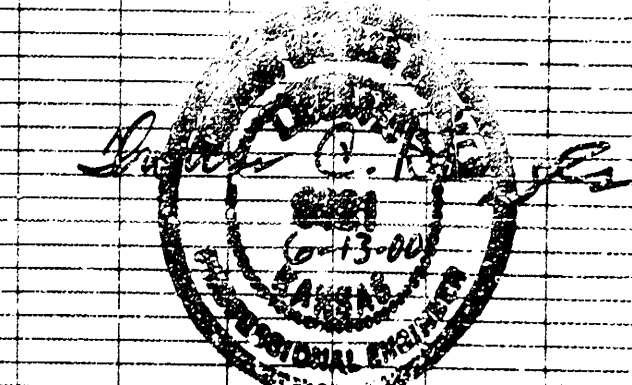


AS-BUILTS (Built per plan)
08/14/2001

TOWNE EAST SQUARE PRIVATE STORM SEWER LOT 1, KELLOGG MALL ADDITION, WICHITA, KS.	
SRB	318-264-8008 WICHITA, KANSAS 67203 FAX 264-4621 http://www.towne-east.com E-Mail: srbs@towne-east.com
SAVOY, RUGGLES & BOHM, P.A. ENGINEERING & SURVEYING	
PROJECT NUMBER 1014 PPS (607861)	
DESIGN TCR	DRAWN JTS
CHECKED SRB	REVIEWED MD
DATE Aug 24, 2000	REVISED 12/2000
SHEET SG2	
3	

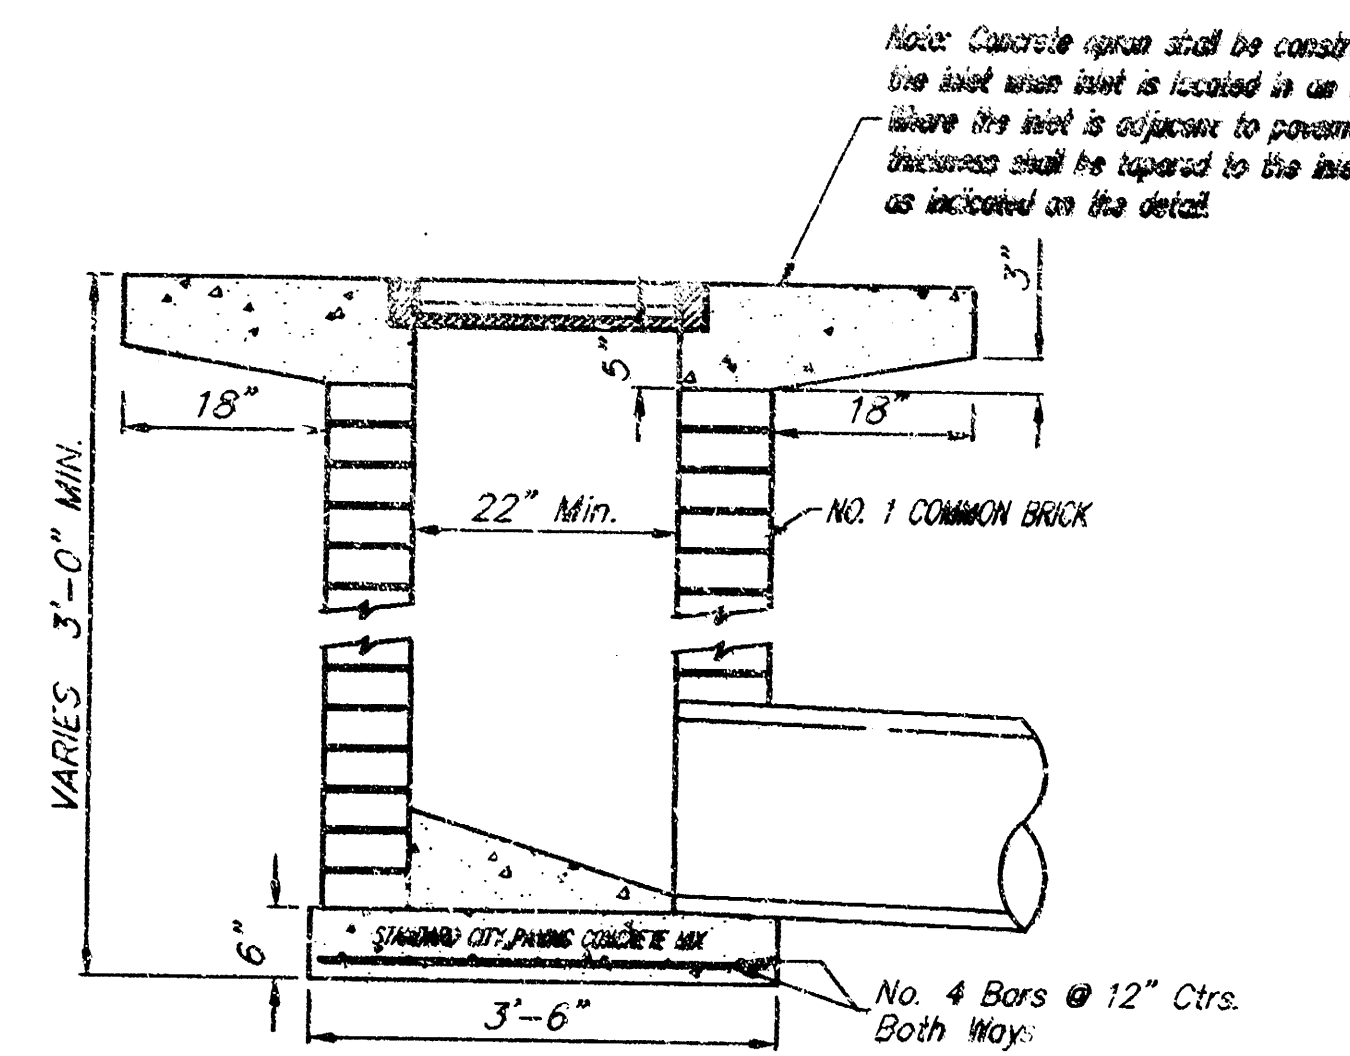
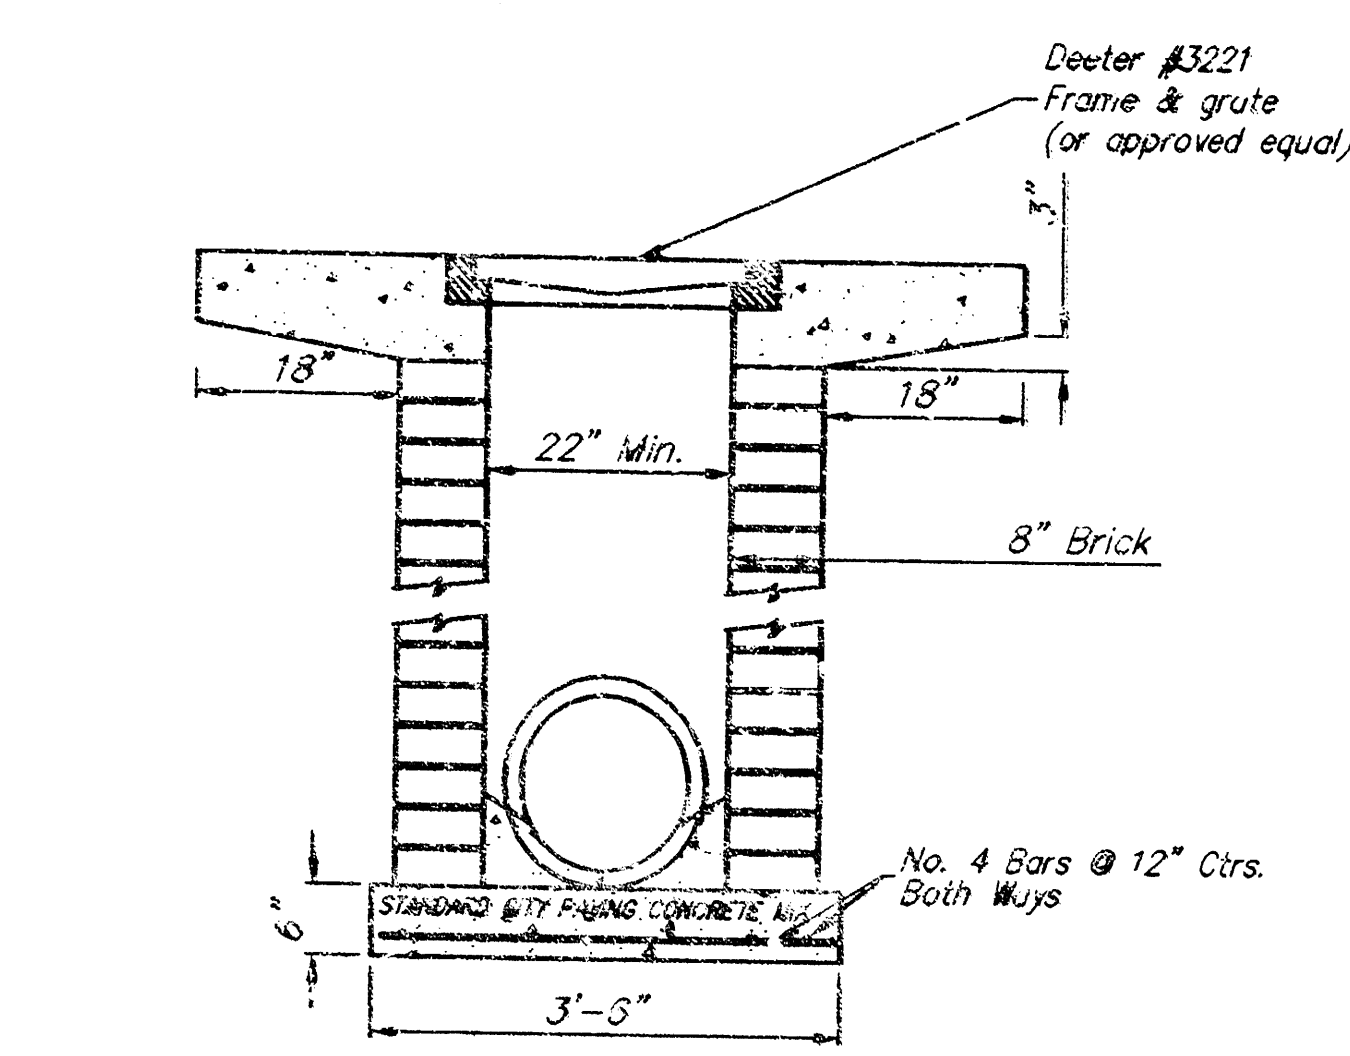


DROP INLET DETAILS


BENCHMARK:
"D" CUT ON THE S. SIDE OF
CONCRETE LIGHT POLE BASE.
B.L. STA. 13+33.70, 178.82' LT.;
ELEV. 173.76

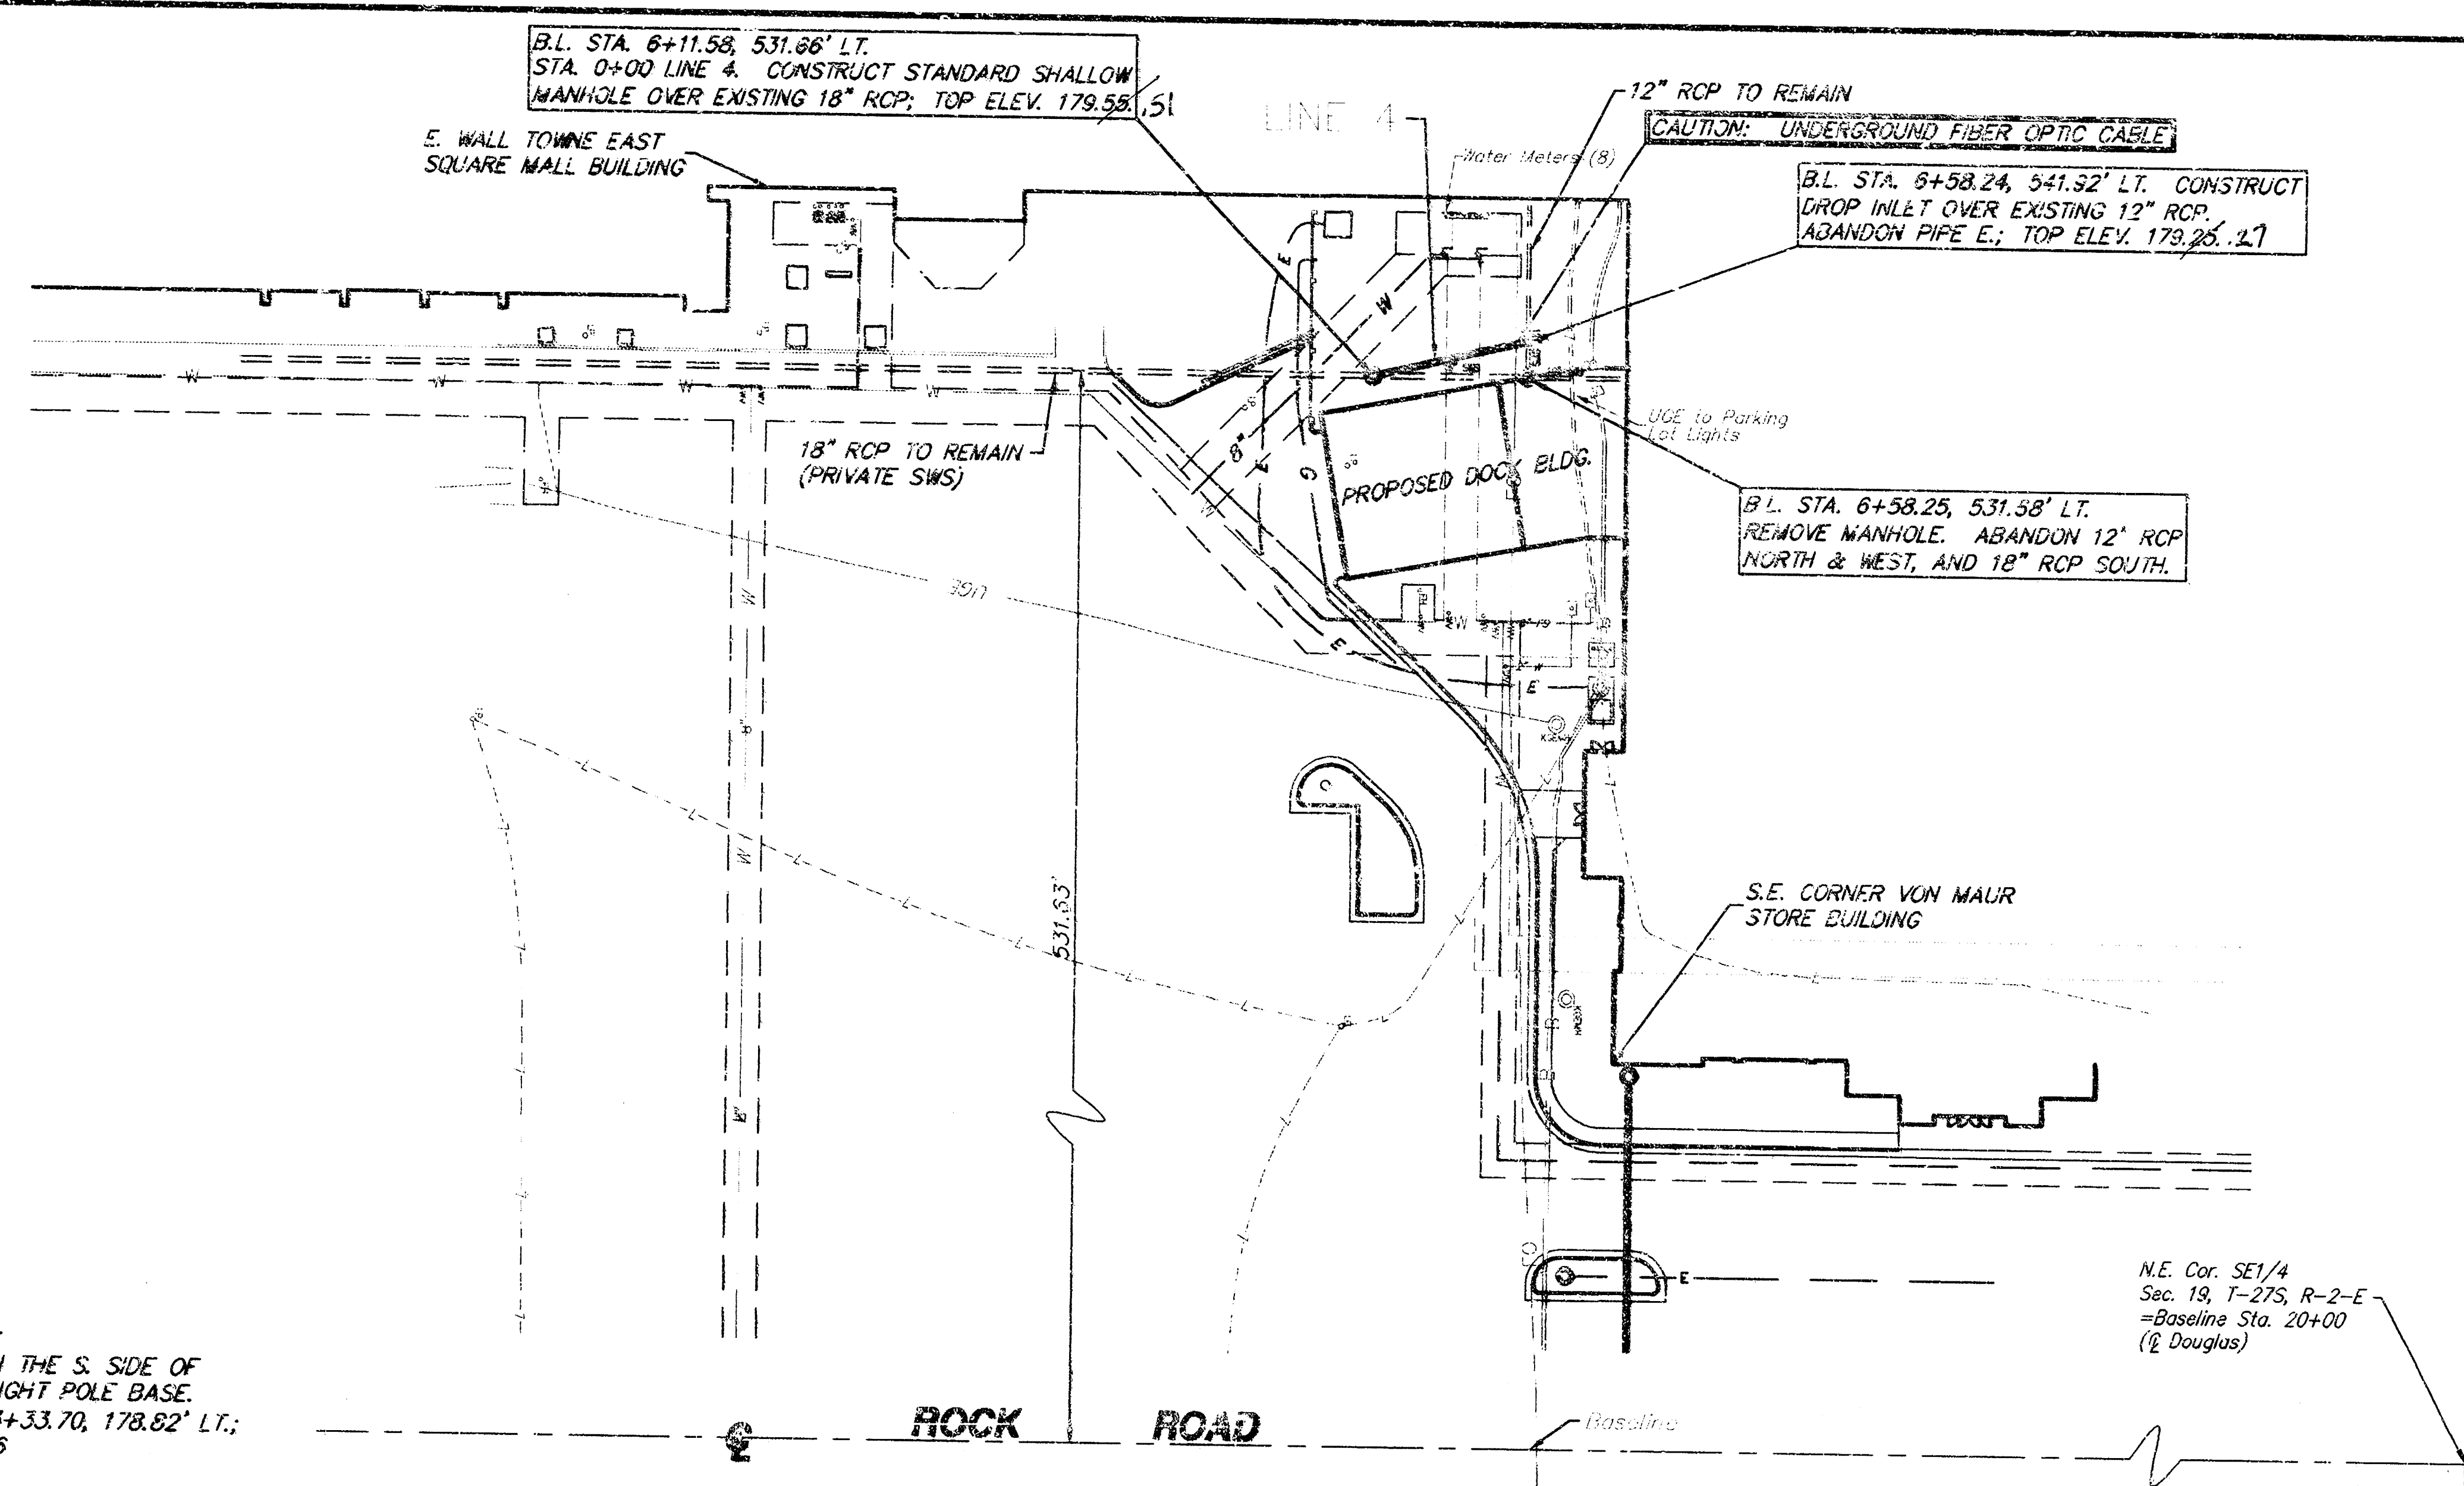


SRB
SCALE
1" = 40' Horiz. (Plan)
1" = 5' Vert. (Profile)

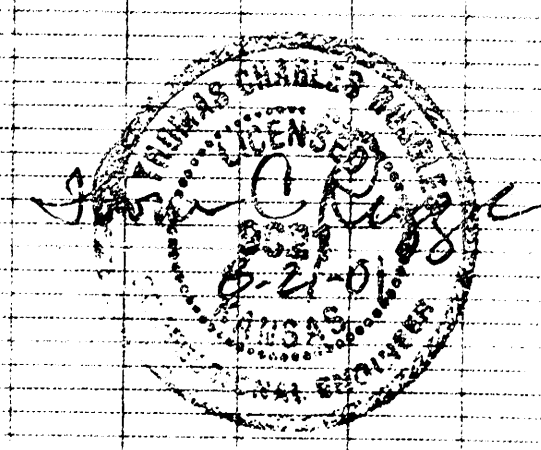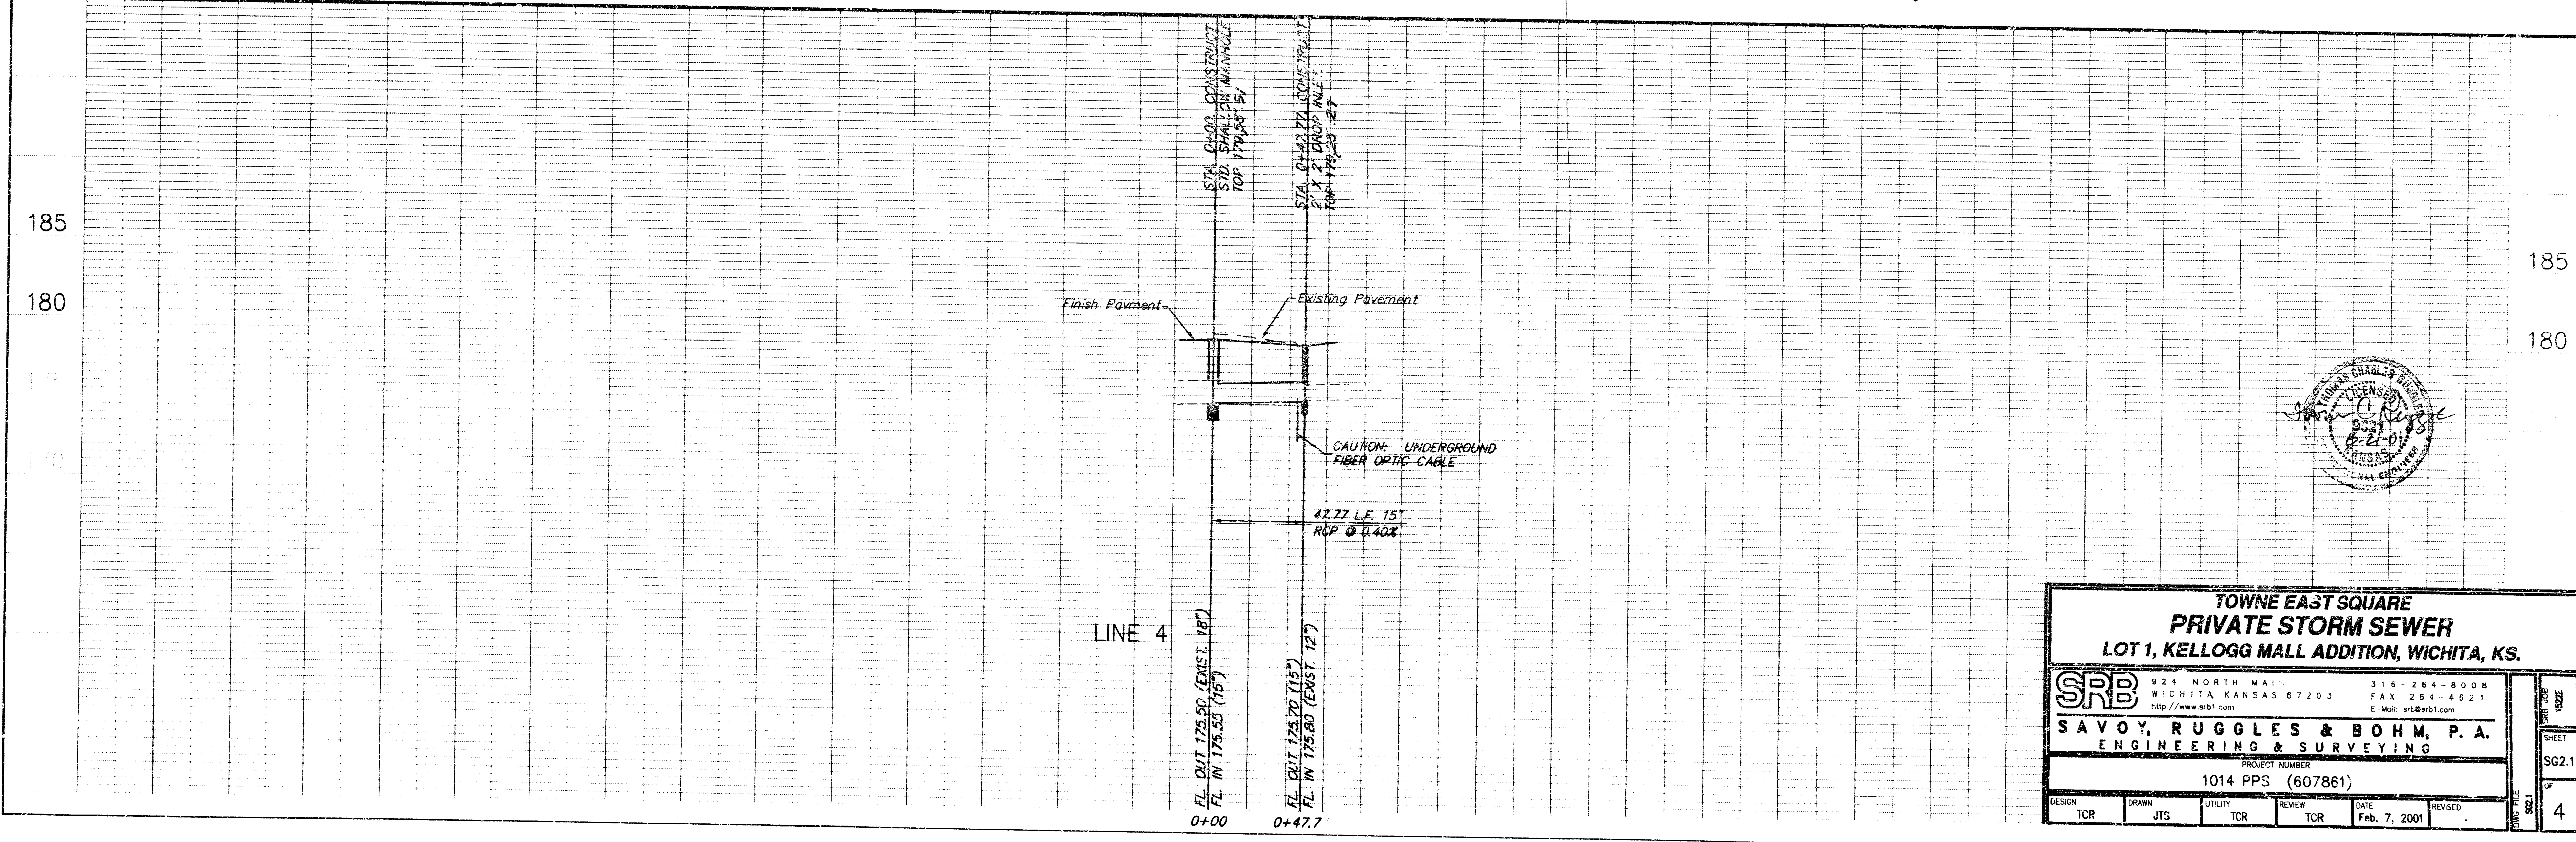


TOWNE EAST SQUARE PRIVATE STORM SEWER LOT 1, KELLOGG MALL ADDITION, WICHITA, KS.			
SRB		924 NORTH MAIN WICHITA, KANSAS 67203 http://www.srb1.com	
SAVOY, RUGGLES & BOHM, P.A. ENGINEERING & SURVEYING		316-284-8008 FAX 264-4621 E-Mail: srl@srb1.com	
PROJECT NUMBER 1014 PPS (607861)			
DESIGN TCR	DRAWN JTS	UTILITY TCR	REVIEW TCR
DATE Feb. 7, 2001		REVISED	
SHEET SG2.1		OF 4	

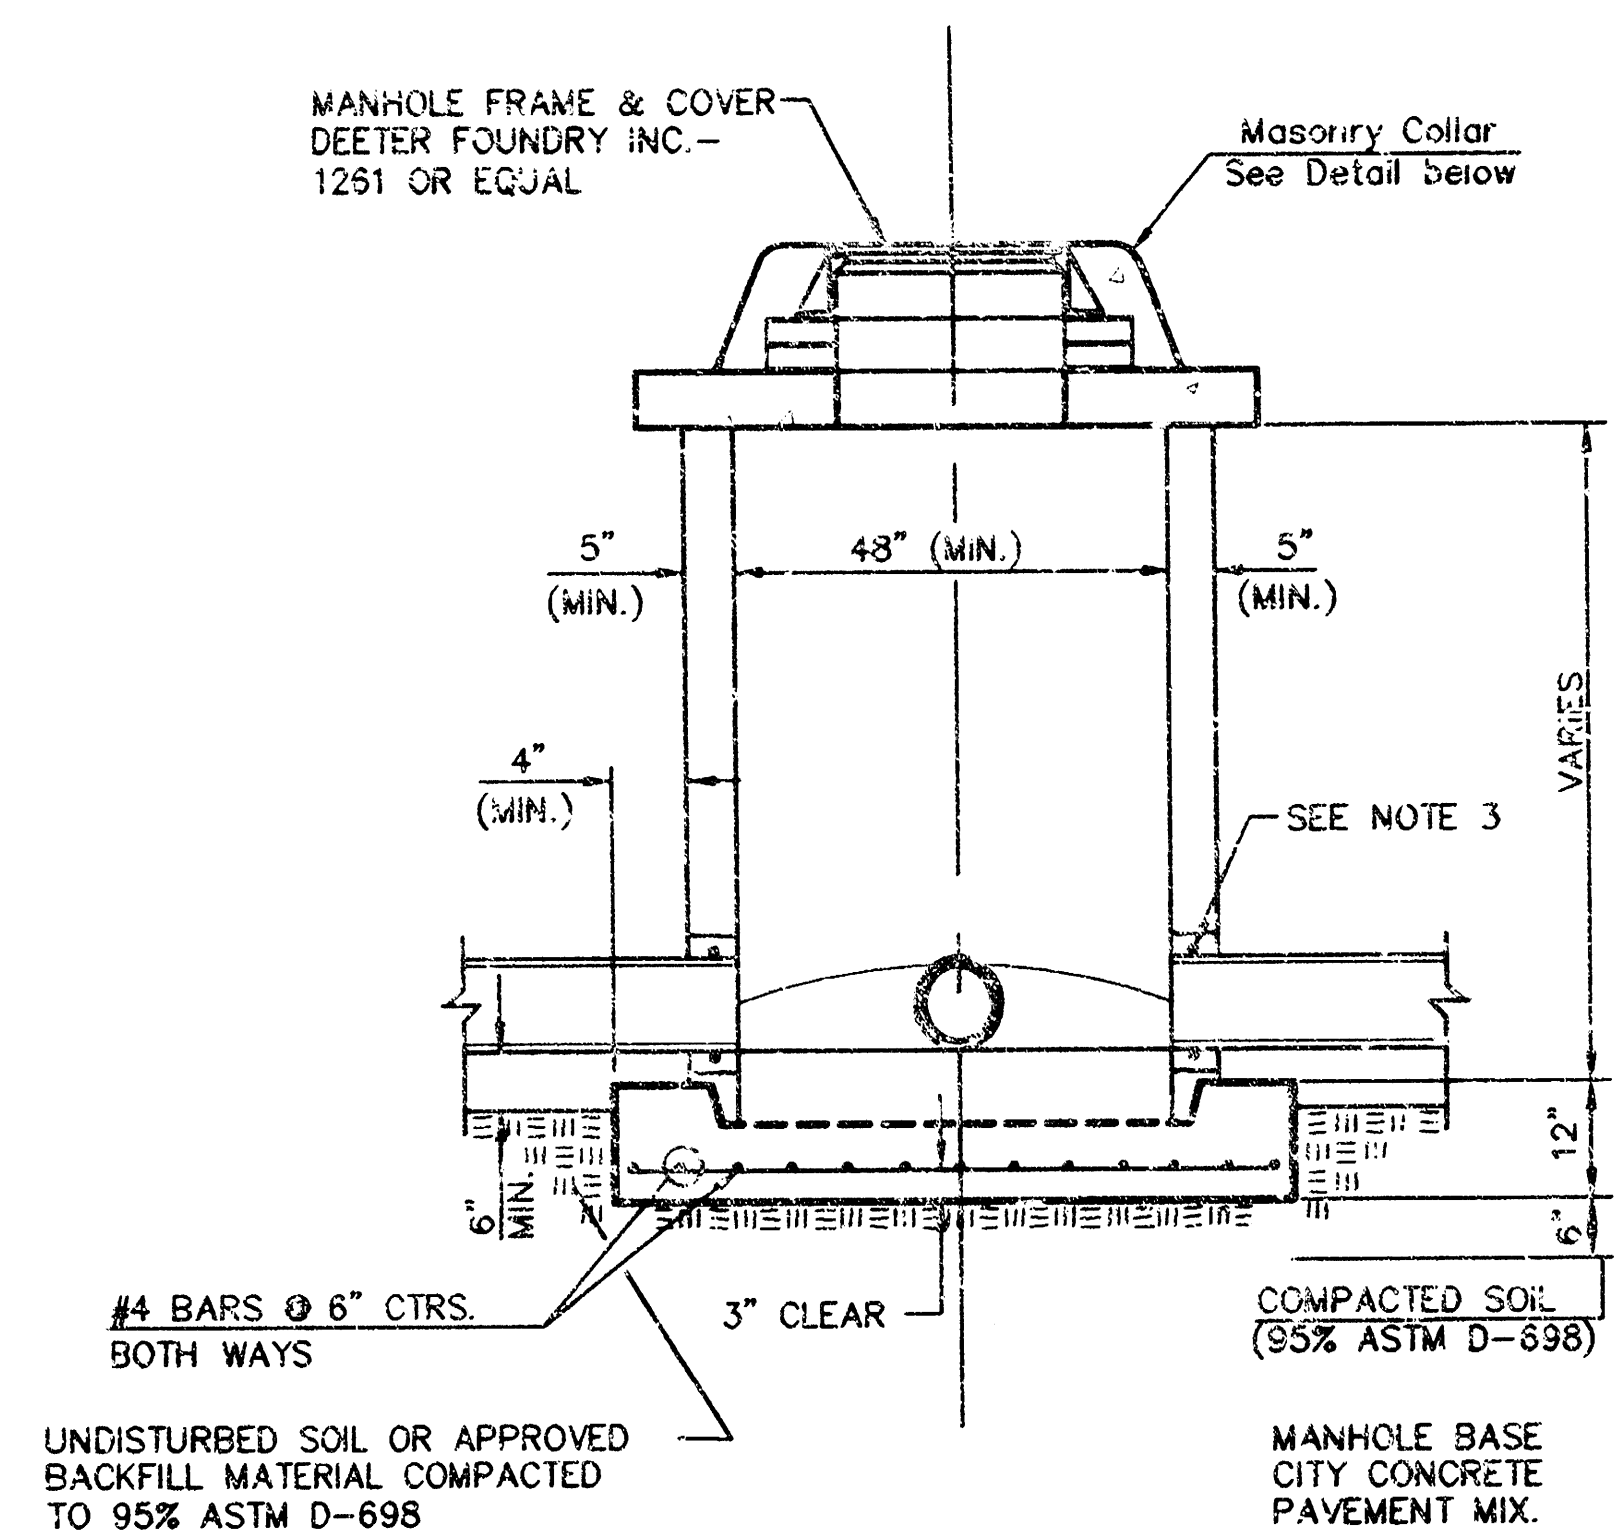

SHALLOW TYPE "P" MANHOLE

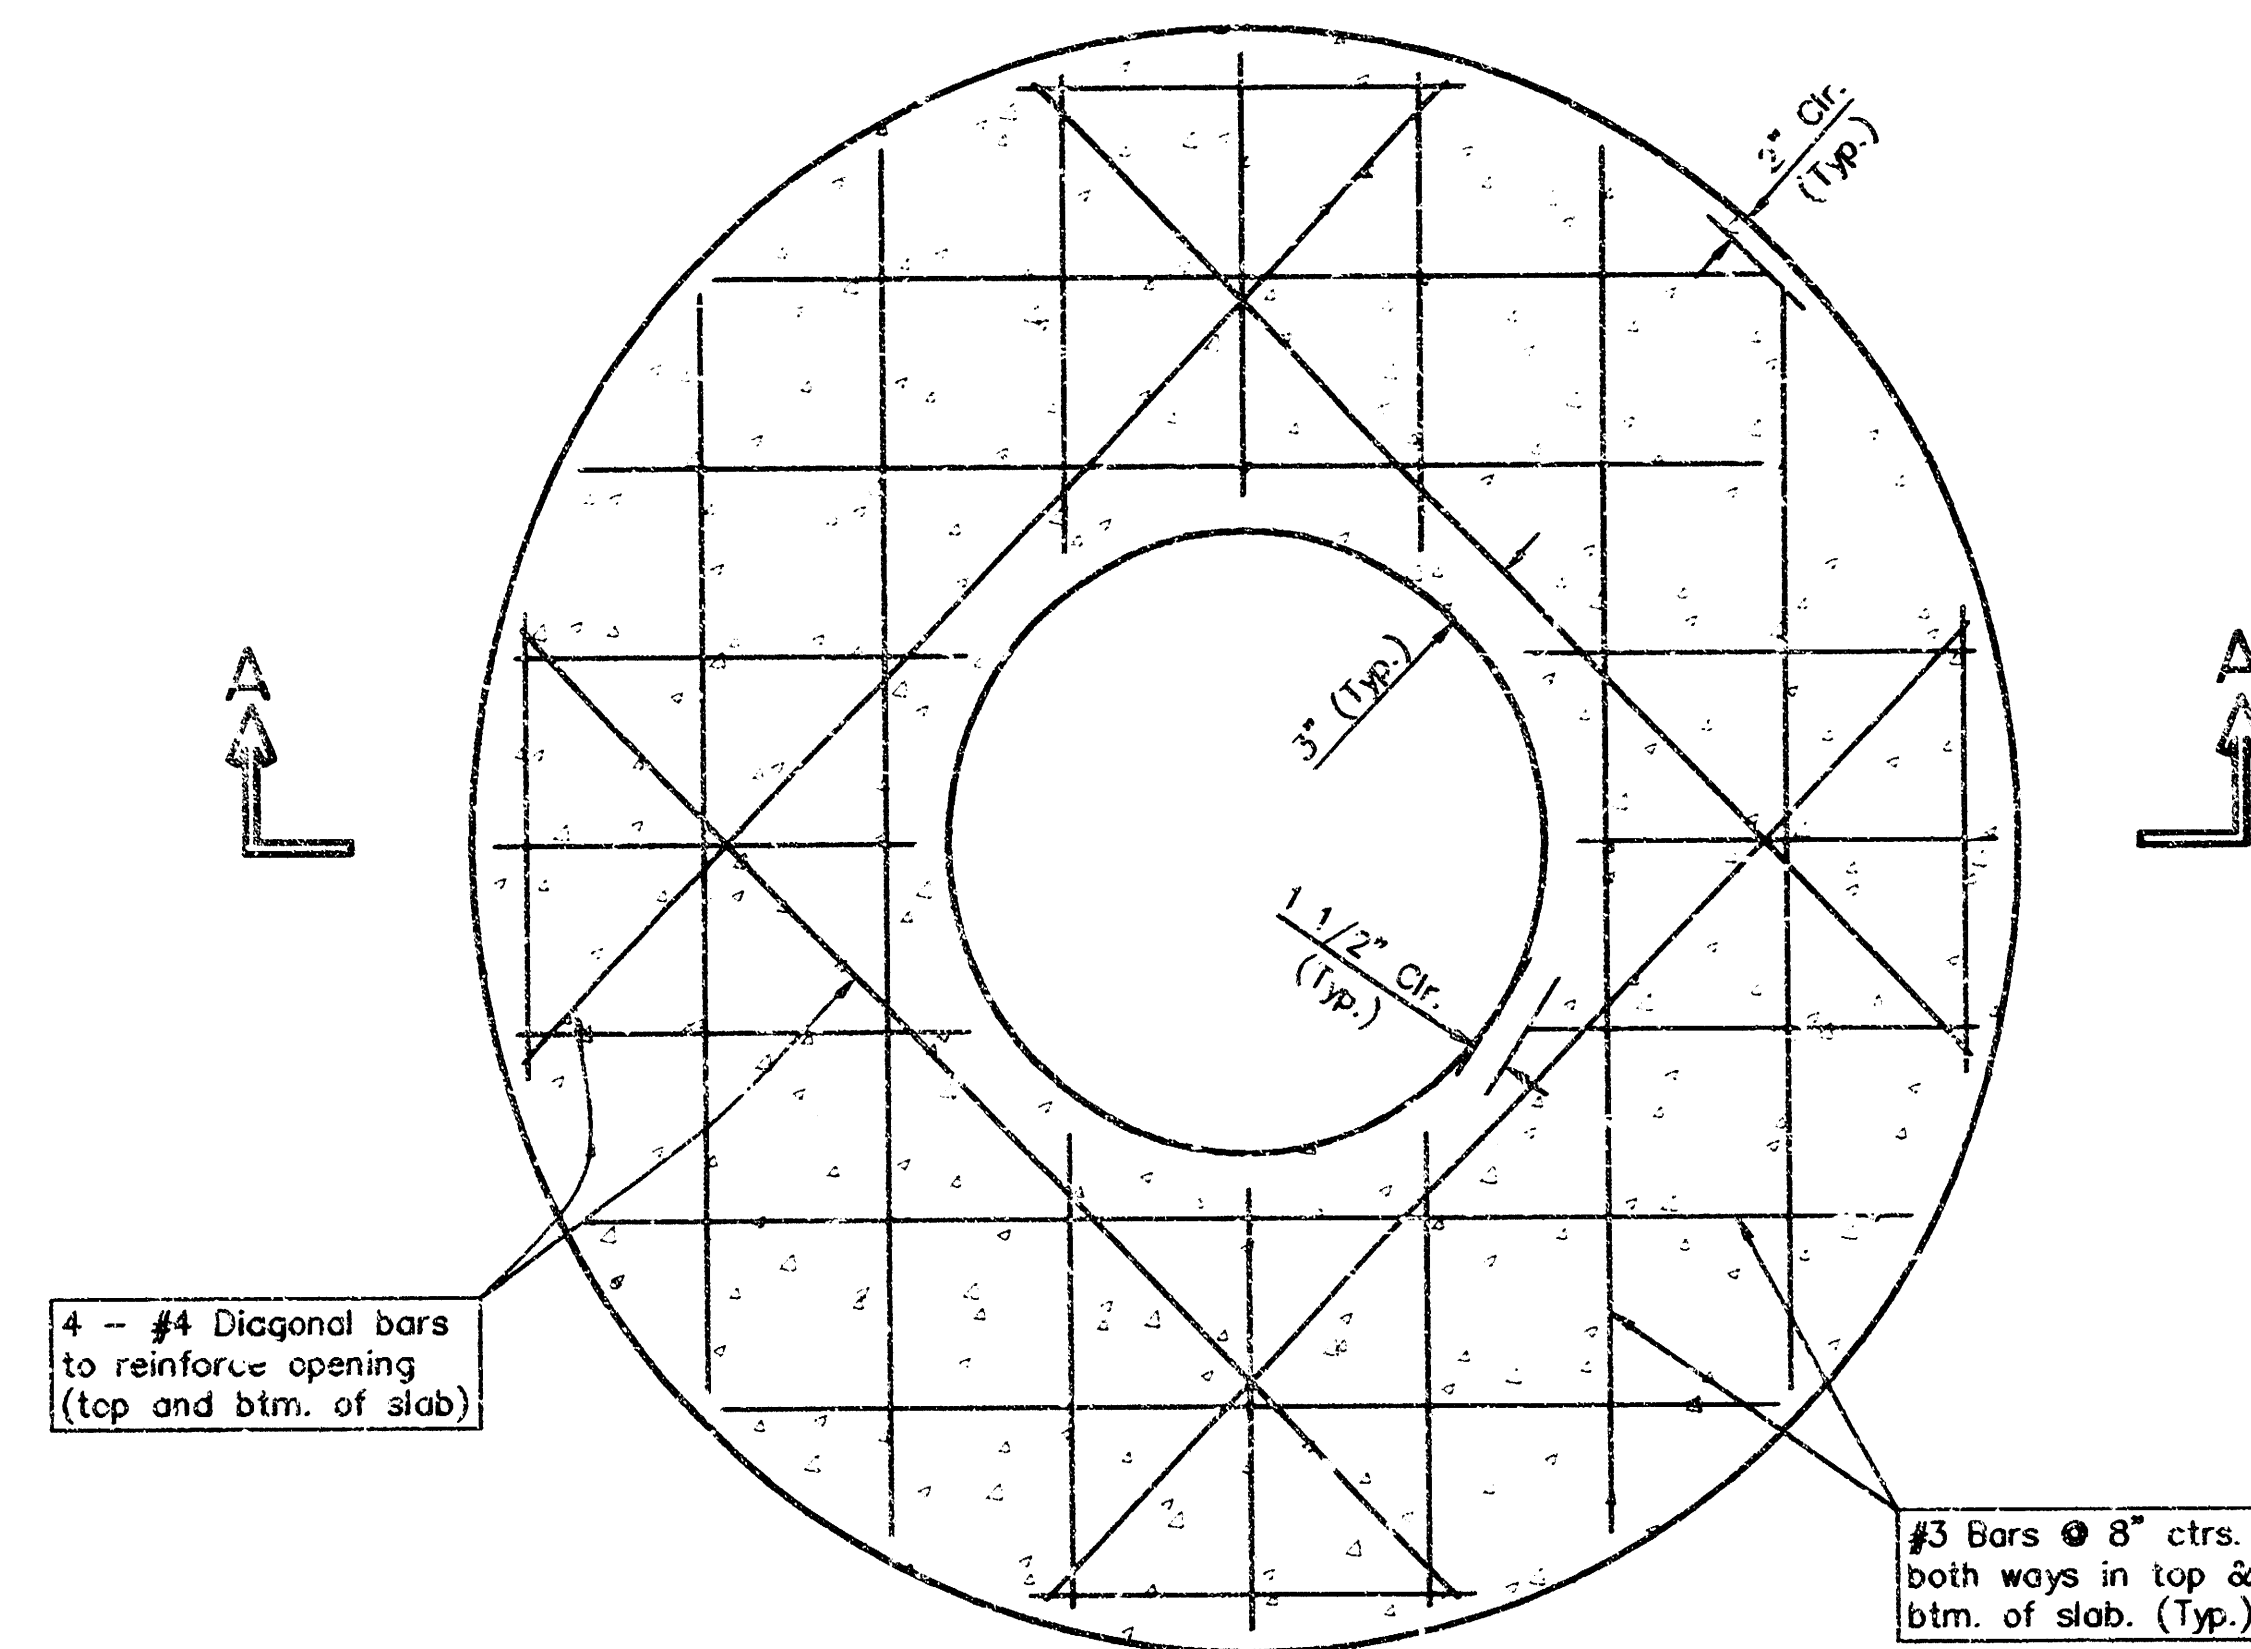


PLAN

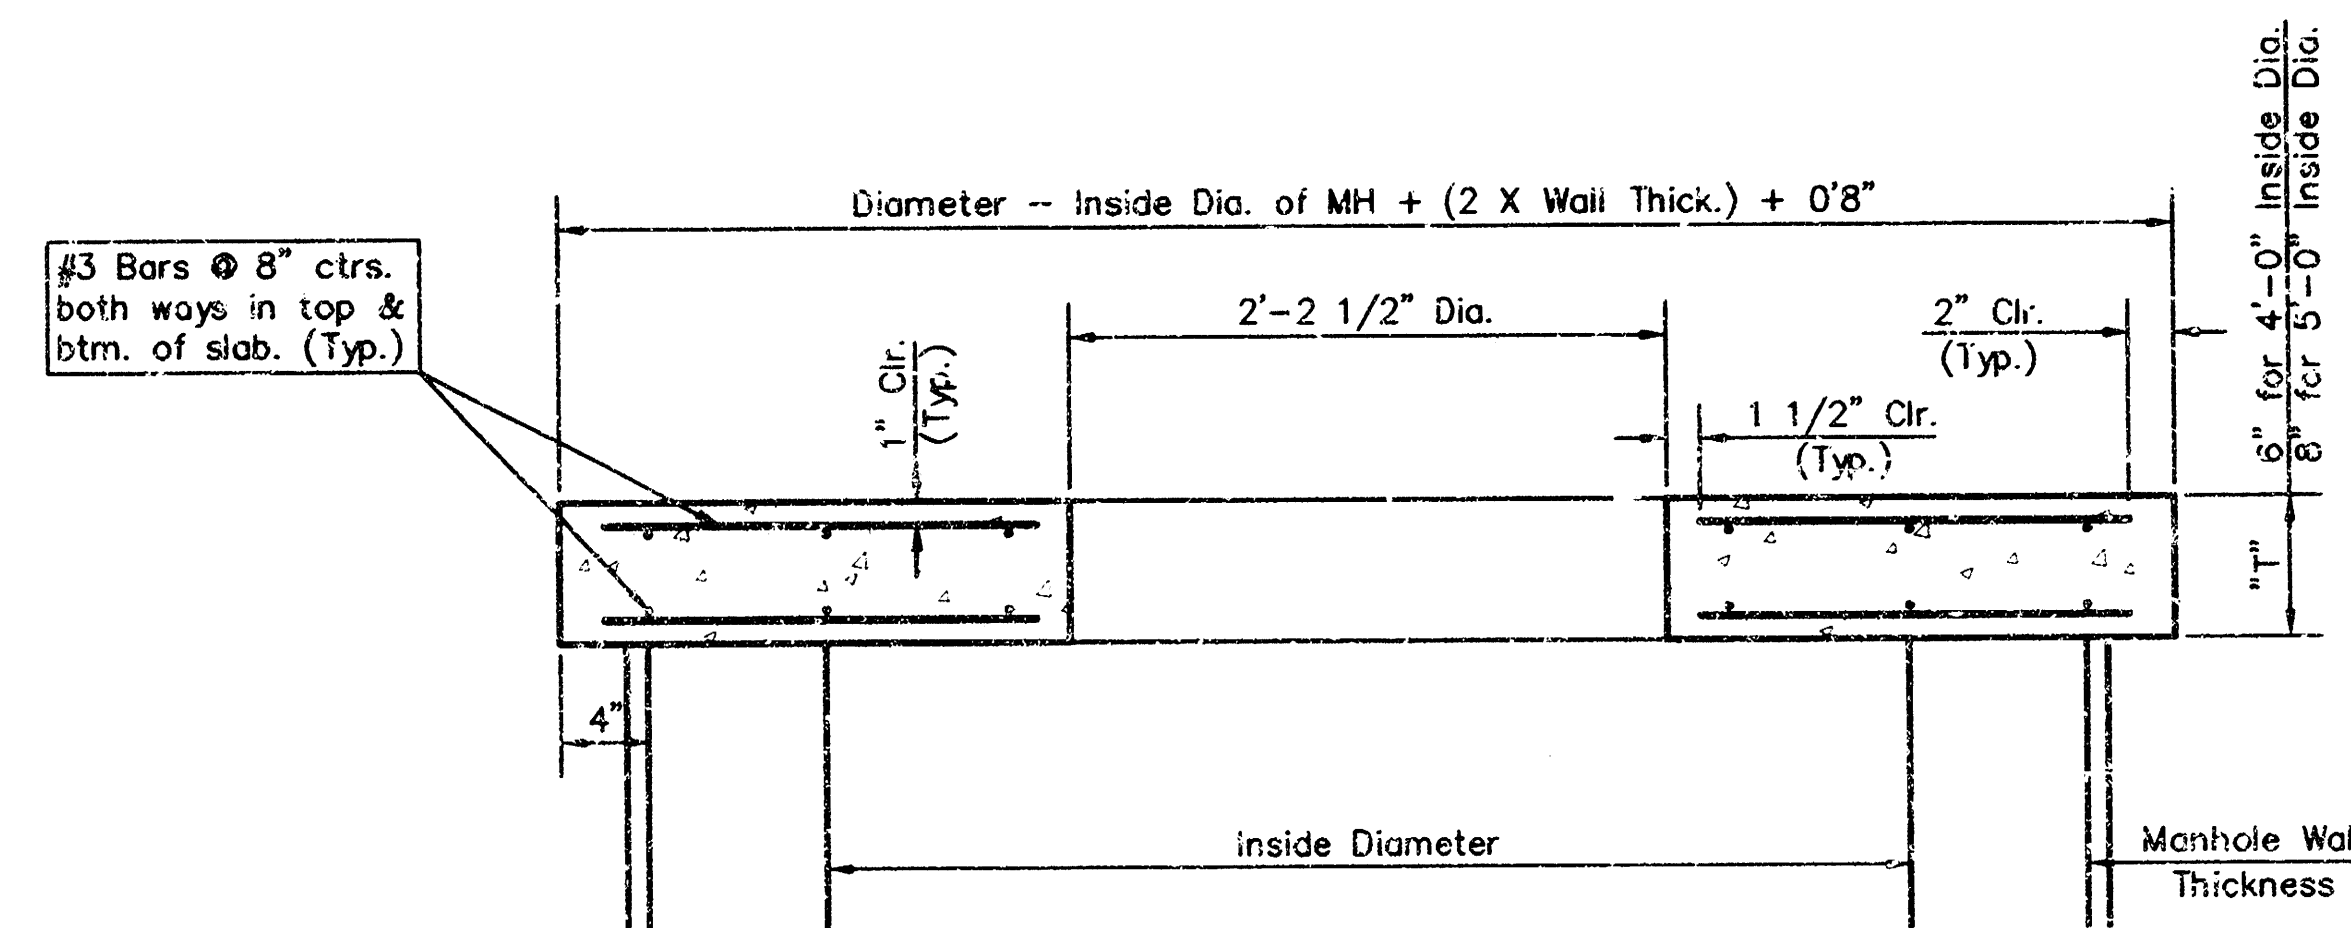


SECTION A-A

CONCRETE SLAB DETAILS

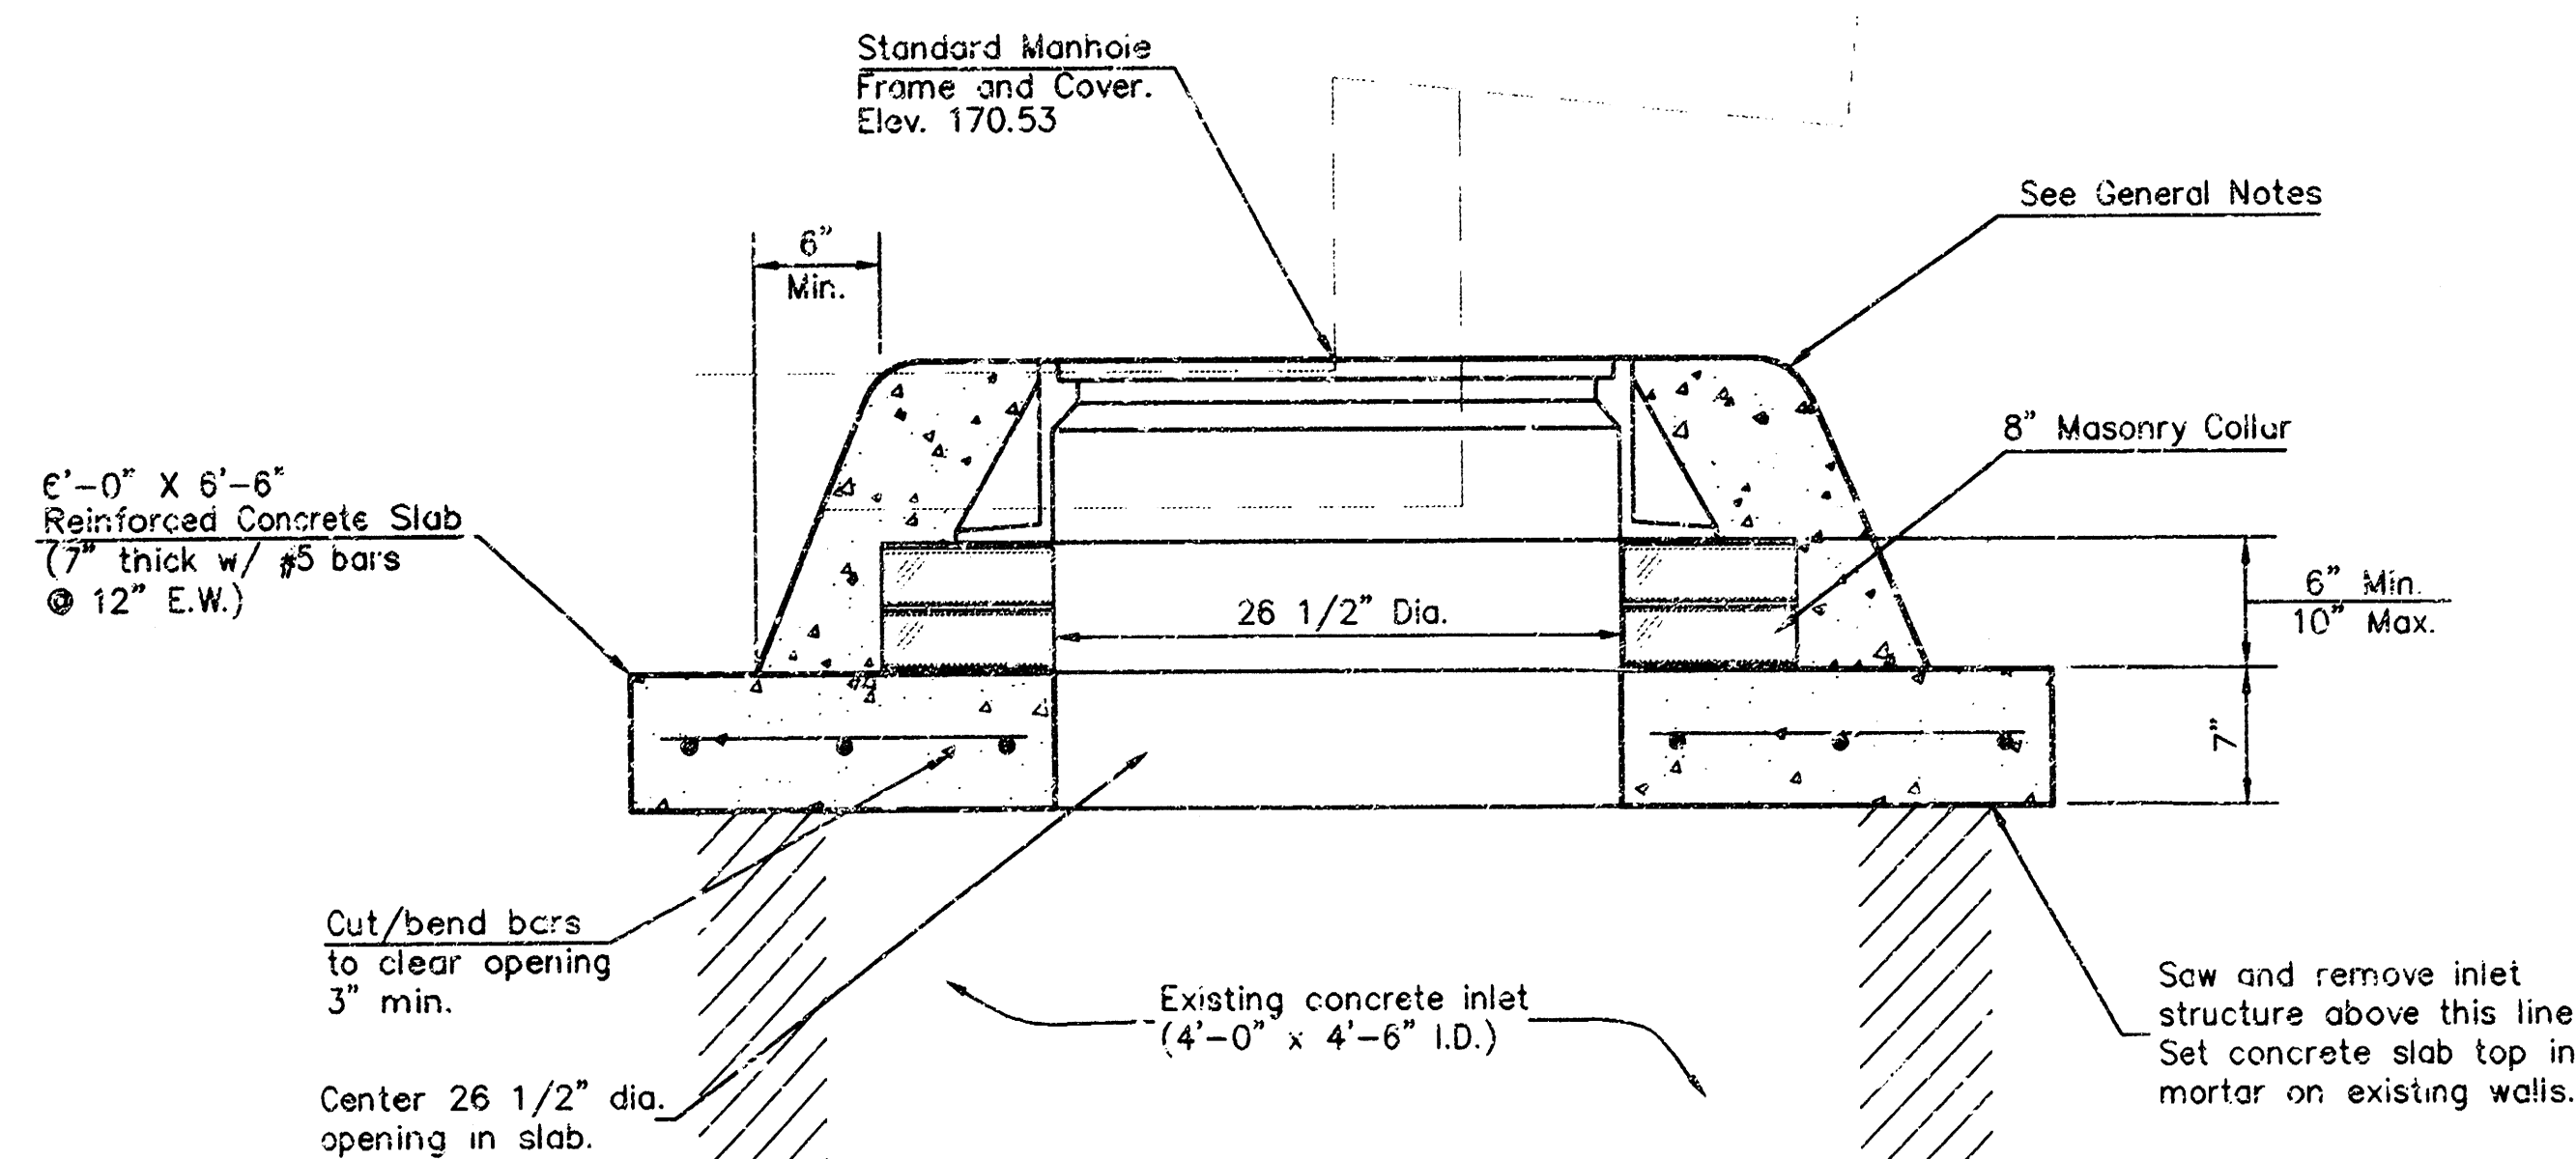

INLET TO MANHOLE CONVERSION DETAIL

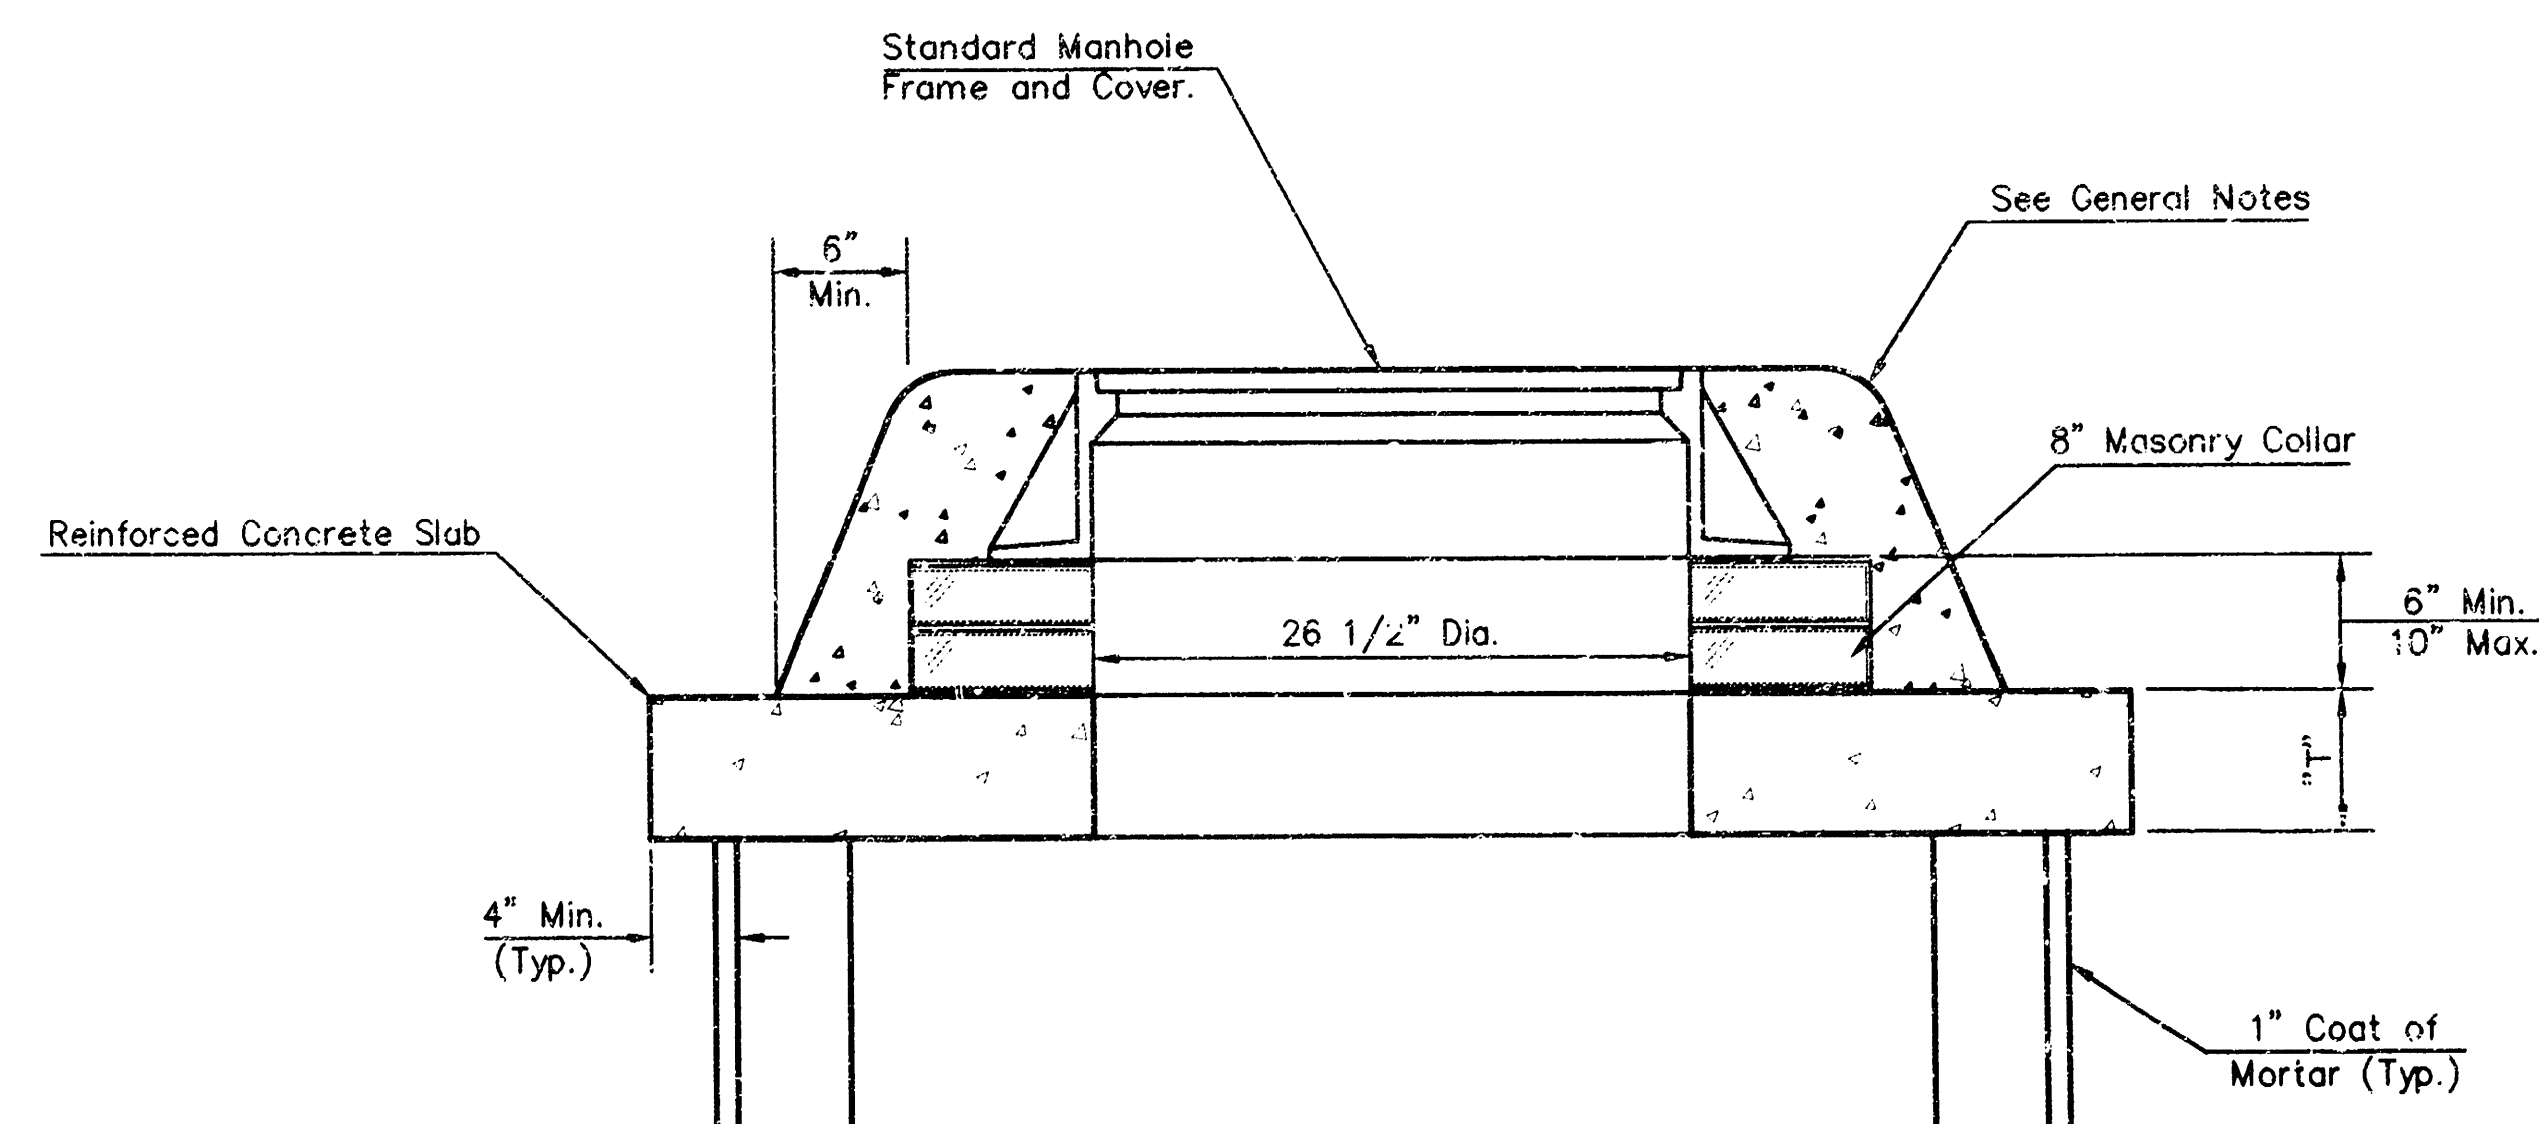


MASONRY COLLAR DETAIL

GENERAL NOTES


1. ALL PRECAST CONCRETE MANHOLE SECTIONS SHALL CONFORM TO THE LATEST REVISIONS OF A.S.T.M. C478 AS MODIFIED BY THE SPECIFICATIONS.
2. NON-SHRINK GROUT SHALL BE NON-METALLIC TYPE.
3. APPROVED FLEXIBLE WATERSTOP GASKETS SHALL BE INSTALLED TO JOIN THE SEWER TO THE MANHOLE WALL WHEN A.S.S. COMPOSITE PIPE OR P.V.C. PIPE IS USED. FOR OTHER TYPES OF PIPE THE SEWER SHALL BE GRADED IN PLACE WITH NON-SHRINK GROUT. THE SEWER PIPE SHALL BE SUPPORTED WITH CONCRETE ENCASEMENT A MINIMUM OF 3 FEET FROM THE MANHOLE WALL AND TO THE FIRST JOINT FOR V.C.P. SUCH THAT THE JOINT REMAINS FLEXIBLE.
4. ALL INSIDE SURFACES OF THE CONCRETE MANHOLE WHICH WOULD BE EXPOSED TO SEWER GAS SHALL BE COATED WITH 2 COATS OF MECC SERIES 66 HI-BUILD EPOXY, DRY THICKNESS OF 8 MILS (MIN.)
5. EXTERIOR MANHOLE WALLS SHALL BE COATED WITH 1 COAT OF MECC 633 BITUMINOUS COATING.
6. JOINT SEALING COMPOUND SHALL BE KENT SEAL NO. 2 OR APPROVED EQUAL.
7. PRECAST MANHOLES SHALL BE SET AT LEAST 4 INCHES INTO THE MANHOLE BASE.
8. TOP OF MANHOLE FLOOR SLAB SHALL BE AT LEAST 3 INCHES BELOW THE FLOW LINE OF THE OUTLET PIPE TO INSURE SUFFICIENT MINIMUM THICKNESS OF SHAPED INVERT.
9. LIFTING HOLES SHALL BE FILLED WITH NON-SHRINK GROUT AND THE INTERIOR SURFACE COATED AS SPECIFIED.
10. MORTAR USED IN MASONRY CONSTRUCTION SHALL CONTAIN 3 BAGS OF CEMENT PER CUBIC YARD. CONCRETE USED IN MANHOLE BASES SHALL CONFORM TO THE REQUIREMENTS OF CONCRETE FOR CONCRETE PAVEMENT CONSTRUCTION AS SPECIFIED IN THE CITY STANDARD PAVING SPECIFICATIONS USING CITY CONCRETE PAVEMENT MIX WITHOUT AIR ENTRAINING ADMIXTURE. MORTAR SHALL BE PLACED AROUND THE MANHOLE RING AS SHOWN ON THE DRAWINGS WHEN MANHOLES ARE CONSTRUCTED IN UNPAVED AREAS. MANHOLES CONSTRUCTED WHERE PIPE SIZES ARE SMALLER THAN 24" SHALL HAVE AN INSIDE DIAMETER OF 4". MANHOLES CONSTRUCTED WHERE PIPE SIZES ARE 24" OR LARGER SHALL HAVE AN INSIDE DIAMETER OF 5". COMPLETED MANHOLE SHALL BE WITHOUT LEAKS AND WATER TIGHT.
11. REINFORCING STEEL SHALL BE INSTALLED IN THE MANHOLE BASES AND SHALL CONSIST OF NO. 4 BARS PLACED @ 6" CENTERS IN BOTH DIRECTIONS. THE MANHOLE BASE REINFORCEMENT SHALL BE PLACED AT LEAST 3" ABOVE THE BOTTOM OF THE MANHOLE BASE. ALL COSTS FOR FURNISHING AND INSTALLING REINFORCING STEEL SHALL BE INCLUDED IN THE UNIT PRICE BID FOR THE MANHOLE.
12. THE FLOORS OF ALL MANHOLES SHALL BE SHAPED WITH FLOW CHANNELS SUCH THAT THE MANHOLES WILL BE SELF CLEANING AND FREE OF AREAS WHERE SOLIDS COULD BE DEPOSITED AS SEWAGE FLOWS THROUGH THE MANHOLE FROM ALL INLET PIPES TO THE OUTLET PIPE. FLOW CHANNELS SHALL BE FORMED TO MATCH THE BOTTOM HALVES OF THE INFLOWING PIPES AND THE OUTFLOWING PIPE AS SHOWN BY THE DRAWINGS EXCEPT FOR INSIDE DROP MANHOLES. FLOW CHANNELS FOR INSIDE DROP MANHOLES SHALL BE CONSTRUCTED AS INDICATED BY THE DRAWING. MANHOLE FLOORS SHALL HAVE SLOPES OF 3 INCHES PER FOOT IN THE AREAS OUTSIDE OF THE FLOW CHANNELS SLOPED TOWARD THE FLOW CHANNELS. PIPES LAID THROUGH MANHOLES SHALL HAVE THE TOP HALF REMOVED TO NEAT LINES FOR THE FULL INSIDE DIAMETER OF THE MANHOLE. MANHOLE FLOORS SHALL THEN BE SHAPED AROUND THE BOTTOM HALF OF THE PIPE WHICH FORMS THE FLOW CHANNEL.
13. PIPES INSTALLED WITHIN THE EXCAVATION MADE FOR THE MANHOLE SHALL BE CRADLED WITH CONCRETE TO THE LIMITS OF THE MANHOLE EXCAVATION. WHEN CLAY PIPE IS USED, THE CRADLE SHALL EXTEND TO THE FIRST JOINT OUTSIDE THE MANHOLE. THE CRADLE SHALL BE TERMINATED AT THE CLAY PIPE JOINT IN A MANNER WHICH WILL MAINTAIN THE FLEXIBILITY OF THE JOINT. COST OF CRADLE WITHIN MANHOLE EXCAVATION OR TO CLAY PIPE JOINTS ADJACENT TO MANHOLE SHALL BE INCLUDED IN THE UNIT PRICE BID FOR THE MANHOLE.
14. MANHOLE COVER CASTINGS AND MANHOLE FRAME CASTINGS SHALL CONFORM TO THE REQUIREMENTS INDICATED IN THE STANDARD SPECIFICATIONS AND AS SHOWN IN THE STANDARD DETAIL DRAWING.
15. ALL BRICK USED IN MANHOLE CONSTRUCTION SHALL MEET GRADE SW OF ASTM C652 OR C82-87.

As-Built (Built per plan) 08/14/2011


INLET TO MANHOLE CONVERSION AND SHALLOW TYPE 'P' MANHOLE DETAILS		WICHITA, KANSAS	
SRB 924 NORTH MAIN WICHITA, KANSAS 67203 http://www.srb1.com		316-264-8000 FAX 264-4621 E-mail: srb@srb1.com	
SAVOY, RUGGLES & BOHM, P.A. ENGINEERING & SURVEYING			
PROJECT NUMBER 1014 PPS (607861)			
DESIGN	DRAWN	UTILITY	REVIEW
			DATE
			REVISED
			3

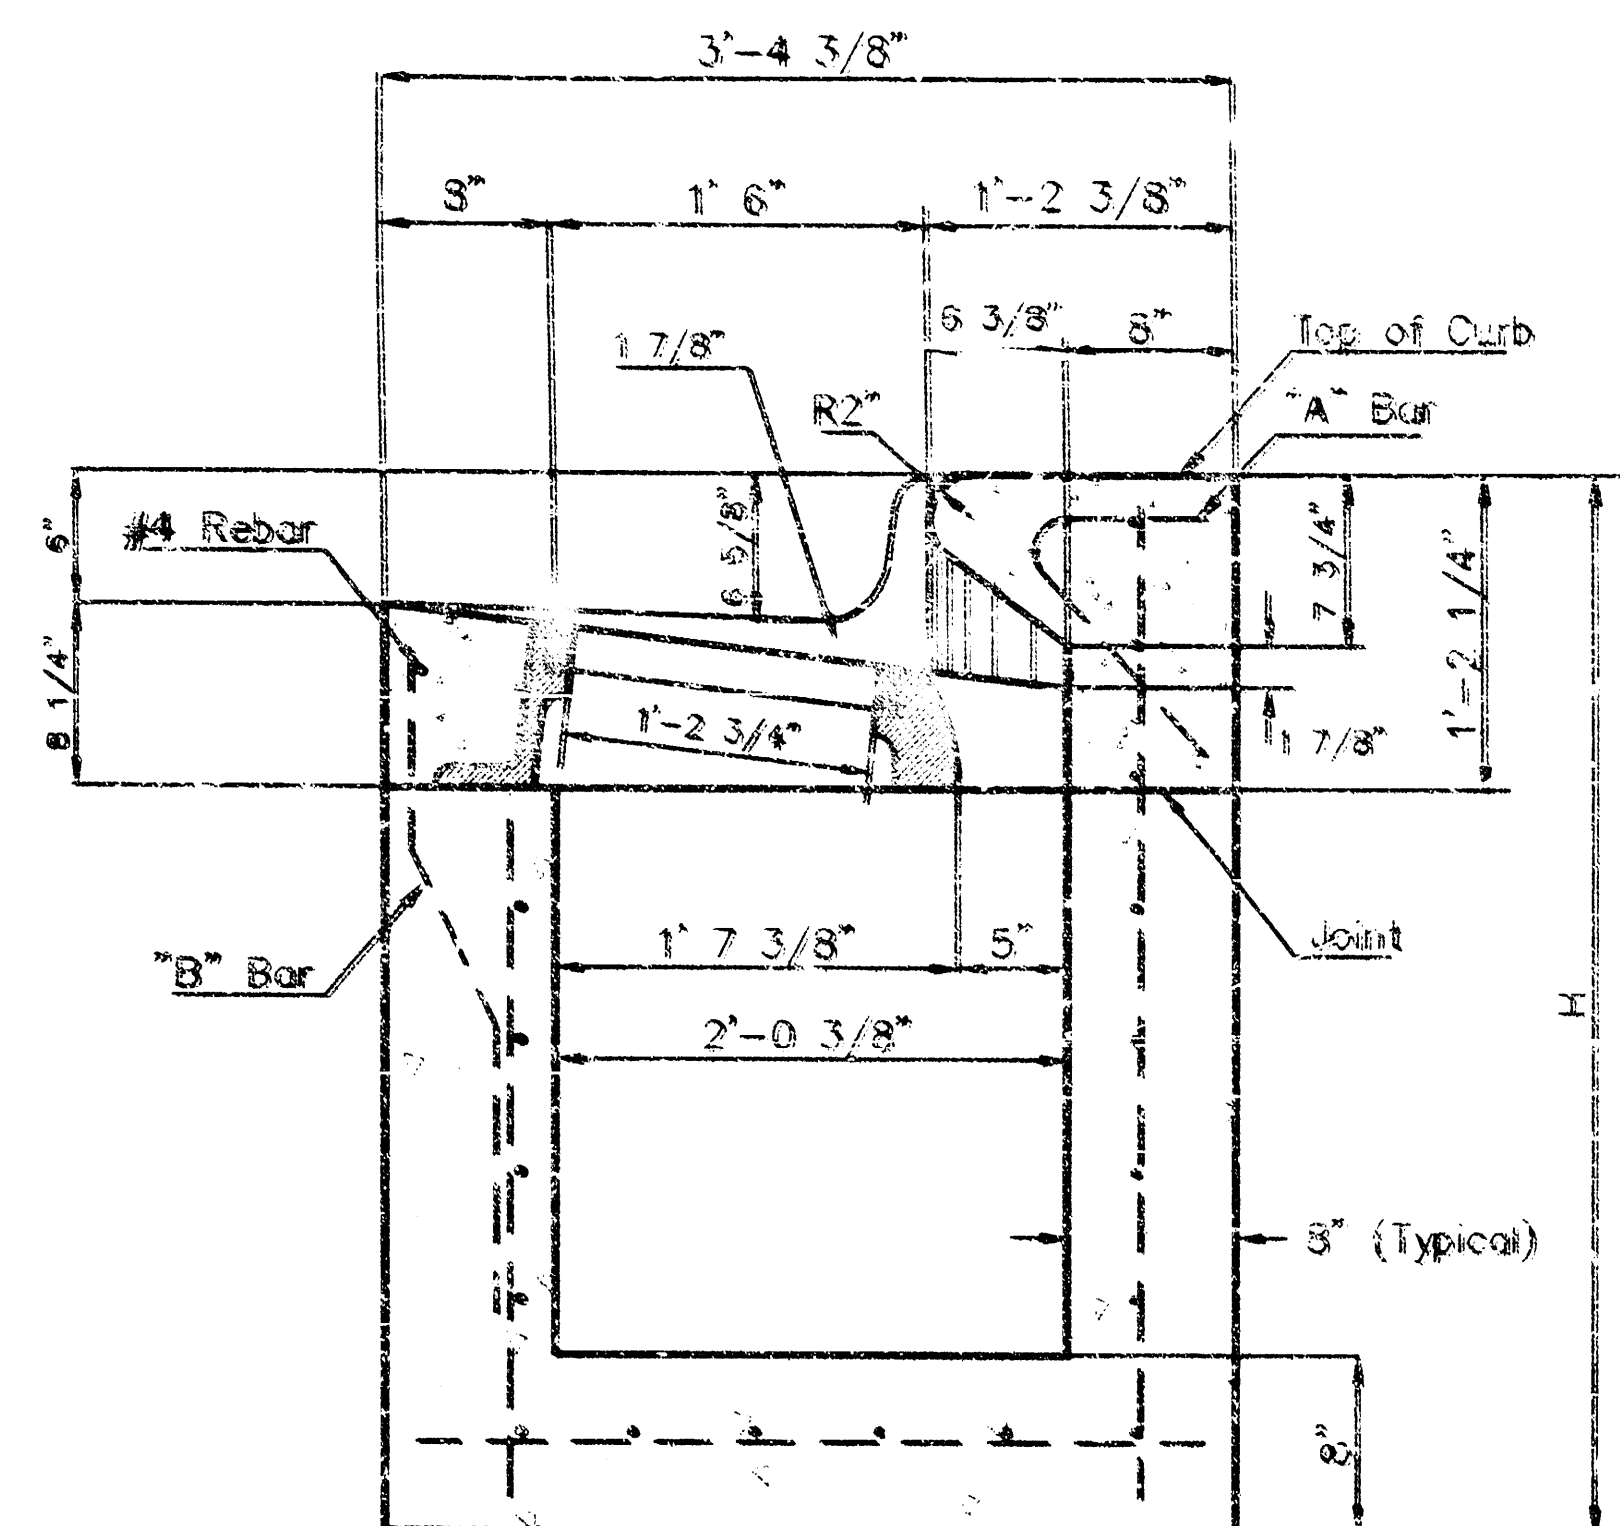


SECTION A-A

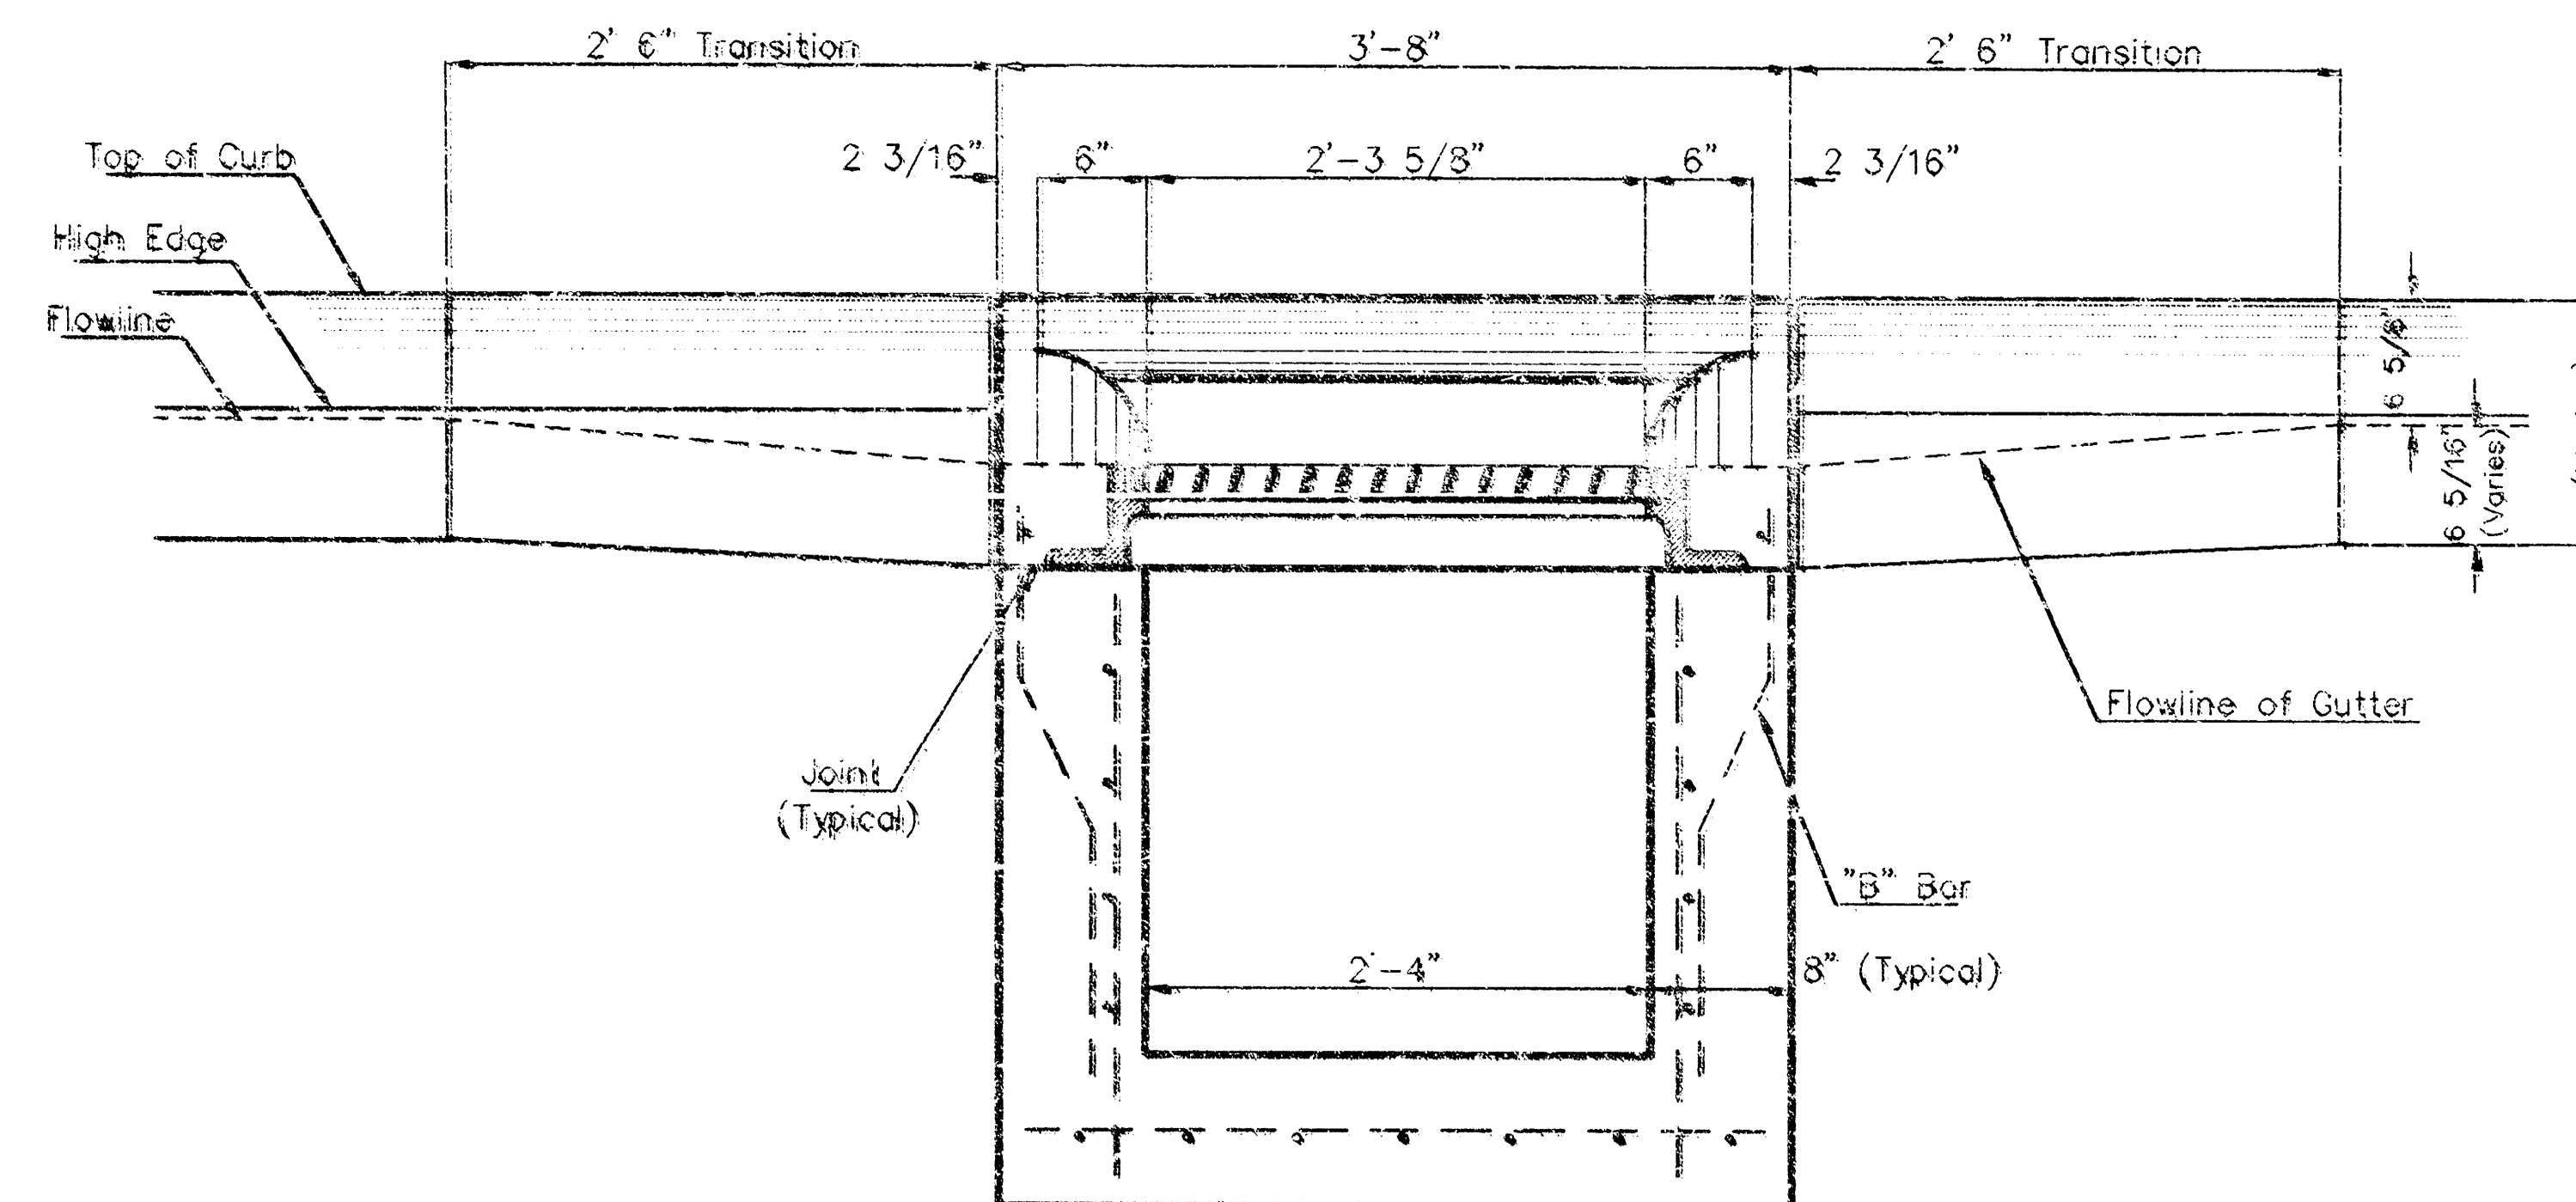



SECTION C-C

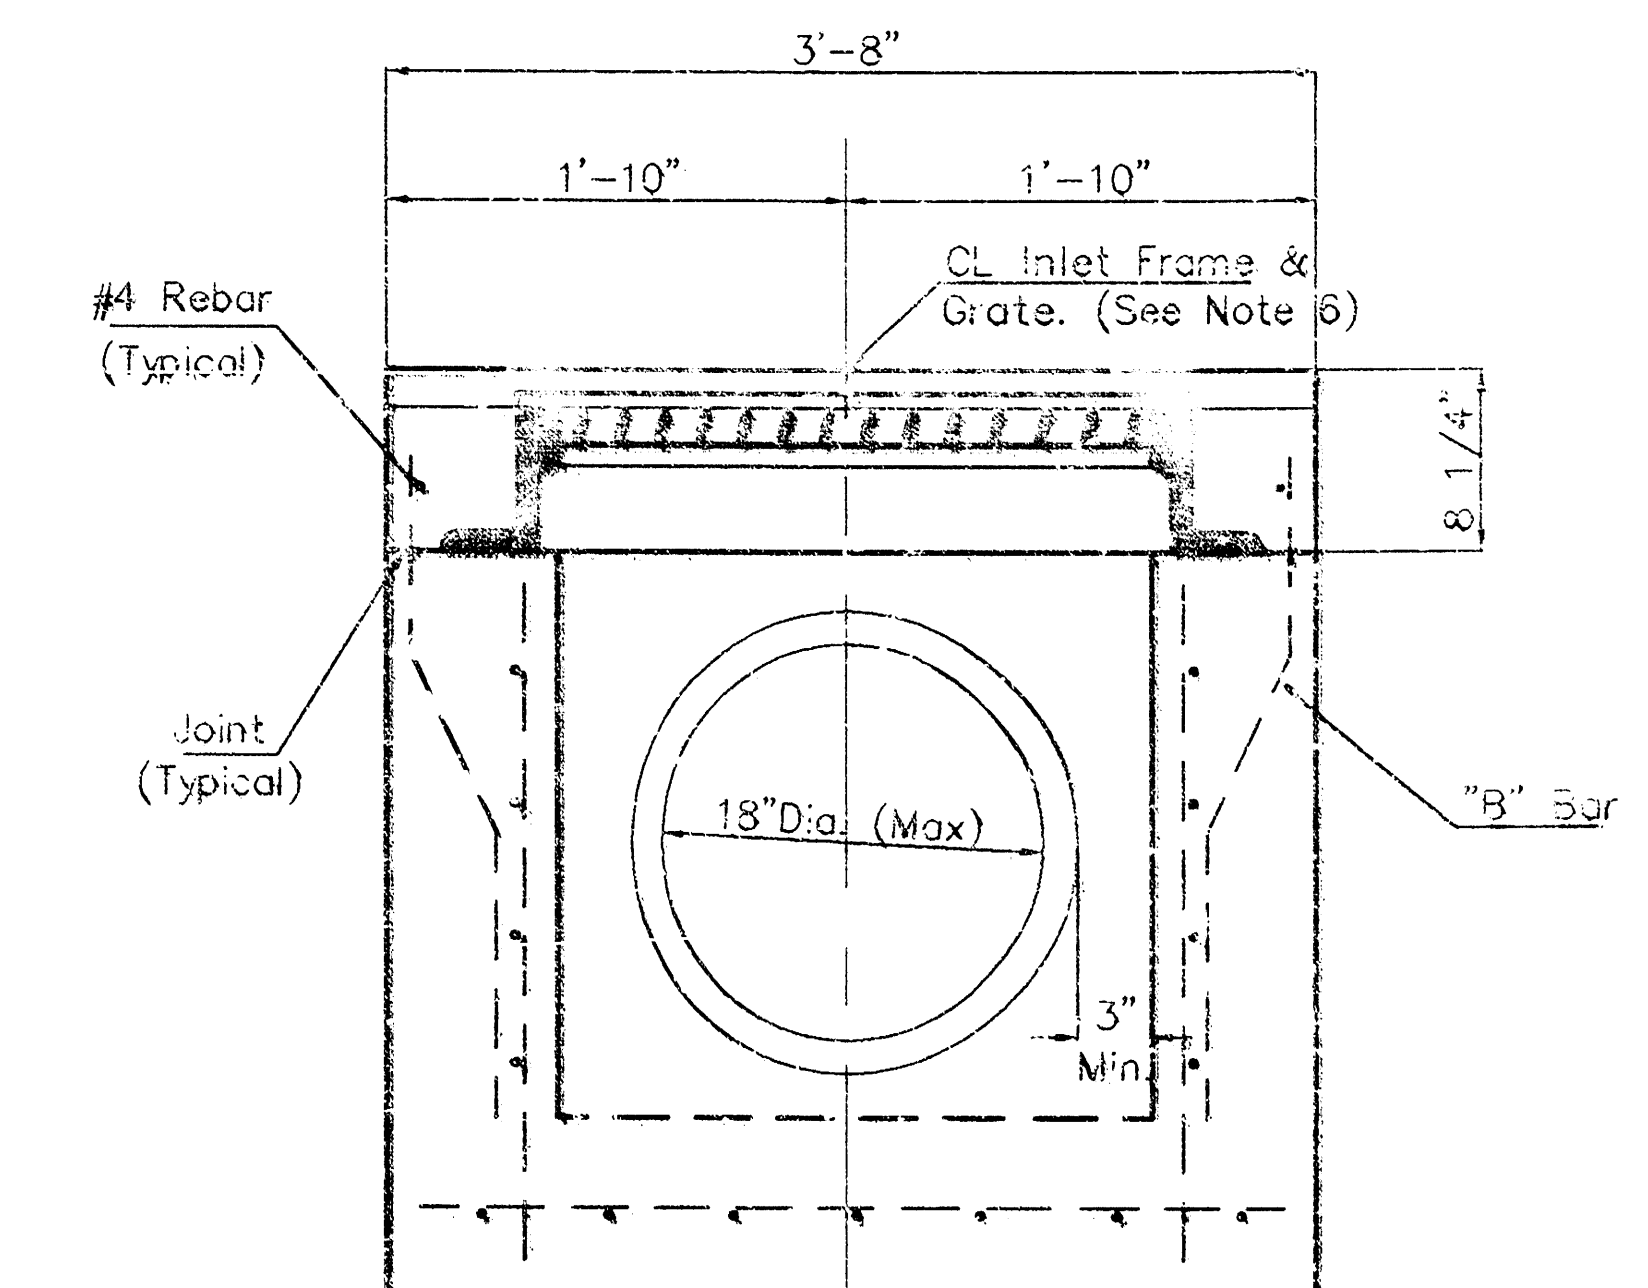


SECTION D-D

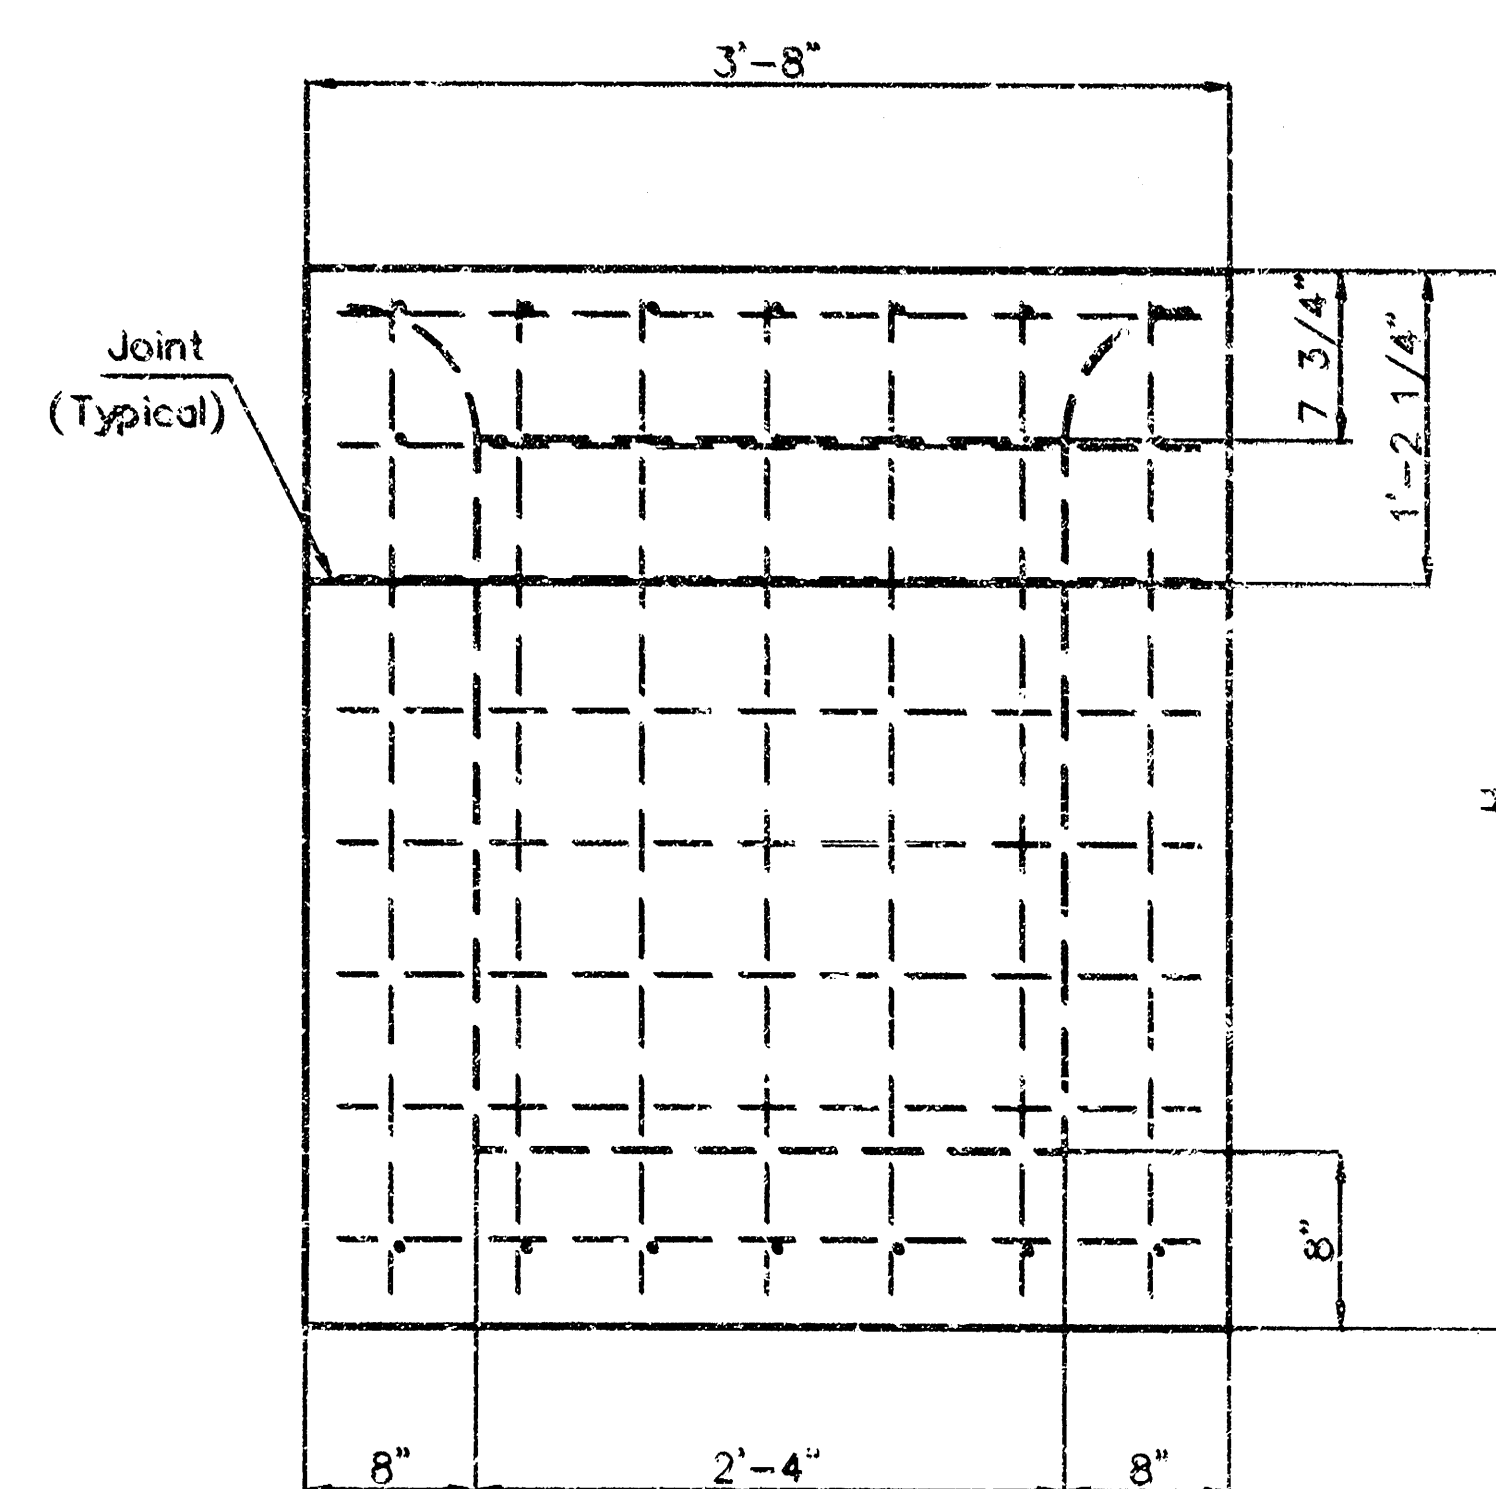

REAR WALL

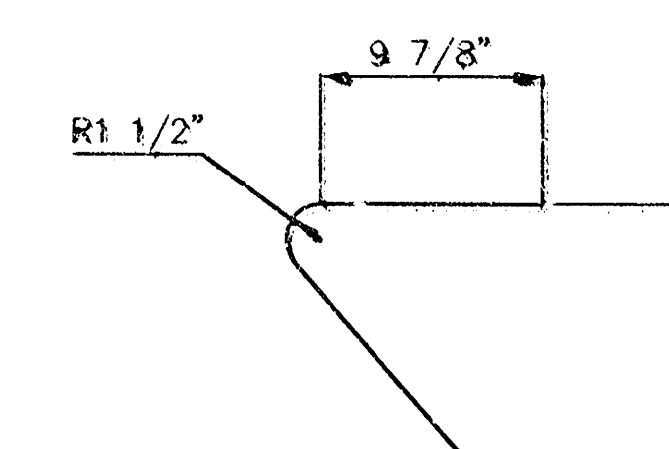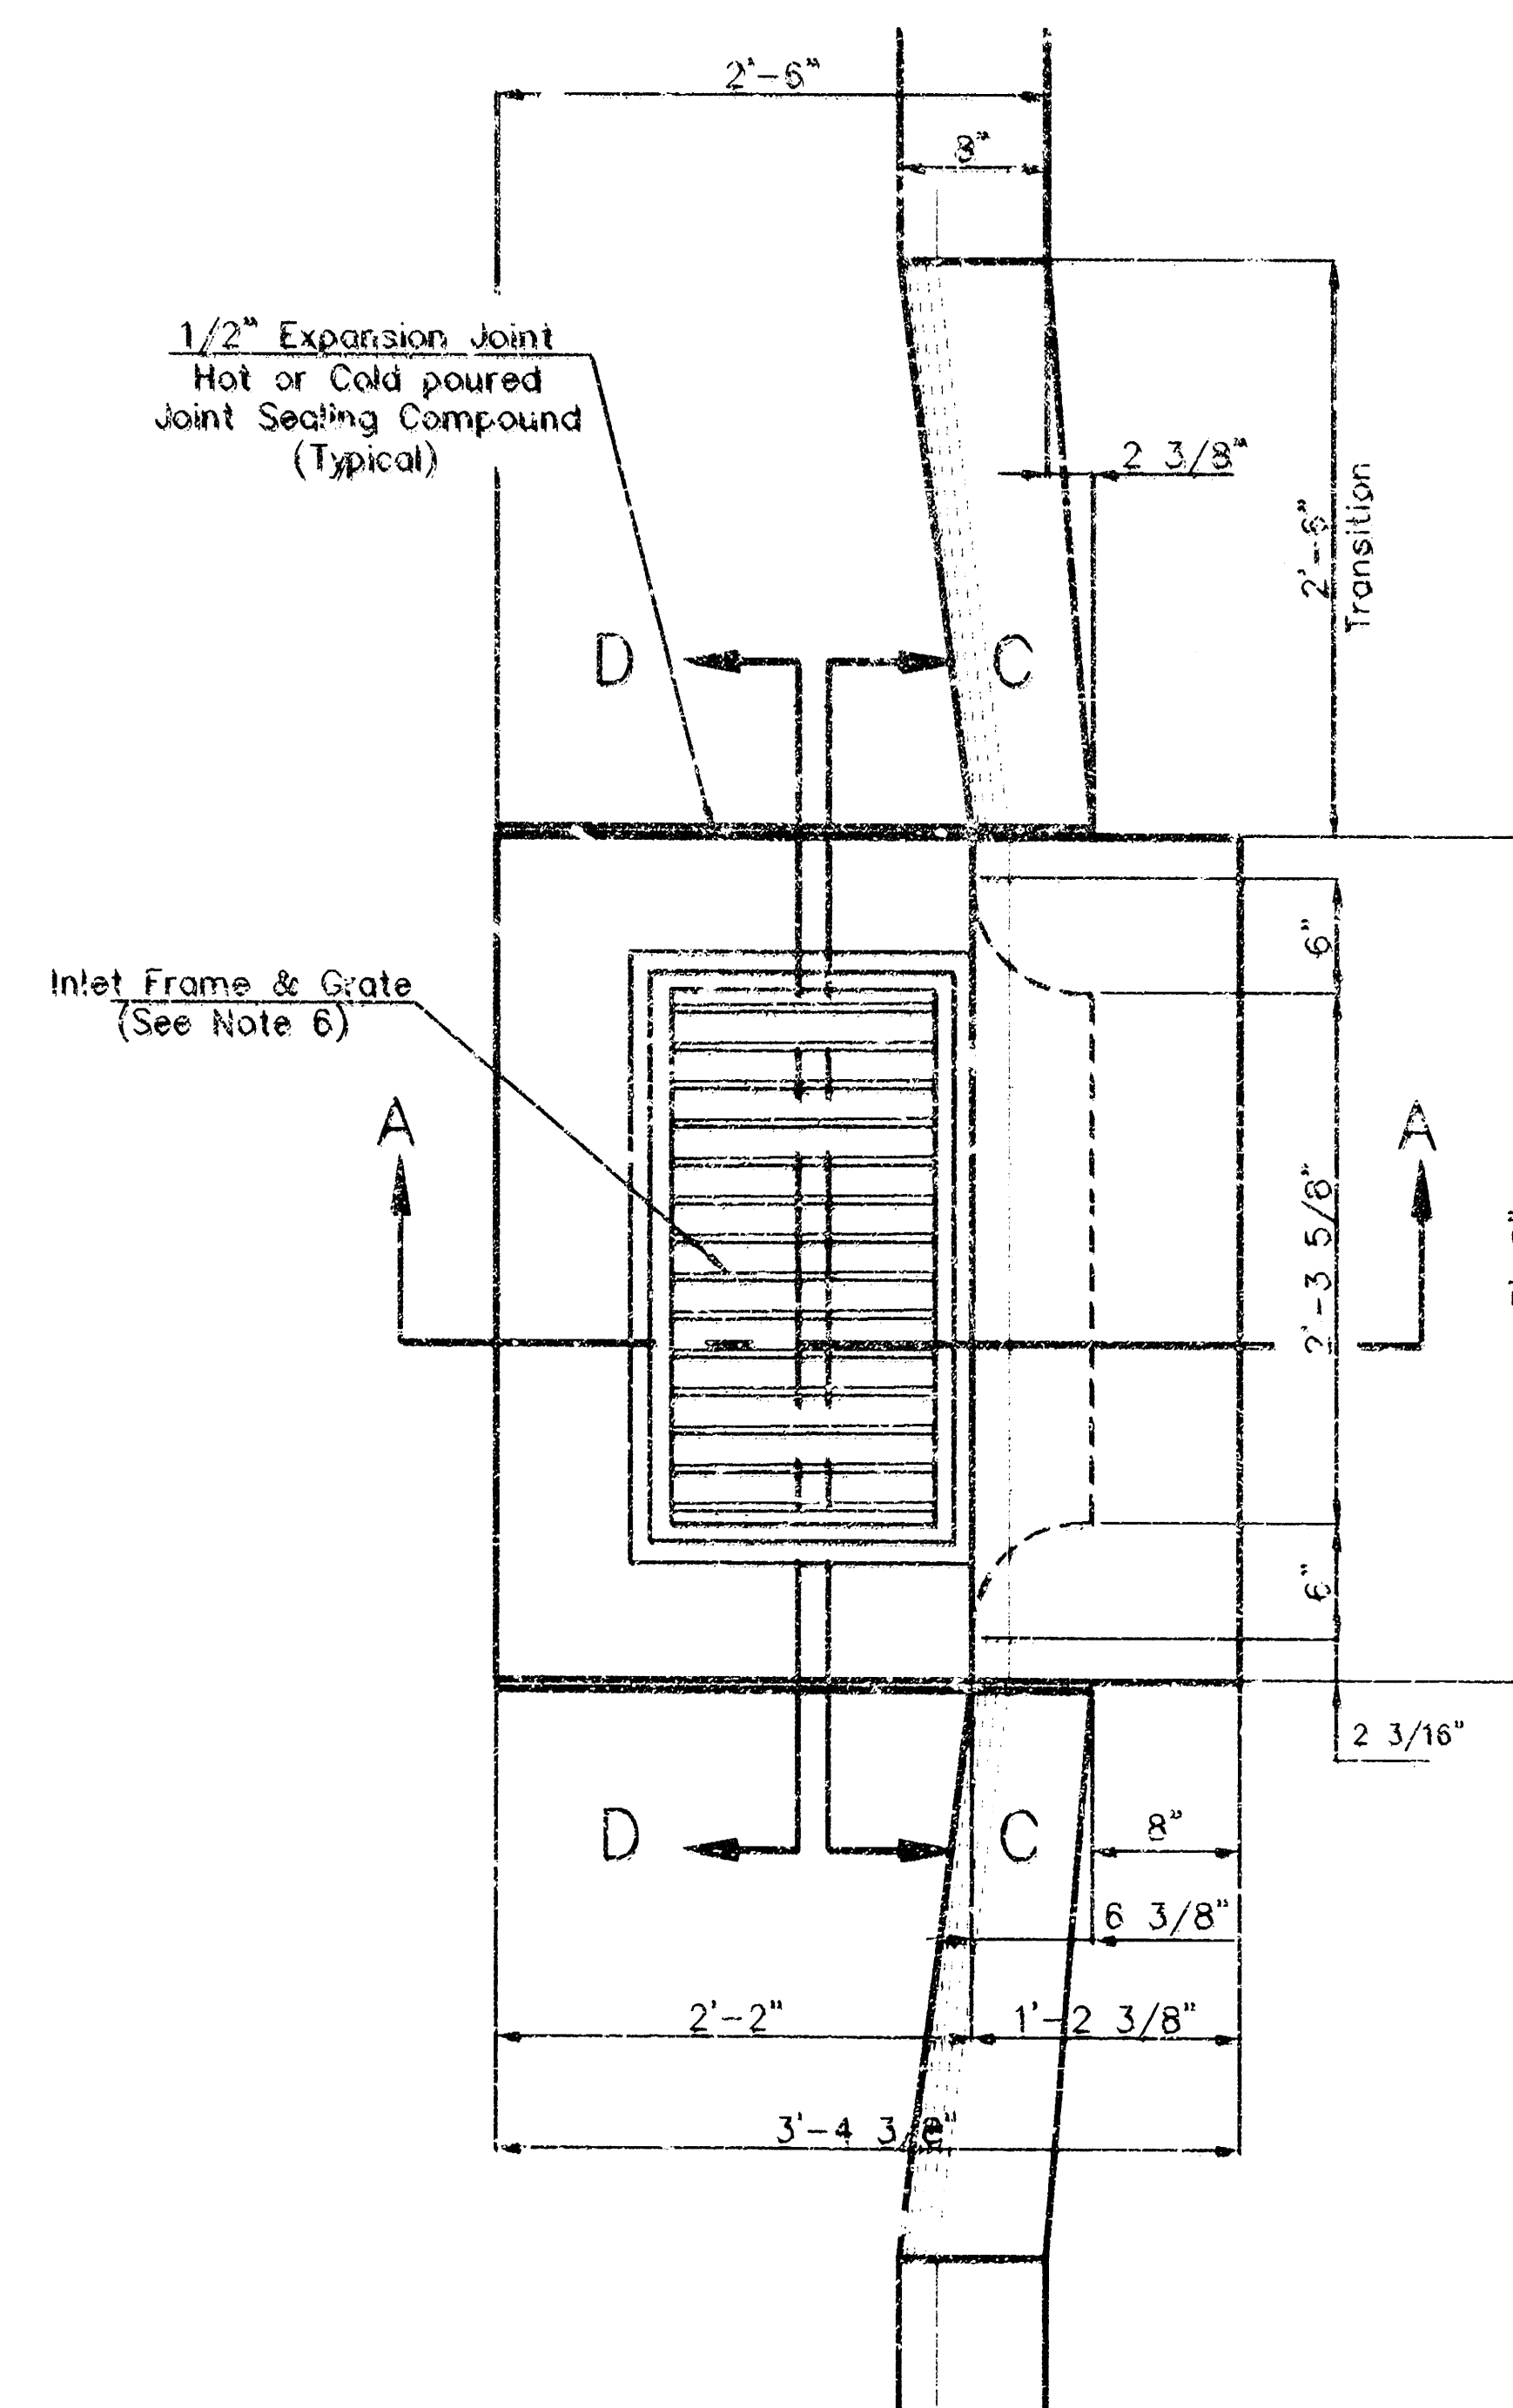

"A" Bar

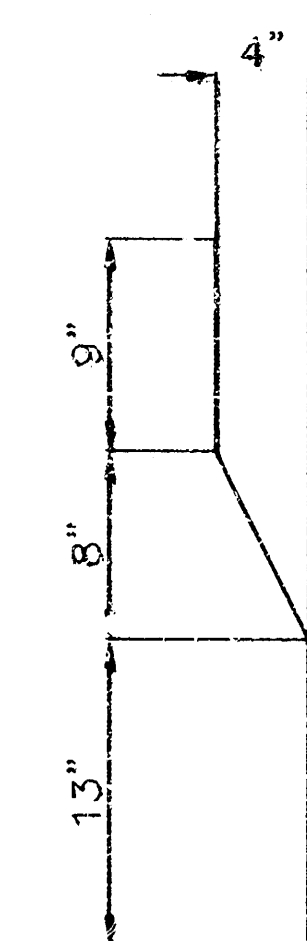

"B" Bar

General Notes

1. Use the concrete mix specified for the City of Wichita concrete pavement throughout. All exposed edges shall be finished with an edging tool. Reinforcing bars shall be bent around pipe.
2. Inlet invert shall be shaped with 8 sack mix concrete to create flow channels and to increase hydraulic efficiency such that the inlet will be self cleaning between all inlet and/or outlet pipes.
3. All bars are #4 with 6" spacing and shall have a minimum clearance of 1 1/2" inches unless otherwise noted on the plans.
4. When directed by the Engineer, a small opening may be required in the back of the inlet in order to drain a low area. Reinforcing bars will extend through the openings. No deductions in concrete quantities will be made for these openings.
5. No deductions will be made in pay length of curb, gutter, or curb and gutter through the inlet area.
6. Use Neenah R-3289 HV Single Inlet Frame and Grate or approved equal. Inlet frame to be proof load tested to 40,000 lbs. on unsupported side.
7. Reinforcing bars shall be cut or bent around pipes. No deduction in concrete quantities shall be made for pipe openings.
8. The vanes of the grate shall be oriented with respect to the flow arrows shown on the plans.

As-Built (Built per plan) 08/14/2001

THE CITY OF WICHITA CITY ENGINEER'S OFFICE CITY HALL - 2ND FLOOR 455 NORTH MAIN STREET WICHITA, KANSAS 67202 (316) 244-4551 (316) 244-4114 FAX	STANDARD TYPE II CURB INLET INLET OPENING = 3'x2'-3 3/8"	
	M. E. LINDBAK P.E. - CITY ENGINEER	
	PROJECT NUMBER 1014 PPS	DCL # 607861
	DATE MAR 98	SHEET SG4 OF 3

AT 10 40 41