


**STORM WATER SEWER IMPROVEMENTS TO SERVE
LOT 4, J.W. RUSSELL 2ND ADDITION
MILLINEUM CONCEPTS
PROJECT NUMBER
1199 PPS (607861)
CITY OF WICHITA, KANSAS
MICHAEL LINDEBAK, P.E., CITY ENGINEER**

Q. A.T. & S.F. RAILROAD

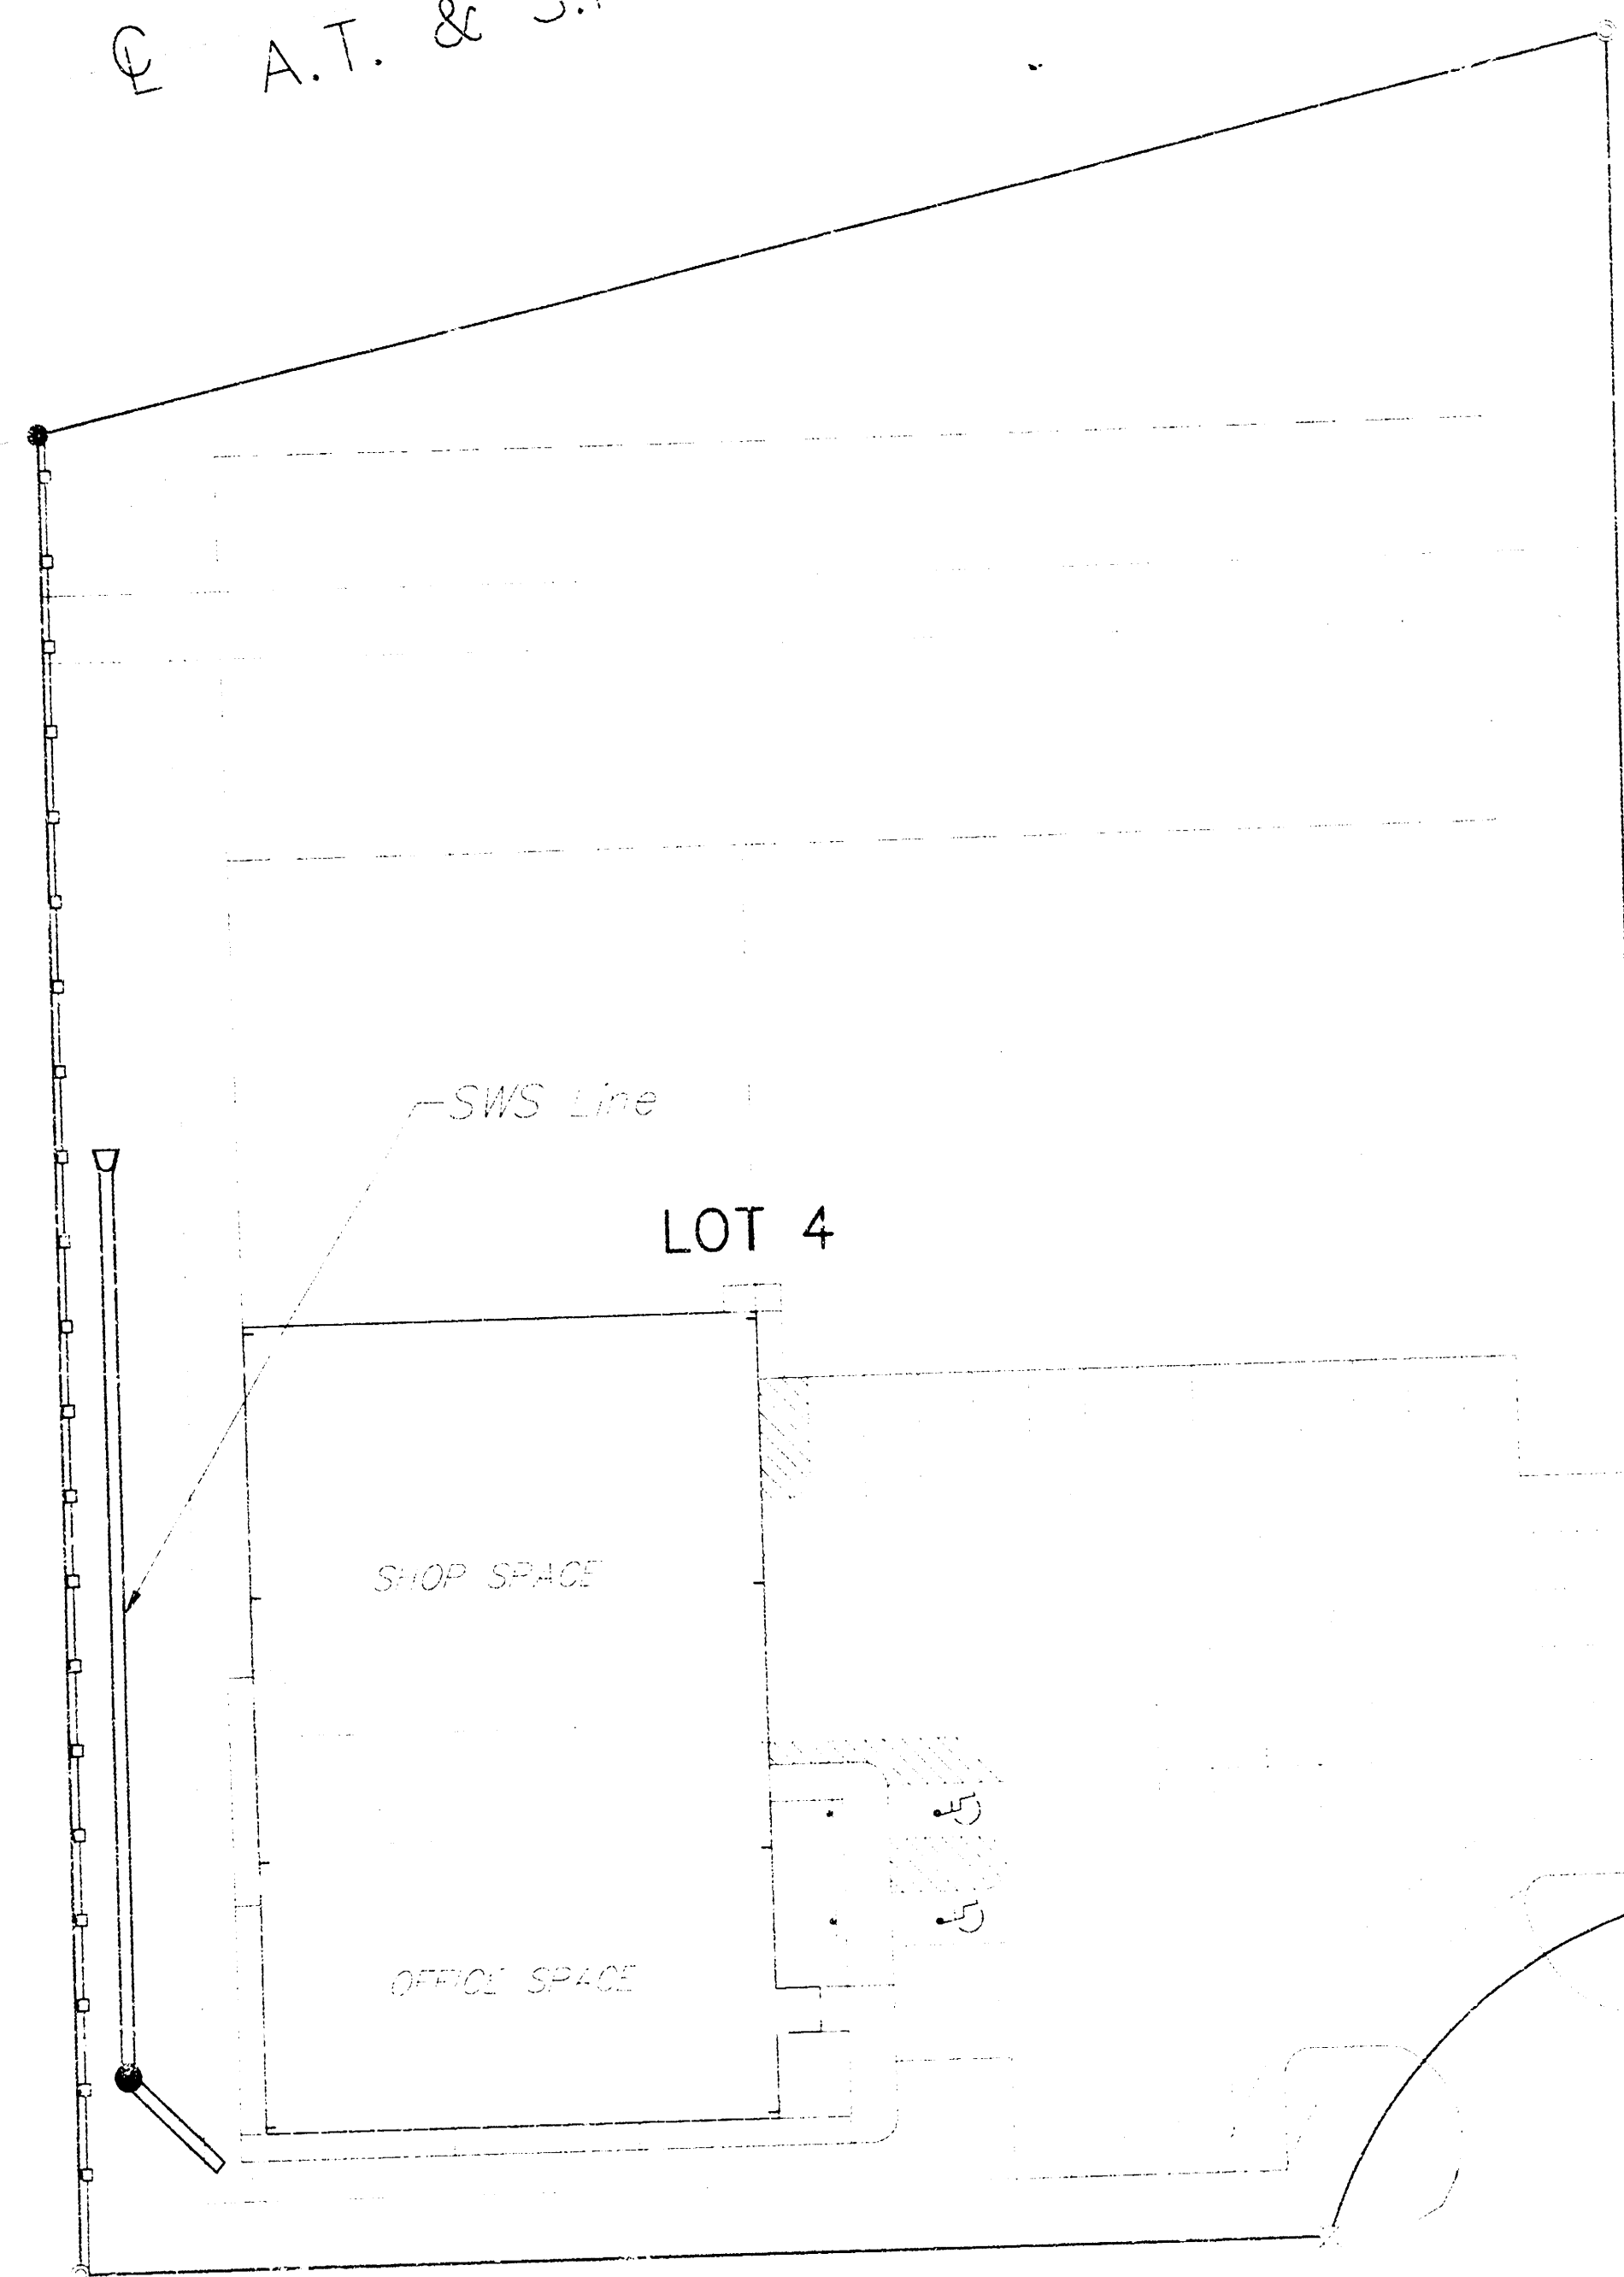


MONROE CIRCLE

N

INDEX

BENCHMARK

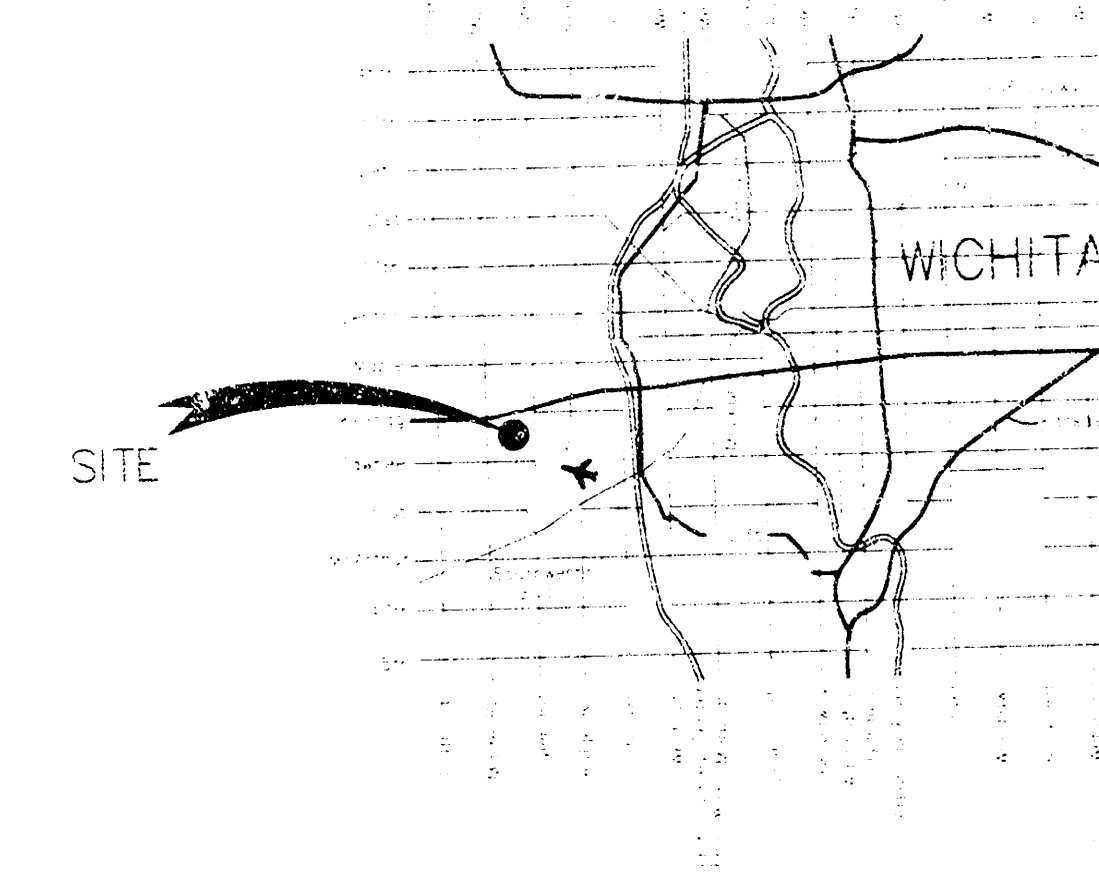

BOOKED
5-30-02
MCL
D-411

LOCATION
MAP

AS-BUILT
Date: 4/15/02
Signed: [Signature]

APPROVED AS NOTED BY CITY ENGINEER OF WICHITA



STORM SEWERS

[illegible]

Ernest R. Ward
1/29/02



AUSTIN
ENGINEERING SERVICE

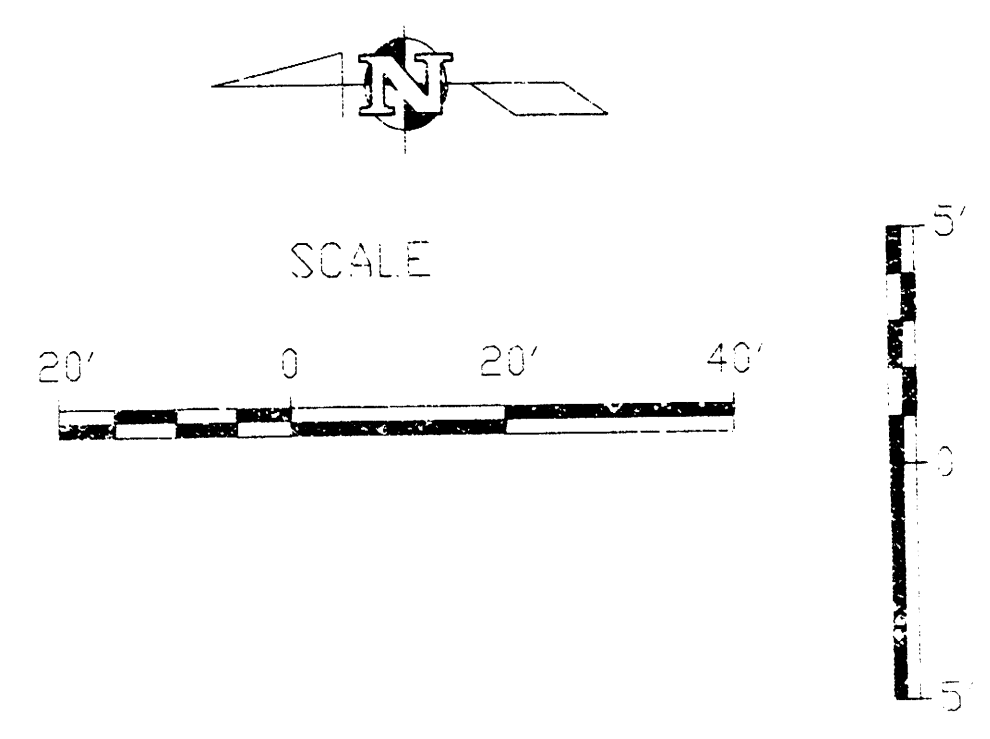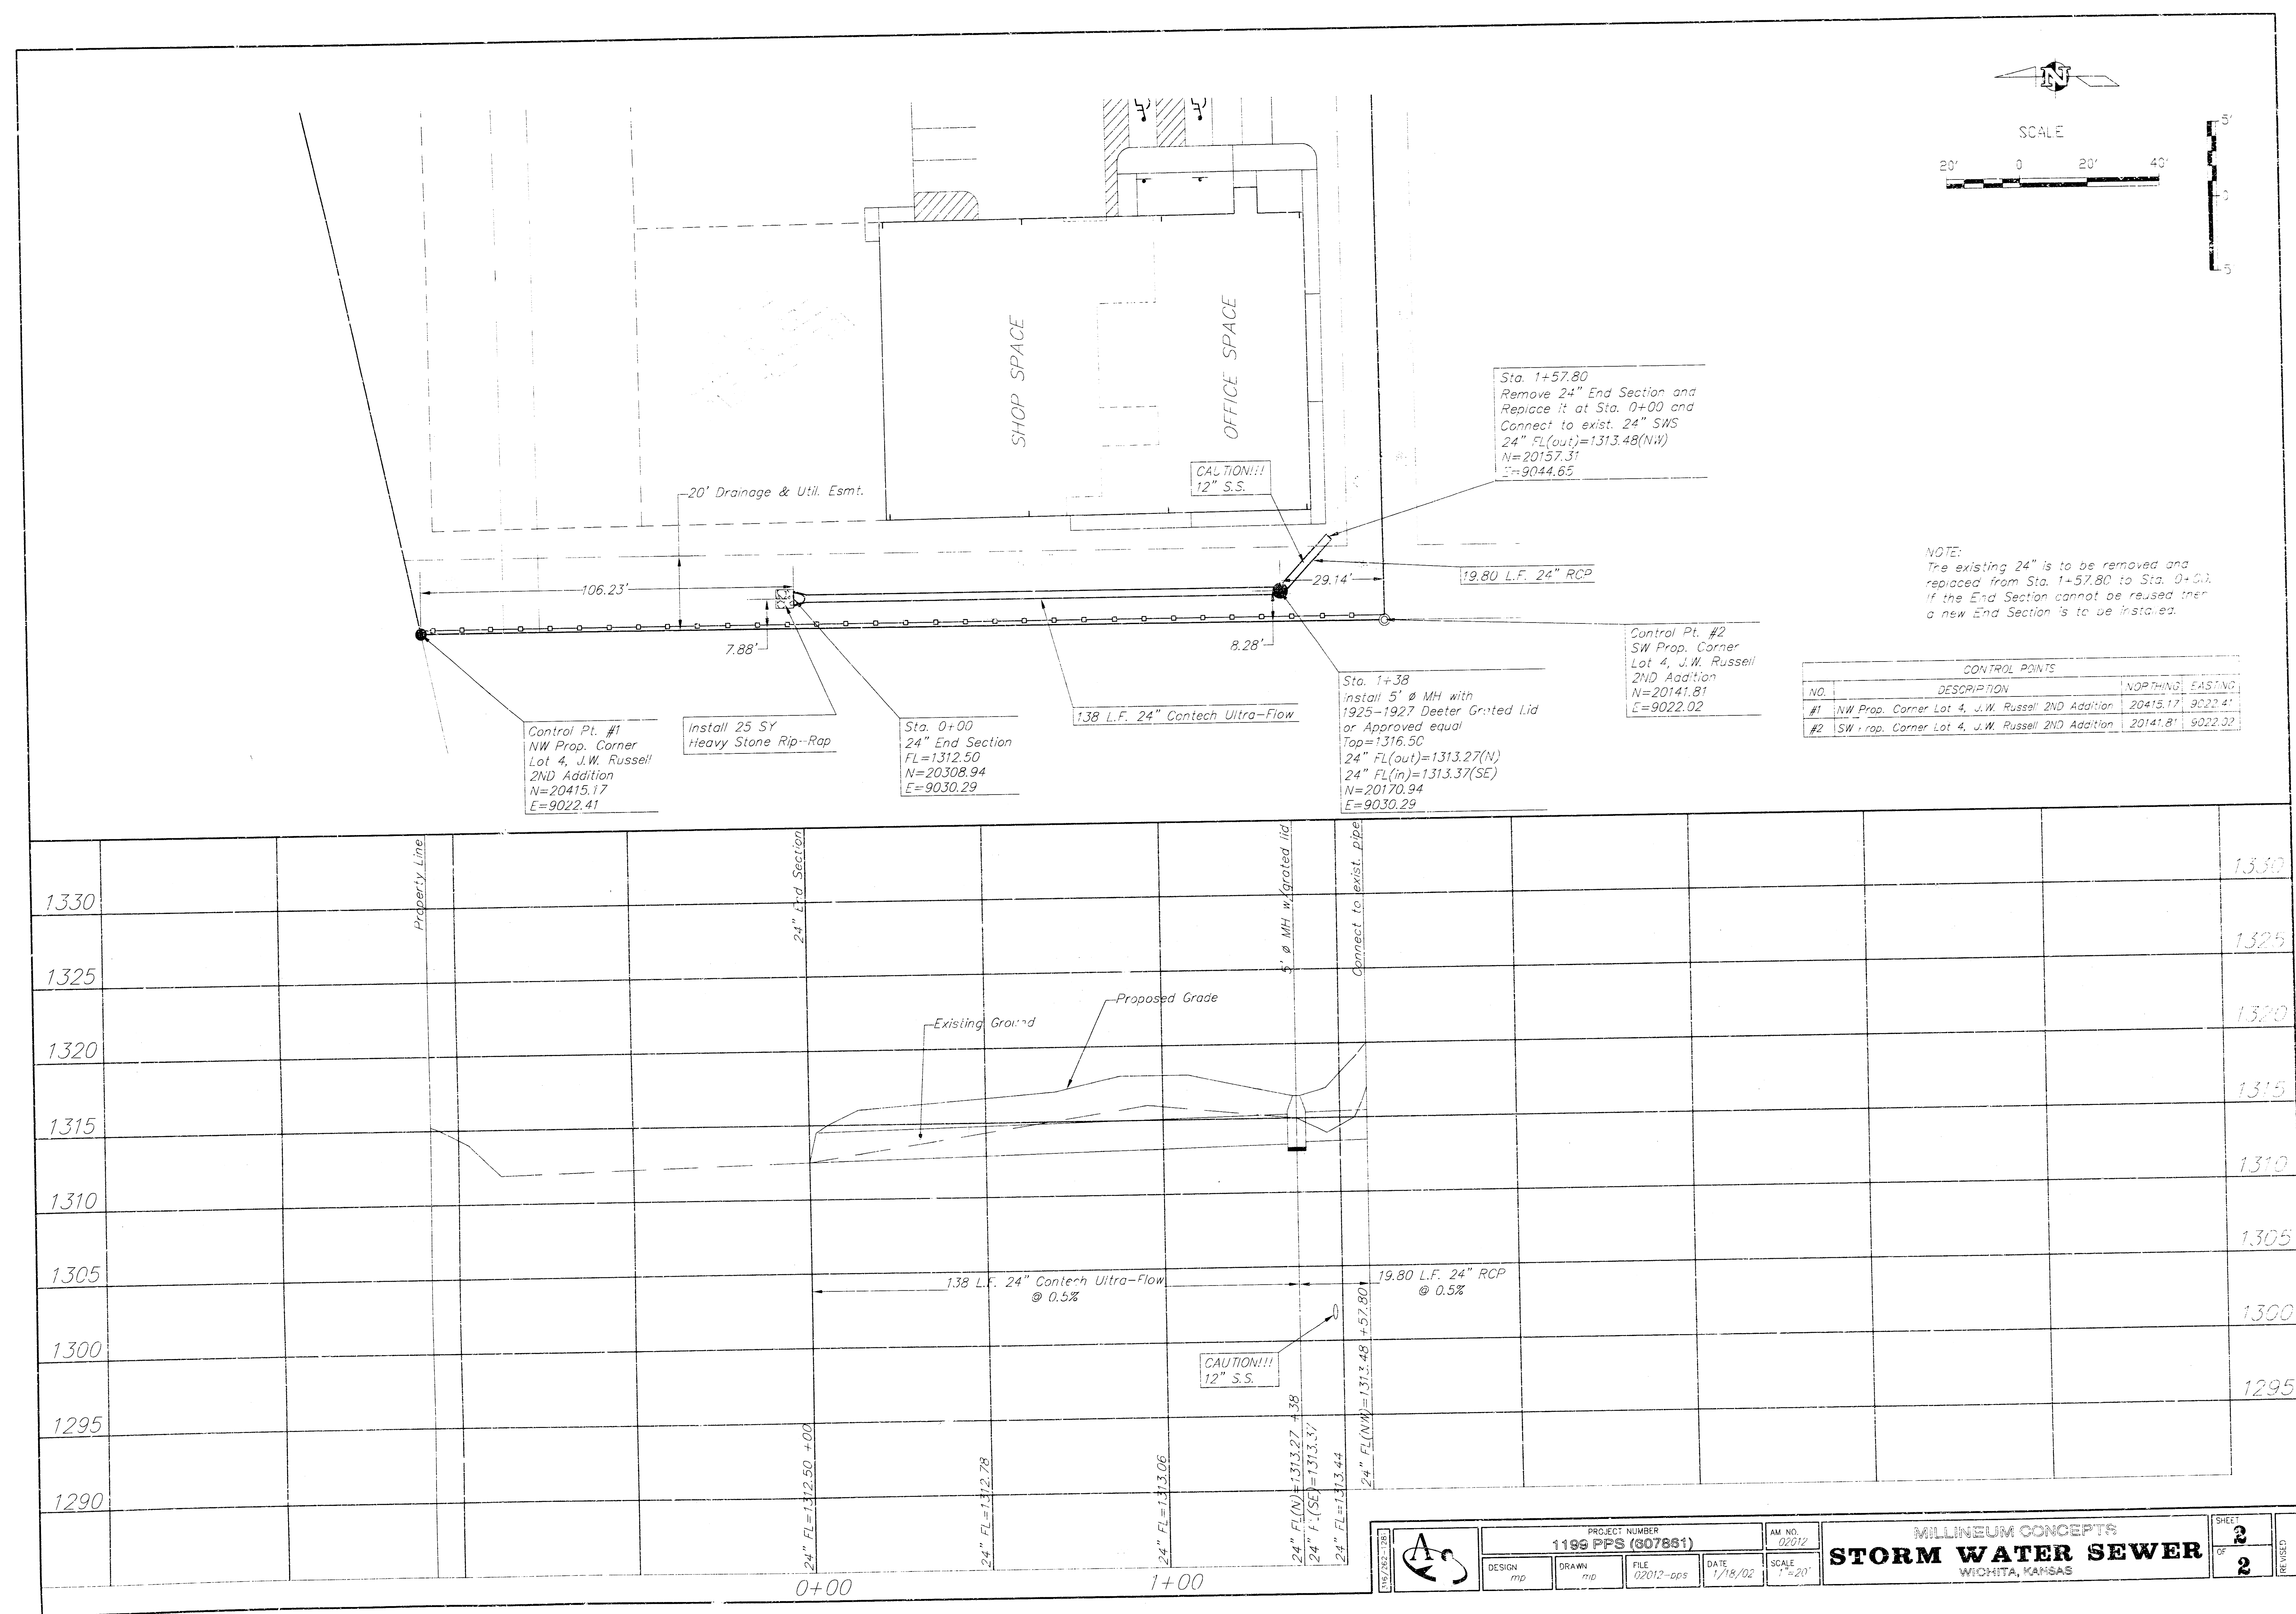

NOTE:
The existing 24" is to be removed and replaced from Sta. 1+57.80 to Sta. 0+00. If the End Section cannot be reused then a new End Section is to be installed.

CONTROL POINTS			
NO.	DESCRIPTION	NORTHING	EASTING
#1	NW Prop. Corner Lot 4, J.W. Russell 2ND Addition	20415.17	9022.41
#2	SW Prop. Corner Lot 4, J.W. Russell 2ND Addition	20141.81	9022.02

PROJECT NUMBER
1199 PFS (807851)

AM NO.
02012

DESIGN
mjd

DRAWN
mjd

FILE
02012-pps

DATE
1/18/02

SCALE
1"=20'

MILLINEUM CONCEPTS
STORM WATER SEWER
WICHITA, KANSAS

SHEET
2
OF
2

REVISED