


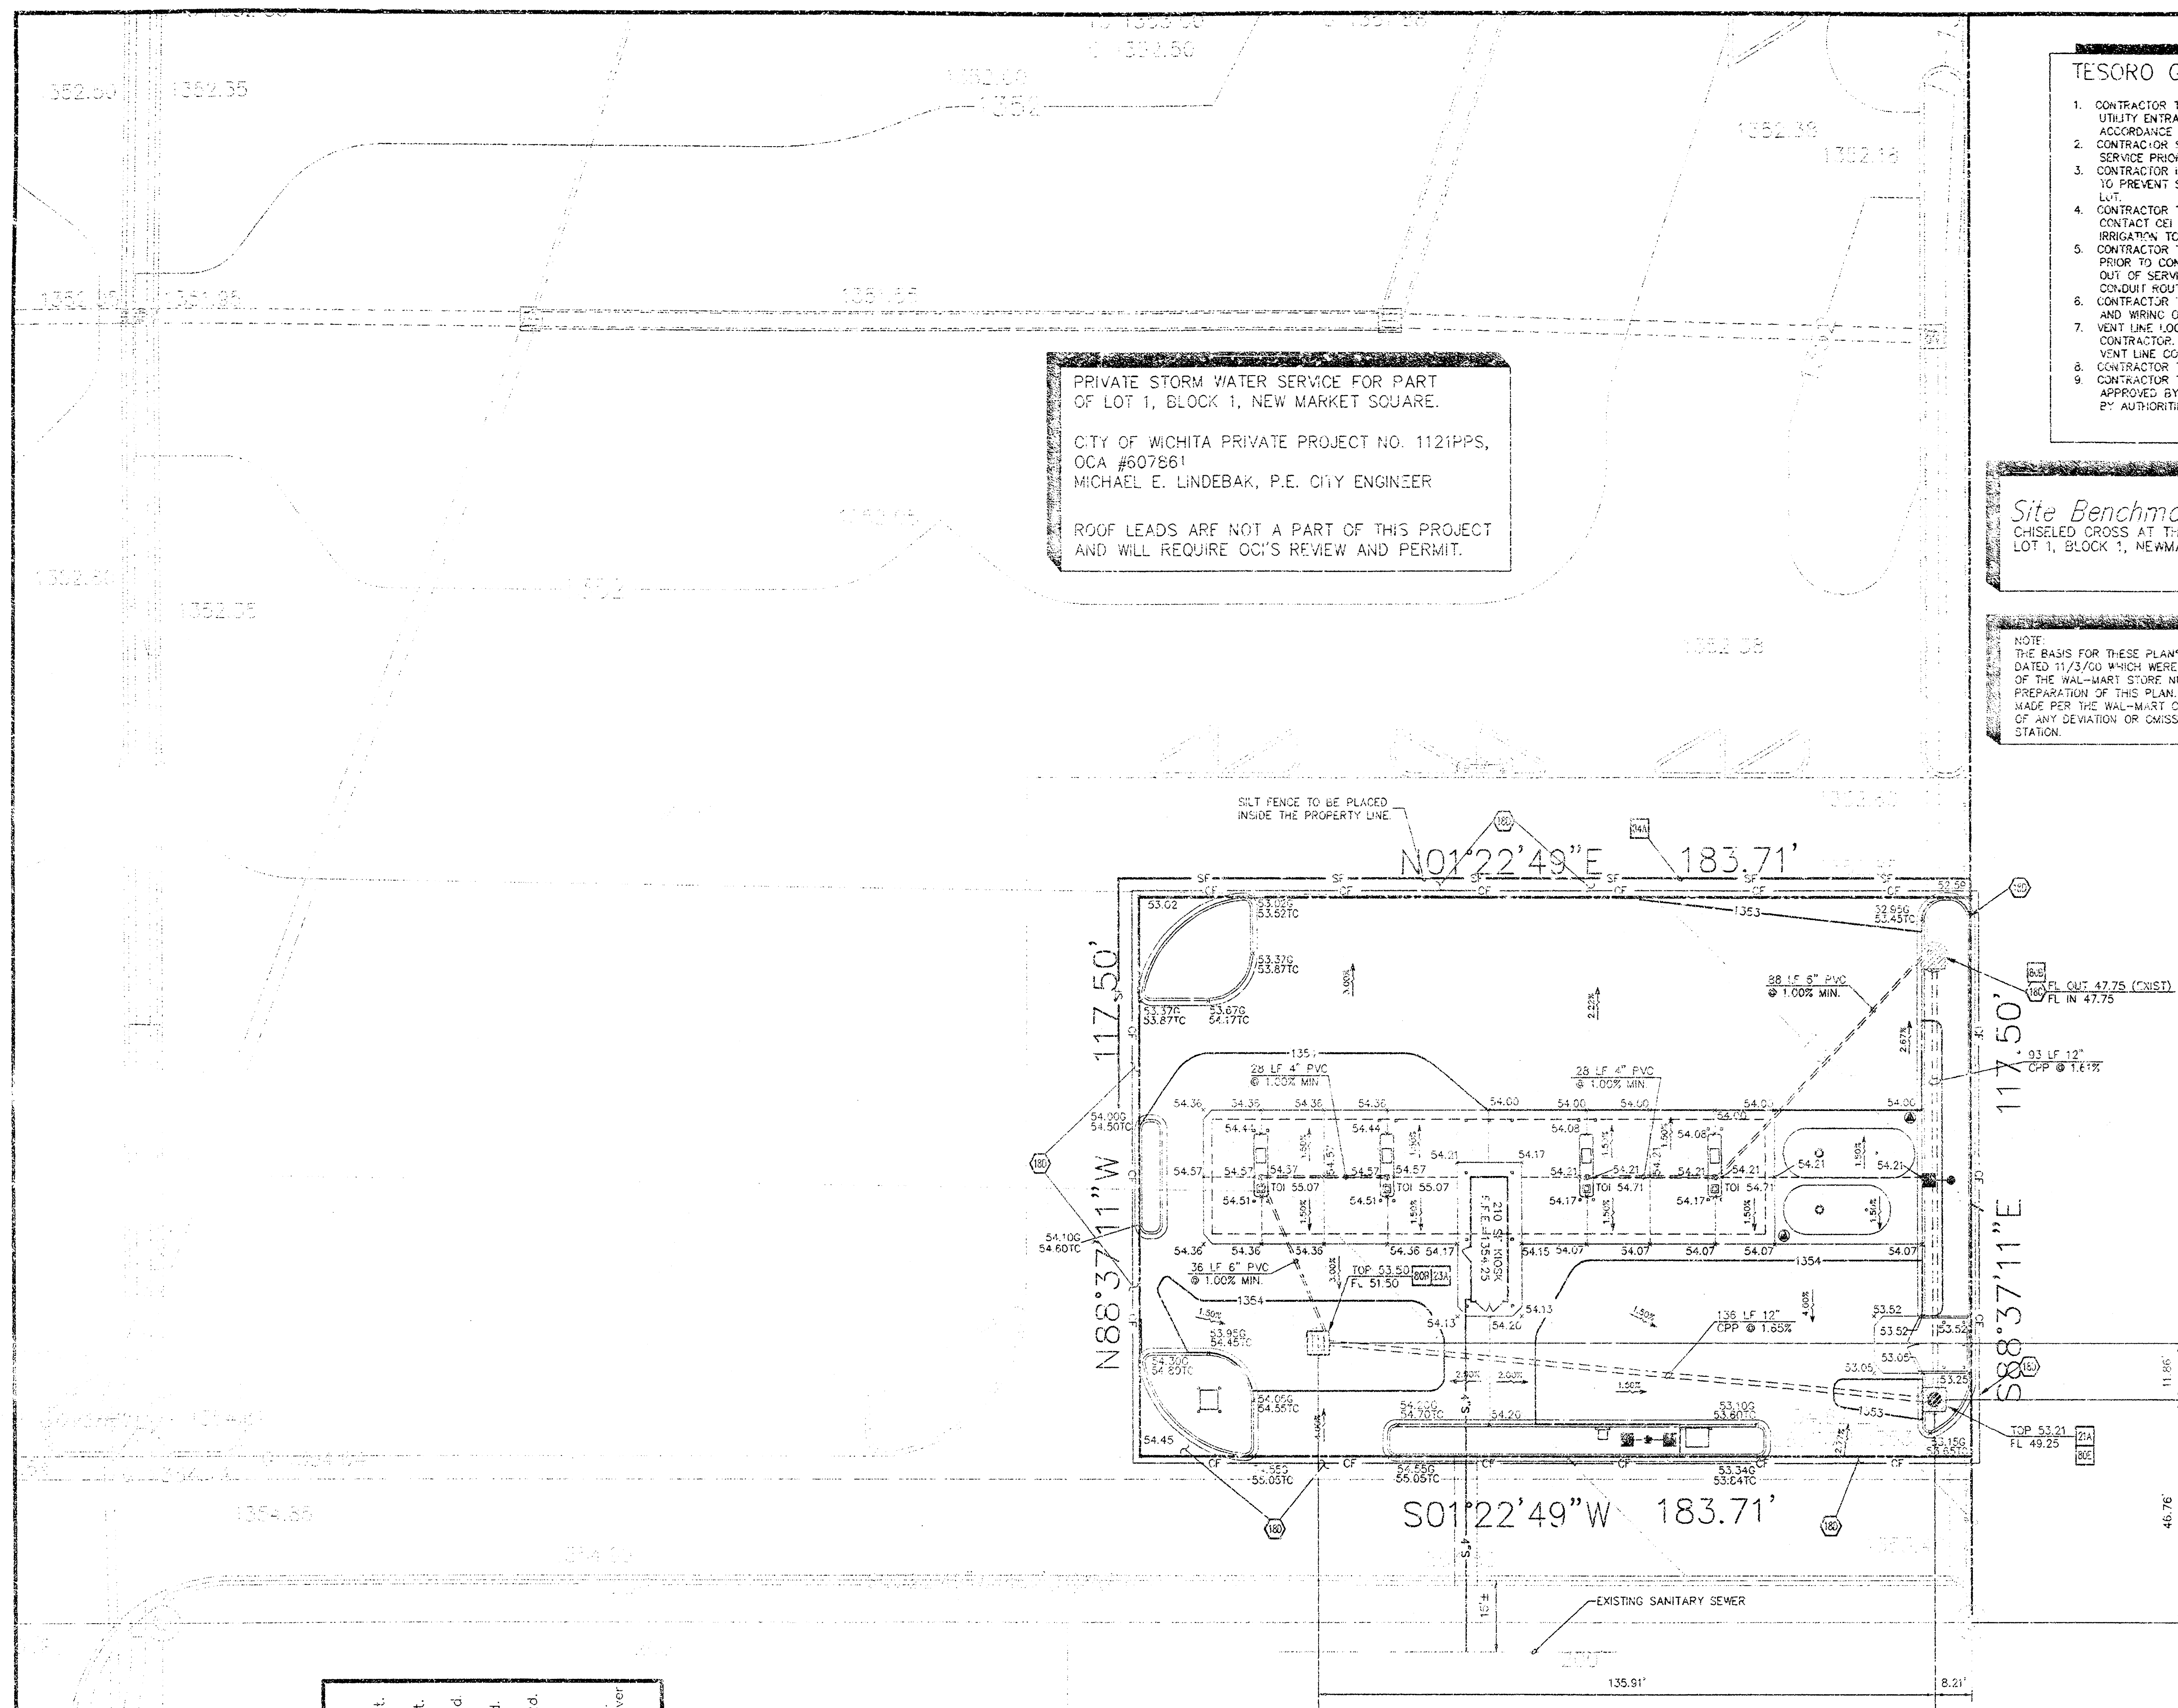

TESORO GENERAL NOTES:

1. CONTRACTOR TO INSTALL PREFABRICATED BUILDING, CANOPY, UTILITY ENTRANCES, AND UNDERGROUND FUEL TANKS IN ACCORDANCE WITH THE ASSOCIATED PLANS.
2. CONTRACTOR SHALL INFORM/CONTACT LOCAL UTILITY LOCATOR SERVICE PRIOR TO PERFORMING ANY CONSTRUCTION.
3. CONTRACTOR IS RESPONSIBLE TO TAKE ANY NECESSARY MEASURES TO PREVENT SEDIMENT FROM ENTERING THE WAL-MART PARKING LOT.
4. CONTRACTOR TO OBTAIN SCHEMATIC OF EXISTING IRRIGATION SYSTEM. CONTRACTOR SHALL INFORM/CONTACT LOCAL UTILITY LOCATOR SERVICE PRIOR TO PERFORMING ANY CONSTRUCTION.
5. CONTRACTOR TO START INSTALLATION OF ANY WAL-MART LIGHT POLES PRIOR TO CONSTRUCTION ON FUELING STATION. LIGHTS ARE TO BE OUT OF SERVICE FOR AS MINIMAL TIME AS POSSIBLE. VERIFY CONDUIT ROUTING BETWEEN LIGHTS PRIOR TO ANY EXCAVATION.
6. CONTRACTOR TO PROVIDE SIGN POLE, PAINTING OF POLE, INSTALLATION AND WIRING OF LIGHTS.
7. VENT LINE LOCATION ON PIPING PLAN TO BE COORDINATED WITH CANOPY CONTRACTOR. THERE SHALL BE NO DRAIN LINES, CONDITS, ETC. WITHIN VENT LINE COLUMN.
8. CONTRACTOR TO PROVIDE ADA PARKING SIGN, POLE, FOUNDATION, ETC.
9. CONTRACTOR TO PROVIDE AND MOUNT FIRE EXTINGUISHERS APPROVED BY LOCAL AUTHORITIES IN LOCATIONS WHICH ARE APPROVED BY AUTHORITIES.

Site Benchmark: Elevation=1351.34
CHISELED CROSS AT THE EASTERN MOST SOUTHEAST CORNER OF LOT 1, BLOCK 1, NEW MARKET SQUARE.

NOTE:
THE BASIS FOR THESE PLANS ARE THE ELECTRONIC FILES PROVIDED BY CSI ENGINEERING DATED 11/3/00 WHICH WERE PART OF THE CONSTRUCTION DOCUMENTS FOR THE CONSTRUCTION OF THE WAL-MART STORE NUMBER 3283-00. CONSTRUCTION MAY HAVE BEEN IN PROGRESS DURING PREPARATION OF THIS PLAN. THE CONTRACTOR SHALL VERIFY THAT THE IMPROVEMENTS HAVE BEEN MADE PER THE WAL-MART CONSTRUCTION PLANS AND SHALL NOTIFY THE OWNER'S REPRESENTATIVE OF ANY DEVIATION OR OMISSIONS THAT MAY AFFECT THE CONSTRUCTION OF THE PROPOSED FUELING STATION.

LEGEND

EXISTING

- 1. EAST OR ELECTRIC
- 2. NORTH
- 3. OVERHEAD
- 4. SOUTH OR SEWER
- 5. TELEPHONE
- 6. UNDERGROUND
- 7. WEST OR WATER
- 8. BOUNDARY LINE
- 9. RIGHT OF WAY LINE
- 10. STORM DRAIN
- 11. GAS
- 12. OVERHEAD ELECTRIC
- 13. OVERHEAD ELECTRIC AND TELEPHONE
- 14. OVERHEAD TELEPHONE
- 15. OVERHEAD TV
- 16. SEWER
- 17. UNDERGROUND ELECTRIC
- 18. UNDERGROUND ELECTRIC AND TELEPHONE
- 19. UNDERGROUND TELEPHONE
- 20. UNDERGROUND TV
- 21. WATER
- 22. TREE INFO
- 23. 5 = DIAMETER OF TRUNK IN FEET
- 24. 10 = HEIGHT OF TREE IN FEET
- 25. 11 = CANOPY DIAMETER IN FEET
- 26. 50.5 = ELEVATION AT BASE OF TREE
- 27. ELECTRICAL RIDER

PROPOSED

- 1. BOUNDARY LINE
- 2. RIGHT OF WAY LINE
- 3. GRADE BREAK
- 4. CONTOUR ELEVATIONS
- 5. STORM DRAIN
- 6. SPOT ELEVATIONS
- 7. TO = TOP OF CURB
- 8. 0 = DUTTER

GENERAL GRADING NOTES


- A. PRIOR TO INSTALLATION OF STORM OR SANITARY SEWER, THE CONTRACTOR SHALL EXCAVATE, VERIFY, AND CALCULATE ALL GRAVINGS AND INFORM THE OWNER AND THE ENGINEER OF ANY CONFLICTS PRIOR TO CONSTRUCTION. THE ENGINEER WILL BE HELD HARMLESS IN THE EVENT THE ENGINEER IS NOT NOTIFIED OF DESIGN CONFLICTS.
- B. ALL SLOPES AND AREAS DISTURBED BY CONSTRUCTION SHALL BE GRADUALLY SMOOTHED AND FOUR INCHES OF TOPSOIL APPLIED. IF ADEQUATE TOPSOIL IS NOT AVAILABLE ON SITE, THE CONTRACTOR SHALL PROVIDE TOPSOIL APPROVED BY THE OWNER. AS NEEDED, THE AREA SHALL THEN BE SEEDED, FERTILIZED, MULCHED, WATERED AND MAINTAINED UNTIL HARDY GRASS GROWTH IS ESTABLISHED IN ALL AREAS (SEE LANDSCAPE PLAN FOR SEED MIX AND PROPER APPLICATION RATE). ANY AREAS DISTURBED FOR ANY REASON PRIOR TO FINAL ACCEPTANCE OF THE PROJECT SHALL BE CORRECTED BY THE CONTRACTOR AT NO ADDITIONAL COST TO THE OWNER.
- C. THE CONTRACTOR IS SPECIFICALLY CAUTIONED THAT THE LOCATION AND/OR ELEVATION OF EXISTING UTILITIES AS SHOWN ON THESE PLANS IS BASED ON RECORDS OF THE VARIOUS UTILITY COMPANIES, AND WHERE POSSIBLE, MEASUREMENTS TAKEN IN THE FIELD. THE INFORMATION IS NOT TO BE RELIED ON AS BEING EXACT OR COMPLETE. THE CONTRACTOR MUST CALL THE APPROPRIATE UTILITY COMPANY AT LEAST 48 HOURS BEFORE ANY EXCAVATION TO REQUEST EXACT FIELD LOCATION OF UTILITIES.
- D. UNLESS OTHERWISE SHOWN, CALLED OUT OR SPECIFIED HEREIN OR WITHIN THE SPECIFICATIONS:
 - ALL STORM DRAIN PIPE BEDDING SHALL BE INSTALLED PER DETAIL 28A.
 - ALL STORM DRAIN PIPES ARE MEASURED FROM CENTER OF STRUCTURES AND ENDS OF FLARED END SECTIONS.

GRADING DETAILS

- 1. CURB INLET
- 2. CRATE INLET
- 3. TEMPORARY STRAW BALE INLET SEDIMENT FILTER
- 4. TEMPORARY GRAVEL CURB INLET SEDIMENT FILTER
- 5. TEMPORARY SILT FENCE

GRADING NOTES

- 1. CONNECT TO EXISTING STORM DRAIN MANHOLE OR INLET
- 2. MATCH EXISTING PAVEMENT ELEVATIONS

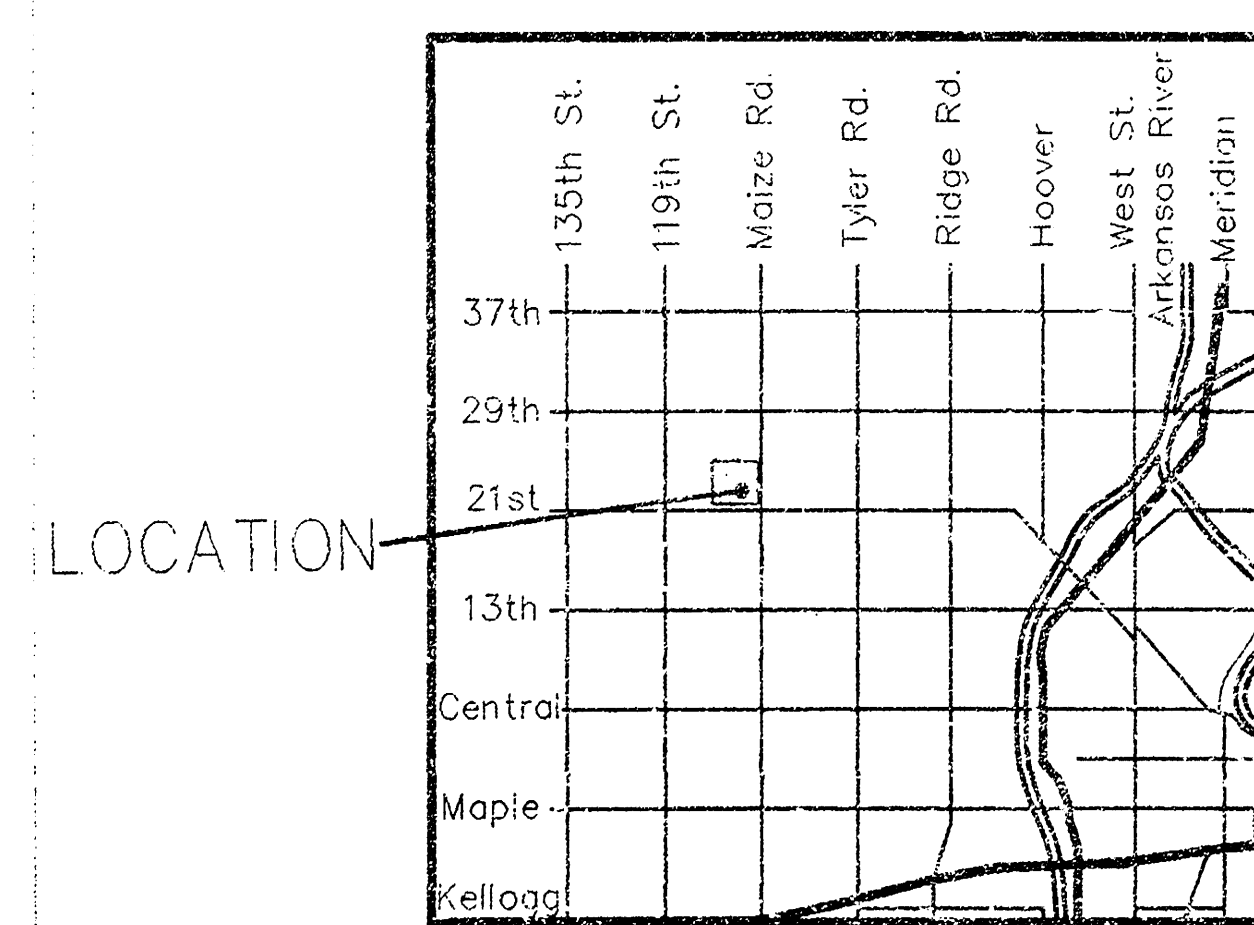

Vicinity Map
NOT TO SCALE


APPROVED AS NOTED
BY CITY ENGINEER OF WICHITA

SANITARY SEWERS _____
STORM SEWERS _____
DRIVEWAY APPROACHES _____
WATER MAINS _____
PAVING _____

NOTE TO CONTRACTORS

INSPECTION AND TESTING FOR THIS PROJECT IS TO BE PROVIDED BY A LICENSED CONSULTING ENGINEERING FIRM UNDER CONTRACT WITH THE OWNER/DEVELOPER. SAID INSPECTION TO BE IN ACCORDANCE WITH THE CITY OF WICHITA STANDARD CONSTRUCTION ENGINEERING PRACTICES AND CERTIFIED BY A LICENSED PROFESSIONAL ENGINEER. NO WORK SHALL BE PERFORMED IN DEDICATED EASEMENTS OR THE PUBLIC RIGHT-OF-WAY BY THE CONTRACTOR WITHOUT SUCH INSPECTION NOR SHALL ANY WORK BE COMMENCED IN DEDICATED EASEMENTS OR PUBLIC RIGHT-OF-WAY WITHOUT WRITTEN AUTHORIZATION BY THE CITY ENGINEER.

THE STORM SEWER FOR THIS PROJECT, WICHITA #1121 PPS(OCA#607861) HAS BEEN CERTIFIED BY "CERTIFIED ENGINEERING DESIGN, P.A. ATTN: HARLAN FORAKER" PER THE ATTACHED CERTIFICATE OF COMPLETION, INSPECTION REPORTS, CONTRACTOR RED-LINES AND VIDEO TAPES.

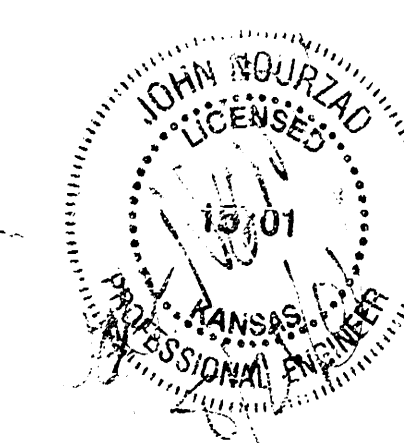

WAL-MART SUPERCENTER #3283					
INITIAL DESIGN	1-16-01	JHN	DMT	CEW	CEW
DATE	PRN	PM	DES	DRW	
Mirastar CEI ENGINEERING ASSOCIATES, INC ENGINEERS PLANNERS SURVEYORS					
3371 S. 7 th ST. Bentonville, AR 72712		(501) 273-3472 FAX (501) 273-0844		JOB NO.: 15939.0 DWG NAME: 5939PROJ	
STORM SEWER AS-BUILT			DATE: 08-21-01 TIME: 10:12 AM		
21st ST. & MAZE RD. WICHITA, KANSAS			SHEET NO. 1 OF 1		