

5-1

CENTRAL

5805 E. Central


MH # 5847-040  
Adjust Manhole to Grade  
(visible but approx. 8" below surrounding ground level, located under west fence, in northwest corner of 6002 E. Avalon)  
Est. depth = 12.0 ft

OAKWOOD


402 N. Brookside

6002 E. Avalon

AVALON

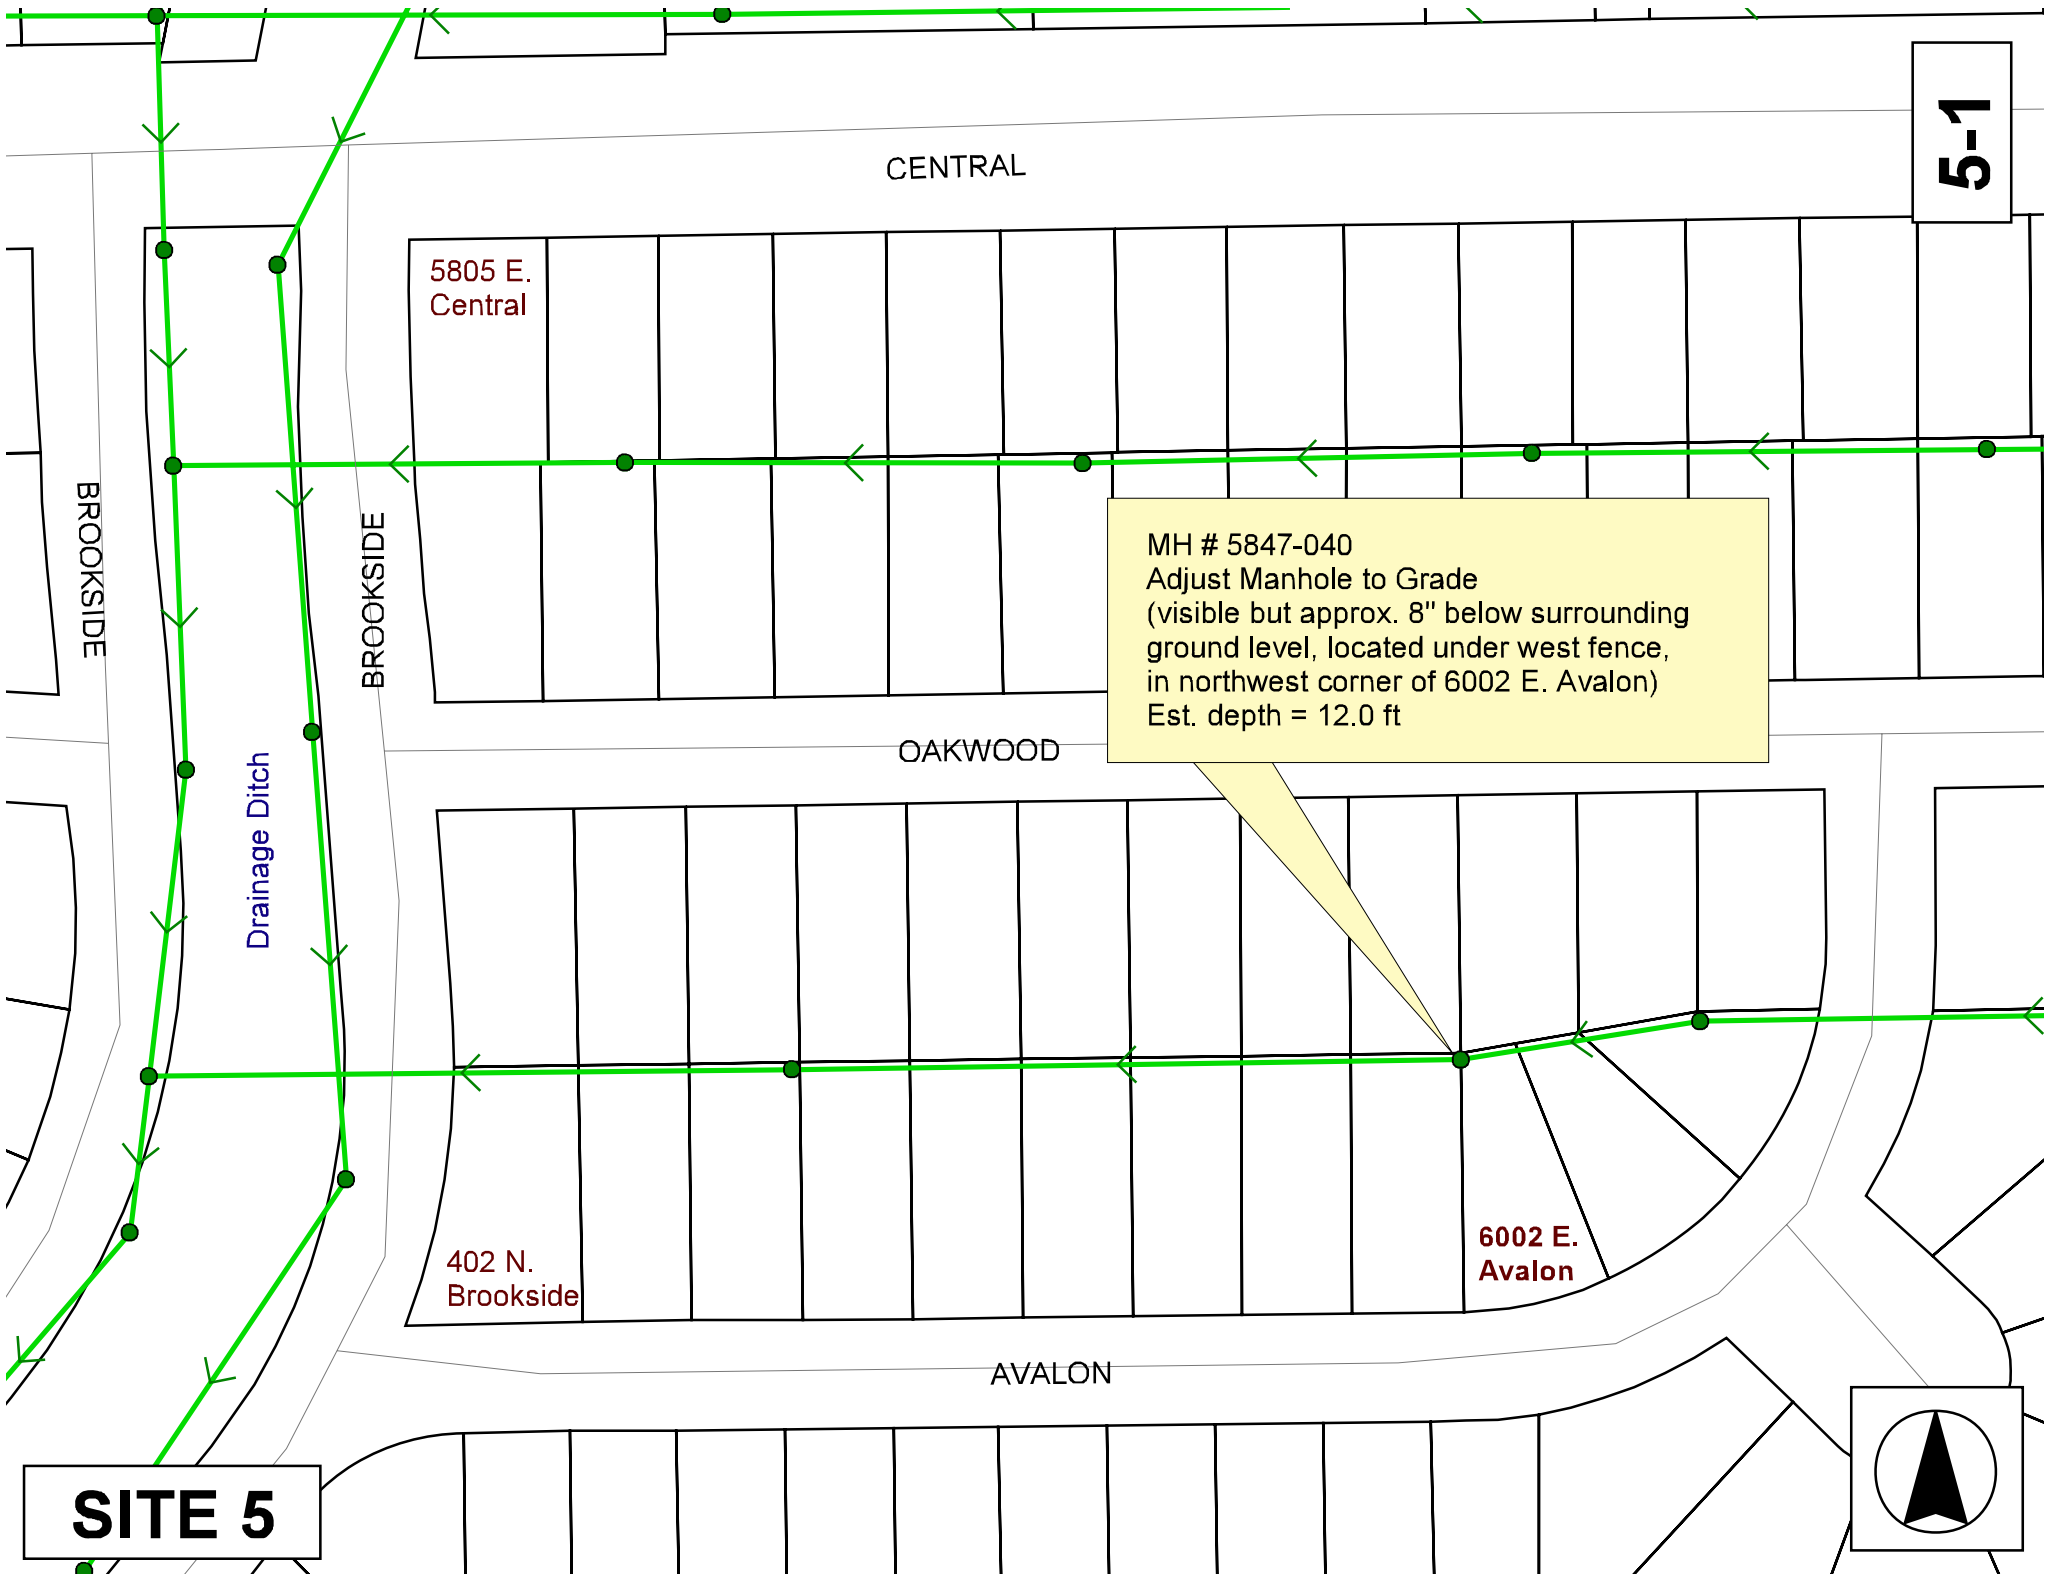

SITE 5

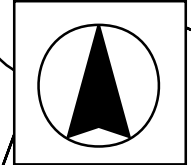

5-2

OAKWOOD

5847-040

6002

AVALON

Aerial View

