


S.M. 15148 S.W. Cor. 4000' porch N.E. LEVITT 15' N. of E.L. BLACKWILL Ho # 8208 LEVITT.  
 S.M. 14938 S.E. Cor. 4000' slab @ S.E. Cor. House # 8324 LEVITT.  
 S.M. 14768 R. 10' Ritchie Dr. OS. INCHER LANE S.E. LEVITT DRIVE.

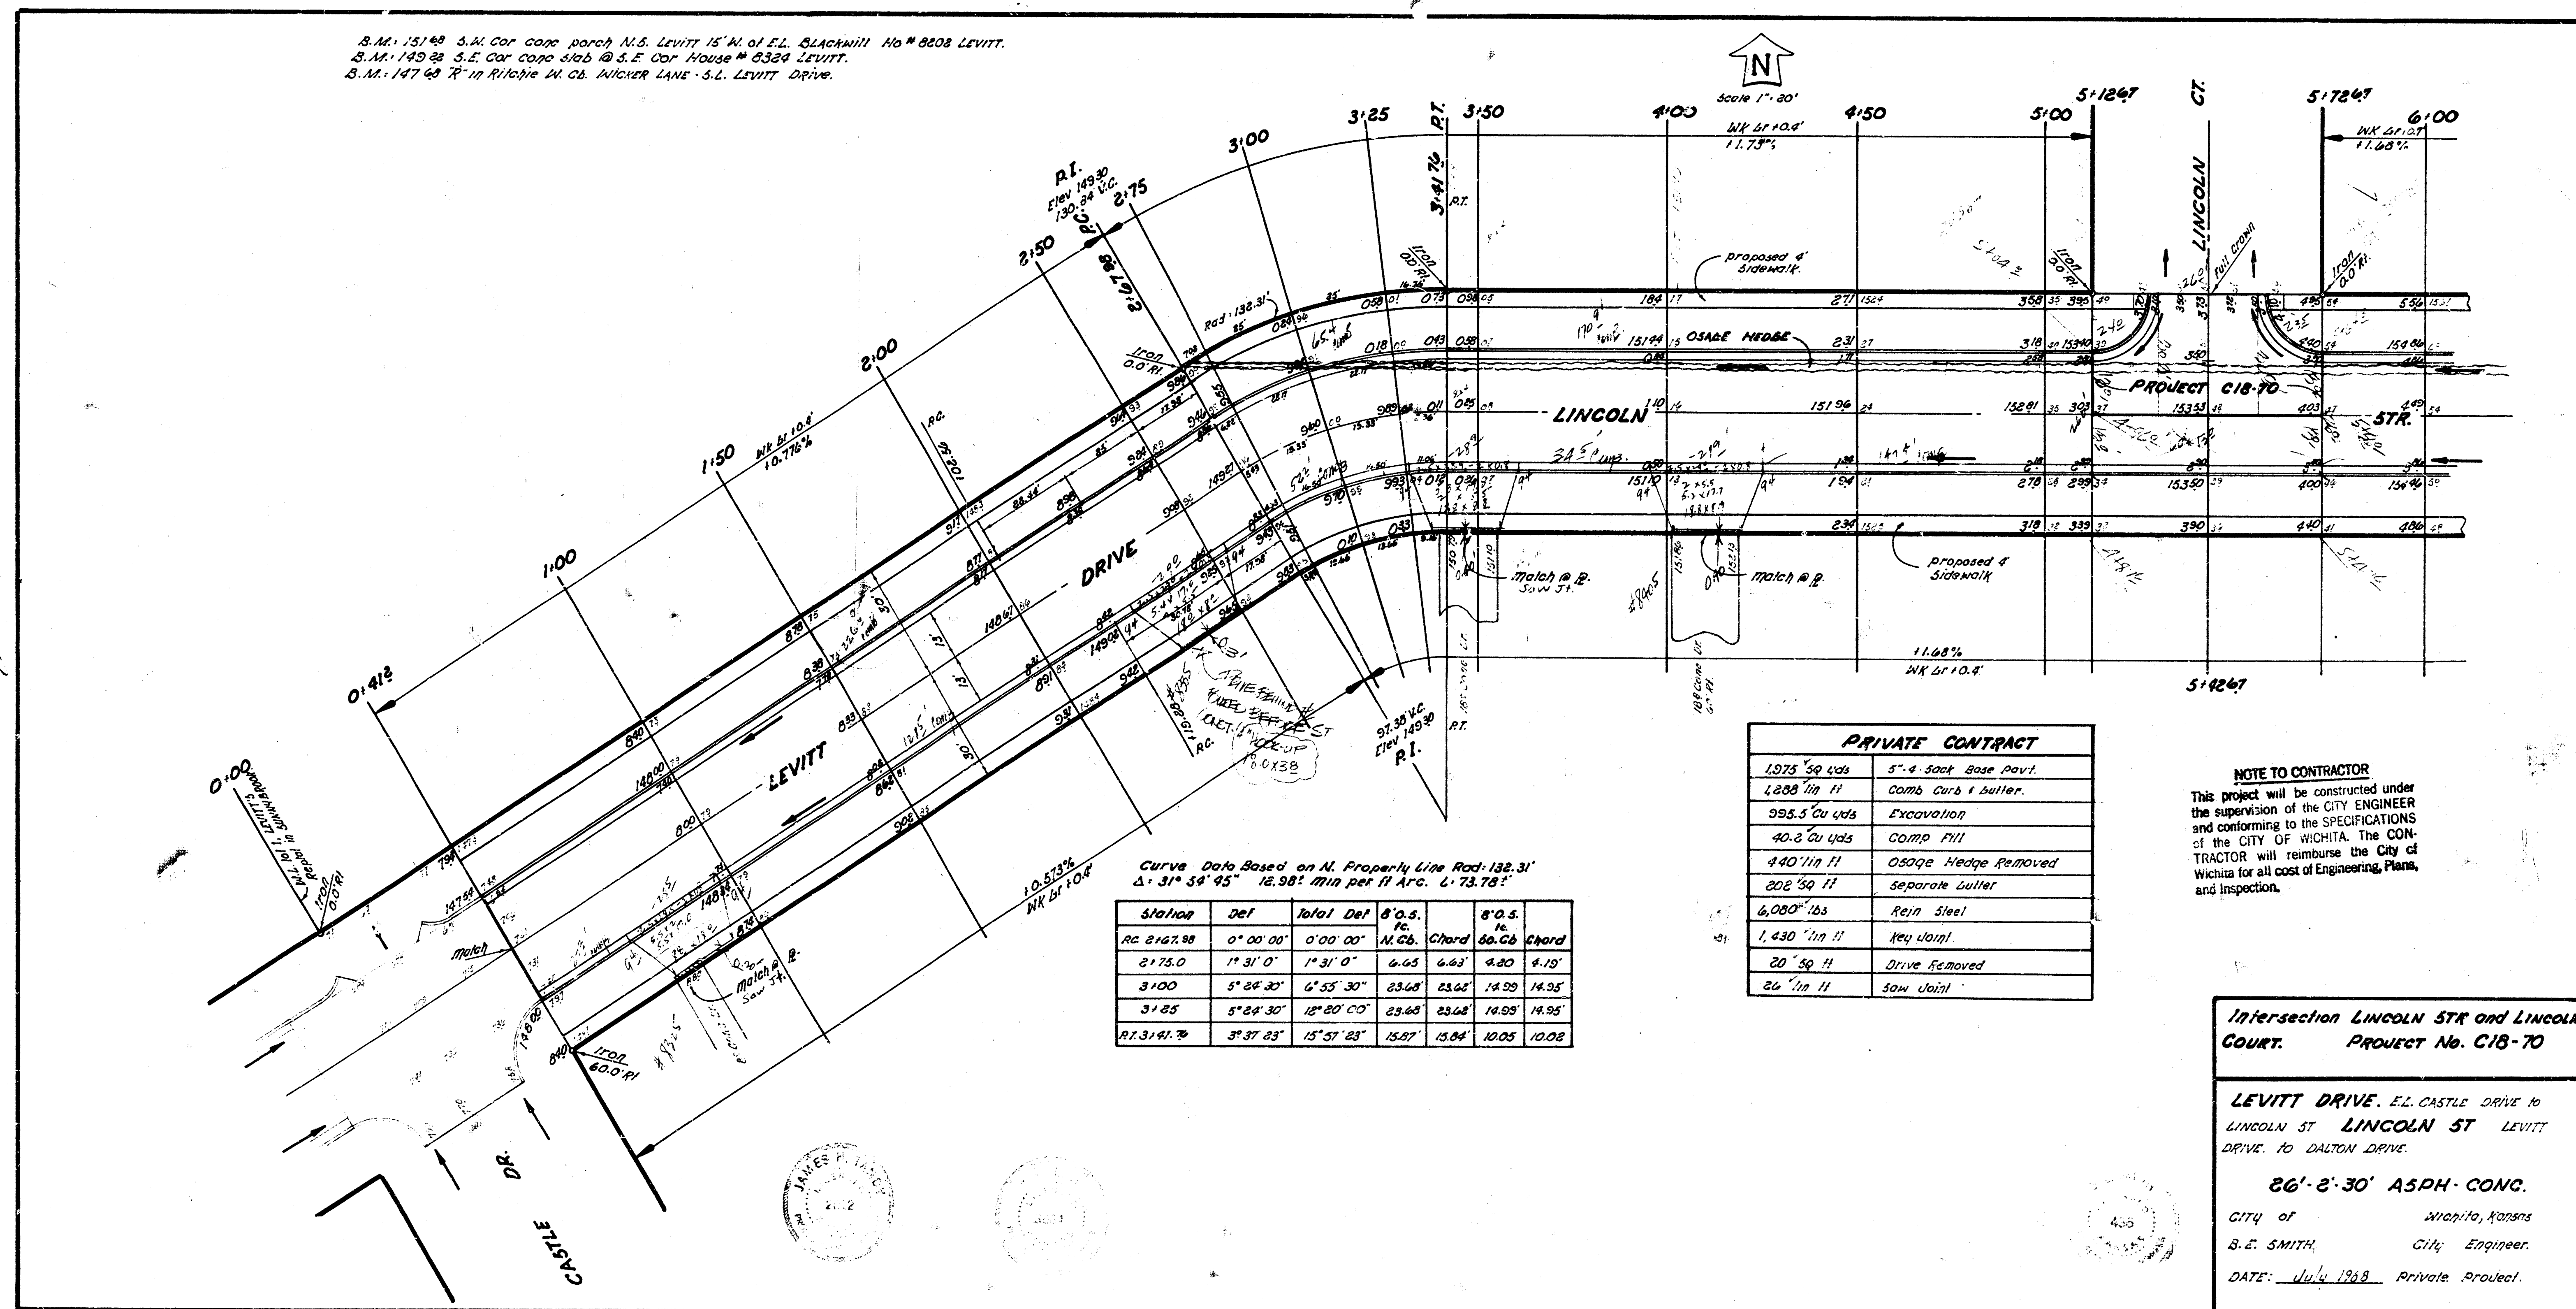

Curve Data Based on N. Property Line Rod-132.31'  
 Δ: 31° 54' 45" 12.98' Min per ft Arc. 4.73.78'

| Sta/100    | Def        | Total Def   | S.O.S. | P.C.  | Chord | S.O.S. | P.C. | Chord |
|------------|------------|-------------|--------|-------|-------|--------|------|-------|
| RC 2167.88 | 0° 00' 00" | 0° 00' 00"  | 11.68  | 6.62  | 4.80  | 4.19   |      |       |
| 2175.0     | 1° 31' 0"  | 1° 31' 0"   | 6.65   | 6.62  | 4.80  | 4.19   |      |       |
| 3100       | 5° 28' 30" | 6° 55' 30"  | 23.68  | 23.68 | 14.59 | 14.59  |      |       |
| 3125       | 5° 28' 30" | 12° 20' 00" | 23.68  | 23.68 | 14.59 | 14.59  |      |       |
| PT 3141.70 | 3° 37' 43" | 15° 57' 43" | 15.67  | 15.64 | 10.05 | 10.08  |      |       |

| PRIVATE CONTRACT |                         |
|------------------|-------------------------|
| 1575' 50 yds     | 5" x 4" Sock Base Pavt. |
| 1288' 119 ft     | Comb. Curb & Butler.    |
| 985.5' 20 yds    | Excavation              |
| 40.3' 20 yds     | Comp. Fill              |
| 440' 119 ft      | OSage Hedge Removed     |
| 202' 59 ft       | Separate Gutter         |
| 6,080' lbs       | Rein. Steel             |
| 1,430' 119 ft    | Key Vault               |
| 20' 59 ft        | Drive Removed           |
| 26' 119 ft       | Sow Joint               |

**NOTE TO CONTRACTOR**  
 This project will be constructed under the supervision of the CITY ENGINEER and conforming to the SPECIFICATIONS of the CITY OF WICHITA. The CONTRACTOR will reimburse the City of Wichita for all cost of Engineering, Plans, and Inspection.

**Intersection LINCOLN ST. and LINCOLN COURT.**  
**PROJECT No. C18-70**

**LEVITT DRIVE. E.L. CASTLE DRIVE TO LINCOLN ST. LINCOLN ST. LEVITT DRIVE TO DALTON DRIVE.**

**86' x 2' 30" ASPH. CONC.**

CITY of **Wichita, Kansas**

**S.E. SMITH** City Engineer.

DATE: **July 1948** Private Project.



