




Scale 1" = 10'

NOTICE TO CONTRACTOR & FIELD ENGINEER:=
Saw off existing curb and construct Intersection as shown with 7" Conc. Pavement
Tie wing steel to exposed steel in existing concrete pavement.
Grade Intersection so water will drain to creek.

NOTE TO CONTRACTOR
This project will be constructed under the supervision of the CITY ENGINEER and conforming to the SPECIFICATIONS of the CITY OF WICHITA. The CONTRACTOR will reimburse the City of Wichita for all cost of Engineering, Plans, and Inspection.

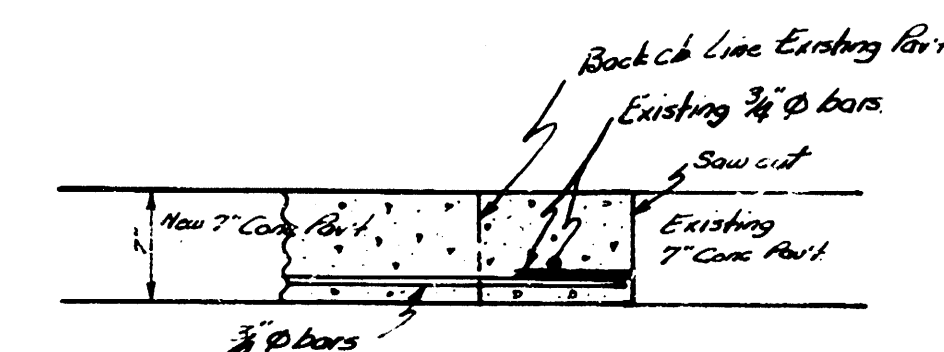

STEEL TIE DETAIL
No Scale.

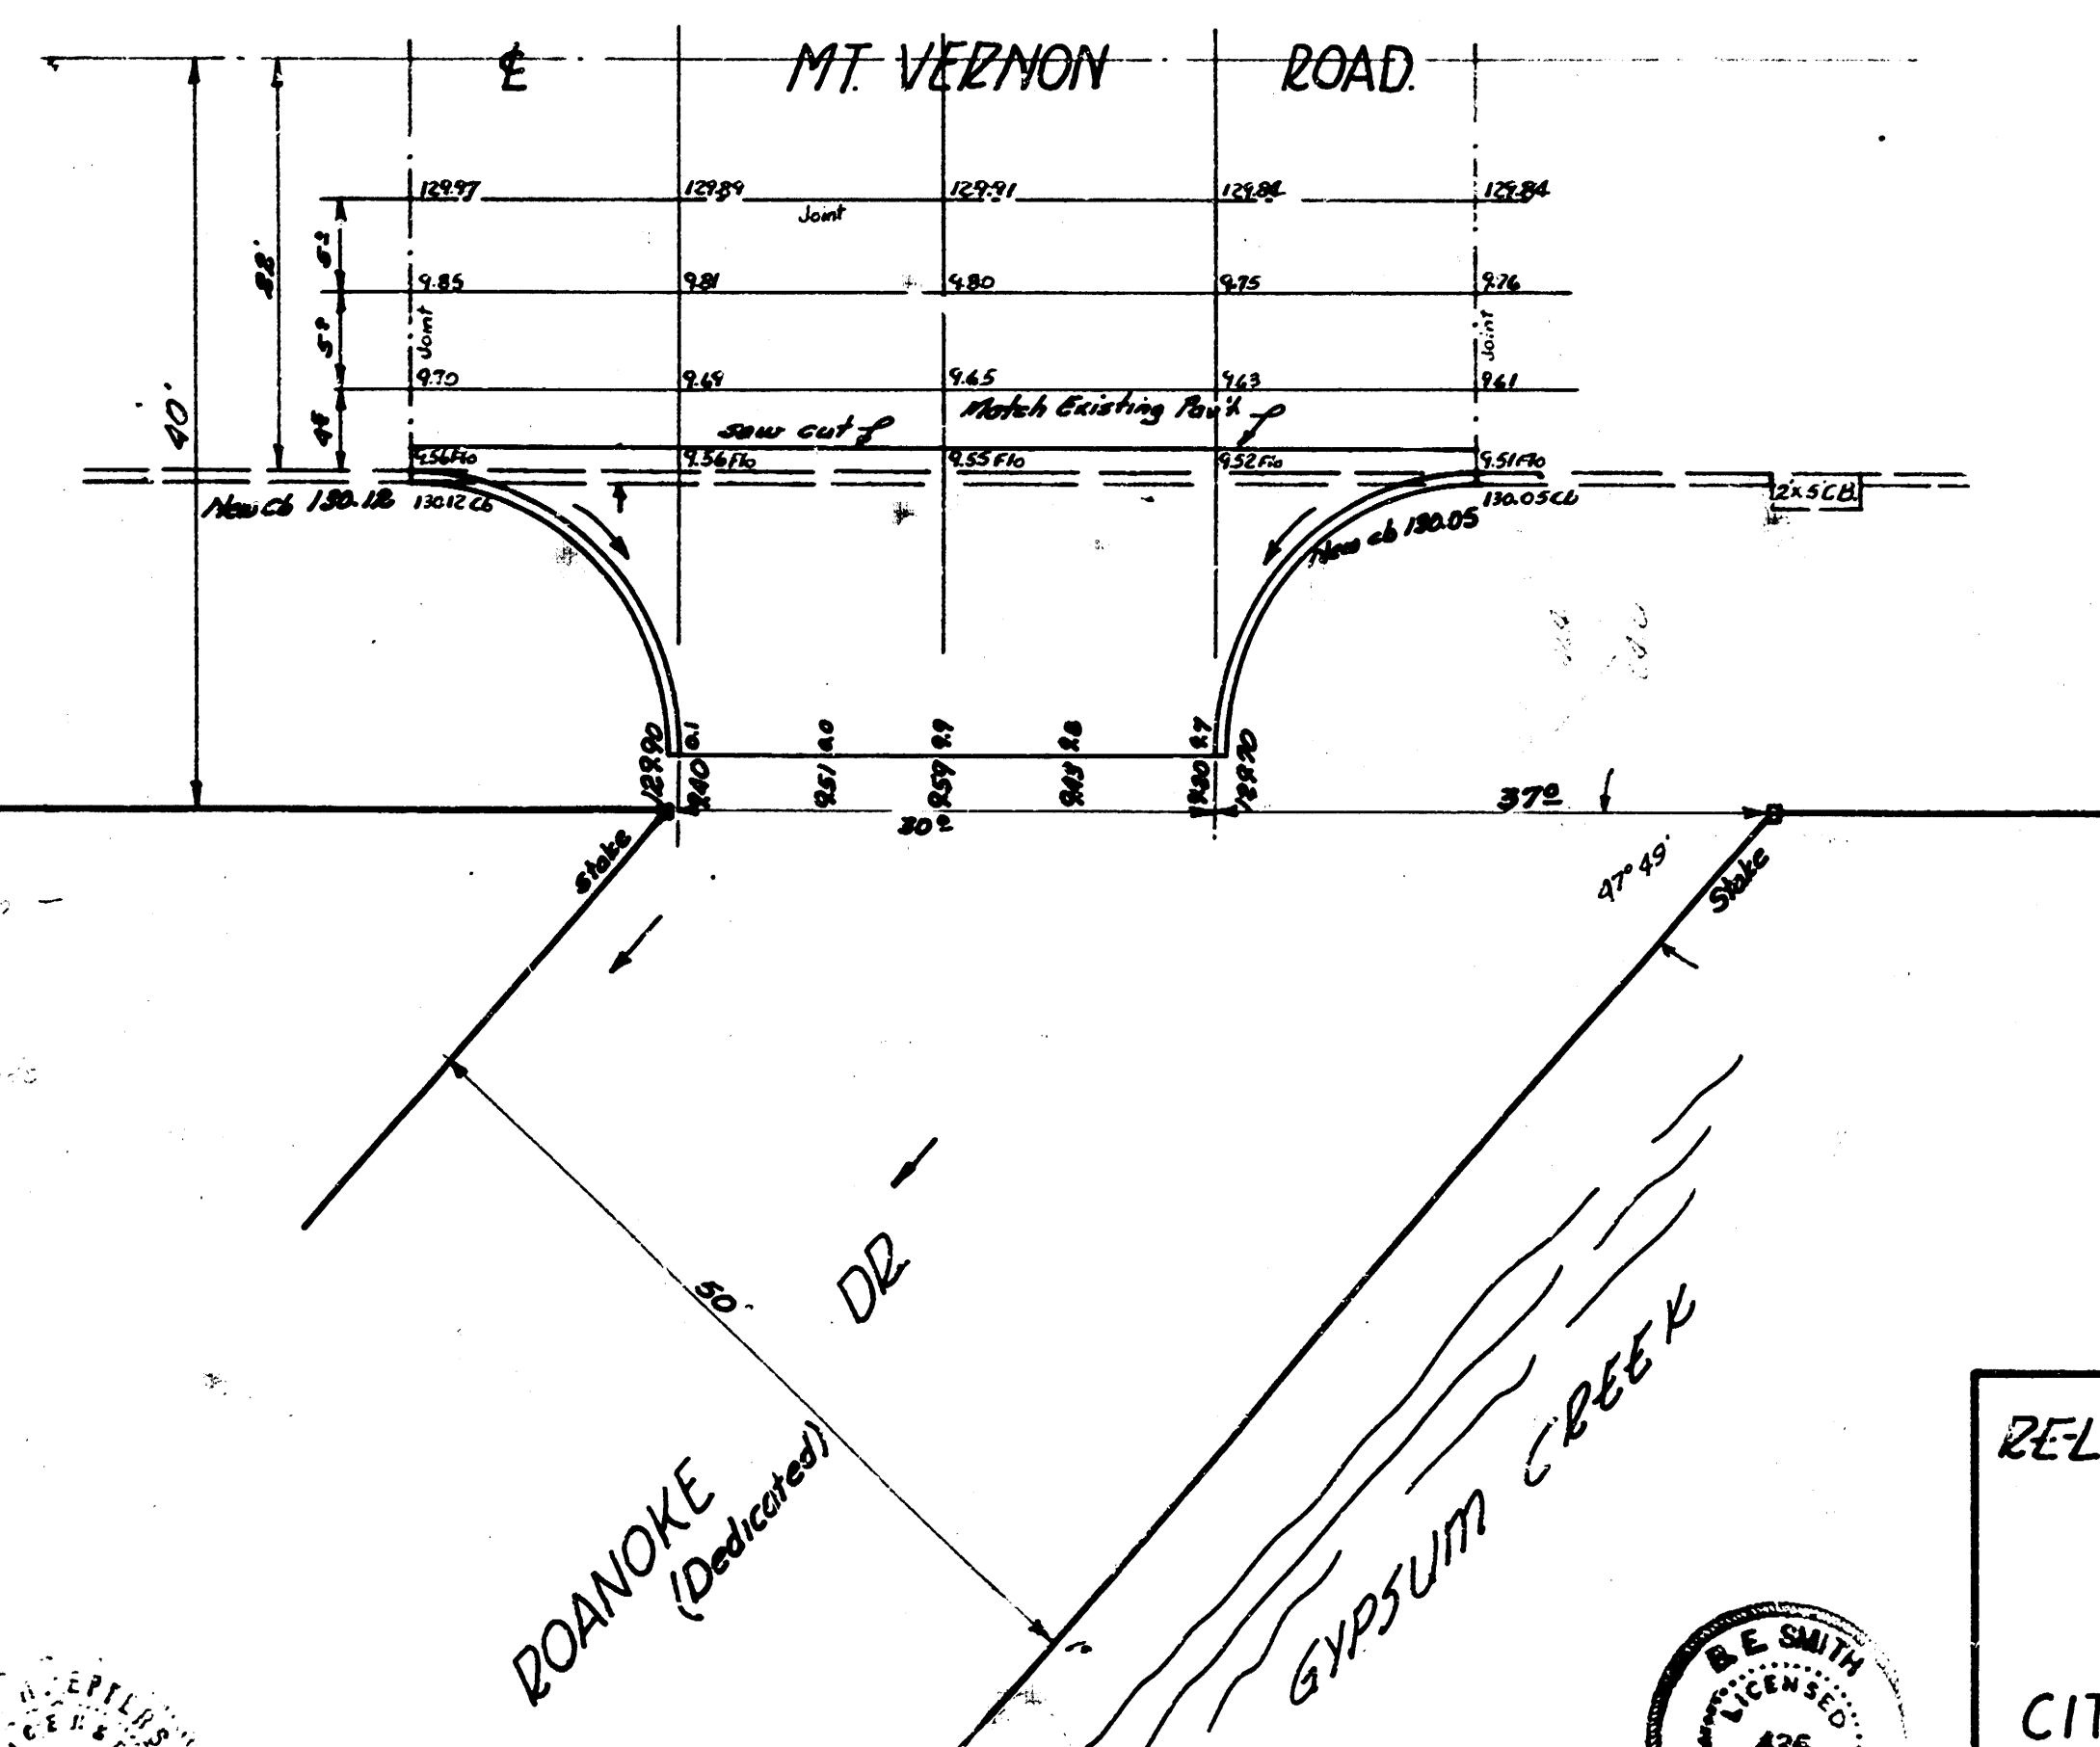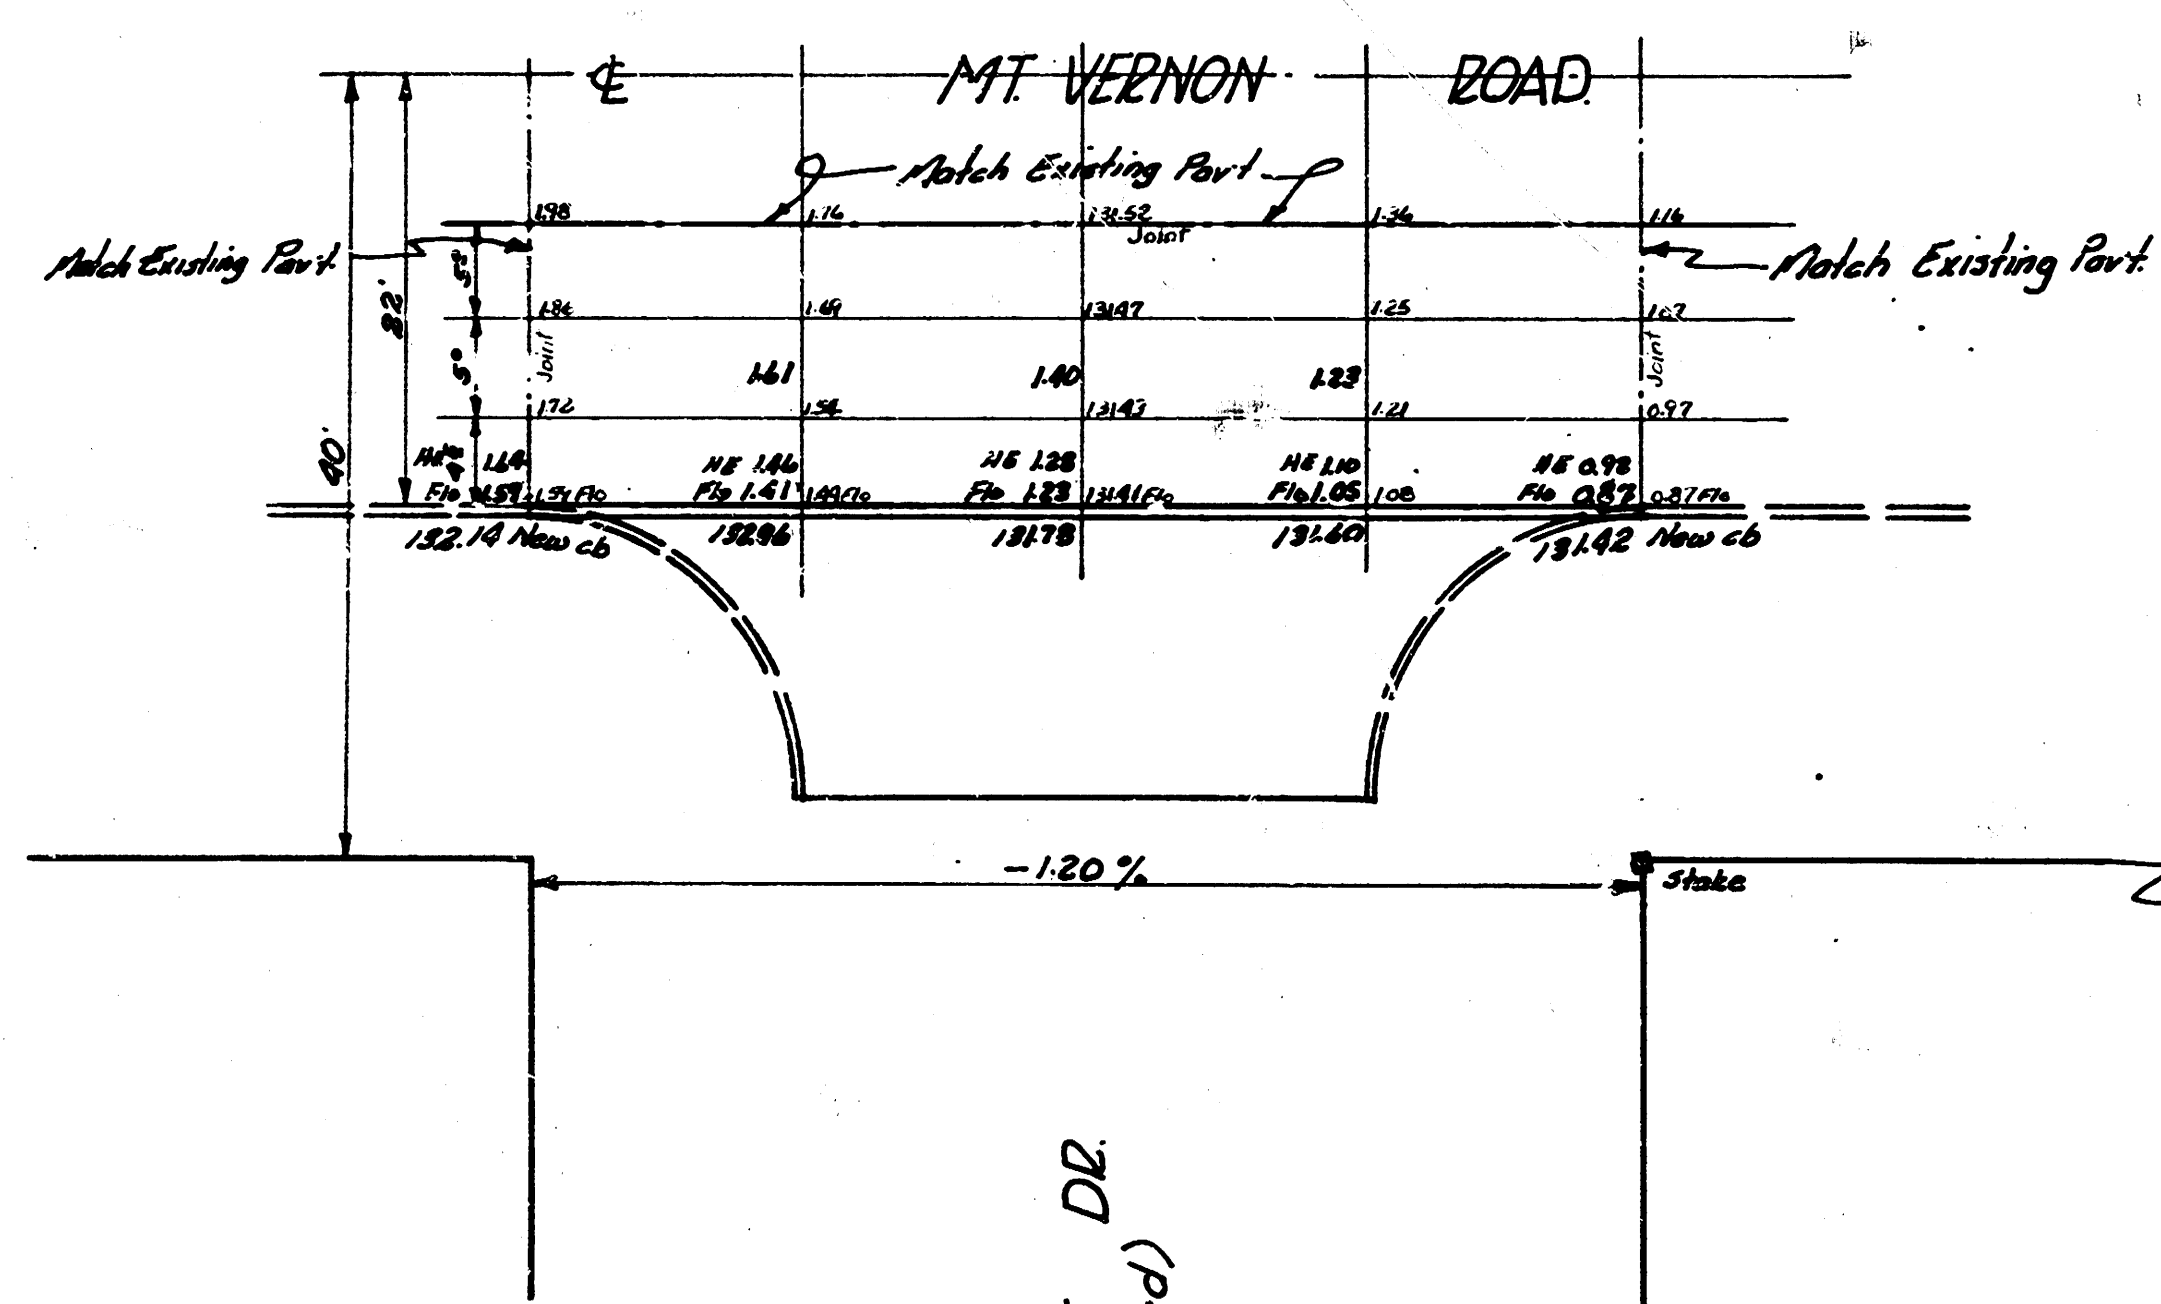

NOTE TO CONTRACTOR
This project has been awarded under the provisions of the PROFESSIONAL ENGINEER and SURVEYOR ACT, REGULATIONS of the PROFESSIONAL ENGINEERS and SURVEYORS of the PROVINCE of ONTARIO, and the CONTRACT is subject to the City of Windsor by a cost of engineering, Plans, and Inspection.

There are many ways to find out about the services and products of the American Institute of Chemical Engineers. Write to the American Institute of Chemical Engineers, 1430 Broadway, New York, NY 10018-1502.

RELOCATION OF INTERSECTION
ROANOKE & MT. VERNON
7th Conc & Ch
CITY OF WICHITA, KANSAS.
B.E. SMITH CITY ENGINEER
PRIVATE JOB.