


NOTE:
ALIGNMENT FROM OUTFALL TO
M.H. STA 0+80 TO BE VERIFIED
BY FLOOD CONTROL IN THE FIELD
PRIOR TO CONSTRUCTION

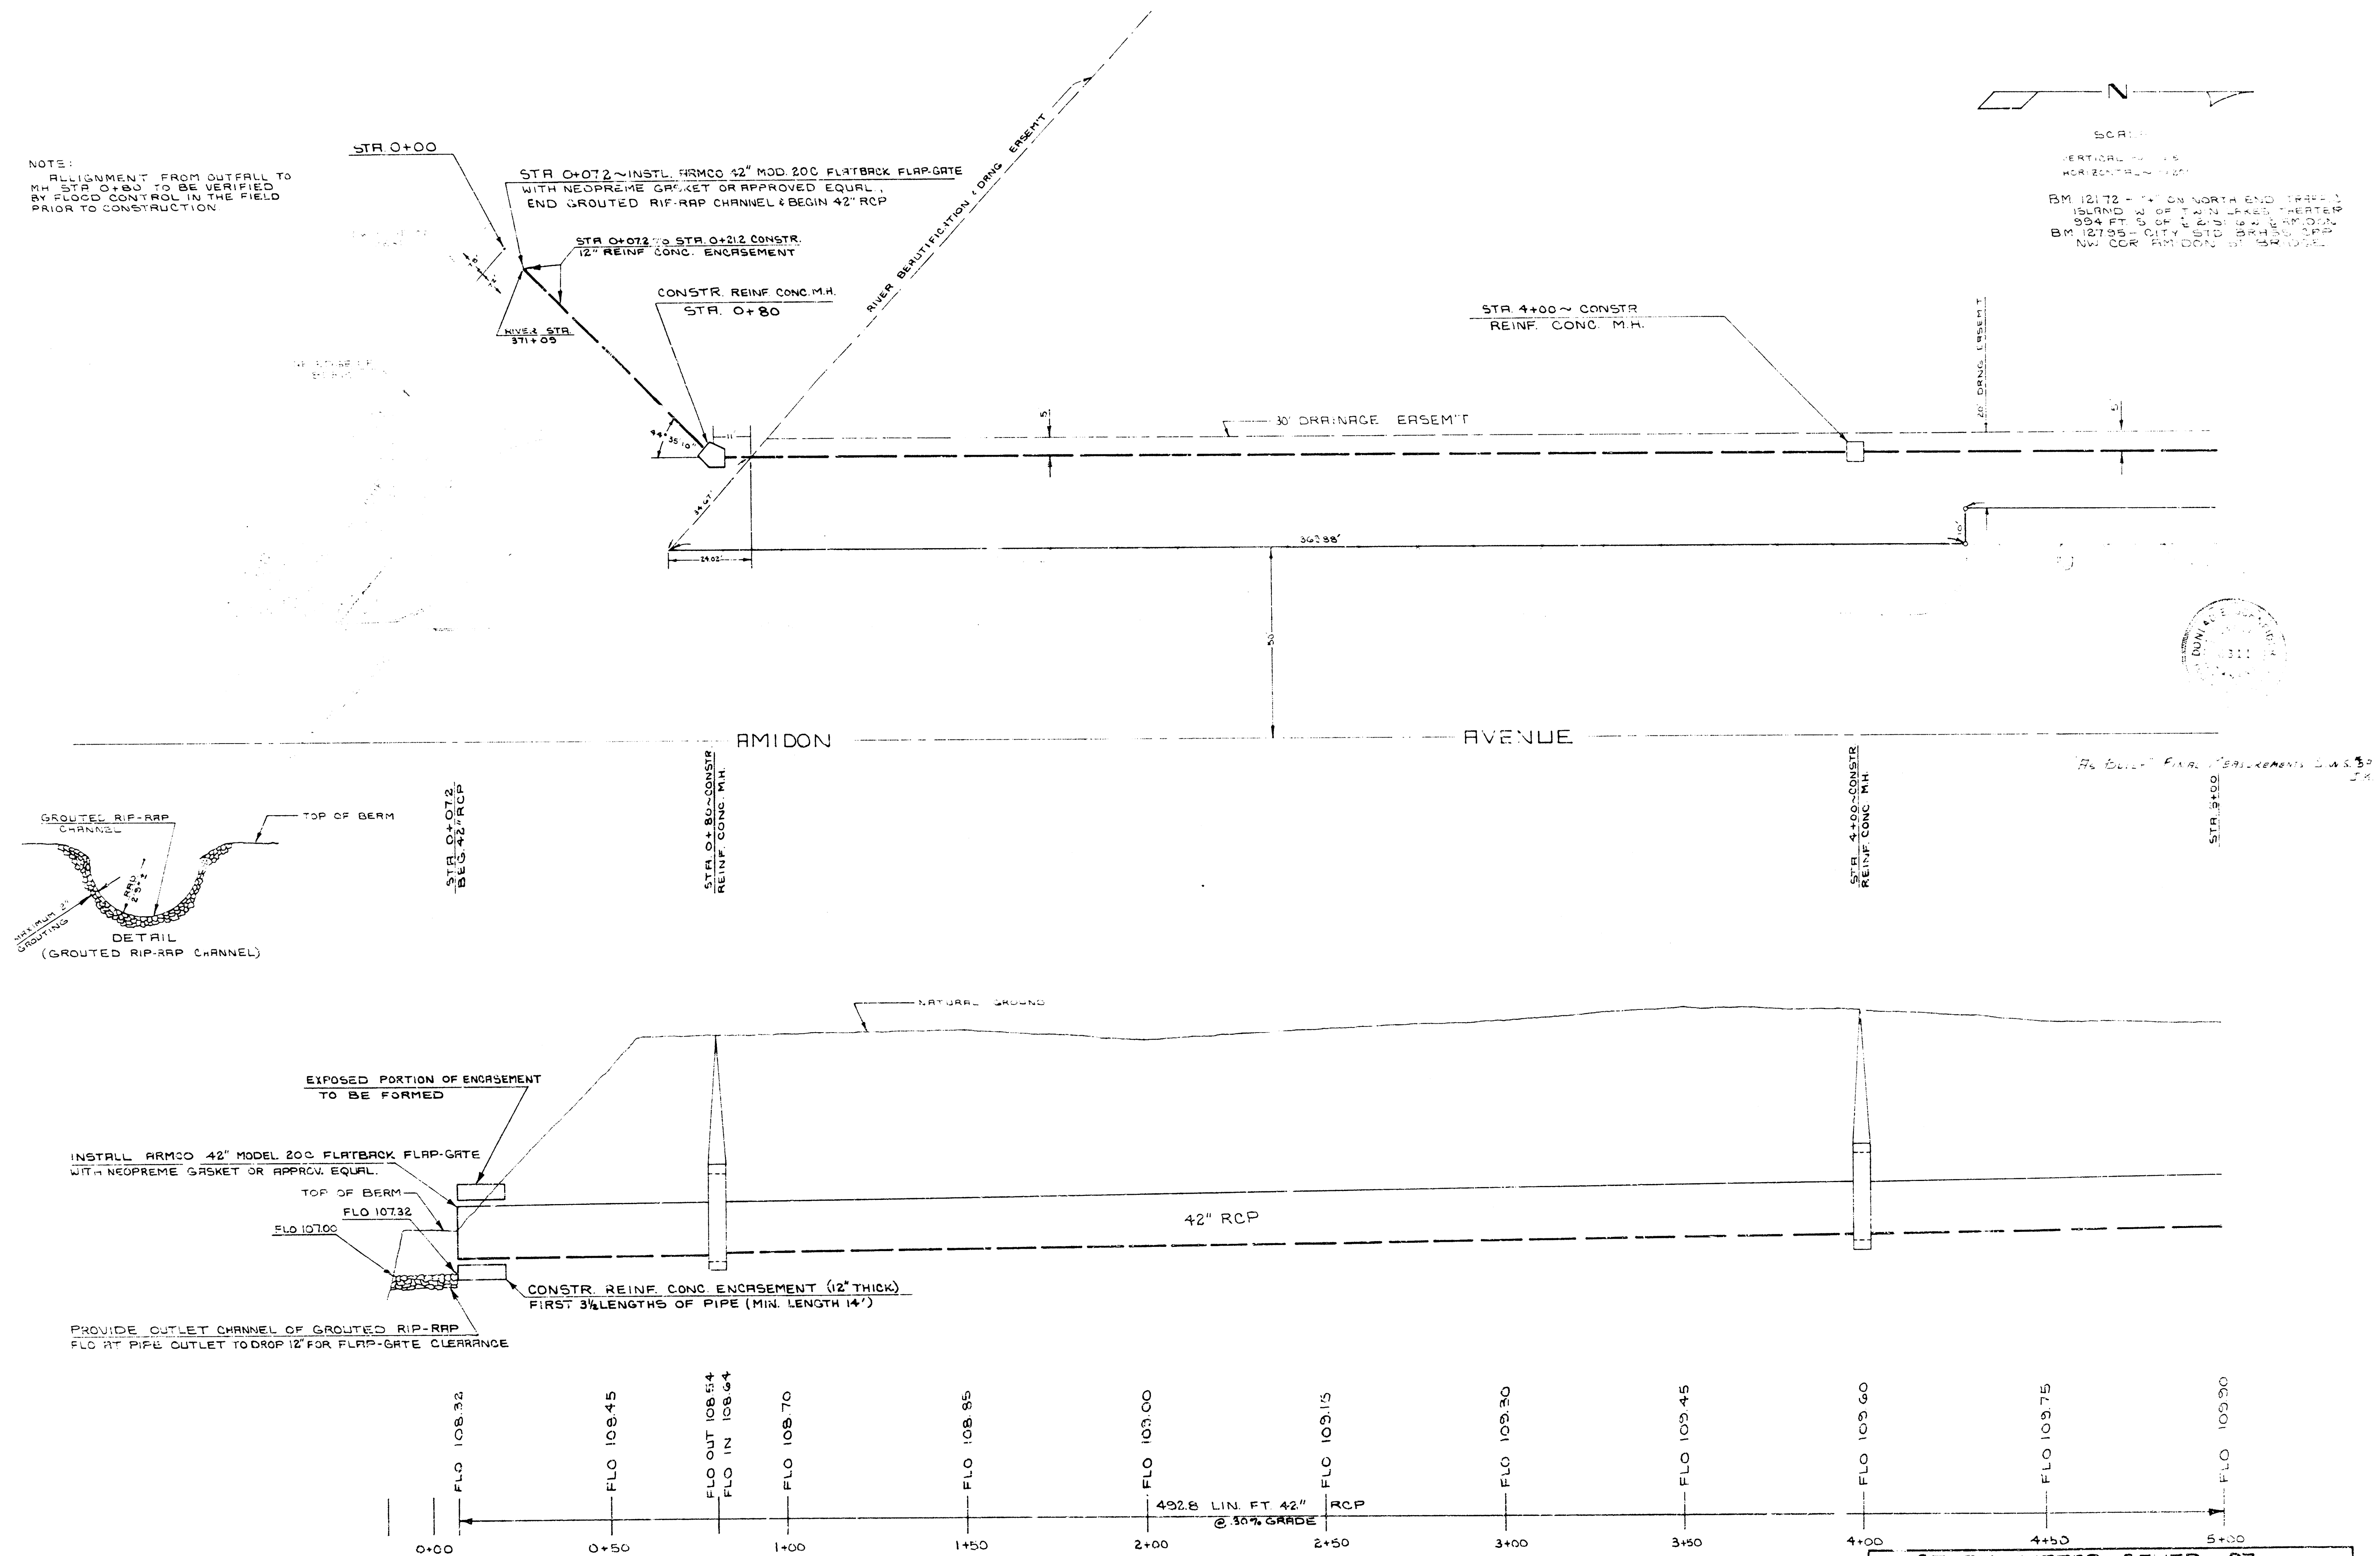

N

SCALES
VERTICAL 1" = 4'
HORIZONTAL 1" = 40'
BM 12172 - 1" ON NORTH END (TRF-1)
156' 0" W. OF TAN. ROAD INTERP.
954 FT. S. OF FLO 108.85
BM 12735 - CITY BLD. BRK. 50' OFF
NW COR. RM. CONC. ST. BRIDGE

PL. 00117 F.A.R. "BRIDGE" 10.8.50

1/3

STORM WATER SEWER 97
CITY OF WICHITA
R.W. LINN - CITY ENGINEER
DATE 10/12/97 PROJECT NO. 08A-5702

