


STORM WATER SEWER NO. 99

CITY OF WICHITA, KANSAS

R.W. LINN, CITY ENGINEER

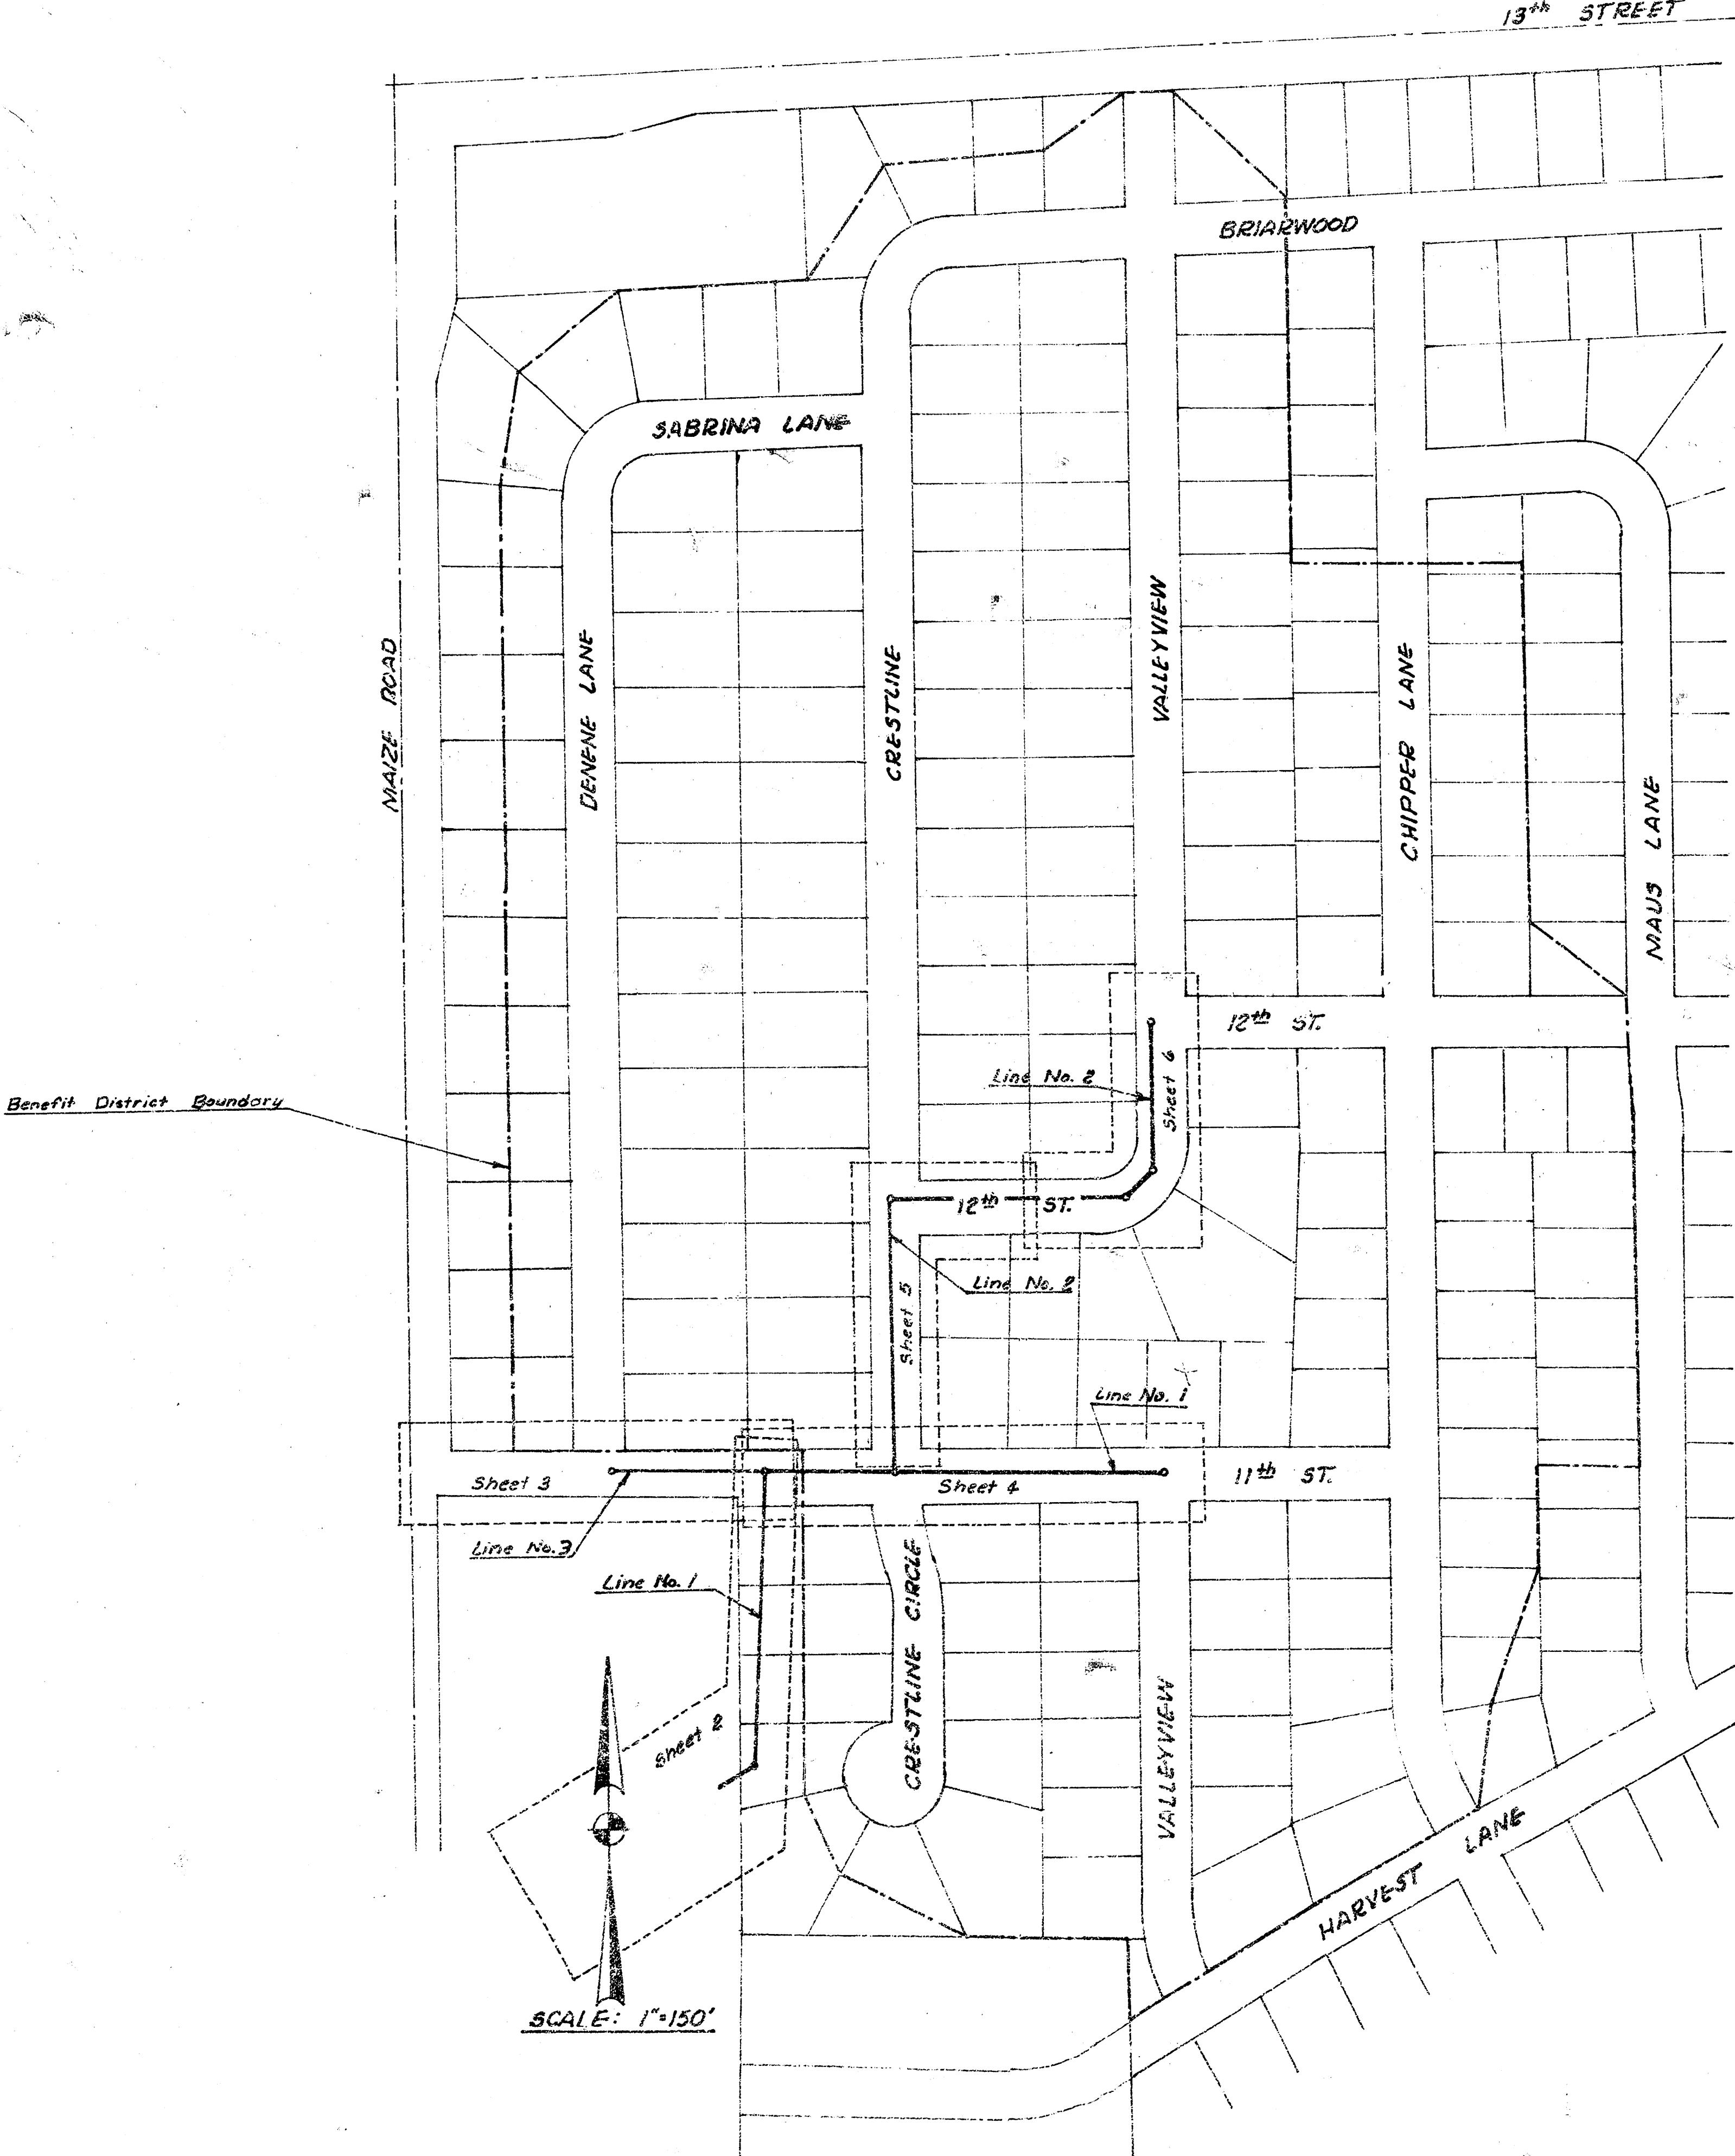

At Lino
943-3645
943-0154

PROJECT NO. DBKA 572071
DATE: May 1st 1973

As Built, Final Meas
K-110

B.M. 152.283 City Rd. on Maple Rd.
1/2 mile S. of 13th Street; 32.0' N.
of 38.0' E. of 1/4 Sec. Cor.

SEEDING: All disturbed areas south & west of Sta. 14+00 to be seeded in accordance with Kansas State Highway 1944 Standard Specifications using mixed native grass seed and prairie hay mulch. Seed shall be applied at 30 lbs. per acre and fertilizer at 300 lbs. per acre. Fertilizer shall contain 12% Nitrogen, 12% Phosphate and 12% Potassium. Cost for seeding, mulching and other appurtenant work to be paid for as per acre bid for "Seeding."

Remove and replace fence in line as required for construction.
(3 strand barbed wire fence)

Iron Pin Sta. 10+89.7 (32.5' S. of N.E. Cor. of unplatted tract)

SCALE:
Hor. 1"=20'
Ver. 1"=5'

Iron Pin @ NW Cor. Lot 1, 81x5 Westlink 10th Add'n (10' S. of N.E. Cor. of unplatted tract.)

Construct approx. 150 L.F. temp. "V" channel with 1:1 side slopes to drain pipe until R/W is acquired. Contractor to erodible channel upon completion of Storm Water Sewer.

Construct 8' bottom ditch with all sides

Fill an area 30' x 30' x 2' deep with broken concrete. This to be paid for at price bid per sq. yd. for dumped rip-rap.

NOTE: All excess excavated material from this project to be stockpiled at locations within Westlink Village 10th Add'n or unplatted tract as determined by Engineer.

NOTE: Engineer to cross-section earthwork areas before and after construction for quantities.

MANHOLE @ 11+07.3 Type I
Scale: 1/8"=1'-0"

STD. 2'x5' INLET @ 14+24.83
Scale: 1/8"=1'-0"

Channel Excavation = 520' C.Y. + 10% = 572 C.Y.
* Note: Includes 140 C.Y. for temp. channel

No Sewer Construction unless easements are obtained

Construct 10' min. cover over pipe.

Existing Ground

Line No. 1

383.33' of 36" RCP @ +0.14%

NO WORK IN THIS AREA UNLESS EASEMENTS ARE OBTAINED

Existing Ground

Ditch Flowline @ +0.1%

160
155
150
145
140

For Typical Section, See Sheet 6
Manhole Depth = 2.50'

MANHOLE @ Sta 12+50 Type II
Scale: $\frac{3}{8}" = 1'-0"$


SCALE: HOR. 1"=20'
VER. 1"=5'

441.33


PROJECT NO. DBKA 572071
Sheet 3 of 3

STORM WATER SEWER #99

DLK 120
Aug
Wor

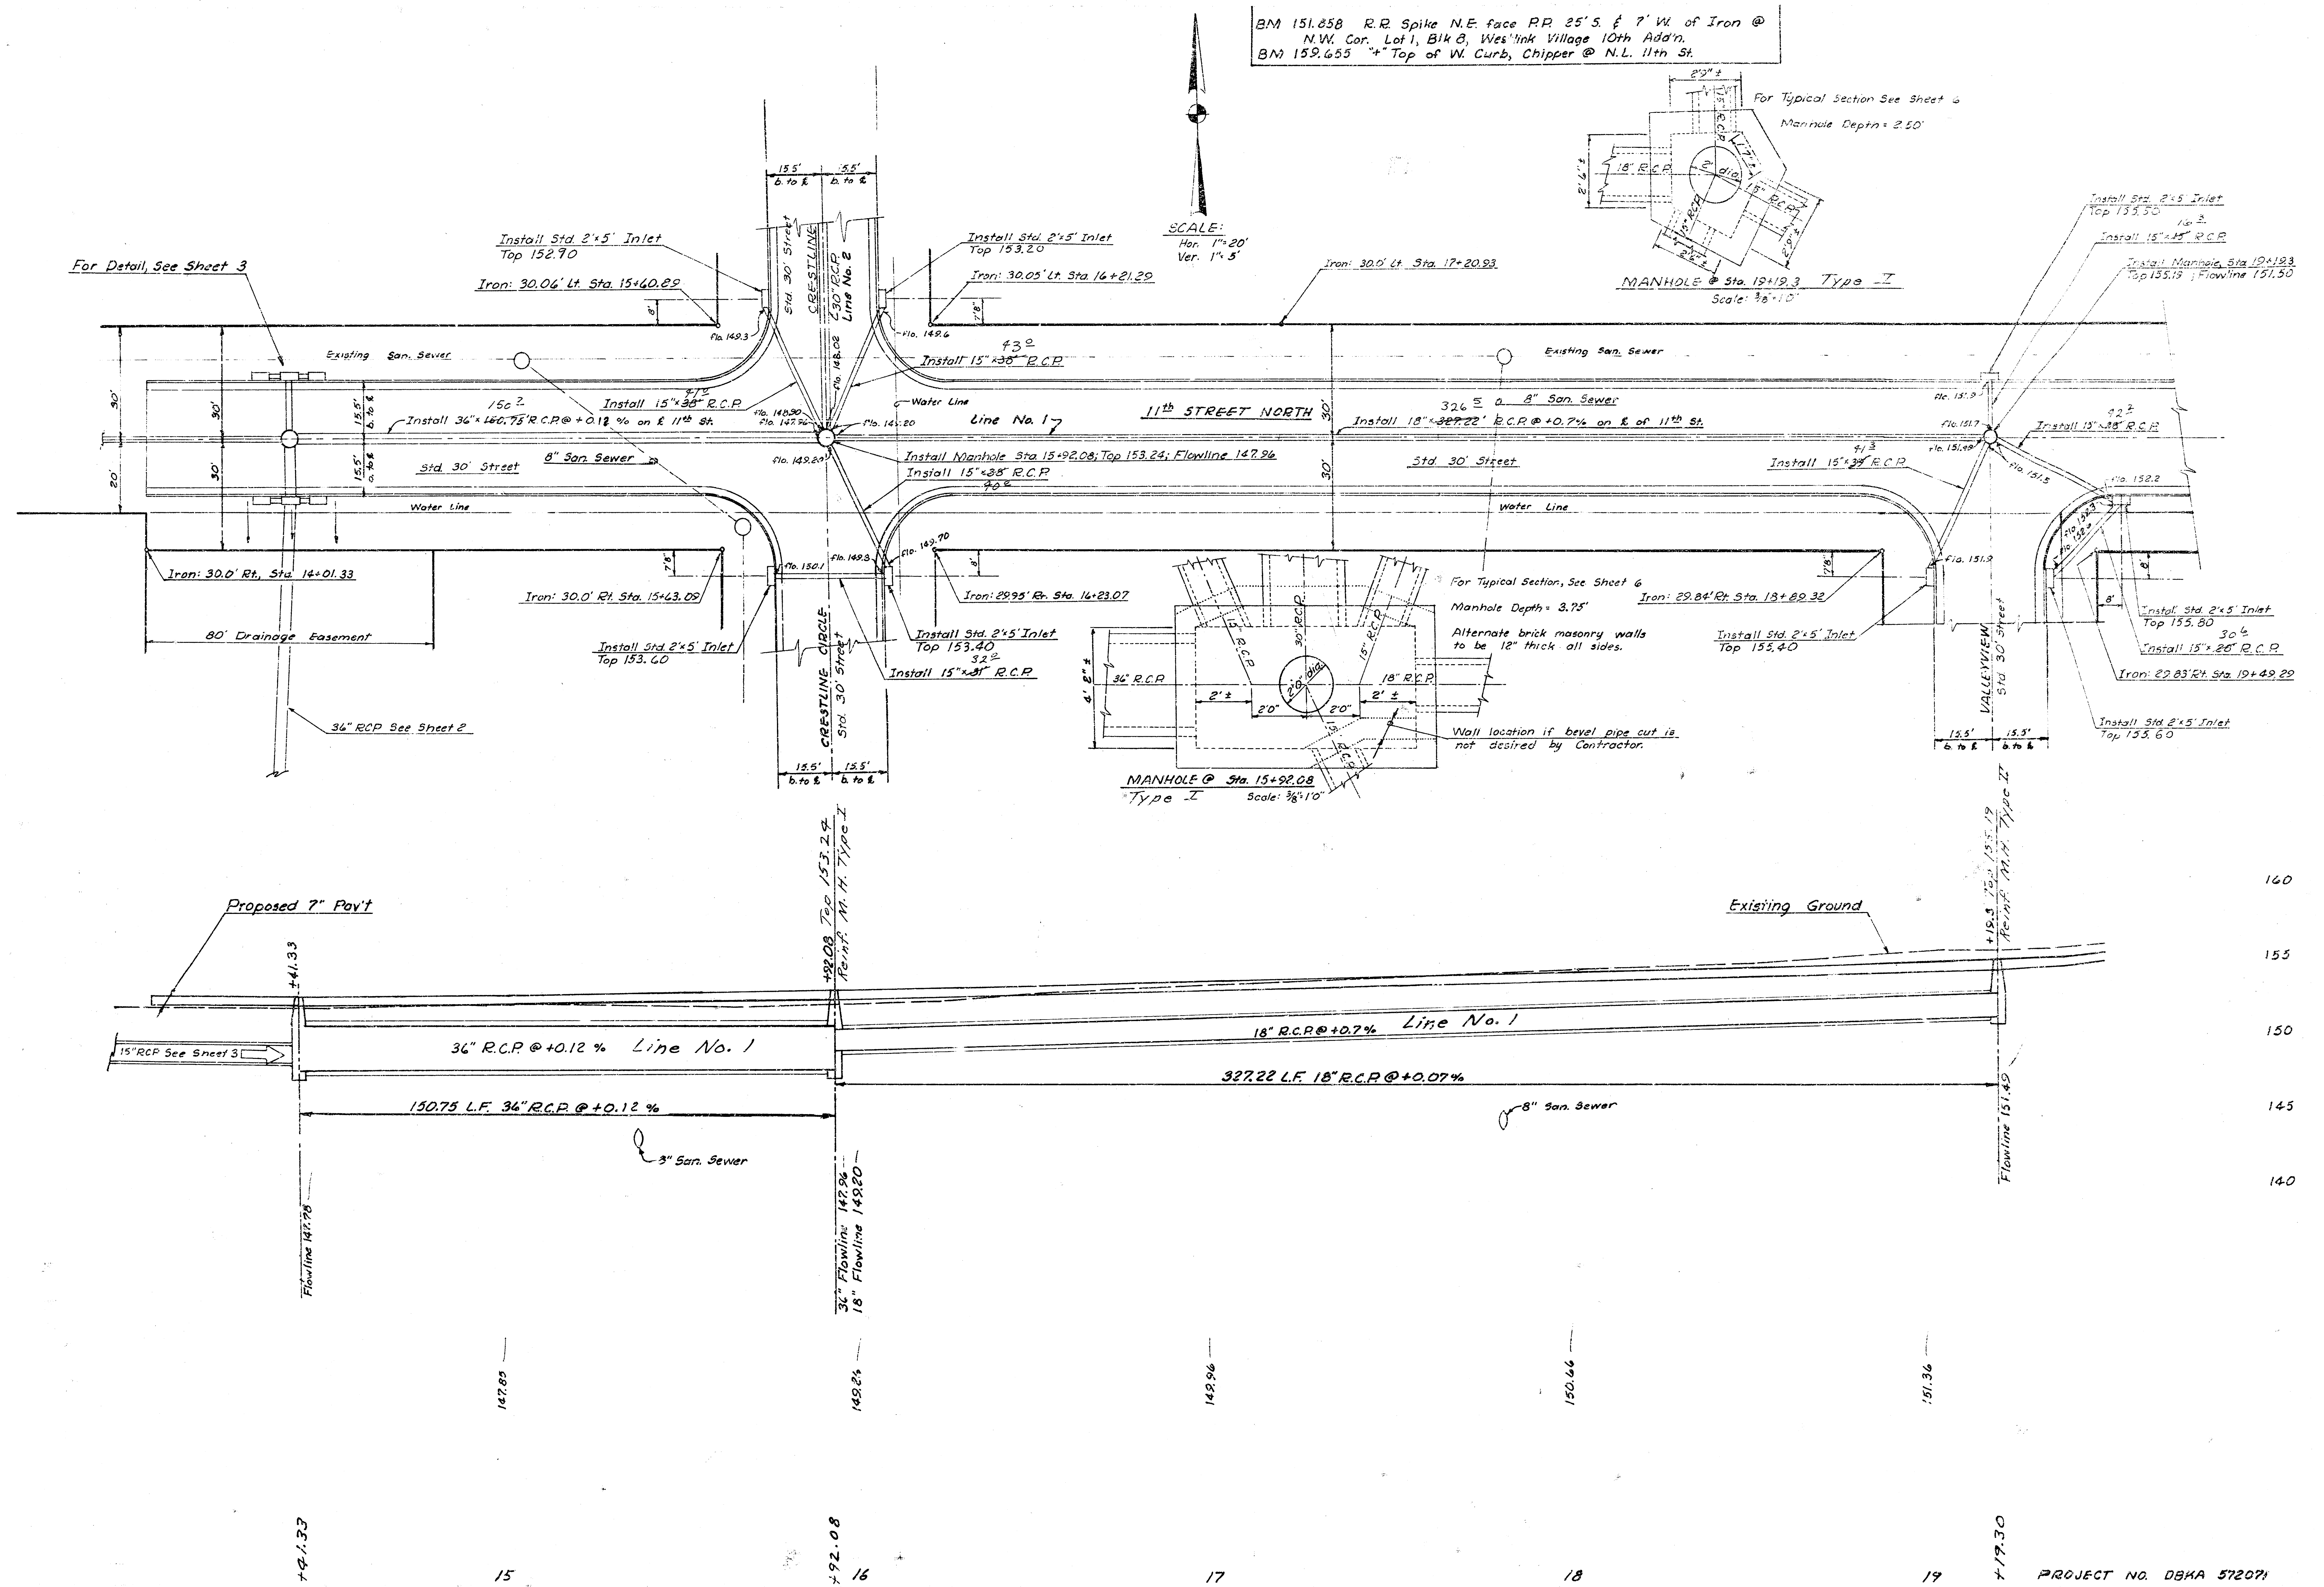

S.M. 151.858 R.R. Spike N.E. Face RR 25' S. & 7' W. of Iron @ N.W. Cor. Lot 1, Blk. 8, Westlink Village 10th Add'n.

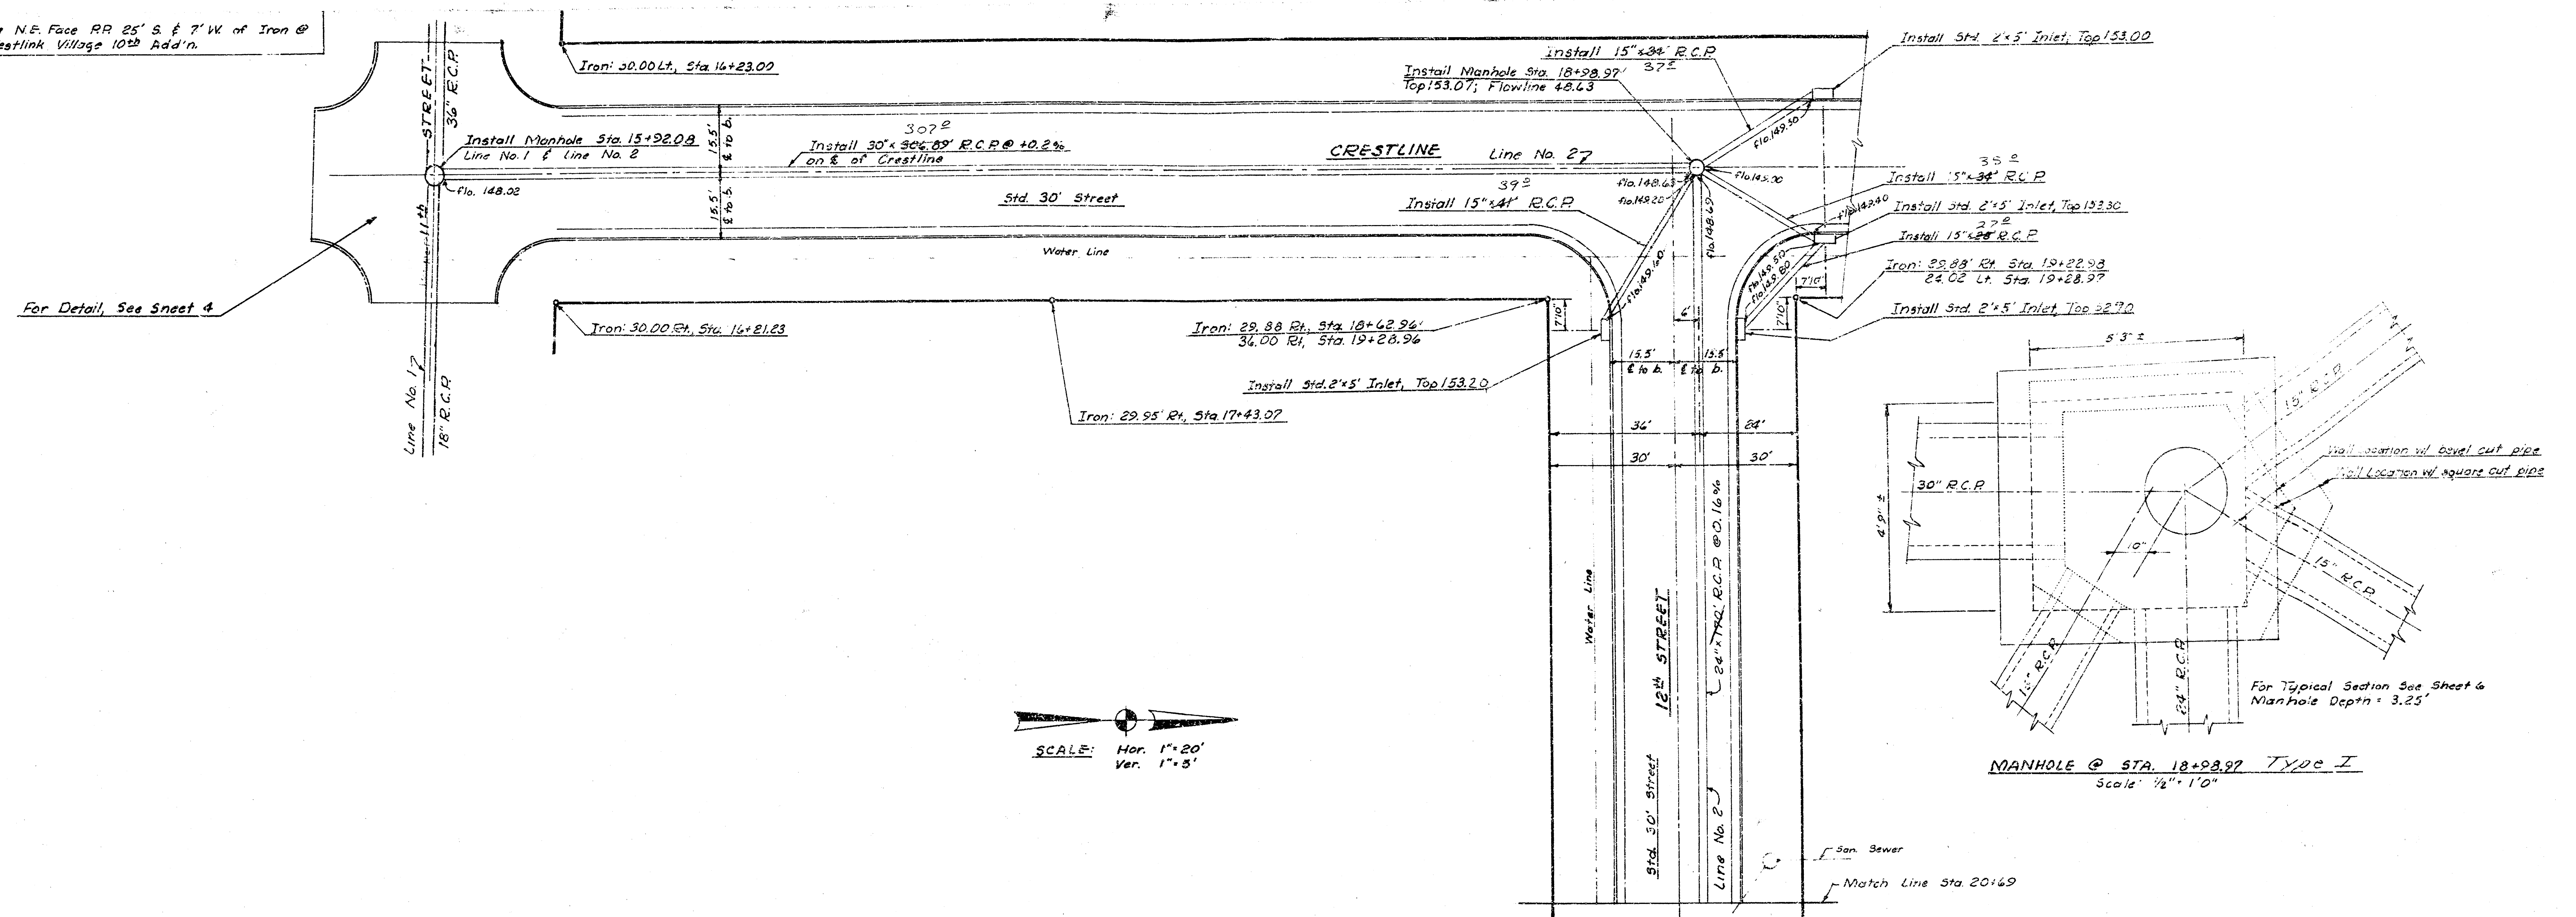

SCALE: Hor. 1" = 20'
Ver. 1" = 5'

