

CHERRY CREEK HILLS




DATE: _____


STORM WATER SEWER NO. 104
Project No. DBKA 573022

Sheet 1 of 4



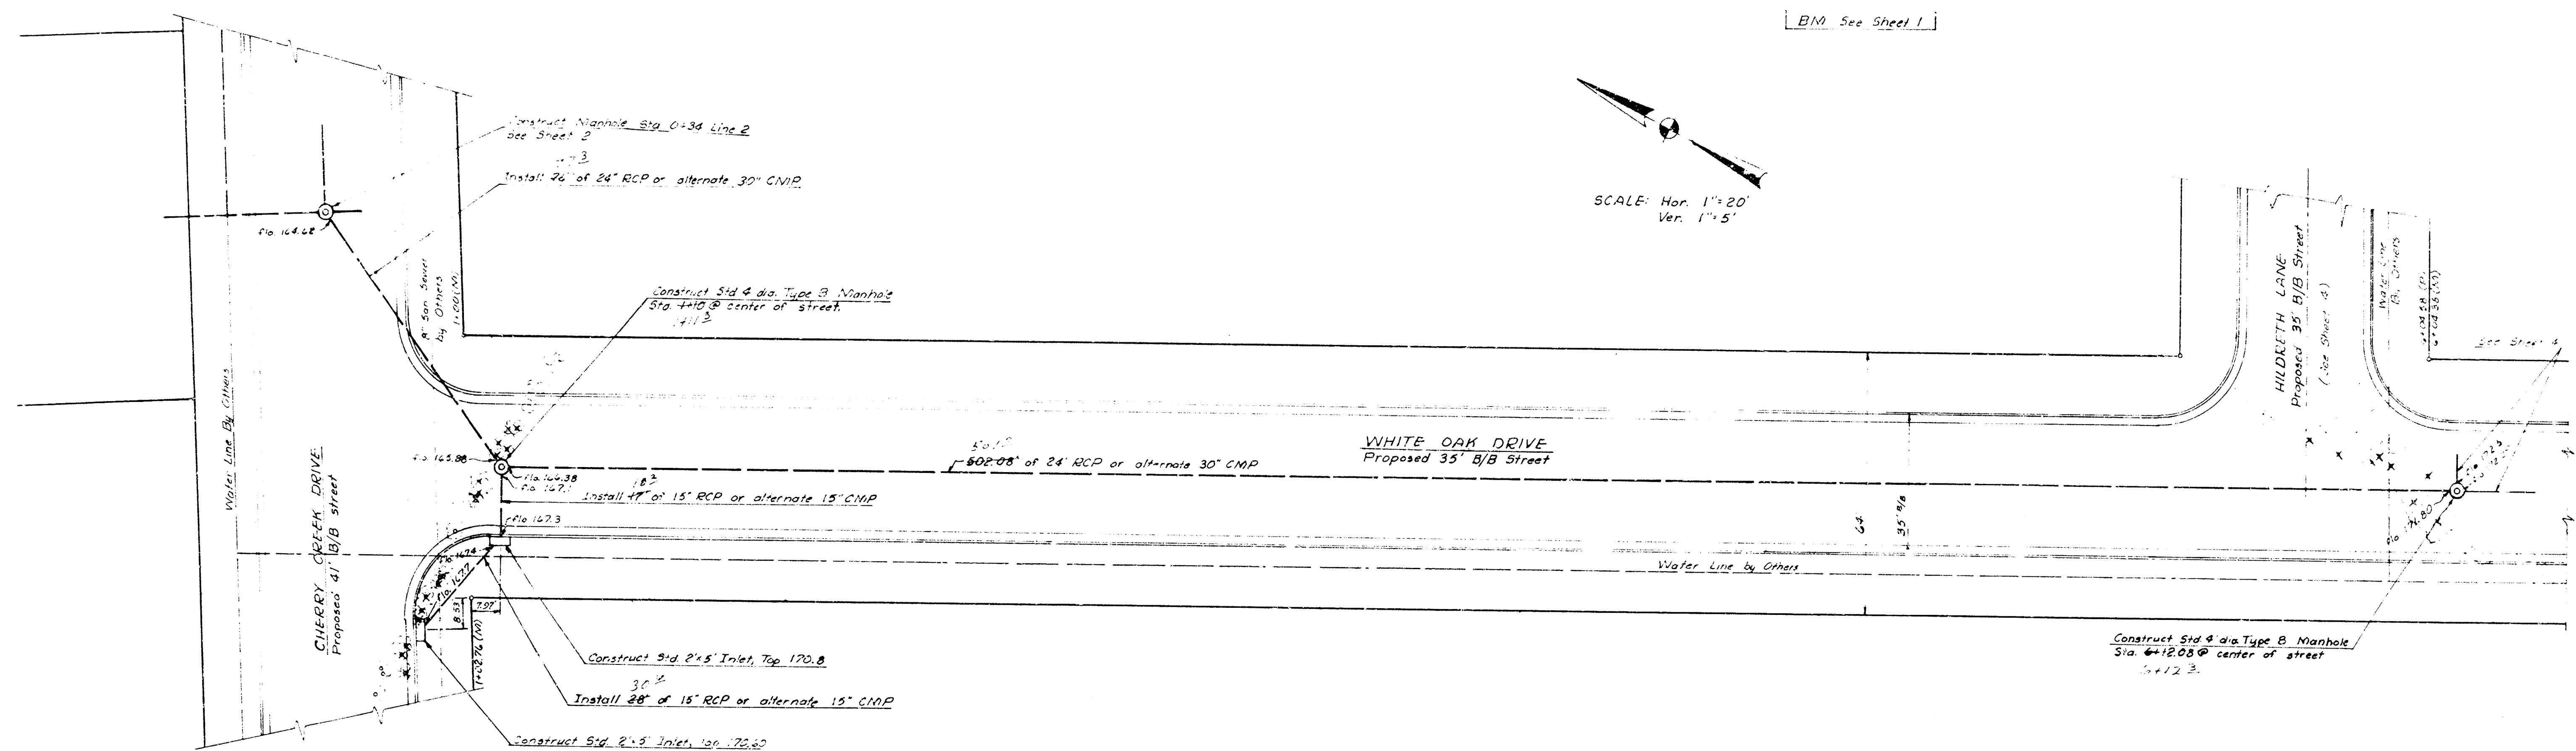

Sewer Sta = Street Plan Sta + 100'

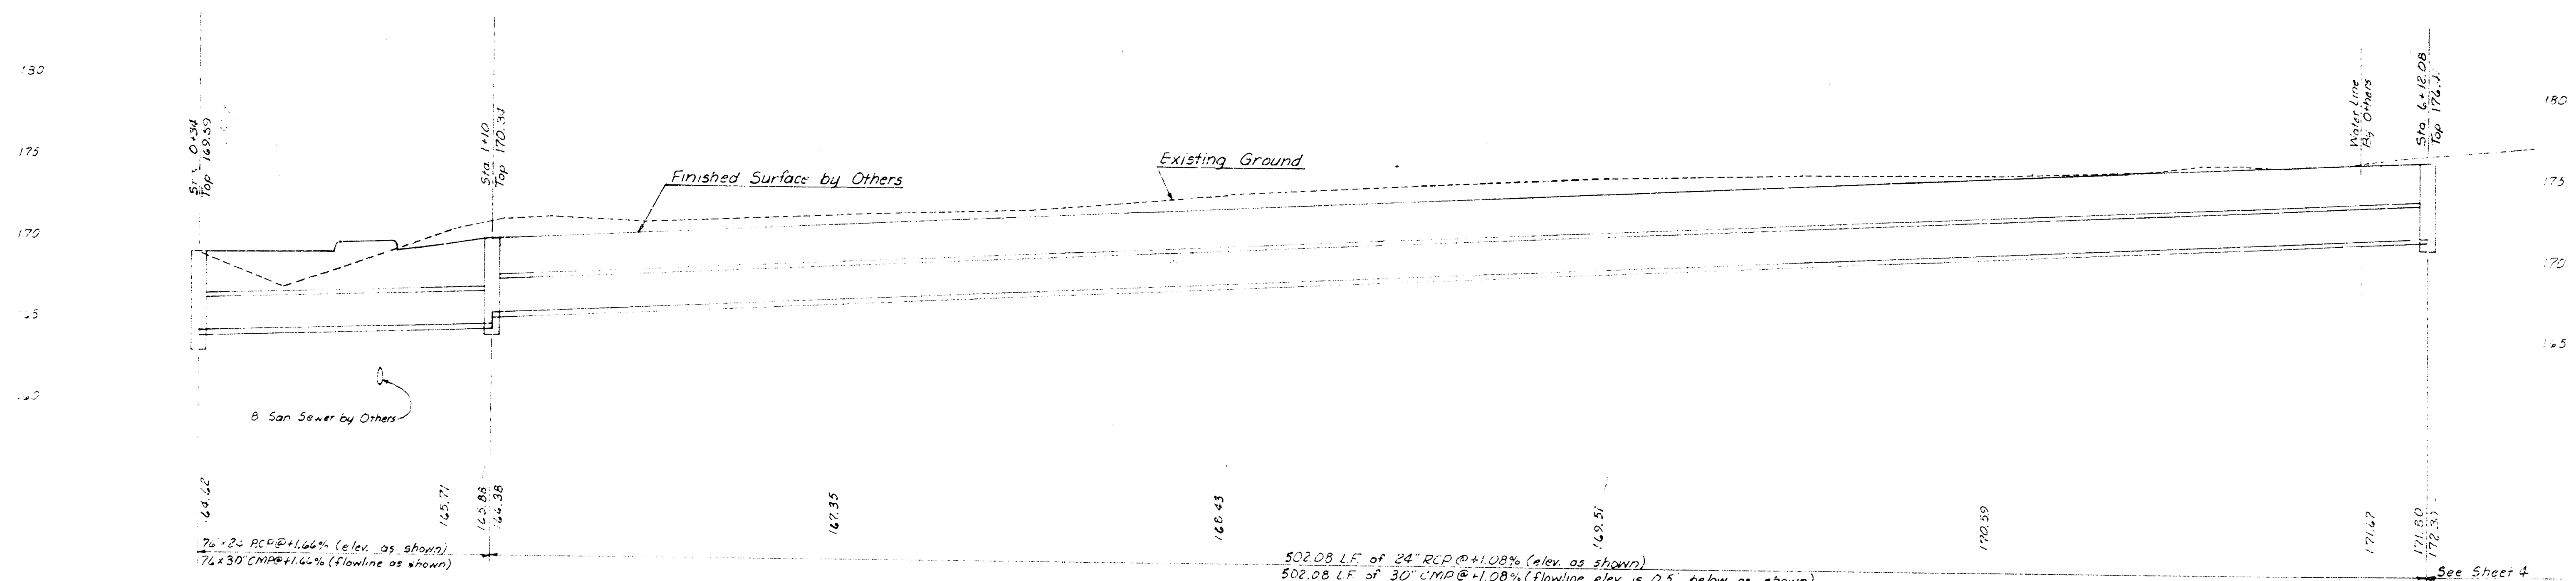

LINE 2

