

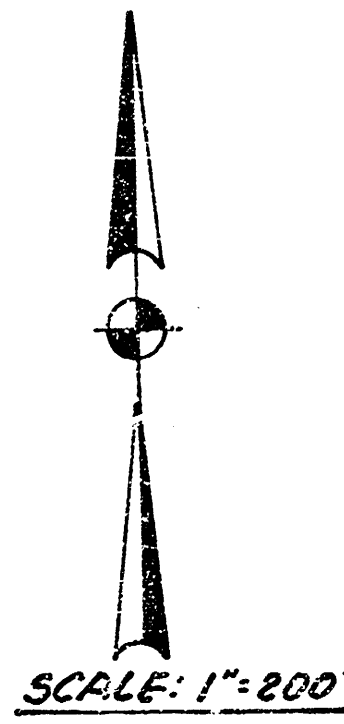
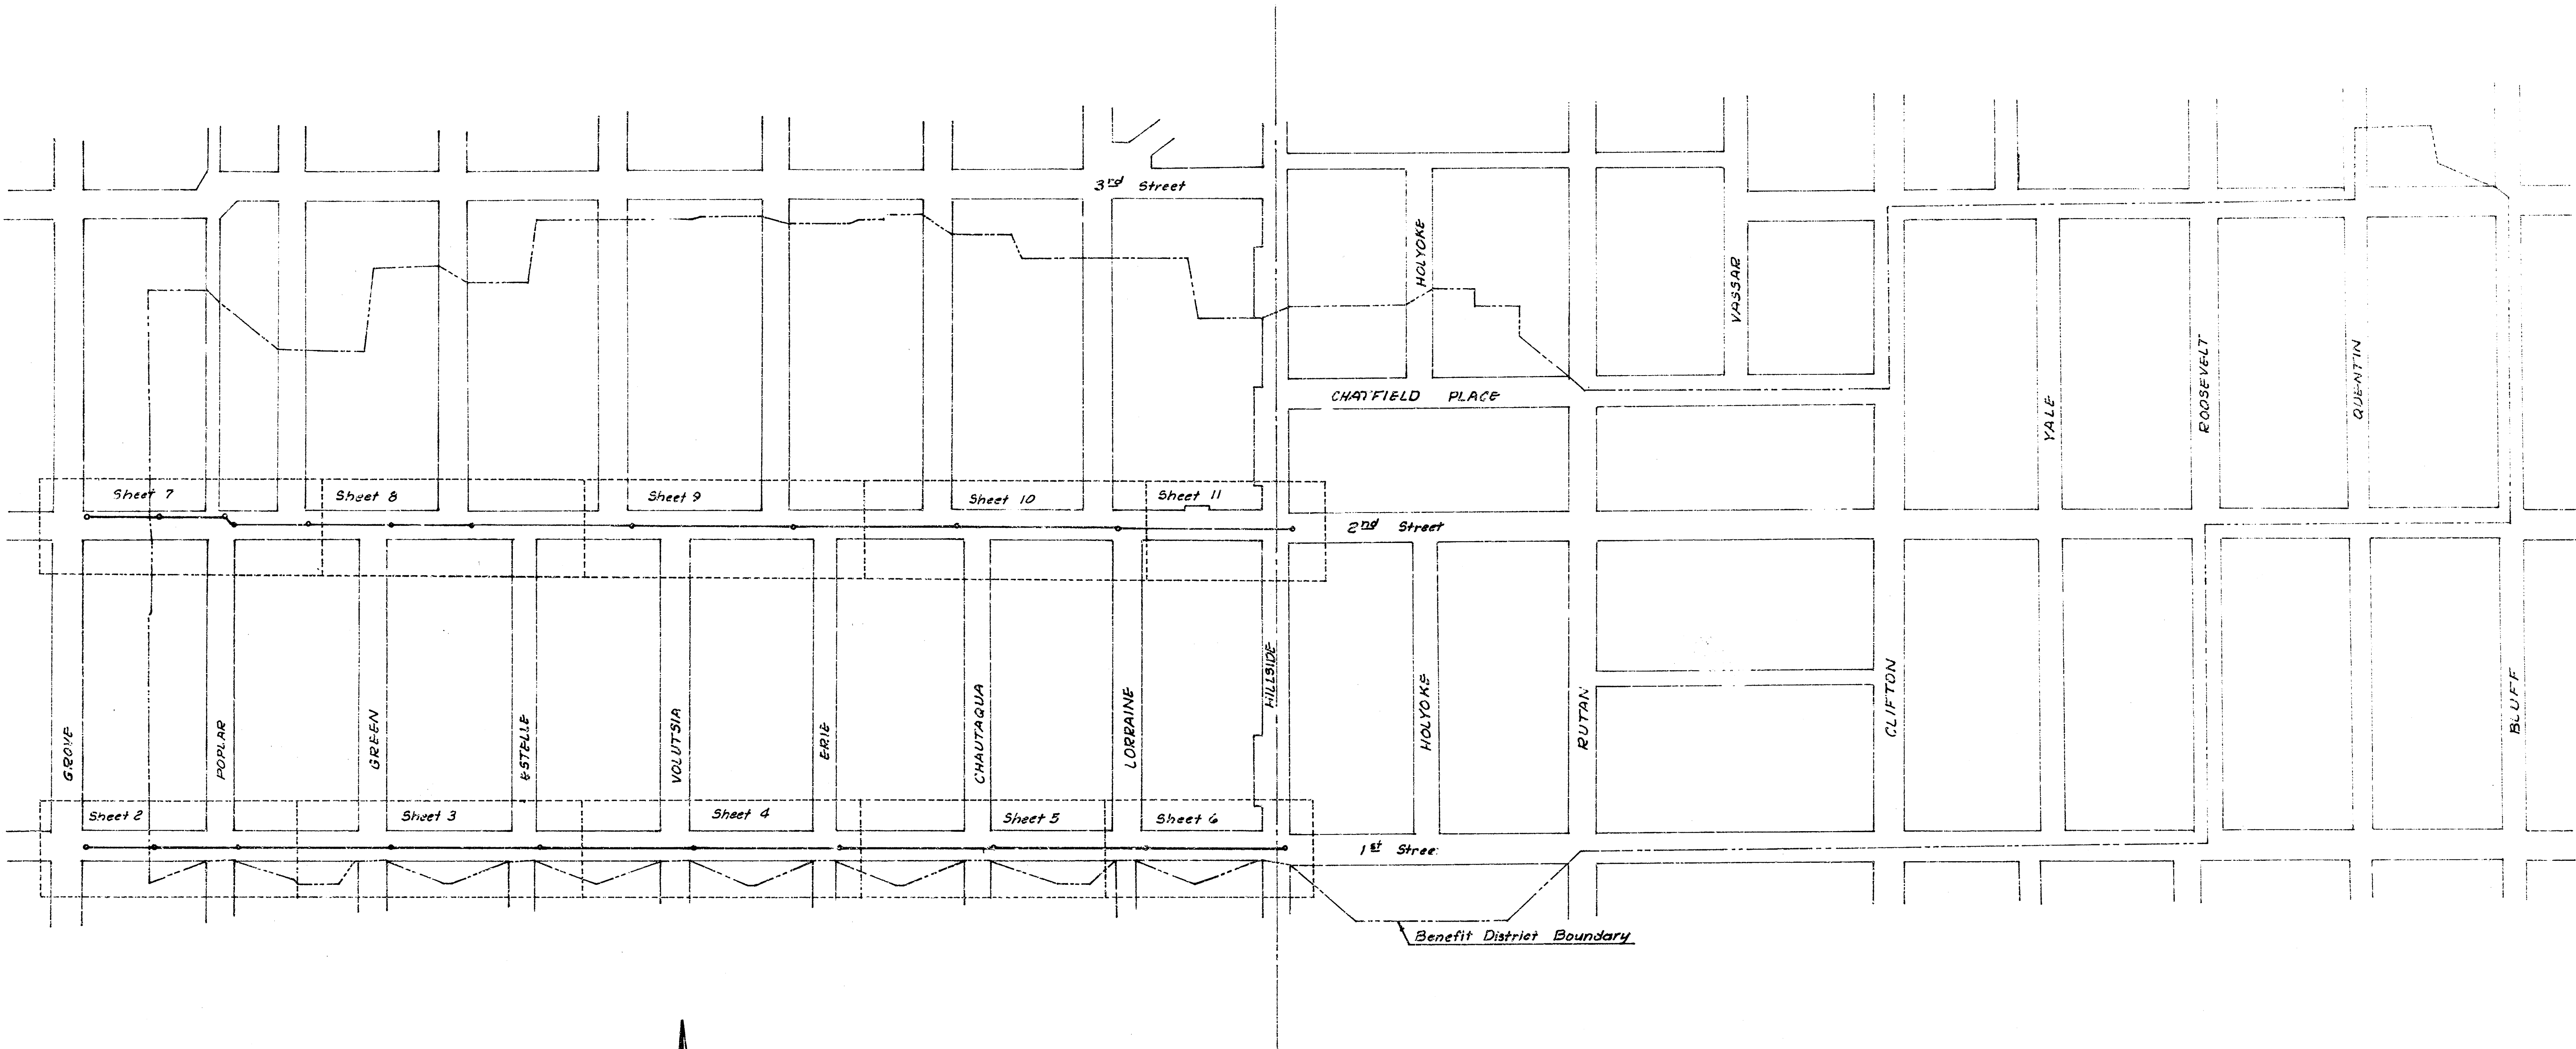


STORM WATER SEWER NO. 105

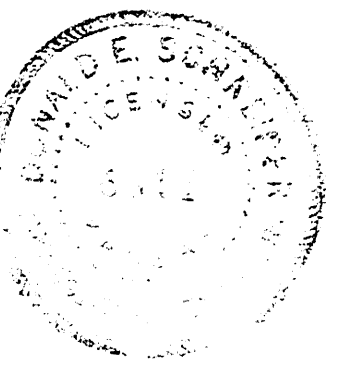


R. W. LINN, CITY ENGINEER
CITY OF WICHITA, KANSAS


DATE May 1, 1913



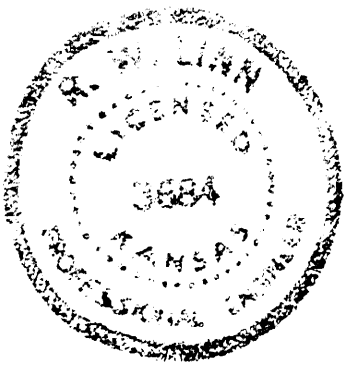




AS BUILT PER PLAN
IH-81

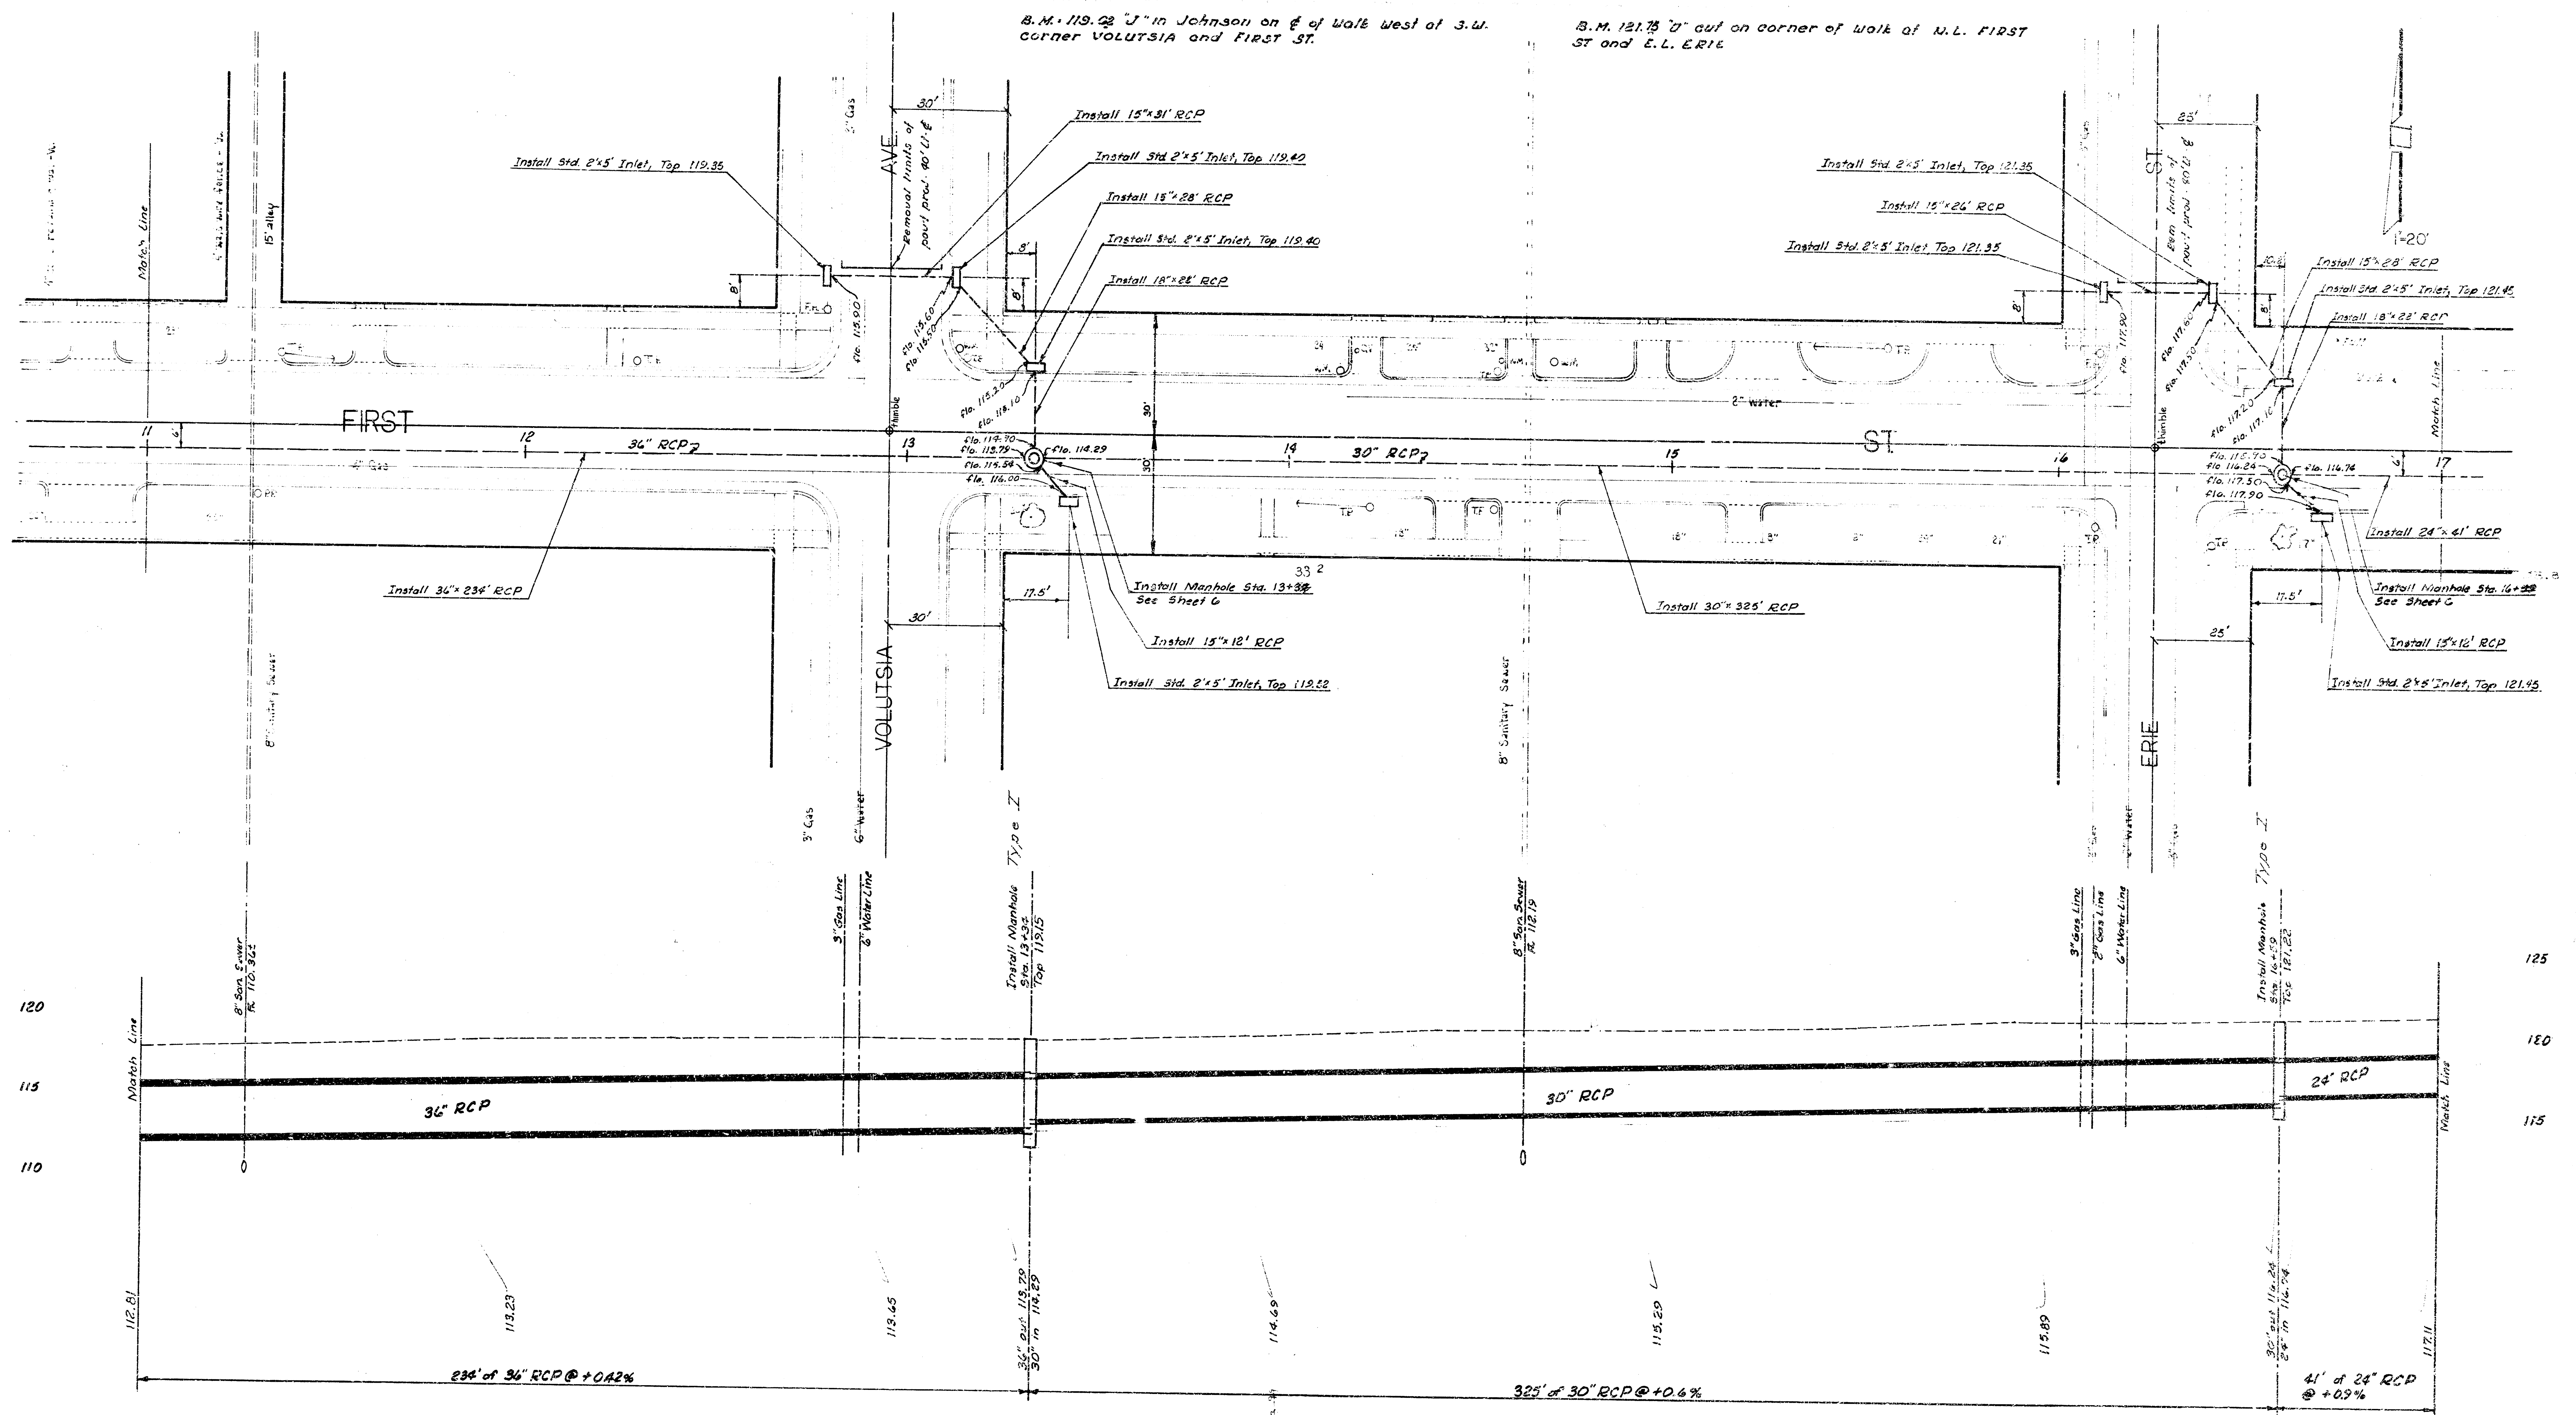

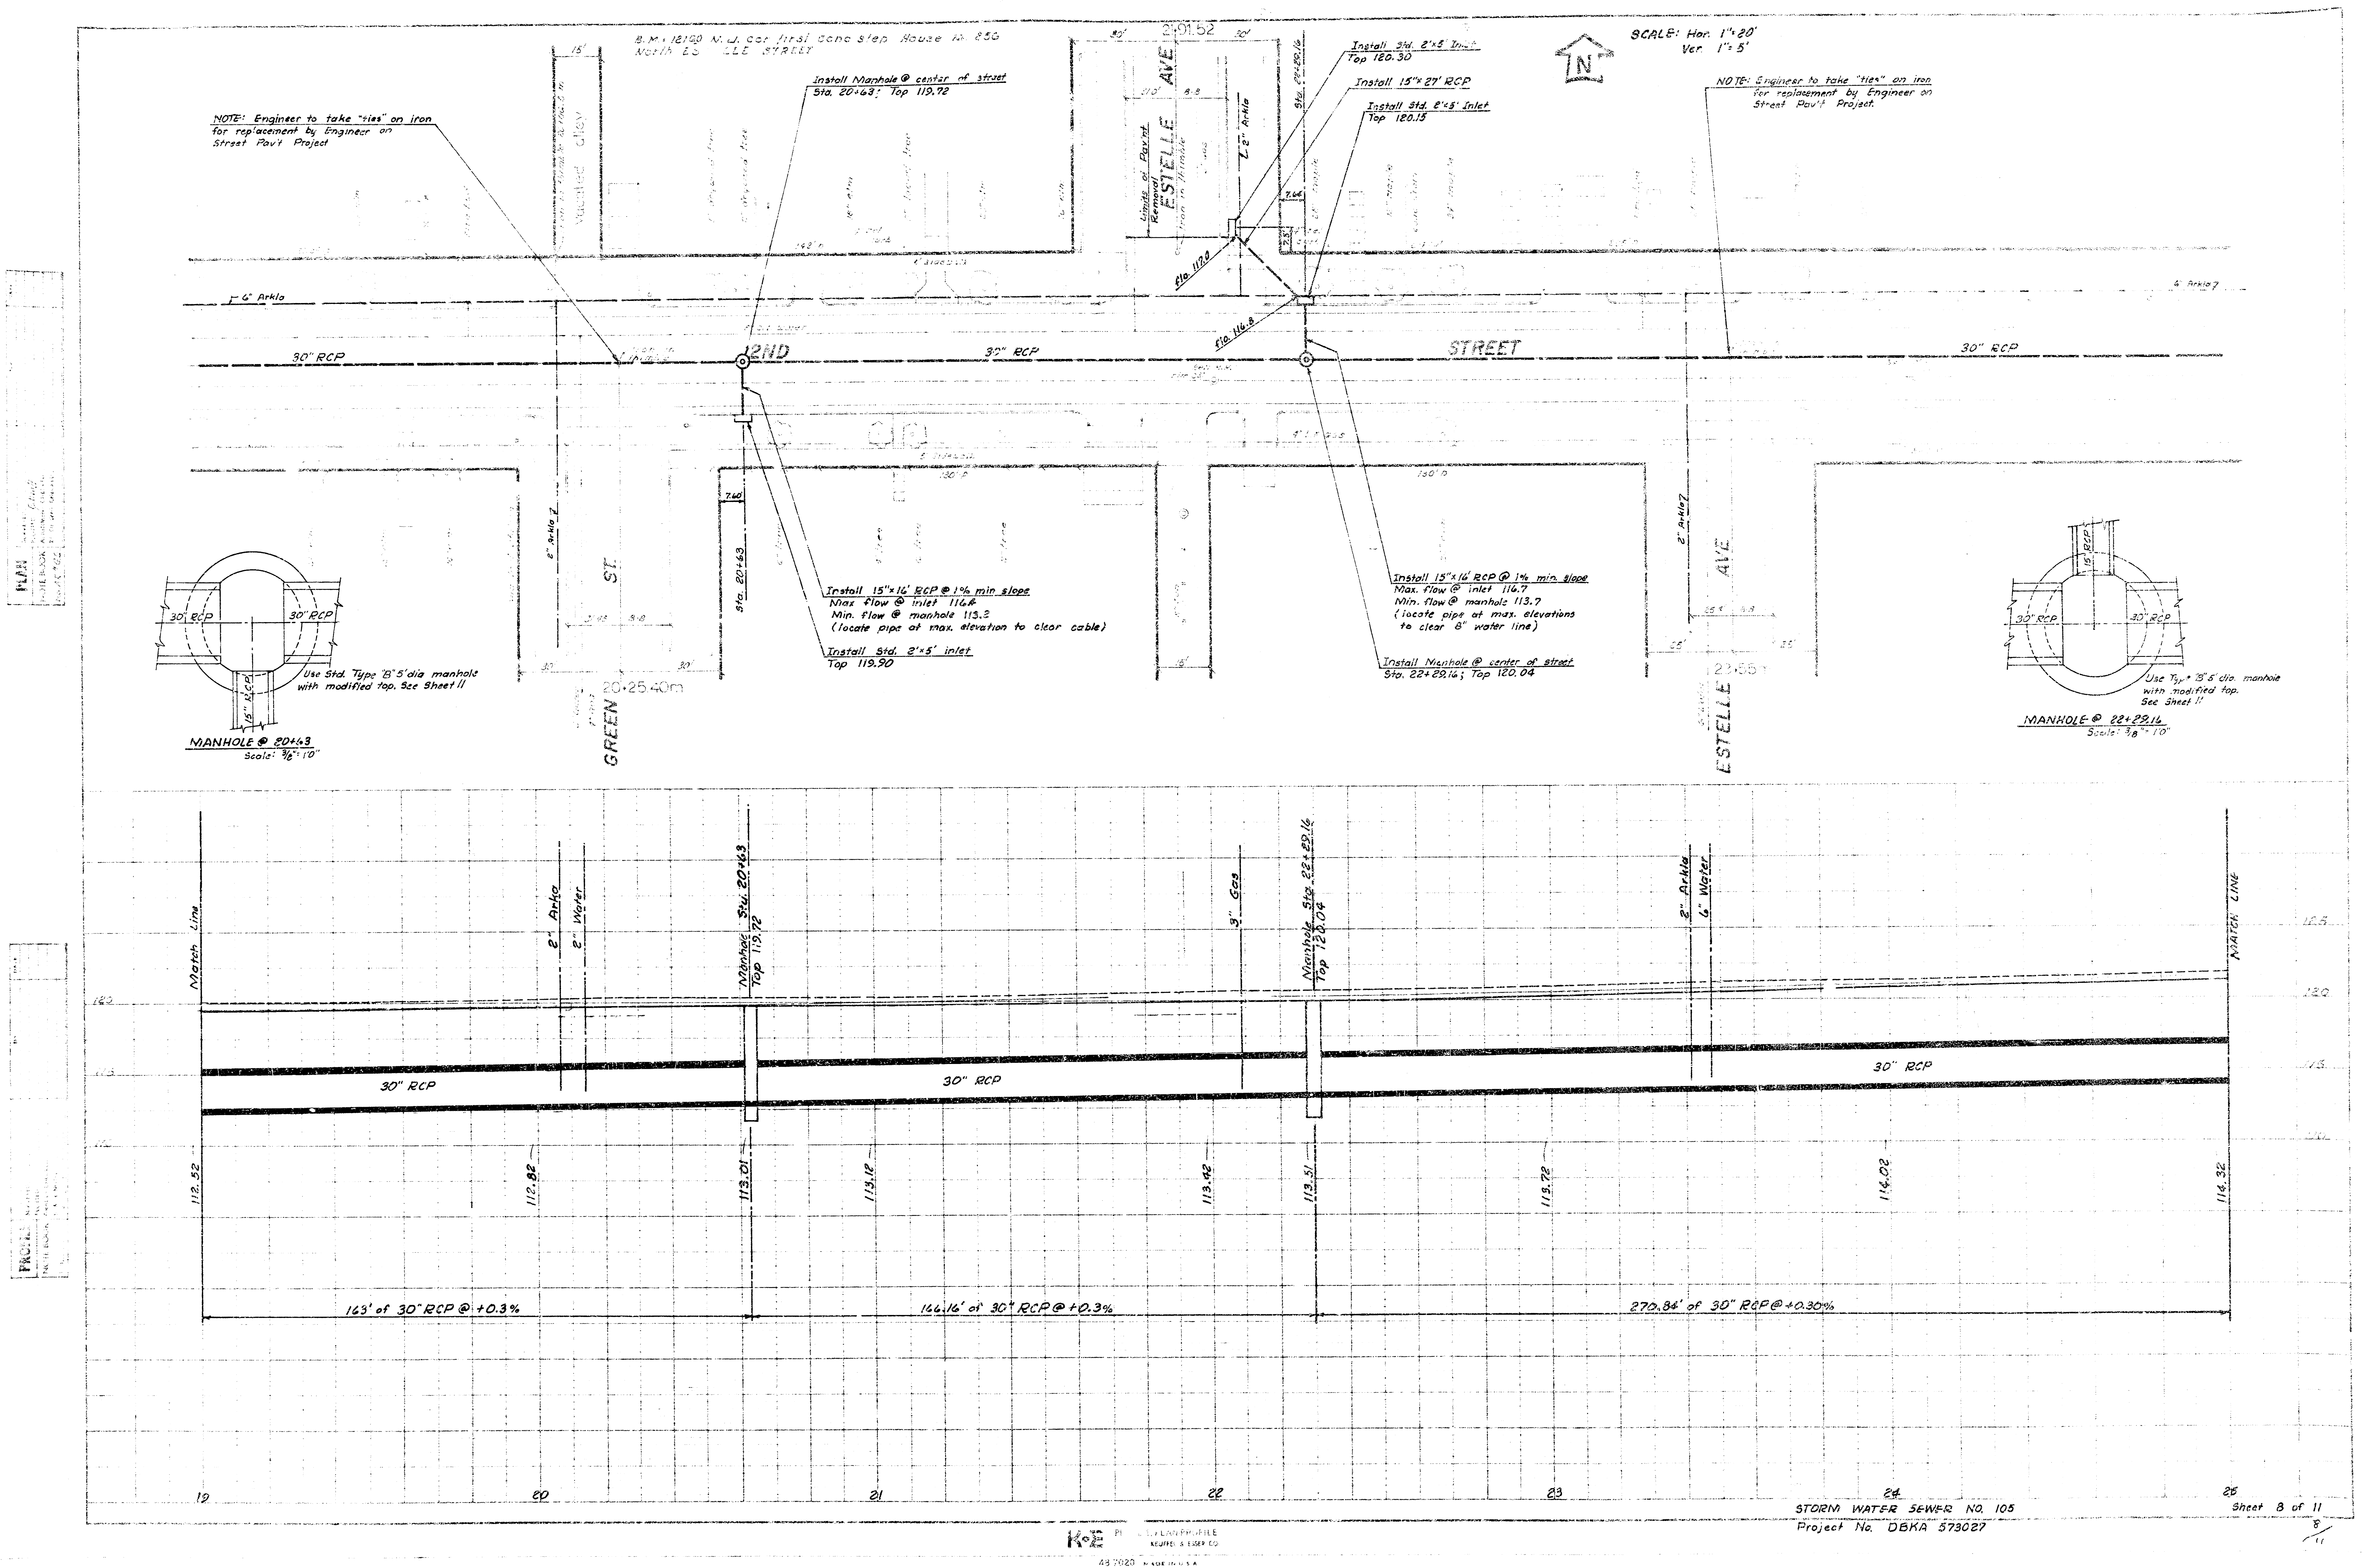

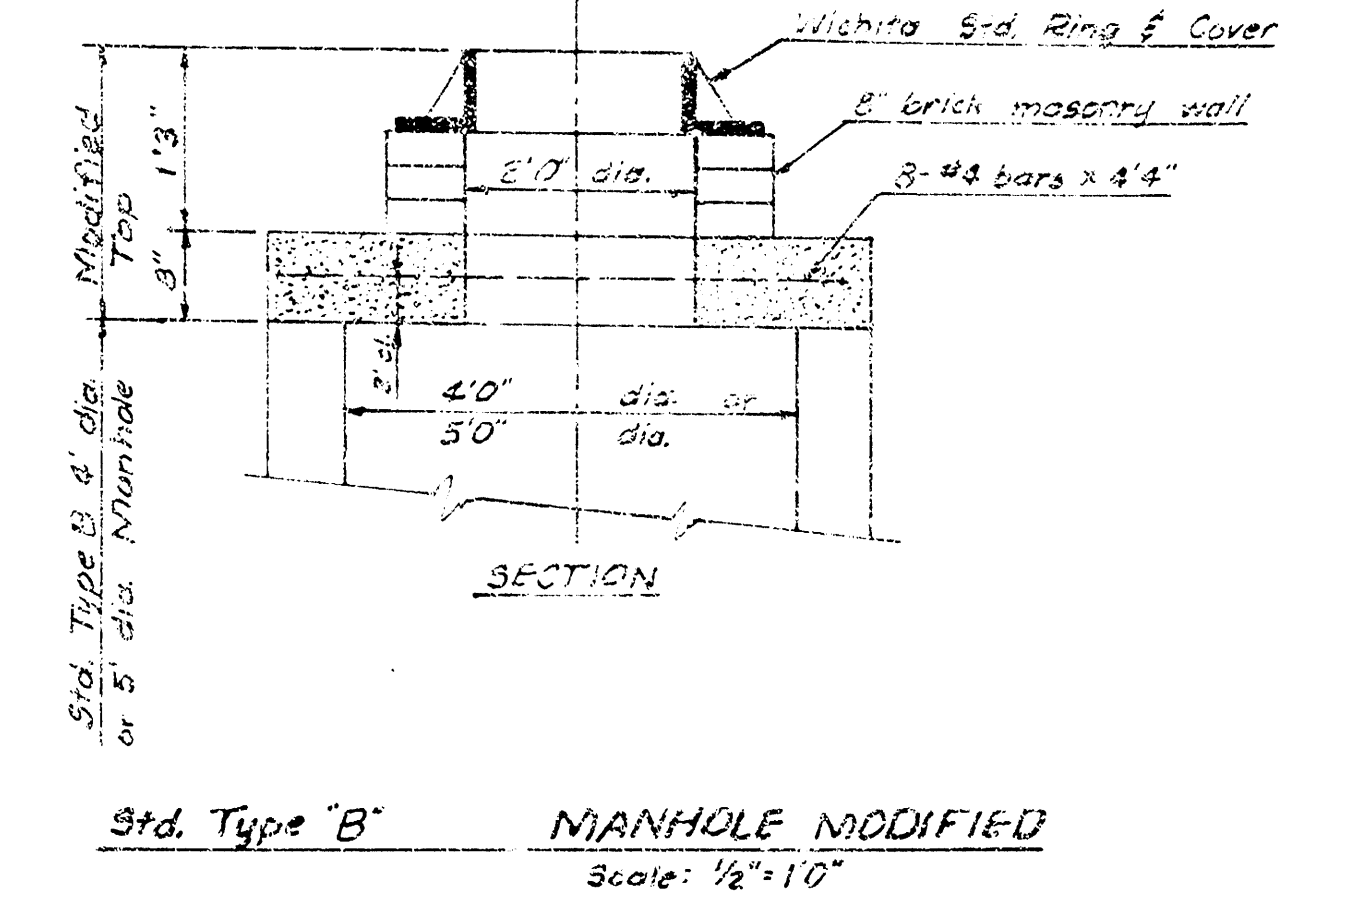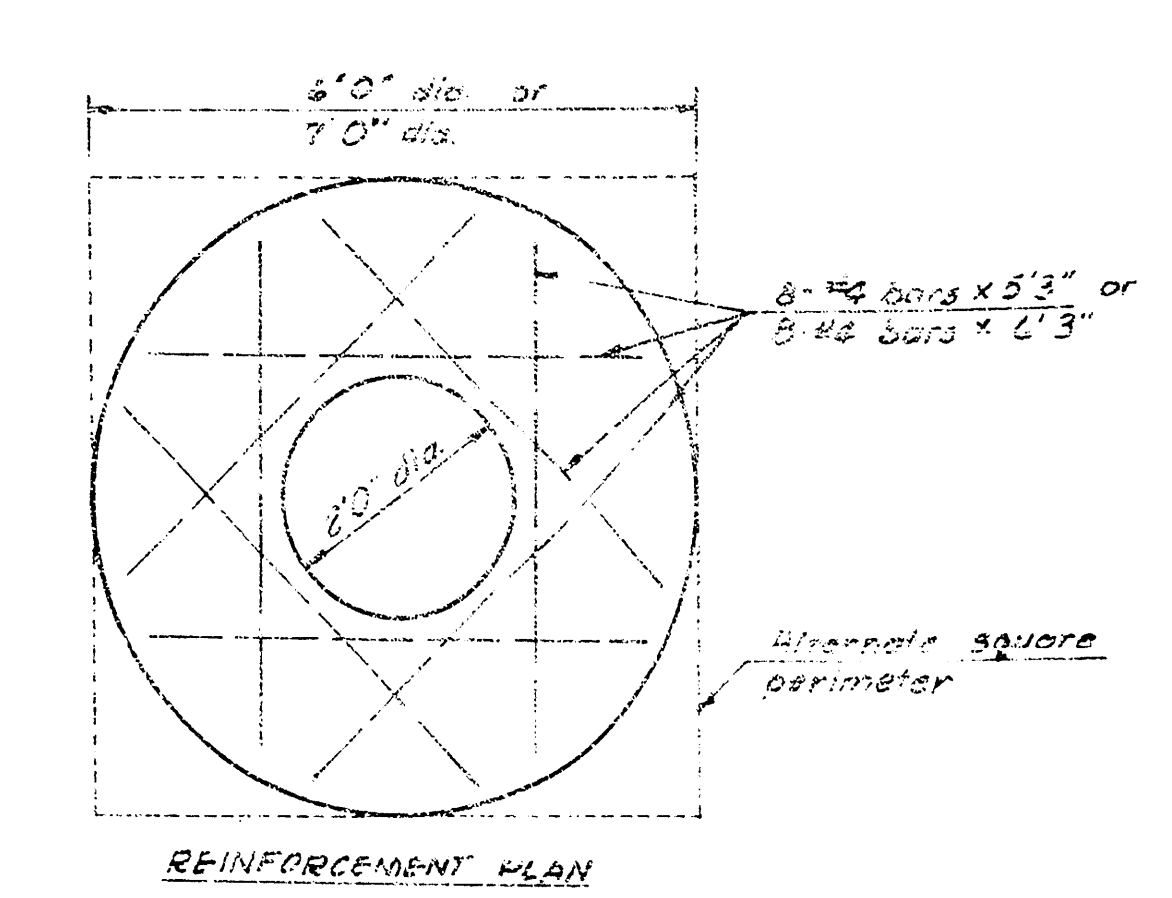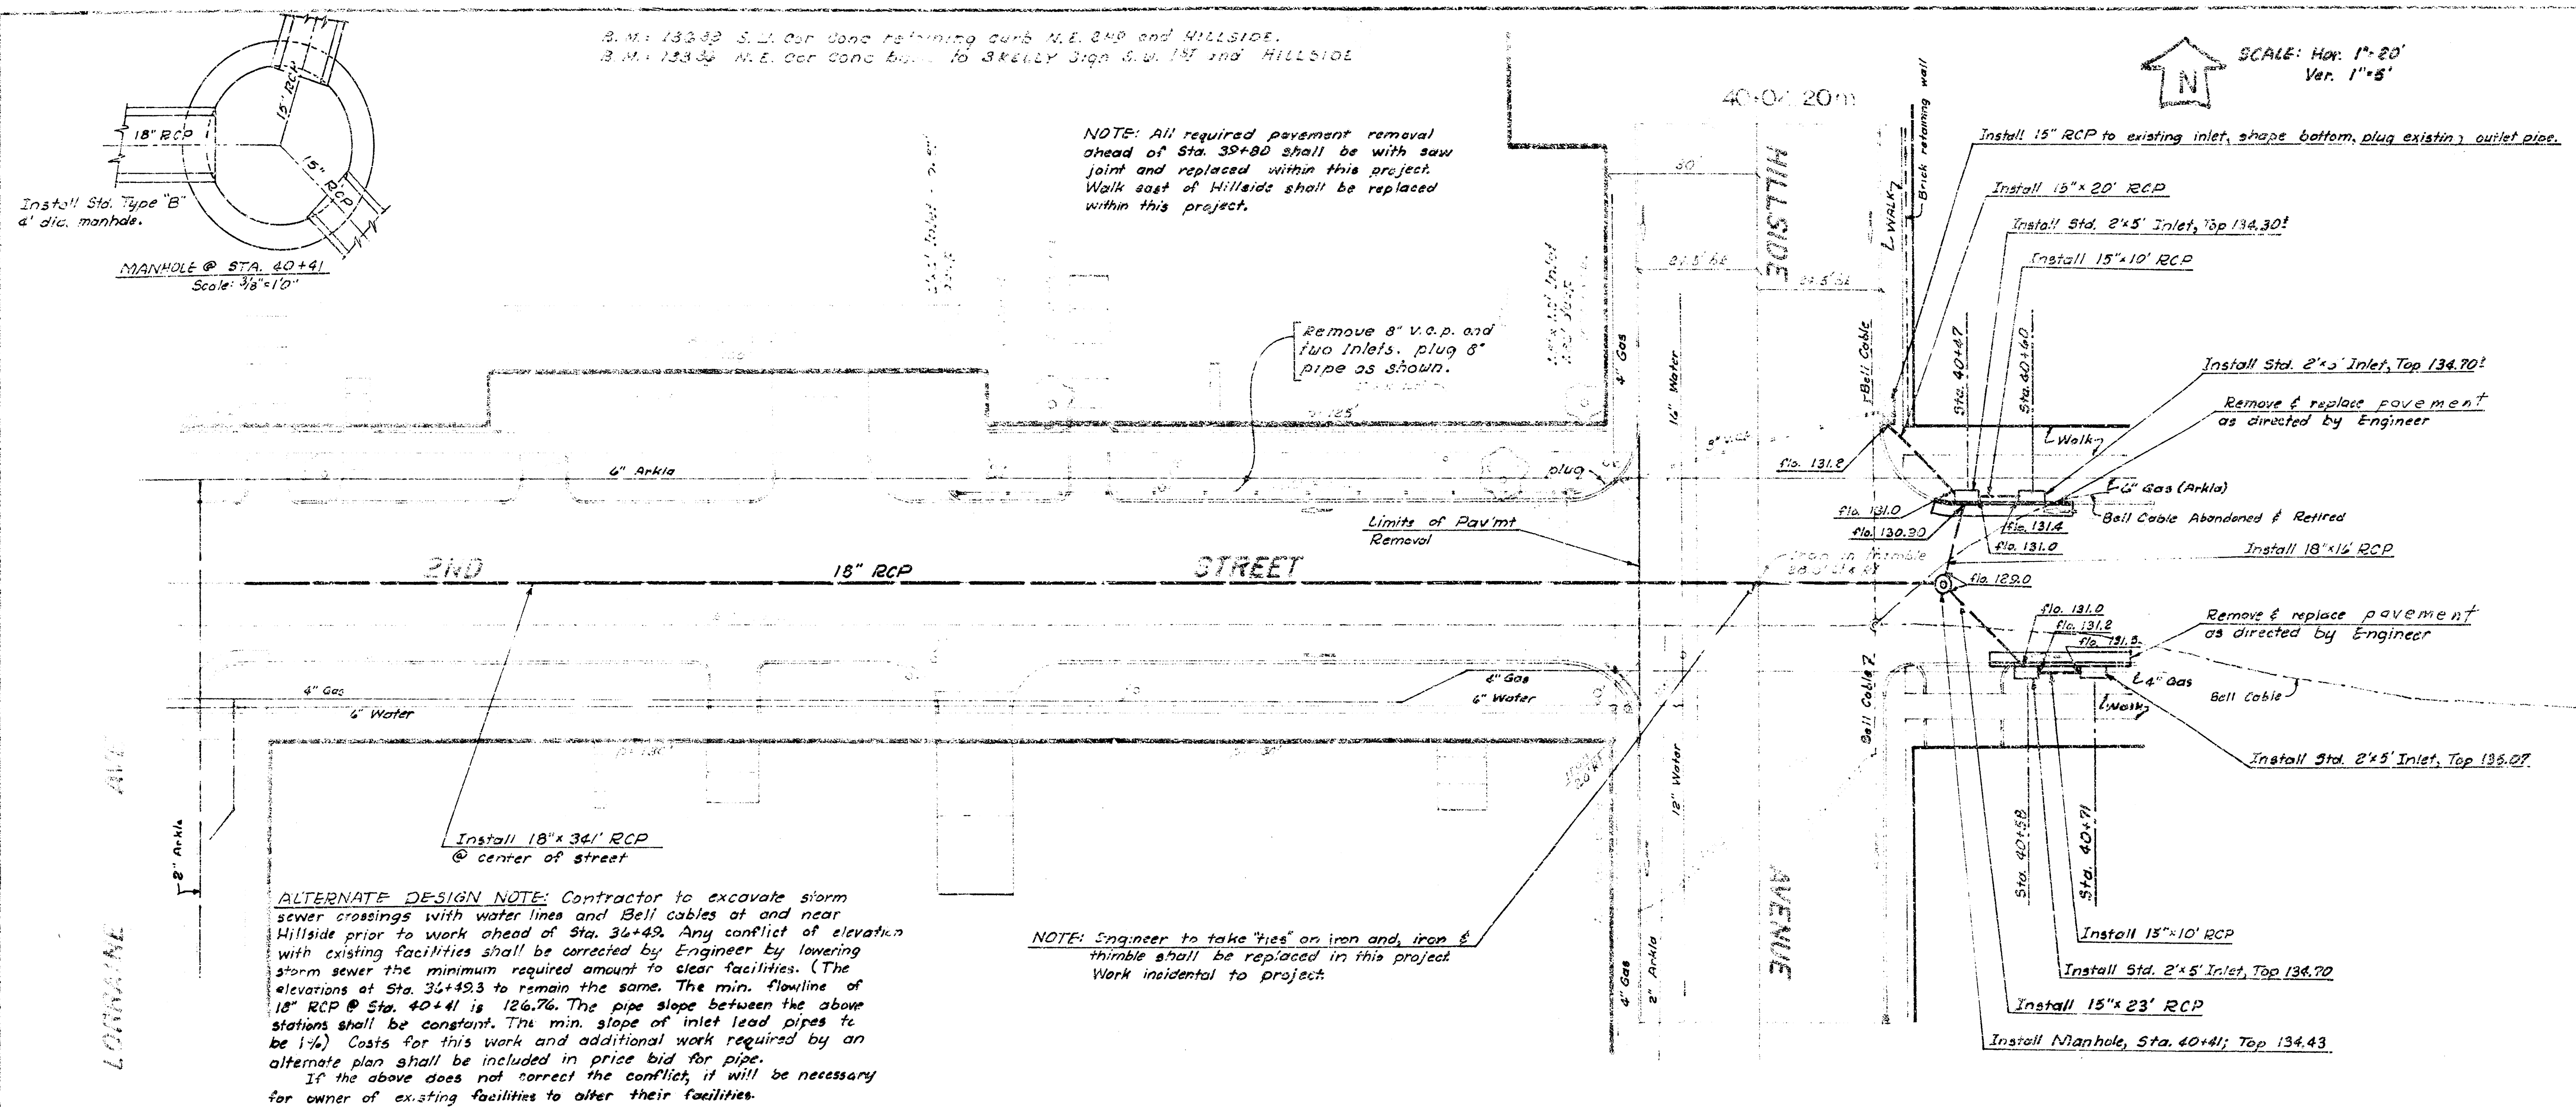

NOTE: CONTRACTOR SHALL HAVE OPTION BETWEEN CONSTRUCTING STANDARD (TYPE B) MANHOLE MODIFIED AS SHOWN BY PLANS OR STANDARD BRICK MANHOLE (TYPE B). WIDE FLANGE MANHOLE RINGS (NO. 500 AS MANUFACTURED BY WESTERN IRON AND FOUNDRY CO., OR AN APPROVED EQUAL, SHALL BE SUBSTITUTED FOR THE STANDARD MANHOLE RING IF THE CONTRACTOR DESIRES THE STANDARD BRICK MANHOLE (TYPE B) OPTION. STANDARD (TYPE B) MANHOLE MODIFIED (5' DIAMETER) OR ALTERNATE STANDARD BRICK MANHOLE (TYPE B) (5' DIAMETER) WITH WIDE FLANGE RING SHALL BE PAID FOR AS MANHOLE TYPE III. STANDARD (TYPE B) MANHOLE MODIFIED (4' DIAMETER) OR ALTERNATE STANDARD BRICK MANHOLE (TYPE B) (4' DIAMETER) WITH WIDE FLANGE RING SHALL BE PAID FOR AS MANHOLE TYPE IV.

