



STORM WATER SEWER NO. 107
 CITY OF WICHITA, KANSAS
 R. W. LINN- CITY ENGINEER
 PROJECT NO. DBKA 573081
 DATE:

- GENERAL NOTES
1. PIPE FURNISHED FOR THIS PROJECT SHALL BE EITHER ALL REINFORCED CONCRETE PIPE OR ALL CORRUGATED METAL PIPE. CORRUGATED METAL PIPE SHALL CONFORM TO THE APPLICABLE SECTIONS OF SECTION 1009.05 OF THE 1973 KANSAS STATE HIGHWAY SPECIFICATIONS. CORRUGATED METAL PIPE FURNISHED FOR THIS PROJECT DOES NOT REQUIRE BITUMINOUS COATING. CORRUGATED METAL PIPE HAVING DIAMETERS OF 18 INCHES OR SMALLER SHALL HAVE HELICAL CORRUGATIONS. CORRUGATED METAL PIPE USED ON THIS PROJECT SHALL BE FURNISHED WITH THE "BUDDER" SAND COUPLER AS MANUFACTURED BY ARSCO STEEL CORPORATION, OR AN APPROVED EQUAL, FOR CONNECTING SECTIONS OF CORRUGATED METAL PIPE.
 2. CONTRACTOR SHALL USE EXCESS EXCAVATED MATERIAL FROM SEWER TRENCH TO FILL AND GRAD DITCH ON SOUTH OF STORM SEWER FROM APPROXIMATELY STA. 4430 TO 6485. THIS ITEM OF WORK WILL NOT BE PAID FOR DIRECTLY AND SHALL BE CONSIDERED AS SUBSIDIARY TO THE OTHER ITEMS OF WORK.
 3. ALL COSTS OF MATERIALS AND LABOR FOR INSTALLATION OF THE 36" ARSCO FLAT BACK FLAP GATE (MODEL 20-C) WITH TYPE "F" THIMBLE, OR APPROVED EQUAL, SHALL BE INCLUDED IN THE BID PRICE FOR THE REINFORCED CONCRETE MANHOLE.




As Built 12-19-75

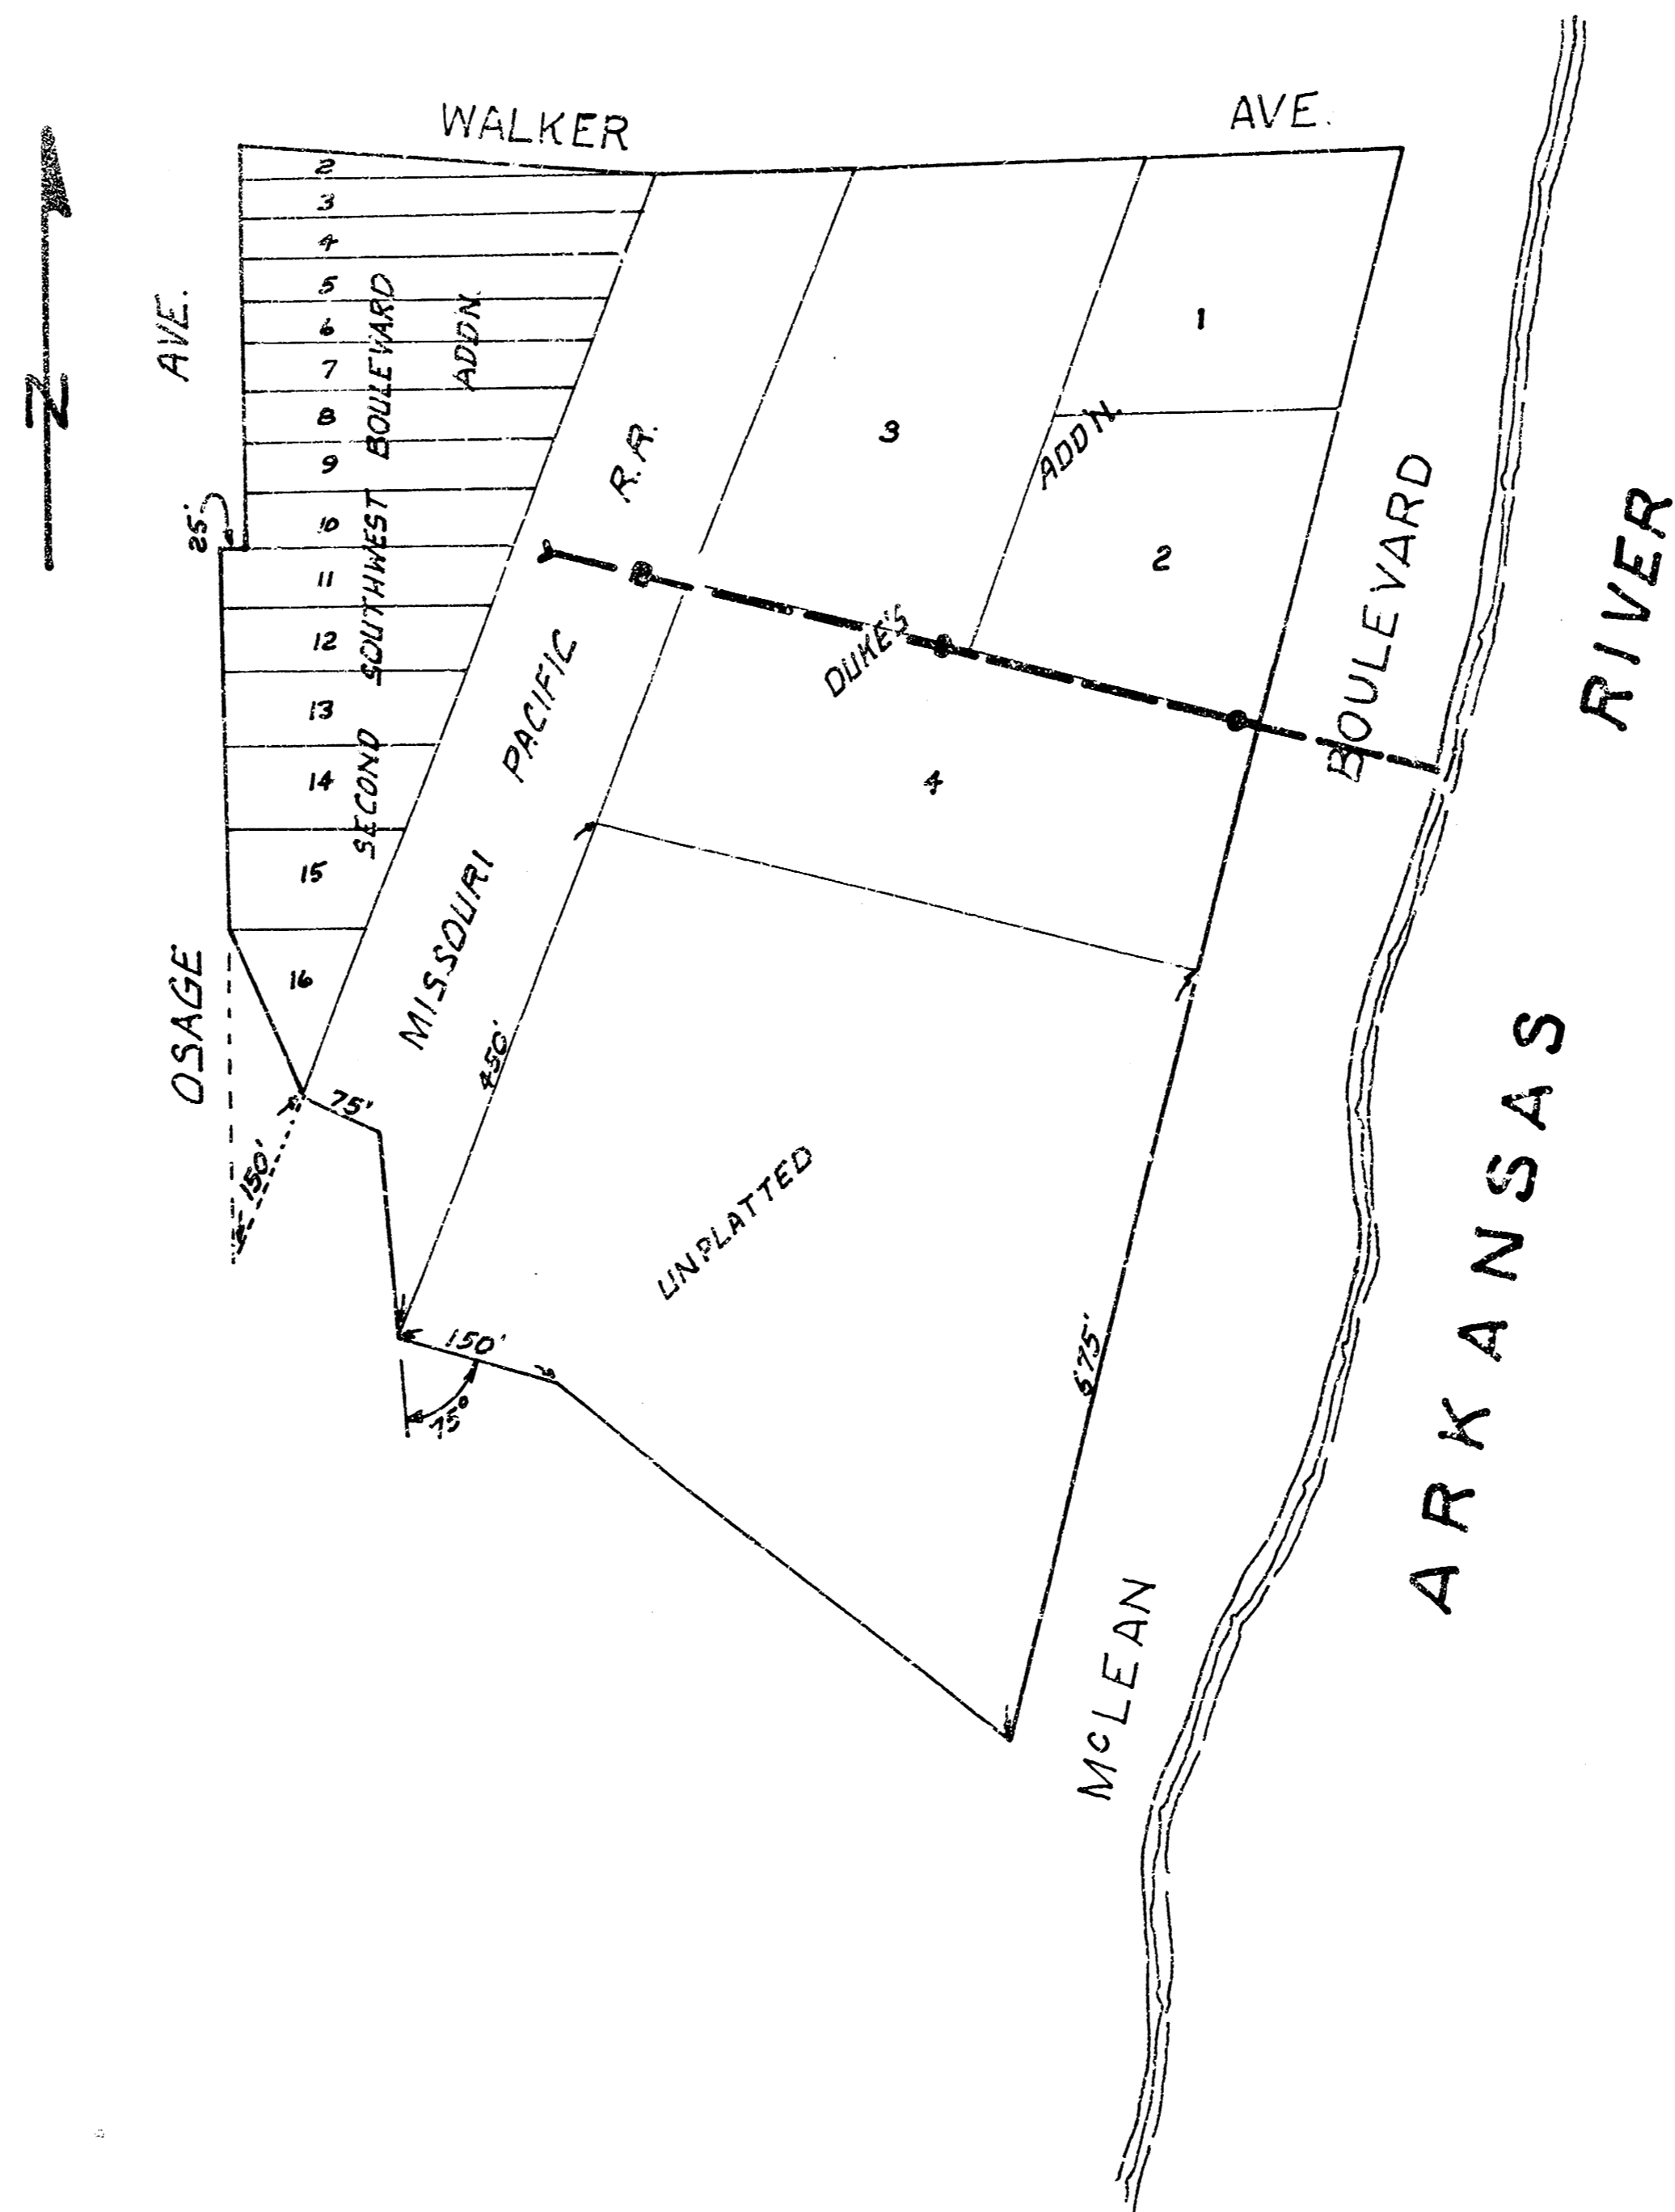

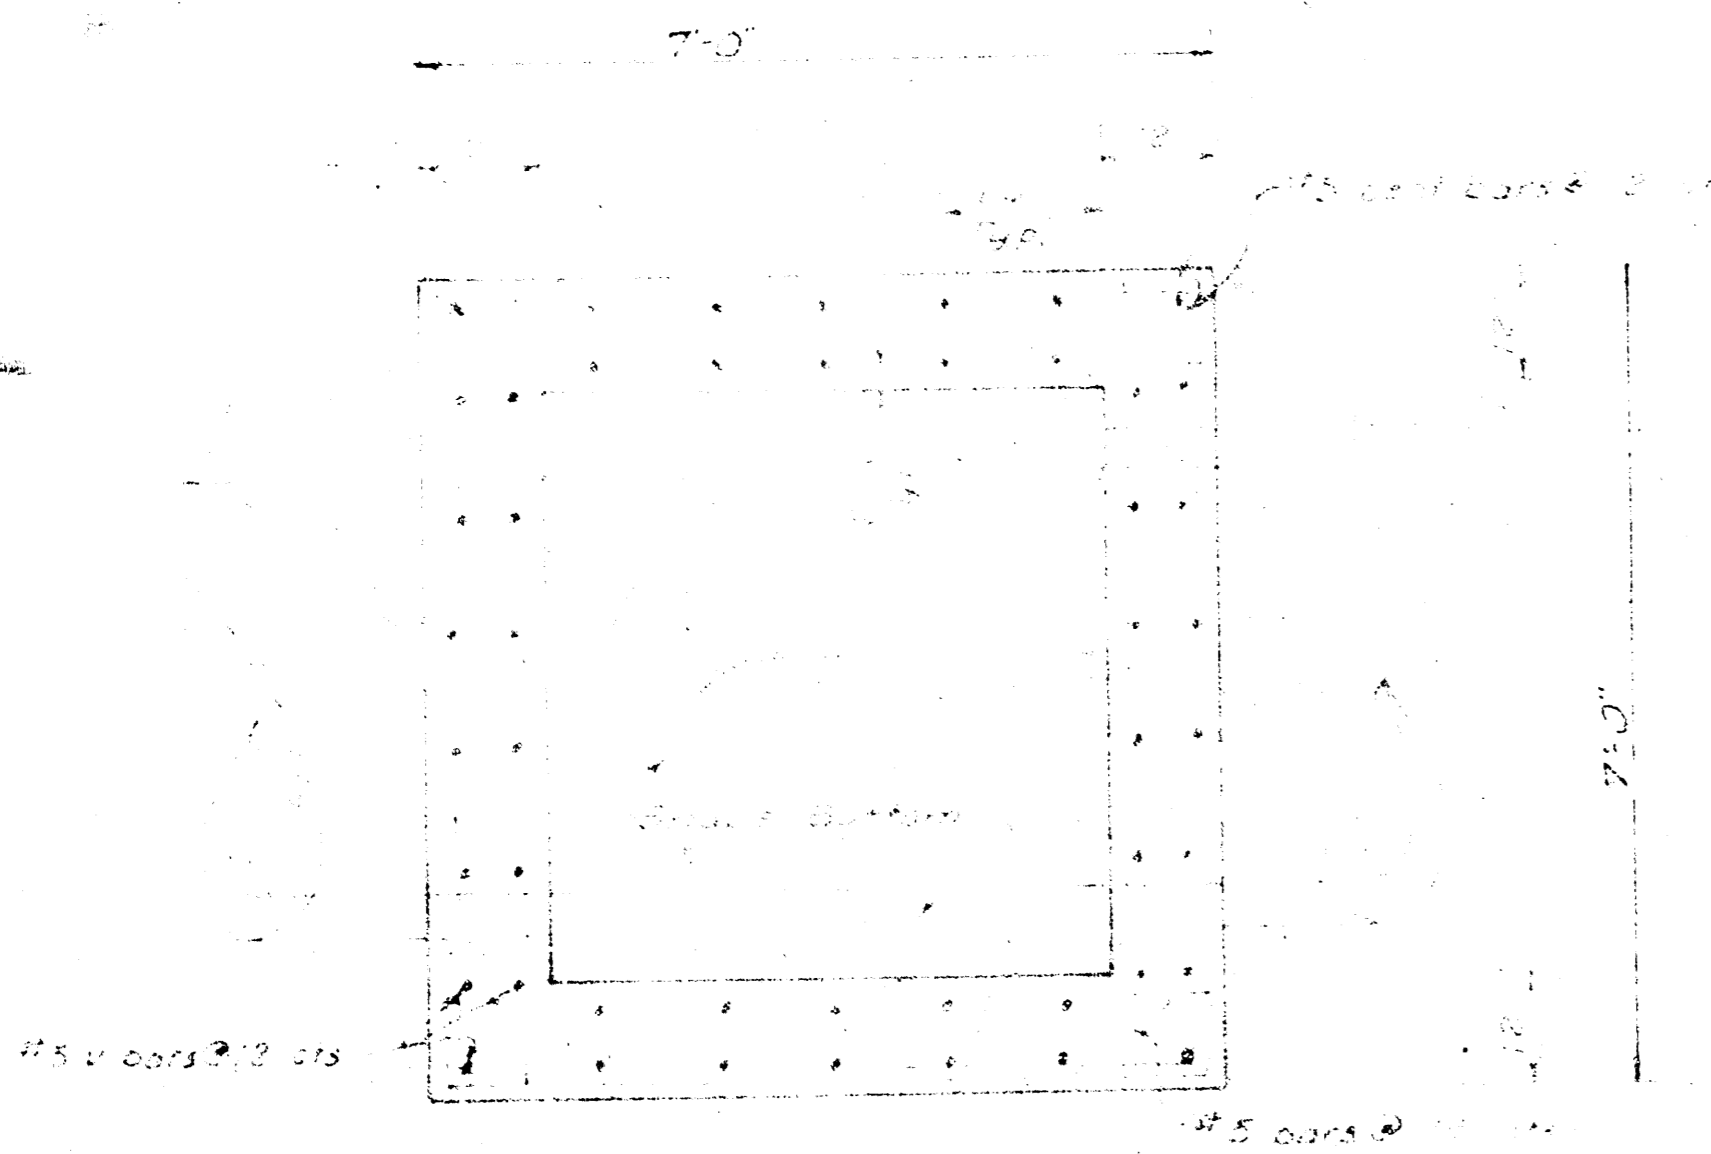

PLAN SECTION TYPICAL WALLS

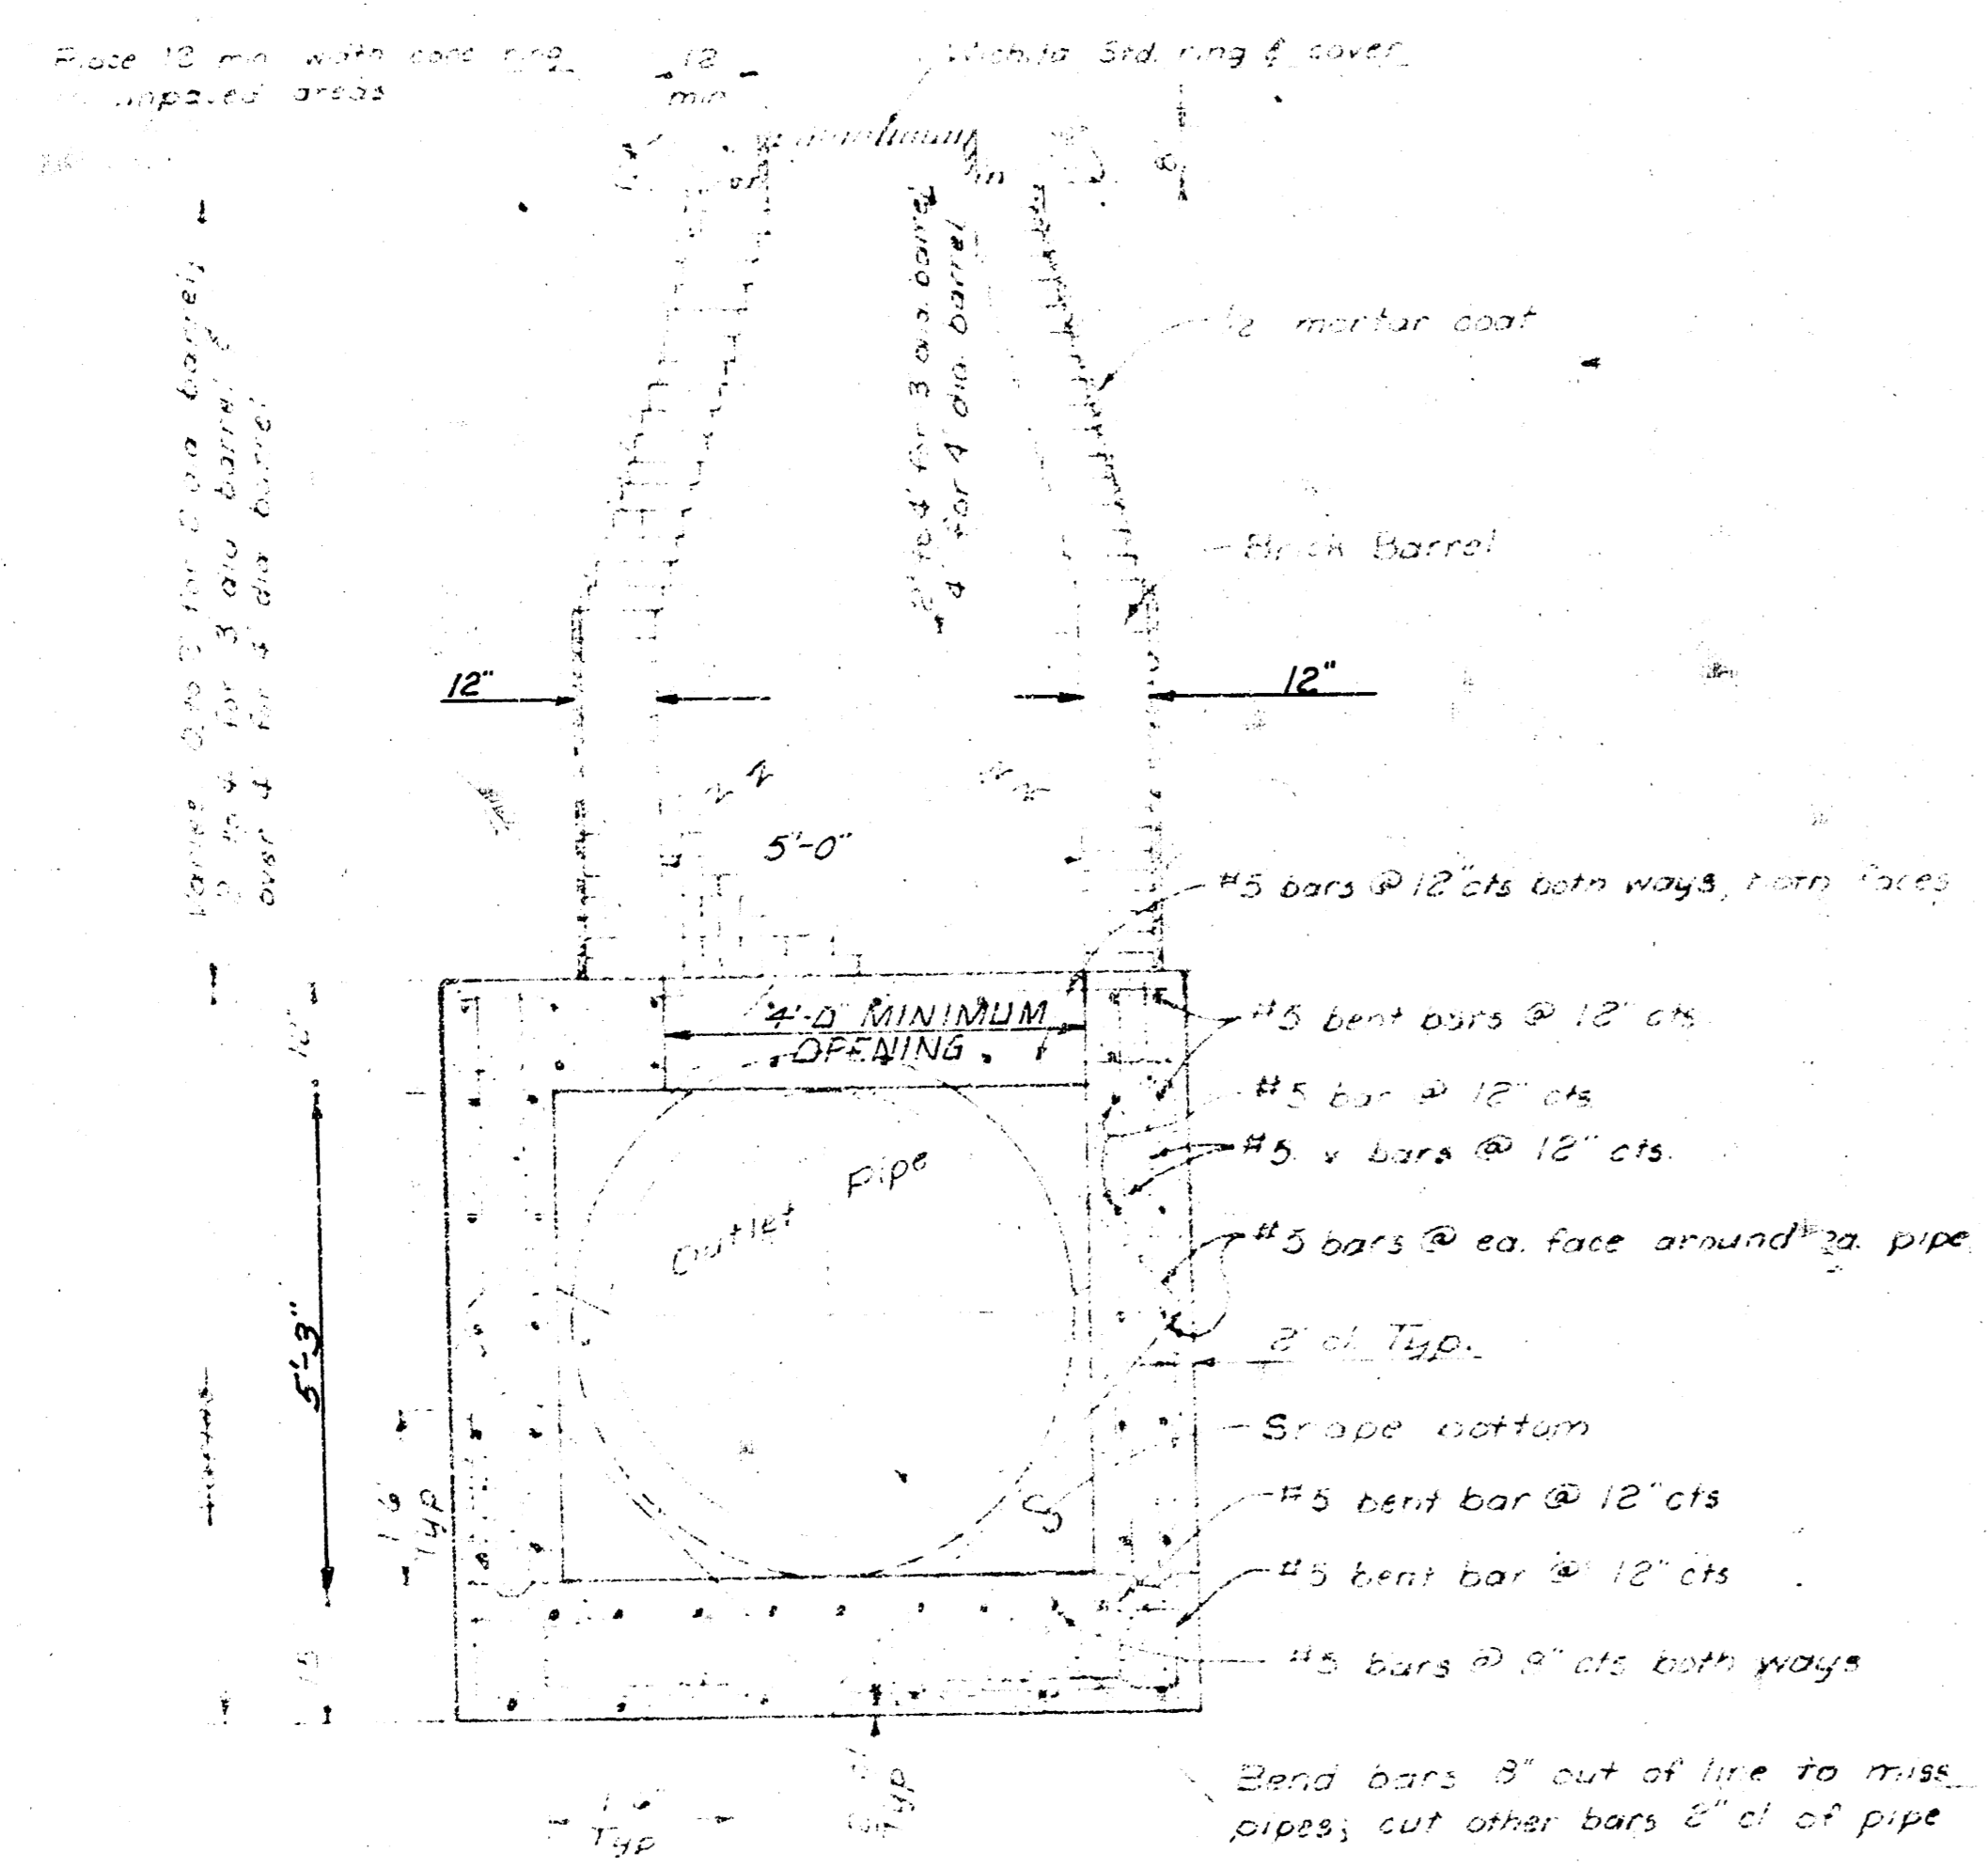


TYPICAL ELEVATION SECTION
SCALE 1/2" = 1'-0"


REINFORCED CONCRETE MANHOLE DETAILS

GENERAL NOTES


1. ALL COSTS OF MATERIALS & LABOR FOR CONSTRUCTION OF REINFORCED CONCRETE INLET MANHOLE SHALL BE INCLUDED IN THE BID PRICE FOR REINFORCED CONCRETE INLET MANHOLE.
2. REINFORCED CONCRETE INLET MANHOLE SHALL BE CONSTRUCTED IN ACCORDANCE WITH THE DETAILS SHOWN ON THIS DRAWING.
3. THE FLOOR OF THE REINFORCED CONCRETE INLET SHALL BE SHAPED TO CONFORM TO THE SECTIONS AS SHOWN WITH 3/8 SACK SAND MIX.
4. THE WALLS AND FLOOR OF THE REINFORCED CONCRETE INLET SHALL BE 6" THICK UNLESS OTHERWISE NOTED.
5. THE REINFORCED CONCRETE INLET SHALL BE CONSTRUCTED WITH 4" MINIMUM COVER TO ALL REINFORCEMENT.
6. THE REINFORCED CONCRETE INLET SHALL BE CONSTRUCTED WITH 4" MINIMUM COVER TO ALL REINFORCEMENT.
7. THE REINFORCED CONCRETE INLET SHALL BE CONSTRUCTED WITH 4" MINIMUM COVER TO ALL REINFORCEMENT.
8. THE REINFORCED CONCRETE INLET SHALL BE CONSTRUCTED WITH 4" MINIMUM COVER TO ALL REINFORCEMENT.
9. THE REINFORCED CONCRETE INLET SHALL BE CONSTRUCTED WITH 4" MINIMUM COVER TO ALL REINFORCEMENT.
10. ALL COSTS OF MATERIALS & LABOR FOR CONSTRUCTION OF REINFORCED CONCRETE INLET SHALL BE INCLUDED IN THE BID PRICE FOR REINFORCED CONCRETE INLET.
11. REINFORCED STEEL IN FLOOR & WALLS OF REINFORCED CONCRETE INLET SHALL BE SPACED AT 8" CENTERS EXCEPT FOR DIAGONAL STEEL WHICH SHALL BE PLACED 2" CLEAR FROM OUTSIDE WALL OF STORM SEWER PIPE.
12. THE FLOOR OF THE REINFORCED CONCRETE INLET SHALL BE SHAPED TO CONFORM TO THE SECTIONS AS SHOWN WITH 3/8 SACK SAND MIX.
13. WALLS AND FLOOR OF REINFORCED CONCRETE INLET SHALL BE 6" THICK UNLESS OTHERWISE NOTED.

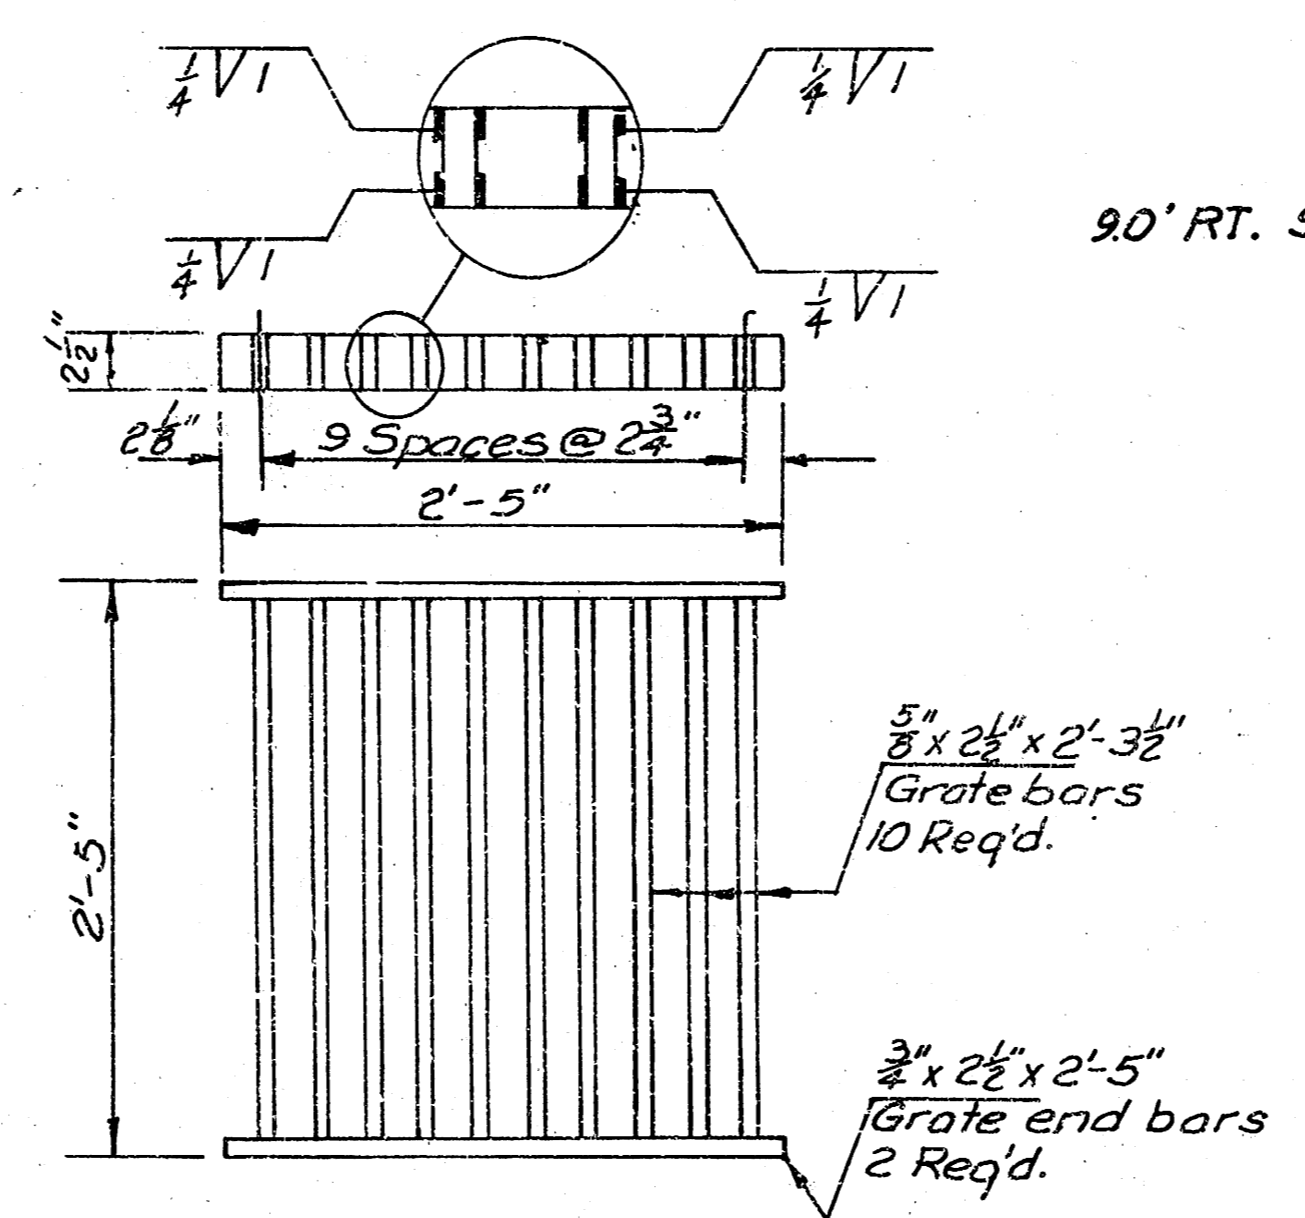


WELDED STRUCTURAL STEEL GRATE
Weight 153 Lbs Each.

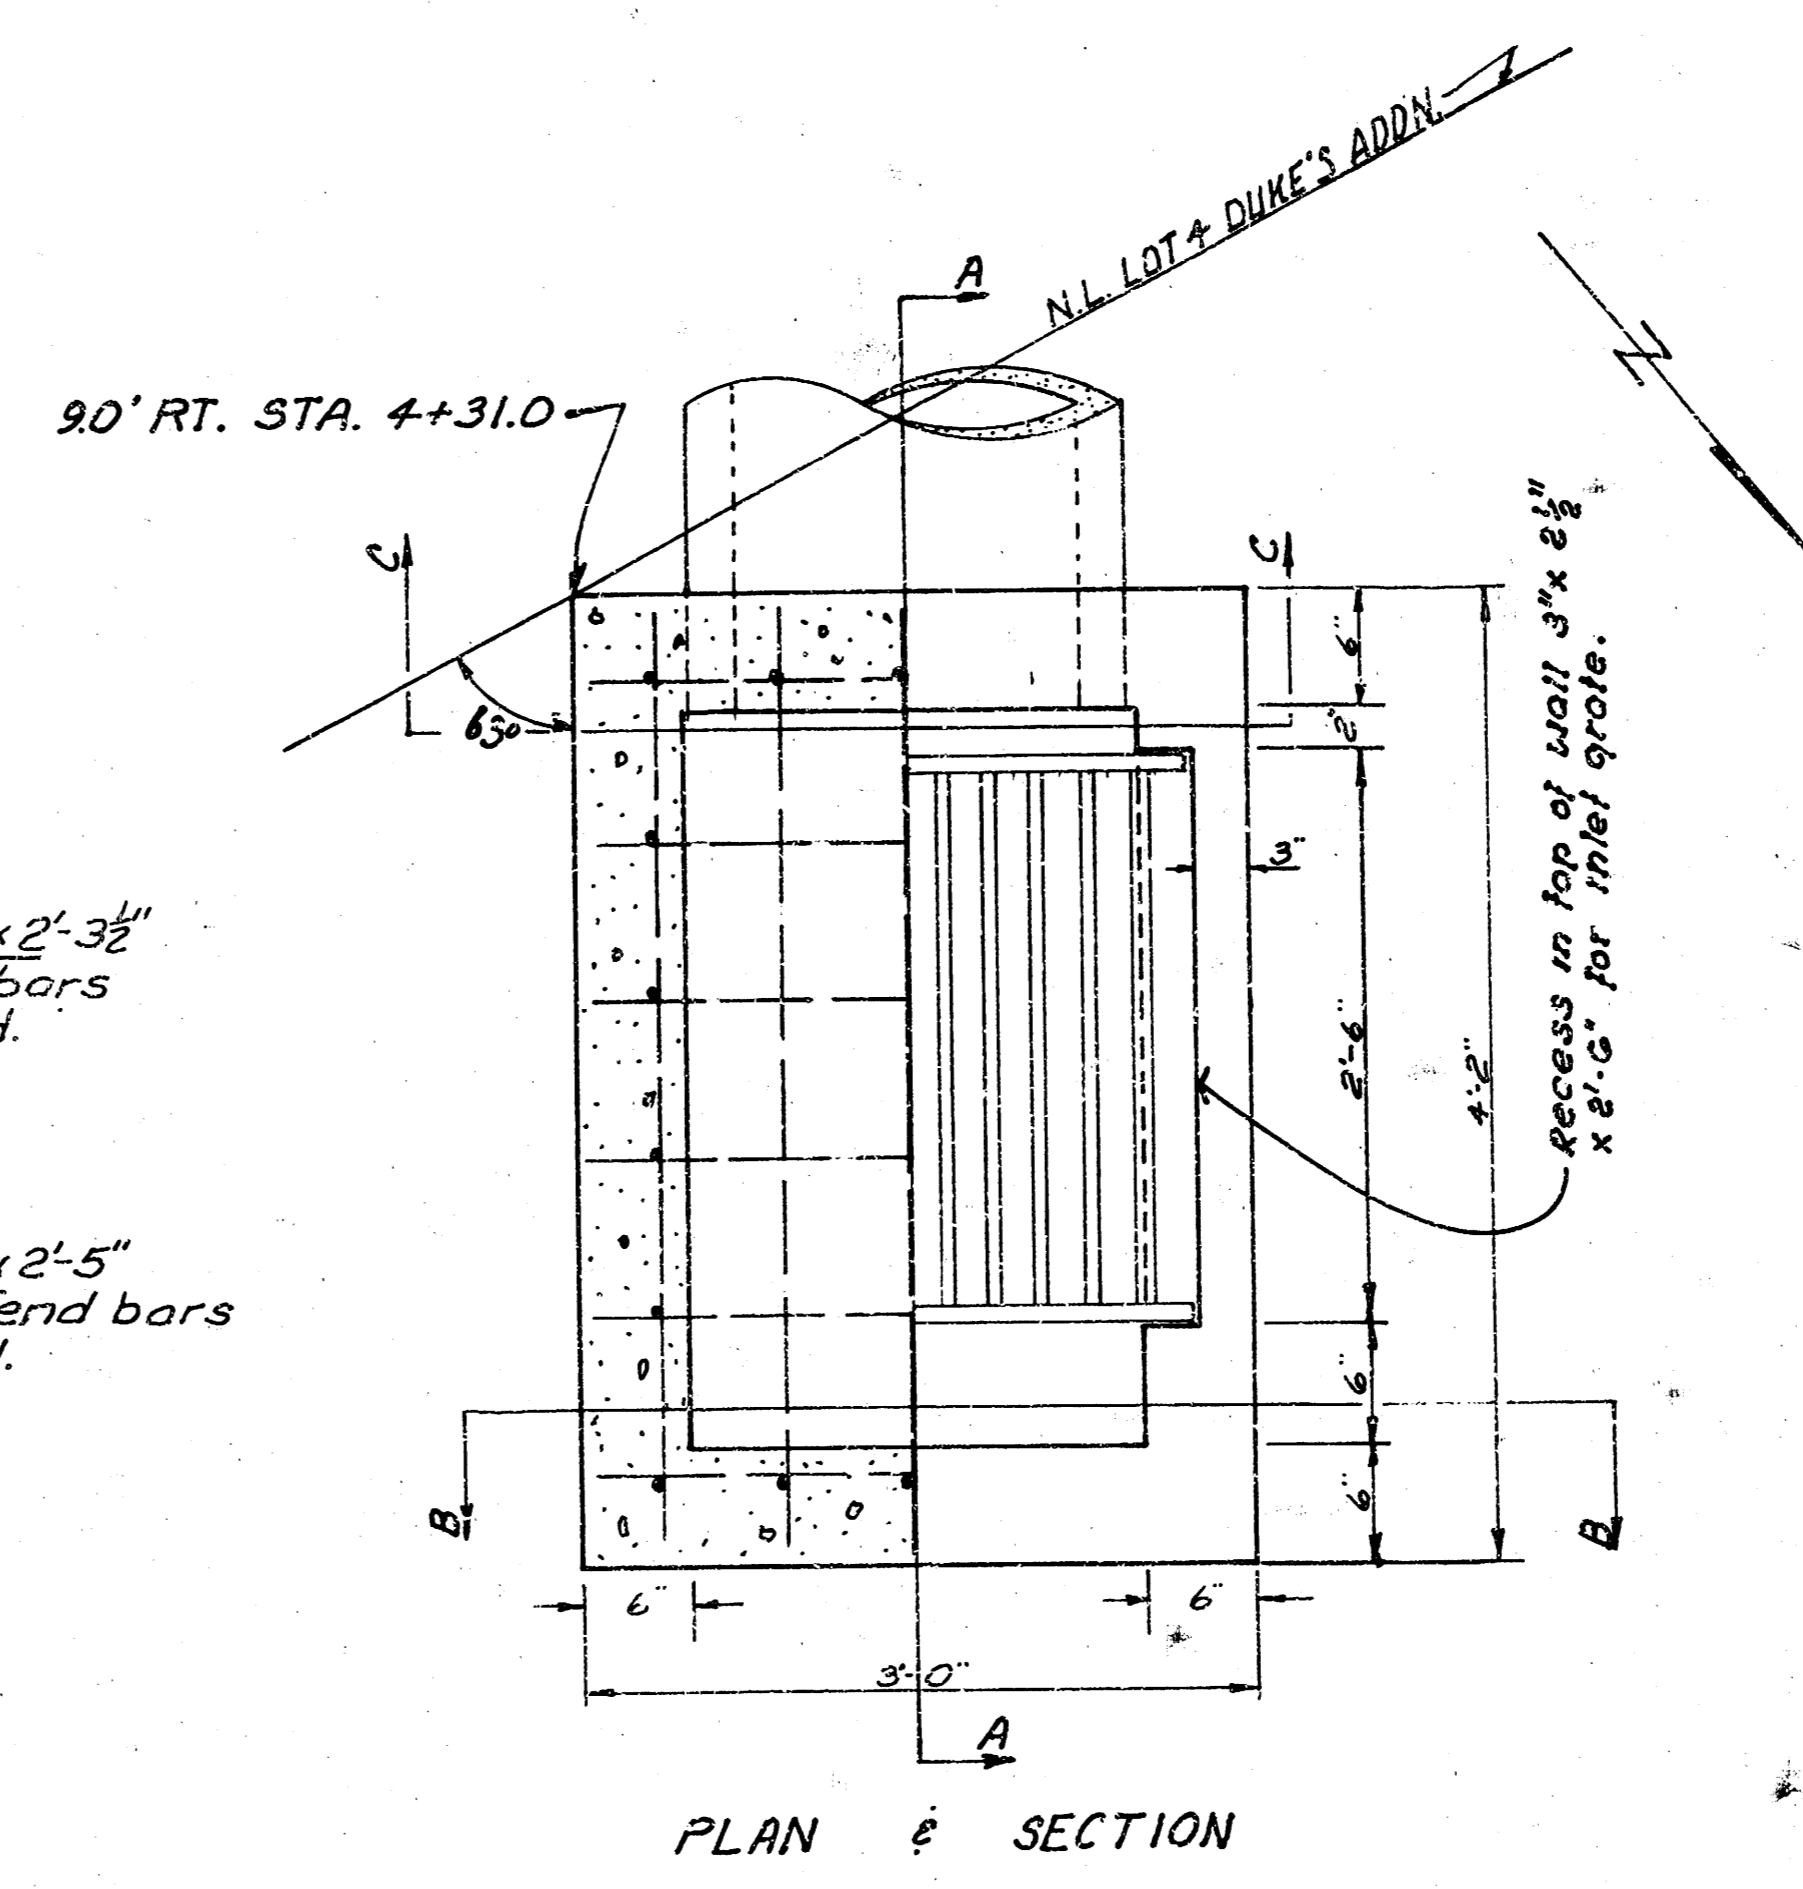


PLAN & SECTION

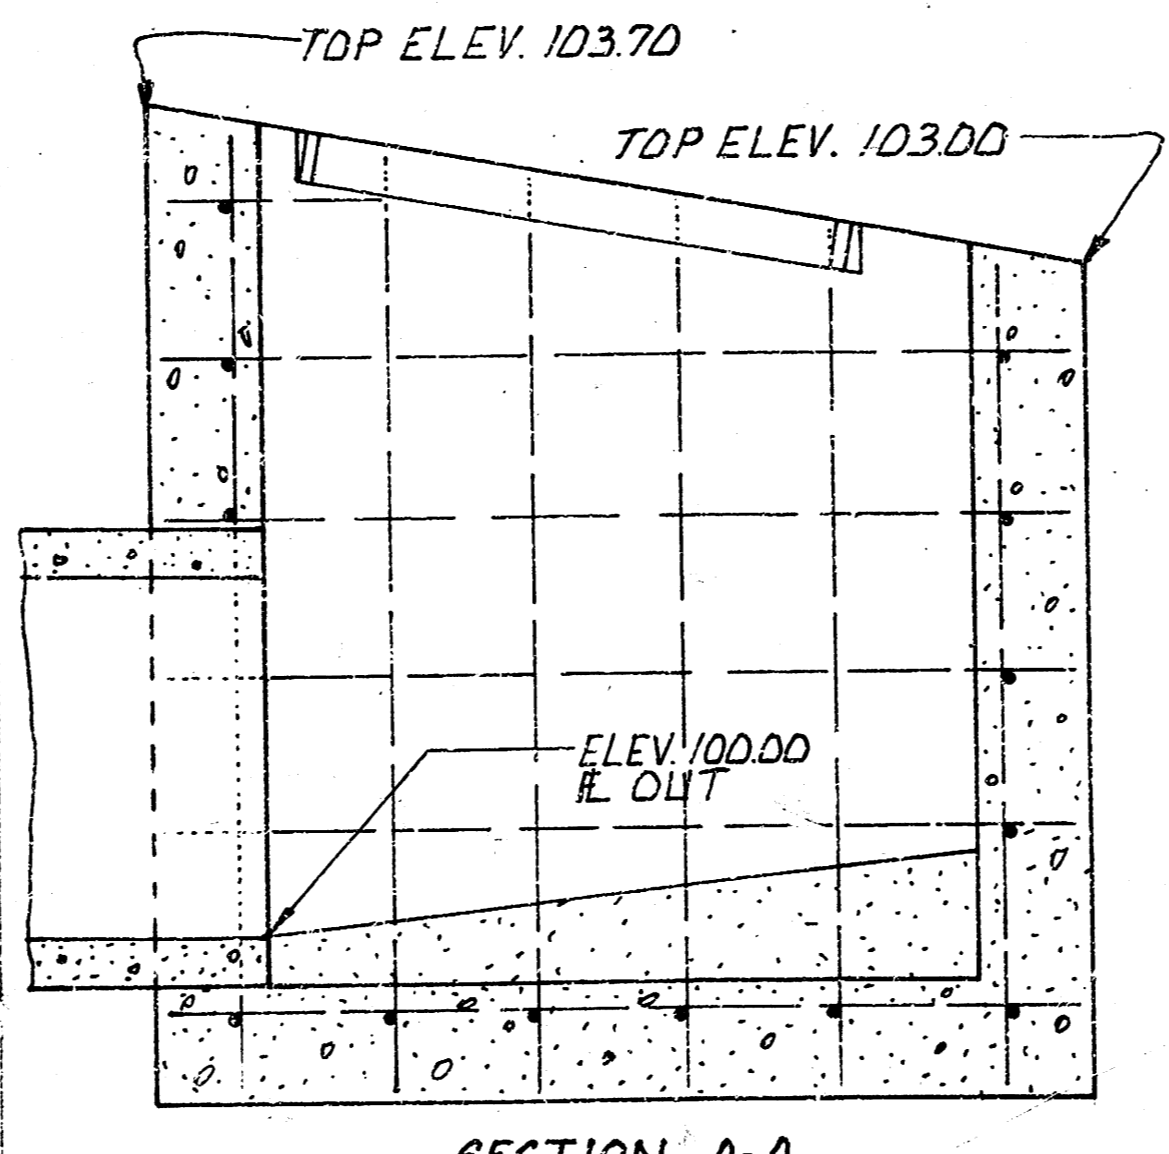

SECTION A-A

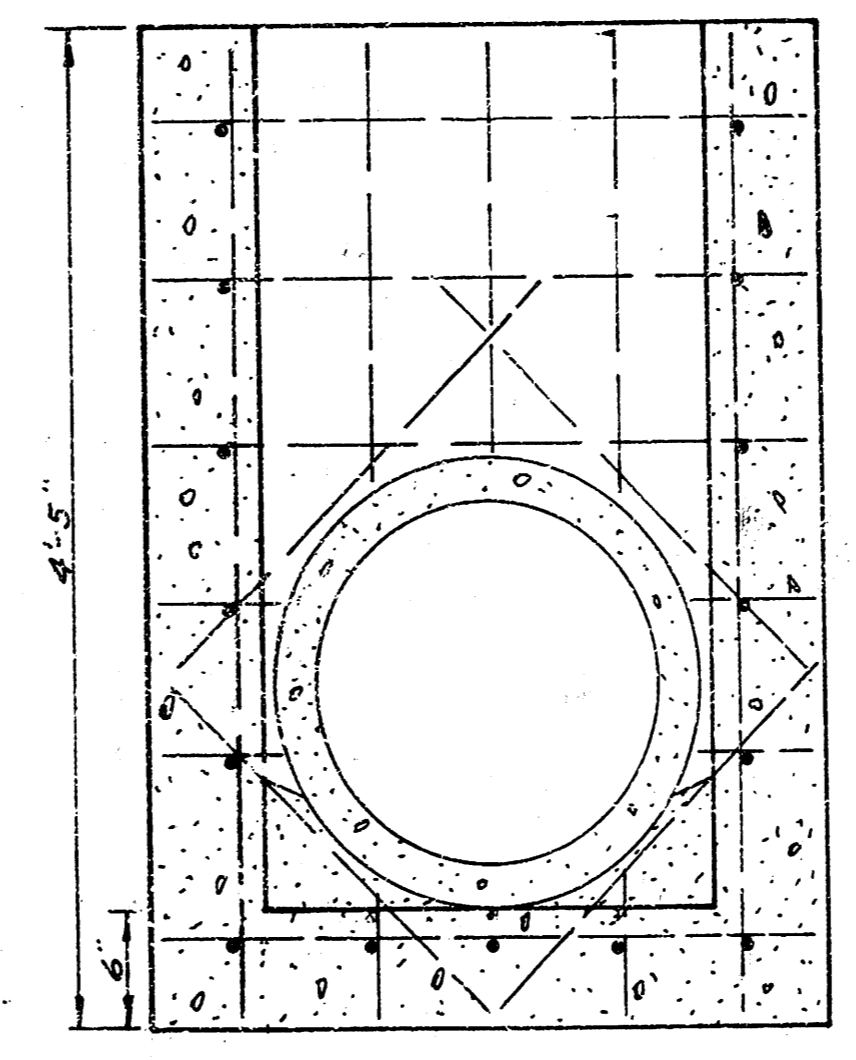


SECTION C-C

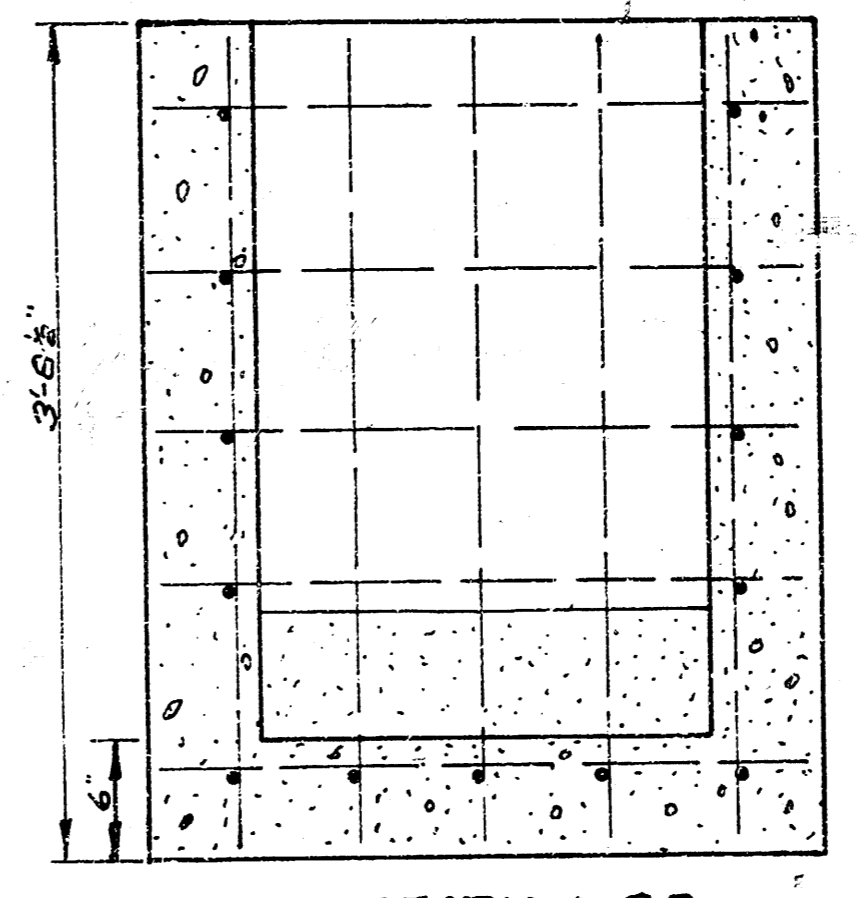


SECTION B-B


REINFORCED CONCRETE INLET DETAIL
90' RT. STA. 4+31

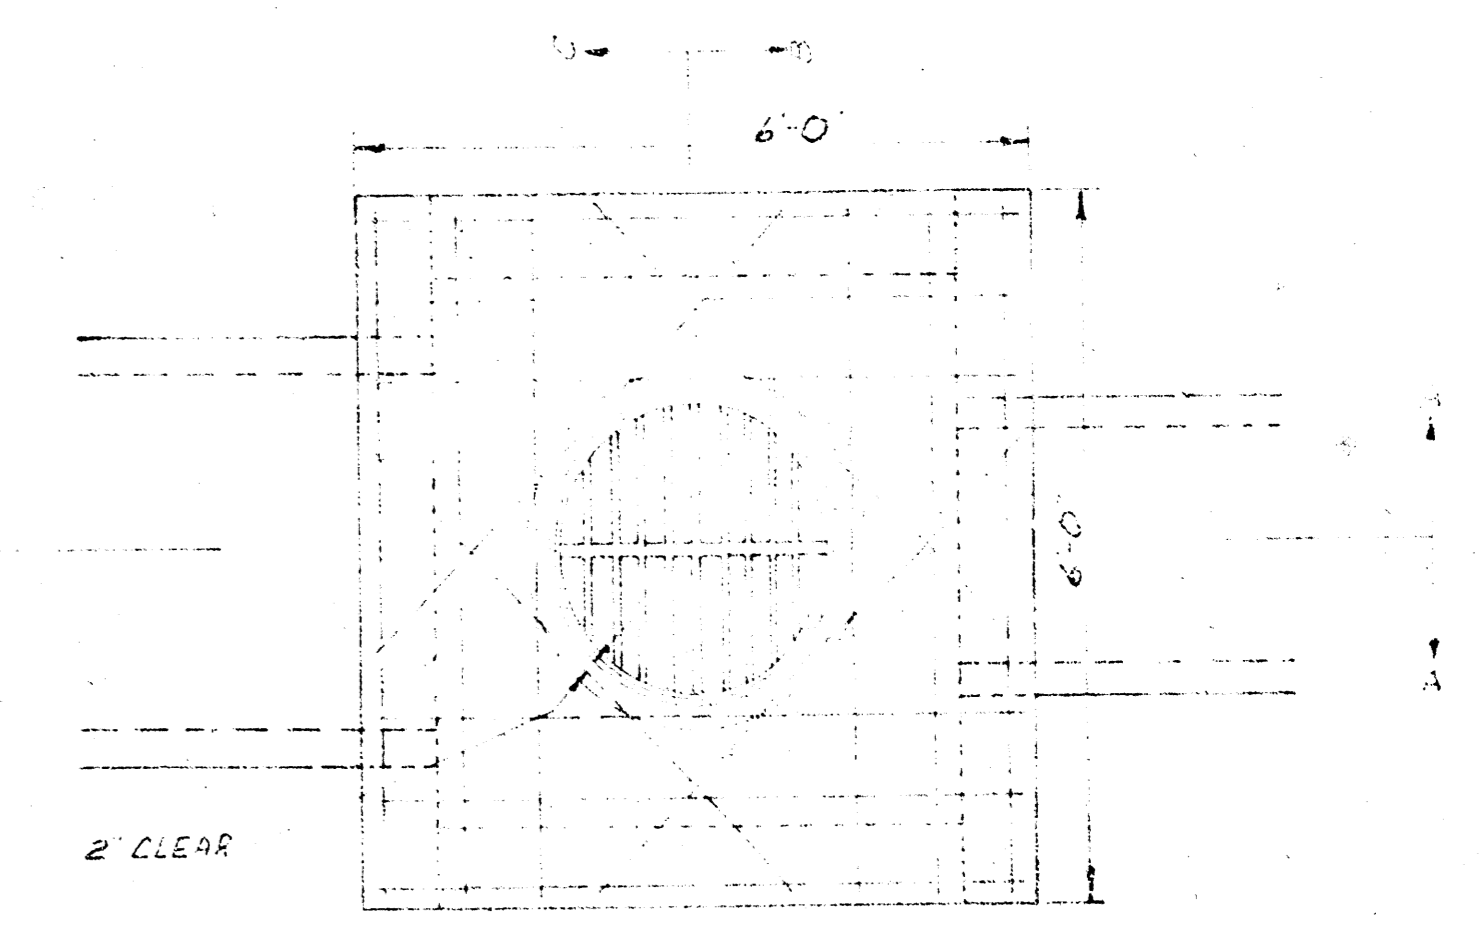


PLAN VIEW

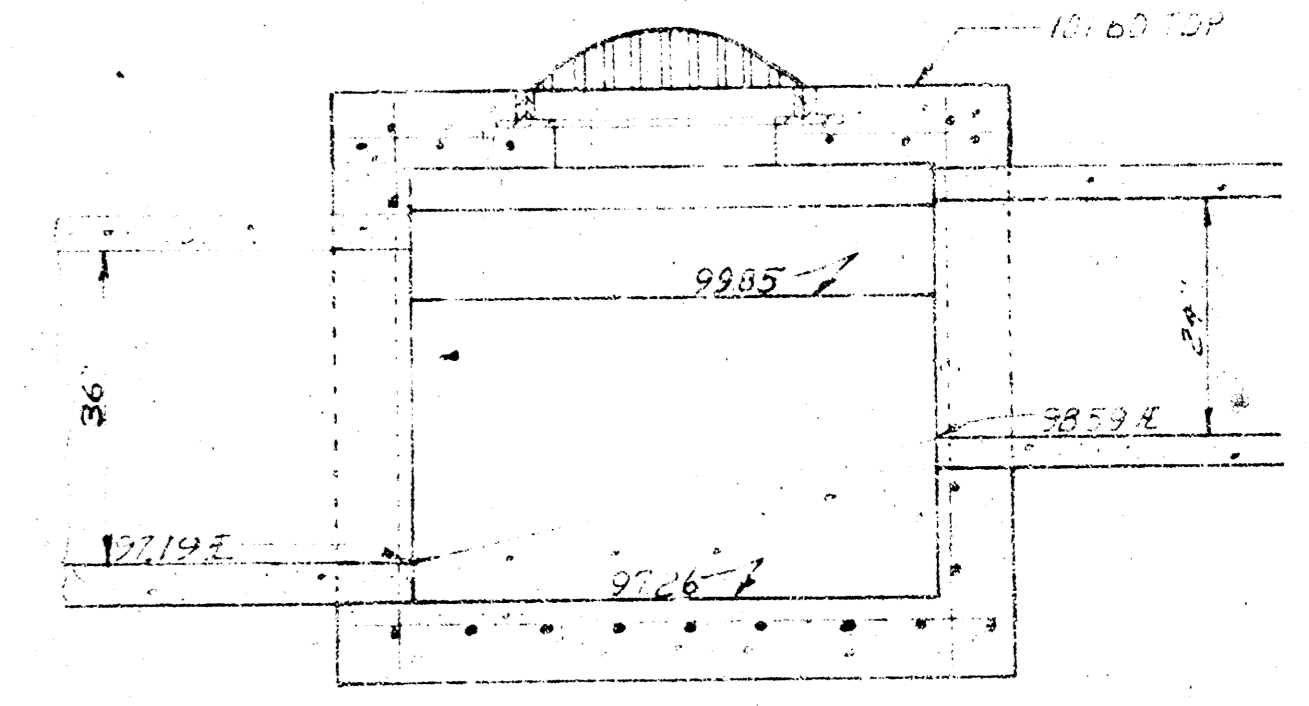

SECTION AA

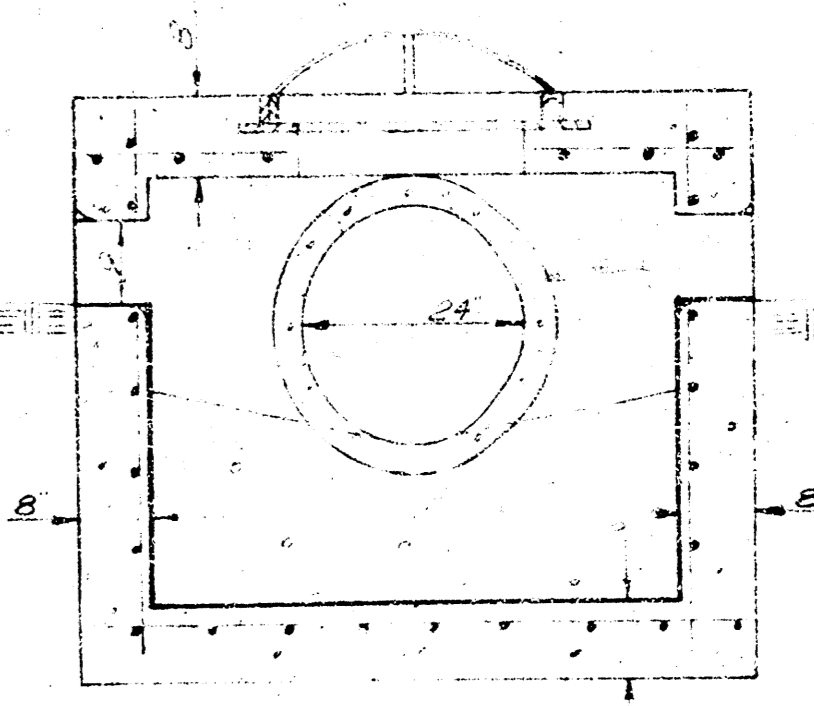

SECTION BB

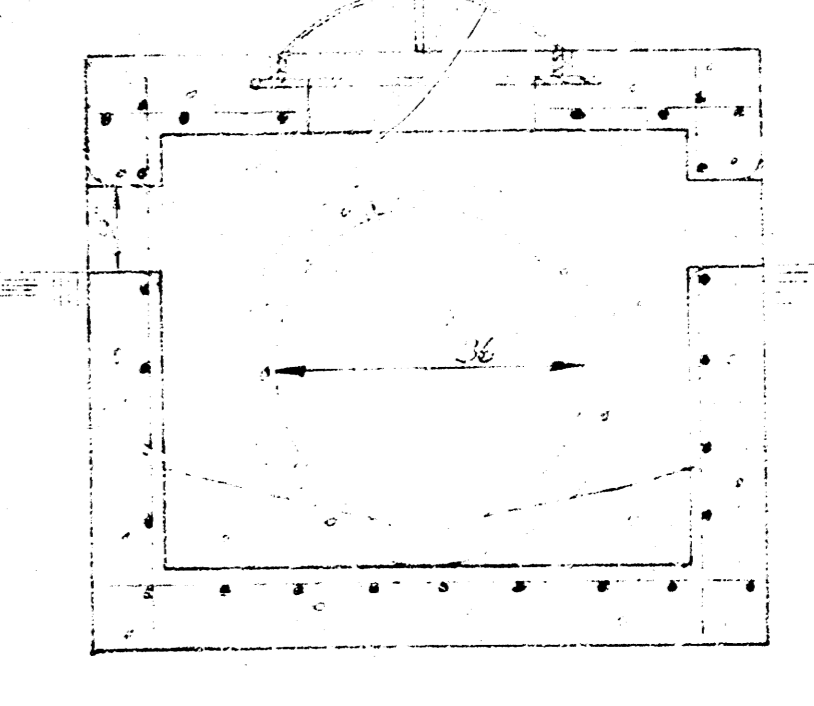

SECTION CC

REINFORCED CONCRETE INLET MANHOLE DETAIL
STA. 7+40

