


Private Project
 Median Modification - 81 Ft of Median on Maple West of West Street
 472-76-245-80000-000-000-008

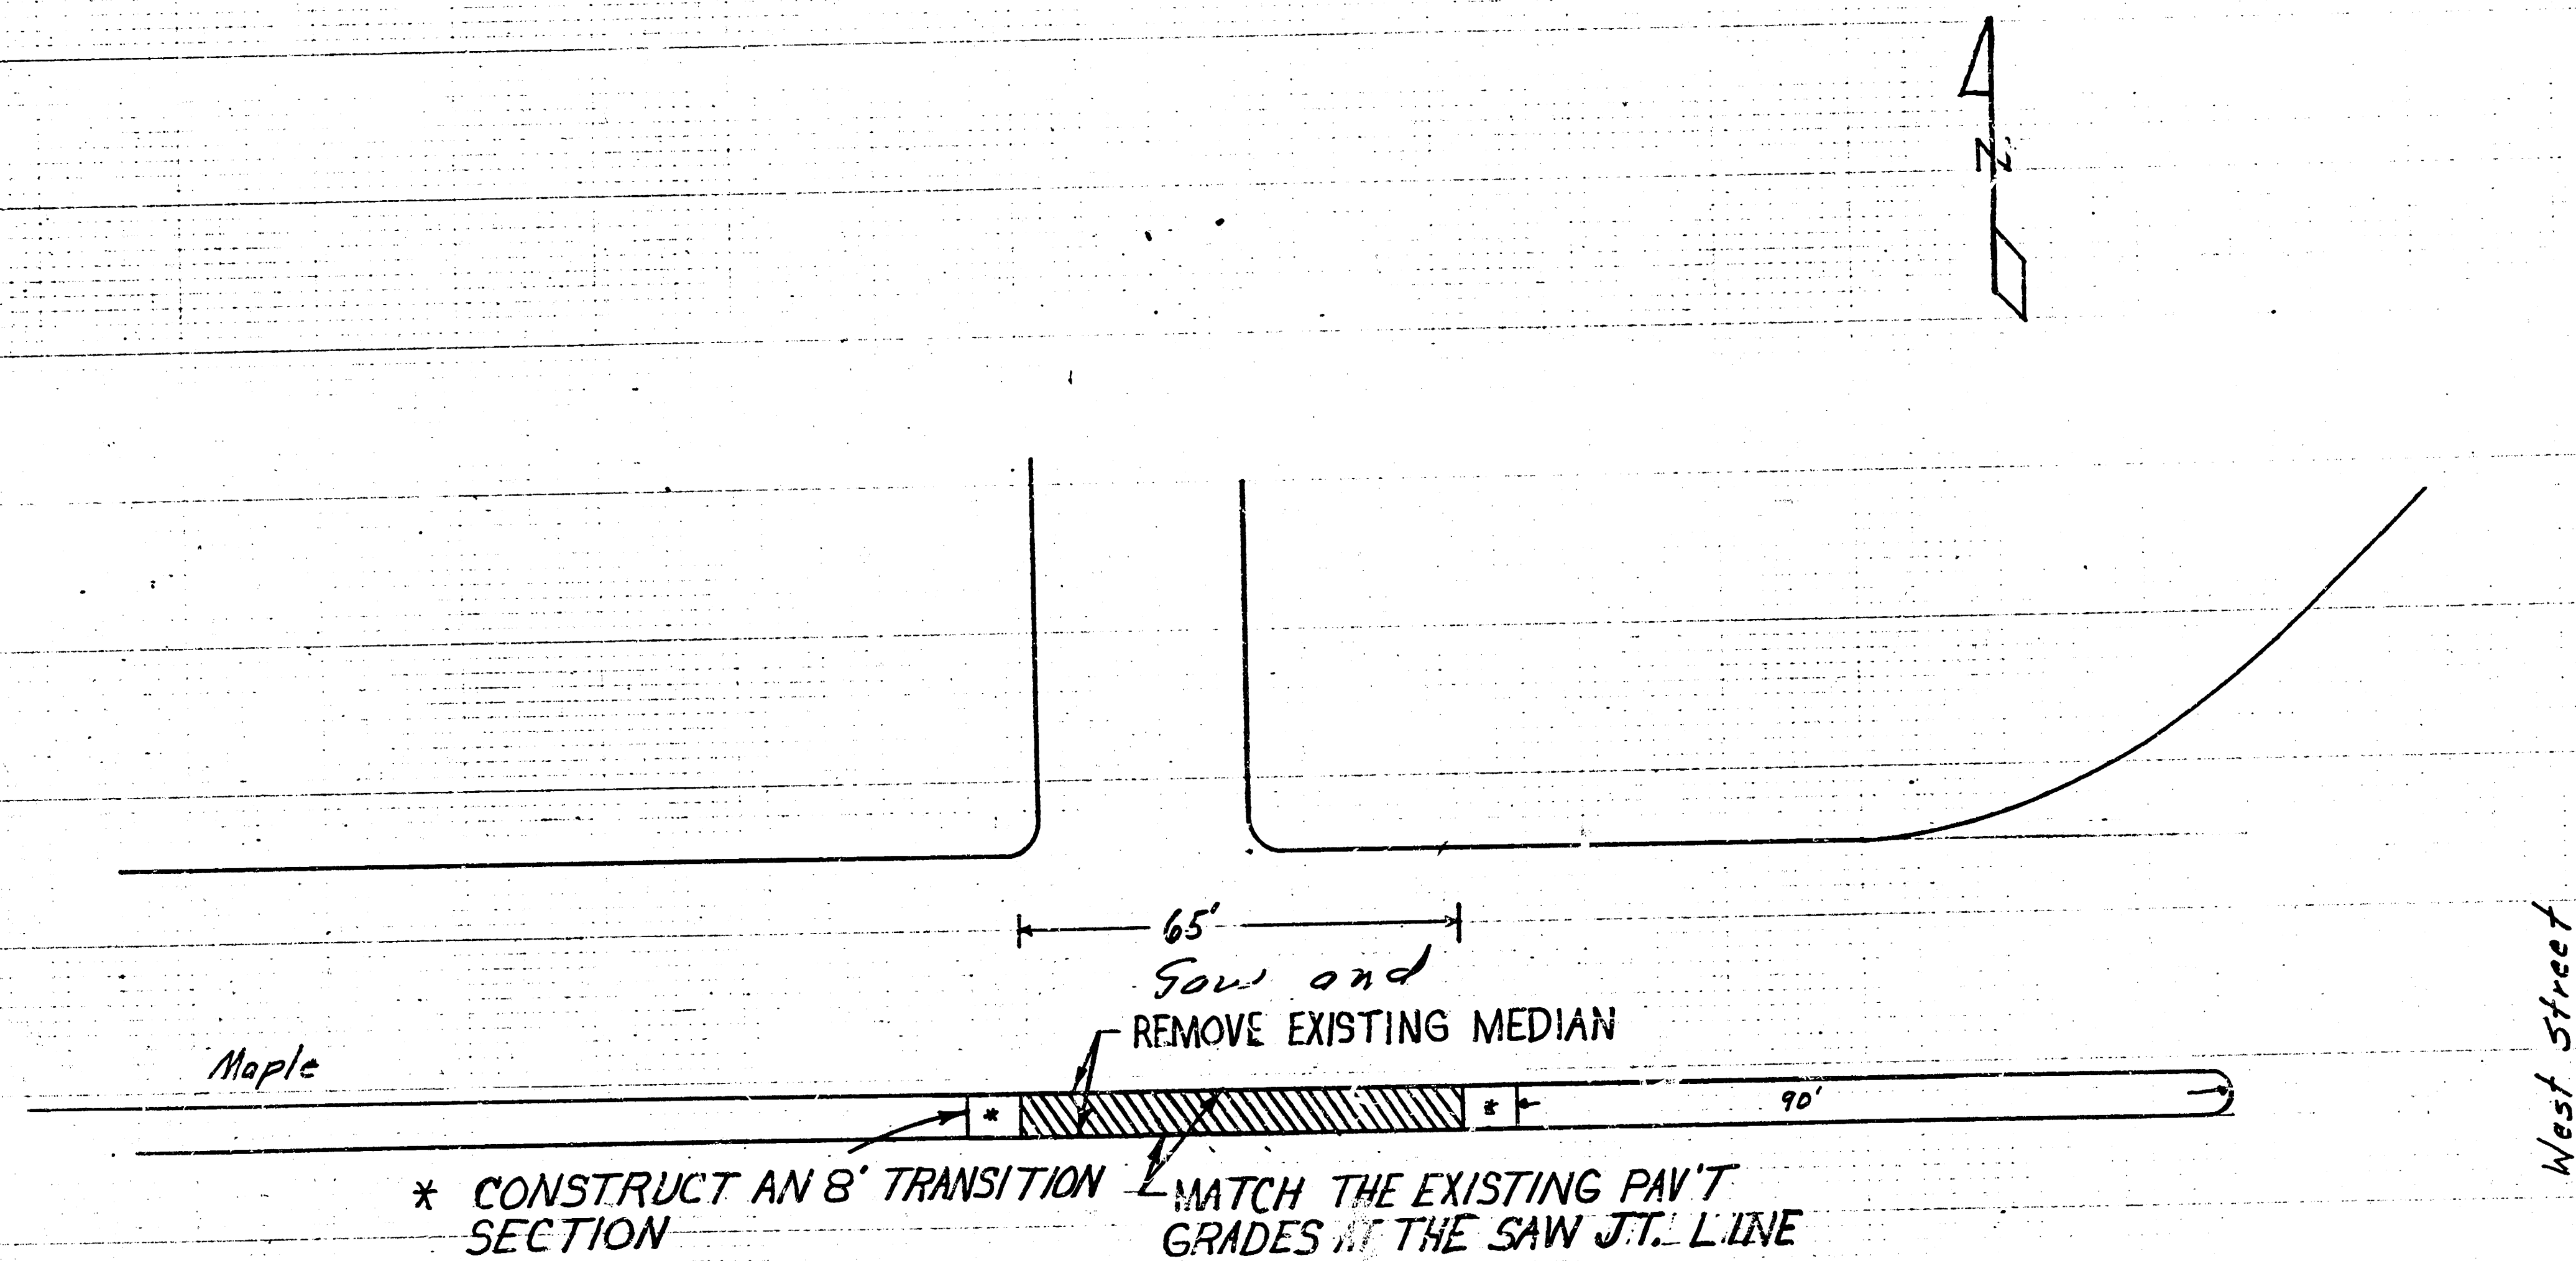

- * Construct 8" Conc Pavement Reinf. With 6" x 12" W4x4 W.W.F.
- Contractor shall provide adequate traffic control
- Maintain one lane traffic in each direction
- Concrete joints to match existing pavement joints
- Compact existing subgrade
- Utilize existing steel to tie new pavement to existing pavement
- Lump Sum

* If present island is on concrete pavement
 Removal of island, patch holes & construct transitions will complete this project

NO SCALE - Wichita Kansas
 1984

NOTE TO CONTRACTOR

This project will be constructed under the supervision of the CITY ENGINEER and conforming to the SPECIFICATIONS of the CITY OF WICHITA. THE CONTRACTOR shall be responsible for all costs of this project.

11-9-84

APPROVED AS NOTED
 By CITY ENGINEER OF WICHITA
 Sanitary Sewers
 Storm Sewers
 Pavement
 Utility Approaches P.E.D.