

Market - S.E. Corner - S.E. English

New Section - Remains Hypothesis

Point A on
Continued Work

Market

New Section

Remains Hypothesis

420

Remains
Hypothesis

Elm
75

50

15' R

50

70

10
11
12

THIRD ST

CENTRAL AVE

600'

New gutter

Downspout removed

25'

80'

Post Street Light

New gutter

downspout removed

Remove

curb

install new

downspout

downspout

70'

Take out

base

SECOND 54.

New butter remove old ~~stone~~ butter

600

225 - Case Name
10/1/19

Use G.R.

THIRD ST.

Received
by the
Attorney
General

Close Drive
North Hotel
Kensington
No. 100

New Search

~~SECRET~~ *SECRET*

About half (100)

James Leonard Brown
and Sumner
Howard Brown.
Part 1.

WILLIAM

130'

36'

120'

DOUGLAS

Hard Rock

Hard Rock

8"

Crown Exposed
Boulder Layer
Pavement


150'


16'

120'

DOUGLAS

FIRST ST.

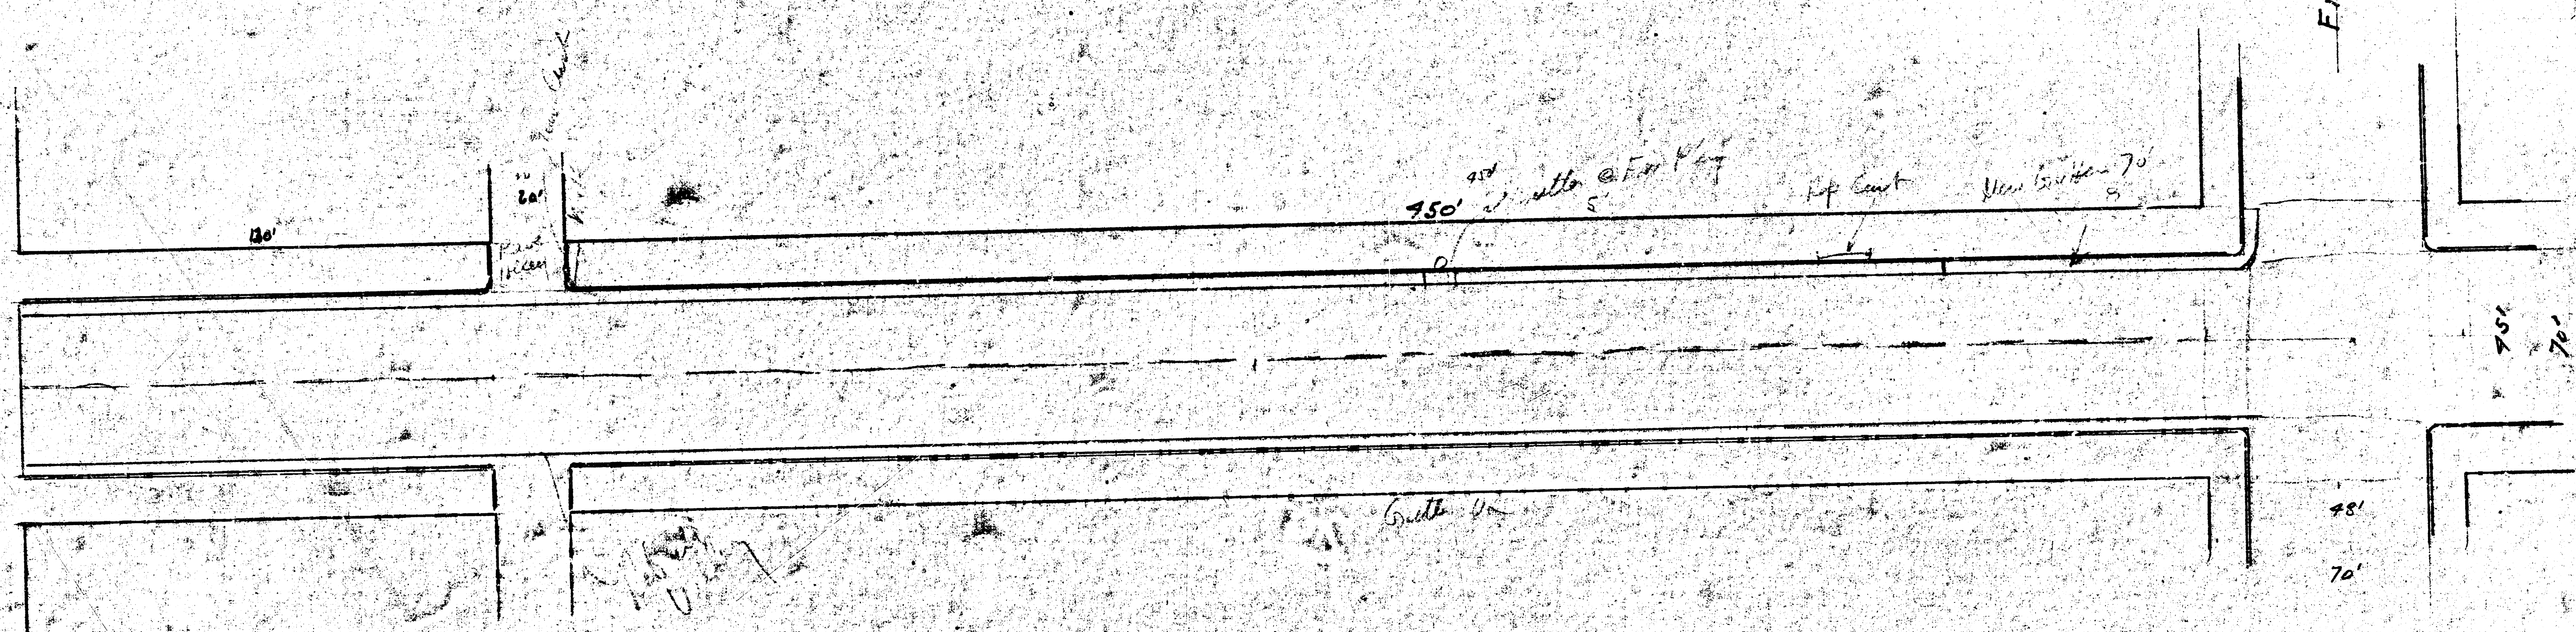

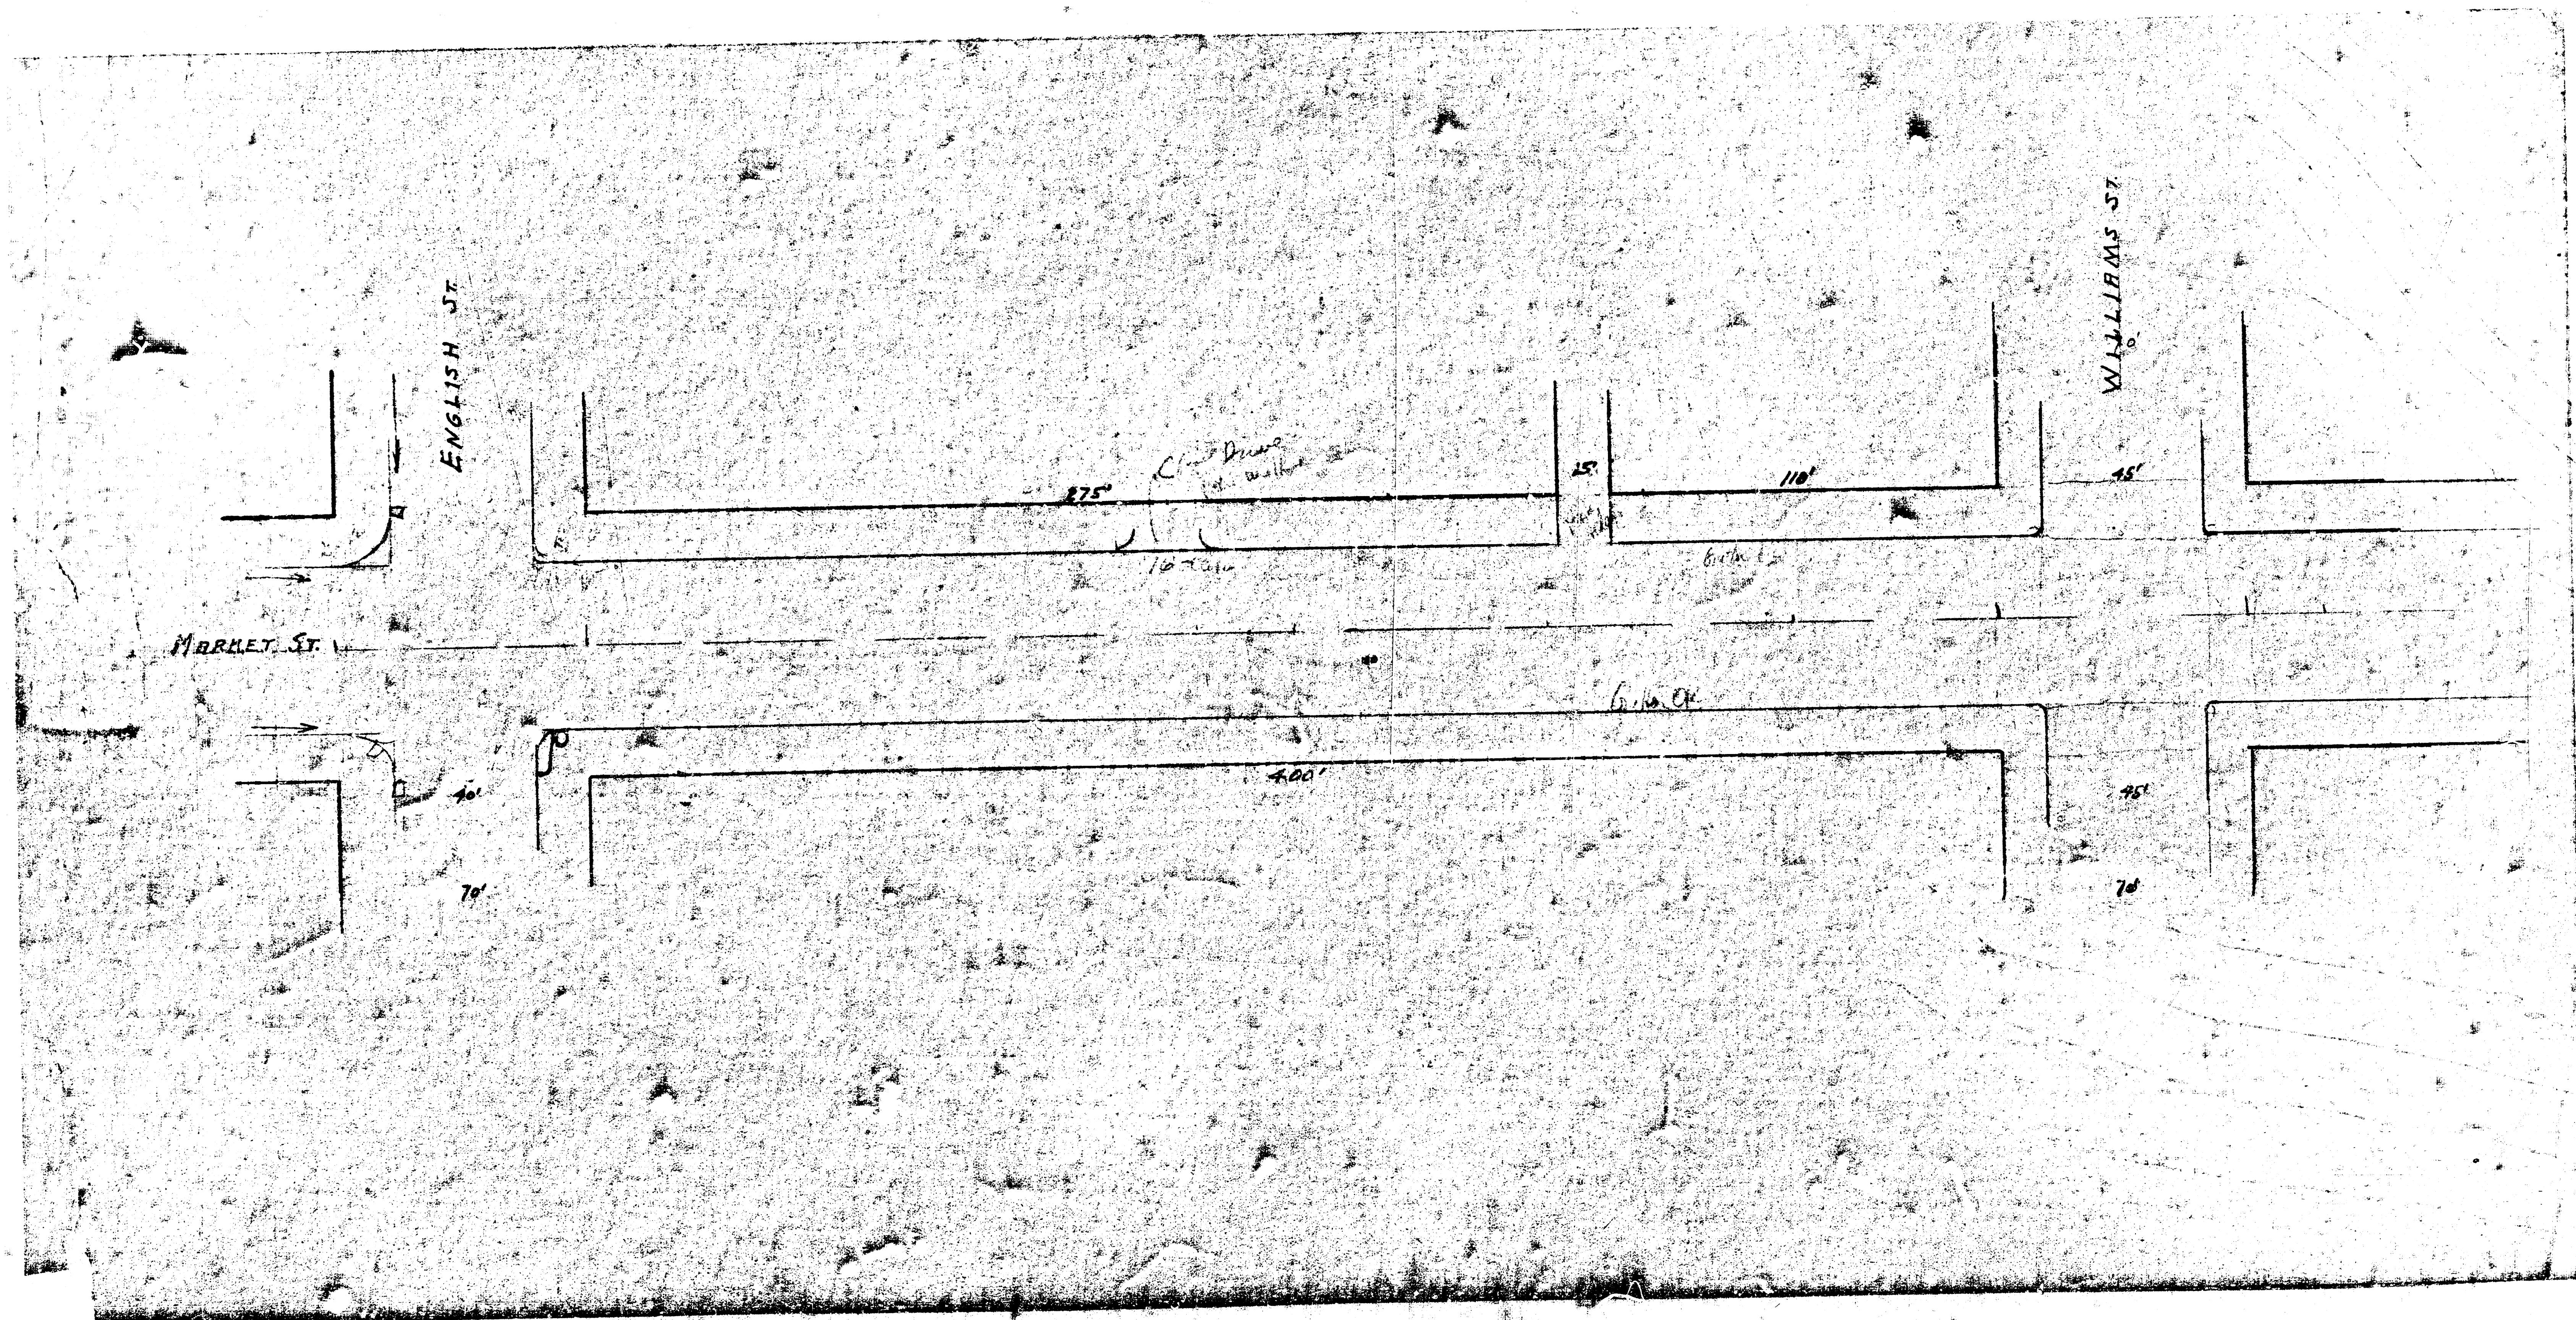

FIRST ST

SECOND ST

Grade Road

800' x 100' Drain

Settlement of road surface
replaced by new concrete

600' 600'
New curb except 75' in front of house

New gutter - narrow - replace
by 20" curb + low wall

236

Eliminate raised
crossing in front of
house of C. H.

75'

70'

70'