


NOTE:
THIS PORTION OF MENTOR ST. SUB.
WAS PUT ON BROWN ST. JOB,
DON'T INCLUDE ELEV. ON THIS JOB

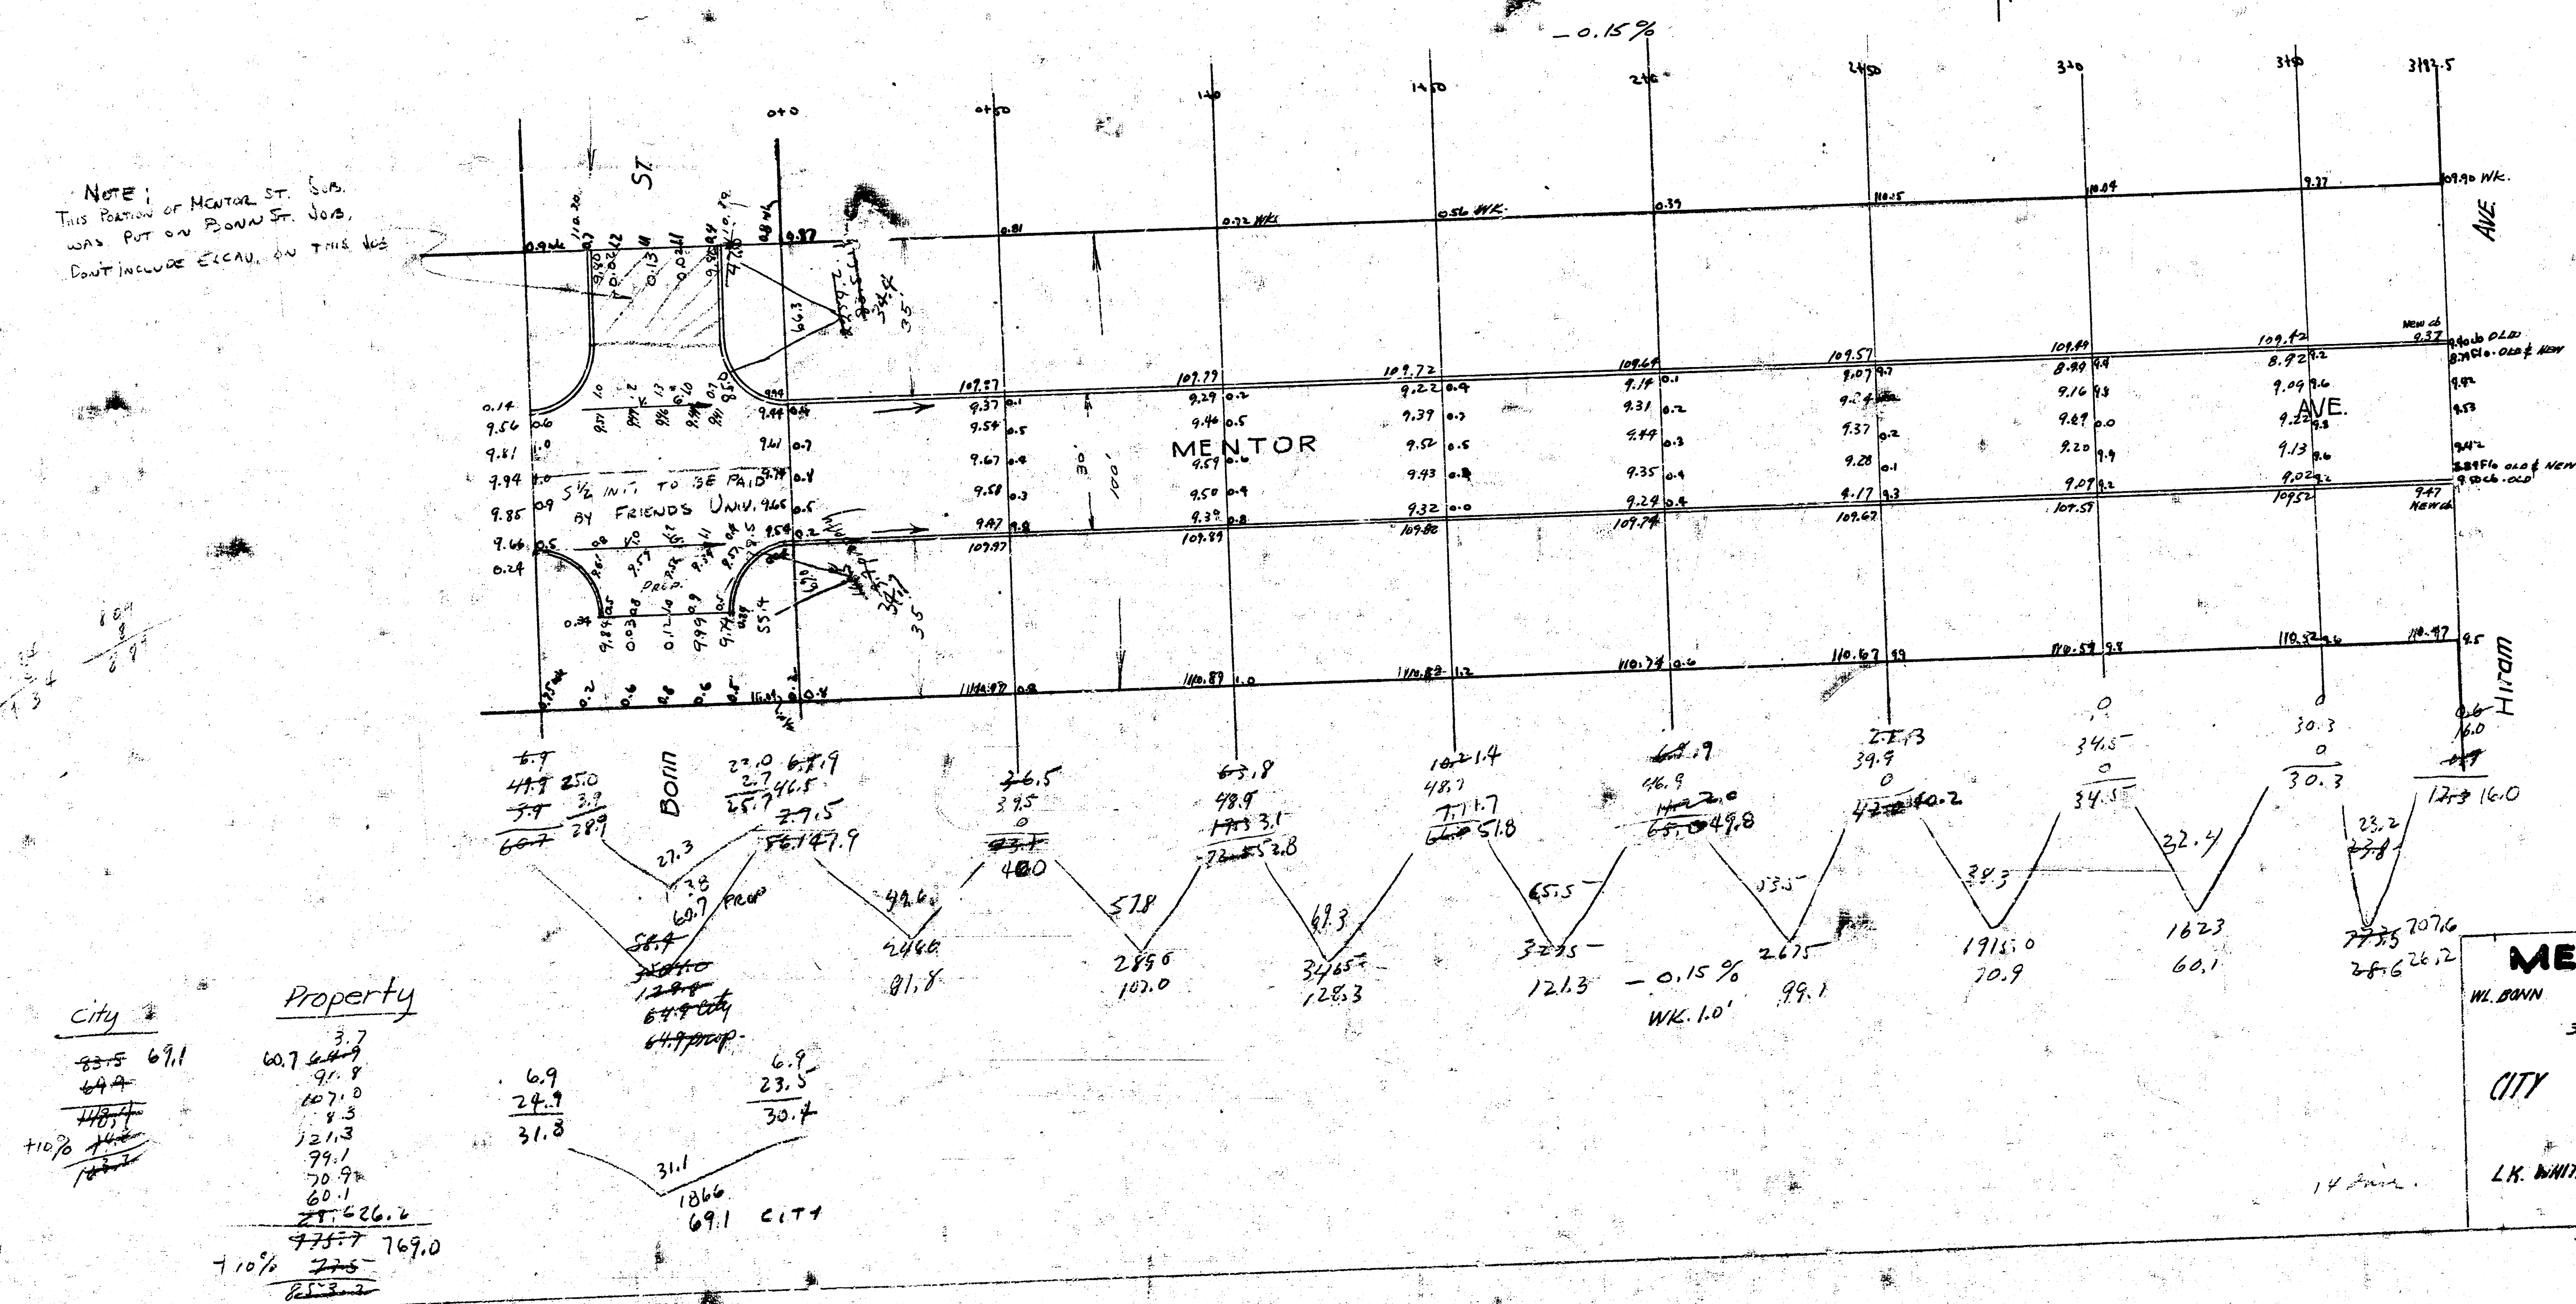

MENTOR AVE.
W.L. BARN 1/0 W.L. HIRAM
30" CONCRETE & CB.
CITY OF WICHITA, KAN.
Engineering Division
L.K. WHITE CITY ENGINEER
JULY 1997