
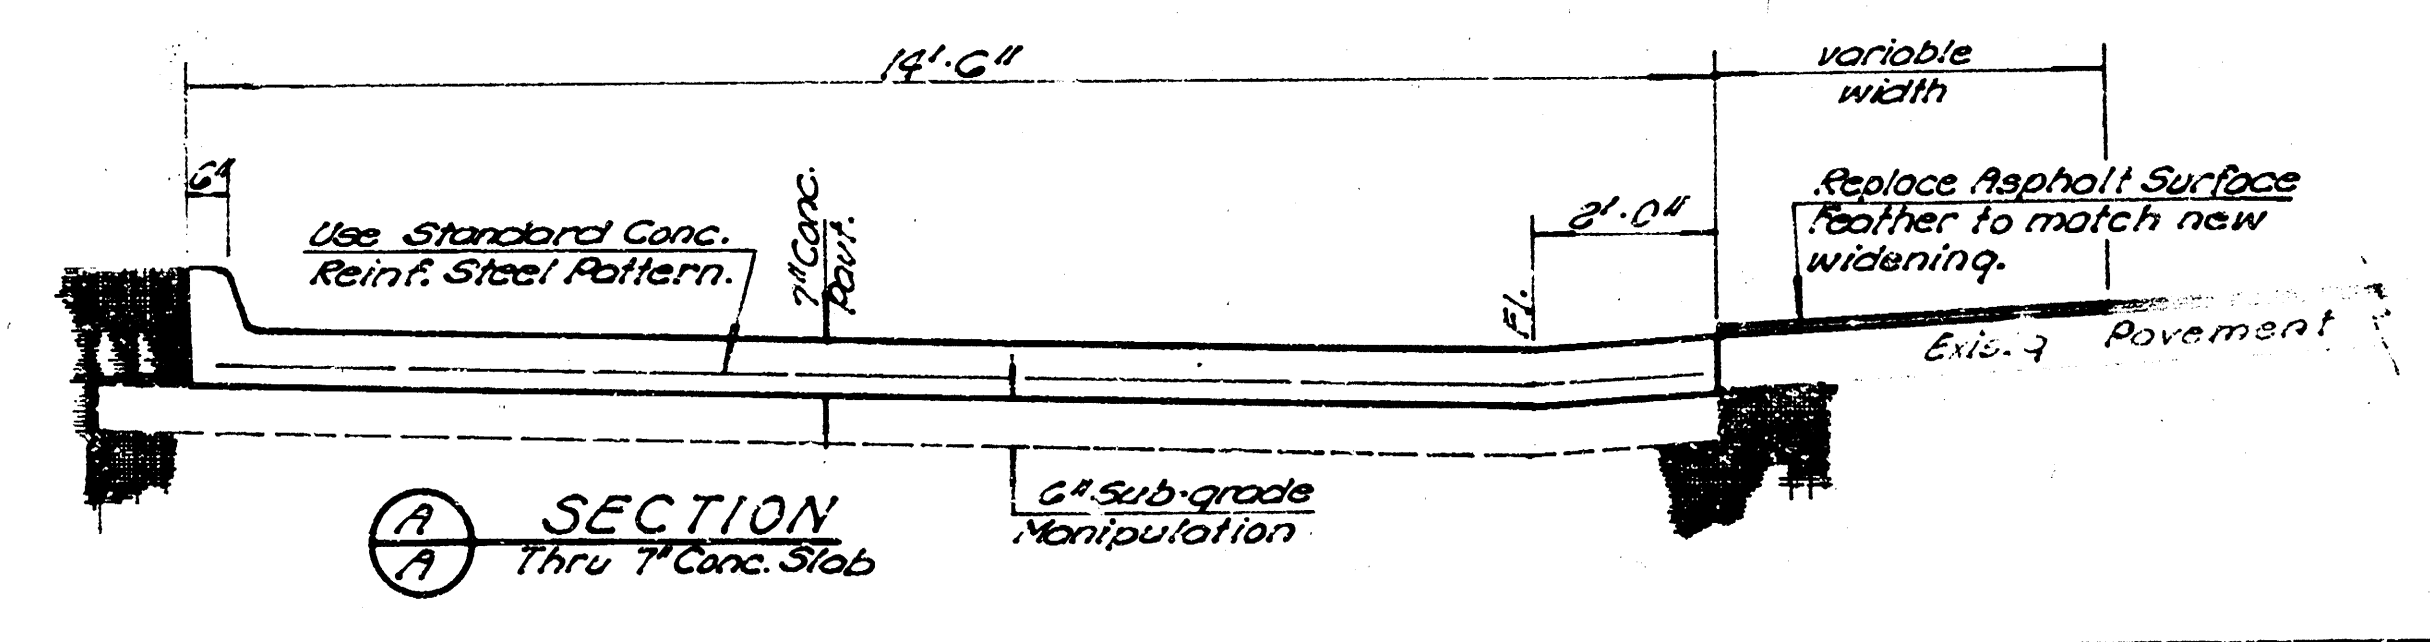


Stamps
City of Wichita
Seal
City Engineer

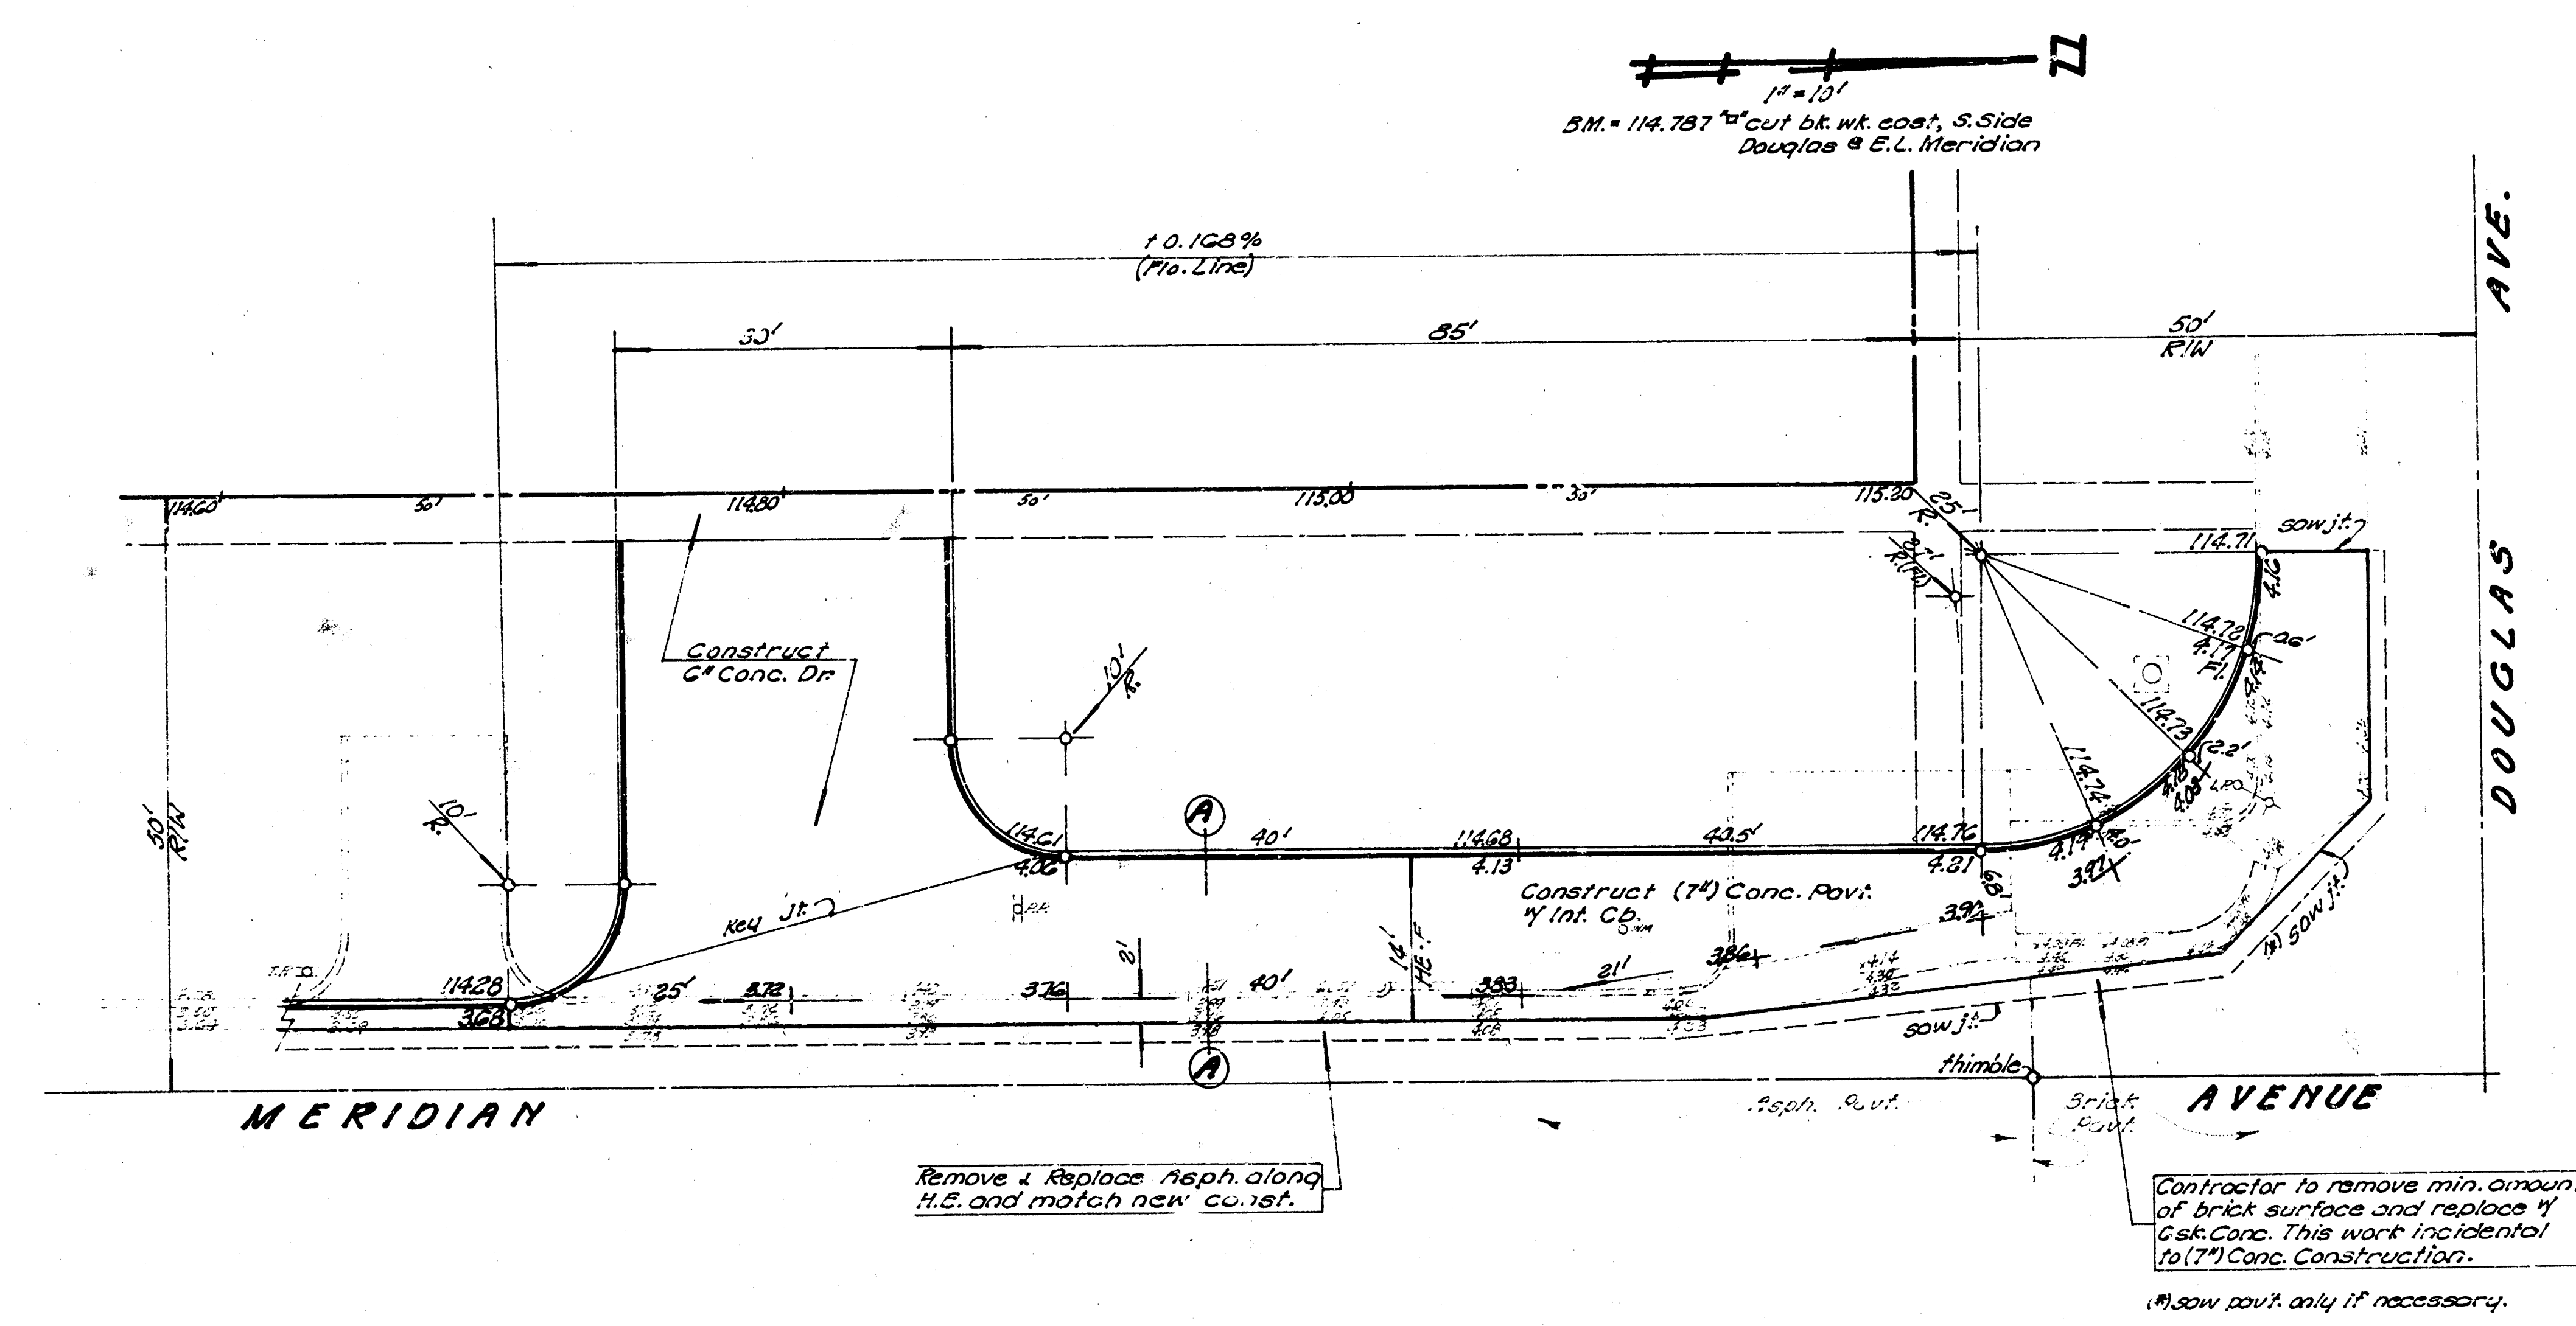

NOTE TO CONTRACTOR
This work is to be constructed under the supervision of the CITY ENGINEER and in accordance with the SPECIFICATIONS of the City of Wichita. The CONTRACTOR shall reimburse the City of Wichita for the cost of engineering, Plans, and inspection.

BILL OF MATERIALS		
Quantity	Unit	Item
245	Sq	7\" Concrete Pavement
120	LF	Int. Curb
35	LF	Sep. Curb
1130	SF	6\" Drive
35	LF	Key Jt.
40	Cy	Excavation
170	LF	Saw Jt.
265	Sq	Sub-grade Manipulation
4	Tons	Portland Cement or Lime
1300	Lbs	Reinf. Steel
170	Sq	Pavement Rem.
75	Sq	Asph. Mat. Rem.


7\" CONG. DECEL. LANE
Southwest Corner Meridian & Douglas
for DILLON'S FOOD STORES

City of Wichita, Kansas
R.W. Linn City Engineer
Date: May 1972 Proj. No. AAKB 502014

BM 114.767 Cut St. W. East, S.S. Douglas & E.L. Meridian

11 650
To 14 Ave.
Circ 11/49
NW Richmond & Douglas

DILLON STORE #3

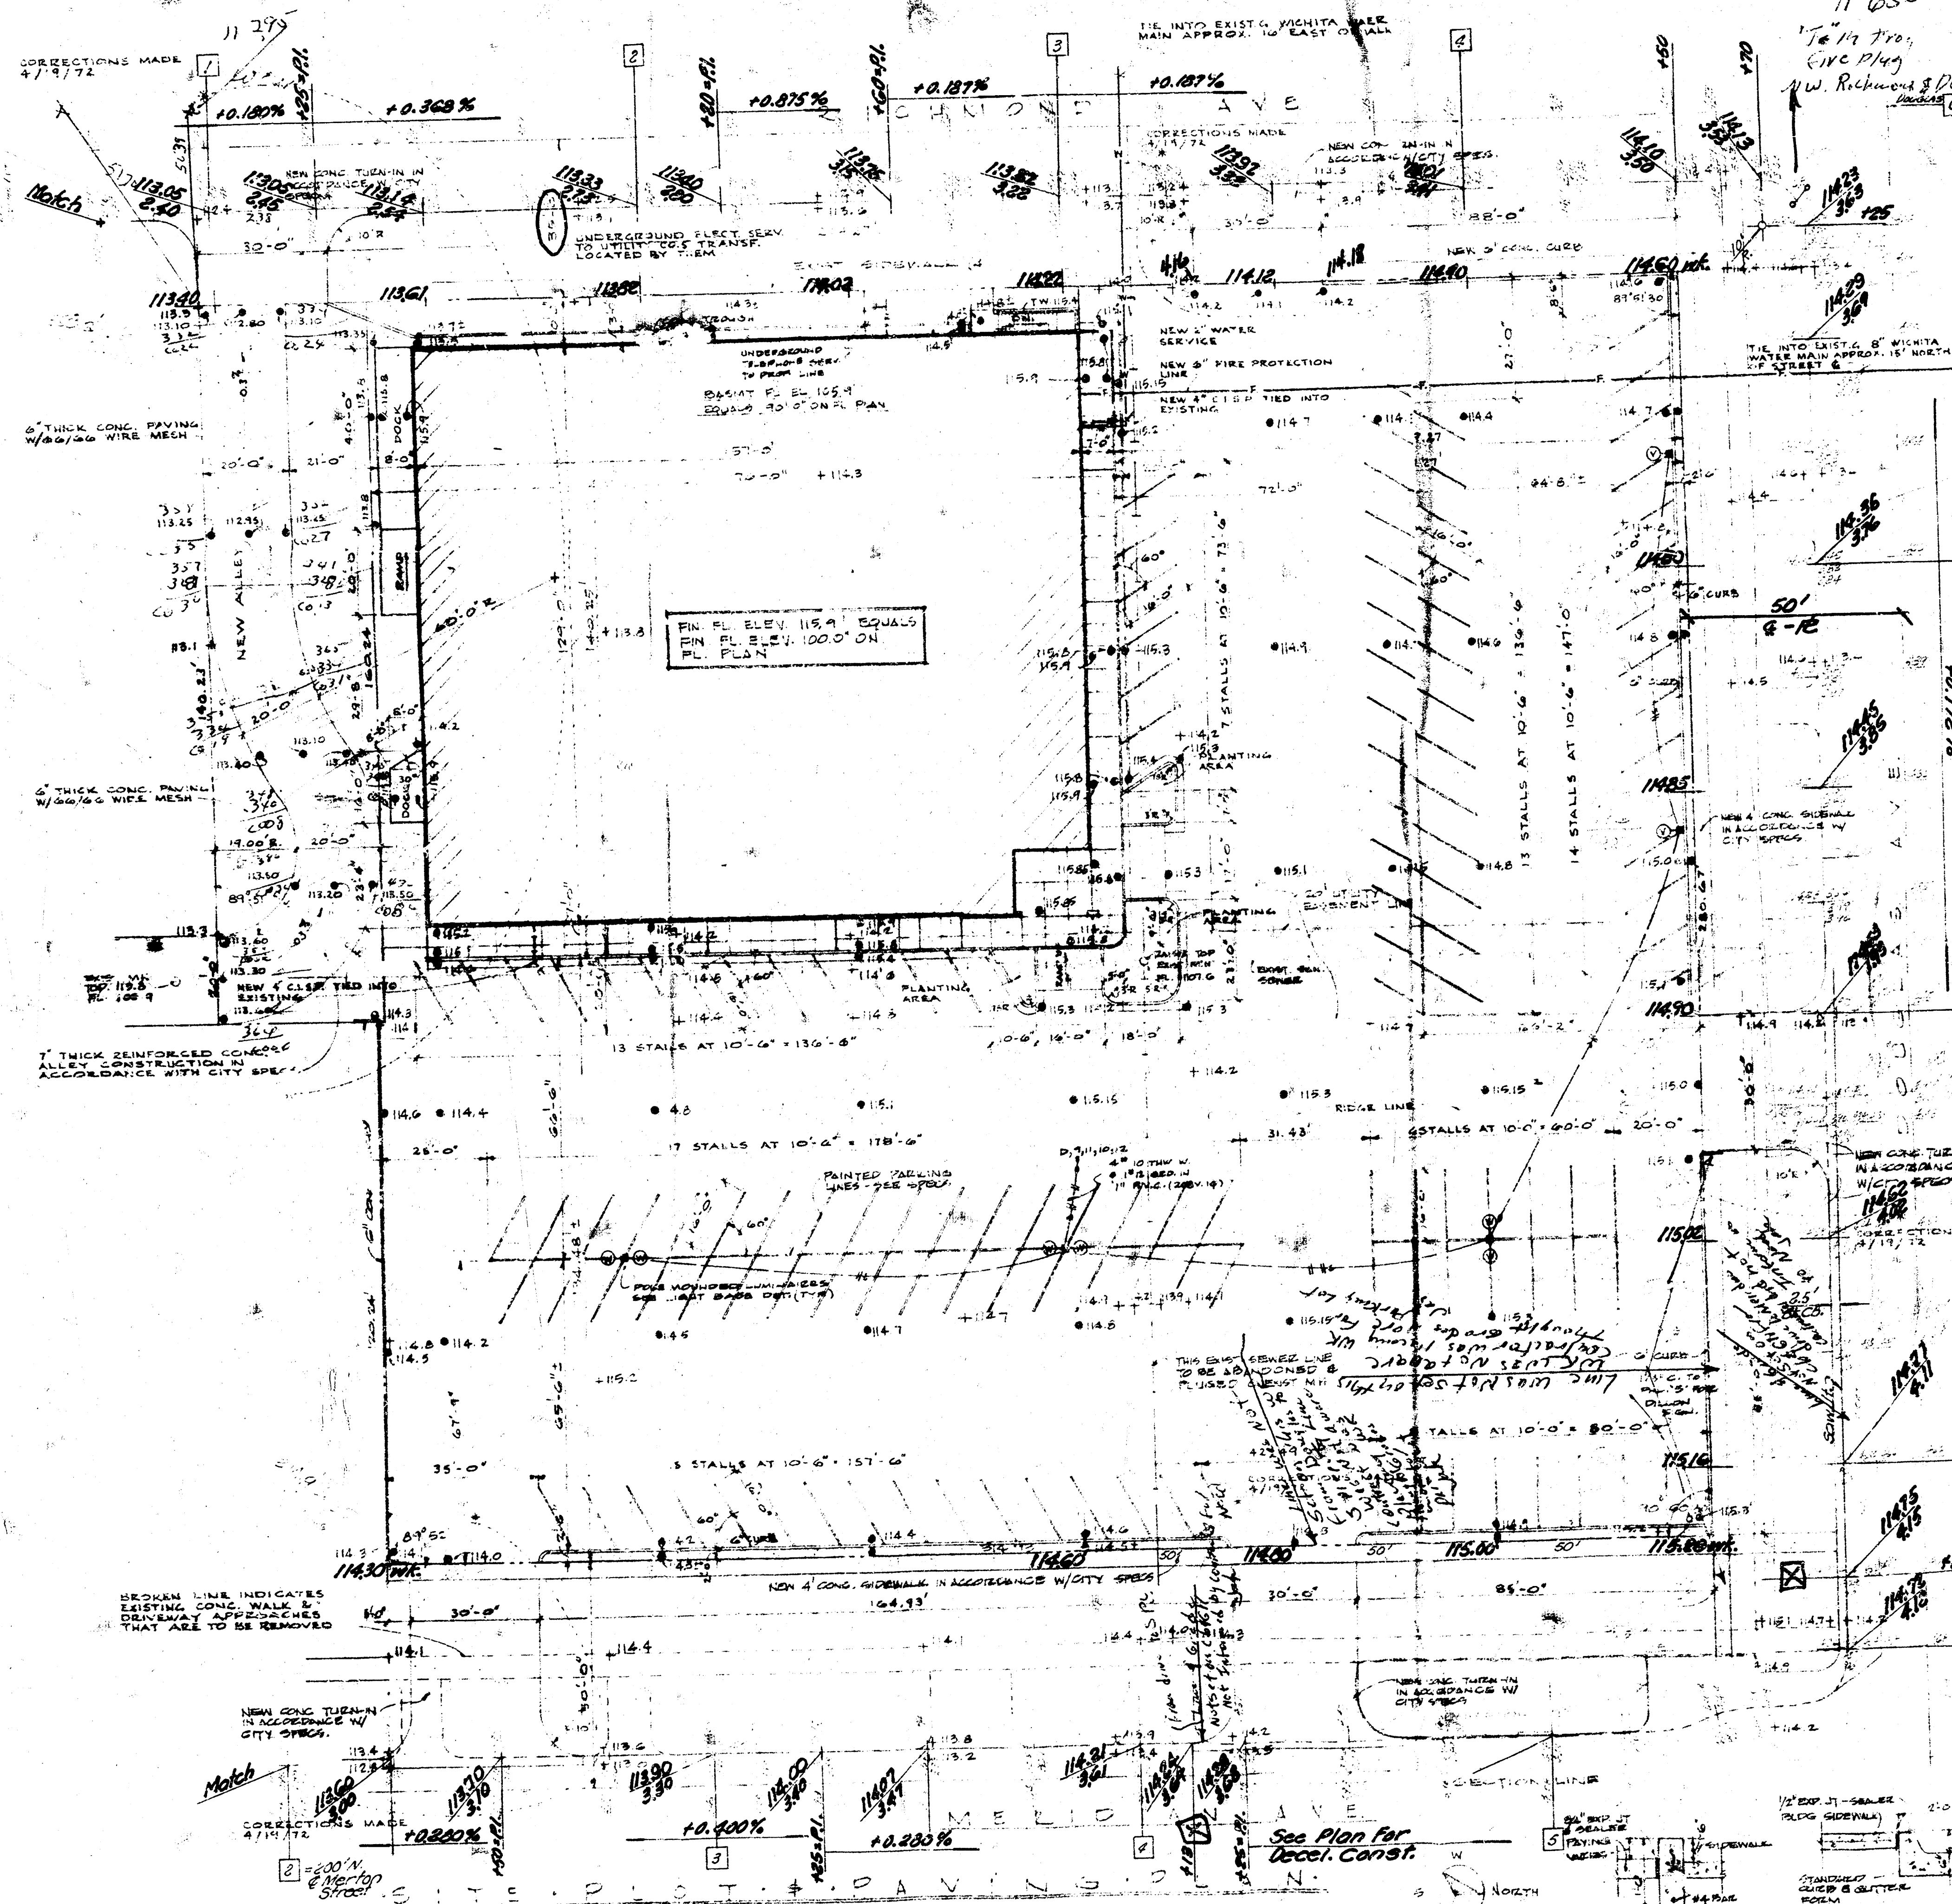


INDEX TO SHEETS

1. SITE PLAN & PAVING DETAILS
2. EXISTING SITE PLAN & PAVING LAYOUT
3. FIRST FLOOR PLAN & SCHEDULES
4. BASEMENT FLOOR PLAN & BUILDING SECTIONS
5. FOOTING & FOUNDATION PLAN
6. BASEMENT PLAN & FRAMING
7. ROOF FRAMING PLAN
8. ROOF FRAMING DETAILS
9. BUILDING ELEVATIONS
10. WALL SECTIONS 1, 2 & 3
11. WALL SECTIONS 4, 5 & 6
12. ROOF PLANS & DETAILS
13. FLOOR TILE LAYOUT PLAN & NICK DETS
14. FIXTURE PLAN & NICK DETS
15. PLUMBING FLOOR PLAN
16. MECHANICAL FLOOR PLAN
17. LIGHTING FLOOR PLAN
18. POWER FLOOR PLAN


OFFICE COPY
00 RETURN 00

SYMBOL SCHEDULE



- | | |
|---|----------------------|
| + | EXISTING GRADE |
| — | FINISH GRADE |
| — | ELECTRICAL SERVICE |
| — | SANITARY SEWER |
| — | WATER SERVICE |
| — | TELEPHONE SERVICE |
| — | LIGHT FIXTURE |
| — | FIRE PROTECTION LINE |

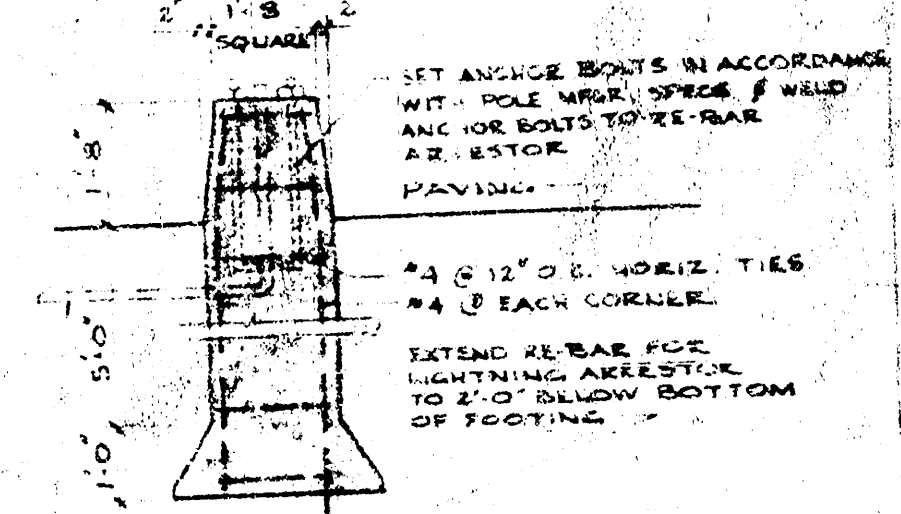

- VI EXP. MAT. SEALER
- EXPANSION JT. (C.1) CONTRACTION JT. (C.2)
- 5 SIDEWALK JOINT DETAILS
SCALE 1" = 1'-0"

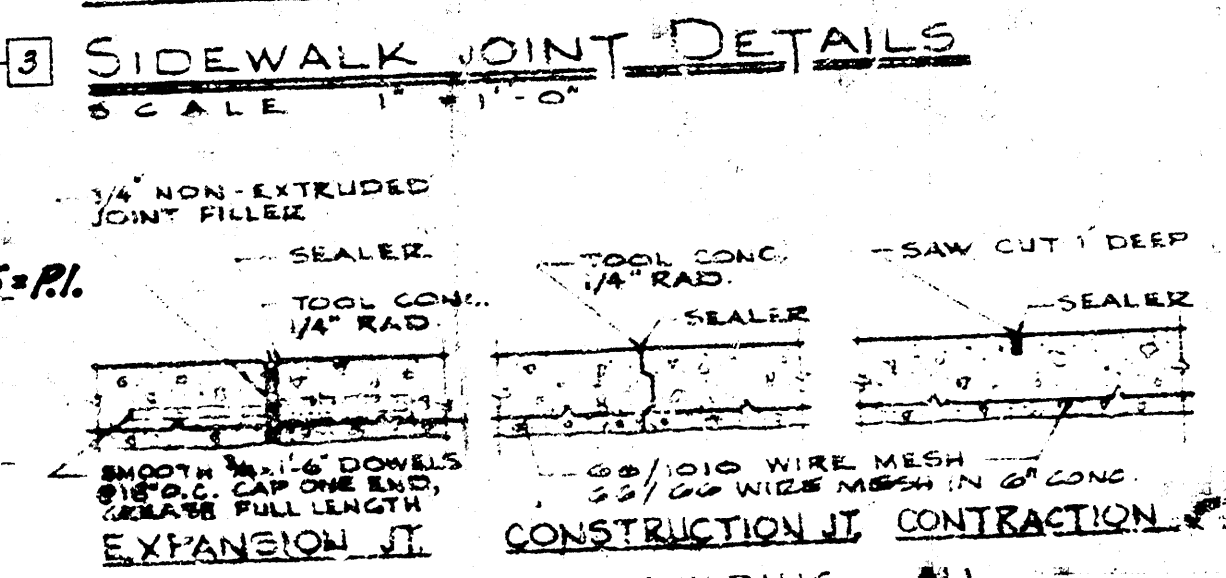

CONCRETE PAVING DETAILS (R.D.)
SCALE 1" = 1'-0"

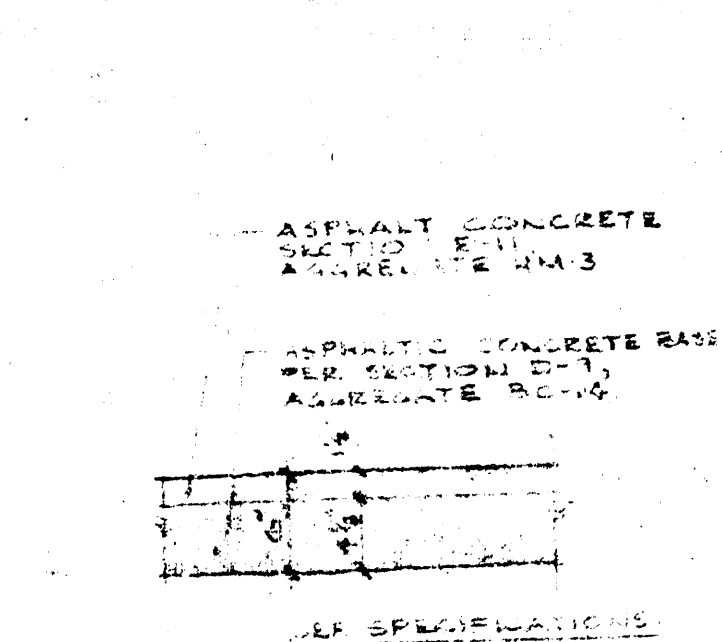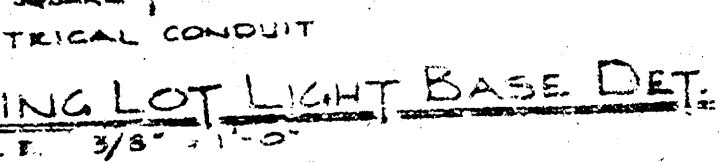

BITUMINOUS PAVING
DETAIL ALTERNATE
SCALE 1" = 1'-0"

DILLON STORE BUILDING #3

11 650

To 14 Ave.
Circ 11/49
NW Richmond & Douglas

See Plan for Local Const.