



B.M. 13133 RR SPIKE, SE. LT. POLE BET. PINECREST & OLD MANOR 60' N of NL KINNAID
 B.M. 149556 S. END N. ROAD ES. COR. ISLAND SW. COR. OLIVER & MT. VERNON
 B.M. 14176 NW. COR. WALK S. SL. MT. VERNON, RL. ELEV.
 B.M. 14216 NW. COR. N. ROAD No. 5003 SW. COR. OLIVER & MT. VERNON
 B.M. 13314 SW. COR. COR. POLE No. 10 OLD MANOR & MT. VERNON

Note: 1. Stripping on H.R.

Exc.


PROP.	CITY
3815.1	264.2
+10%	+10%
4195.6 at 425.	400.6 at 425.

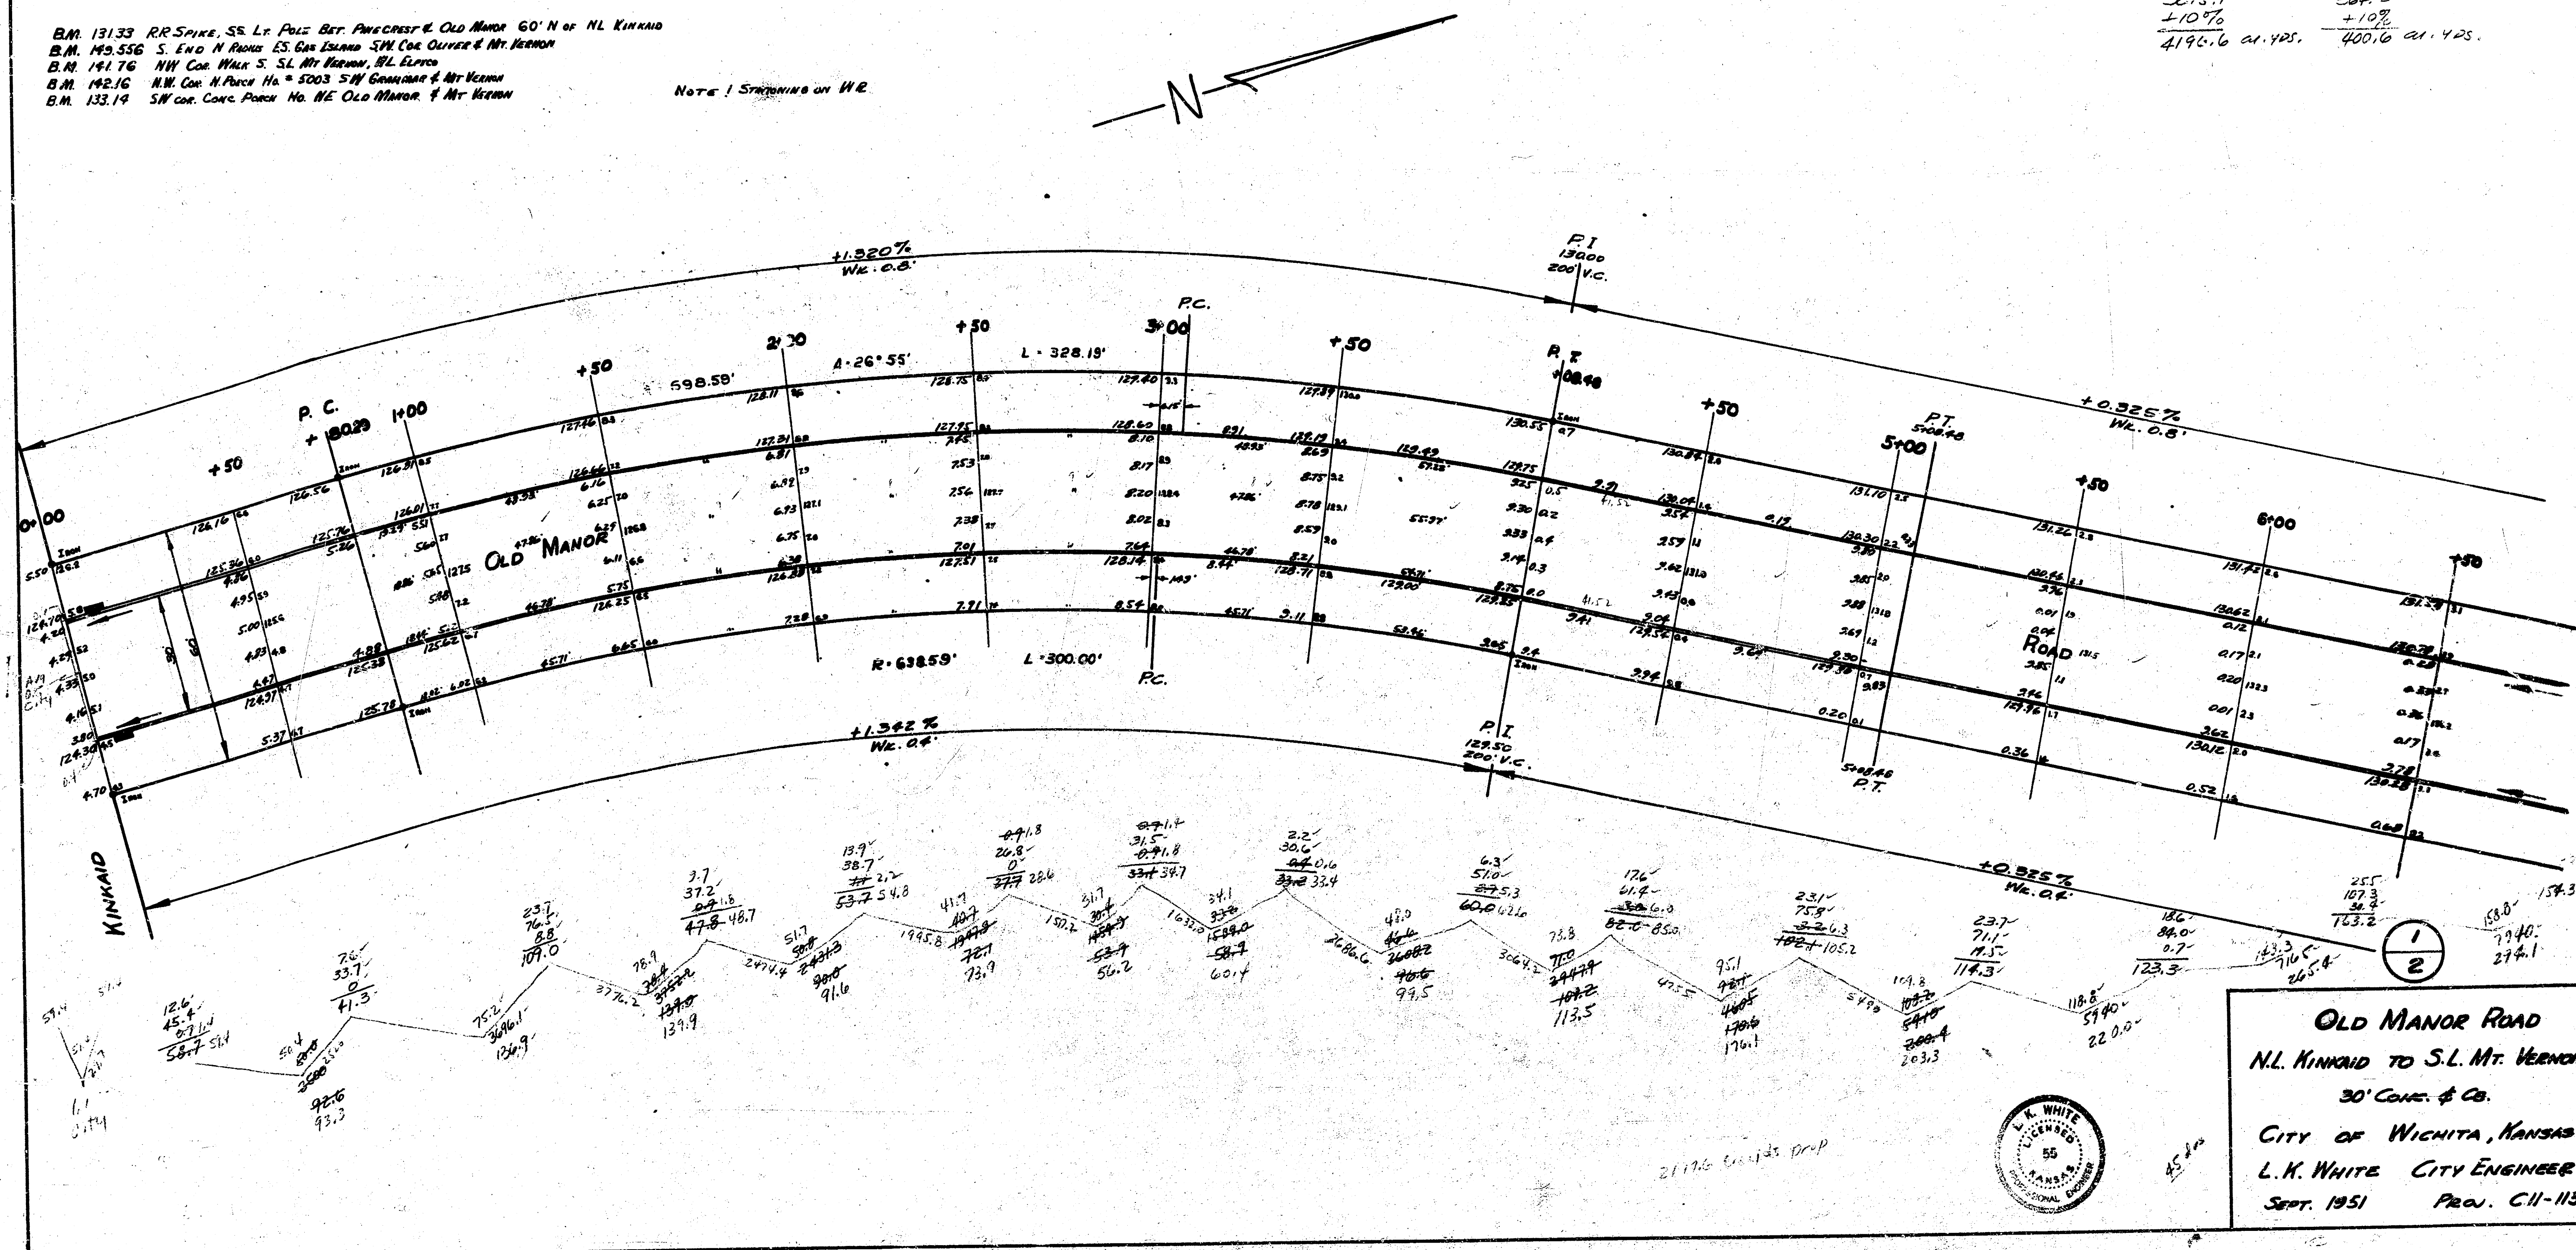

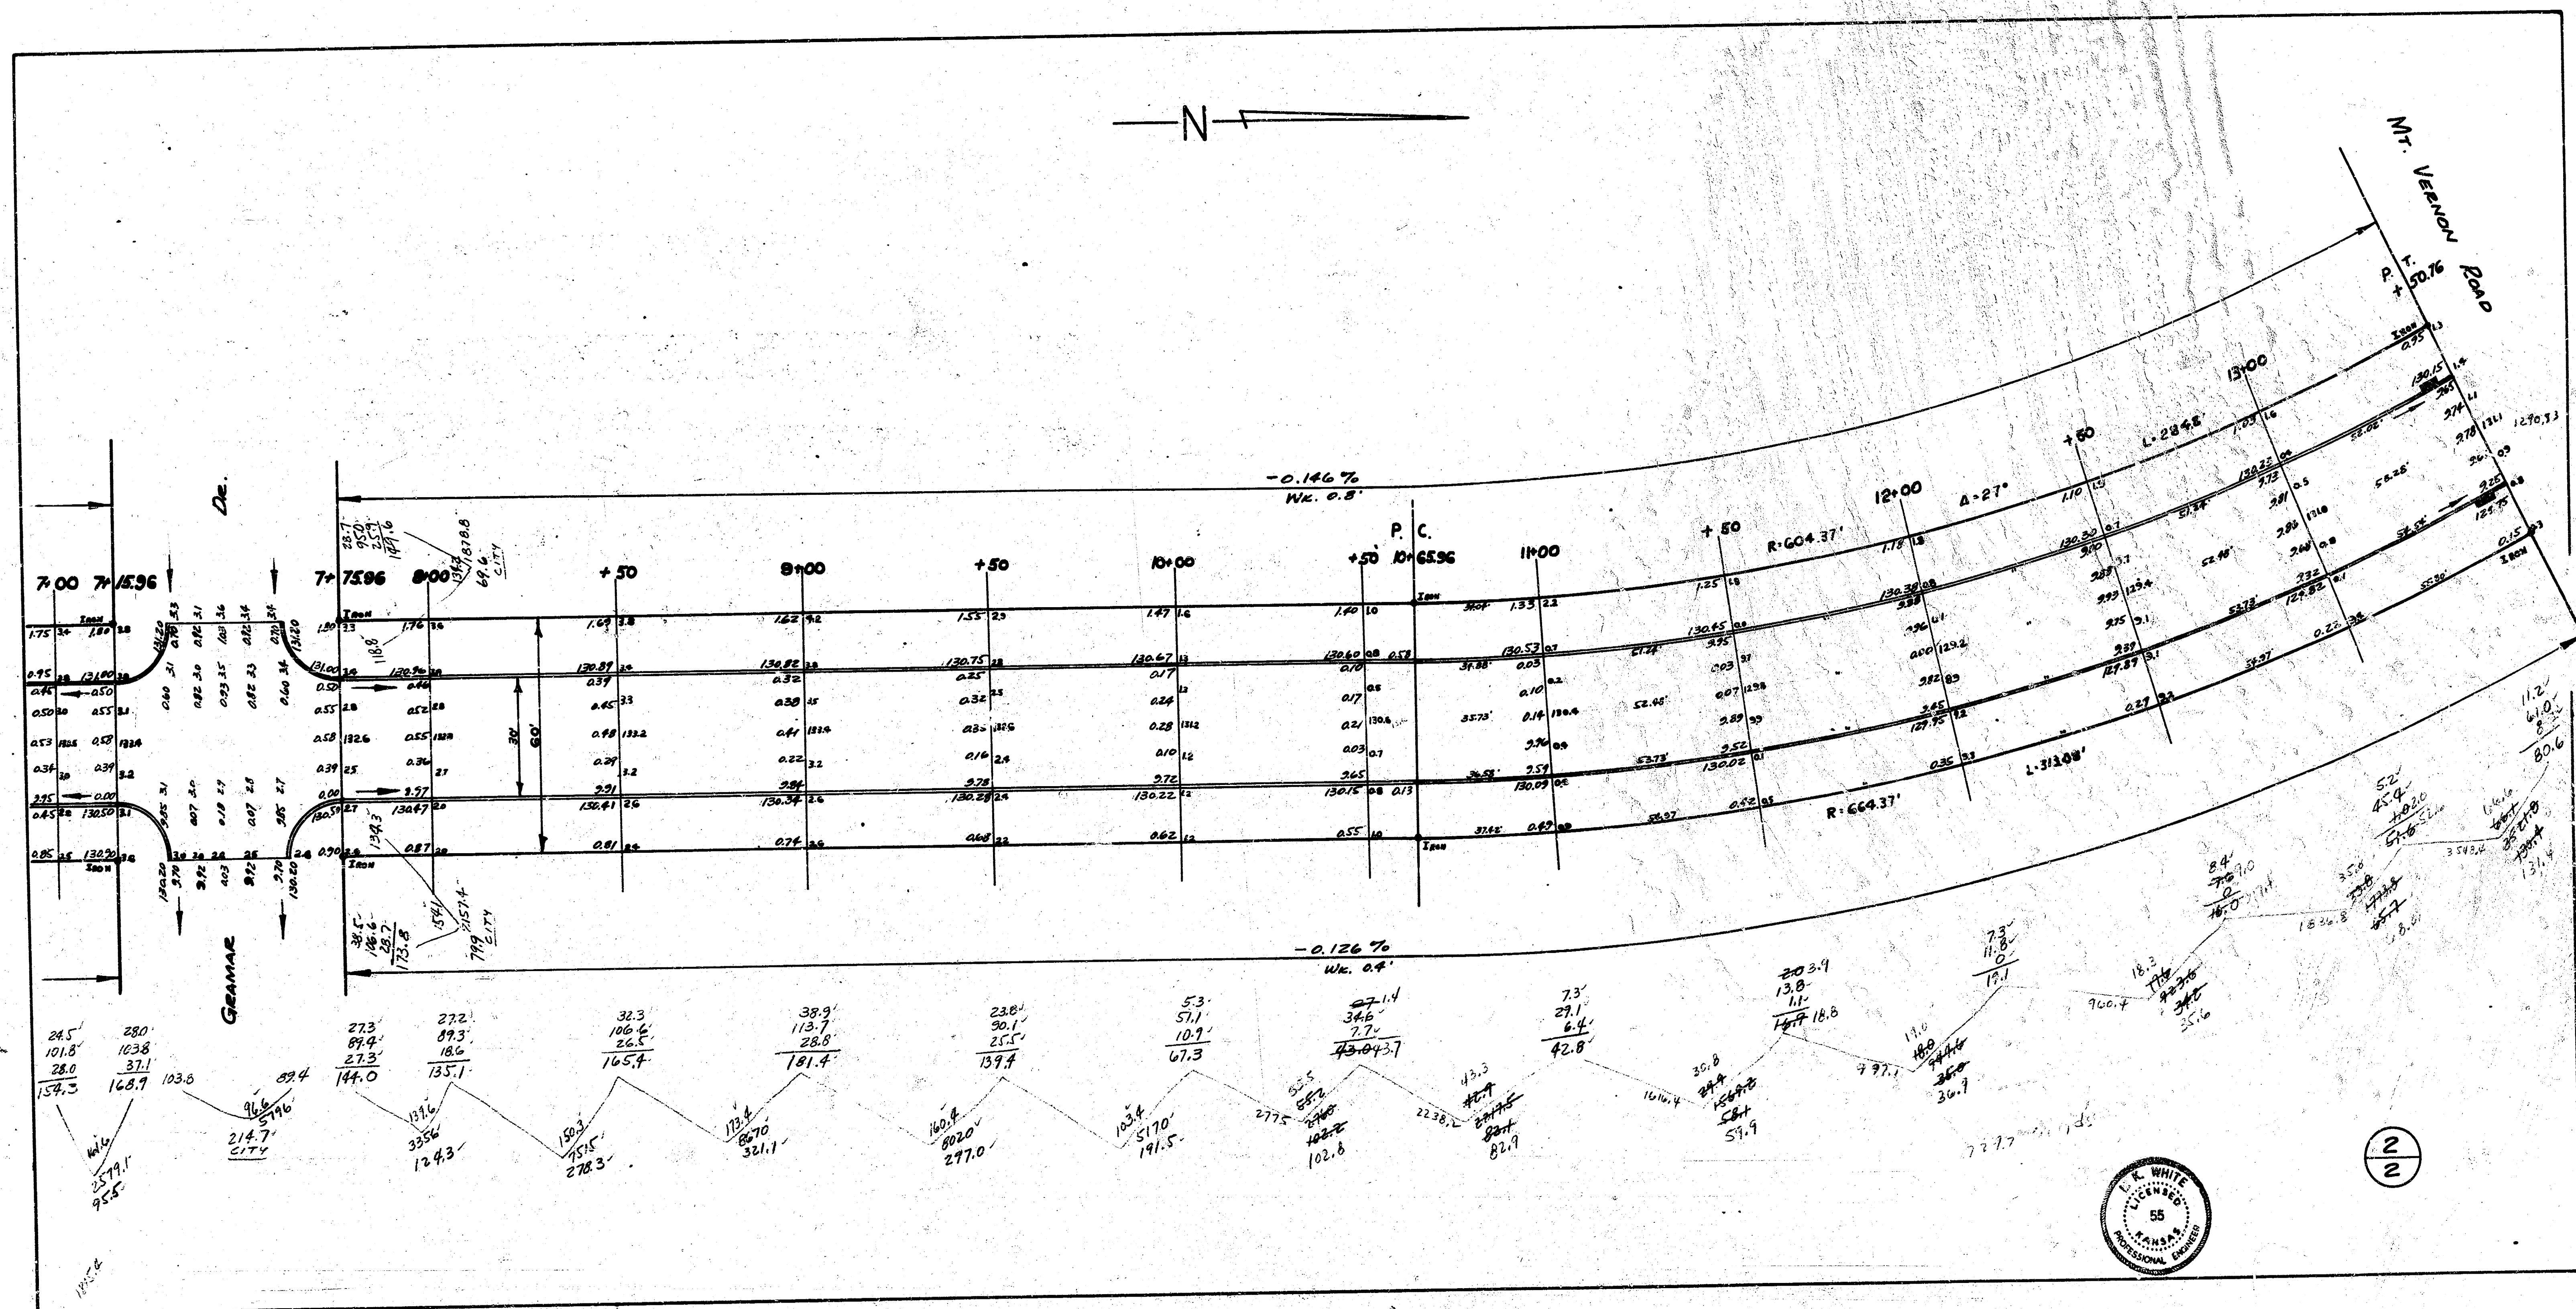

H-1

B.M. 130.61 'B' in Builders F.W.K. N.E. Cor. Mt. Vernon & Old Manor
B.M. 139.87 Standard N.W. Cor. Mt. Vernon & Edgemoor

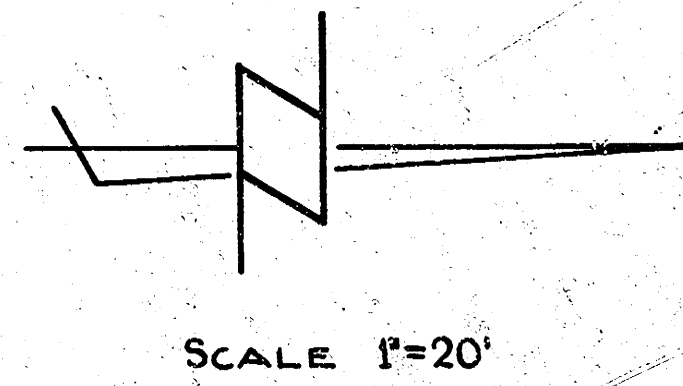

Property



Fill

106.0 x 1/2 = 35.3 cu. yds. 35.3

2.4 x 1/2 = 0.77 tons

106.0 cu. yds. Fill

MT. VERNON ROAD

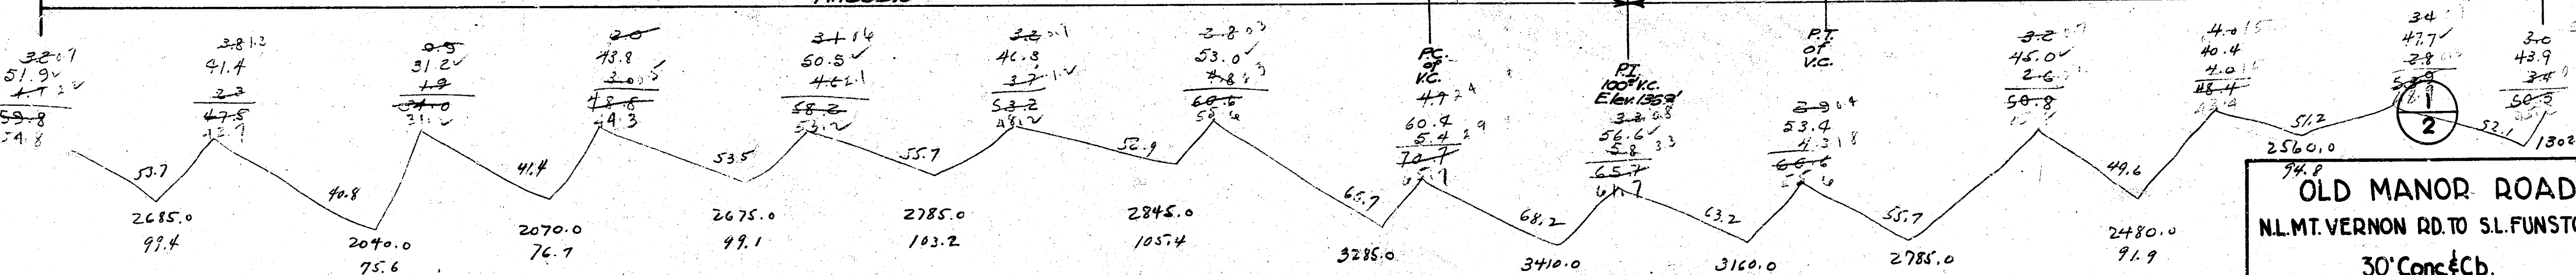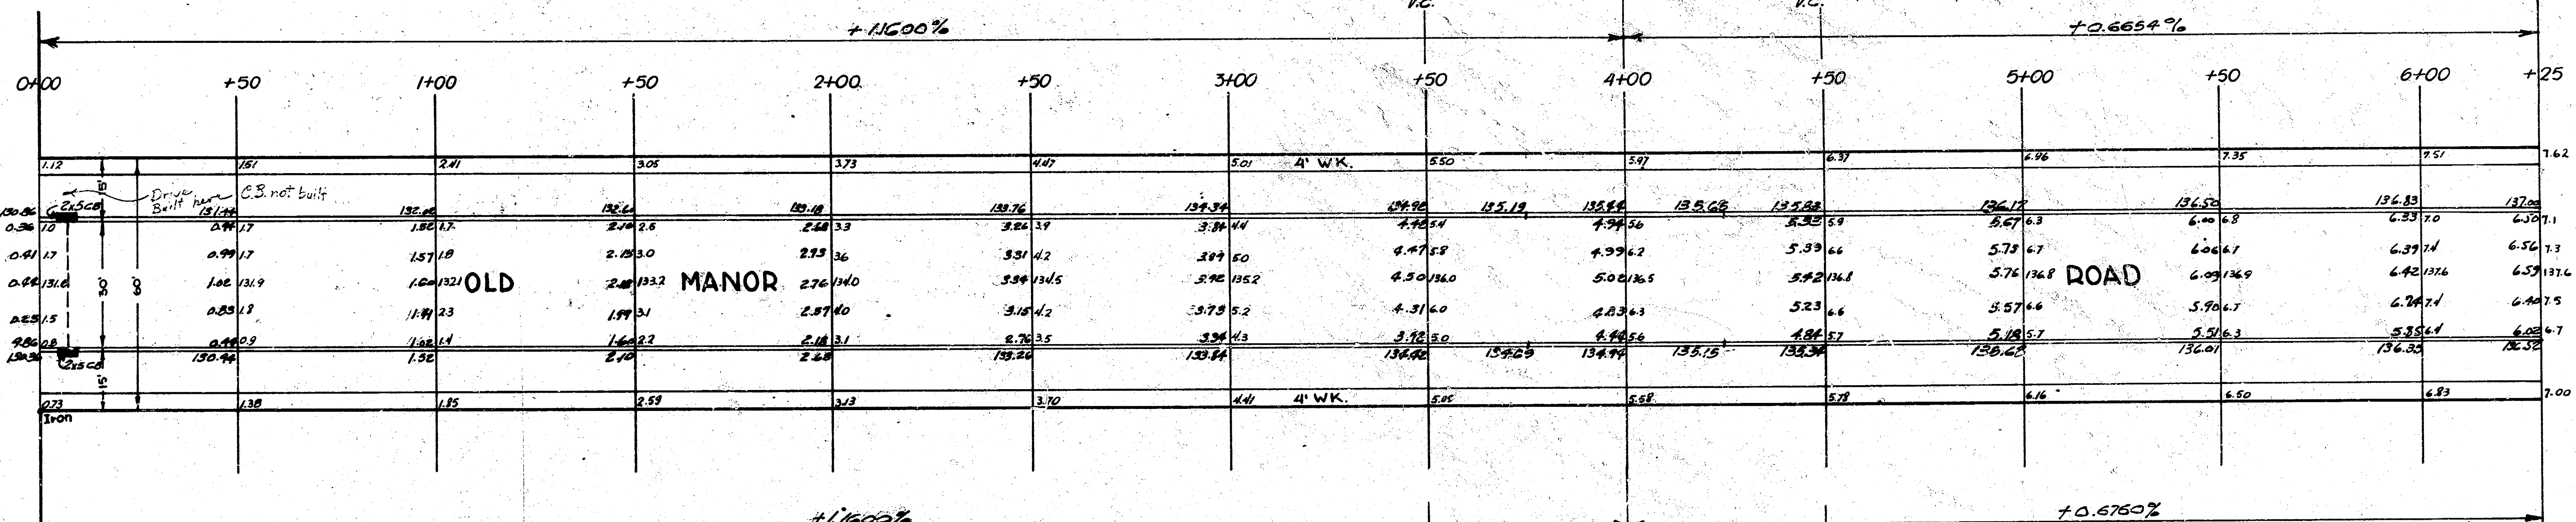

OLD MANOR ROAD
N.L. MT. VERNON RD. TO S.L. FUNSTON AVE
30' Conc. Cb.
CITY OF WICHITA, KANSAS
L.K. WHITE CITY ENGINEER
SEPT. 1981 PROJ. NO. 111-123



H-1

