



TYPICAL 37' PAVEMENT DETAILS

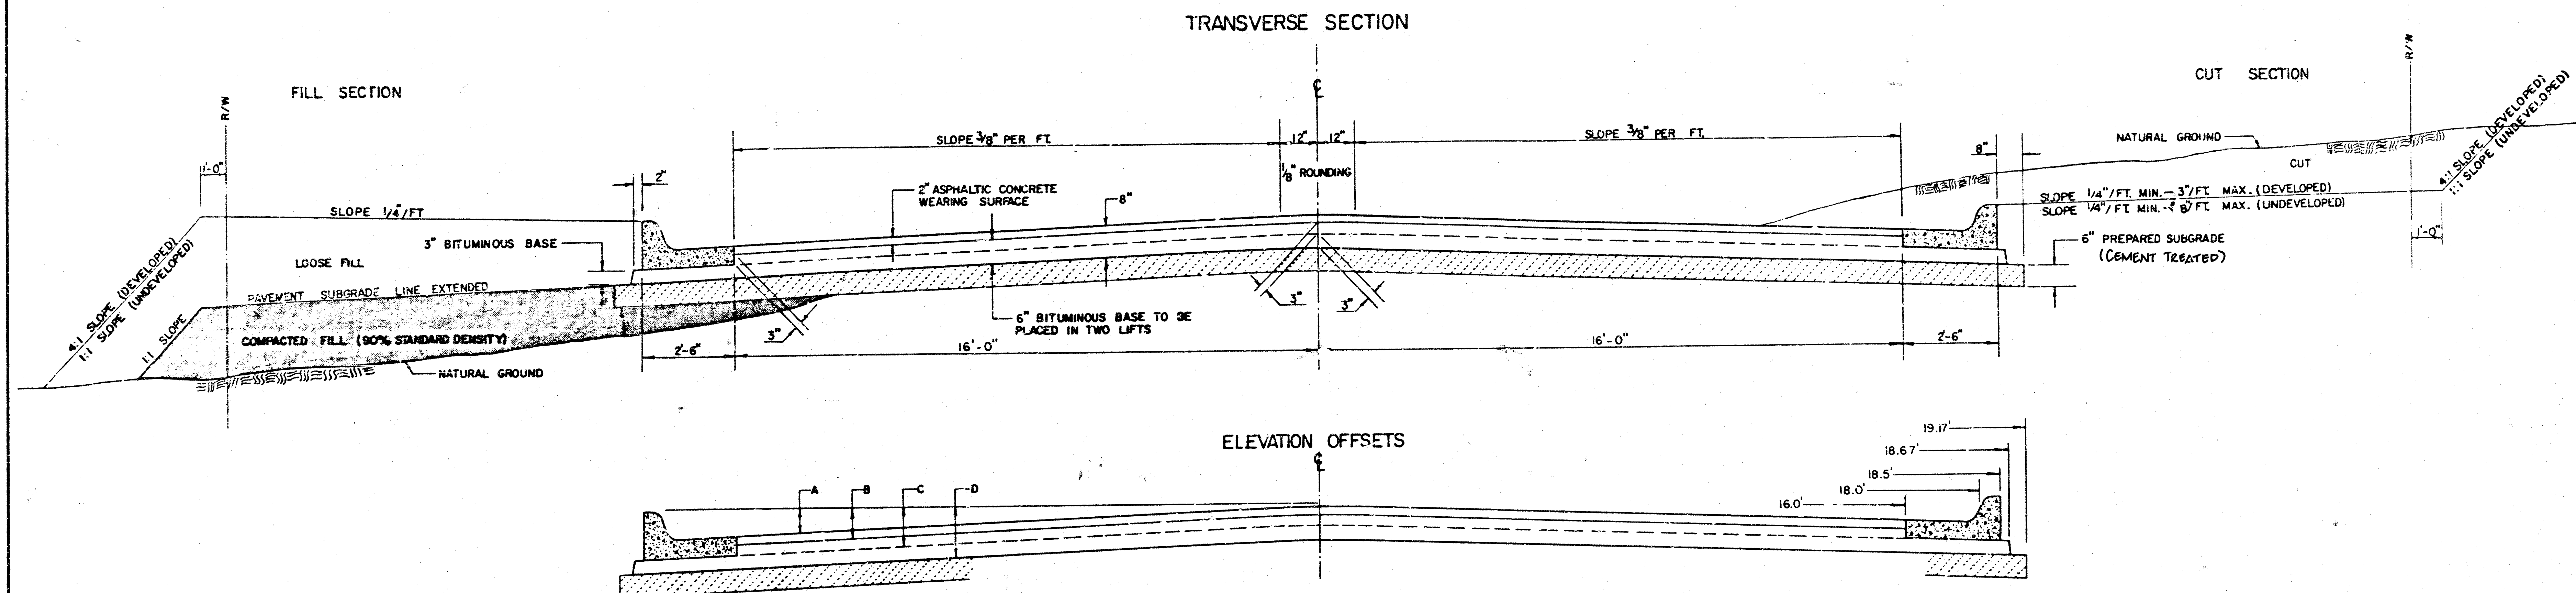

	DISTANCE FROM CENTERLINE (LT. & RT.)												
	0	2	4	6	8	10	12	14	16	18	18.5	18.67	19.17
A: TOP OF CURBS TO TOP OF SURFACE LIFT	.01	.05	.11	.18	.24	.30	.36	.43	.49	—	—	—	—
B: TOP OF CURBS TO TOP OF UPPER BASE LIFT	.17	.22	.28	.34	.40	.47	.53	.59	.65	—	—	—	—
C: TOP OF CURBS TO TOP OF LOWER BASE LIFT	.42	.47	.53	.59	.65	.72	.78	.84	.90	.97	.98	.99	—
D: TOP OF CURBS TO TOP OF SUBGRADE	.67	.72	.78	.84	.90	.97	1.03	1.09	1.15	1.22	1.23	1.24	1.25


COMBINED CURB & GUTTER

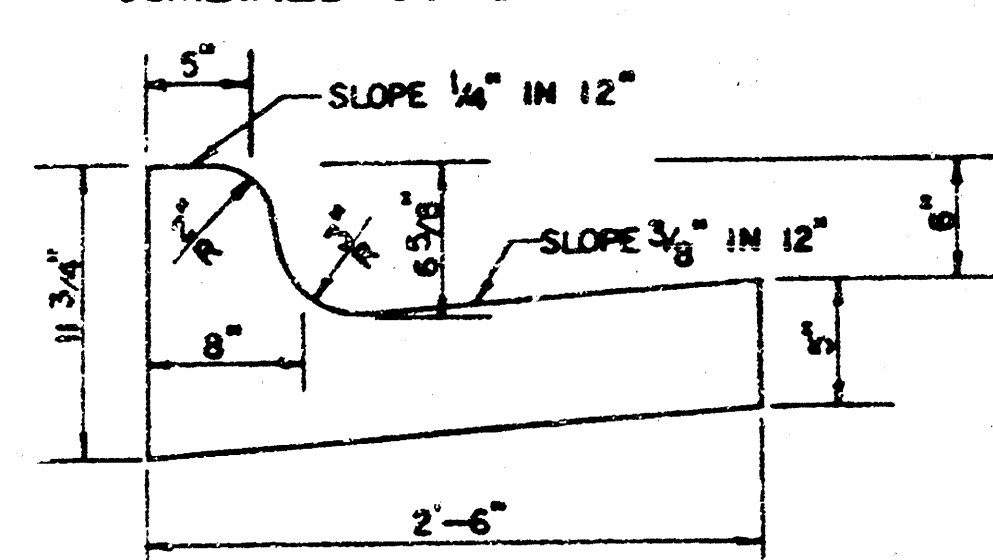

GENERAL NOTES

- 1) THE ASPHALTIC CONCRETE PAVEMENT BETWEEN THE COMBINED CURB AND GUTTER SHALL BE PAID AS SQUARE YARDS OF 8" ASPHALTIC CONCRETE (6" BITUMINOUS BASE).
- 2) THE BITUMINOUS BASE UNDER AND BEHIND THE COMBINED CURB AND GUTTER SHALL BE PAID AS SQUARE YARDS OF 3" BITUMINOUS BASE.
- 3) A TACK COAT OF EMULSIFIED ASPHALT (SC-1H OR CSS-1H) SHALL BE APPLIED AT AN APPROXIMATE RATE OF 0.05 GALLONS PER SQUARE YARD BETWEEN EACH LIFT OF ASPHALTIC MATERIAL.
- 4) BITUMINOUS BASE AND ASPHALTIC CONCRETE WEARING SURFACE SHALL BE PLACED WITH A LAYDOWN MACHINE HAVING AUTOMATIC CONTROLS FOR LINE AND GRADE.
- 5) CONSTRUCTION JOINTS IN EACH LIFT SHALL BE STAGGERED A MINIMUM DISTANCE OF ONE (1) FOOT FROM JOINTS IN PRECEDING LIFTS AND PLACED SO THAT A JOINT WILL BE CONSTRUCTED ON THE CENTERLINE OF THE TOP LIFT.
- 6) CONTRACTOR TO BID ONLY ONE SUBGRADE TREATMENT ALTERNATE WHEN ALTERNATES ARE PROVIDED IN THE PROPOSAL AND CONTRACT. THE ALTERNATE CHOSEN BY THE SUCCESSFUL BIDDER SHALL BE USED IN CONSTRUCTING THIS PROJECT.

TRANSVERSE CONSTRUCTION JOINTS

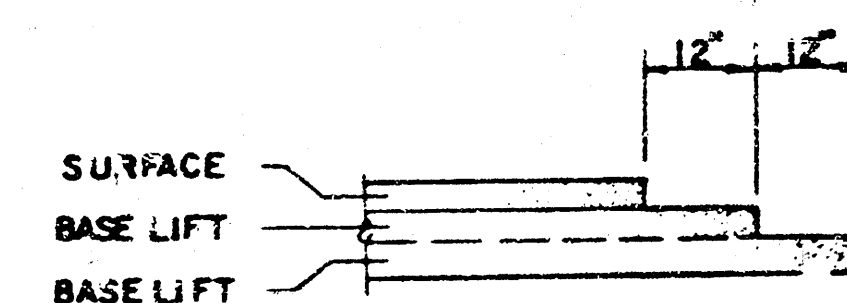

TRANSVERSE CONSTRUCTION JOINTS SHALL BE CONSTRUCTED IN FLEXIBLE BASE PAVEMENTS AT LOCATIONS WHERE PAVEMENT JOINTS EXISTING FLEXIBLE BASE PAVEMENT AS SHOWN BY THE DETAIL. ALL COSTS ASSOCIATED WITH THE CONSTRUCTION OF THE TRANSVERSE JOINT SHALL BE INCLUDED IN THE BID PRICE FOR SQUARE YARDS 8" ASPHALTIC CONCRETE (6" BITUMINOUS BASE).

8 INCH RESIDENTIAL ASPHALTIC CONCRETE
PAVEMENT WITH 6 INCH BITUMINOUS BASE
CITY OF WICHITA, KANSAS

PROJECT NUMBER
472-79-245-61183-000-000-001

2/14

STREET IMPROVEMENTS

GOLD

FROM THE SW CORNER OF LOT 16, BLOCK 11
AND A POINT 40 FEET NE OF S CORNER LOT 17, BLOCK 8
TO THE NE LINE OF LOT 17, BLOCK 9
AND TO THE N LINE OF LOT 13, BLOCK 11

GOLD COURT

FROM THE E LINE OF GOLD TO THE E LINE OF GOLD


SYCAMORE

FROM THE N LINE OF LOT 8, BLOCK 9 TO THE W LINE OF GOLD
SOUTH SENECA GARDENS FOURTH ADDITION

PROJECT NO. 472-76-245-81193-000-000-001


GENERAL NOTES

1. The Contractor shall contact Kan-U-Dig-It (267-2889) for location of underground utilities prior to any excavation.
2. The Contractor shall be responsible for protecting block corners and property irons. Any such irons disturbed by the Contractor's operations shall be replaced at Contractor's expense, by a licensed professional engineer or surveyor, in accordance with state laws.
3. Curb and Gutter on Gold Court and on Sycamore shall be Roll-Type Combined Curb and Gutter, as indicated on the plans. Top of curb grades shown are for full height curb.
4. Roll curb shall be depressed through all drives that are to be constructed as part of this project.

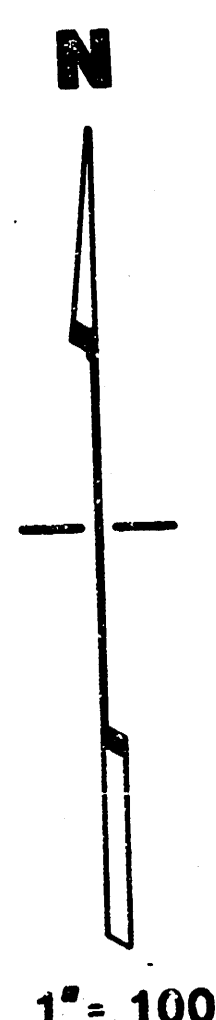

BENCH MARK:

City of Wichita Standard disc, 45' west
and 48' north of 1/4 sec. corner at 55th
Street South and Gold, Elev. 81.36

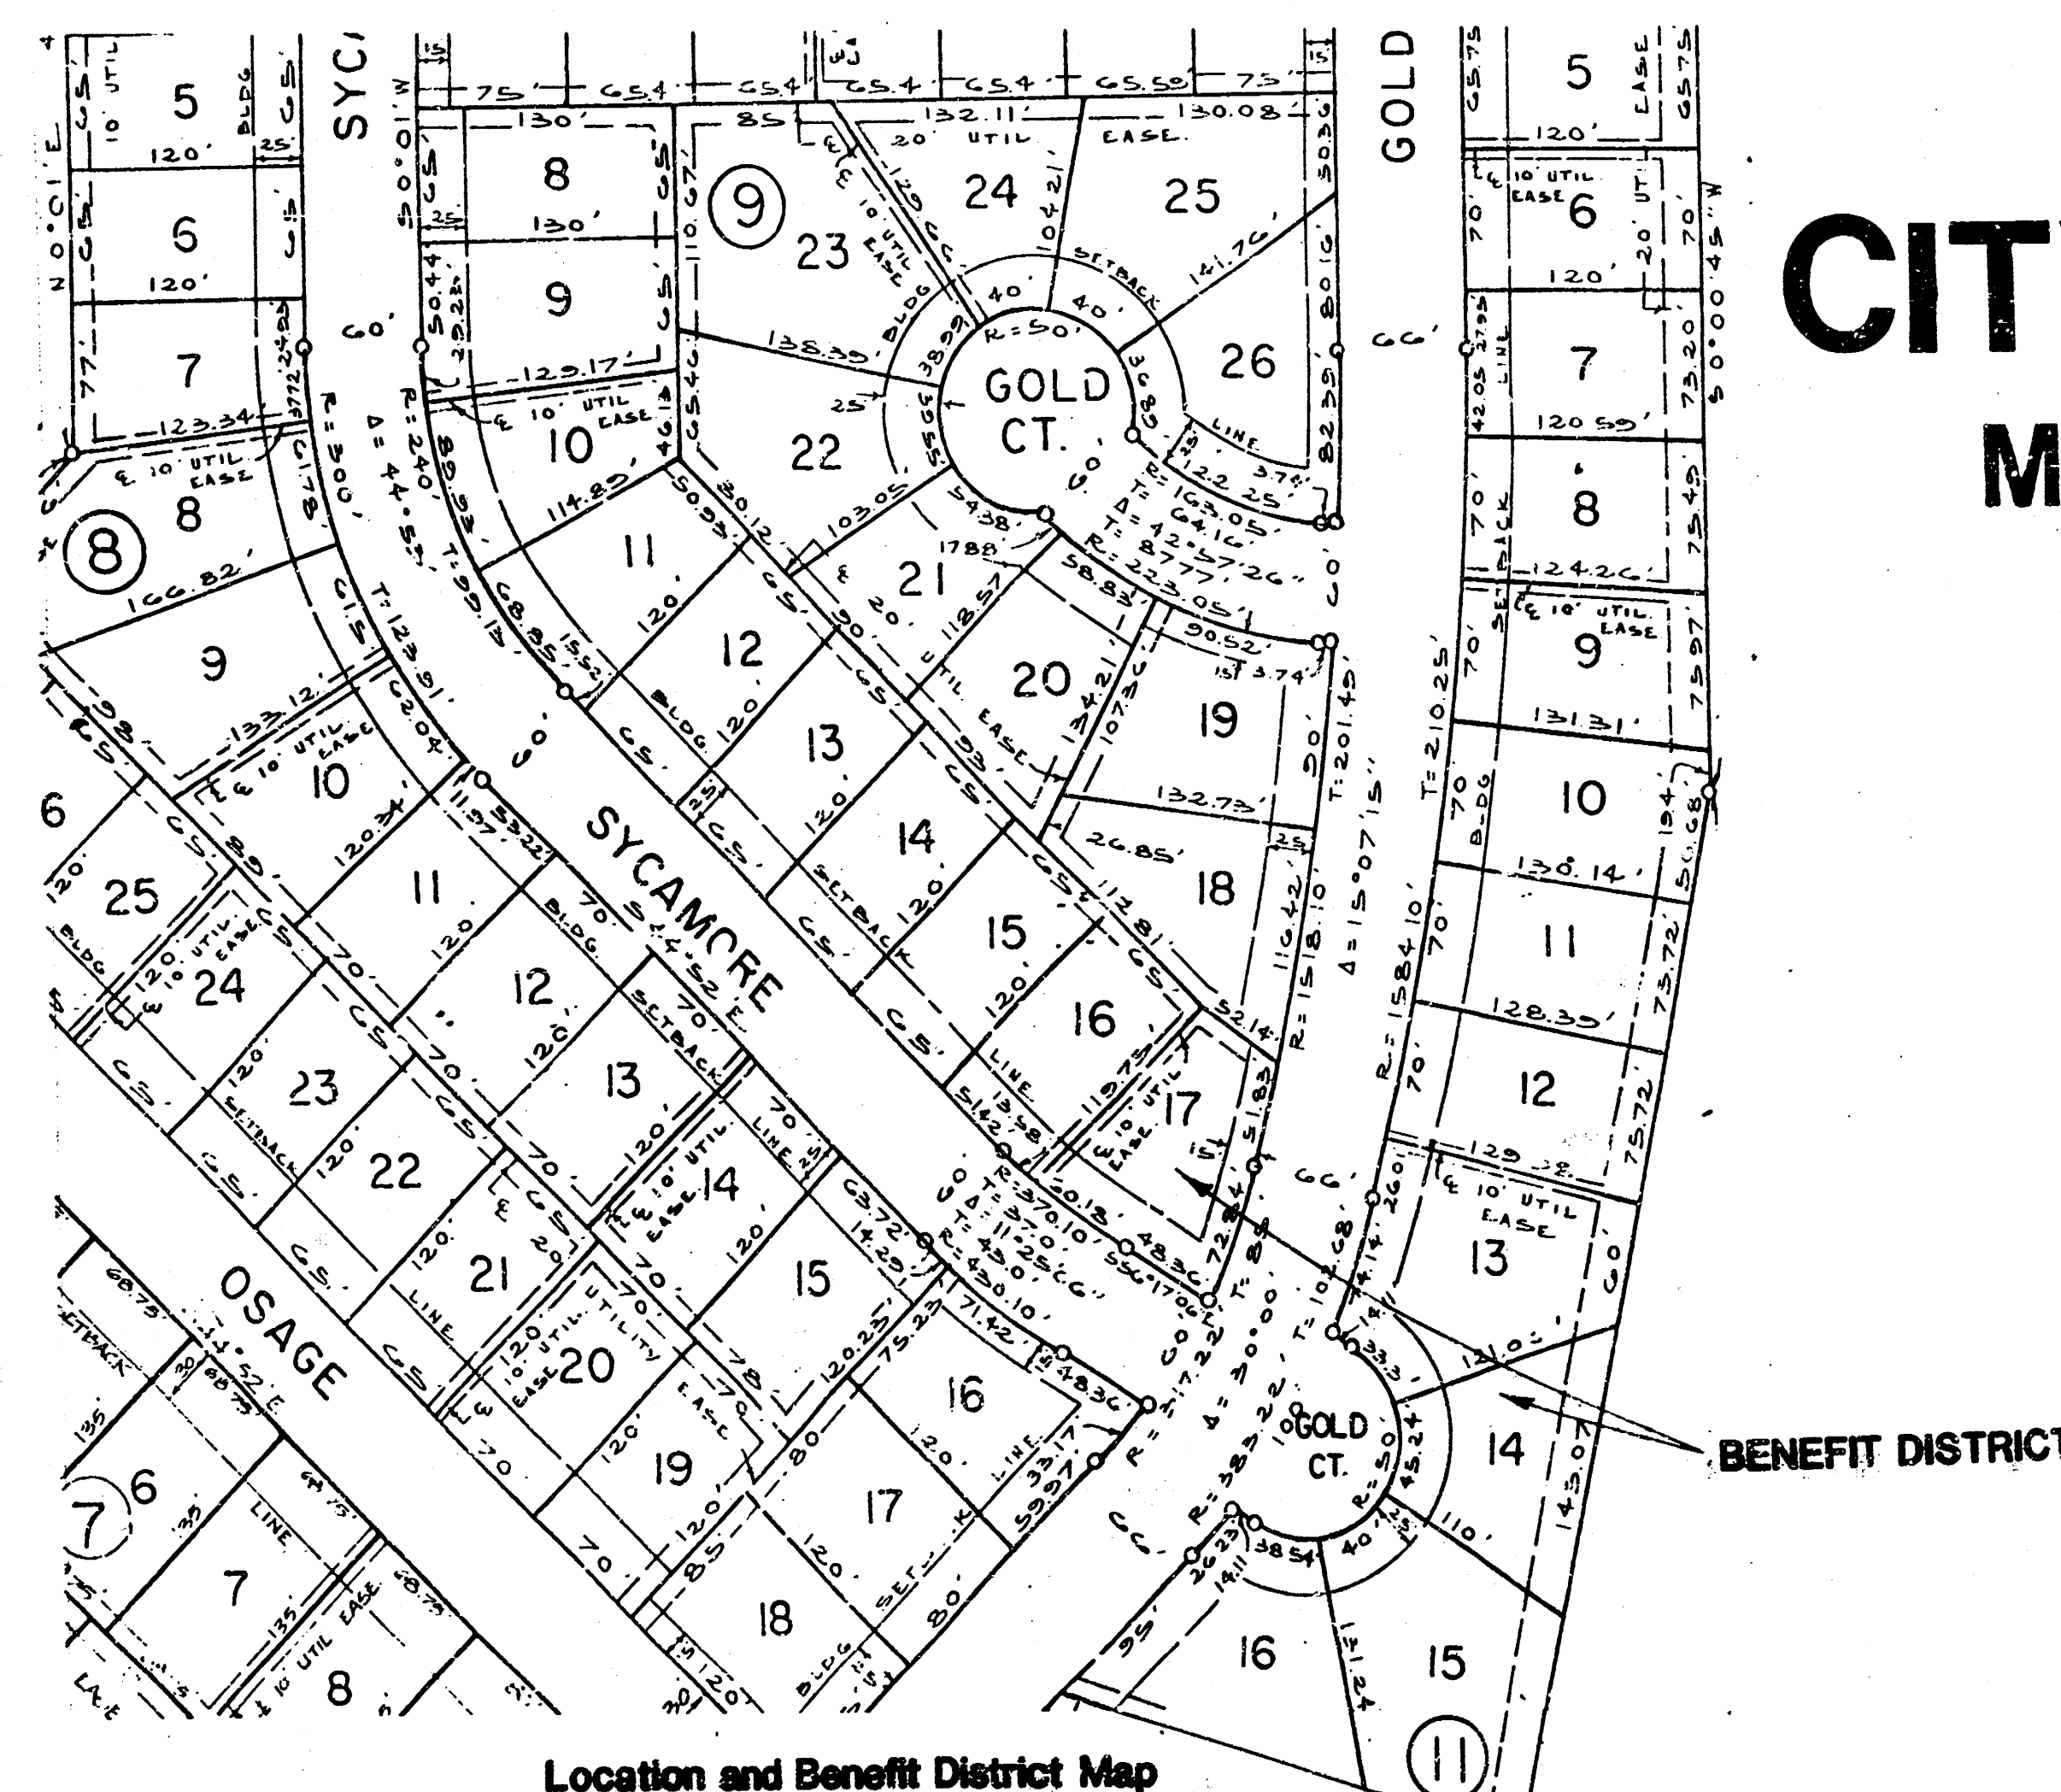

CITY OF WICHITA, KANSAS
MIKE E. LINDEBAK, CITY ENGINEER

INDEX


- | | |
|-------|---------------------------------|
| 1 | Location & Benefit District Map |
| 2-4 | Typical Sections |
| 5-7 | Street Improvement Plans |
| 8-9 | Incidental Drainage |
| 10 | Type 1A Inlet Detail |
| 11 | Type "B" Manhole Detail |
| 12-14 | Earthwork Sections |




SEPTEMBER 1984

BAUGHMAN COMPANY, P.A.
SURVEYING & ENGINEERING
316/262-7271 • 330 LAURA • WICHITA, KANSAS 67211


1/14

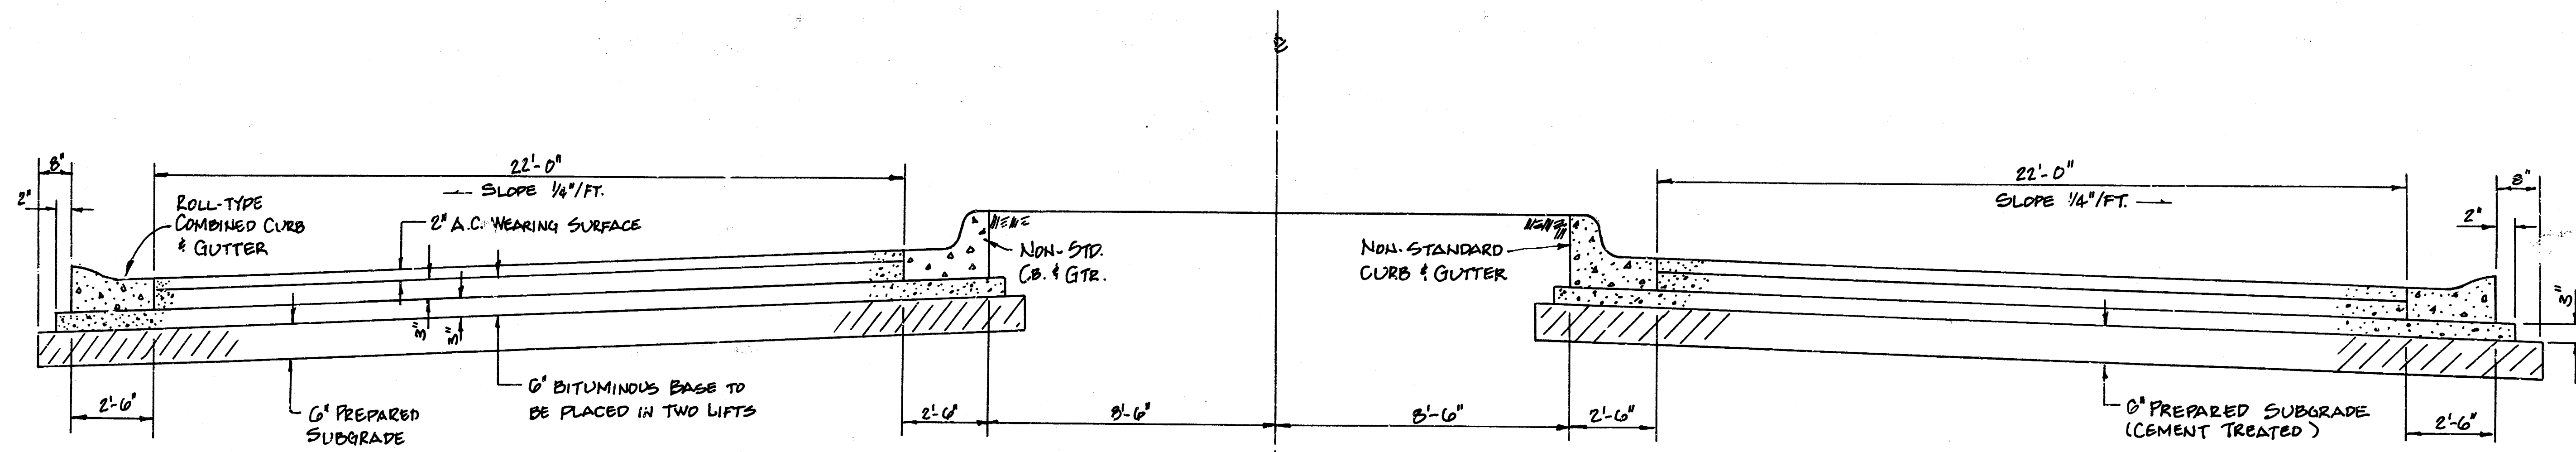


**TYPICAL SECTION
8' ASPHALTIC CONCRETE PAVEMENT
(GOLD COURT)**

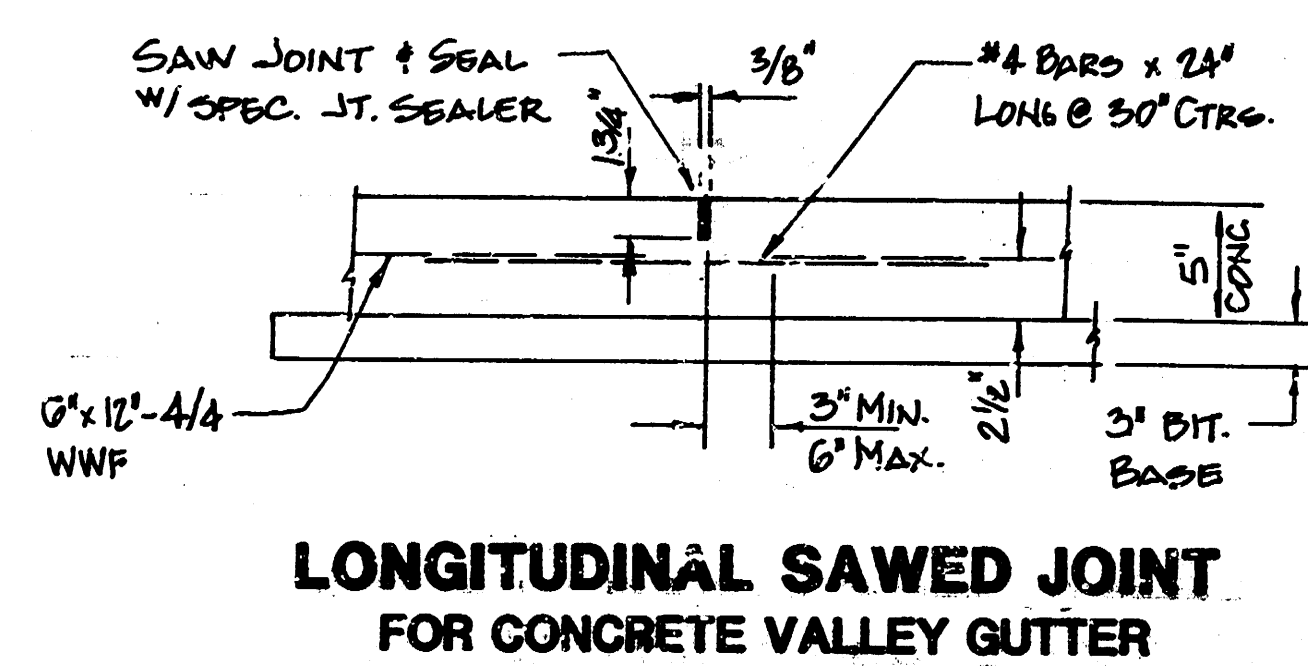


**LONGITUDINAL SAWED JOINT
FOR CONCRETE VALLEY GUTTER**

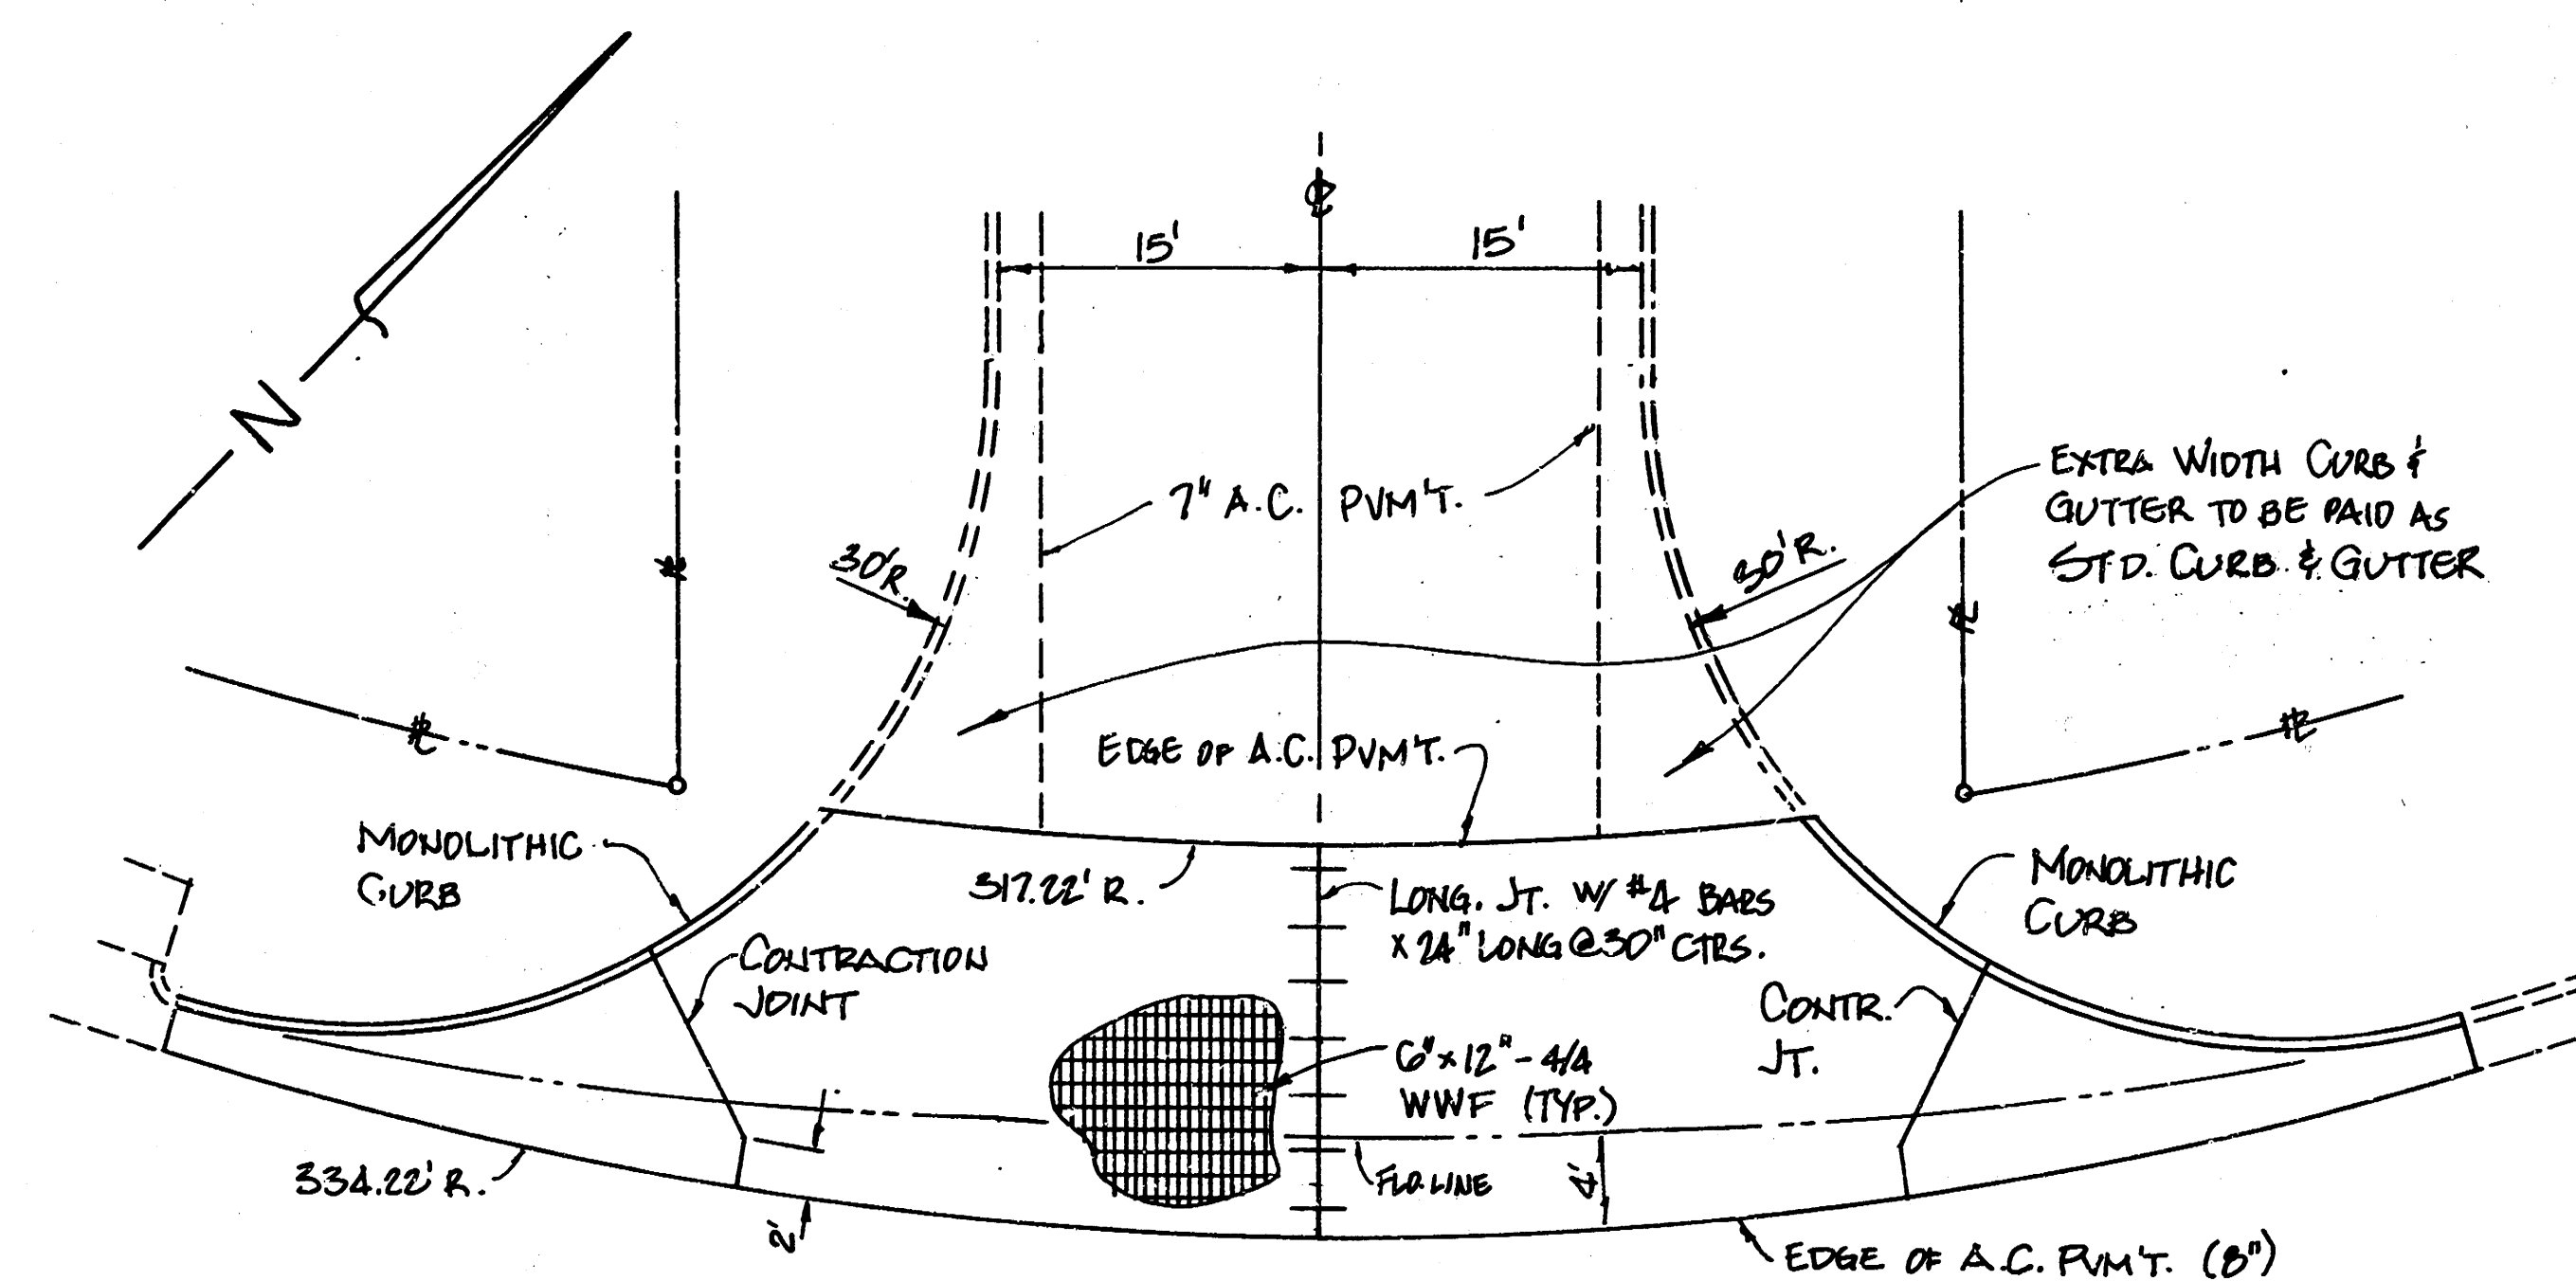


**VALLEY GUTTER DETAIL
GOLD/STCAMORE**

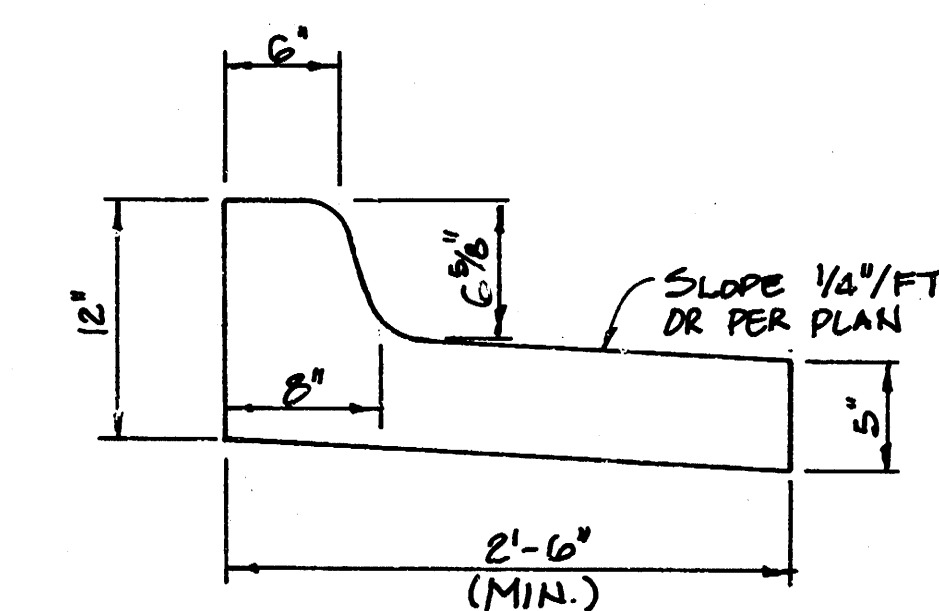


**NON-STD. COMBINED
CURB AND GUTTER**

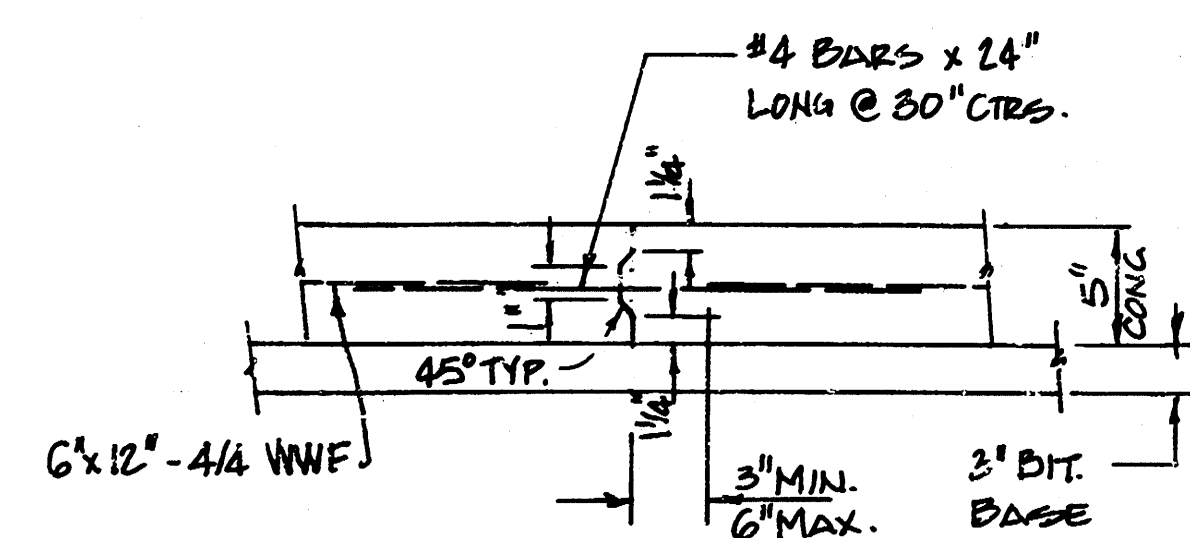


**LONGITUDINAL CONSTRUCTION JOINT
FOR CONCRETE VALLEY GUTTER**

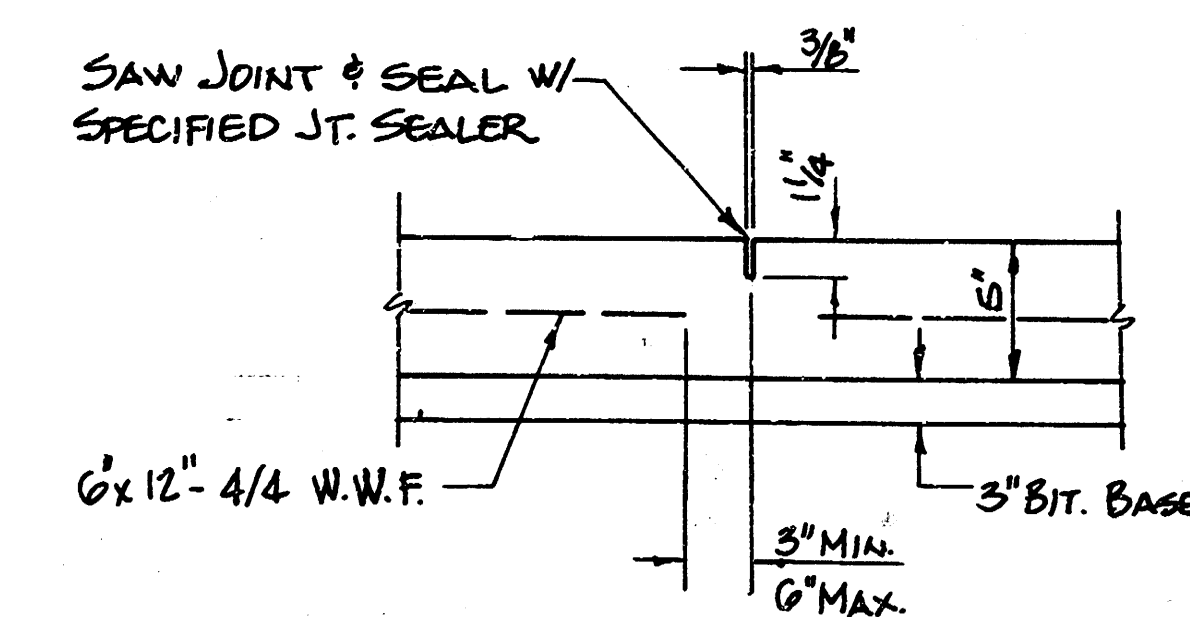

**CONTRACTION JOINT
FOR CONCRETE VALLEY GUTTER**

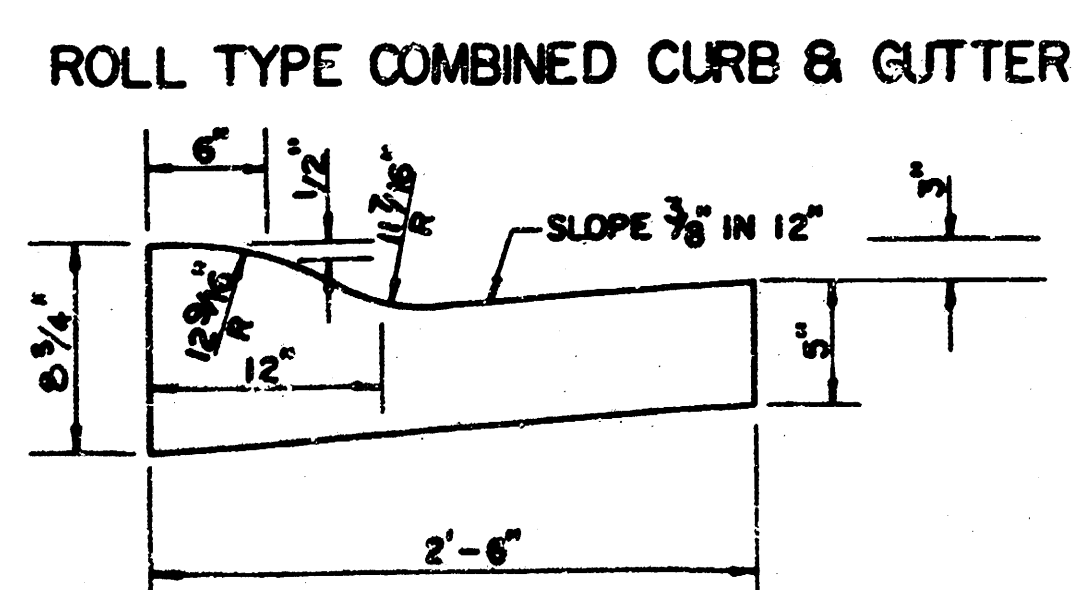

ROLL TYPE COMBINED CURB & GUTTER

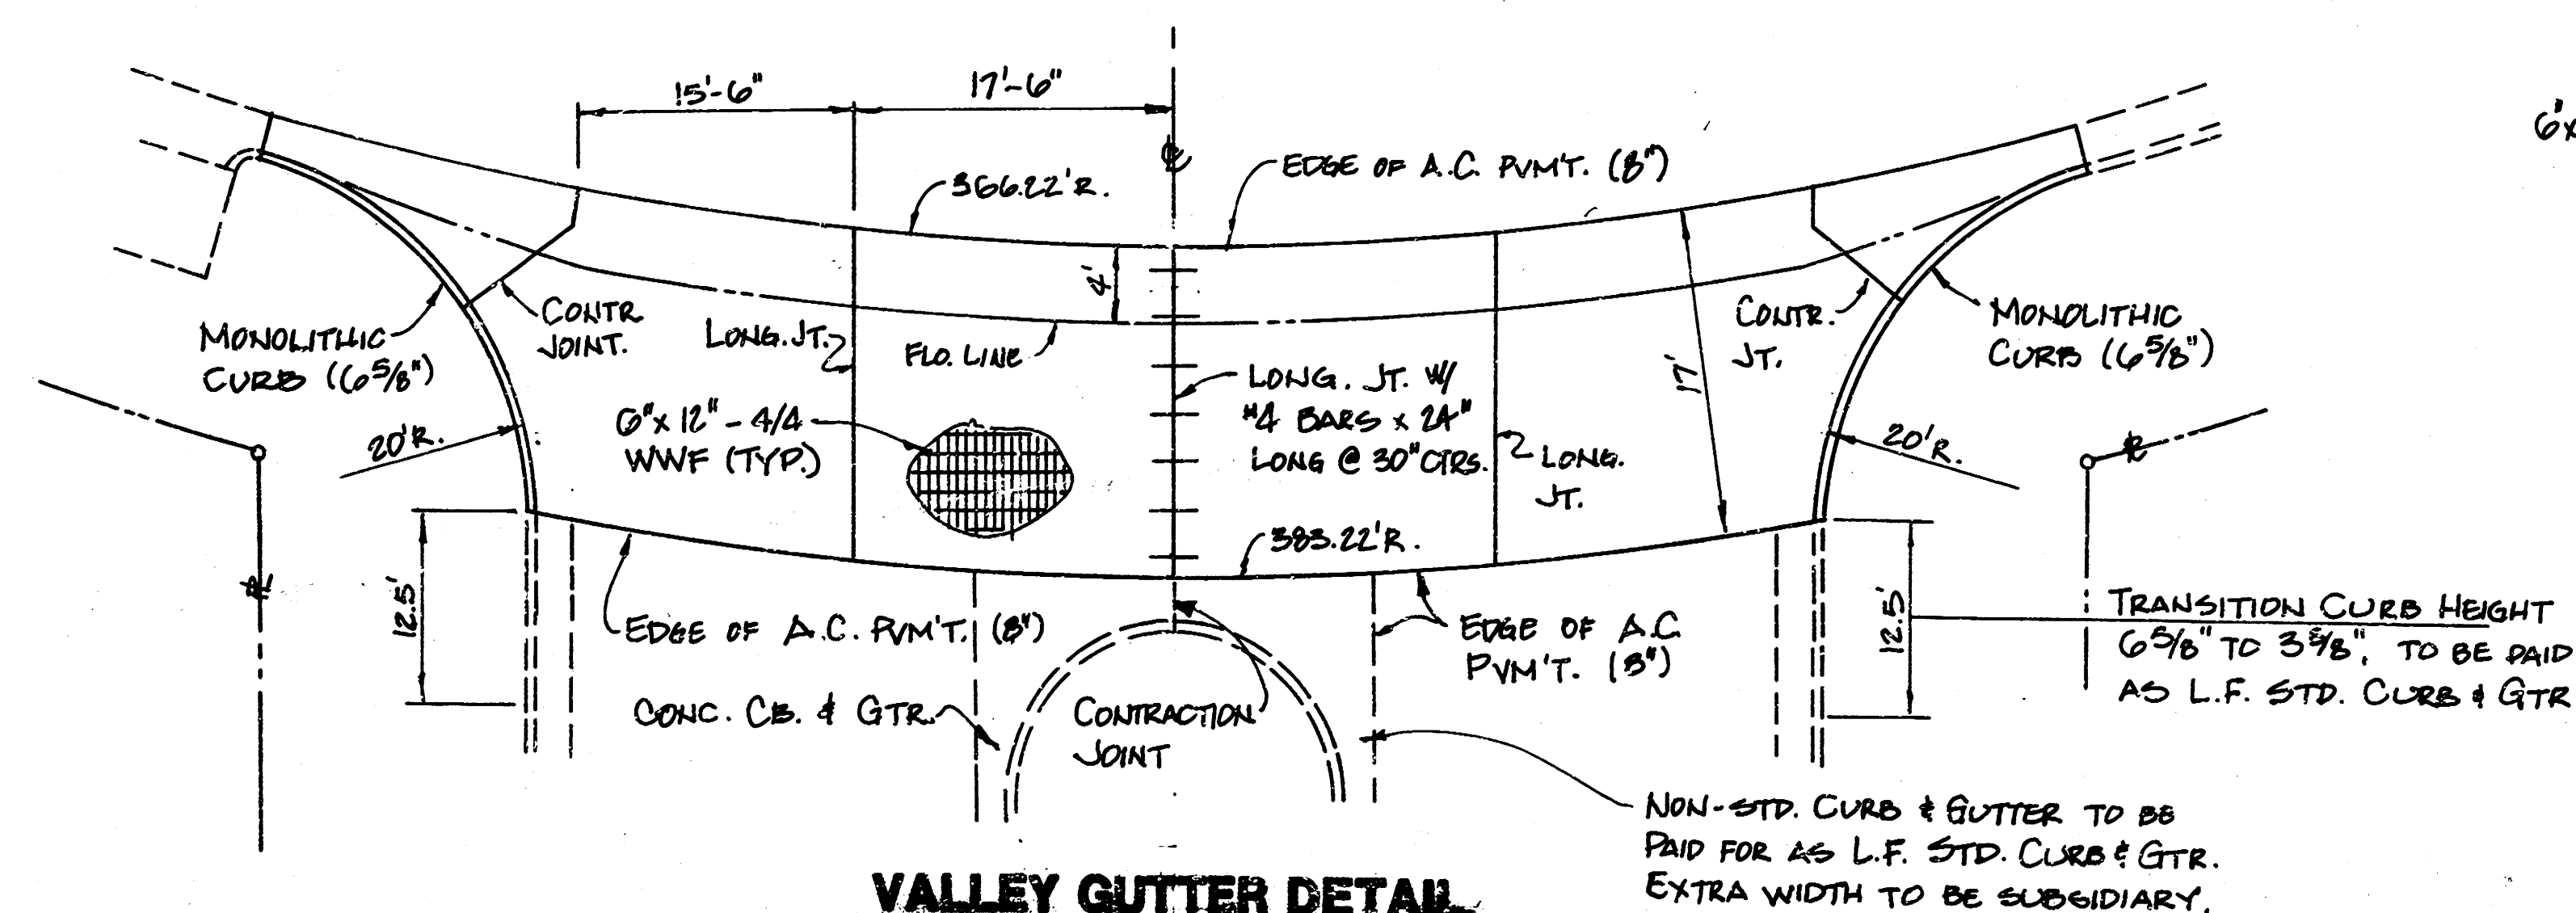


**VALLEY GUTTER DETAIL
GOLD/GOLD COURT**

**TYPICAL SECTION AND
VALLEY GUTTER DETAILS**


Proj. # 472-76-245-81193-000-000-000

TYPICAL 3' PAVEMENT DETAILS

TRANSVERSE SECTION

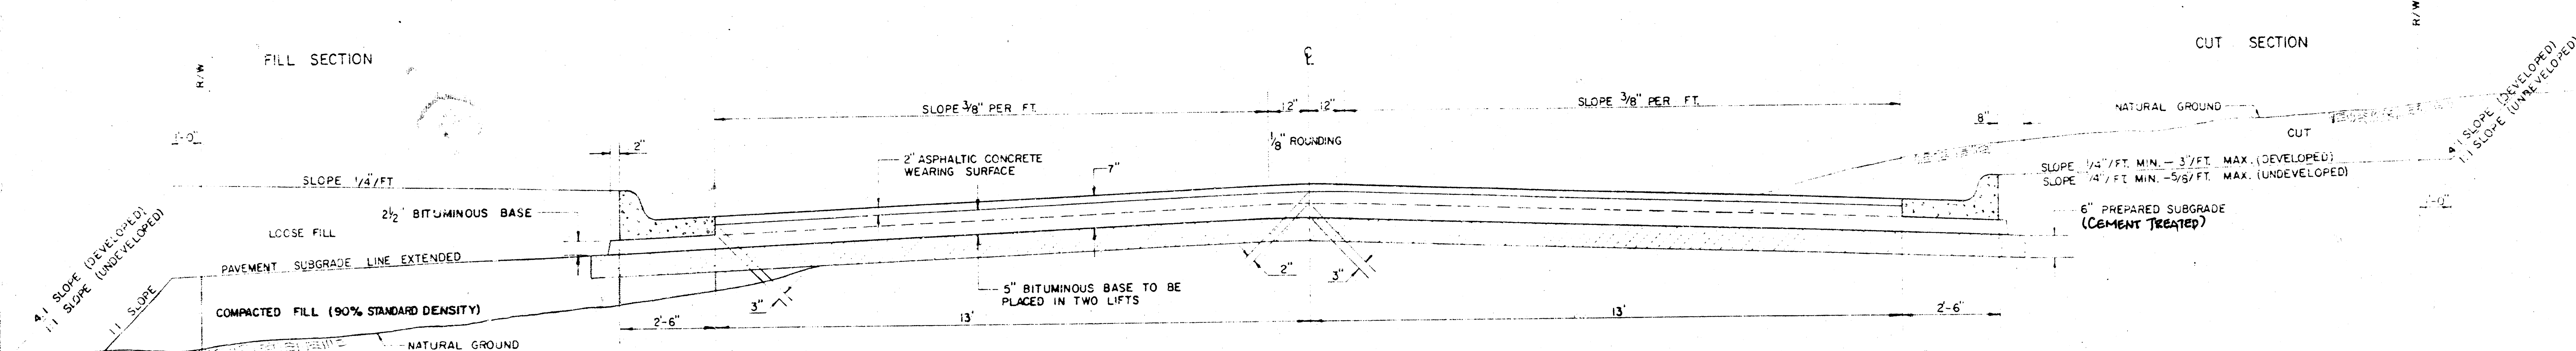


ELEVATION OFFSETS

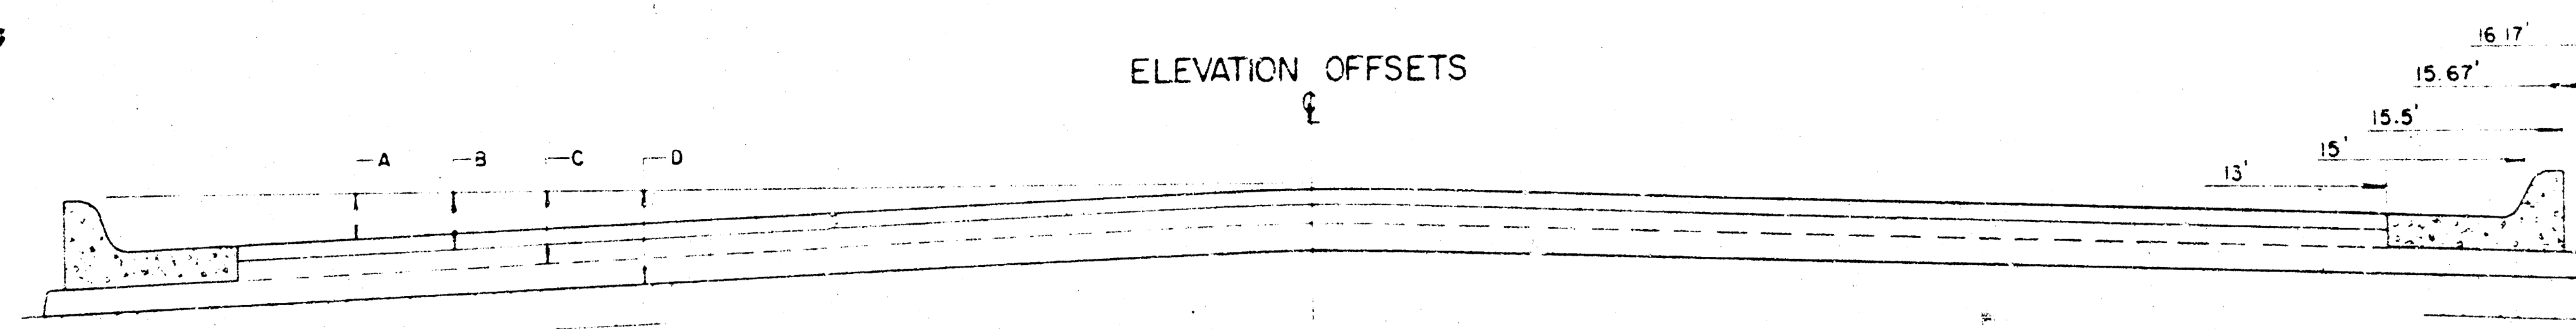


	DISTANCE FROM CENTERLINE (LT. & RT.)											
	0'	2'	4'	6'	7.5'	10'	12'	13'	15'	15.5'	15.67'	16.17'
A. TOP OF CURBS TO TOP OF SURFACE LIFT	0.10	0.14	0.21	0.27	0.32	0.39	0.46	0.49	—	—	—	—
B. TOP OF CURBS TO TOP OF UPPER BASE LIFT	0.27	0.31	0.38	0.44	0.49	0.56	0.63	0.66	—	—	—	—
C. TOP OF CURBS TO TOP OF LOWER BASE LIFT	0.44	0.49	0.57	0.64	0.70	0.79	0.87	0.90	0.98	1.00	1.00	—
D. TOP OF CURBS TO TOP OF SUBGRADE	0.69	0.73	0.80	0.87	0.93	1.01	1.09	1.12	1.19	1.21	1.21	1.23

TRANSVERSE CONSTRUCTION JOINTS

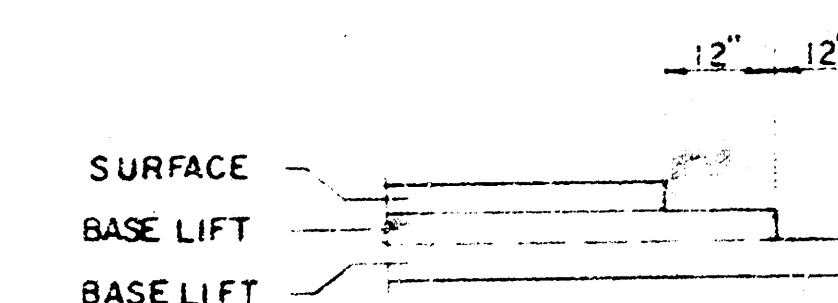

ROLL TYPE COMBINED CURB & GUTTER

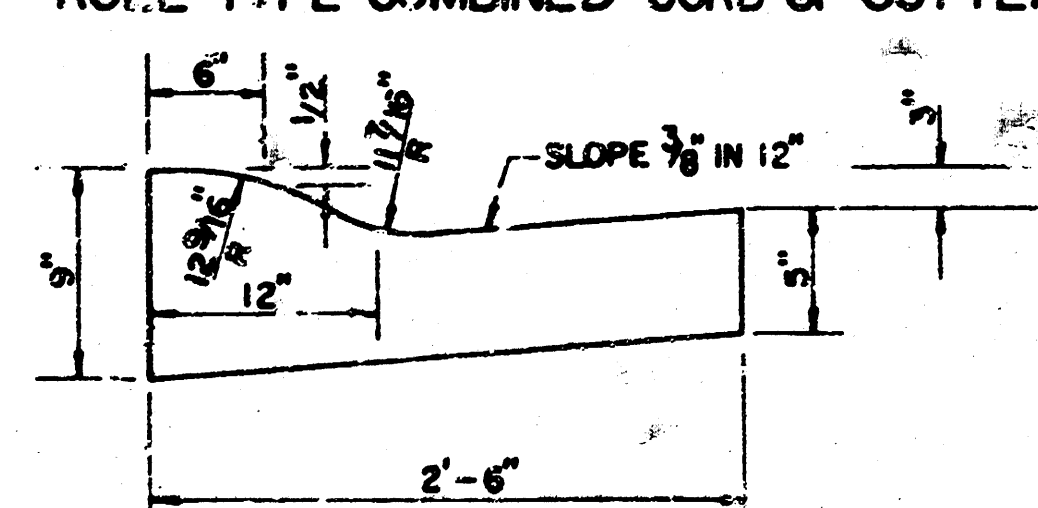

GENERAL NOTES



- 1) THE ASPHALTIC CONCRETE PAVEMENT BETWEEN THE COMBINED CURB AND GUTTER SHALL BE PAID AS SQUARE YARDS OF 7\"/>

7 INCH RESIDENTIAL ASPHALTIC CONCRETE
PAVEMENT WITH 5 INCH BITUMINOUS BASE
CITY OF WICHITA, KANSAS

472-76-246-81-93-000-000-001

4/14

NOTE: CONSTRUCT ROLL-TYPE COMBINED CURB & GUTTER WHERE INDICATED. ELEVATIONS SHOWN FOR FULL CURB.

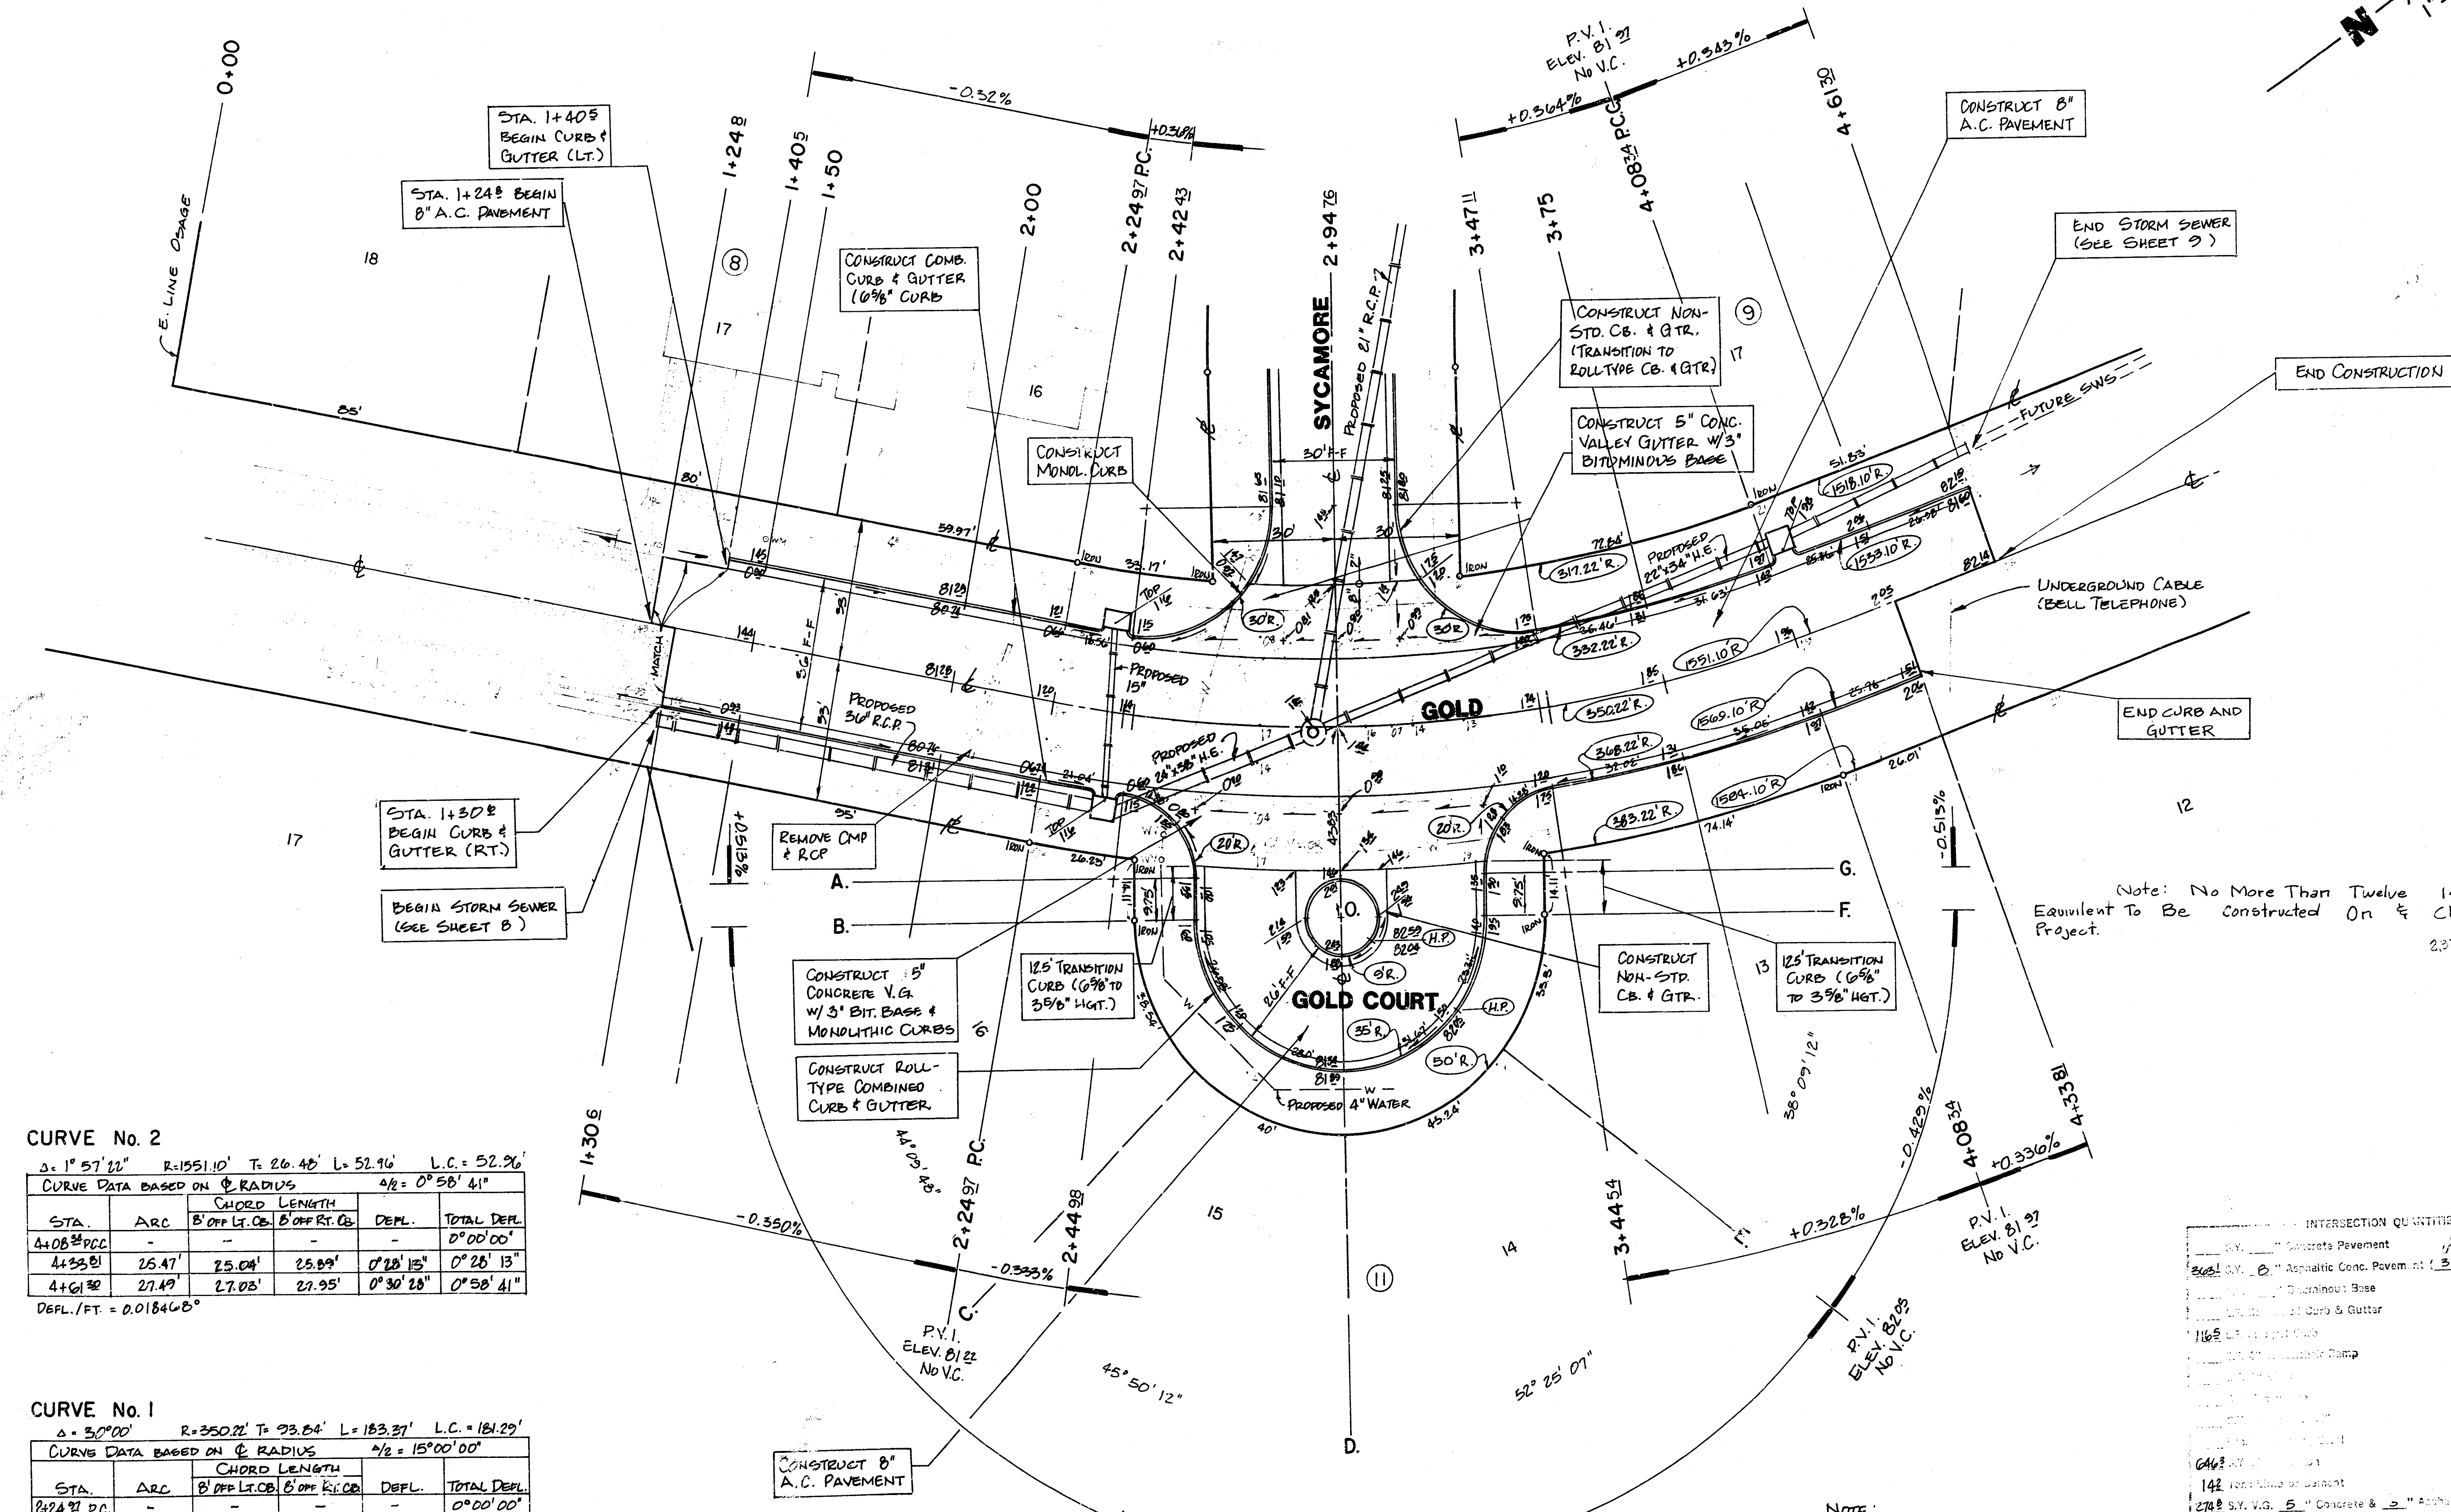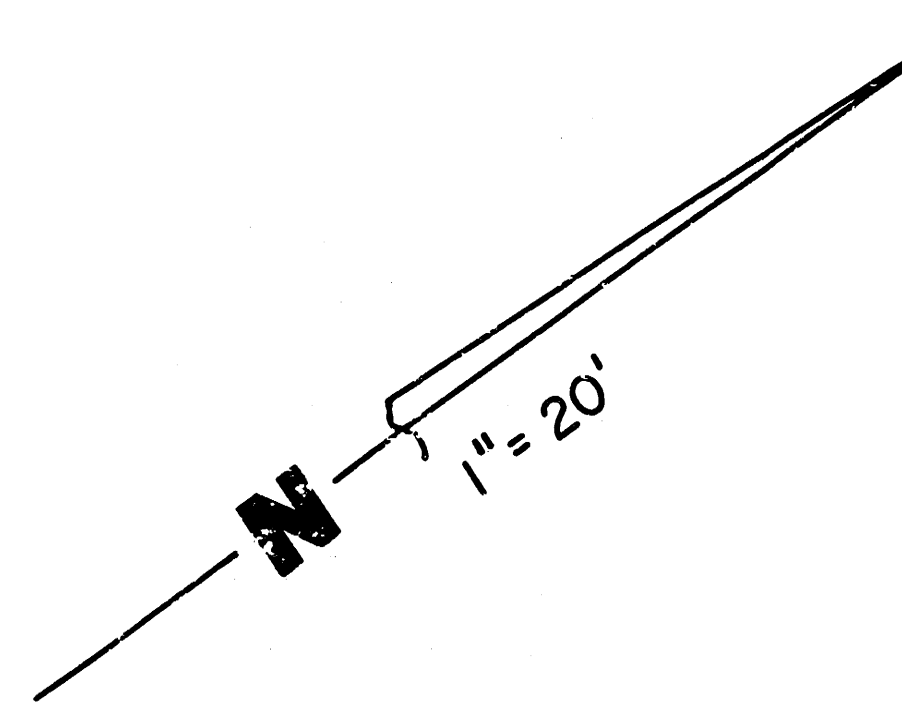

CURVE No. 2
 $\Delta = 1^\circ 57' 22''$ $R = 1551.10'$ $T = 26.48'$ $L = 52.96'$ $L.C. = 52.96'$
 CURVE DATA BASED ON ϕ RADIUS $\frac{\Delta}{2} = 0^\circ 58' 41''$

STA.	ARC	CHORD LENGTH	CHORD BEARING	DEFL.	TOTAL DEFL.
4+08.84 P.C.C.	-	-	-	-	0° 00' 00"
4+53.81	25.47'	25.04'	25.04'	0° 26' 13"	0° 26' 13"
4+61.80	27.49'	27.05'	27.05'	0° 30' 28"	0° 56' 41"

DEFL./FT. = 0.018465

CURVE No. 1
 $\Delta = 3^\circ 00' 00''$ $R = 350.22'$ $T = 33.84'$ $L = 183.37'$ $L.C. = 183.37'$
 CURVE DATA BASED ON ϕ RADIUS $\frac{\Delta}{2} = 1^\circ 30' 00''$

STA.	ARC	CHORD LENGTH	CHORD BEARING	DEFL.	TOTAL DEFL.
2+24.91 P.O.	-	-	-	-	0° 00' 00"
2+42.49	17.46'	16.16'	16.16'	1° 25' 42"	1° 25' 42"
2+44.99	2.55'	2.49'	2.49'	0° 12' 51"	1° 38' 33"
2+94.74	49.76'	48.40'	55.43'	4° 04' 19"	5° 46' 52"
3+44.94	49.76'	48.40'	55.43'	4° 04' 19"	9° 46' 52"
3+47.11	2.57'	2.49'	2.49'	0° 12' 51"	9° 59' 29"
3+75	27.89'	25.81'	32.71'	2° 16' 58"	12° 16' 22"
4+08.84 P.C.C.	53.34'	50.85'	55.60'	2° 43' 36"	15° 00' 00"


DEFL./FT. = 0.061802


EARTHWORK:
 EXCAVATION 1200 CU. YDS.
 COMPACTED FILL 17 CU. YDS.
SUBGRADE STABILIZATION 4675 SQ. YDS.

Note: No More Than Twelve 14 Ft. Driveways or Equivalent To Be Constructed On & Charged To This Project.
 2,371.2 SF

INTERSECTION QUANTITIES

2442	1" Concrete Pavement	1'
2442	2" Asphaltic Conc. Pavement (3" Bit. Base)	1'
2442	3" Bit. Base	1'
2442	4" Bit. Base	1'
2442	5" Bit. Base	1'
2442	6" Bit. Base	1'
2442	7" Bit. Base	1'
2442	8" Bit. Base	1'
2442	9" Bit. Base	1'
2442	10" Bit. Base	1'
2442	11" Bit. Base	1'
2442	12" Bit. Base	1'
2442	13" Bit. Base	1'
2442	14" Bit. Base	1'
2442	15" Bit. Base	1'
2442	16" Bit. Base	1'
2442	17" Bit. Base	1'
2442	18" Bit. Base	1'
2442	19" Bit. Base	1'
2442	20" Bit. Base	1'

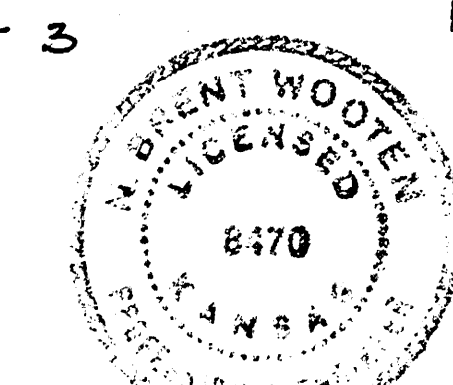

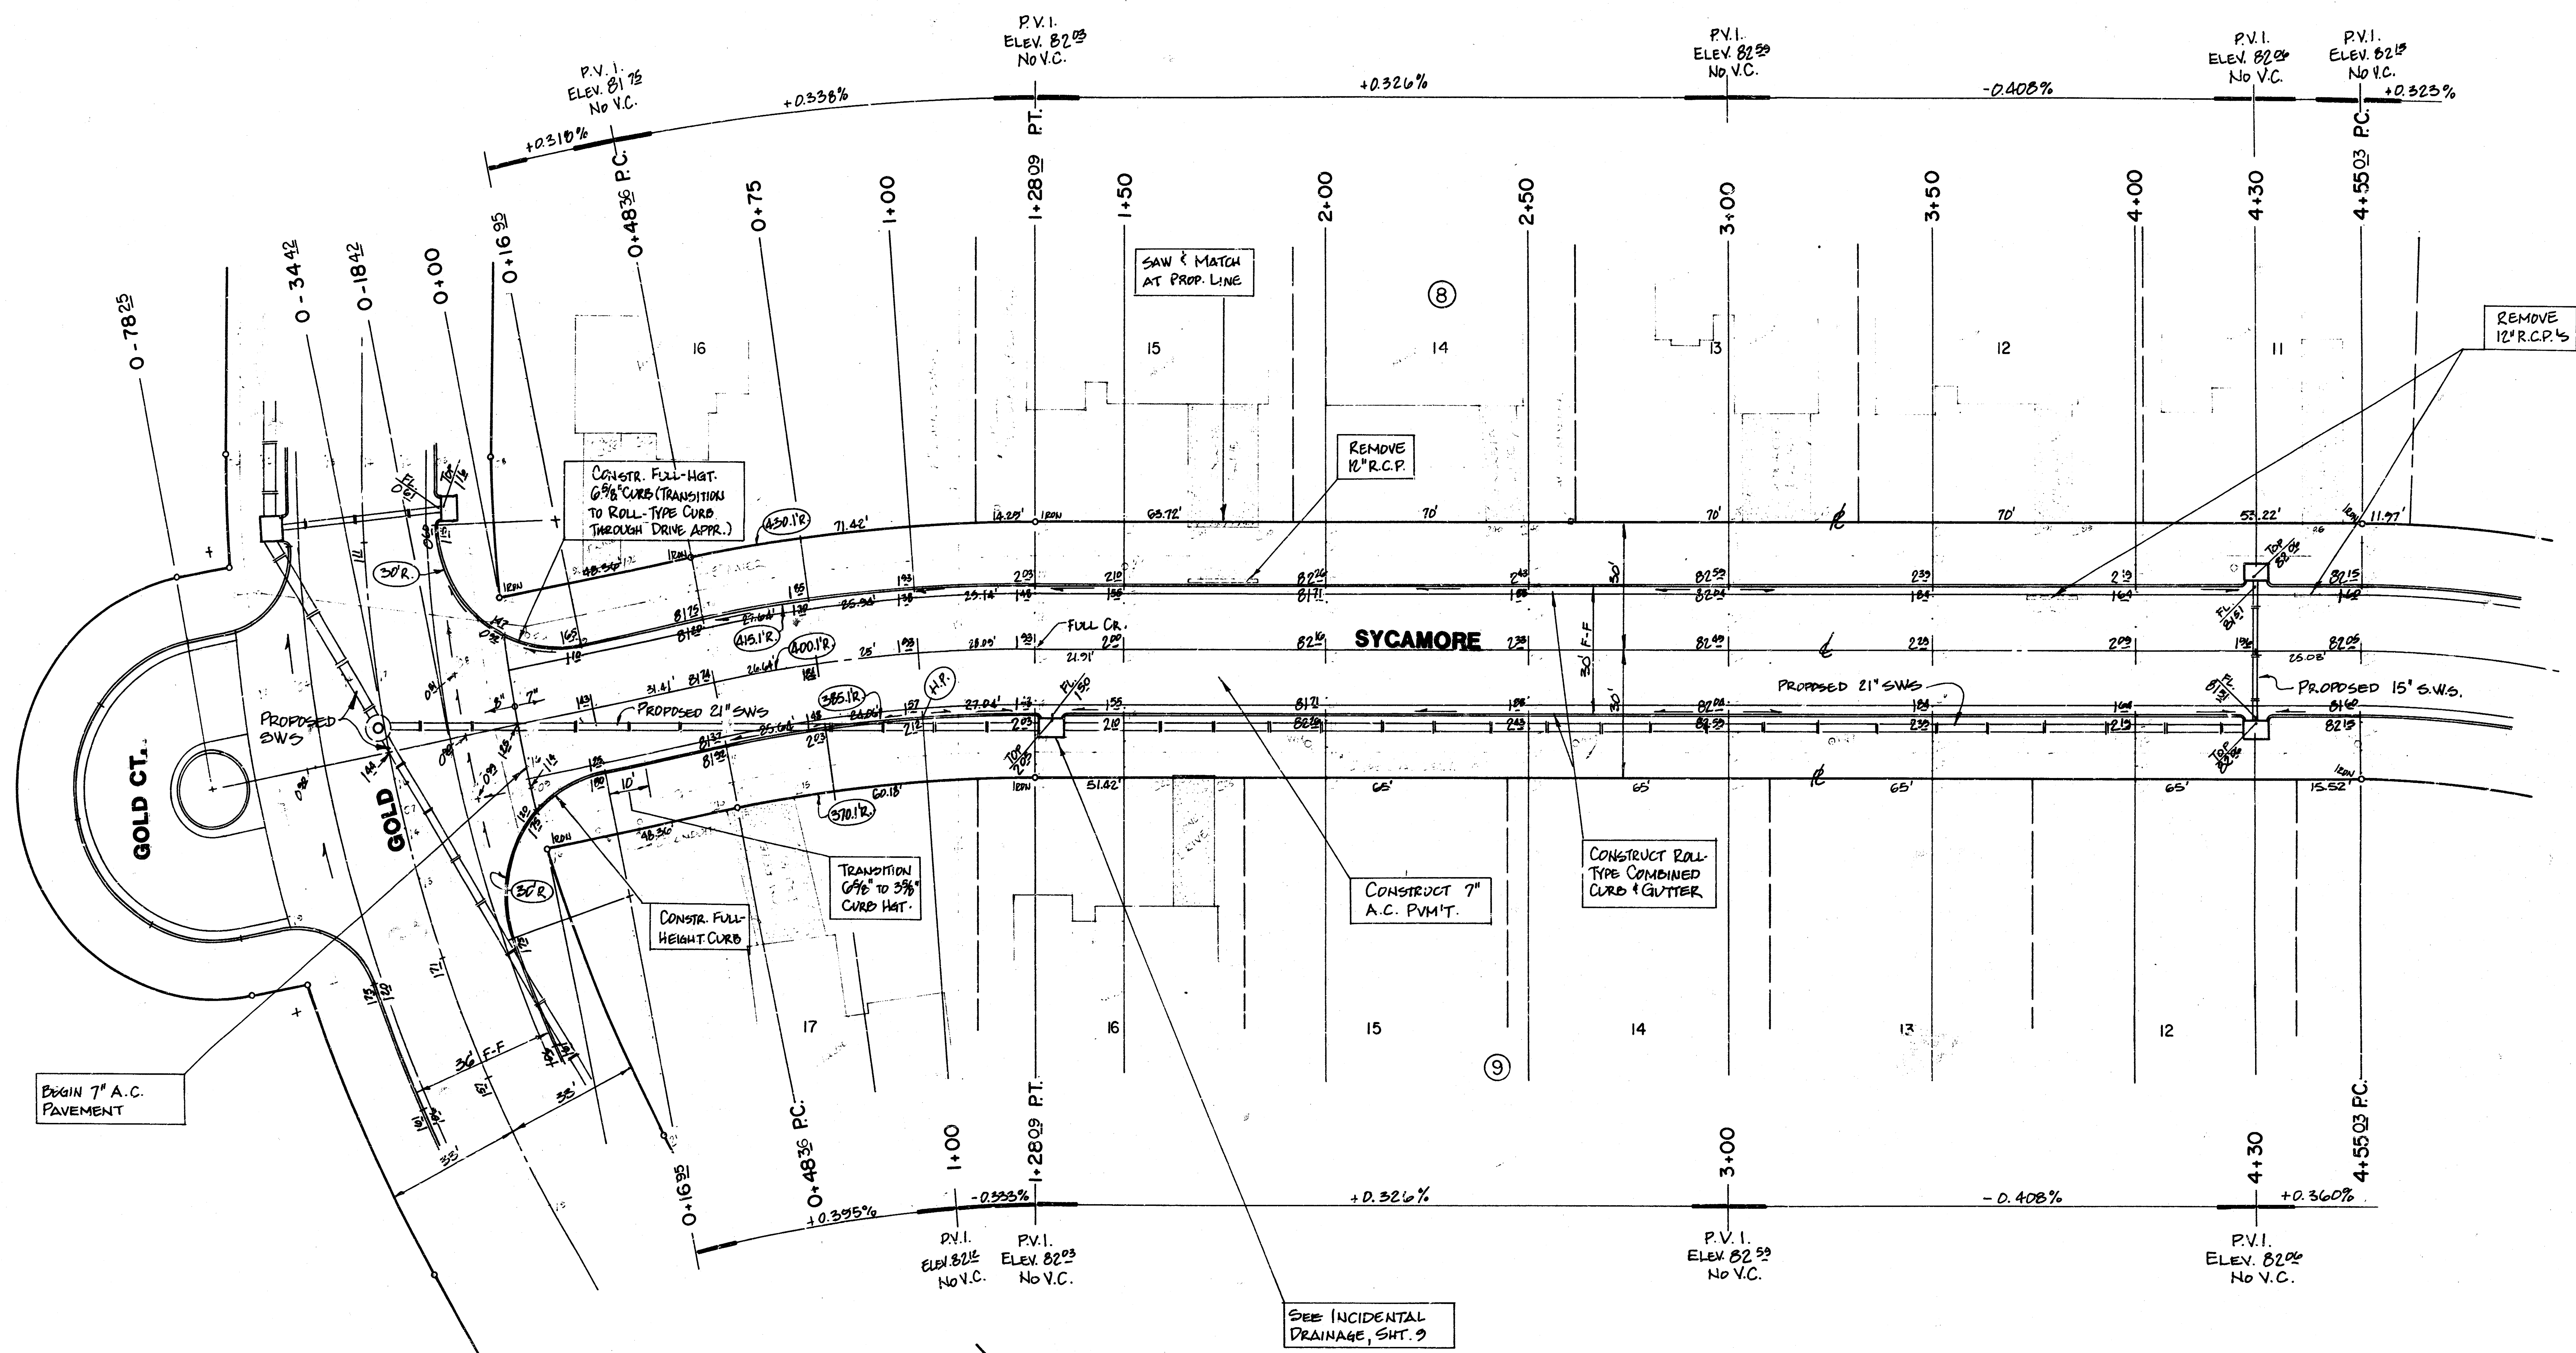


$\Delta = 11^\circ 25' 06''$ $R = 400.10'$ $T = 40.00'$ $L = 79.75'$ $L.C. = 79.60'$
 CURVE DATA BASED ON 6° RADIUS $\frac{1}{2} \Delta = 5^\circ 42' 33''$

STA.	ARC.	CHORD LENGTH		DEPL.	TOTAL DEPL.
		8' OFF LT. CB	8' OFF RT. CB		
0+00.00	-	-	-	-	0° 00' 00"
0+75	26.64'	26.17'	25.10'	1° 51' 27"	1° 54' 27"
1+00	25'	26.44'	25.56'	1° 47' 15"	3° 41' 52"
1+28.09 P.T.	26.09'	29.70'	26.47'	2° 00' 41"	5° 42' 33"

DEFL. / FT. = 0.07161°

NOTE:
 CONSTRUCT ROLL-TYPE CURB &
 GUTTER AS INDICATED. ELEVATIONS
 SHOWN FOR FULL CURB.

INDICATES REMOVAL

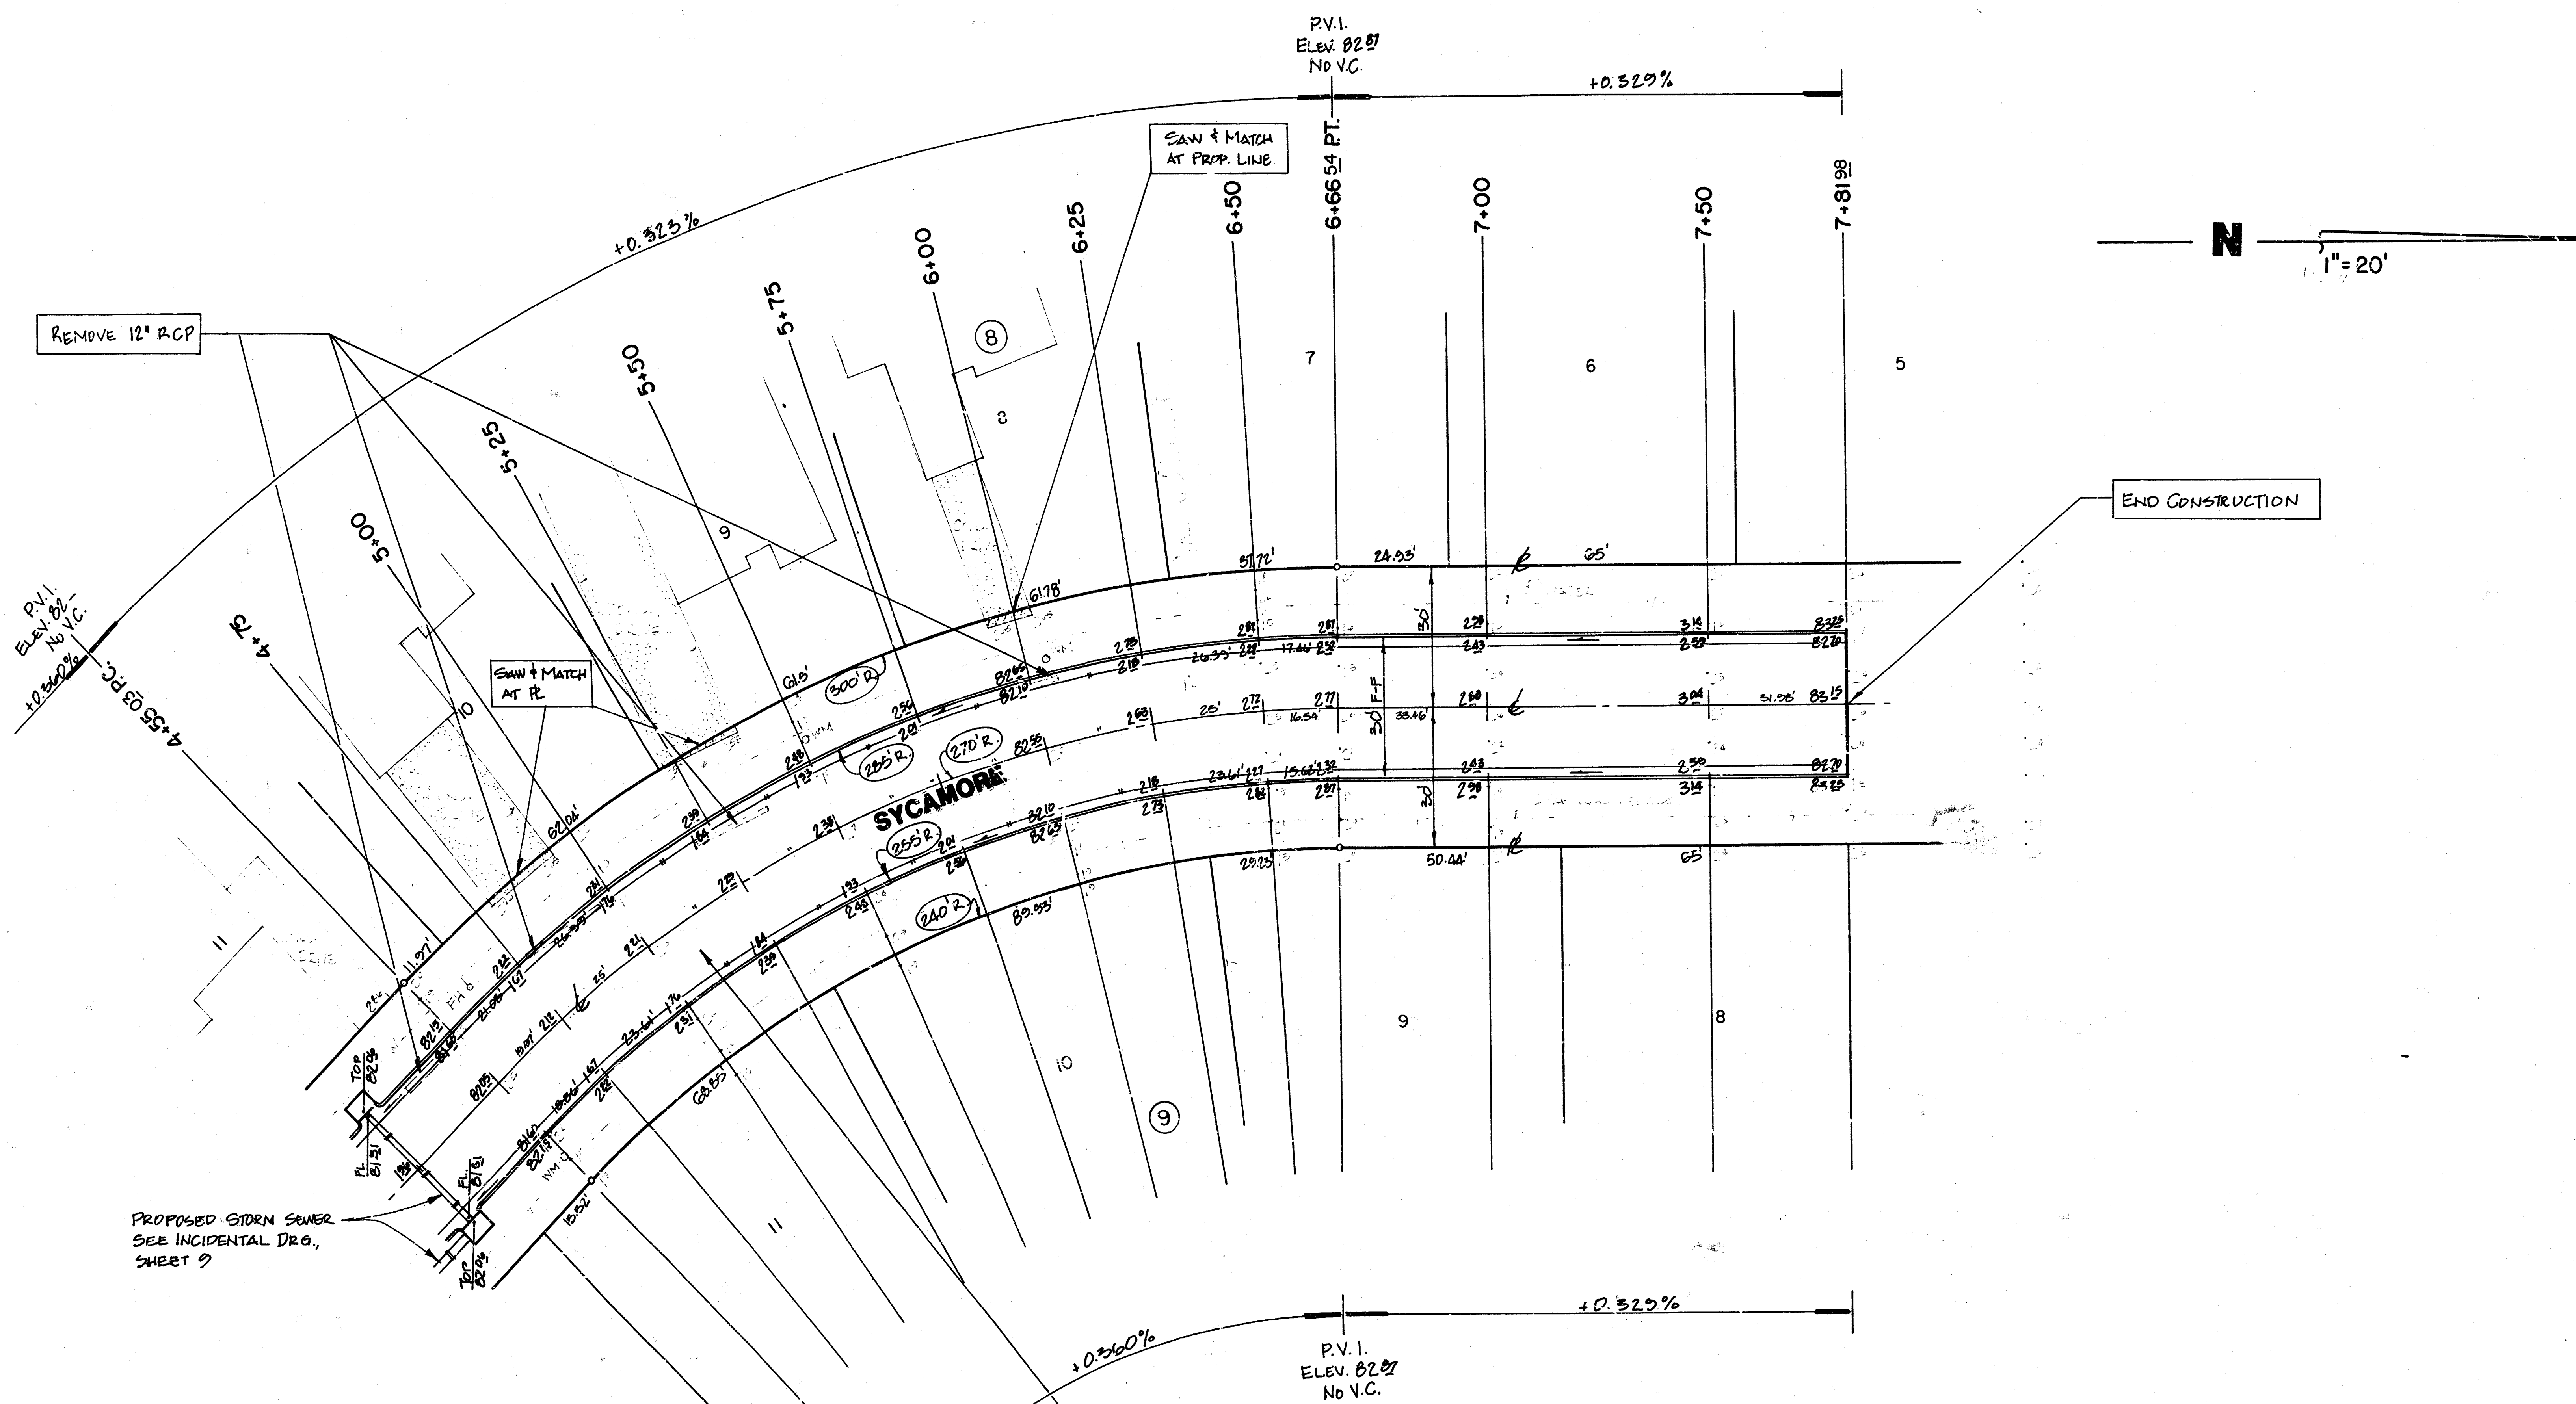

$\Delta = 44^\circ 53'$ $R = 270'$ $T = 111.52'$ $L = 211.51'$ $L.C. = 206.14'$

CURVE DATA BASED ON $\frac{1}{2}$ RADIUS $\frac{1}{2} R = 135.26'$




STA	ARC	CHORD LENGTH		CHORD BEING	CHORD TO CURVE	DEFL.	TOTAL DEFL.
4+55.50 PC	-	-	-	-	-	-	0° 00' 00"
4+75	19.97'	21.67'	15.26'	2° 07' 08"	2° 07' 08"	2° 07' 08"	
5+00	25'	27.12'	22.86'	2° 32' 09"	4° 39' 17"	4° 39' 17"	
5+25	25'	27.12'	22.86'	2° 32' 09"	7° 11' 26"	7° 11' 26"	
5+50	25'	27.12'	22.86'	2° 32' 09"	10° 43' 35"	10° 43' 35"	
5+75	25'	27.12'	22.86'	2° 32' 09"	13° 15' 44"	13° 15' 44"	
6+00	25'	27.12'	22.86'	2° 32' 09"	15° 47' 53"	15° 47' 53"	
6+25	25'	27.12'	22.86'	2° 32' 09"	18° 19' 52"	18° 19' 52"	
6+50	25'	27.12'	22.86'	2° 32' 09"	20° 51' 51"	20° 51' 51"	
6+66.54 PT	16.54'	17.94'	15.15'	1° 45' 17"	22° 26' 30"	22° 26' 30"	


DEFL. / FT. = 0.10610"

NOTE:
 CONSTRUCT ROLL-TYPE COMBINED CURB & GUTTER AS INDICATED.
 GRADES SHOWN ARE FOR FULL CURB.

SCALE: 1"=20' PLAN
1"=20' PROFILE HORIZ.
1"=5' PROFILE VERT.

As Built Plan
7-1-85
GREENE

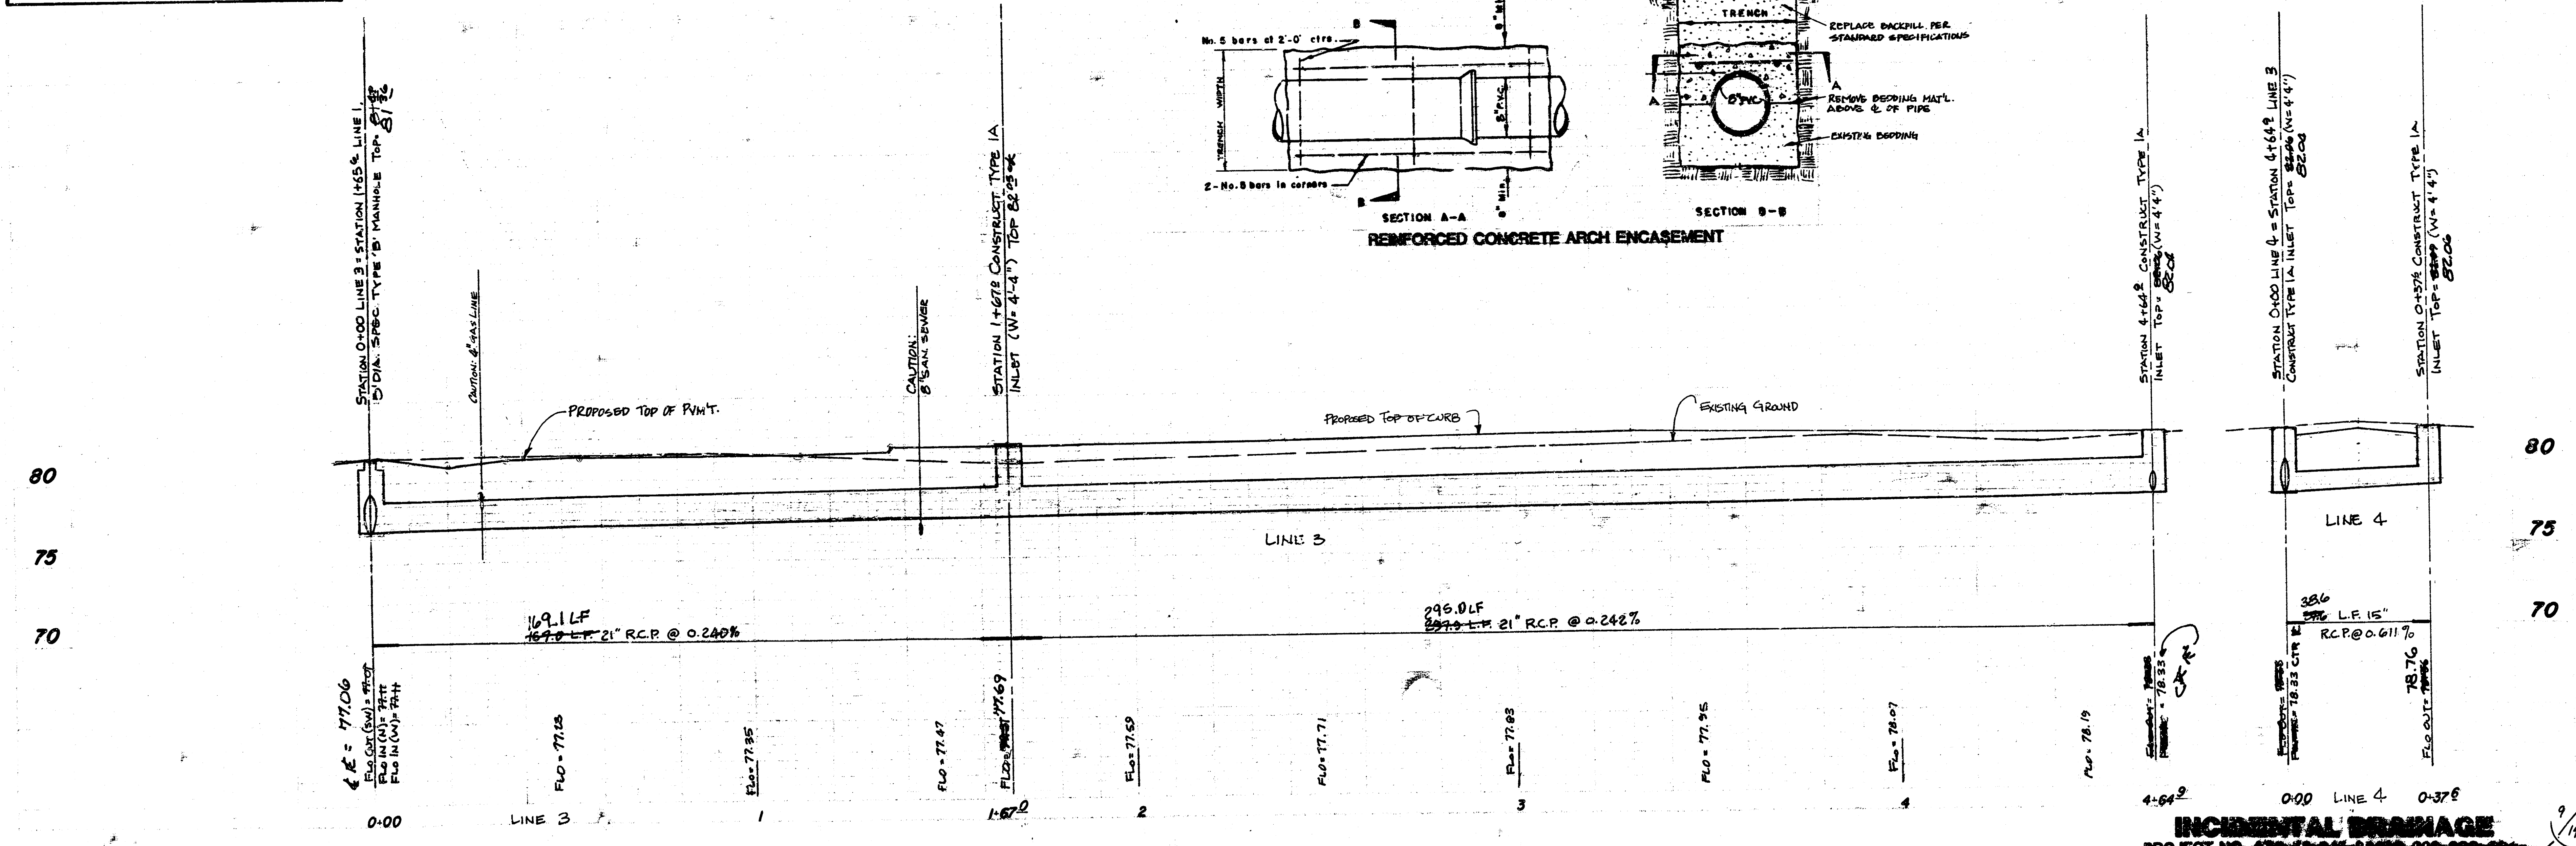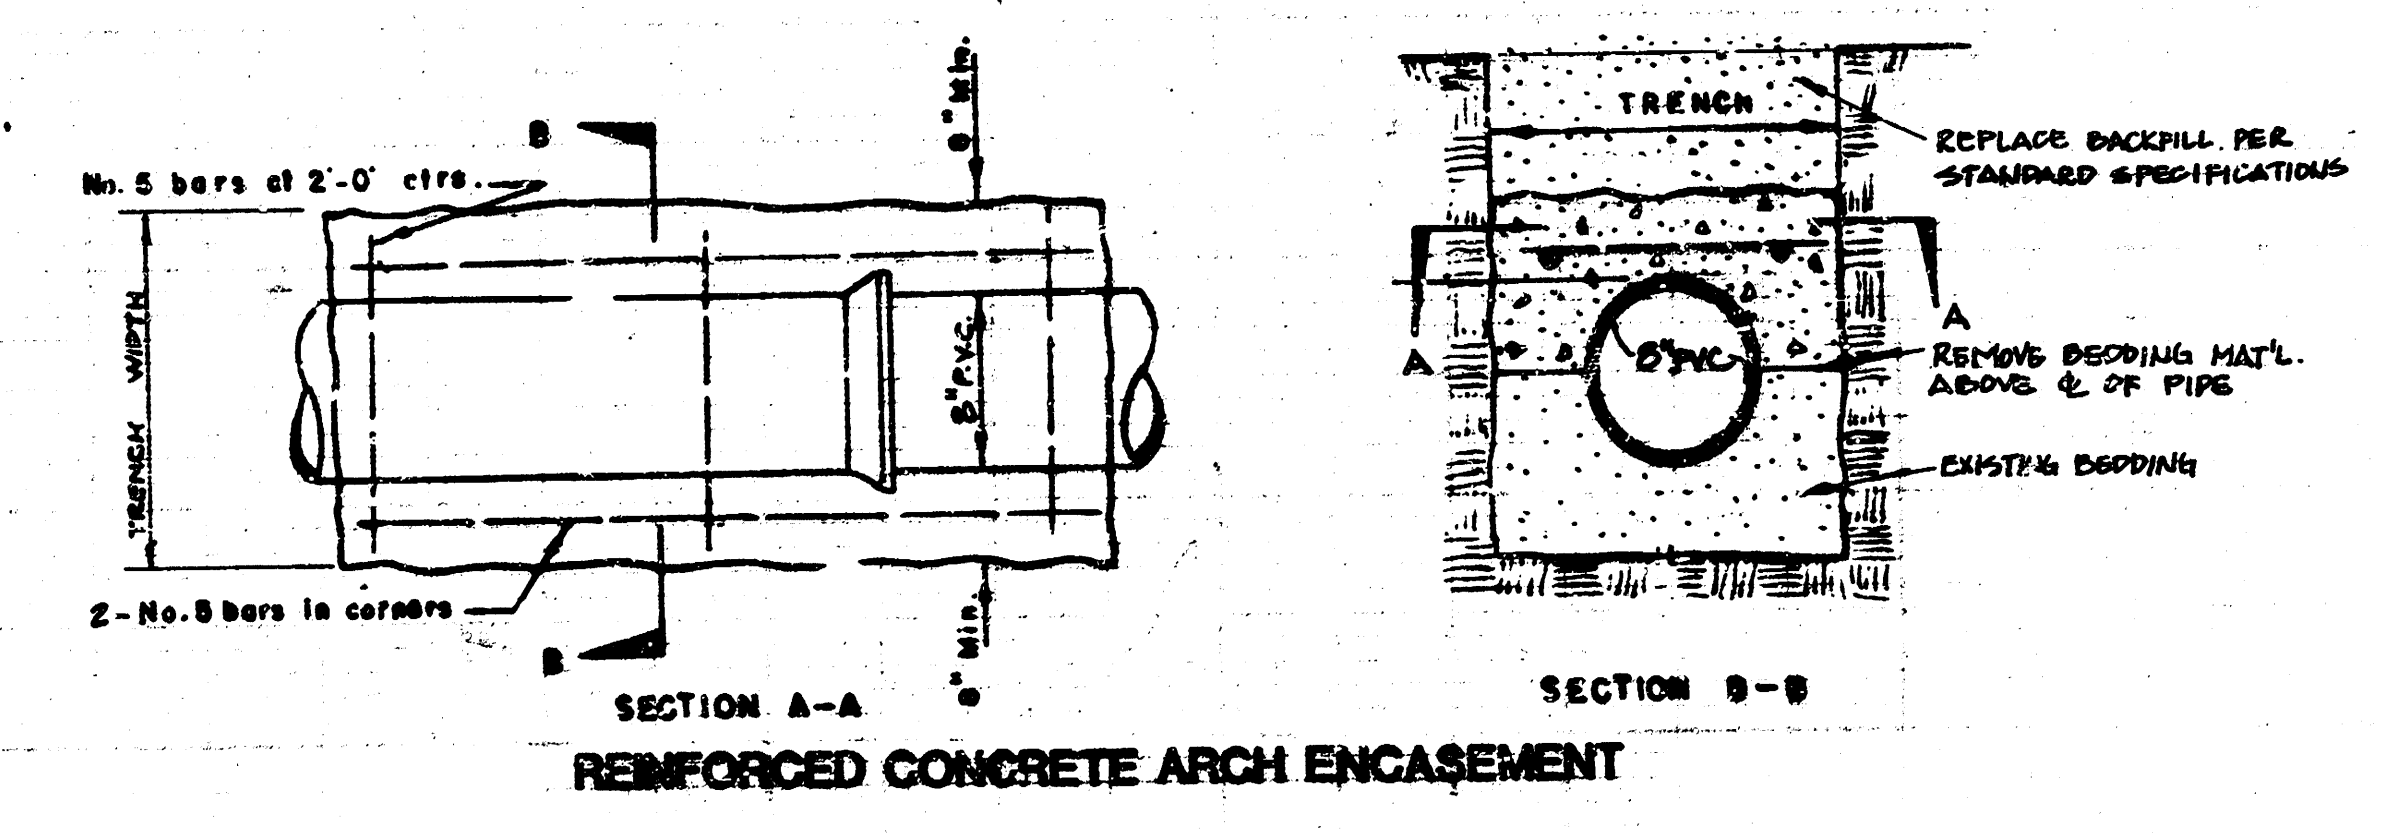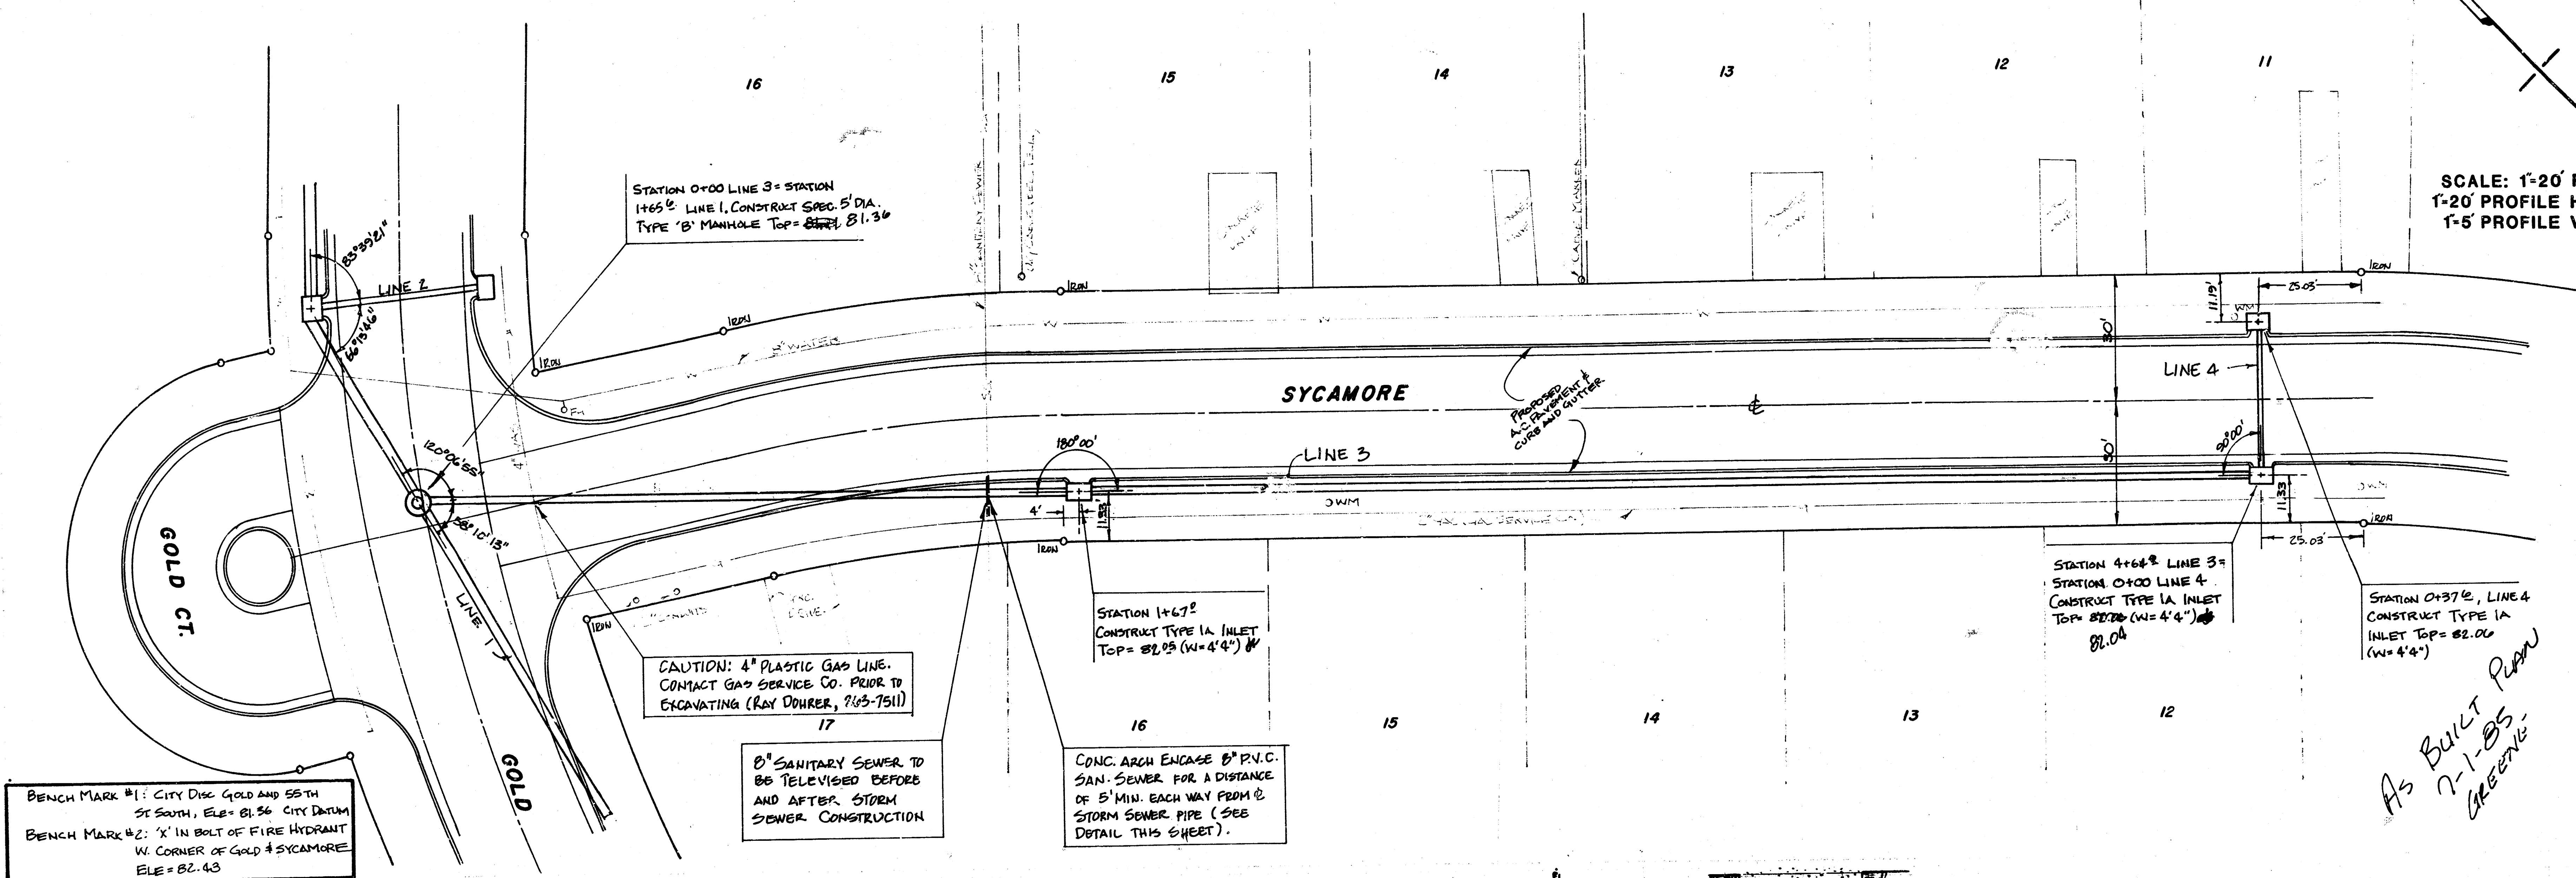

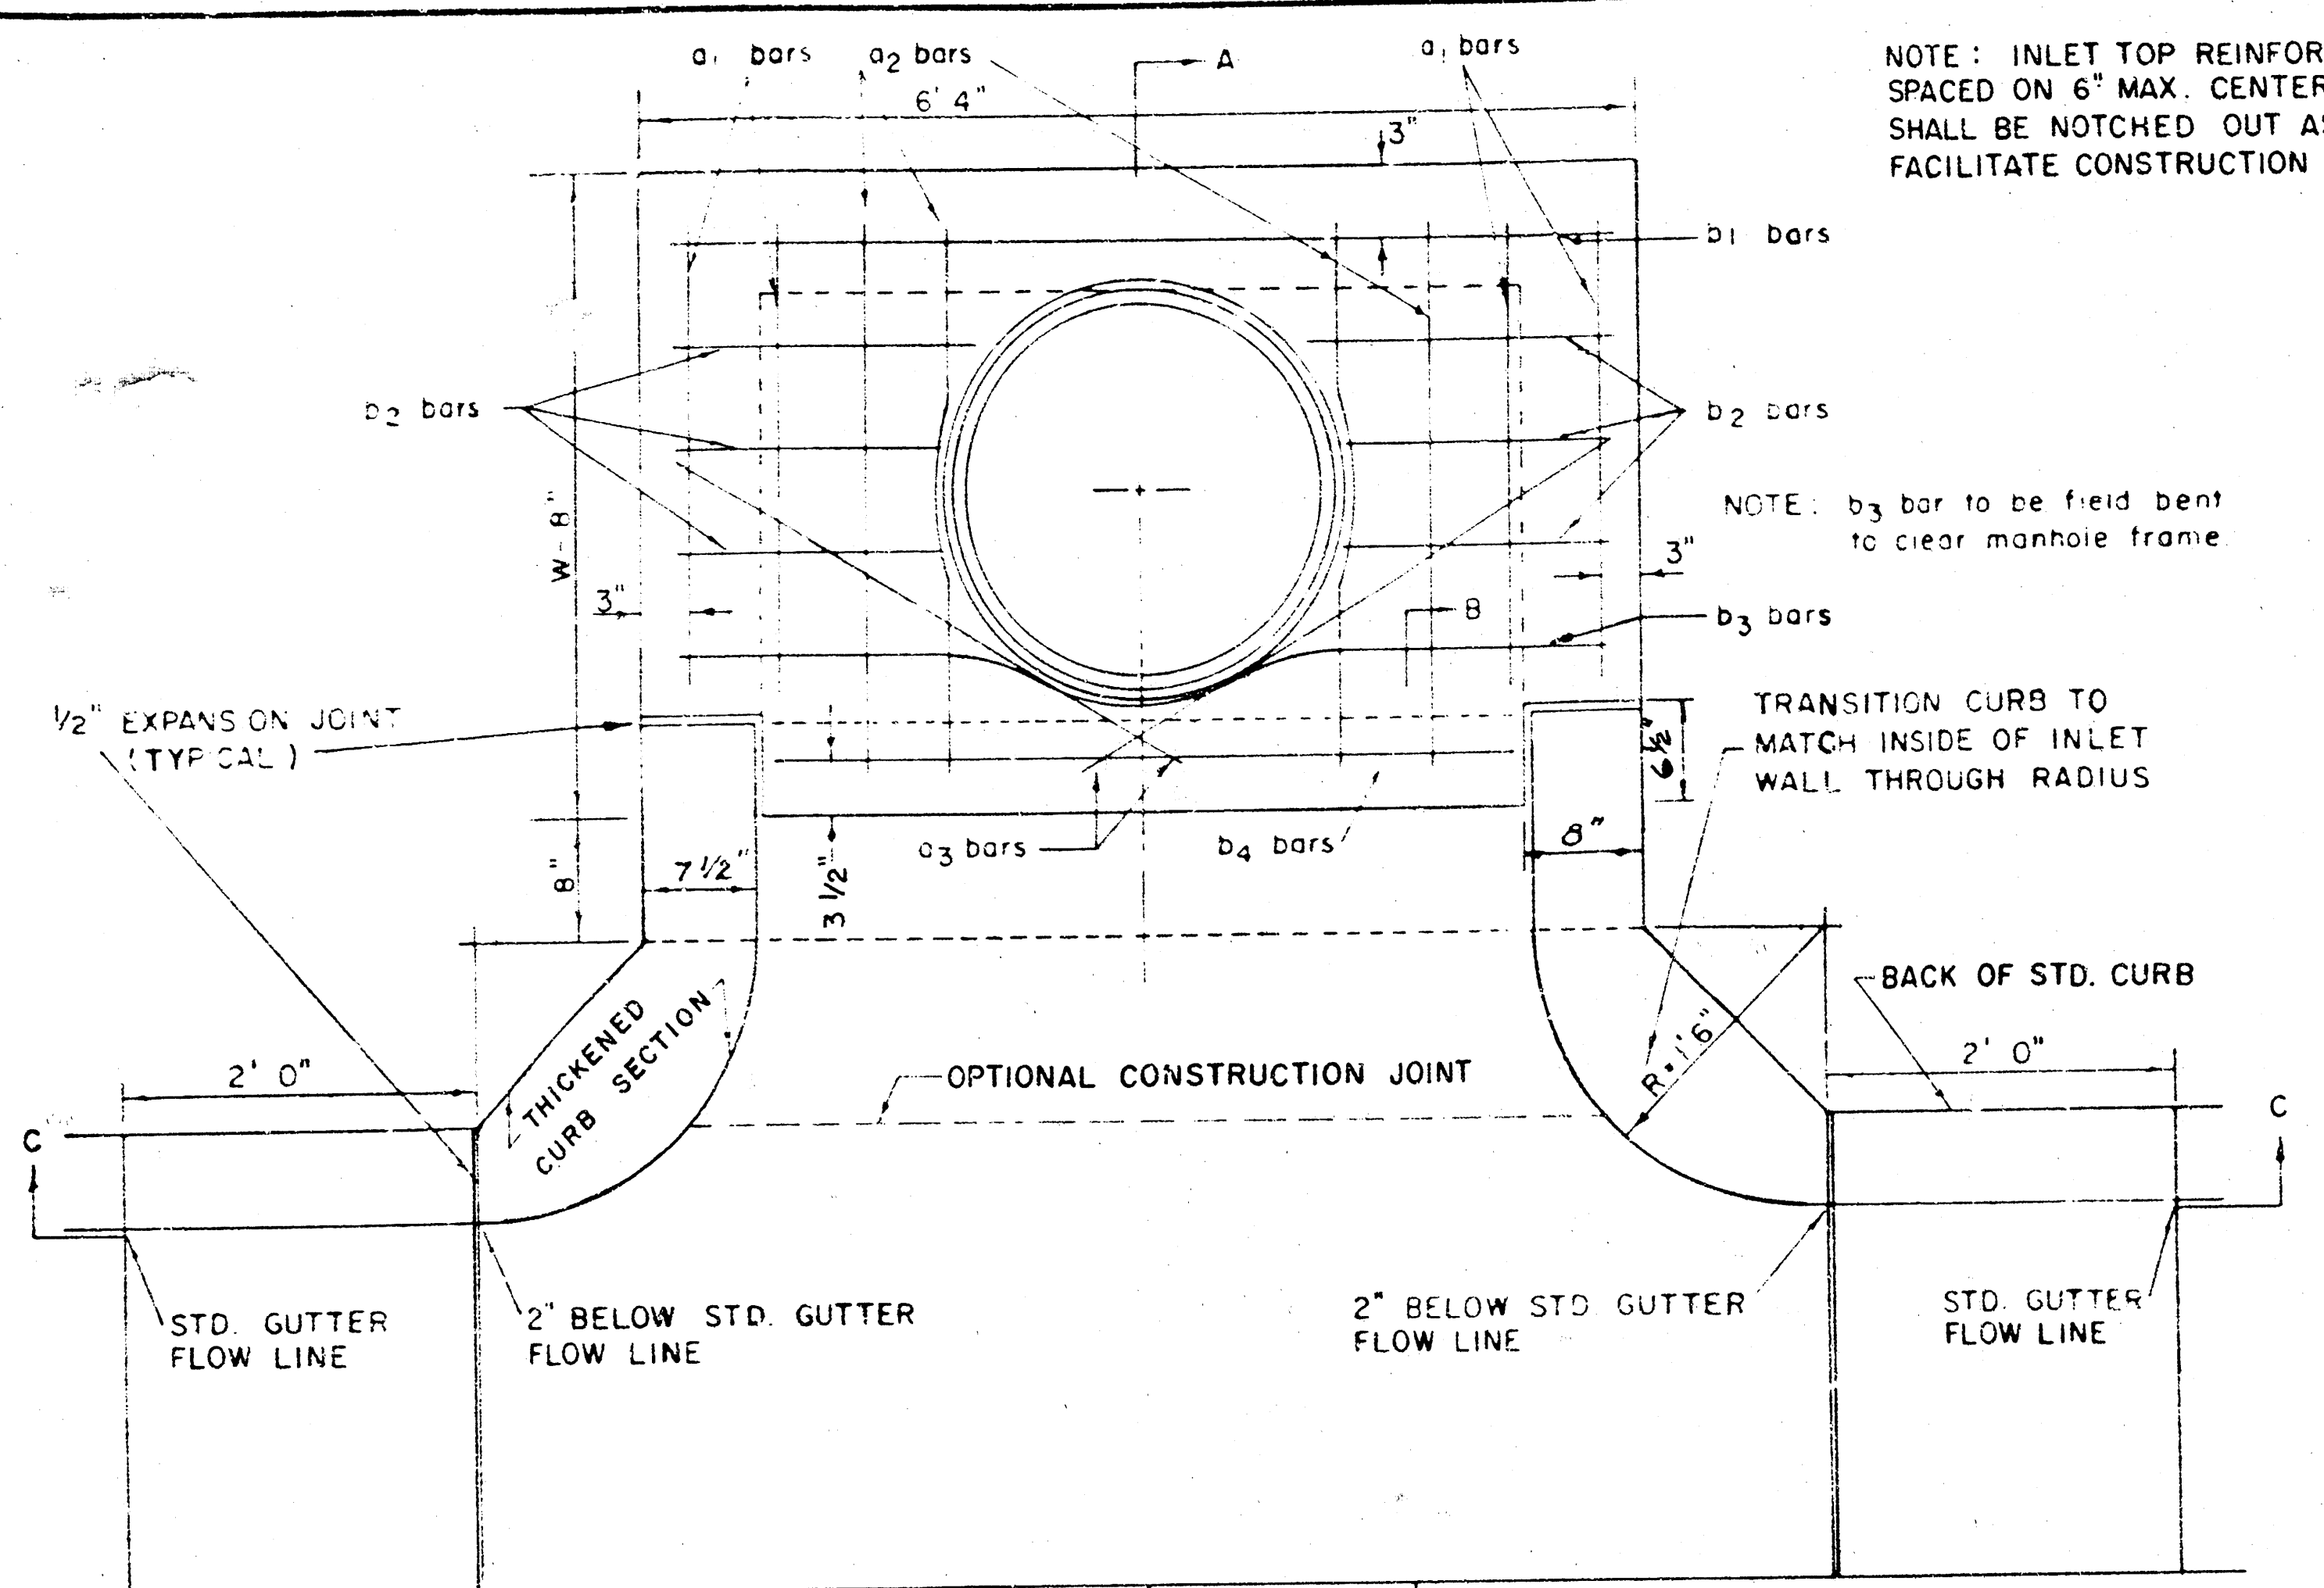


NOTE: EXPANSION JOINT ONLY IN CURB AREA WITH CONC. PAVEMENT.

PLAN

STEEL SCHEDULE												
BAR	a ₁	a ₂	a ₃	a ₄	a ₅	a ₆	a ₇	a ₈	a ₉	a ₁₀	a ₁₁	a ₁₂
NUMBER	4	4	2	1	3	5	7	9	6	1	1	
SIZE	#4	#4	#4	#4	#4	#4	#4	#4	#4	#4	#6	
W=4'4"	5'7"	6'7"	4'0"	6'1"	-	-	-	-	1'9"	6'2"	4'8"	60±
W=5'4"	7'7"	8'7"	5'0"	-	6'1"	-	-	-	1'9"	6'2"	4'8"	81±
W=6'4"	9'7"	10'7"	6'0"	-	-	6'1"	-	-	1'9"	6'2"	4'8"	101±
W=7'4"	11'7"	12'7"	7'0"	-	-	-	6'1"	-	1'9"	6'2"	4'8"	121±
W=8'4"	13'7"	14'7"	8'0"	-	-	-	-	6'1"	1'9"	6'2"	4'8"	141±

* NOTE: a₃ BARS TO BE PLACED APPROX. 2" BELOW TOP OF INLET COVER

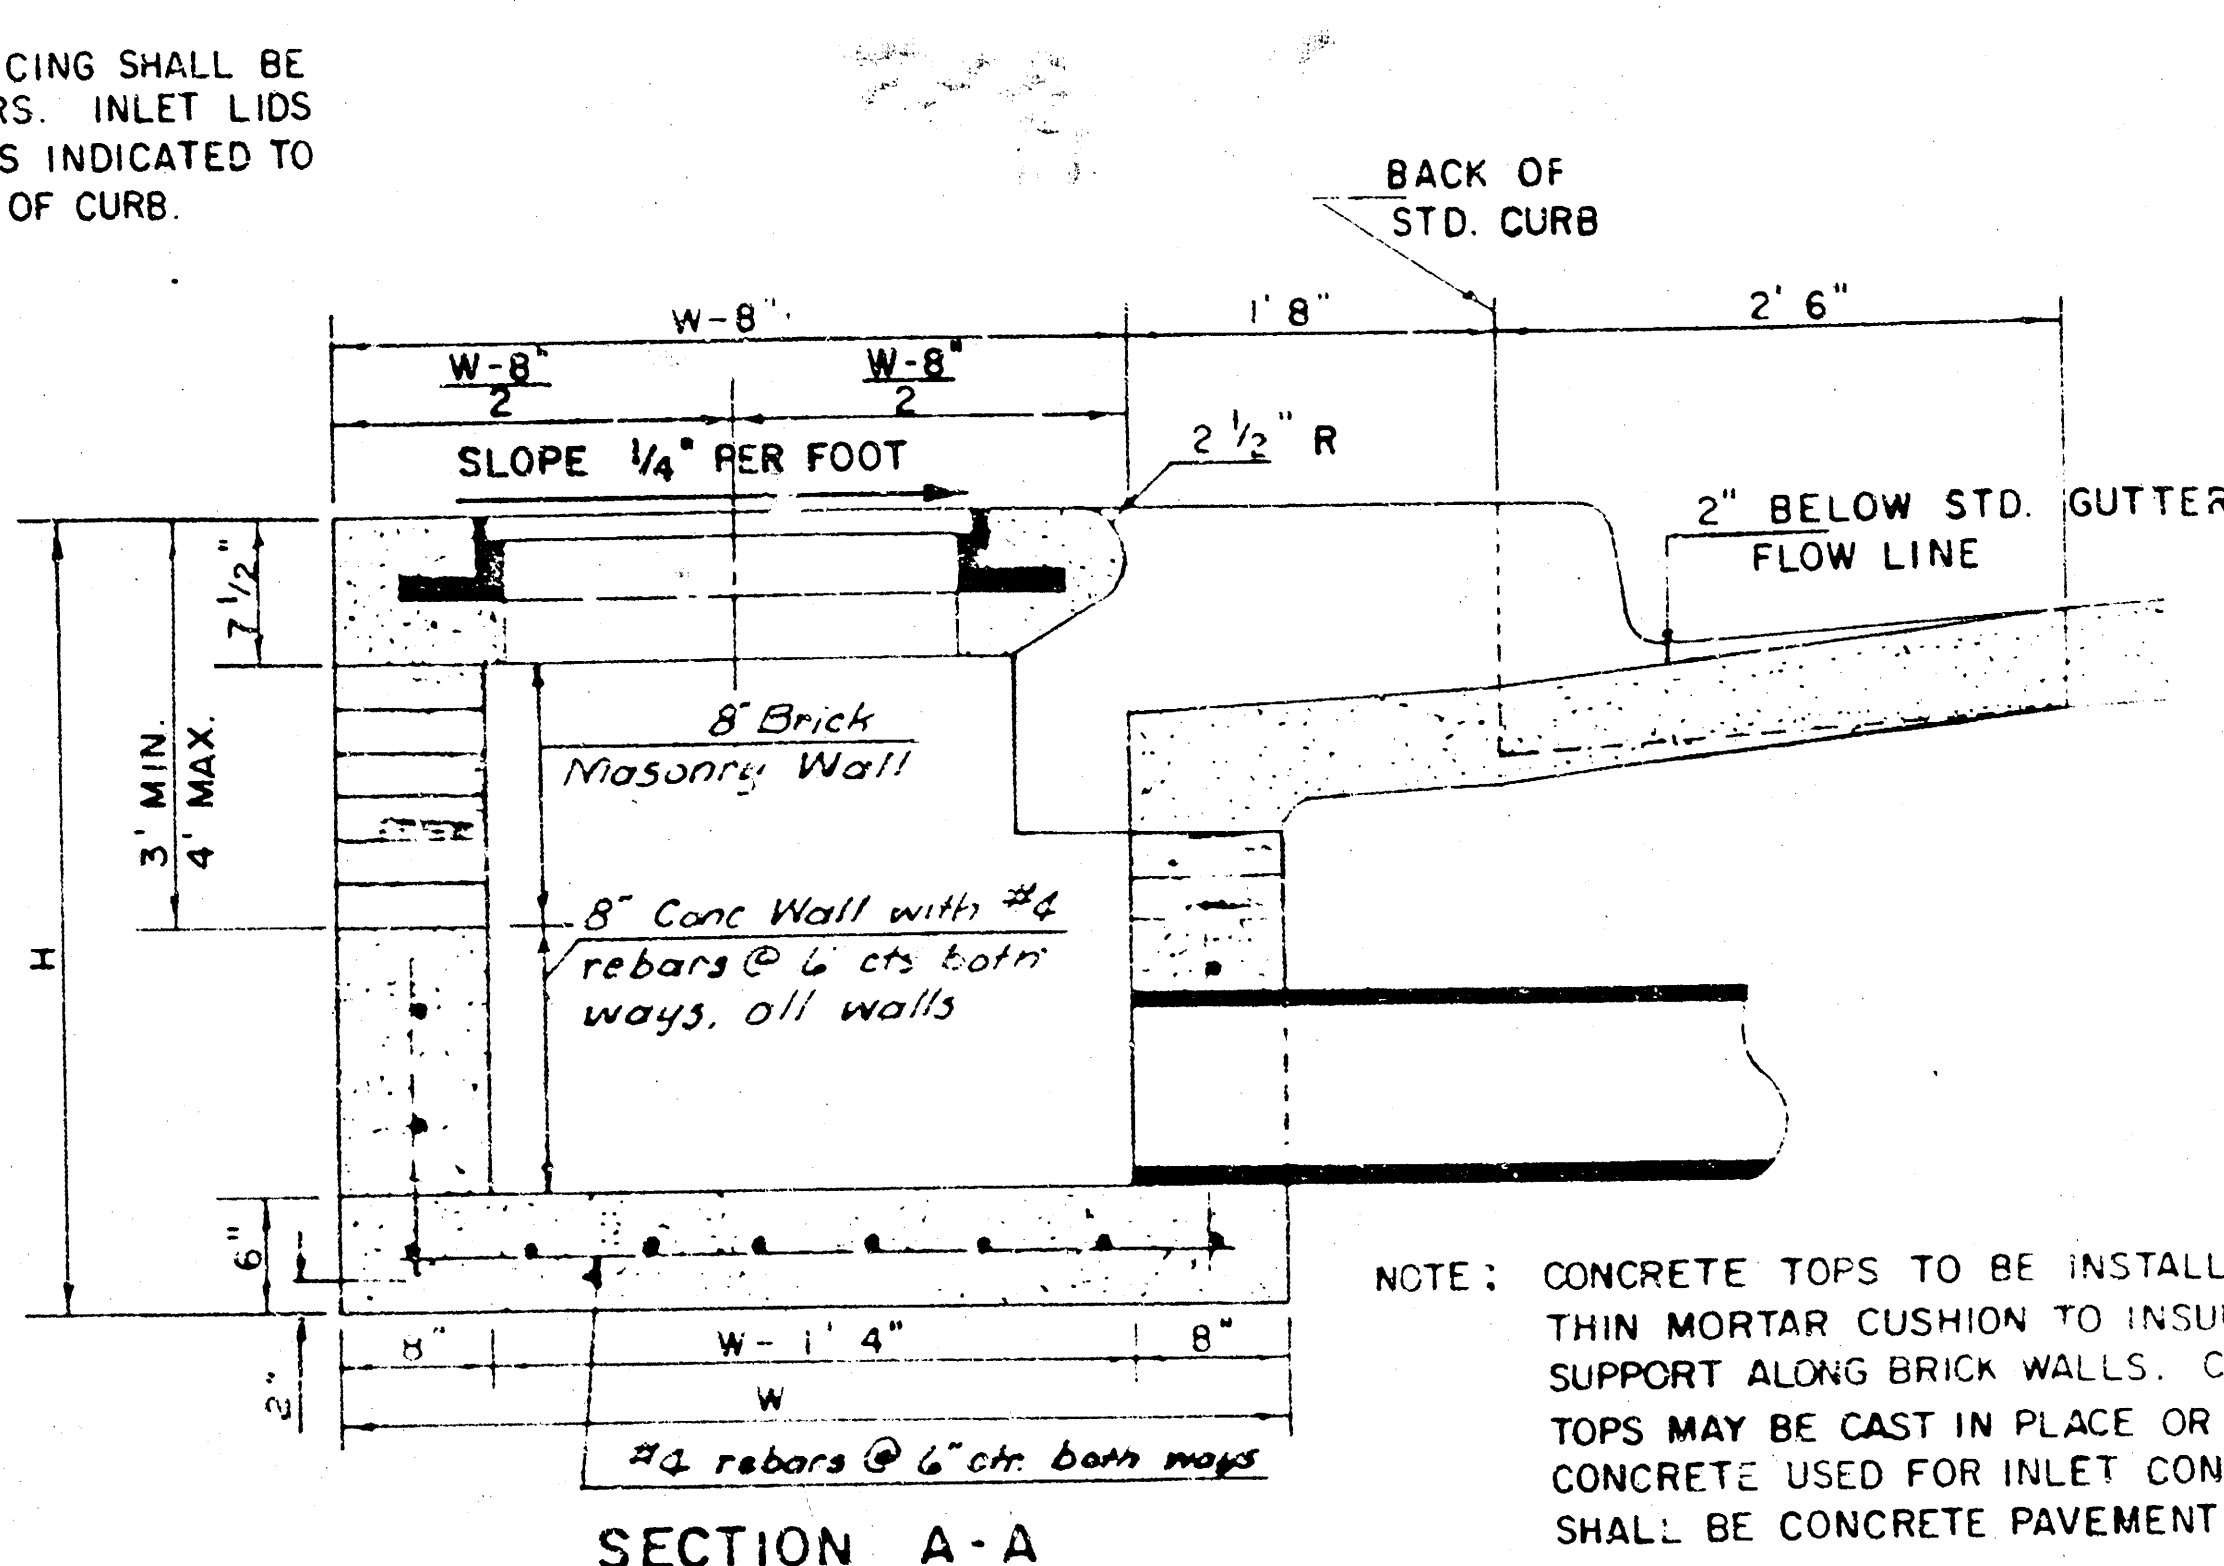


NOTE: CONTRACTOR SHALL HAVE THE OPTION OF CONSTRUCTING 8" BRICK MASONRY WALLS BETWEEN THE CONCRETE INLET BASE AND TOP ON THIS INLET WHEN A = 4'4" AND H = 6'6" OR LESS.

ADDITIONAL CURB AND GUTTER CONSTRUCTION NECESSARY TO CONNECT SET-BACK INLET TO PAVEMENT WILL BE PAID FOR AT THE UNIT PRICE BID FOR EACH INLET HOOKUP.

INLET INVERT SHALL BE SHAPED WITH 8 SACK SAND MIX CONCRETE TO CREATE FLOW CHANNELS AND TO INCREASE HYDRAULIC EFFICIENCY SUCH THAT THE INLET WILL BE SELF CLEANING BETWEEN ALL INLET AND/OR OUTLET PIPES.


NOTE: CONCRETE TOPS TO BE INSTALLED ON THIN MORTAR CUSHION TO INSURE FULL SUPPORT ALONG BRICK WALLS. CONCRETE TOPS MAY BE CAST IN PLACE OR PRECAST. CONCRETE USED FOR INLET CONSTRUCTION SHALL BE CONCRETE PAVEMENT MIX.

SECTION A-A

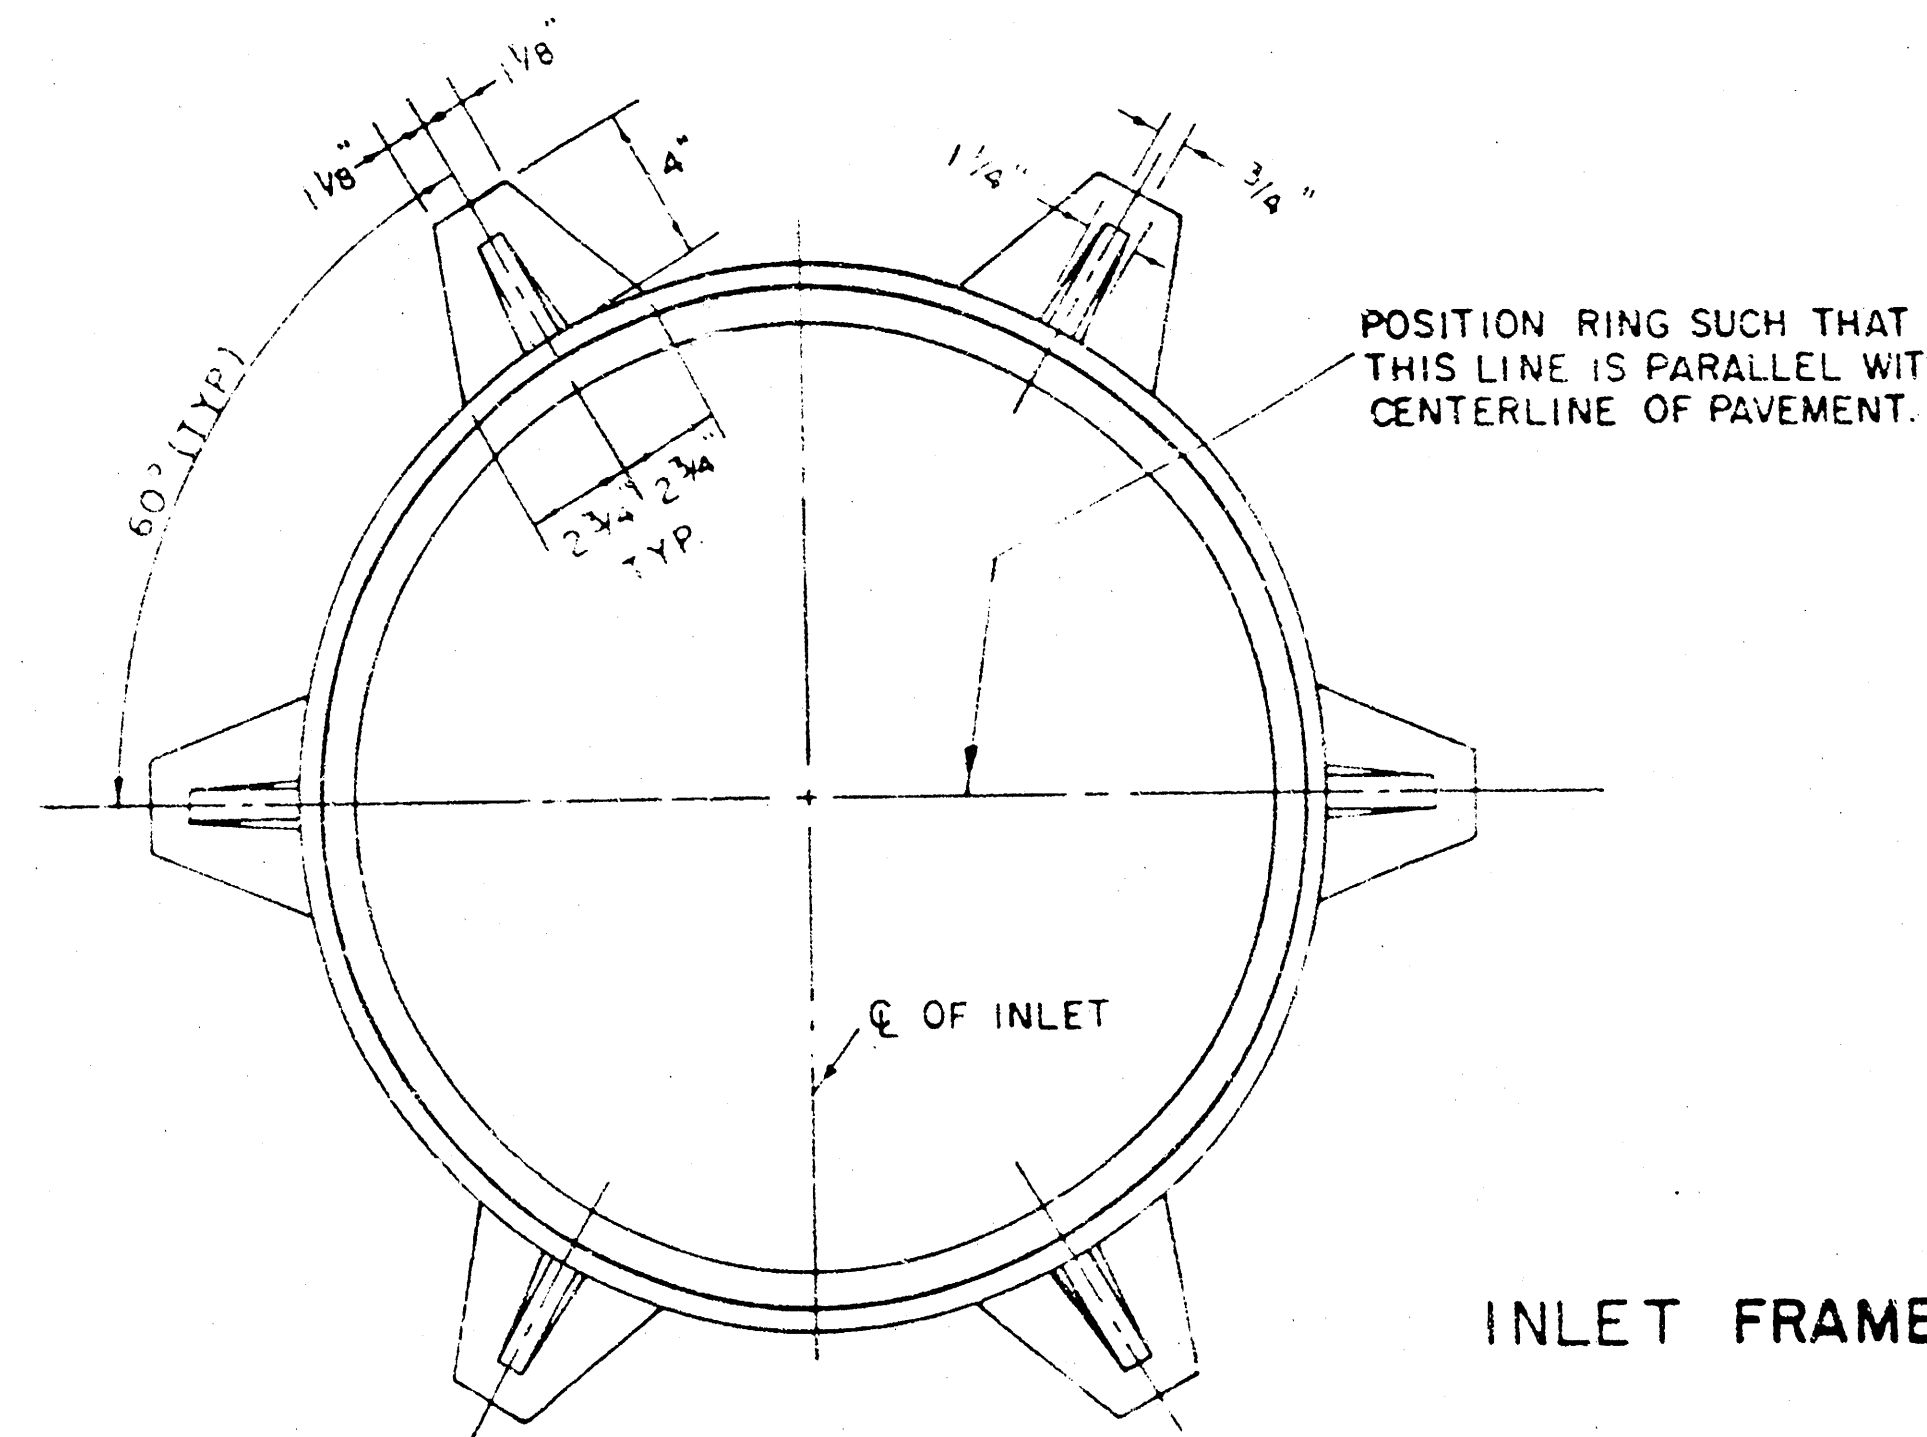


INLET FRAME


WEIGHT = 180 LBS

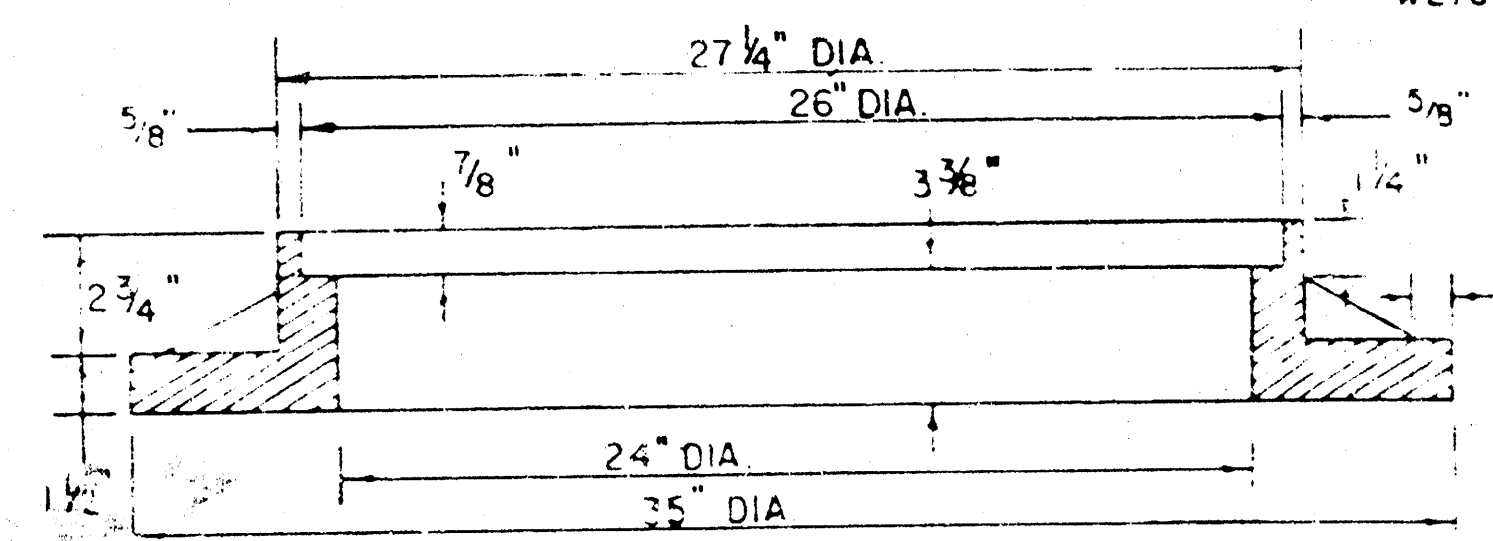

SEE DETAIL OF WICHITA STANDARD MANHOLE FRAME AND COVER DETAIL SHEET FOR COVER DETAILS TO BE USED WITH INLET FRAME.

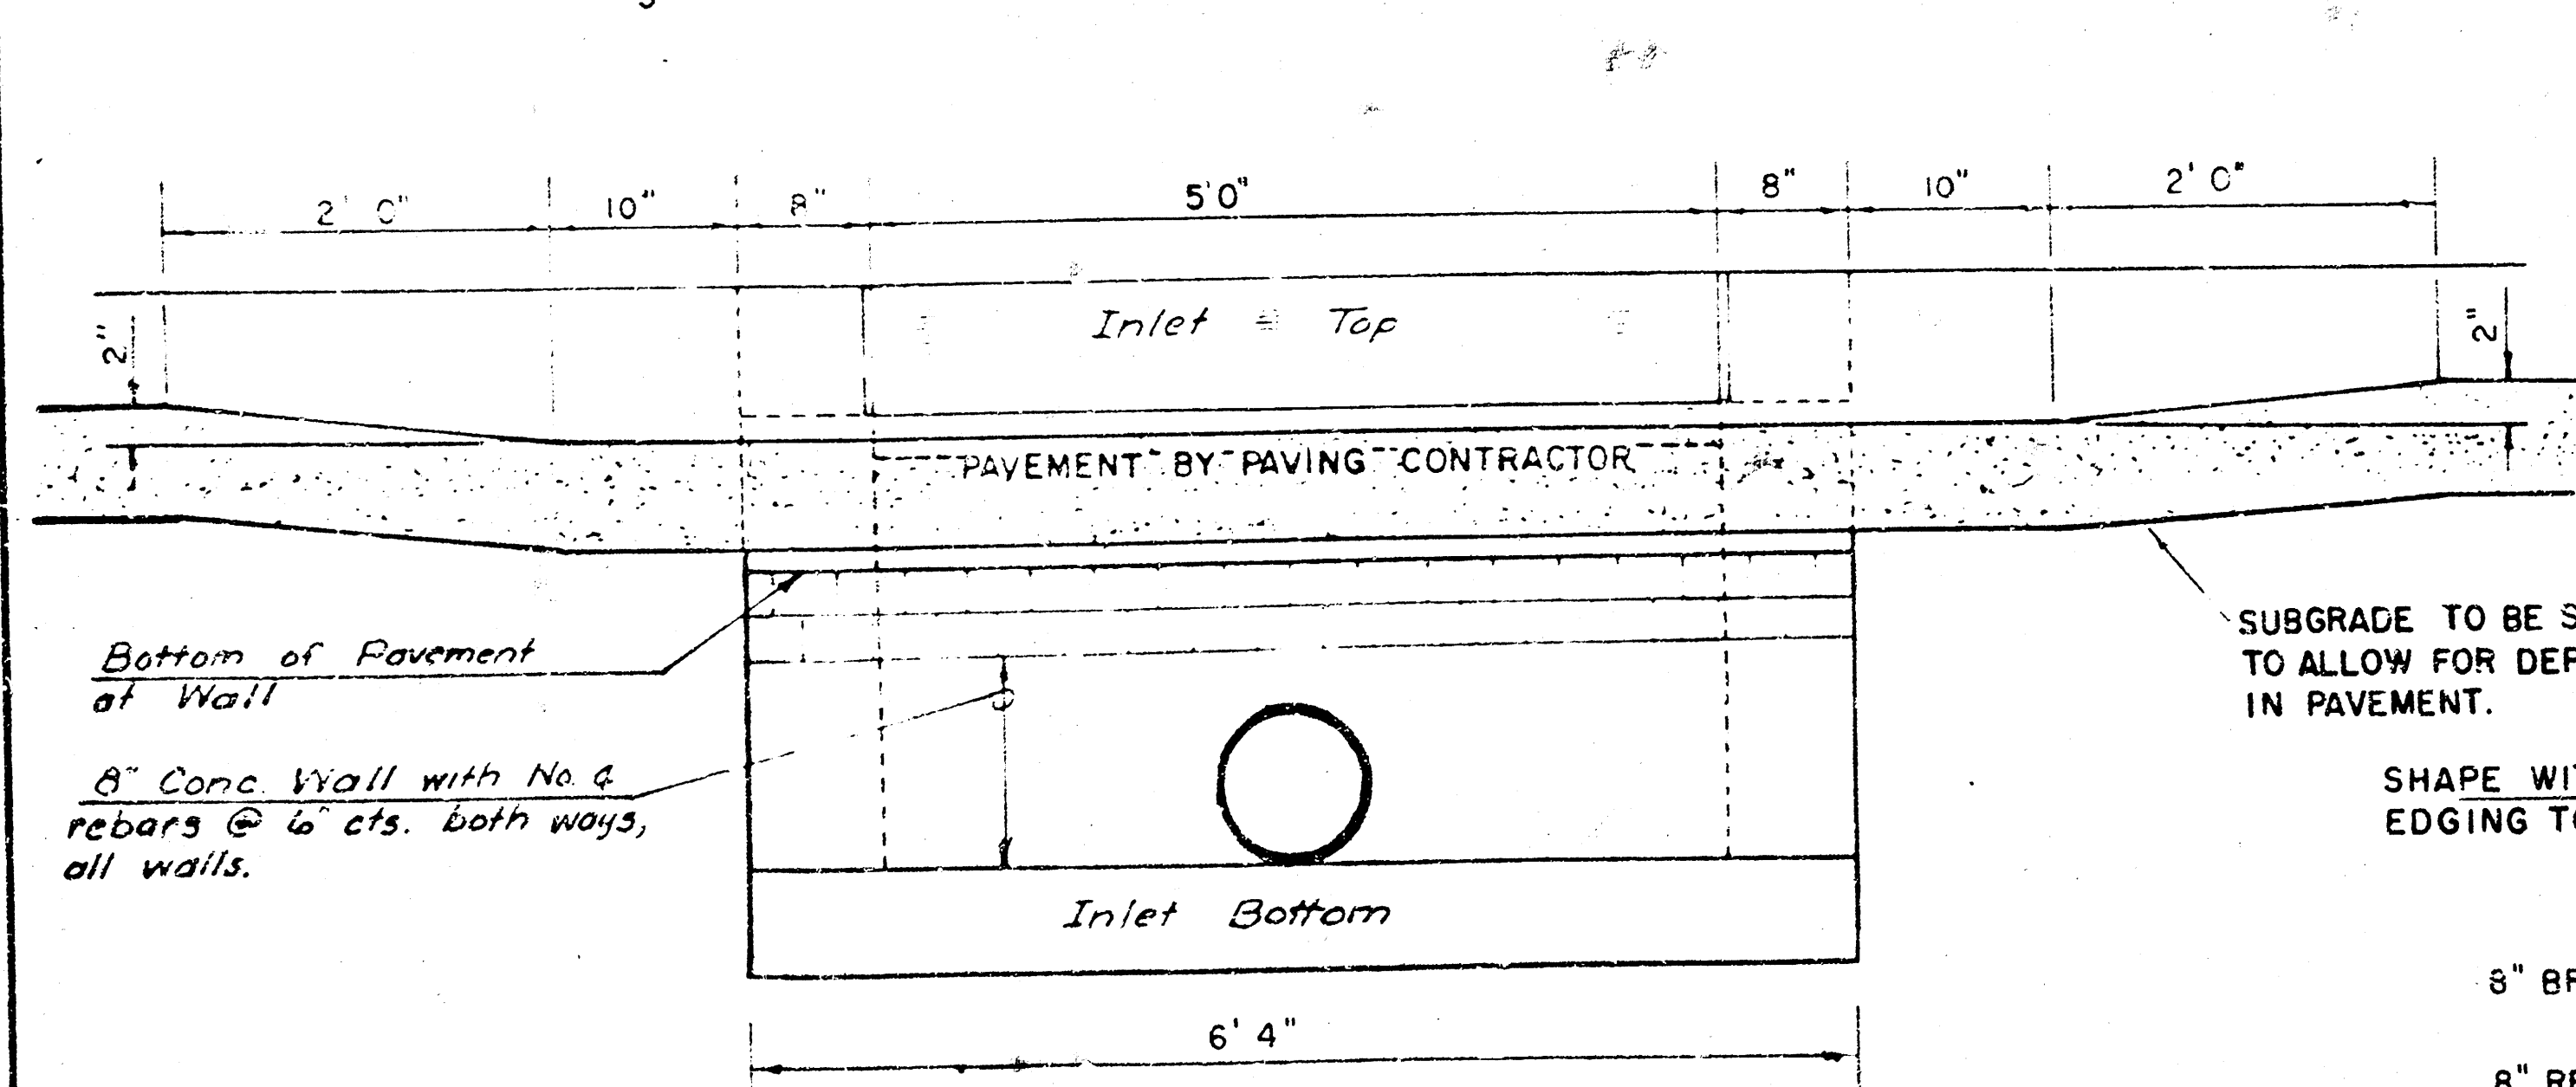

SECTION C-C

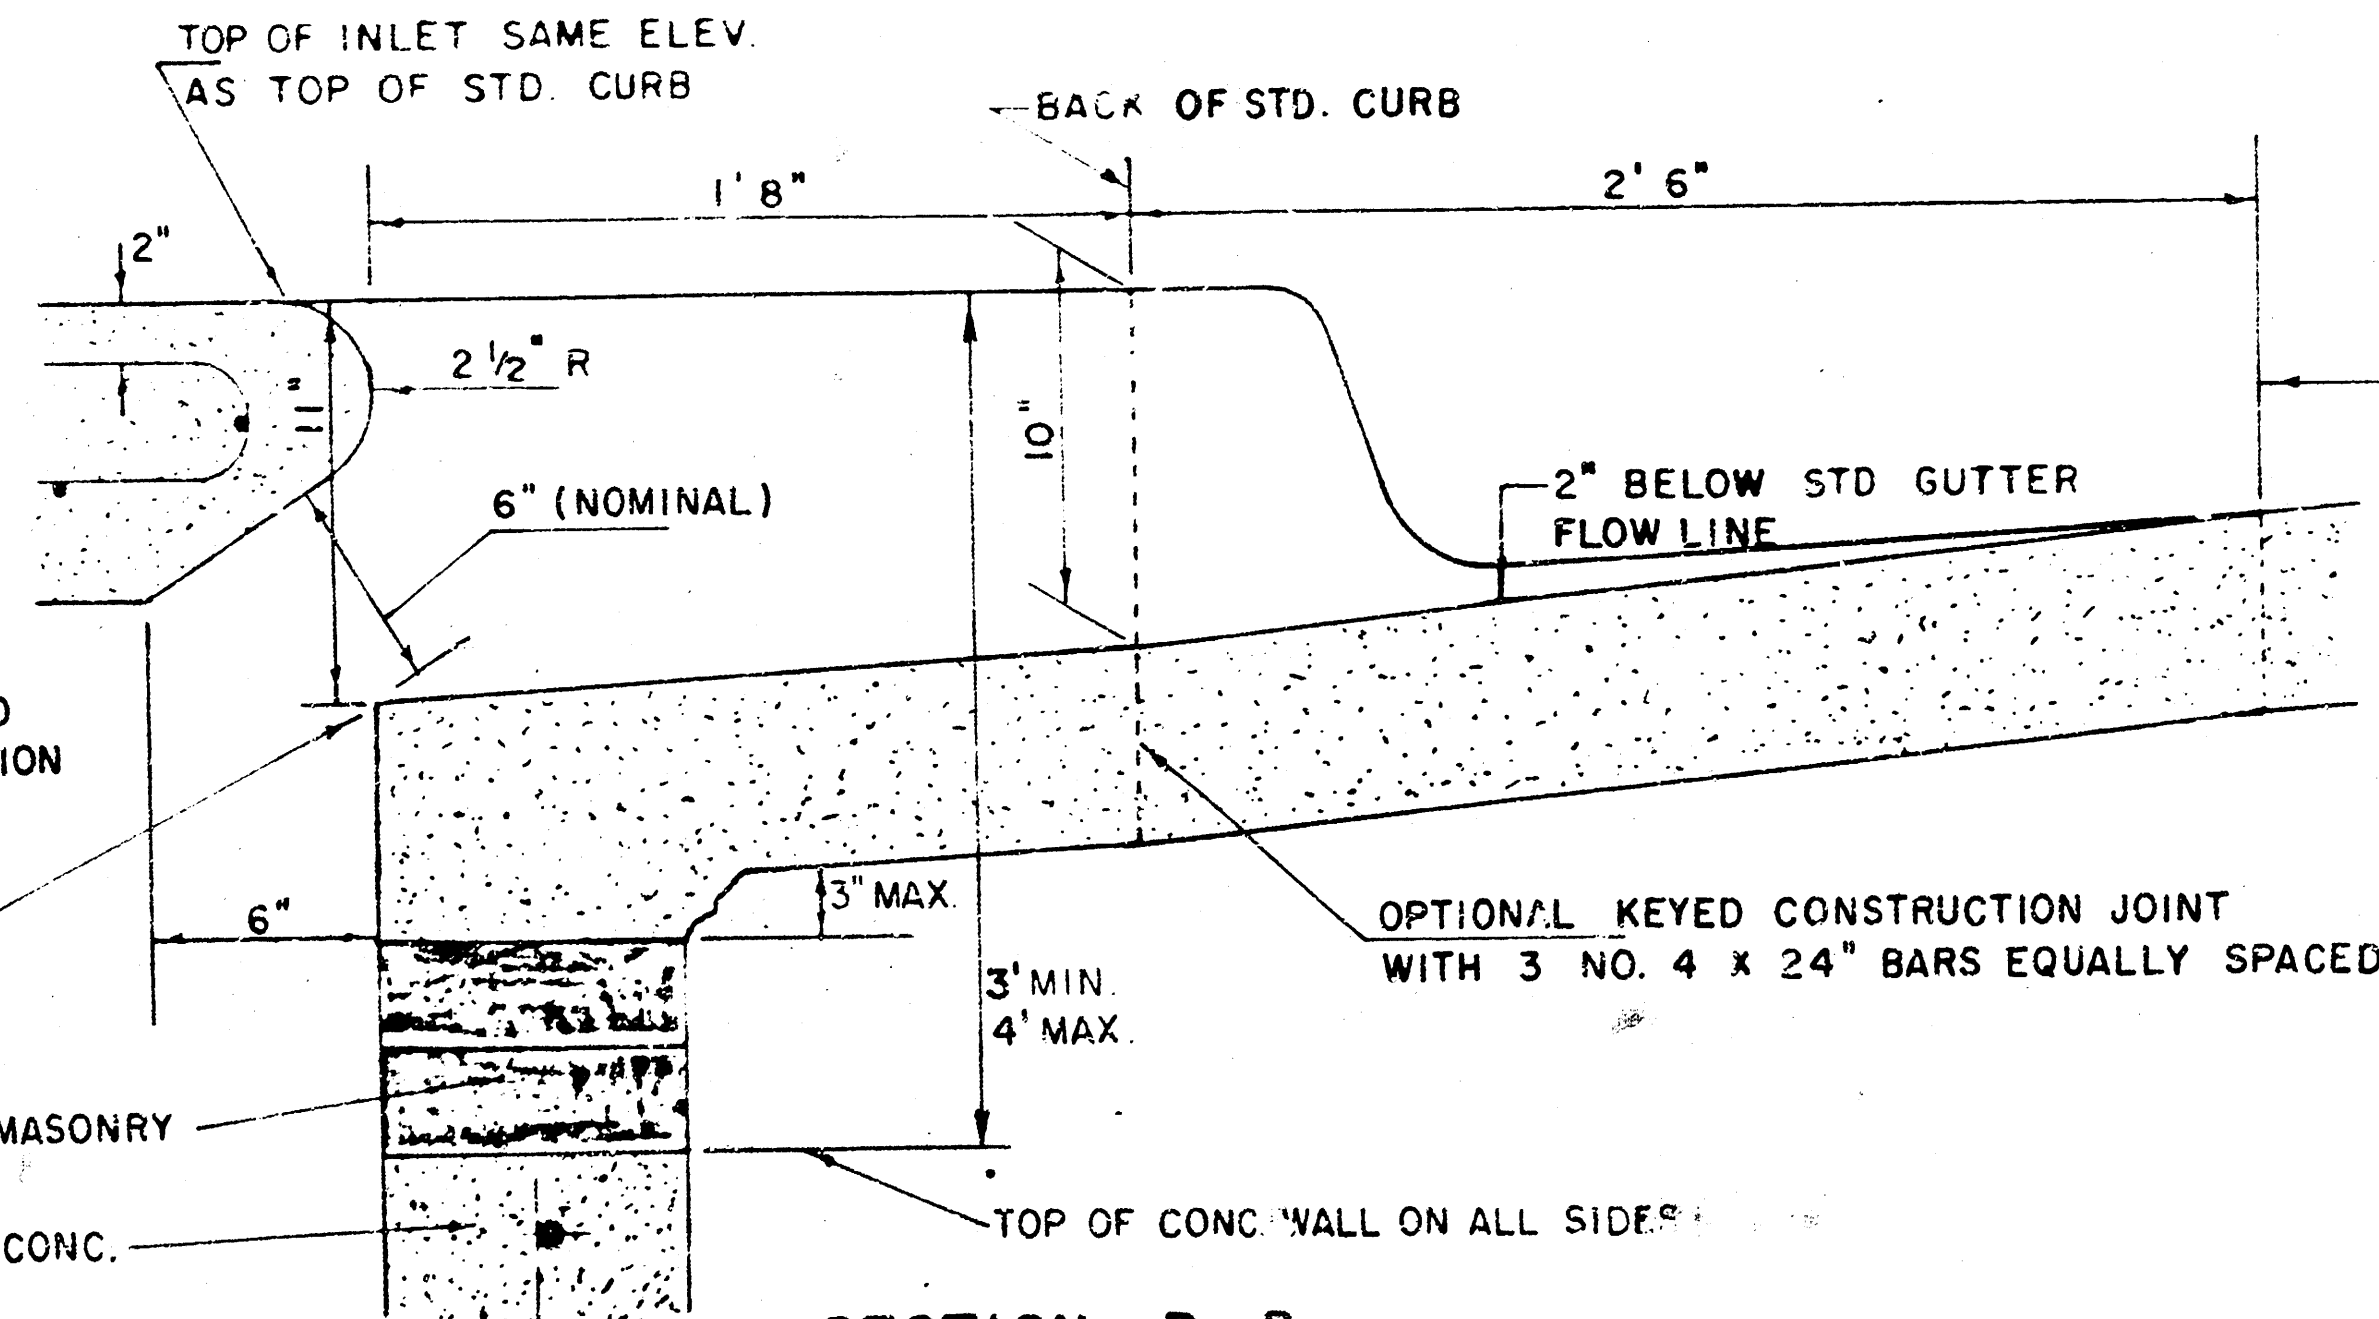

SECTION B-B

LIMITS OF GUTTER SHAPING AND/OR EDGE OF COMB. CURB AND GUTTER

DETAIL STANDARD TYPE 1A CURB INLET

CITY OF WICHITA, KANSAS

INLET OPENING = 6" x 5' 0"

Project no. 472-76-245-81193-000-000-001

JUNE 1984

10/14


SEWER APPURTENANCES DETAILS

ADOPTED AS STANDARD DESIGN
BY


City of Wichita, Kansas

REVISED MAY 1983
REVISED JAN 1983


TYPE "B" MANHOLE

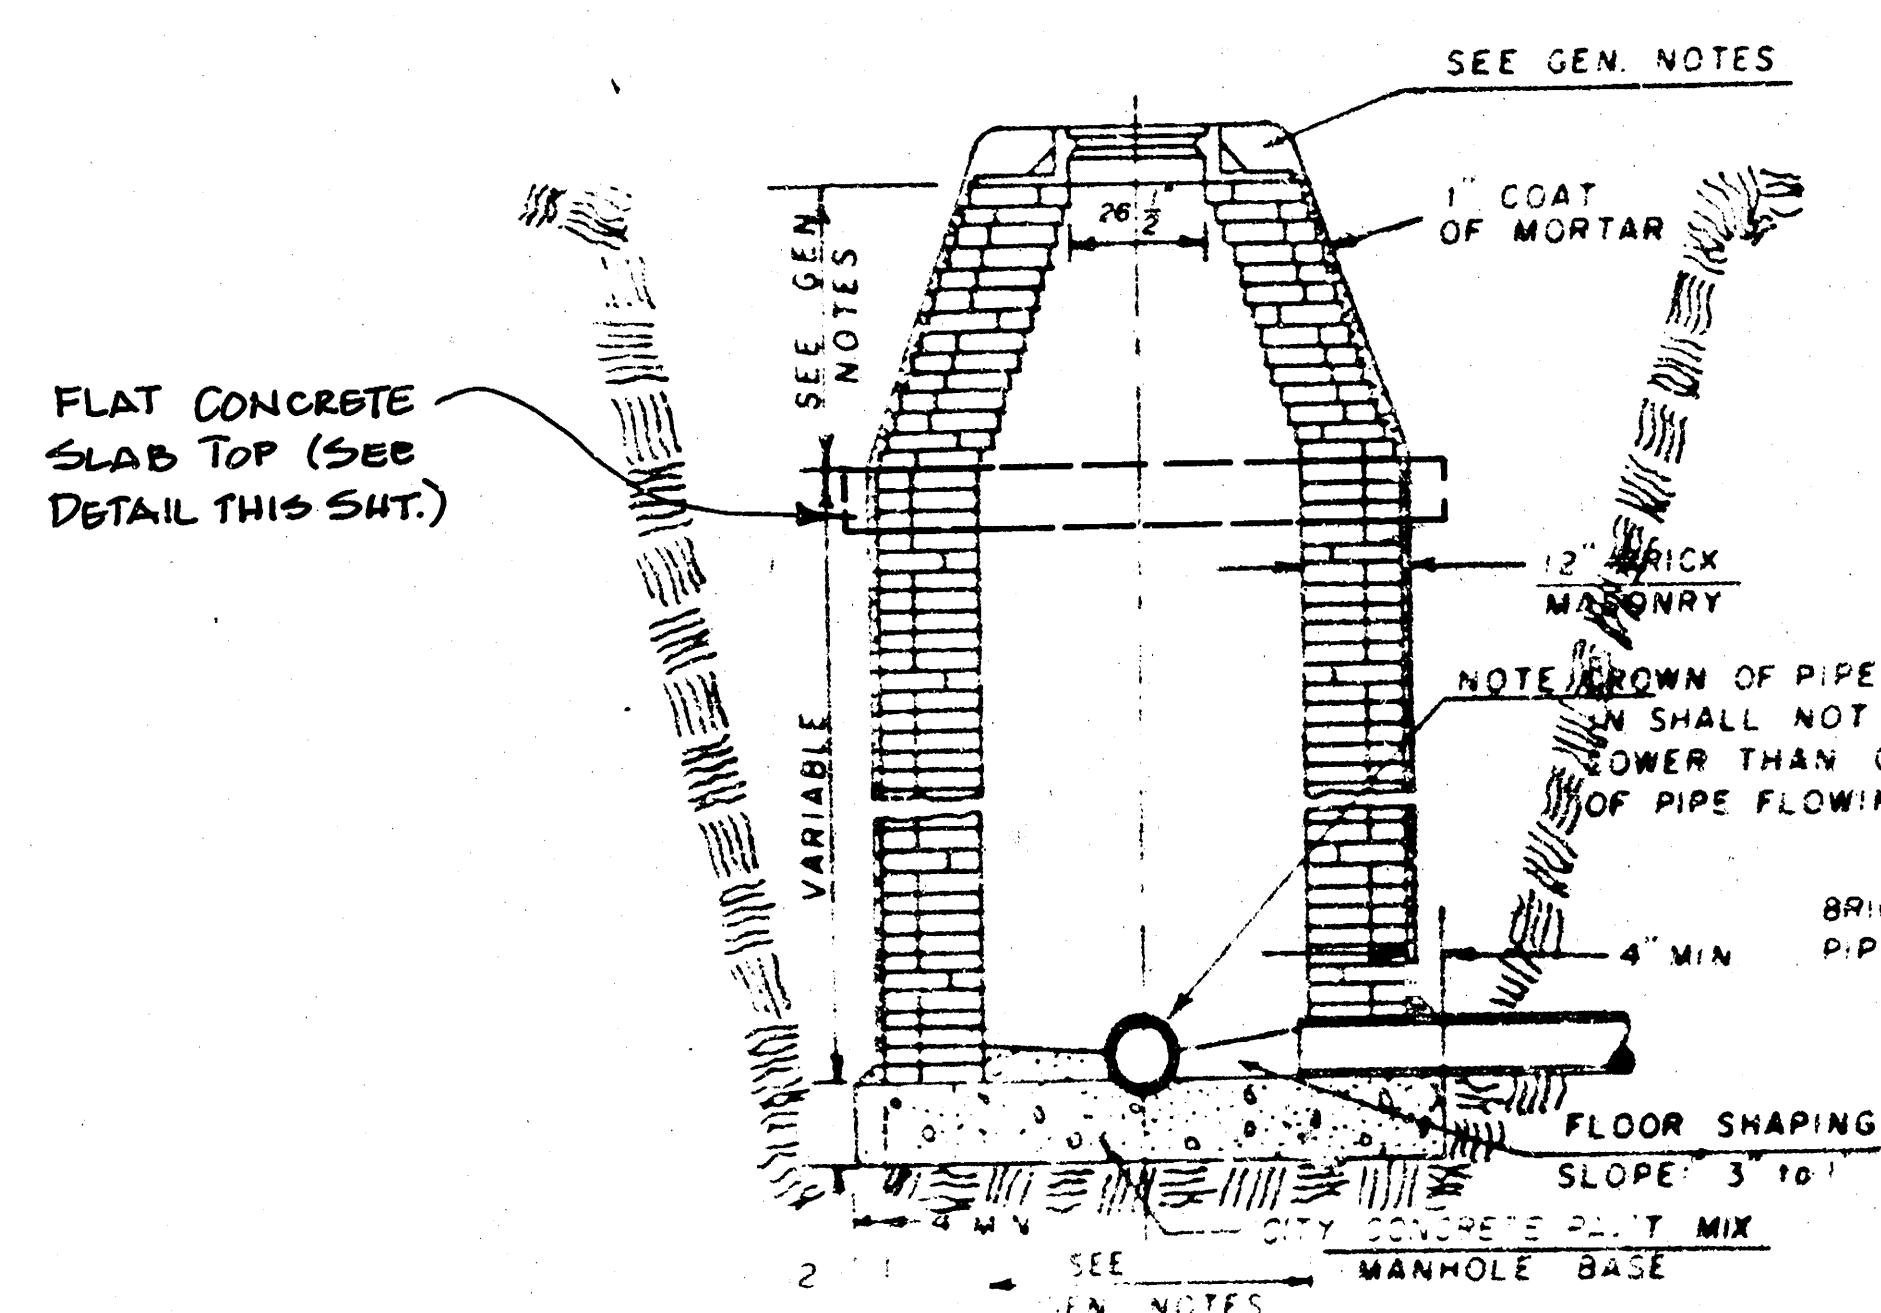


TYPE "B" INSIDE DROP MANHOLE

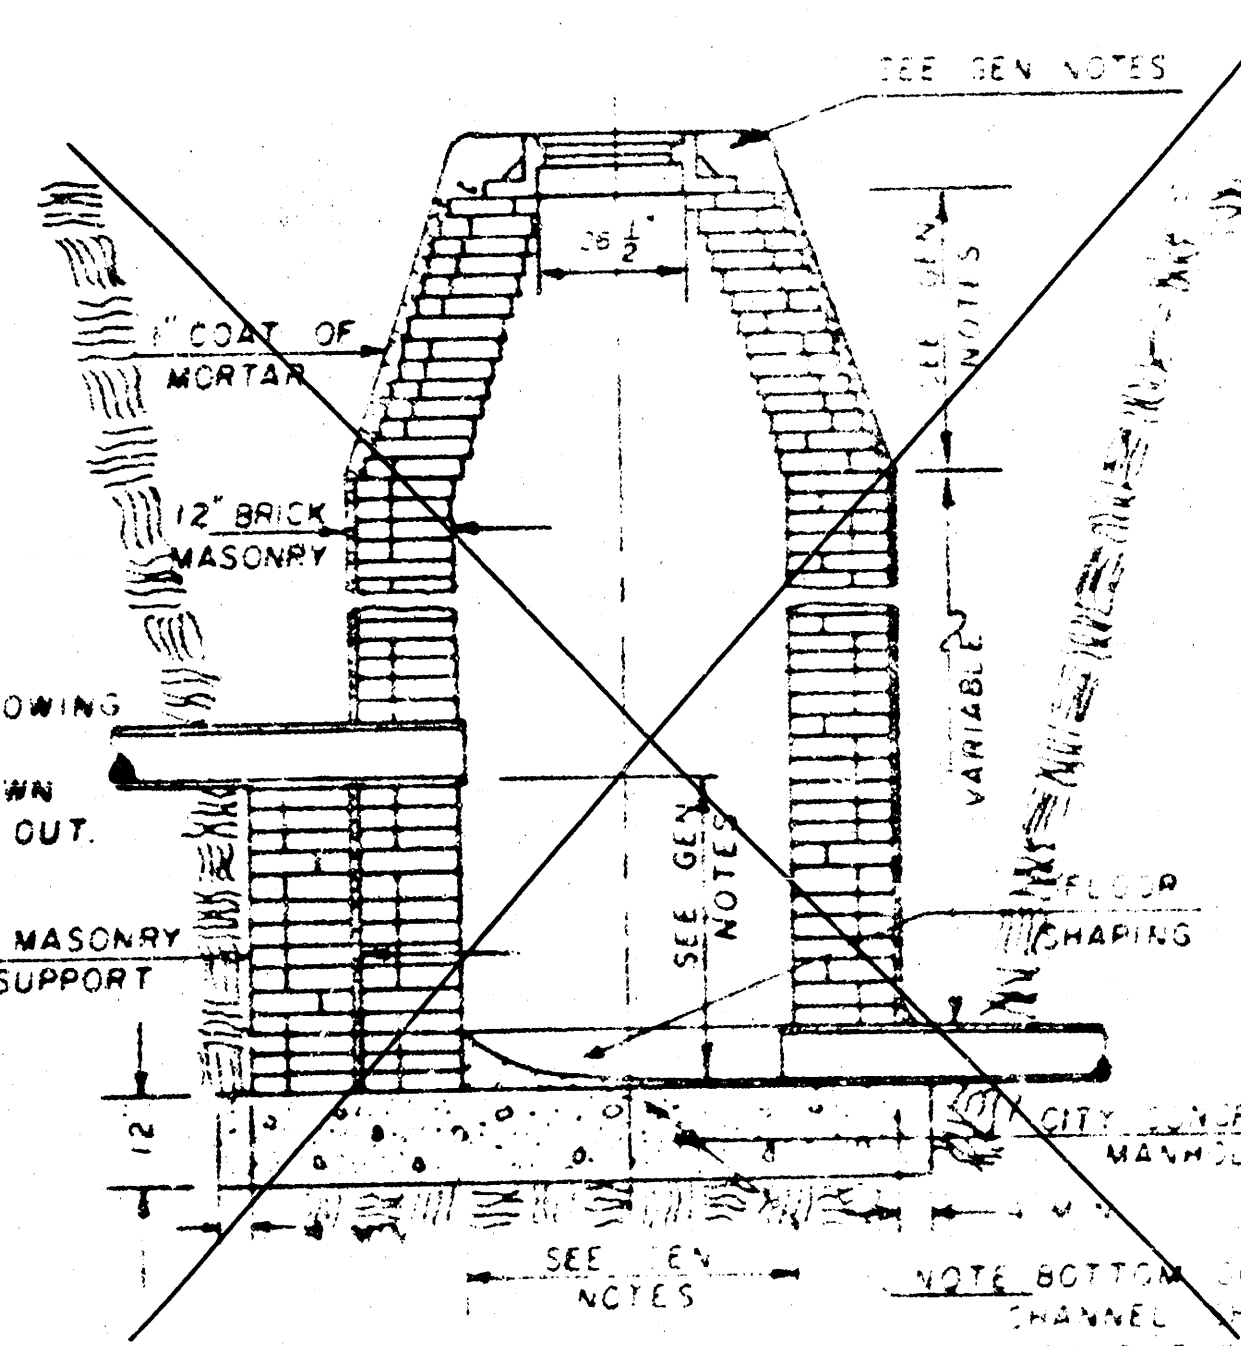

TYPE "B" OUTSIDE DROP MANHOLE

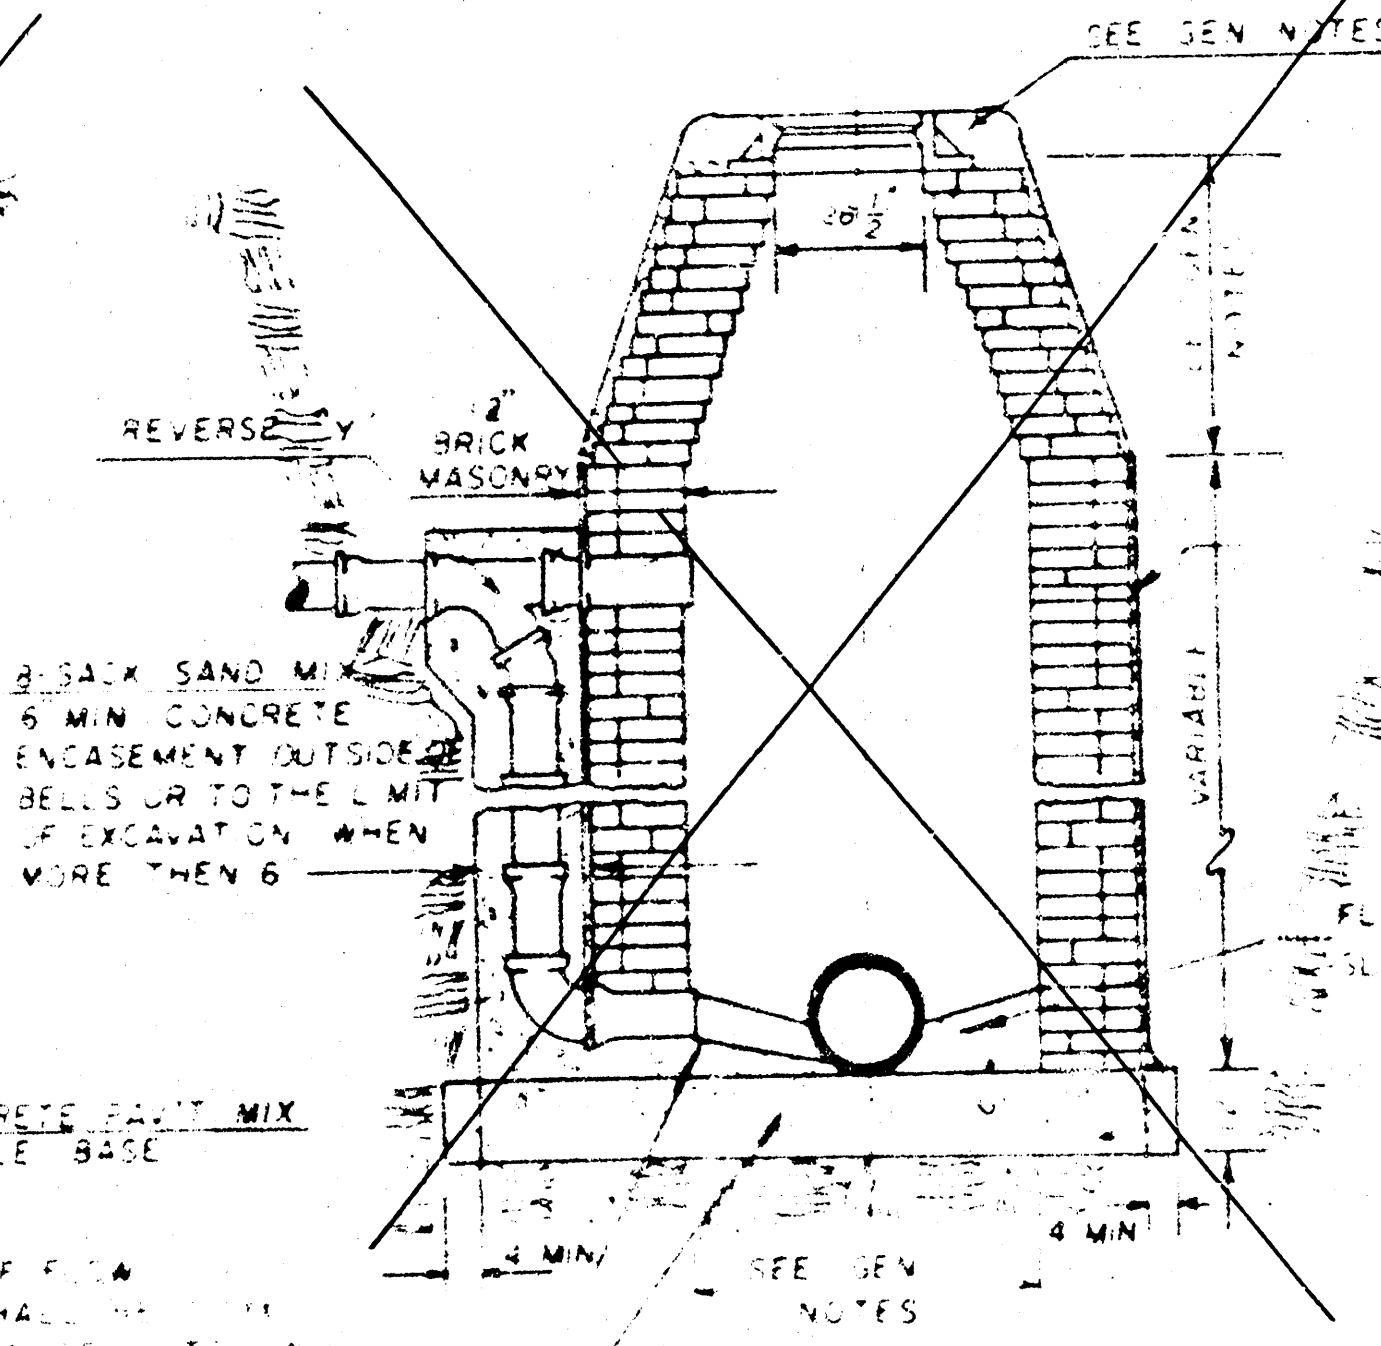


DETAIL OF OUTSIDE DROP
CONSTRUCTED ON EXISTING M-HOLE

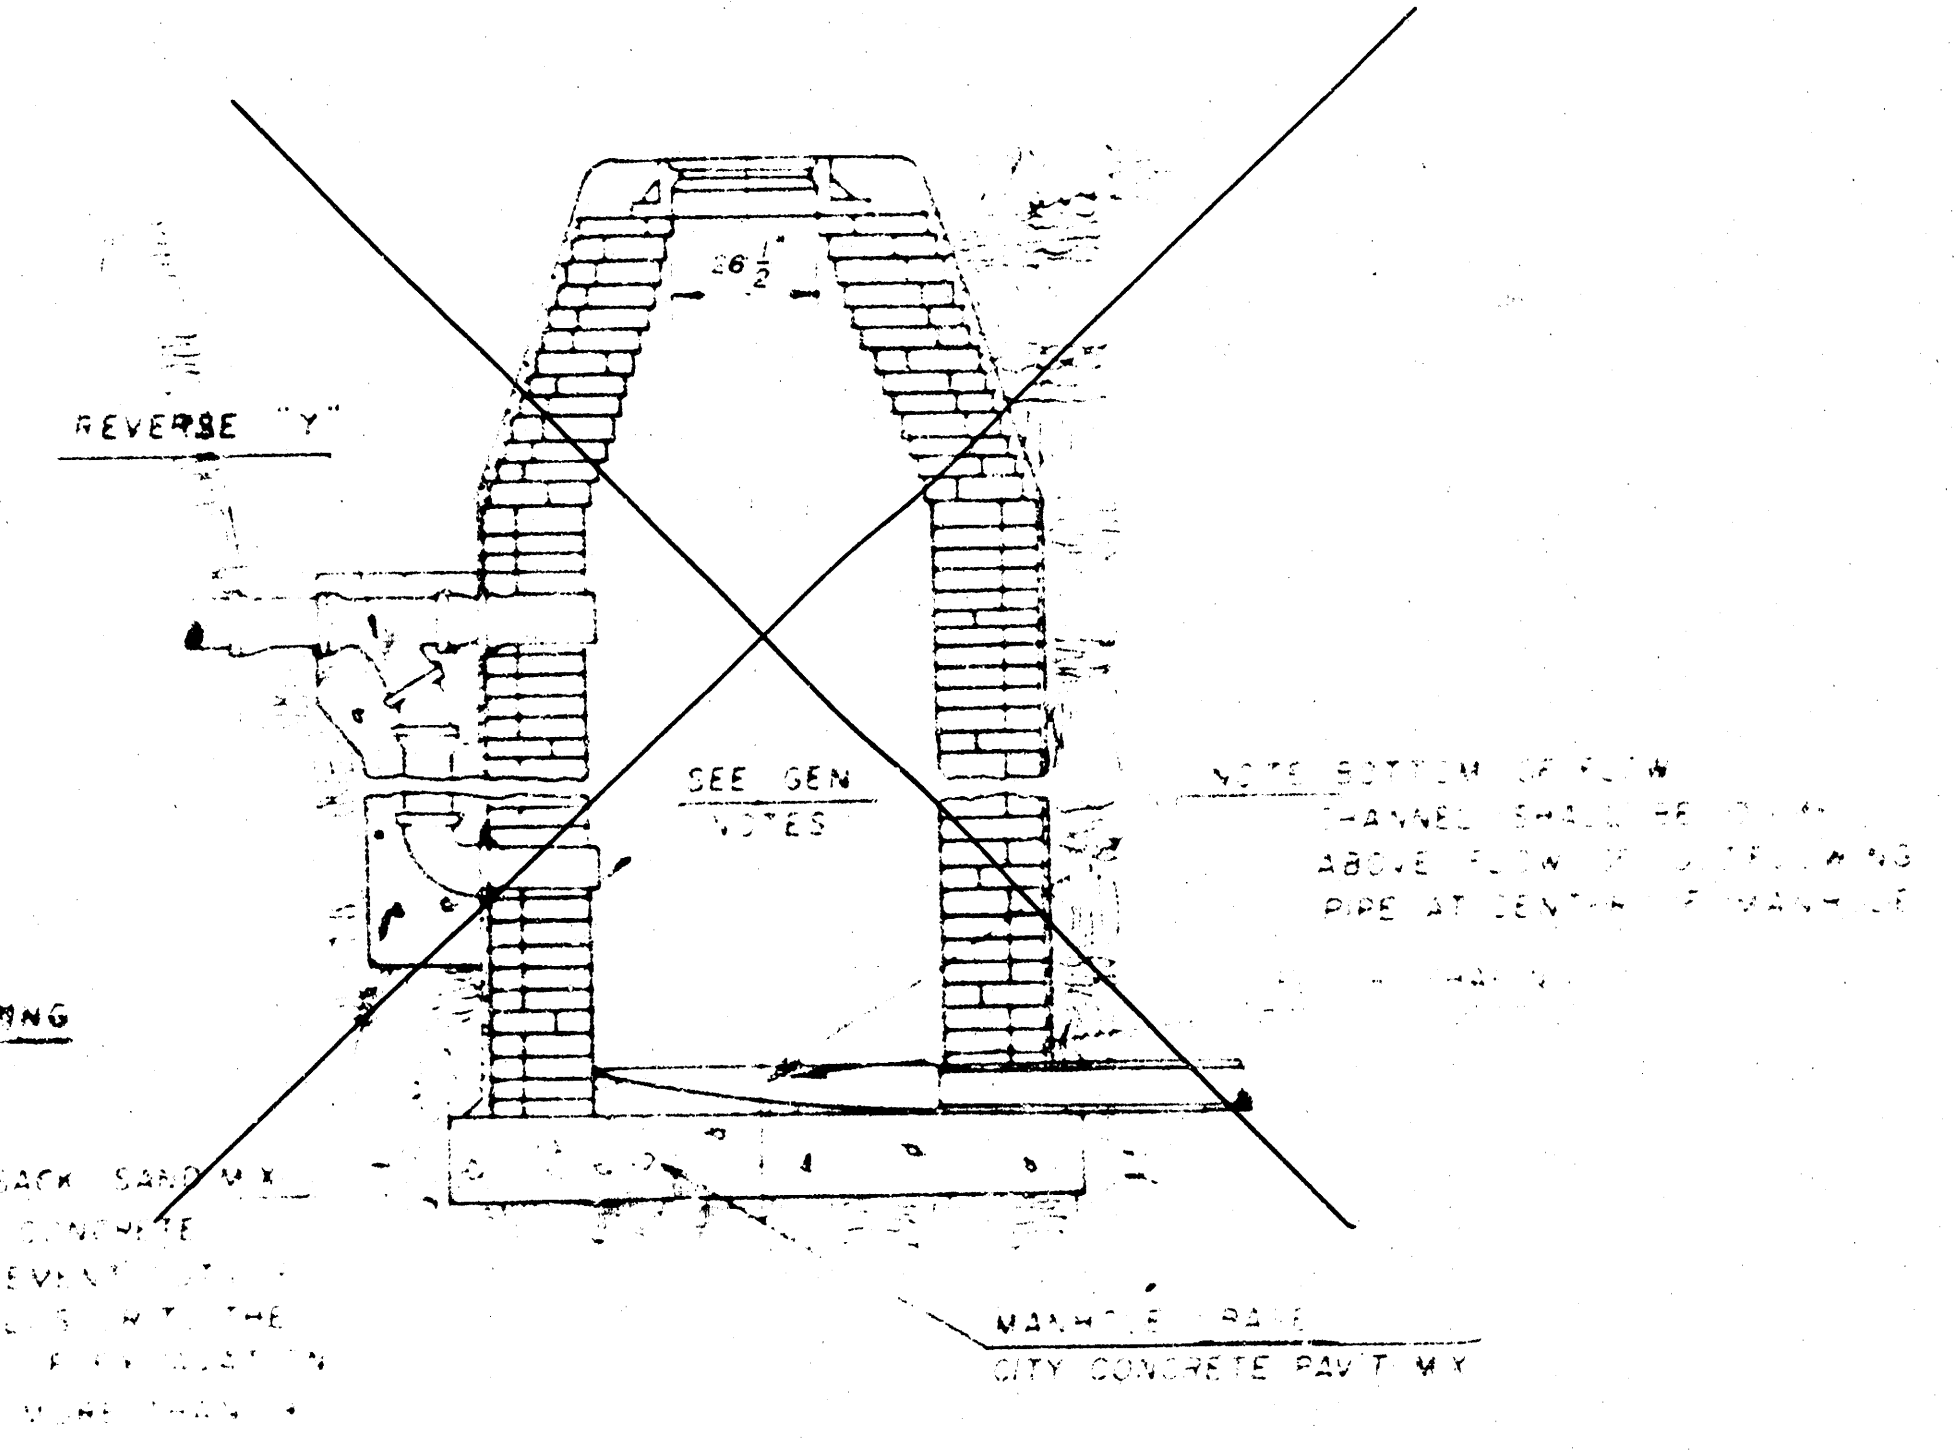


- MORTAR USED IN MASONRY CONSTRUCTION SHALL CONTAIN 3 BAGS OF GROUT PER CUBIC YARD. CONCRETE USED IN MANHOLE BASES SHALL CONFORM TO THE REQUIREMENTS OF CONCRETE FOR CONCRETE PAVEMENT CONSTRUCTION AS SPECIFIED IN THE CITY STANDARD PAVING SPECIFICATIONS USING CITY CONCRETE PAVEMENT MIX WITHOUT AIR ENTRAINING ADMIXTURE. MORTAR SHALL BE PLACED AROUND THE MANHOLE RING AS SHOWN ON THE DRAWINGS WHEN MANHOLES ARE CONSTRUCTED IN UNPAVED AREAS. TYPE "B" MANHOLES CAN BE USED ON AREAS HAVING DEPTHS GREATER THAN 10' OR WHEN THE MANHOLE IS LOCATED IN PUBLIC STREET PAVEMENT. MANHOLES CONSTRUCTED WHERE PIPE SIZES ARE SMALLER THAN 24" SHALL HAVE AN INSIDE DIAMETER OF 4'. MANHOLES CONSTRUCTED WHERE PIPE SIZES ARE 24" OR LARGER SHALL HAVE AN INSIDE DIAMETER OF 5'. THE HEIGHT OF THE CORNER ON 4' DIAMETER MANHOLES SHALL BE 4'. MANHOLES HAVING A DIAMETER OF 5' SHALL HAVE CORNERS 5' IN HEIGHT. COMPLETED MANHOLE SHALL BE WITHOUT LEAKS AND WATER TIGHT.
- REINFORCING STEEL SHALL BE INSTALLED IN THE MANHOLE BASES AND SHALL CONSIST OF NO. 4 BARS PLACED ON 6" CENTERS IN BOTH DIRECTIONS. THE MANHOLE BASE REINFORCEMENT SHALL BE PLACED 4" ABOVE THE BOTTOM OF THE MANHOLE BASE. ALL COSTS FOR FURNISHING AND INSTALLING REINFORCING STEEL SHALL BE INCLUDED IN THE UNIT PRICE BID FOR THE MANHOLE.
- OPENINGS SHALL BE CUT INTO THE MANHOLE WALL WHEN OUTSIDE DROPS ARE CONSTRUCTED ON EXISTING MANHOLES. SUCH OPENINGS CUT INTO EXISTING MANHOLES SHALL BE AS SMALL AS PRACTICAL TO FACILITATE INSTALLATION AND SHOOTING THE NEW PIPE IN PLACE. WATERSTOP WAGERS SHALL BE USED WITH P.V.C. AND A.B.S. COMPOSITE PIPE. THE NEW PIPE SHALL BE GRADED TO THE OPENING USING AN APPROVED NONSHRINK GROUT FOR THE FULL MANHOLE WALL THICKNESS. THE EXTERIOR OF THE COMPLETED CONNECTION SHALL BE SEALED WITH AN APPROVED BITUMINOUS COATING FROM THE EXTERIOR. THE FLOW CHANNEL FOR THE NEW CONNECTION AS INDICATED ON THE DRAWINGS. THE VERTICAL DROP FROM THE LOWER PIPE ON SUCH OUTSIDE DROP CONNECTIONS SHALL NOT EXCEED 4' FOR INFLOWING PIPES SIZED 18" OR LARGER AND 2' FOR INFLOWING PIPES SIZED SMALLER THAN 18". EXCEPT THE SLOPE OF THE LOWER PIPE SHALL NEVER BE SET BELOW THE SLOPE OF ANY EXISTING INFLOWING PIPE. THIS WORK, INCLUDING MODIFICATION OF MANHOLE BASES, SHALL BE PAID FOR AT THE UNIT PRICE BID FOR OUTSIDE DROP WHEN CONSTRUCTED ON EXISTING MANHOLE.


- THE FLOORS OF ALL MANHOLES SHALL BE SHAPED WITH FLOW CHANNELS SUCH THAT THE MANHOLES WILL BE SELF-CLEANING AND FREE OF AREAS WHERE DEBRIS COULD BE DEPOSITED AS SEWAGE FLOWS THROUGH THE MANHOLE FROM THE INLET PIPES TO THE OUTLET PIPES. FLOW CHANNELS SHALL BE FORMED TO MATCH THE BOTTOM HALVES OF THE INFLOWING PIPES AND THE OUTFLOWING PIPES AS SHOWN BY THE DRAWINGS EXCEPT FOR INSIDE DROP MANHOLES. FLOW CHANNELS FOR INSIDE DROP MANHOLES SHALL BE CONSTRUCTED AS INDICATED BY THE DRAWINGS. MANHOLE FLOORS SHALL HAVE SLOPES OF 1/8" PER FOOT IN THE AREAS OUTSIDE OF THE FLOW CHANNELS SLOPED TOWARD THE FLOW CHANNELS. PIPES LAYED THROUGH MANHOLES SHALL HAVE THE TOP HALF REINFORCED WITH REBAR FOR THE FULL INSIDE DIAMETER OF THE MANHOLE. MANHOLE FLOORS SHALL THEN BE GRADED AROUND THE BOTTOM HALF OF THE PIPE WHICH FORMS THE FLOW CHANNEL.
- PILES INSTALLED WITHIN THE EXCAVATION BASE FOR THE MANHOLE SHALL BE LOCATED WITHIN CONCRETE TO THE LEVELS OF THE MANHOLE EXCAVATION. WHEN CLAY PILES ARE USED, THE GRADE SHALL BE AT THE FIRST POINT WITHIN THE MANHOLE. THE MANHOLE SHALL BE LOCATED AT THE BASE OF THE PILE. IN A MANHOLE 4' OR 5' IN DIAMETER, THE FLOORING OF THE BASE OF THE MANHOLE SHALL BE LOCATED AT THE BASE OF THE PILE. IN A MANHOLE 4' OR 5' IN DIAMETER, THE FLOORING OF THE BASE OF THE MANHOLE SHALL BE LOCATED AT THE BASE OF THE PILE.
- SEWER, DRAIN, CATCHING AND MANHOLE FRAME MATERIALS SHALL BE AS TO THE REQUIREMENTS AS SPECIFIED IN THE DRAWINGS AND SHALL BE PAID FOR IN THE UNIT PRICE BID FOR THE MANHOLE.
- THE VERTICAL DROP IN OUTSIDE DROP MANHOLES SHALL NOT EXCEED 4' FOR INFLOWING PIPES SIZED 18" OR LARGER AND 2' FOR INFLOWING PIPES SIZED SMALLER THAN 18". EXCEPT THE SLOPE OF THE LOWER PIPE SHALL NEVER BE SET BELOW THE SLOPE OF ANY EXISTING INFLOWING PIPE. THIS WORK, INCLUDING MODIFICATION OF MANHOLE BASES, SHALL BE PAID FOR AT THE UNIT PRICE BID FOR OUTSIDE DROP WHEN CONSTRUCTED ON EXISTING MANHOLE.
- SEWER, DRAIN, CATCHING AND MANHOLE FRAME MATERIALS SHALL BE AS TO THE REQUIREMENTS AS SPECIFIED IN THE DRAWINGS AND SHALL BE PAID FOR IN THE UNIT PRICE BID FOR THE MANHOLE.

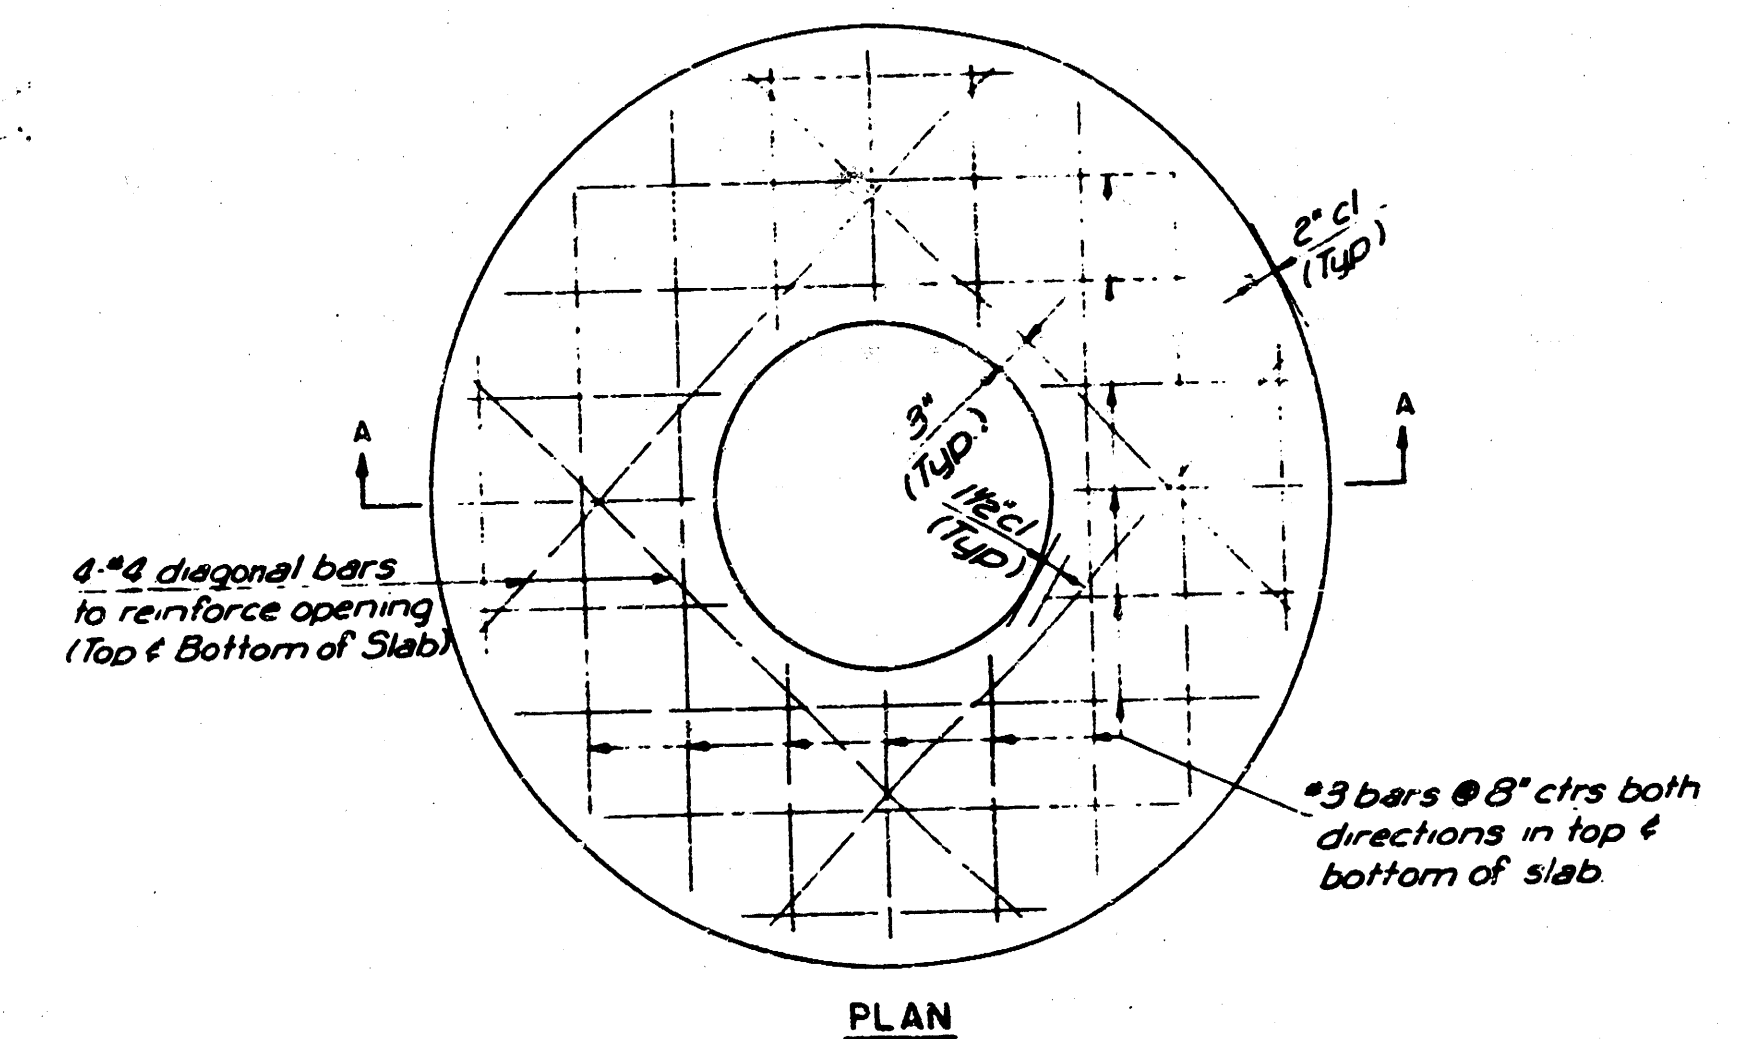



NOTE: CONSTRUCT BRICK COLLAR ON TOP OF SLAB UNDER RING, MIN. THICKNESS 6"

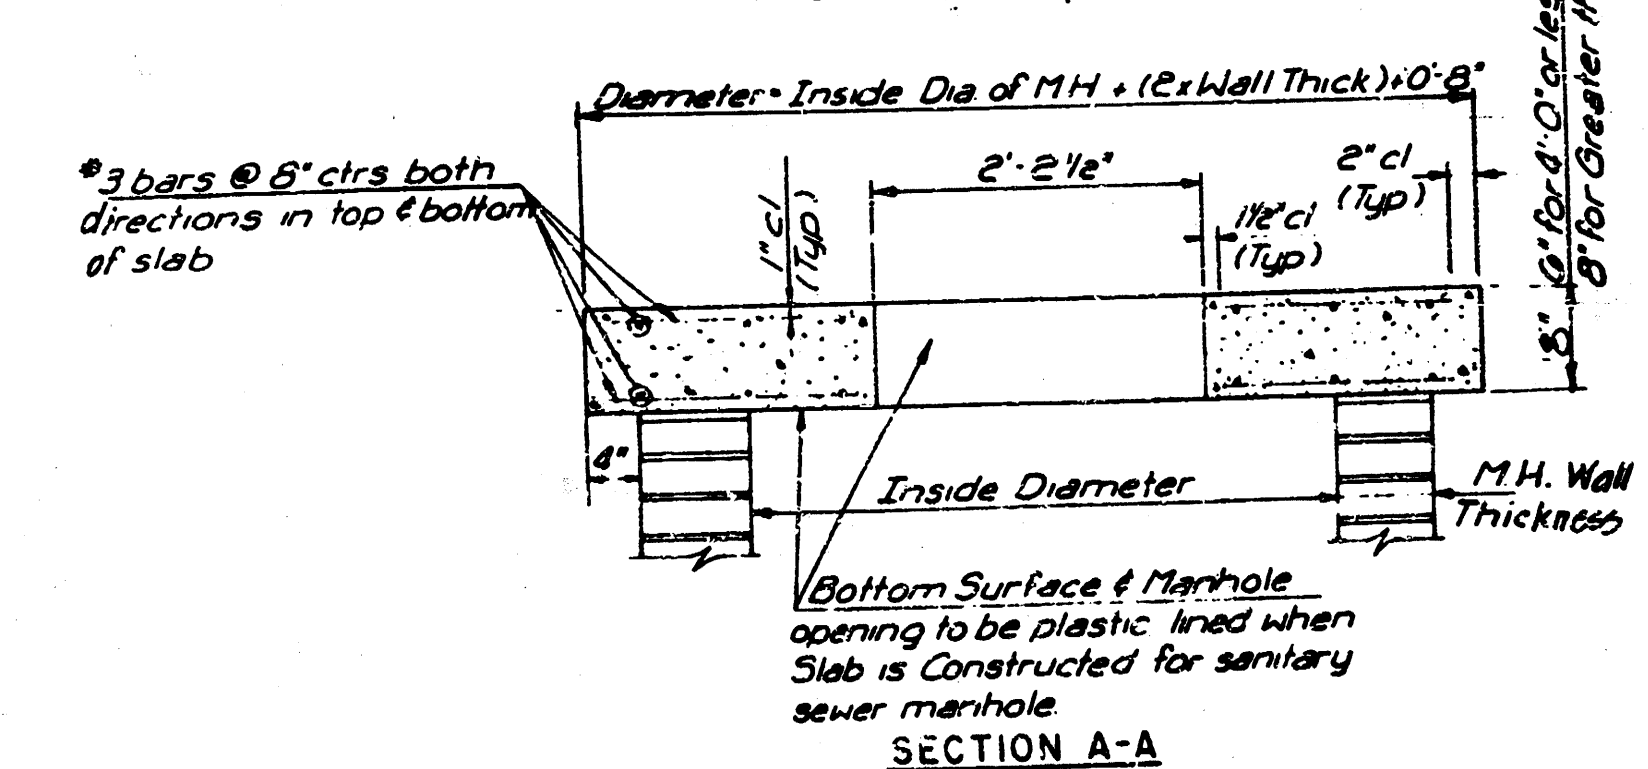

FLAT CONCRETE SLAB DETAILS

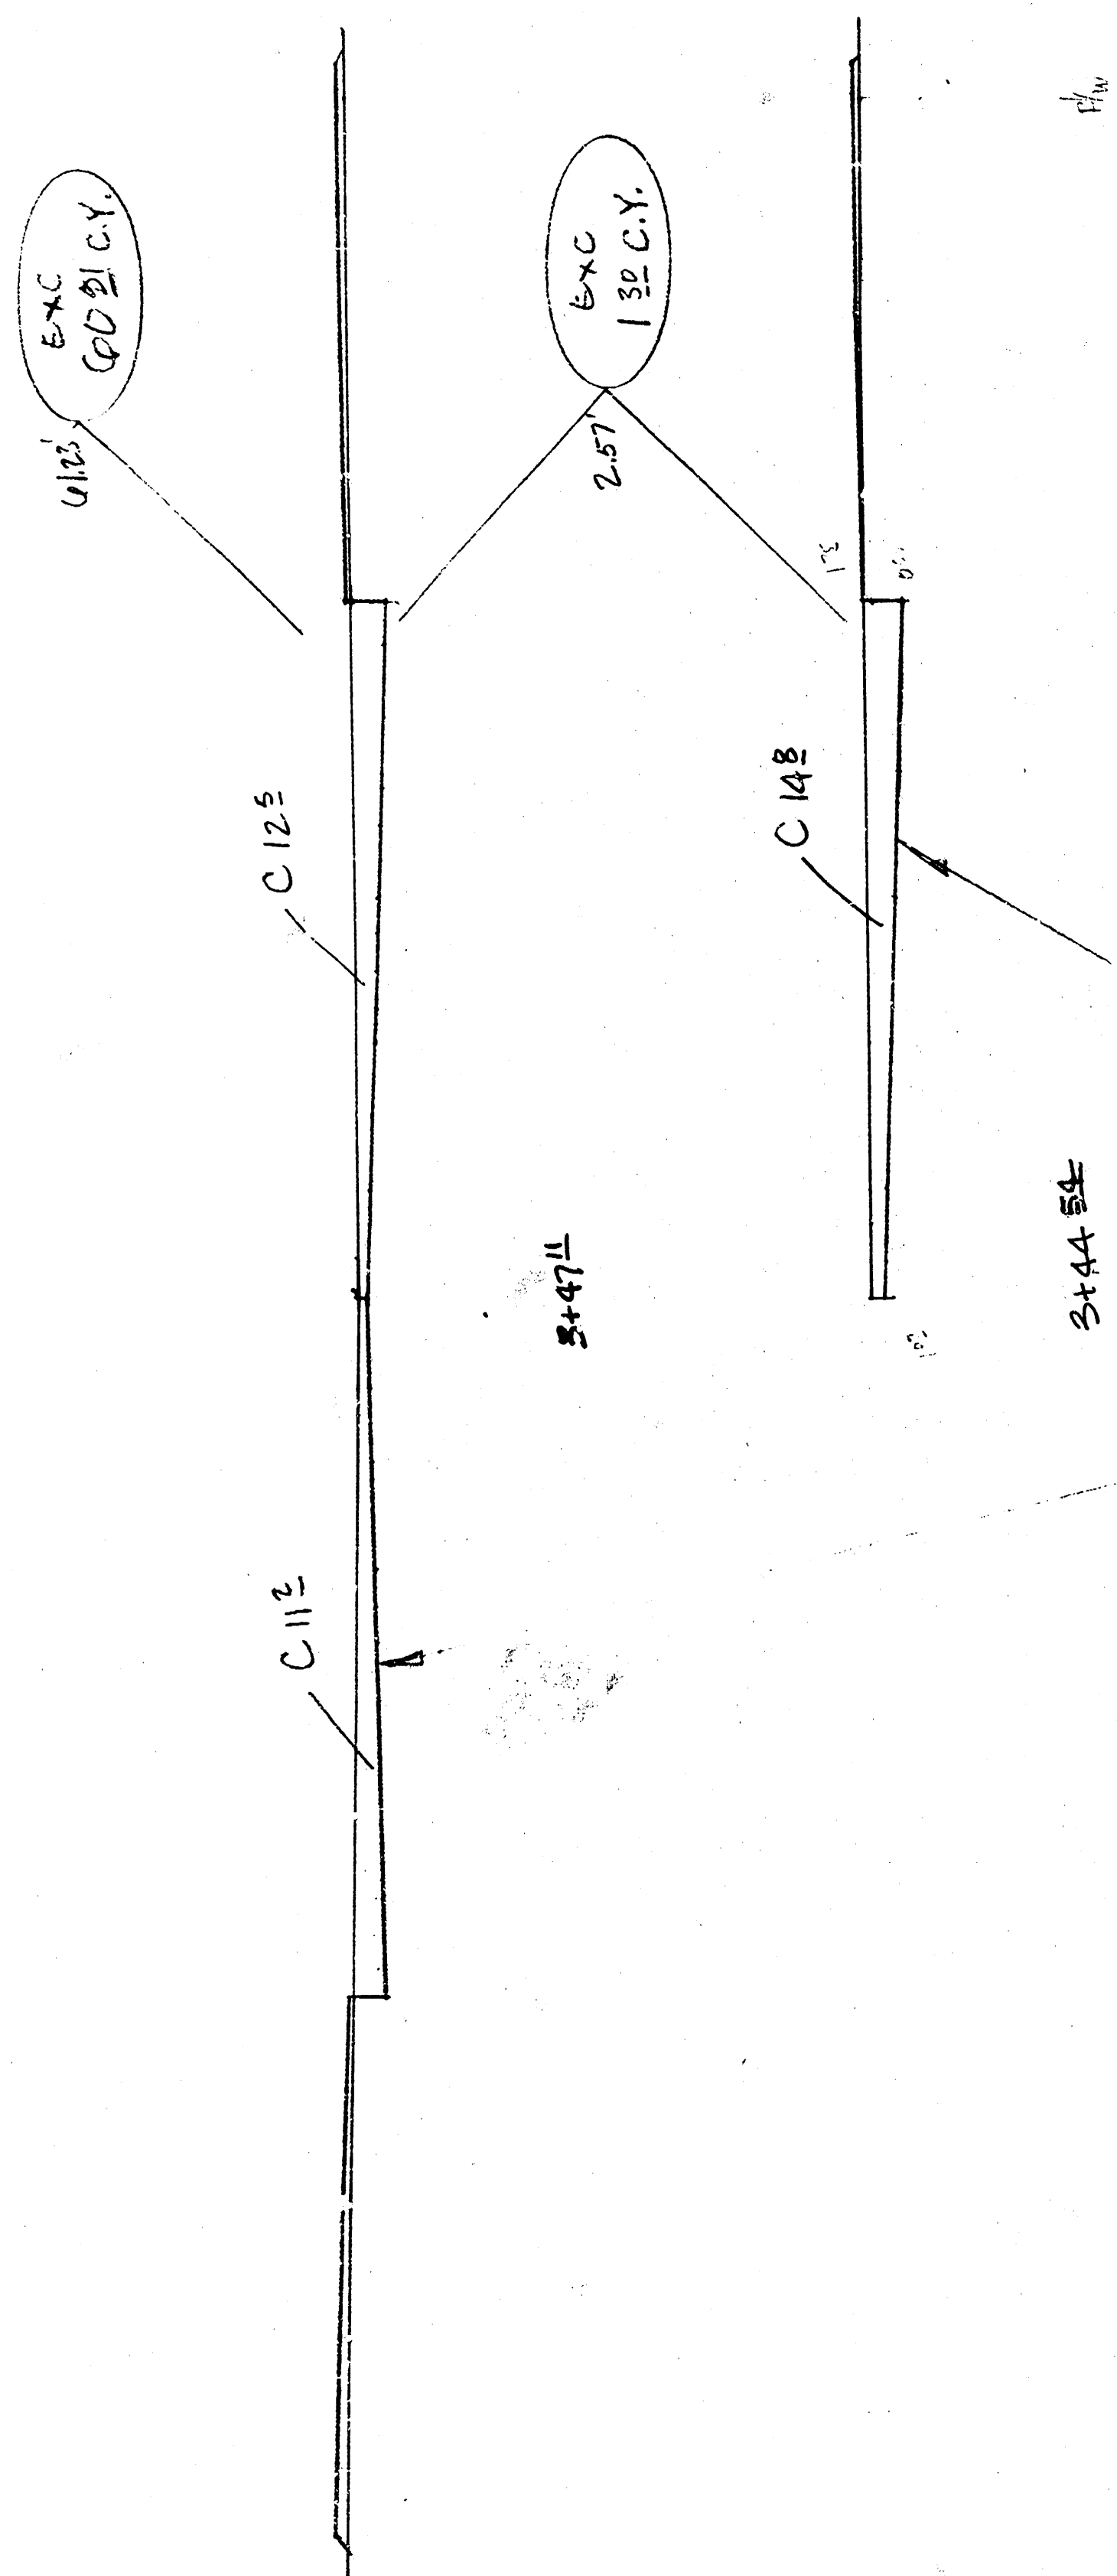

$\Delta E_{CUT} = 0.92$
 $\Delta AREA = 9168.67 \text{ ft}^2$
EXC 312 41 C.Y.

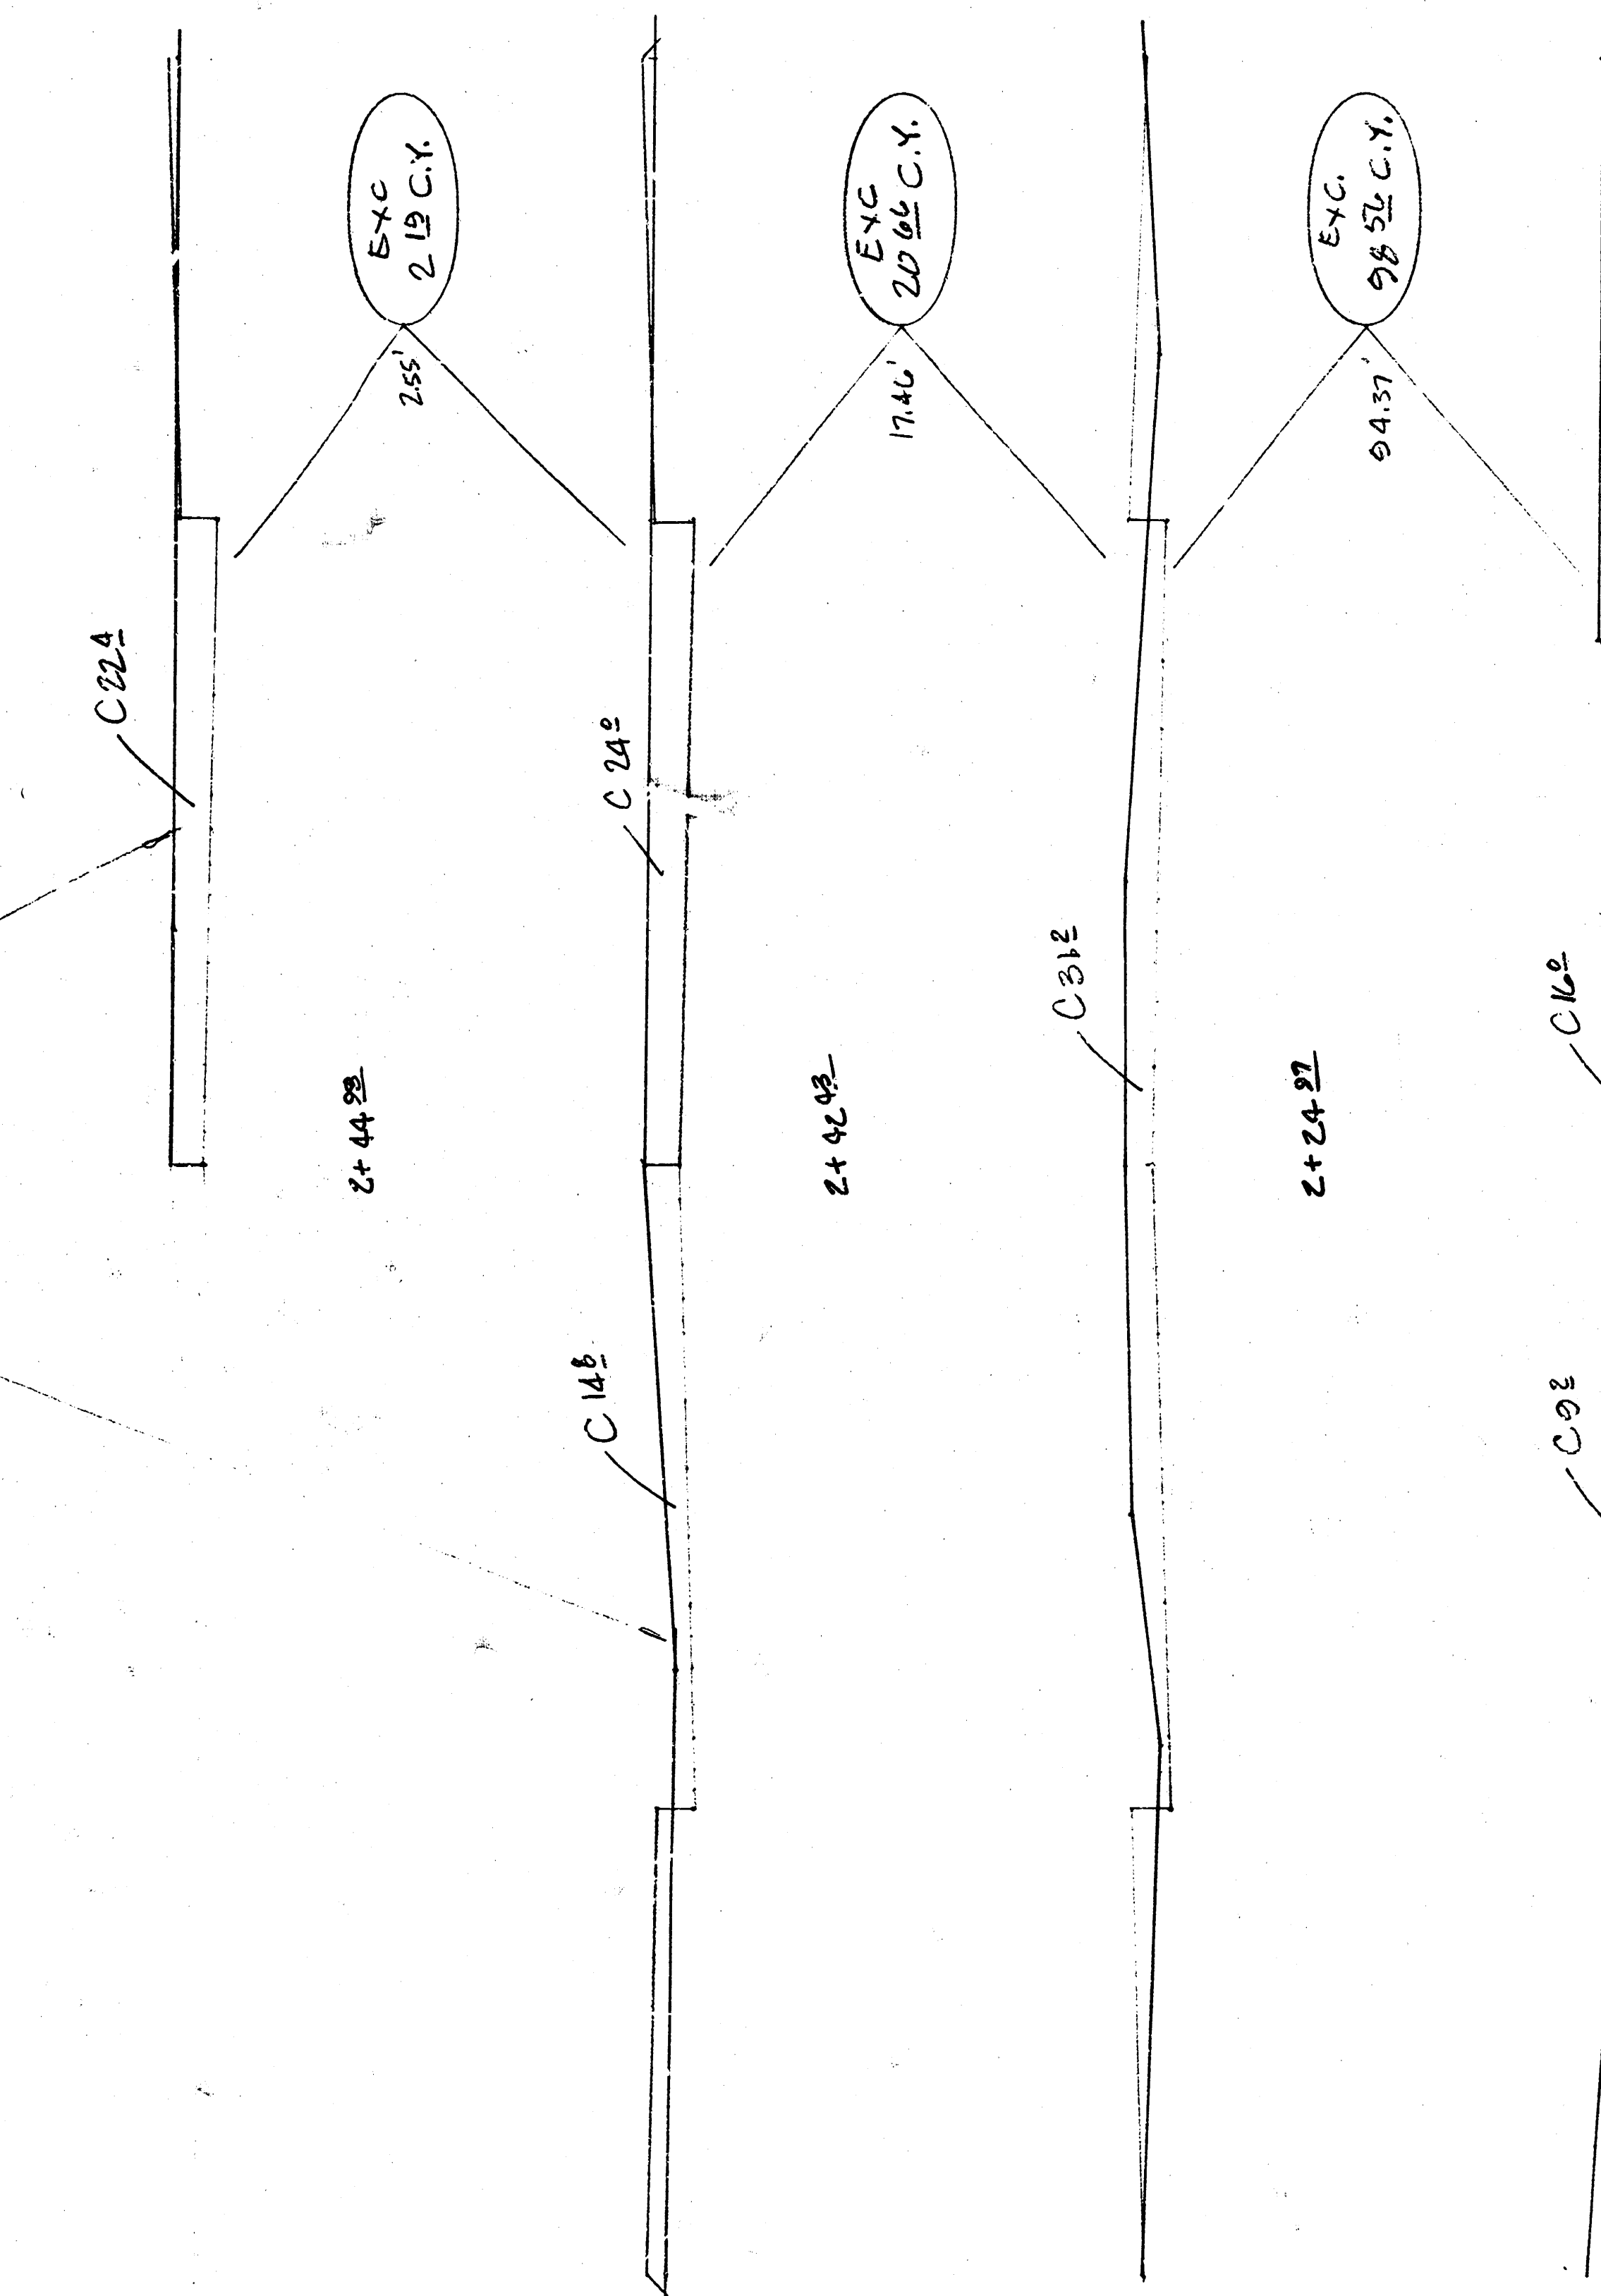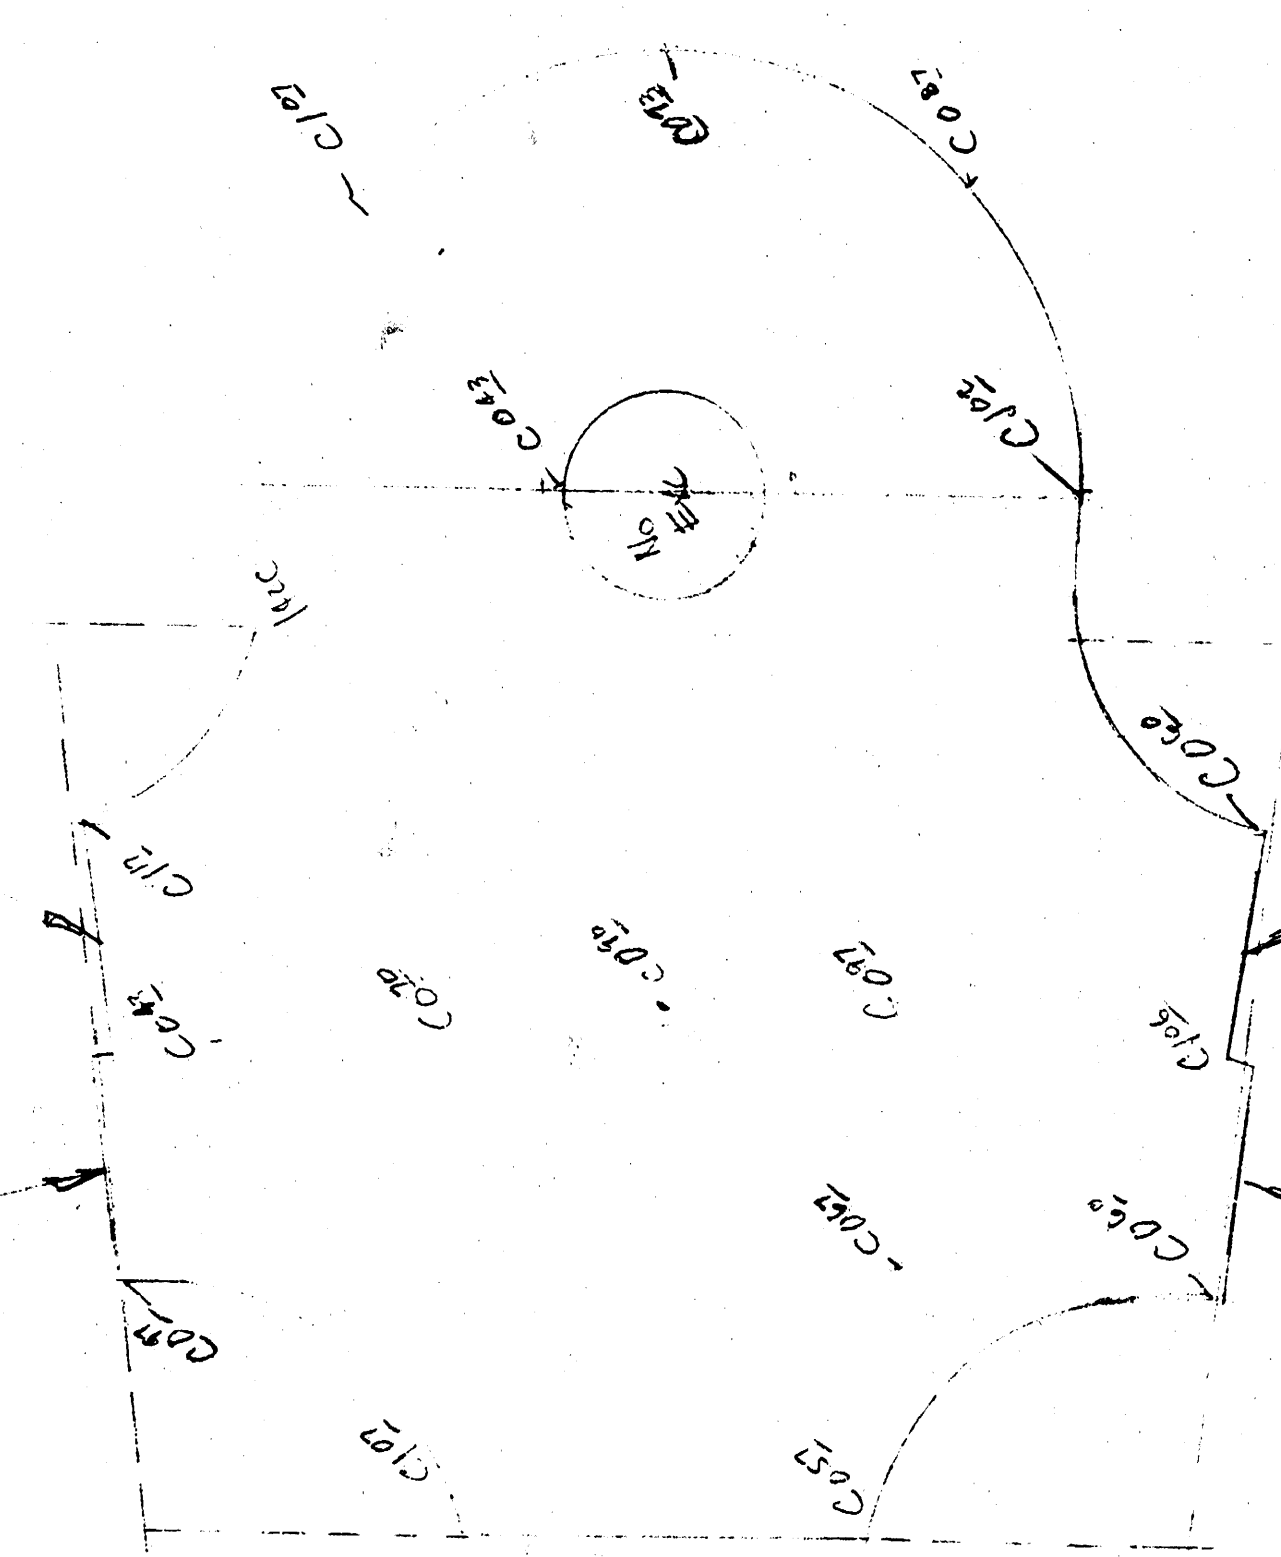


SHEET TOTAL
45822 C.Y. EXCAVATION

EARTHWORK SECTIONS
GOLD/GOLD COURT


Proj. # 472-78 245-81193 -000-000-801

12/14

1 20 10 0 10 30

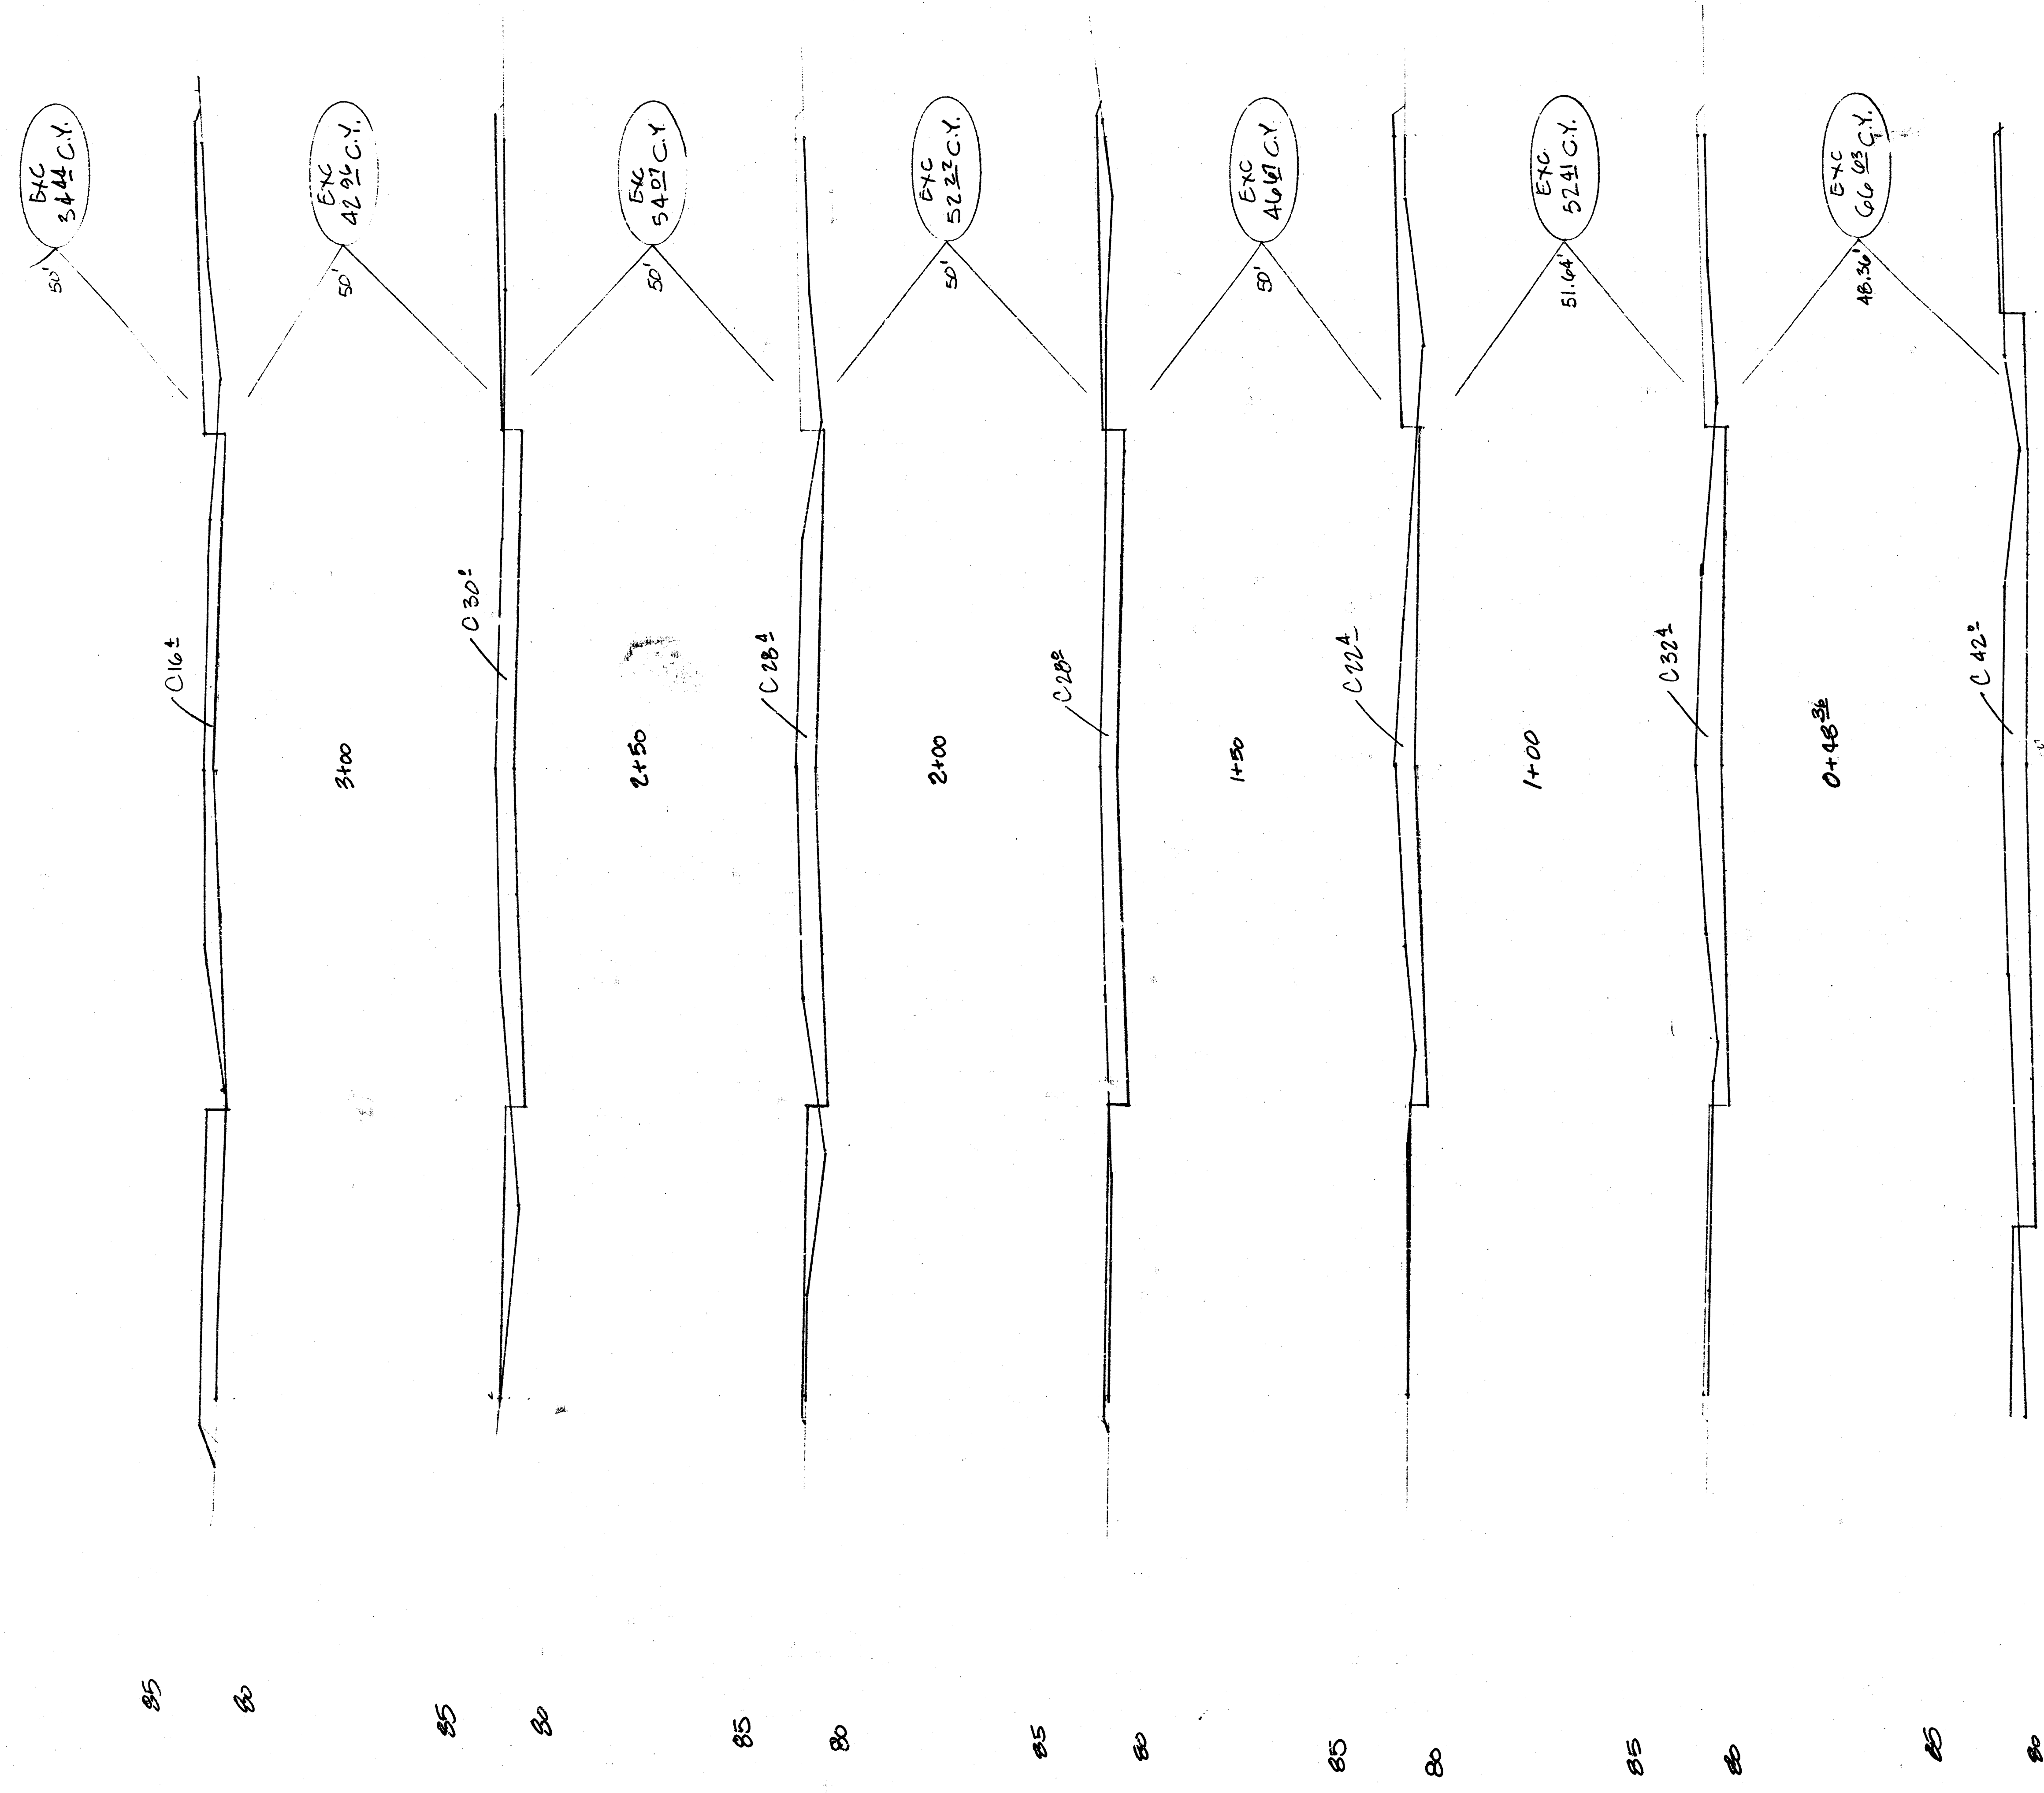

SYCAMORE

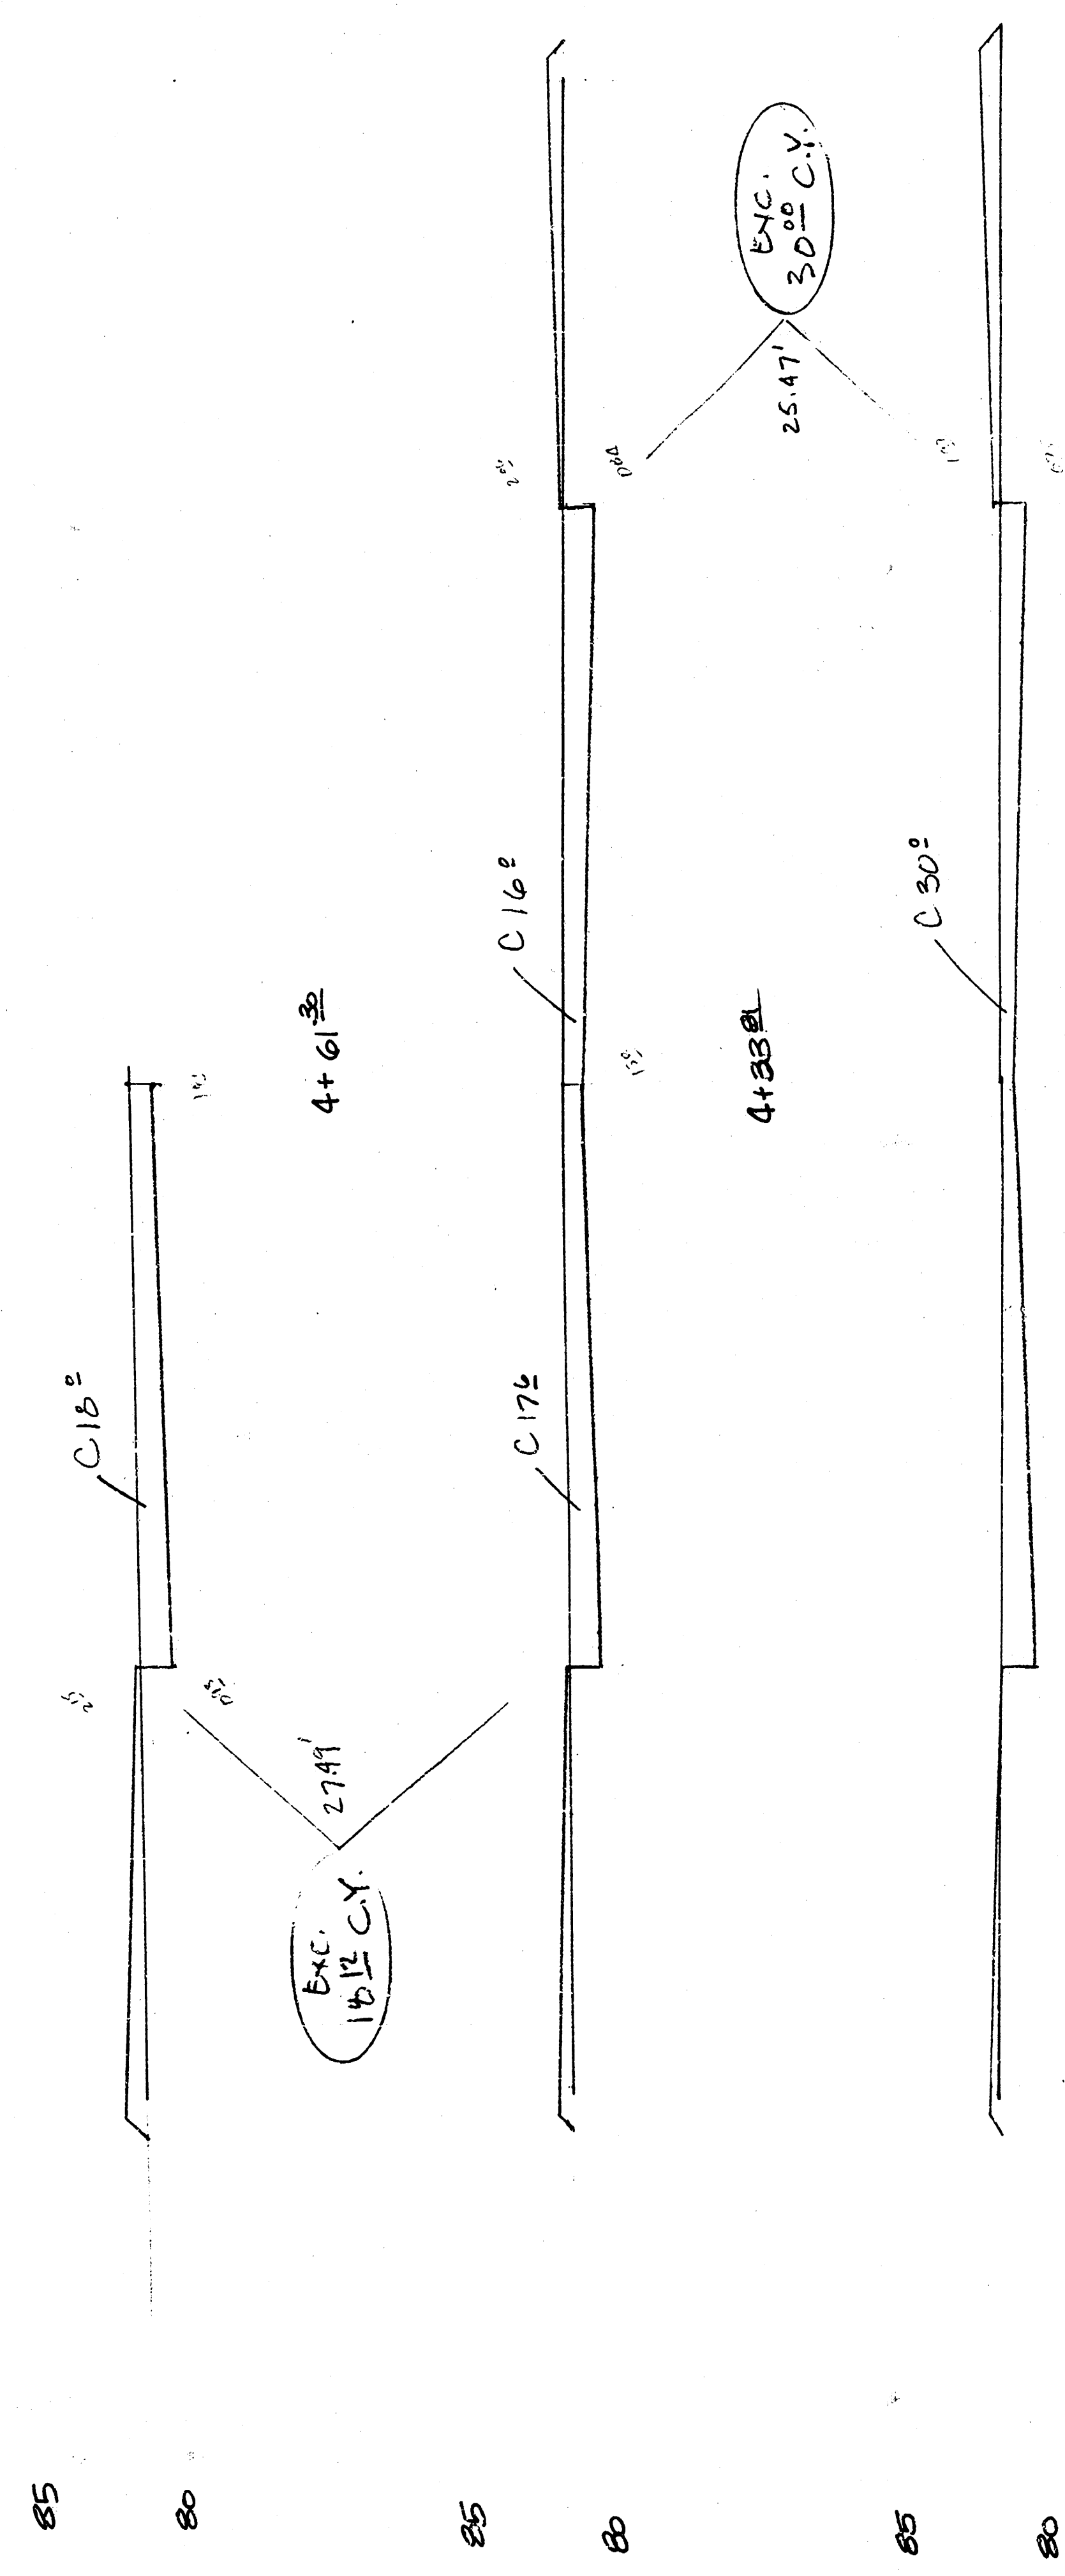

SHEET TOTAL
397.49 C.Y. EXCAVATION


30	20	10	0	10	20	30
----	----	----	---	----	----	----

EARTHWORK SECTIONS

GOLD & SYCAMORE

Proj # 472-78-245-81193-000-000-001

13/14/14

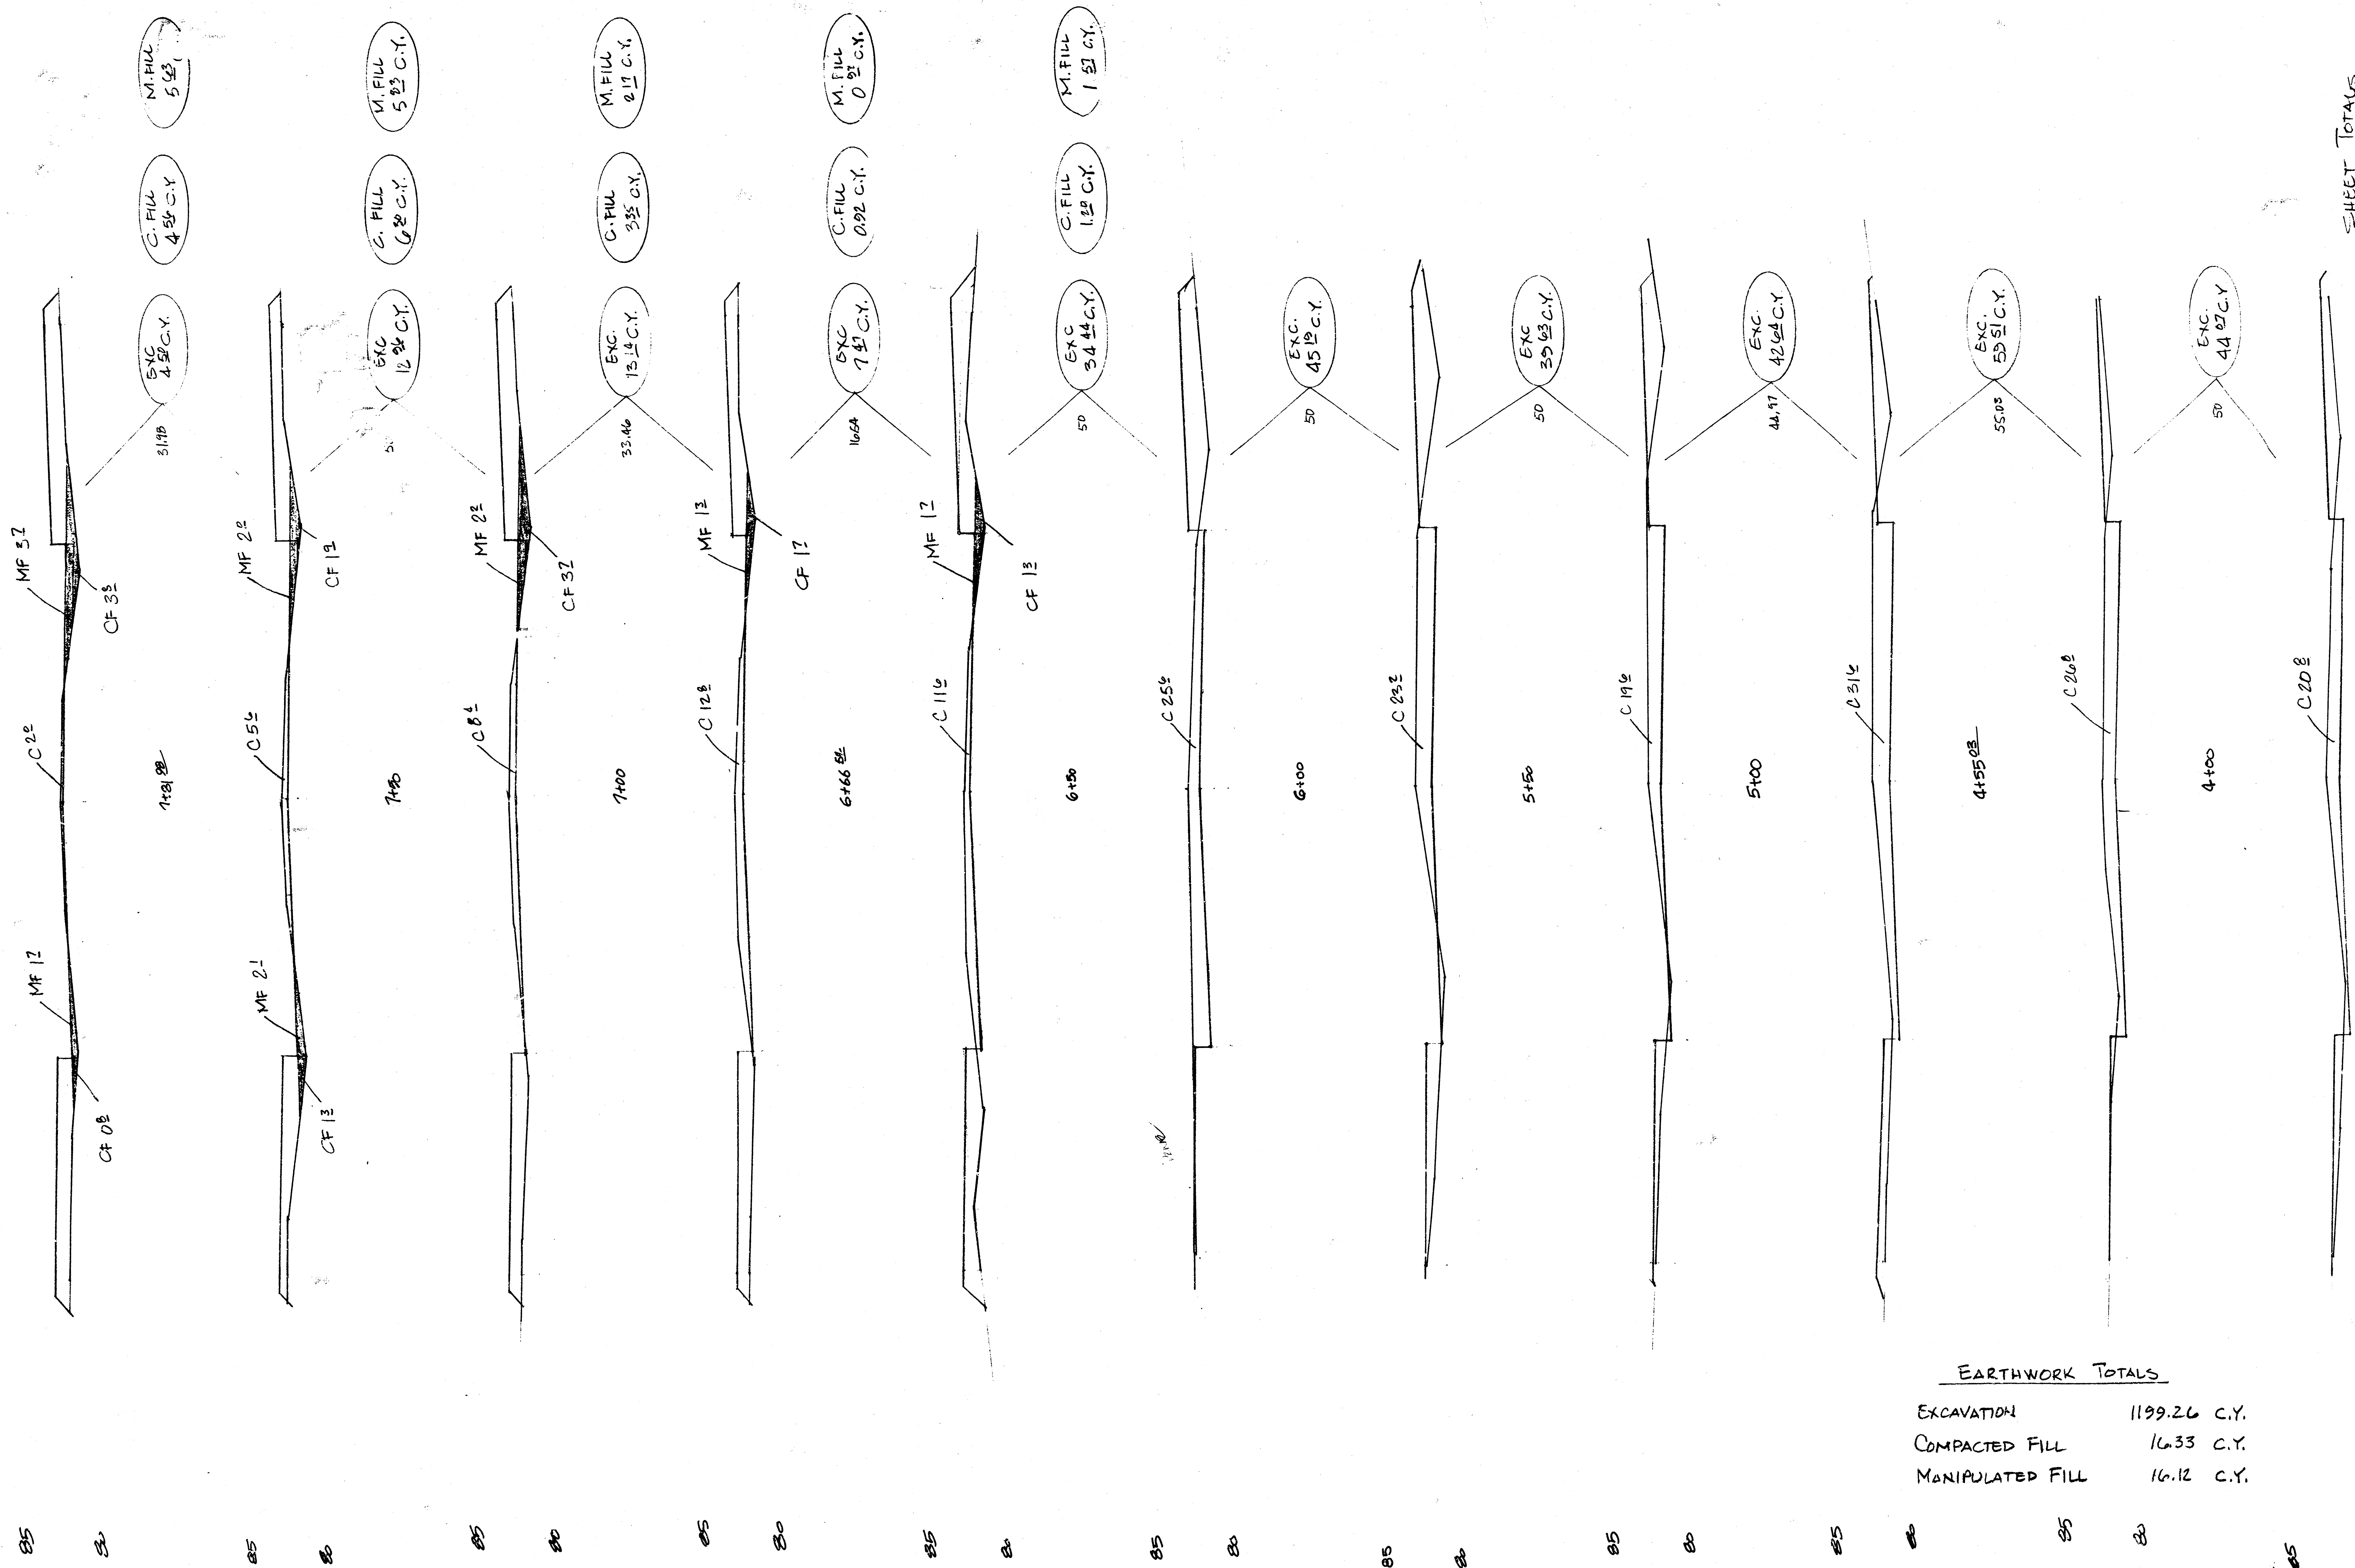

EARTHWORK TOTALS

EXCAVATION	1199.26 C.Y.
COMPACTED FILL	16.33 C.Y.
MANIPULATED FILL	16.12 C.Y.

SHEET TOTALS

303.55 C.Y.	EXCAVATION
16.33 C.Y.	COMP. FILL
16.12 C.Y.	MANIP. FILL