

CITY OF WICHITA, KANSAS
 MICHAEL E. LINDEBAK, P.E., CITY ENGINEER
STREET IMPROVEMENTS

O'NEIL/MILSTEAD - E.L. 119TH STREET WEST TO N.L. FIRST STREET
 O'NEIL - E.L. MILSTEAD TO N.L. PARKRIDGE

IN
WESTLINK VILLAGE EIGHTEENTH ADDITION
 CITY OF WICHITA PROJECT NO. 472-76-245-80001-000-000-022

SHEET NO.	TOTAL SHEETS
1	9

APPROVED AS NOTED
 By CITY ENGINEER OF WICHITA

Sanitary Sewers _____
 Storm Sewers _____
 Driveway Approaches _____
 Water Mains _____
 Paving CLB 12-17-86

1626

NOTE TO CONTRACTOR



This project will be constructed under the supervision of the CITY ENGINEER and conforming to the SPECIFICATIONS of the CITY OF WICHITA. The CONTRACTOR will pay the City of Wichita for all costs of plan review, inspection and booking per contract.

INDEX OF SHEETS

1. TITLE SHEET
2. PLAT
3. TYPICAL 35' PAVEMENT DETAILS
4. TYPICAL 29' PAVEMENT DETAILS
- 5.-8. PAVING PLANS
9. STANDARD DRIVE ENTRANCE DETAILS

PROJECT SURVEY CONTROL

VERTICAL DATUM: CITY OF WICHITA DATUM
 DATUM BENCH MARK: R.R. SPIKE SOUTH FACE 14" HACKBERRY 29'± N. OF FIRST STREET & EAST LINE WESTLINK VILLAGE 18TH ADDITION. ELEV. = 151.86
 BENCH MARK: CHISELED "D" NORTHEAST CORNER STORM DRAIN INLET, EAST SIDE PARKRIDGE 40'± NORTH OF NORTH CURB OF O'NEIL EXTENDED. ELEV. = 150.96
 BENCH MARK: R.R. SPIKE EAST FACE HEDGE TREE 50'± EAST OF WEST 1/4 CORNER, SEC. 19, T27S, R1W. ELEV. = 150.59

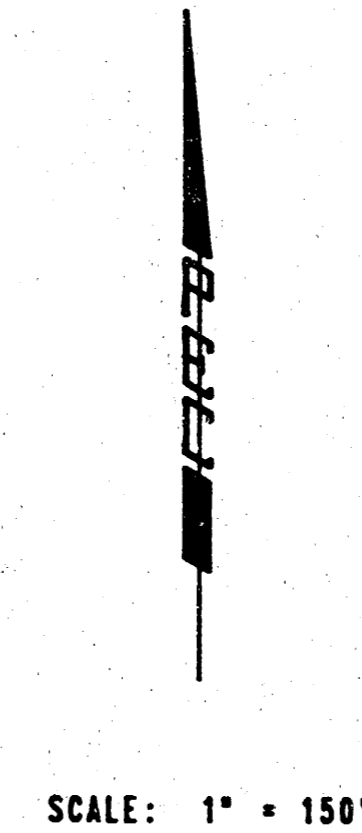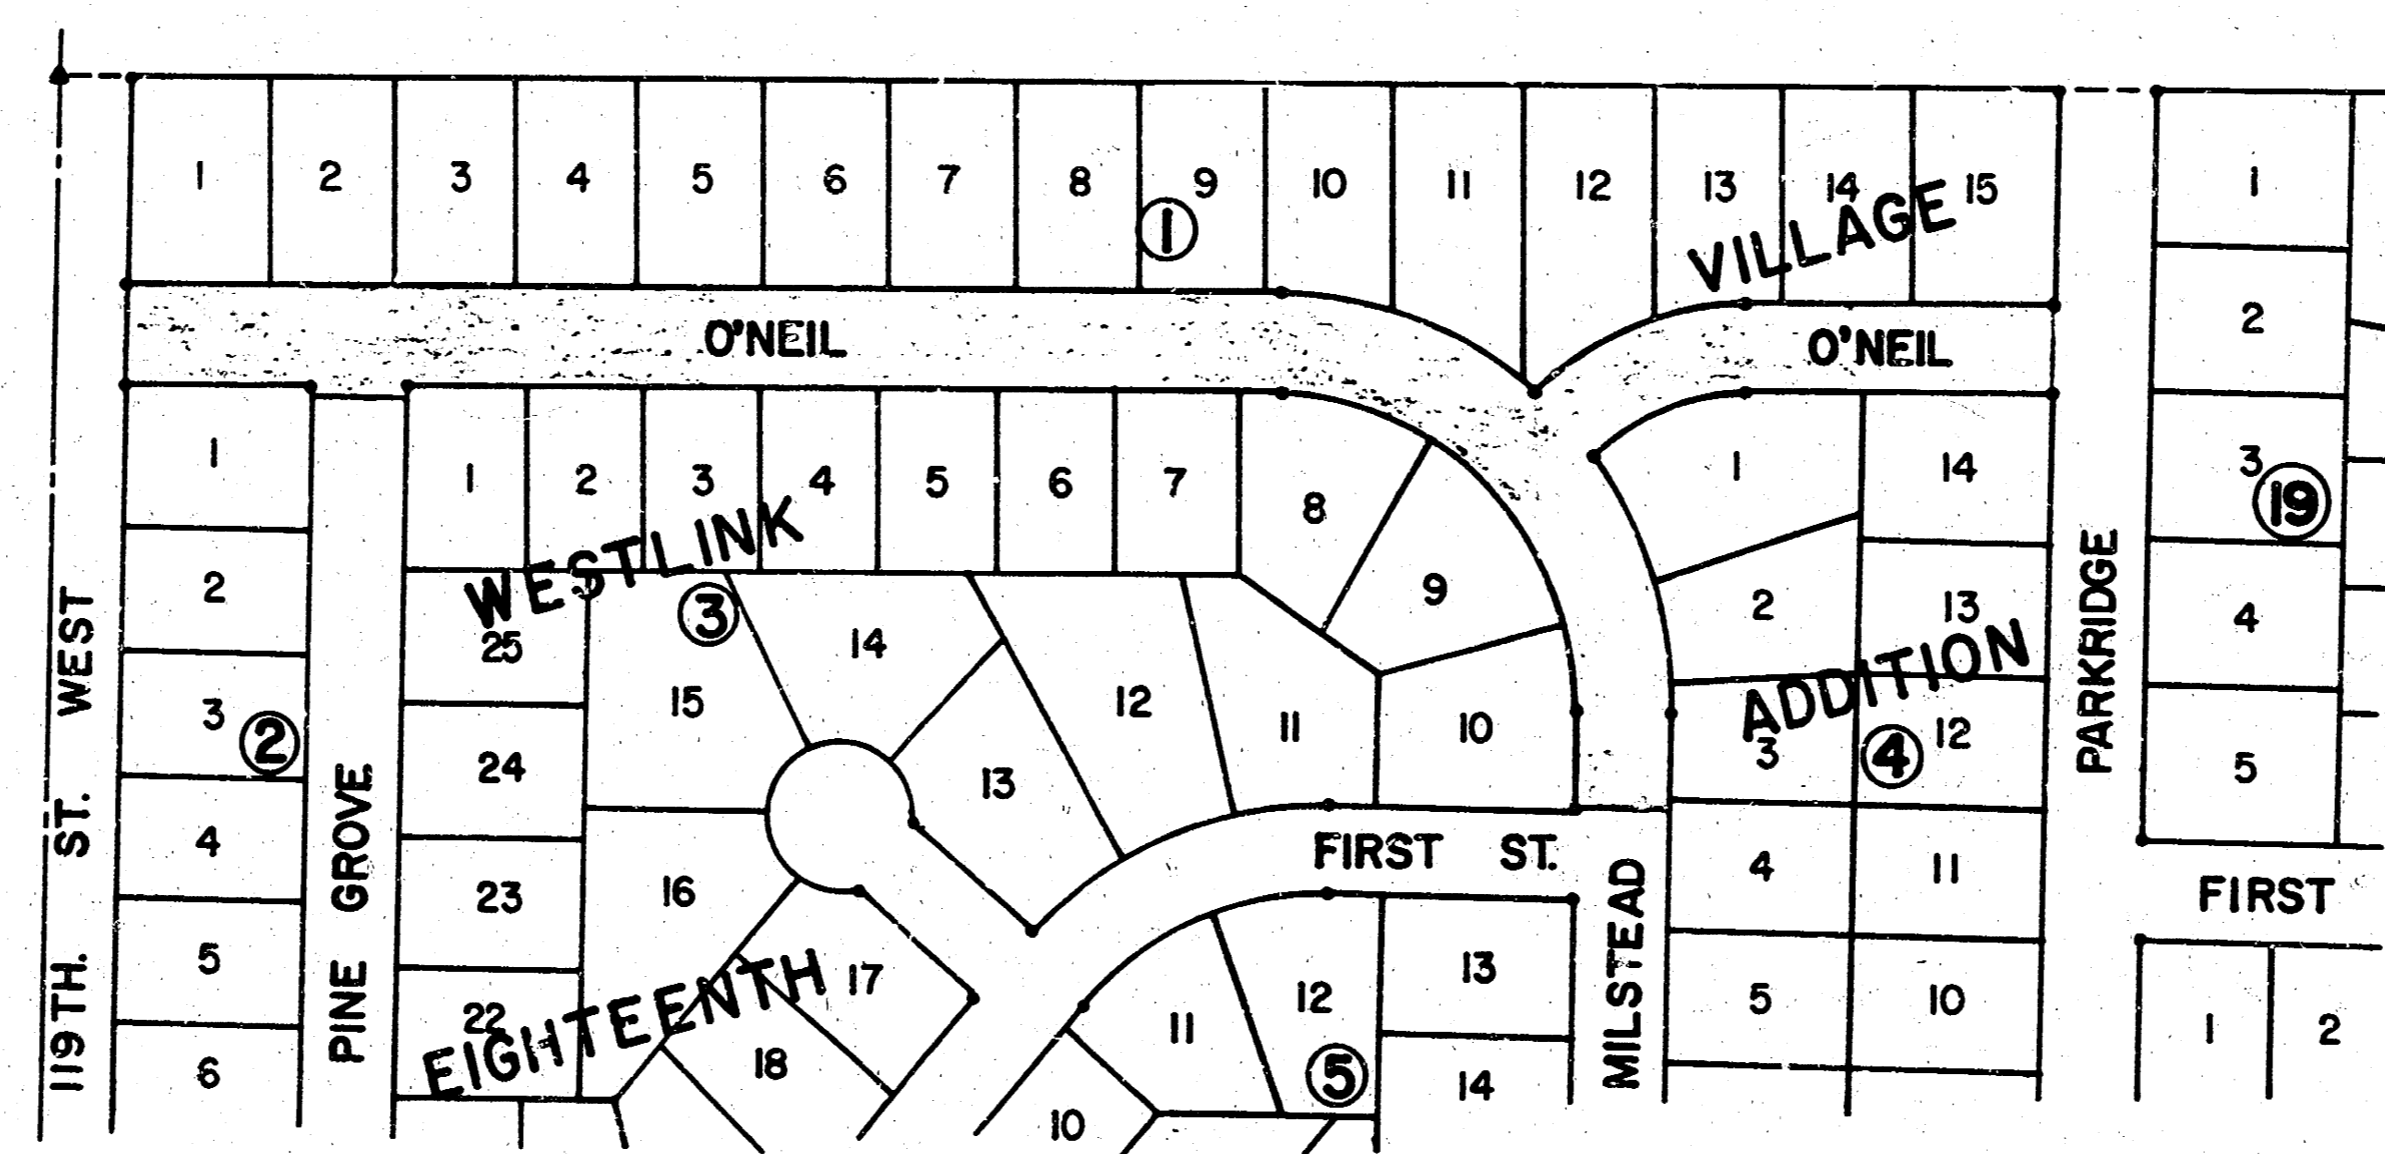

GENERAL NOTES

UTILITY SERVICE LINES, POLES, VALVE BOXES, METERS, AND ETCETERA ARE TO BE ADJUSTED OR REMOVED AS NECESSARY BY OTHERS PRIOR TO OR DURING CONSTRUCTION UNLESS THE PLANS SPECIFICALLY CALL FOR THEIR ADJUSTMENT BY THE CONTRACTOR. EXISTING UTILITIES, THEIR LOCATION, AS SHOWN ON THE PLANS, REPRESENT THE BEST INFORMATION AVAILABLE FOR DESIGN. LOCATION INFORMATION HAS BEEN OBTAINED FROM THE VARIOUS UTILITY COMPANIES AND IS EITHER FROM COMPANY RECORD DRAWINGS OR COMPANY PROVIDED FIELD LOCATIONS. THE PLAN LOCATIONS ARE NOT GUARANTEED. ADDITIONAL EXISTING UTILITIES MAY ALSO BE ENCOUNTERED. THE CONTRACTOR WILL BE REQUIRED TO WORK AROUND EXISTING UTILITIES WITHIN THE RIGHT-OF-WAY WHICH DO NOT CONFLICT WITH PROPOSED CONSTRUCTION.

All Water Line Stubs Shall Be Installed Per City of Wichita Standard 14533 For Water Line Installation.

RUBBLE FROM THE REMOVAL OF MISCELLANEOUS STRUCTURES AND EXCESS EXCAVATION WHICH IS TO BE WASTED SHALL BE DISPOSED OF ON SITES TO BE PROVIDED BY THE CONTRACTOR. THESE SITES SHALL BE APPROVED BY THE ENGINEER AS TO SUITABILITY, APPEARANCE, AND SITE LOCATION. LOCATIONS THAT IN THE OPINION OF THE ENGINEER, WILL LEAVE AN UNSIGHTLY APPEARANCE WILL NOT BE APPROVED.

TREES AND SHRUBS IN PUBLIC RIGHT-OF-WAY WHICH ARE IN DIRECT CONFLICT WITH PROPOSED NEW CONSTRUCTION SHALL BE REMOVED AND DISPOSED OF BY THE CONTRACTOR WITH ENGINEER'S APPROVAL. TREES AND SHRUBS WHICH ARE NOT IN CONFLICT WITH PROPOSED NEW CONSTRUCTION SHALL BE SAVED AND PROTECTED FROM DAMAGE.

LIMITS OF EARTHWORK SHALL MATCH EXISTING GROUND ELEVATIONS AT THE RIGHT-OF-WAY LINE UNLESS OTHERWISE NOTED ON THE PLANS WITH A NEW FINISHED GRADE ELEVATION. WHEN A NEW FINISHED GRADE ELEVATION IS SHOWN, THE EARTHWORK SHALL EXTEND ONE FOOT BEYOND THE RIGHT-OF-WAY LINE AND THEN SLOPED UP OR DOWN USING PERMISSIBLE SLOPES TO MATCH THE EXISTING GROUND SURFACE.

THE CONTRACTOR SHALL BE RESPONSIBLE FOR PRESERVING PROPERTY IRONS. THE CONTRACTOR WILL BE REQUIRED TO RE-ESTABLISH ANY PROPERTY IRONS WHICH ARE DAMAGED OR DESTROYED BY HIS CONSTRUCTION OPERATIONS. SUCH IRONS SHALL BE RE-ESTABLISHED BY A LICENSED LAND SURVEYOR OR A LICENSED PROFESSIONAL ENGINEER IN ACCORDANCE WITH STATE LAWS.

ALL EXCESS EXCAVATED MATERIAL FROM THIS PROJECT SHALL BE WASTED ON SITE. NO EXCESS MATERIAL SHALL BE WASTED WITHIN STREET RIGHT-OF-WAY. THE CONTRACTOR SHALL CONTACT THE OWNER AT 722-8974 FOR INFORMATION PERTAINING TO ACCEPTABLE LOCATIONS FOR THE DISPOSITION OF WASTE MATERIAL. WASTE MATERIAL SHALL BE BLADED SMOOTH AND SLOPED TO DRAIN. THIS WORK SHALL BE CONSIDERED SUBSIDIARY TO OTHER BID ITEMS.

DECEMBER, 1986
 PLANS PREPARED BY
 PROFESSIONAL ENGINEERING CONSULTANTS, P.A.
 ENGINEERS
 WICHITA, KANSAS




1/9

FILMED FROM THE BEST AVAILABLE COPY

WESTLINK VILLAGE EIGHTEENTH ADDITION

WICHITA, SEDGWICK COUNTY, KANSAS


SHEET 2 OF 3 SHEETS

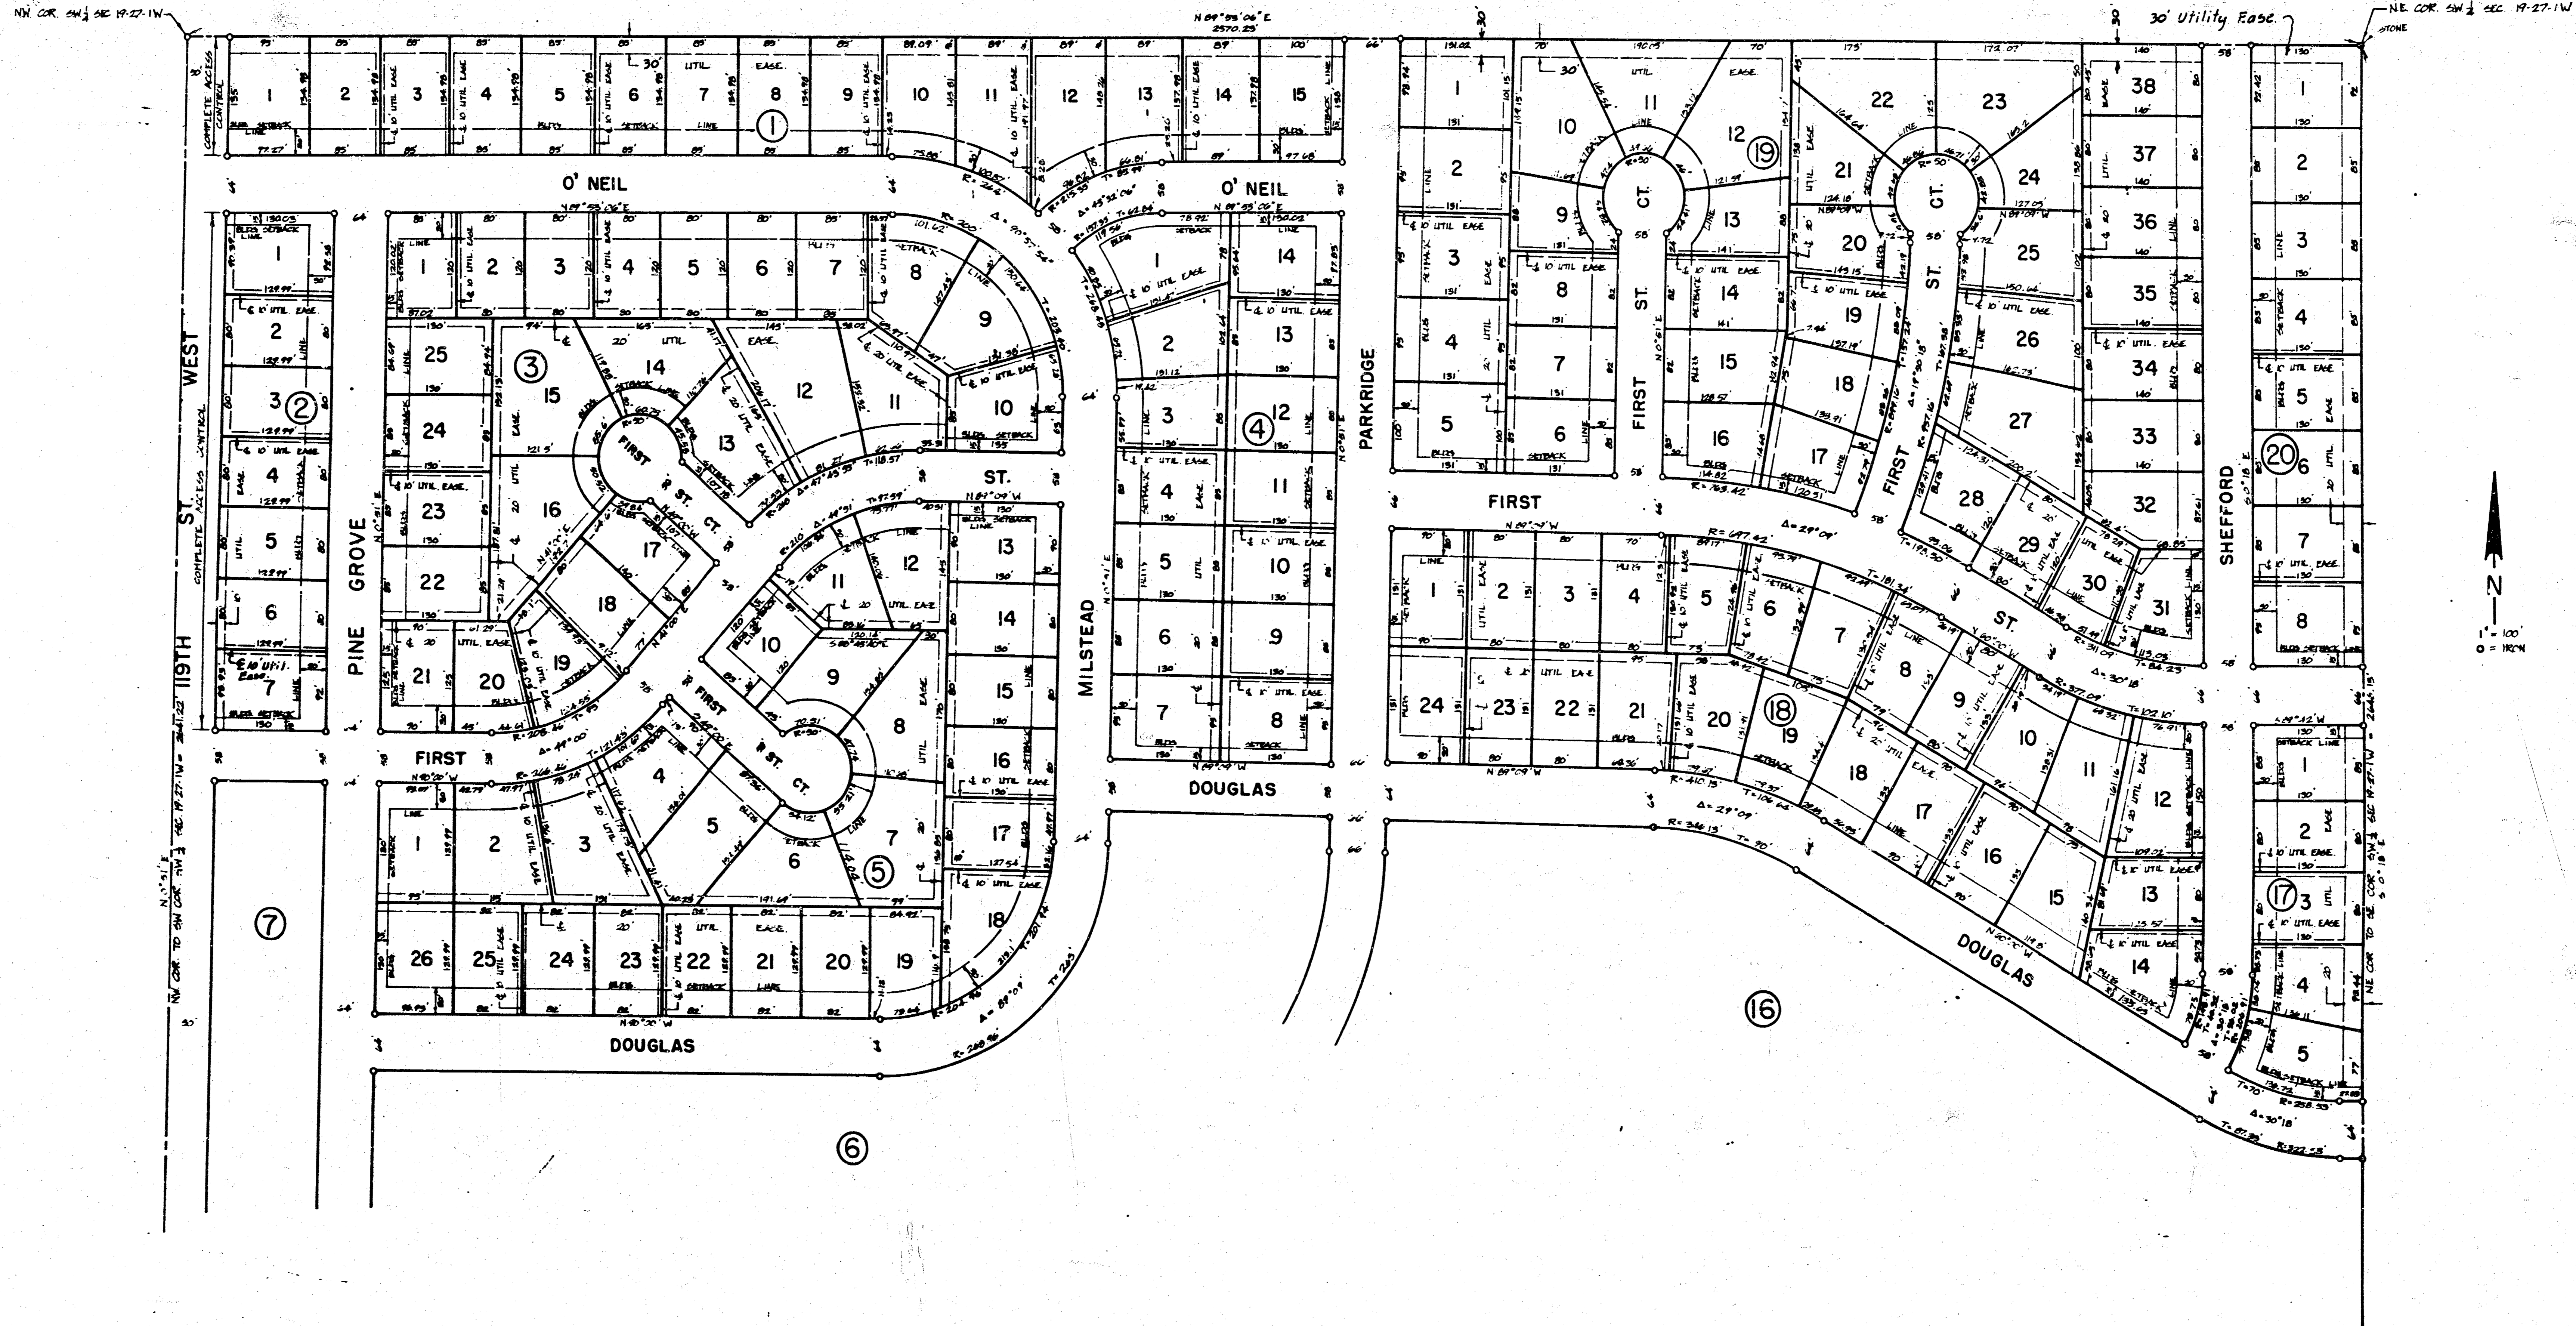


FILMED FROM THE BEST AVAILABLE COPY

TYPICAL 35' PAVEMENT DETAILS



3
9

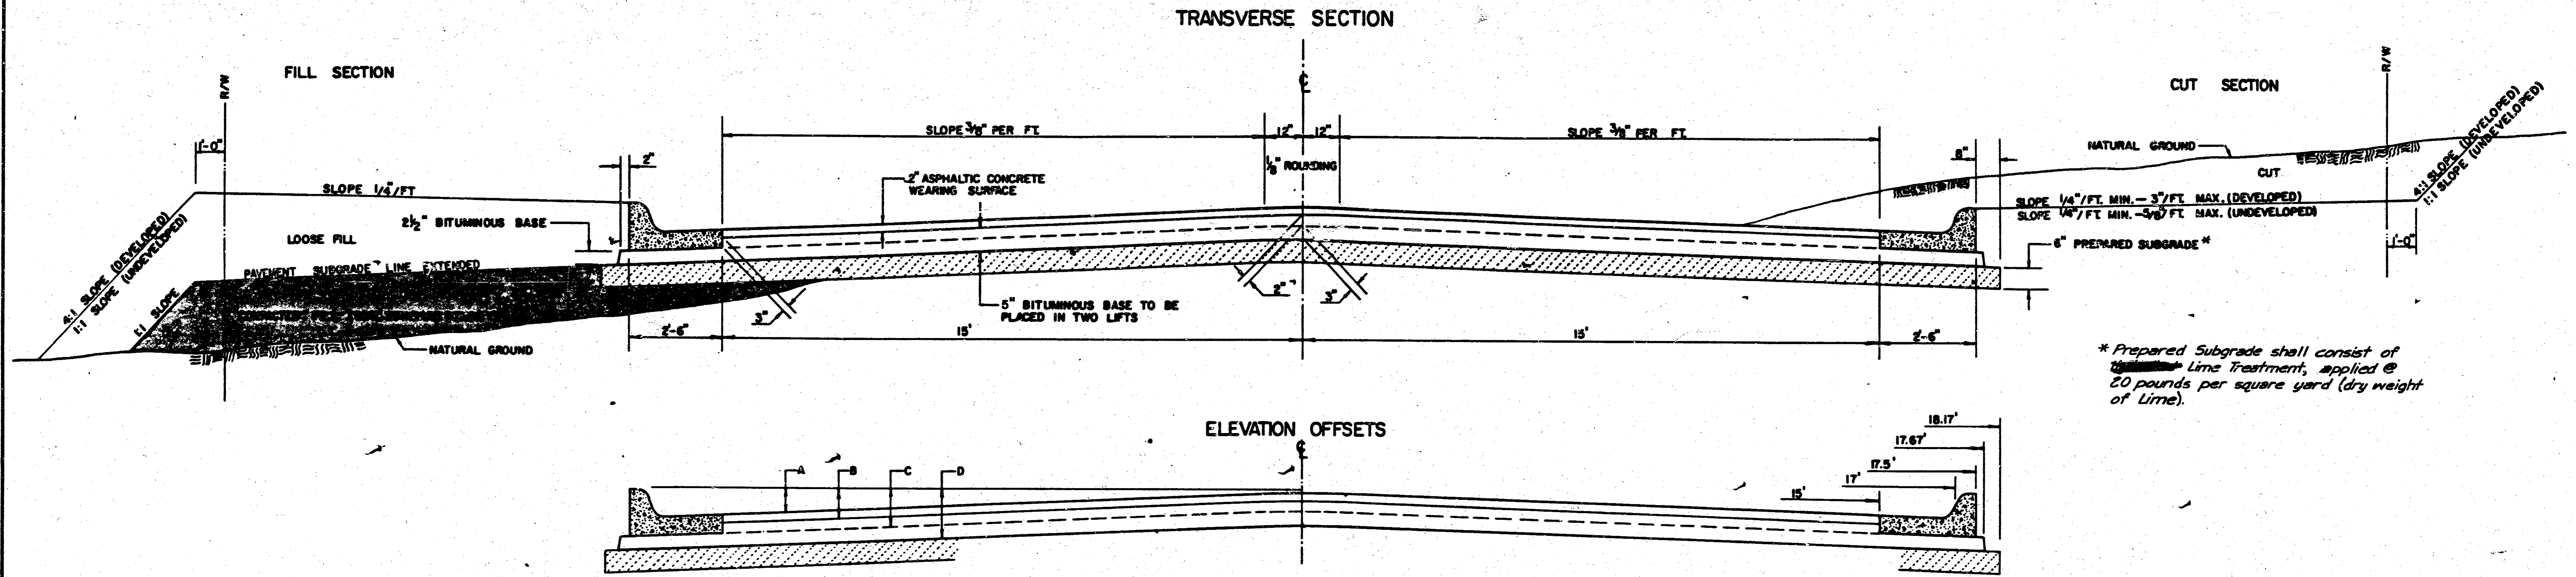

* Prepared Subgrade shall consist of ~~lime~~ Lime Treatment, applied @ 20 pounds per square yard (dry weight of Lime).

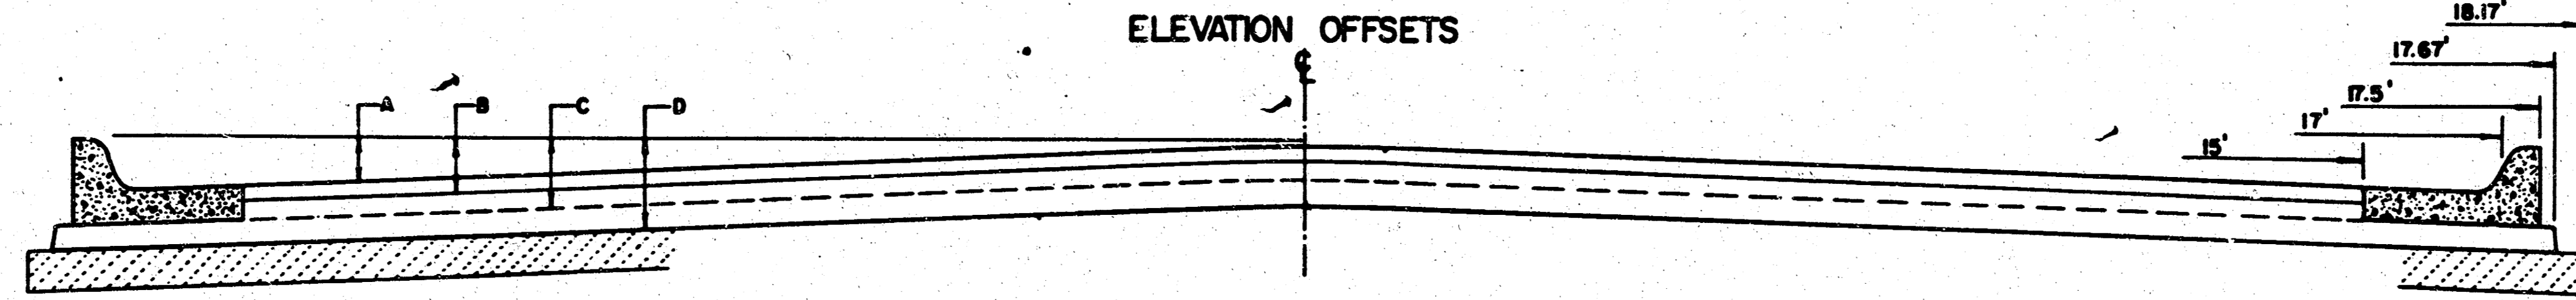


	DISTANCE FROM CENTERLINE (LT. & RT.)												
	0'	2'	4'	6'	8.5'	10'	12'	14'	15'	17'	17.5'	17.67'	18.17'
A: TOP OF CURBS TO TOP OF SURFACE LIFT	0.04	0.08	0.14	0.21	0.29	0.33	0.39	0.46	0.49	—	—	—	—
B: TOP OF CURBS TO TOP OF UPPER BASE LIFT	0.21	0.25	0.31	0.37	0.45	0.50	0.56	0.62	0.65	—	—	—	—
C: TOP OF CURBS TO TOP OF LOWER BASE LIFT	0.37	0.43	0.50	0.57	0.67	0.72	0.79	0.87	0.90	0.98	1.00	1.00	—
D: TOP OF CURBS TO TOP OF SUBGRADE	0.52	0.67	0.74	0.81	0.90	0.95	1.02	1.08	1.12	1.19	1.21	1.21	1.23

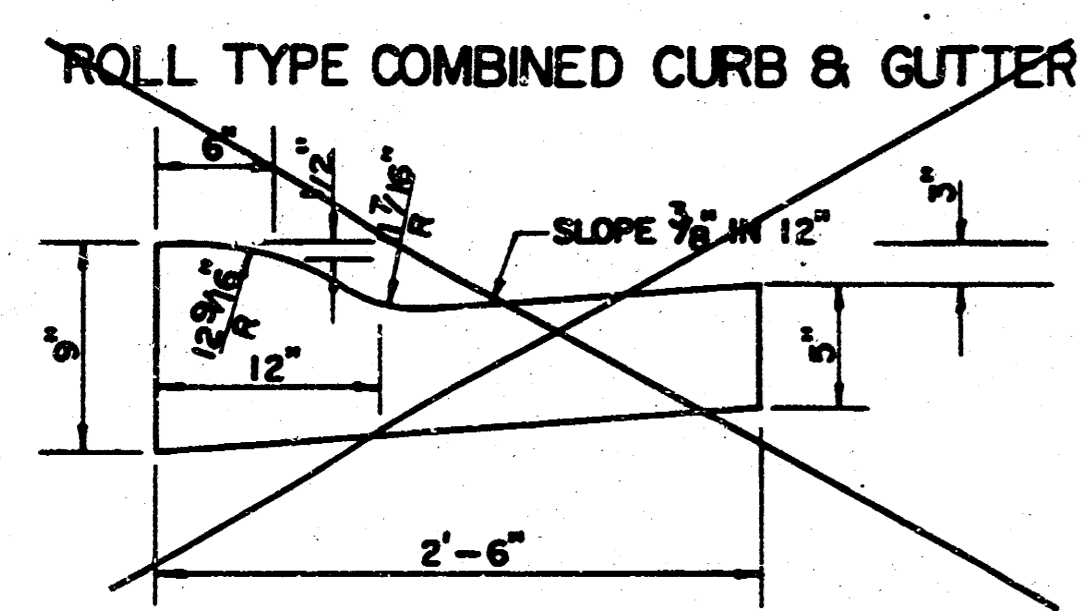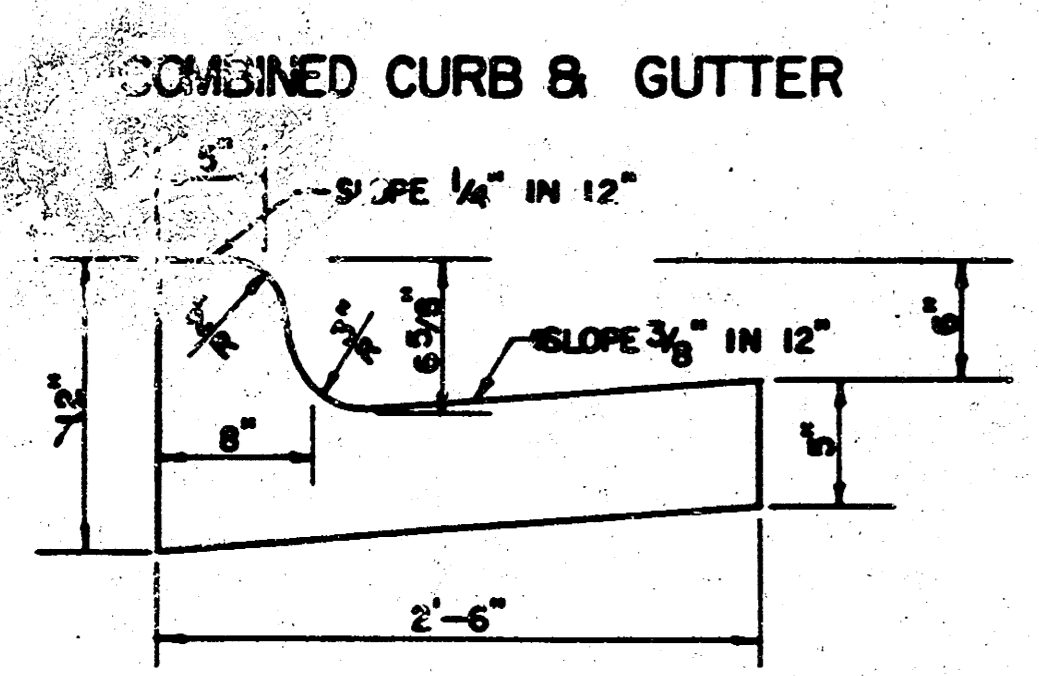

GENERAL NOTES

- 1) THE ASPHALTIC CONCRETE PAVEMENT BETWEEN THE COMBINED CURB AND GUTTER SHALL BE PAID AS SQUARE YARDS OF 7" ASPHALTIC CONCRETE (5" BITUMINOUS BASE).
- 2) THE BITUMINOUS BASE UNDER AND BEHIND THE COMBINED CURB AND GUTTER SHALL BE PAID AS SQUARE YARDS OF 2 1/2" BITUMINOUS BASE.
- 3) A TACK COAT OF EMULSIFIED ASPHALT (SC-1H OR CSS-1H) SHALL BE APPLIED AT AN APPROXIMATE RATE OF 0.05 GALLONS PER SQUARE YARD BETWEEN EACH LIFT OF ASPHALTIC MATERIAL.
- 4) BITUMINOUS BASE AND ASPHALTIC CONCRETE WEARING SURFACE SHALL BE PLACED WITH A LAYDOWN MACHINE HAVING AUTOMATIC CONTROLS FOR LINE AND GRADE.
- 5) CONSTRUCTION JOINTS IN EACH LIFT SHALL BE STAGGERED A MINIMUM DISTANCE OF ONE (1) FOOT FROM JOINTS IN PRECEDING LIFTS AND PLACED SO THAT A JOINT WILL BE CONSTRUCTED ON THE CENTERLINE OF THE TOP LIFT.
- 6) CONTRACTOR TO BID ONLY ONE SUBGRADE TREATMENT ALTERNATE WHEN ALTERNATES ARE PROVIDED IN THE PROPOSAL AND CONTRACT. THE ALTERNATE CHOSEN BY THE SUCCESSFUL BIDDER SHALL BE USED IN CONSTRUCTING THIS PROJECT.

TRANSVERSE CONSTRUCTION JOINTS

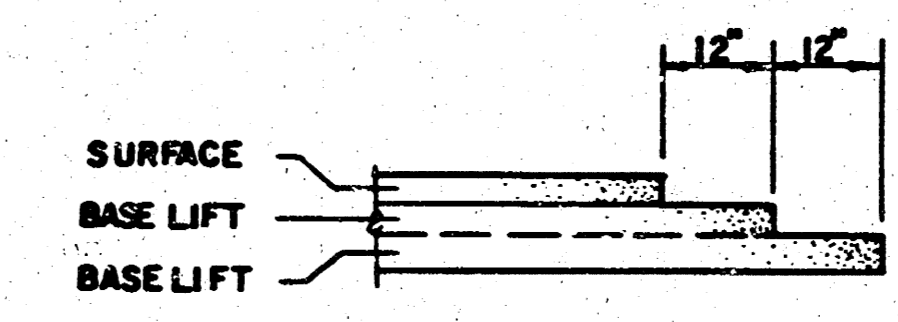


TRANSVERSE CONSTRUCTION JOINTS SHALL BE CONSTRUCTED IN FLEXIBLE BASE PAVEMENTS AT LOCATIONS WHERE PAVEMENT JOINS EXISTING FLEXIBLE BASE PAVEMENT AS SHOWN BY THE DETAIL. ALL COSTS ASSOCIATED WITH THE CONSTRUCTION OF THE TRANSVERSE JOINT SHALL BE INCLUDED IN THE BID PRICE FOR SQUARE YARDS 7" ASPHALTIC CONCRETE (5" BITUMINOUS BASE).

7 INCH RESIDENTIAL ASPHALTIC CONCRETE PAVEMENT WITH 5 INCH BITUMINOUS BASE
CITY OF WICHITA, KANSAS
PROJECT NUMBER 3/9

FILMED FROM THE BEST AVAILABLE COPY

TYPICAL 29' PAVEMENT DETAILS


4/9

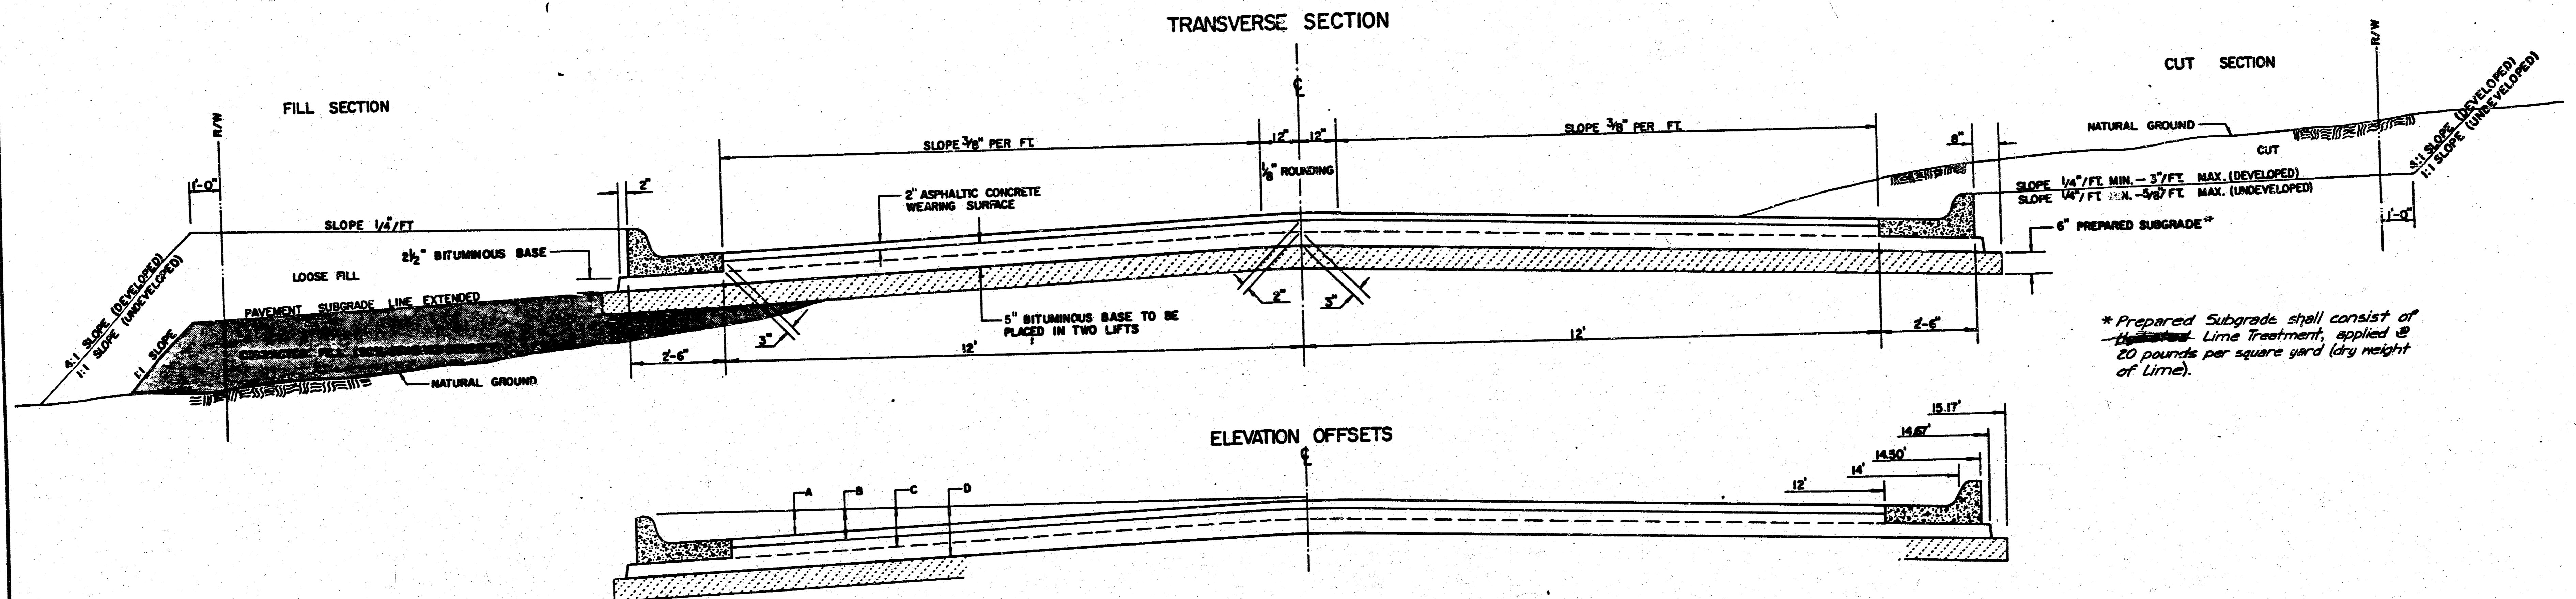


* Prepared Subgrade shall consist of ~~Hydrated~~ Lime Treatment, applied @ 20 pounds per square yard (dry weight of Lime).

	DISTANCE FROM CENTERLINE (LT. & RT.)												
	0'	2'	4'	6'	7'	8'	10'	12'	14'	14.5'	14.67'	15.17'	
A: TOP OF CURBS TO TOP OF SURFACE LIFT	0.13	0.18	0.24	0.30	0.33	0.36	0.43	0.49	—	—	—	—	
B: TOP OF CURBS TO TOP OF UPPER BASE LIFT	0.30	0.35	0.41	0.47	0.50	0.53	0.60	0.66	—	—	—	—	
C: TOP OF CURBS TO TOP OF LOWER BASE LIFT	0.47	0.52	0.60	0.68	0.71	0.75	0.83	0.90	0.98	1.00	1.01	—	
D: TOP OF CURBS TO TOP OF SUBGRADE	0.72	0.77	0.84	0.91	0.94	0.98	1.05	1.12	1.19	1.21	1.21	1.23	


COMBINED CURB & GUTTER

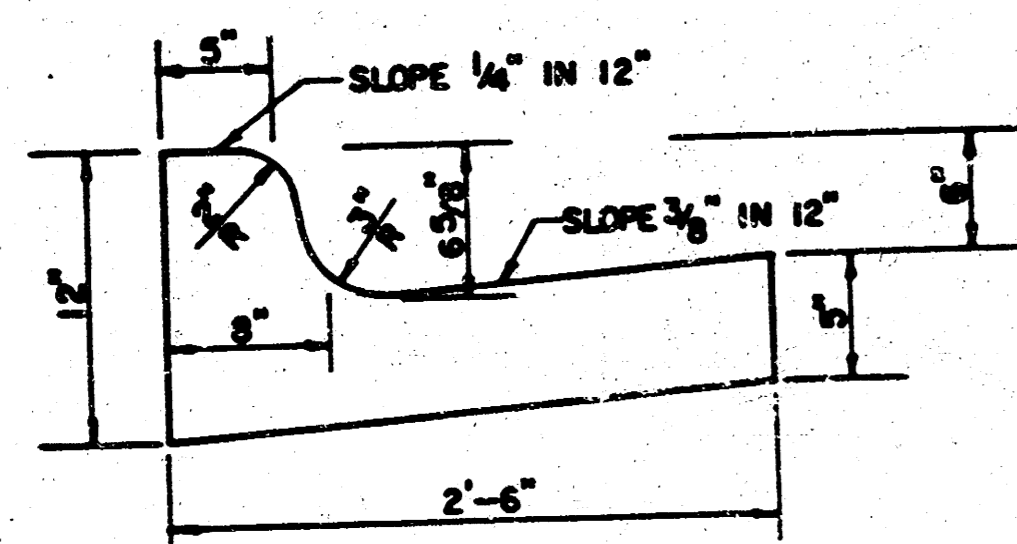

ROLL TYPE COMBINED CURB & GUTTER

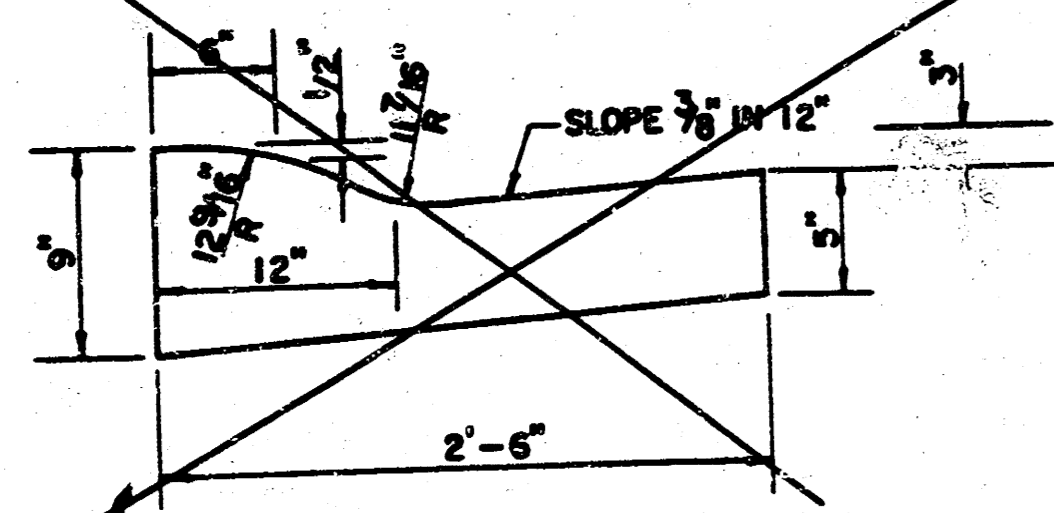

TRANSVERSE CONSTRUCTION JOINTS

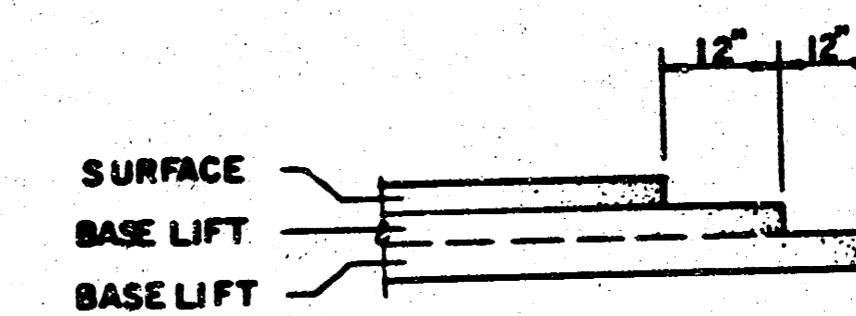

TRANSVERSE CONSTRUCTION JOINTS SHALL BE CONSTRUCTED IN FLEXIBLE BASE PAVEMENTS AT LOCATIONS WHERE PAVEMENT JOINS EXISTING FLEXIBLE BASE PAVEMENT AS SHOWN BY THE DETAIL. ALL COSTS ASSOCIATED WITH THE CONSTRUCTION OF THE TRANSVERSE JOINT SHALL BE INCLUDED IN THE BID PRICE FOR SQUARE YARDS 7" ASPHALTIC CONCRETE (5" BITUMINOUS BASE).


GENERAL NOTES

- 1) THE ASPHALTIC CONCRETE PAVEMENT BETWEEN THE COMBINED CURB AND GUTTER SHALL BE PAID AS SQUARE YARDS OF 7" ASPHALTIC CONCRETE (5" BITUMINOUS BASE).
- 2) THE BITUMINOUS BASE UNDER AND BEHIND THE COMBINED CURB AND GUTTER SHALL BE PAID AS SQUARE YARDS OF 2 1/2" BITUMINOUS BASE.
- 3) A TACK COAT OF EMULSIFIED ASPHALT (SC-1H OR CSS-1H) SHALL BE APPLIED AT AN APPROXIMATE RATE OF 0.05 GALLONS PER SQUARE YARD BETWEEN EACH LIFT OF ASPHALTIC MATERIAL.
- 4) BITUMINOUS BASE AND ASPHALTIC CONCRETE WEARING SURFACE SHALL BE PLACED WITH A LAYDOWN MACHINE HAVING AUTOMATIC CONTROLS FOR LINE AND GRADE.
- 5) CONSTRUCTION JOINTS IN EACH LIFT SHALL BE STAGGERED A MINIMUM DISTANCE OF ONE (1) FOOT FROM JOINTS IN PRECEDING LIFTS AND PLACED SO THAT A JOINT WILL BE CONSTRUCTED ON THE CENTERLINE OF THE TOP LIFT.
- 6) CONTRACTOR TO BID ONE SUBGRADE TREATMENT ALTERNATE WHEN ALTERNATES ARE PROVIDED IN THE PROPOSAL AND CONTRACT. THE ALTERNATE CHOSEN BY THE SUCCESSFUL BIDDER SHALL BE USED IN CONSTRUCTING THIS PROJECT.

7 INCH RESIDENTIAL ASPHALTIC CONCRETE PAVEMENT WITH 5 INCH BITUMINOUS BASE
CITY OF WICHITA, KANSAS
PROJECT NUMBER 4/9

FILMED FROM THE BEST AVAILABLE COPY


PROJECT NO.	SHEET NO.	TOTAL SHEETS
	5	9

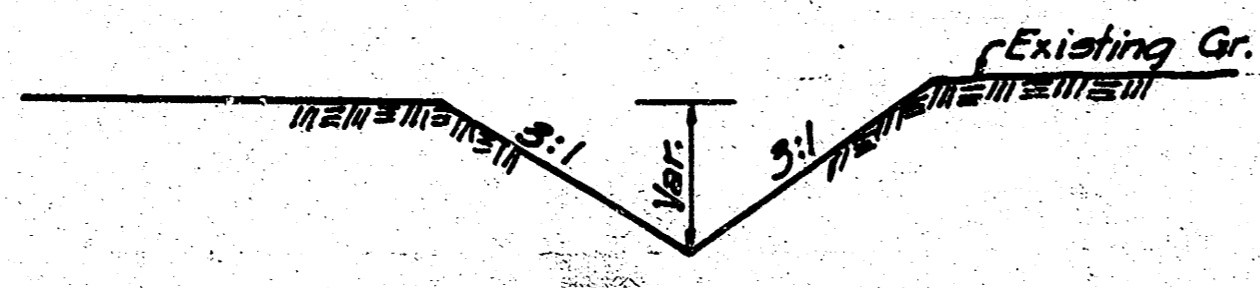

"V" DITCH DETAIL

Scale: 1" = 20'

Contractor to Construct 246' ± "V" Ditch @ 0.10% See Detail this sheet

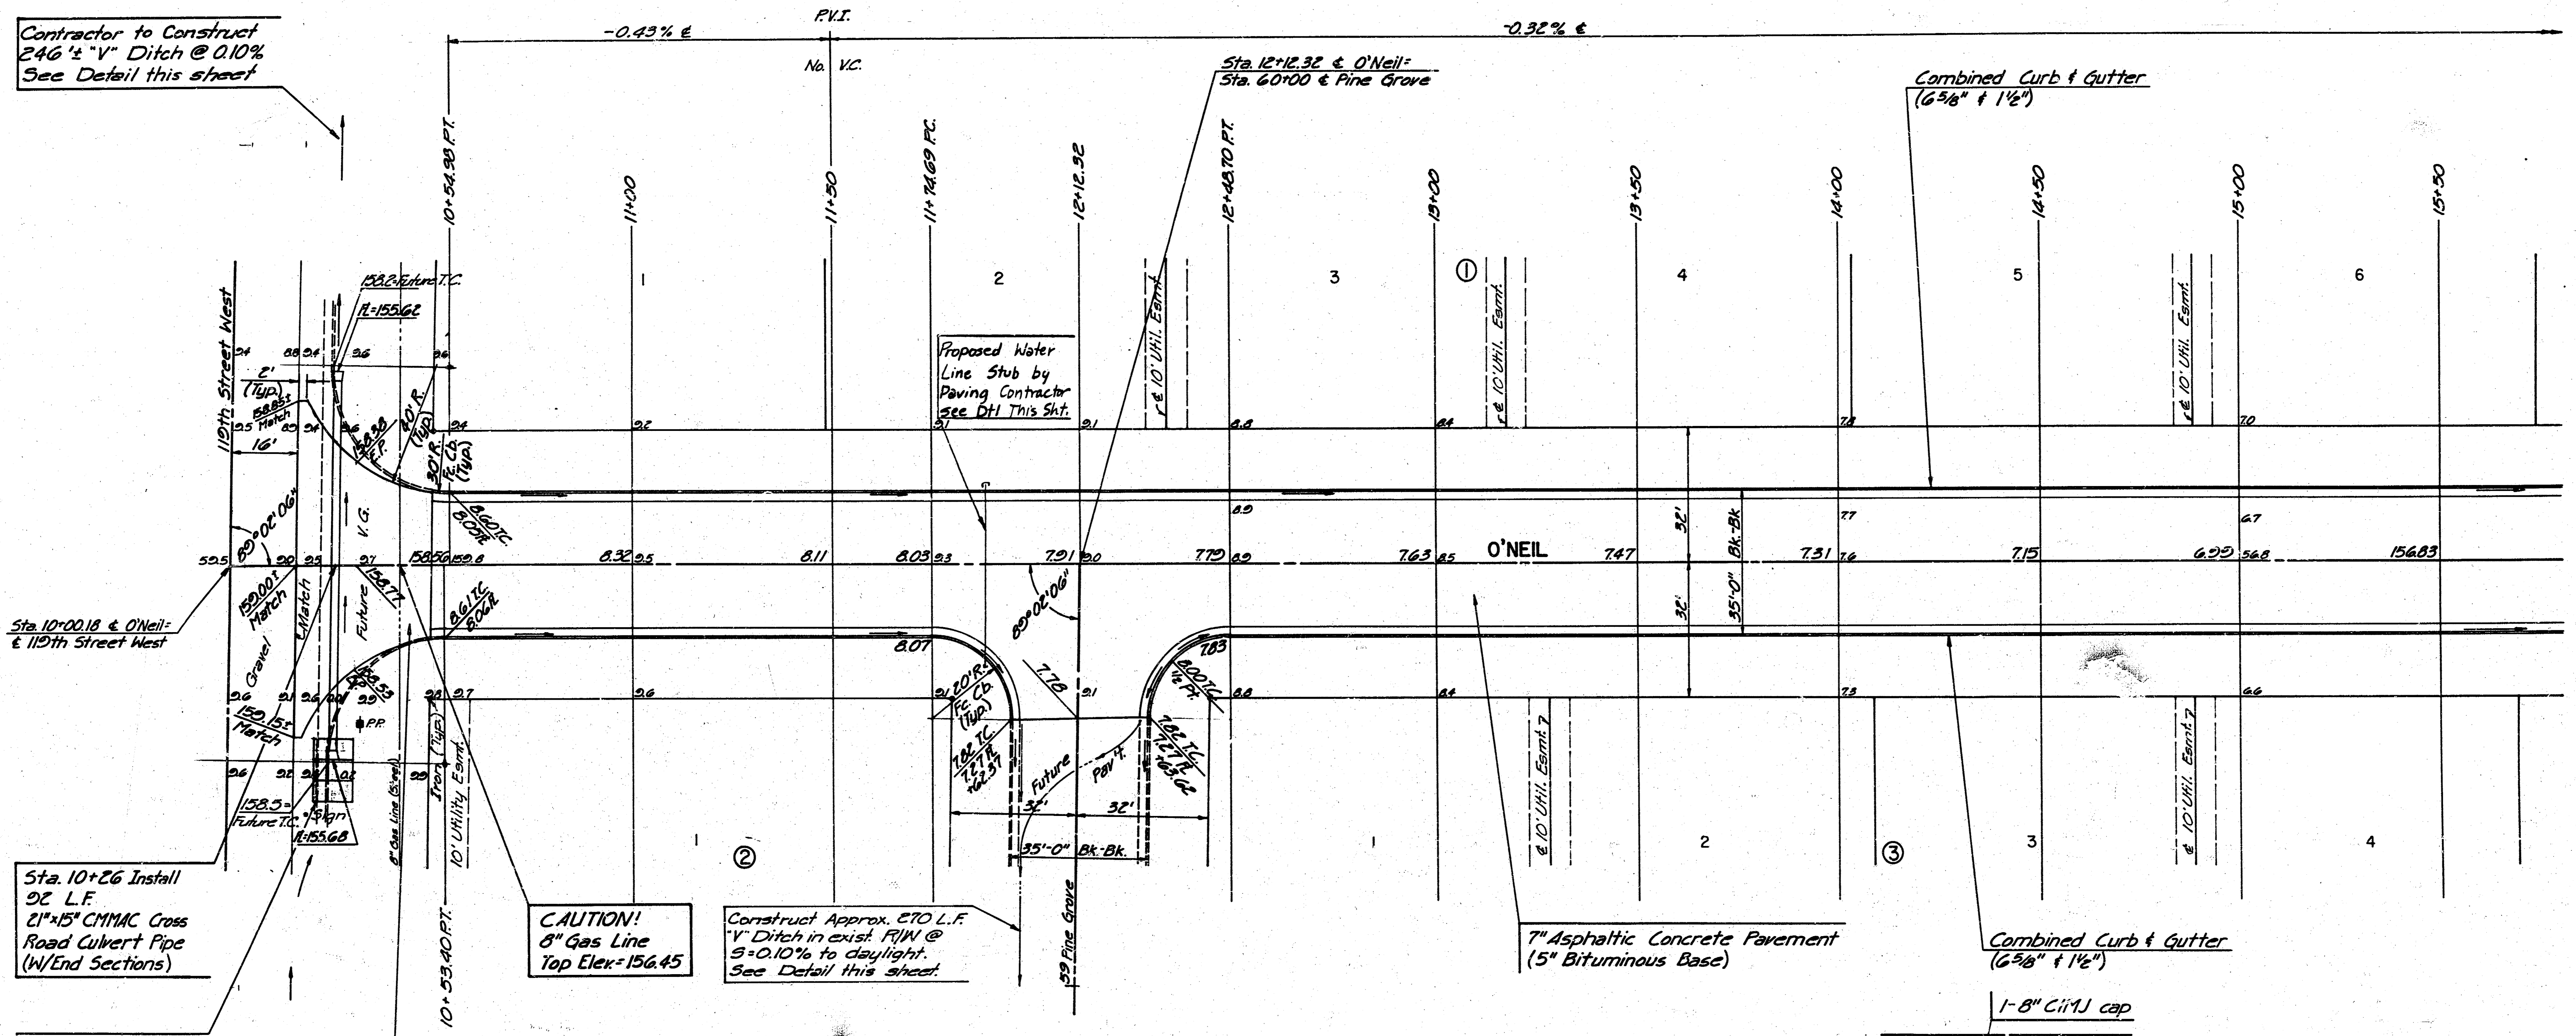


Sta. 10+26 Install 22' L.F. 21" x 15" CMMAC Cross Road Culvert Pipe (W/End Sections)

Install Light stone riprap See details this sheet.


Install 187.6 Sq. Yds. 6" Temporary Asphaltic Concrete Pavement (4" Bituminous Base)

CAUTION! 8" Gas Line Top Elev=156.45


Construct Approx. 270 L.F. "V" Ditch in exist. R/W @ S=0.10% to daylight. See Detail this sheet.

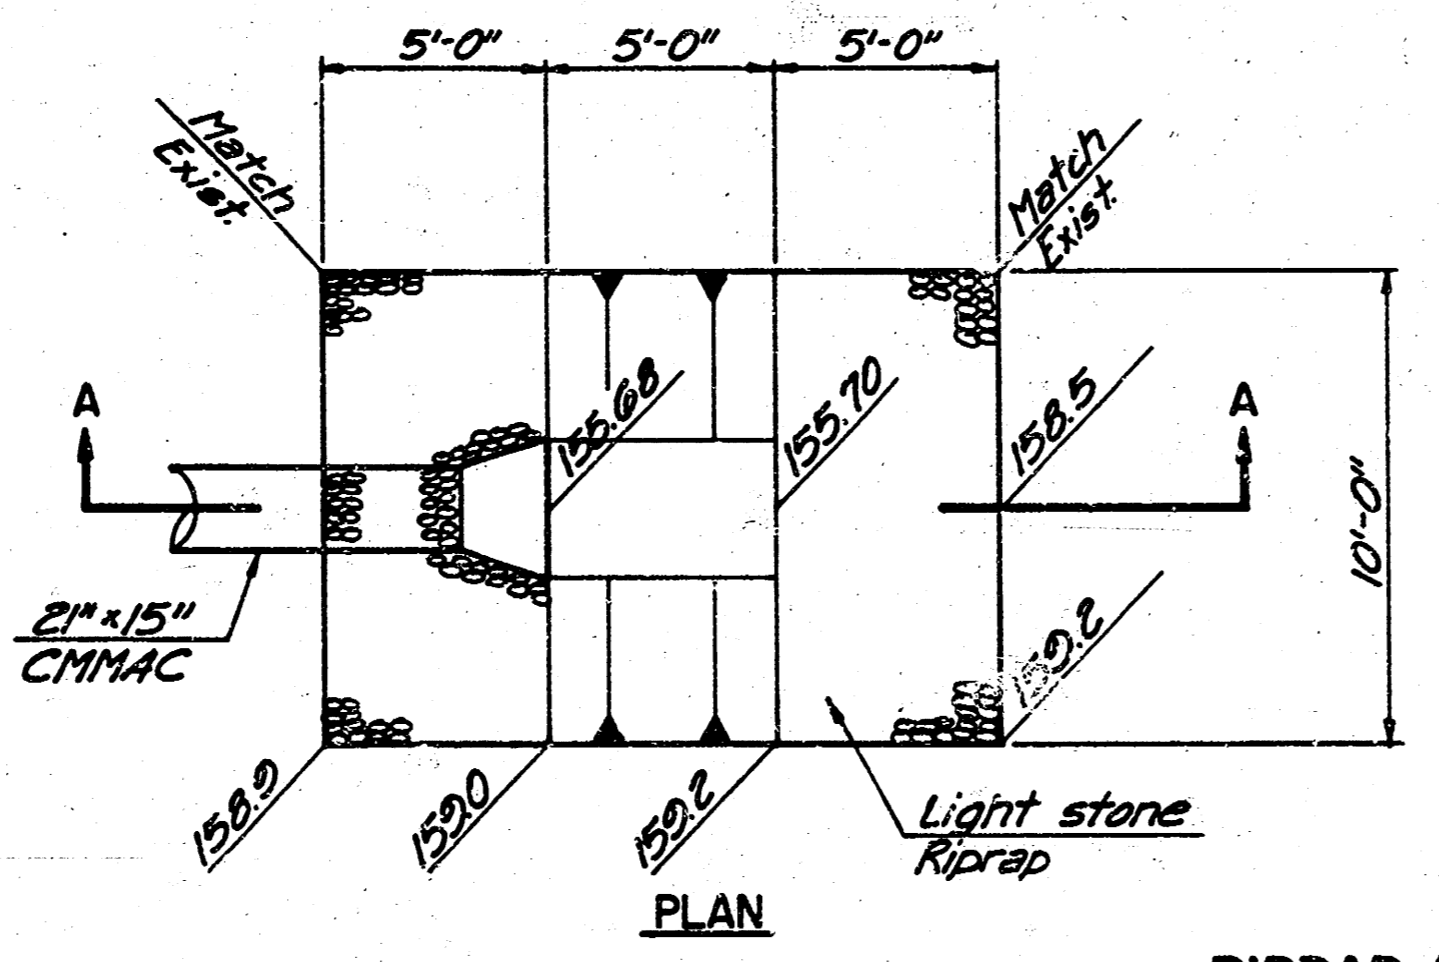

RIPRAP DETAILS

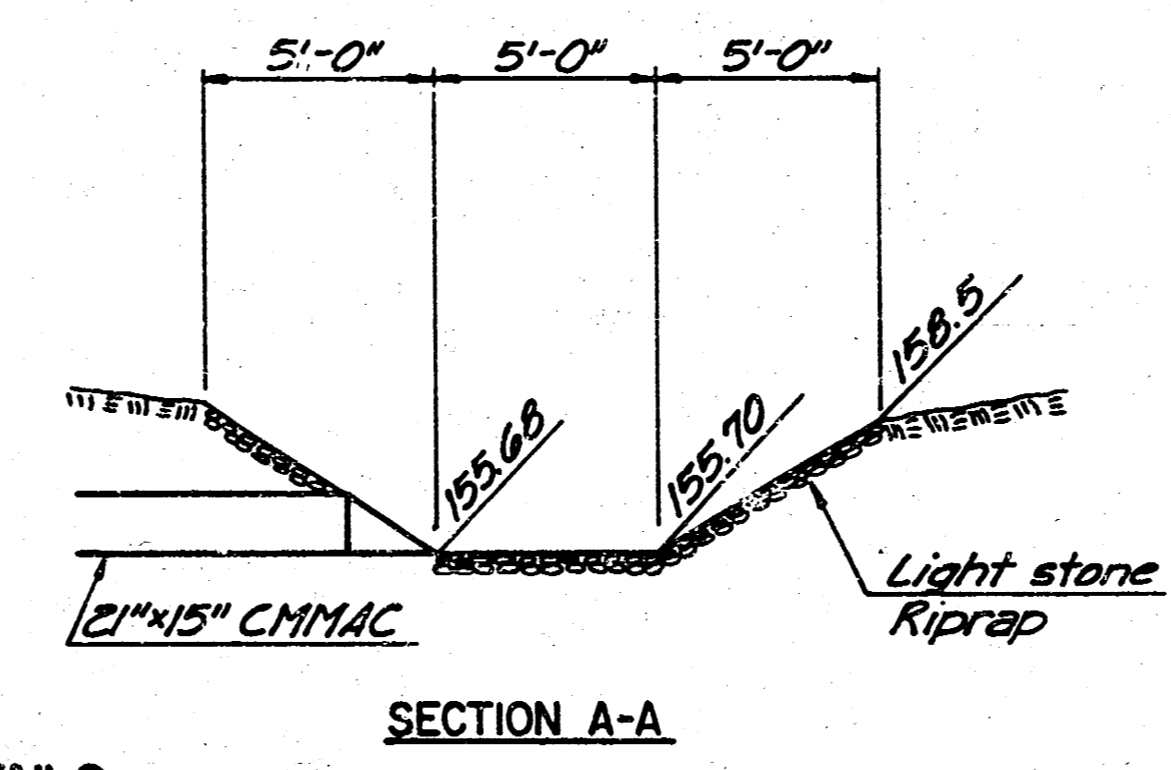

SECTION A-A

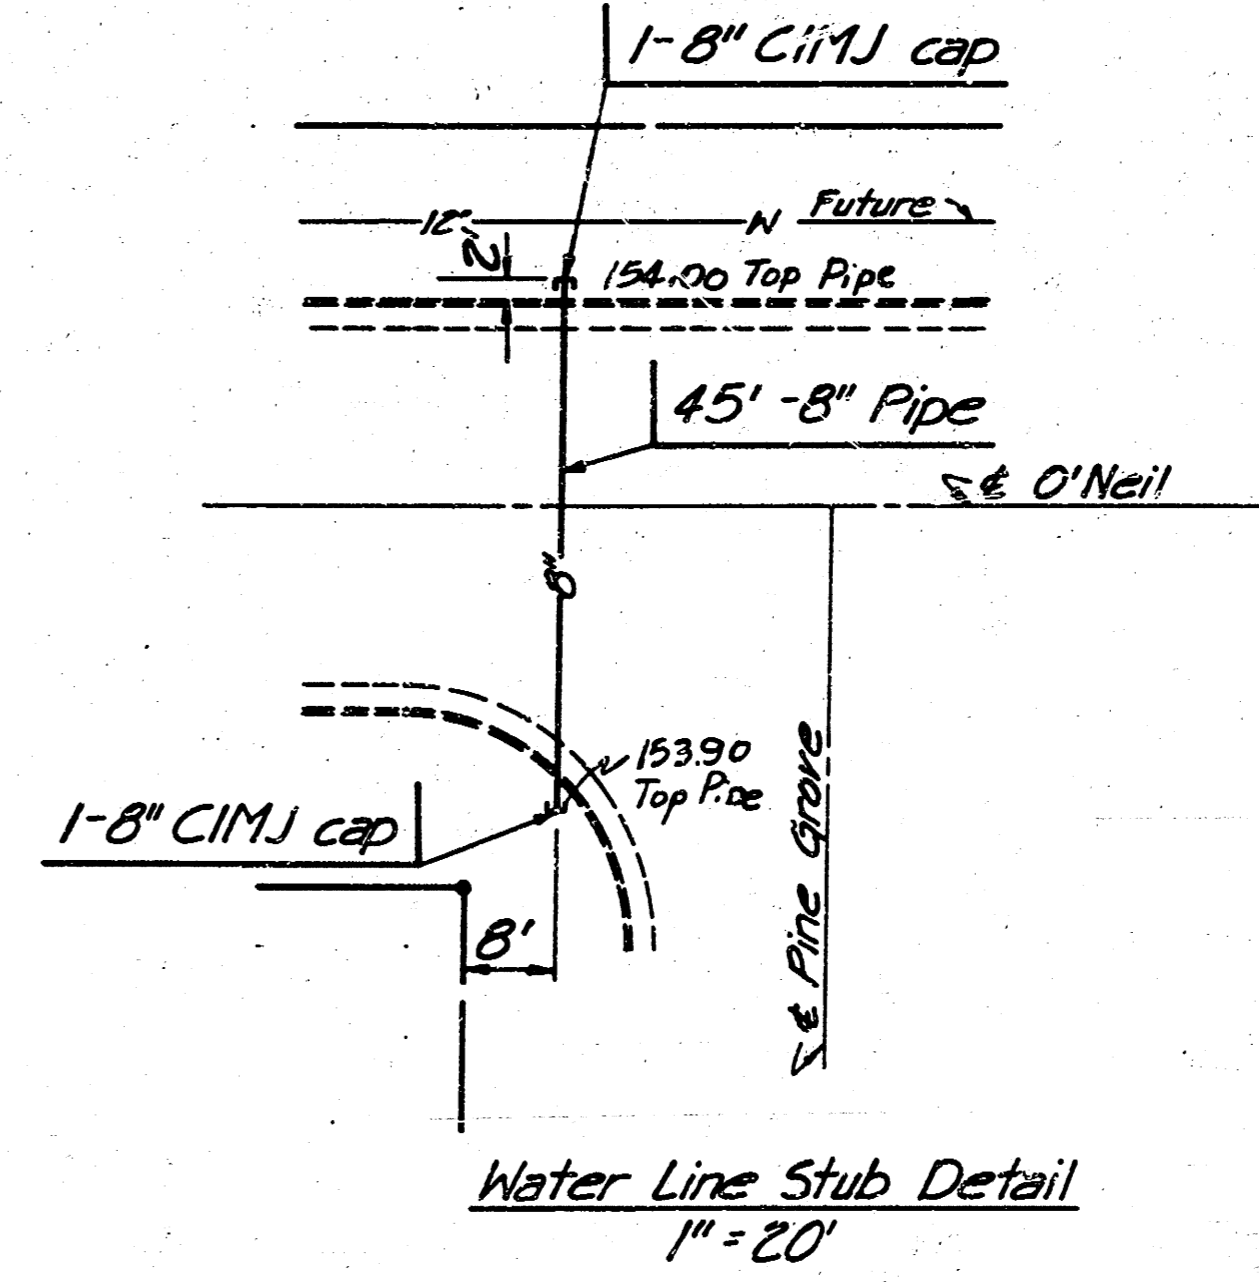

Water Line Stub Detail 1" = 20'


O' NEIL
STA. 10+00.18 TO STA. 15+50.00

PROFESSIONAL ENGINEERING CONSULTANTS, P.A.
ENGINEERS
WICHITA, KANSAS

Designed by	CSB	Checked by	S/9
Drawn by	GDD, BS	Date	Dec, 1986
		Job No.	86563

FILMED FROM THE BEST AVAILABLE COPY

PROJECT NO.	SHEET NO.	TOTAL SHEETS
	6	9

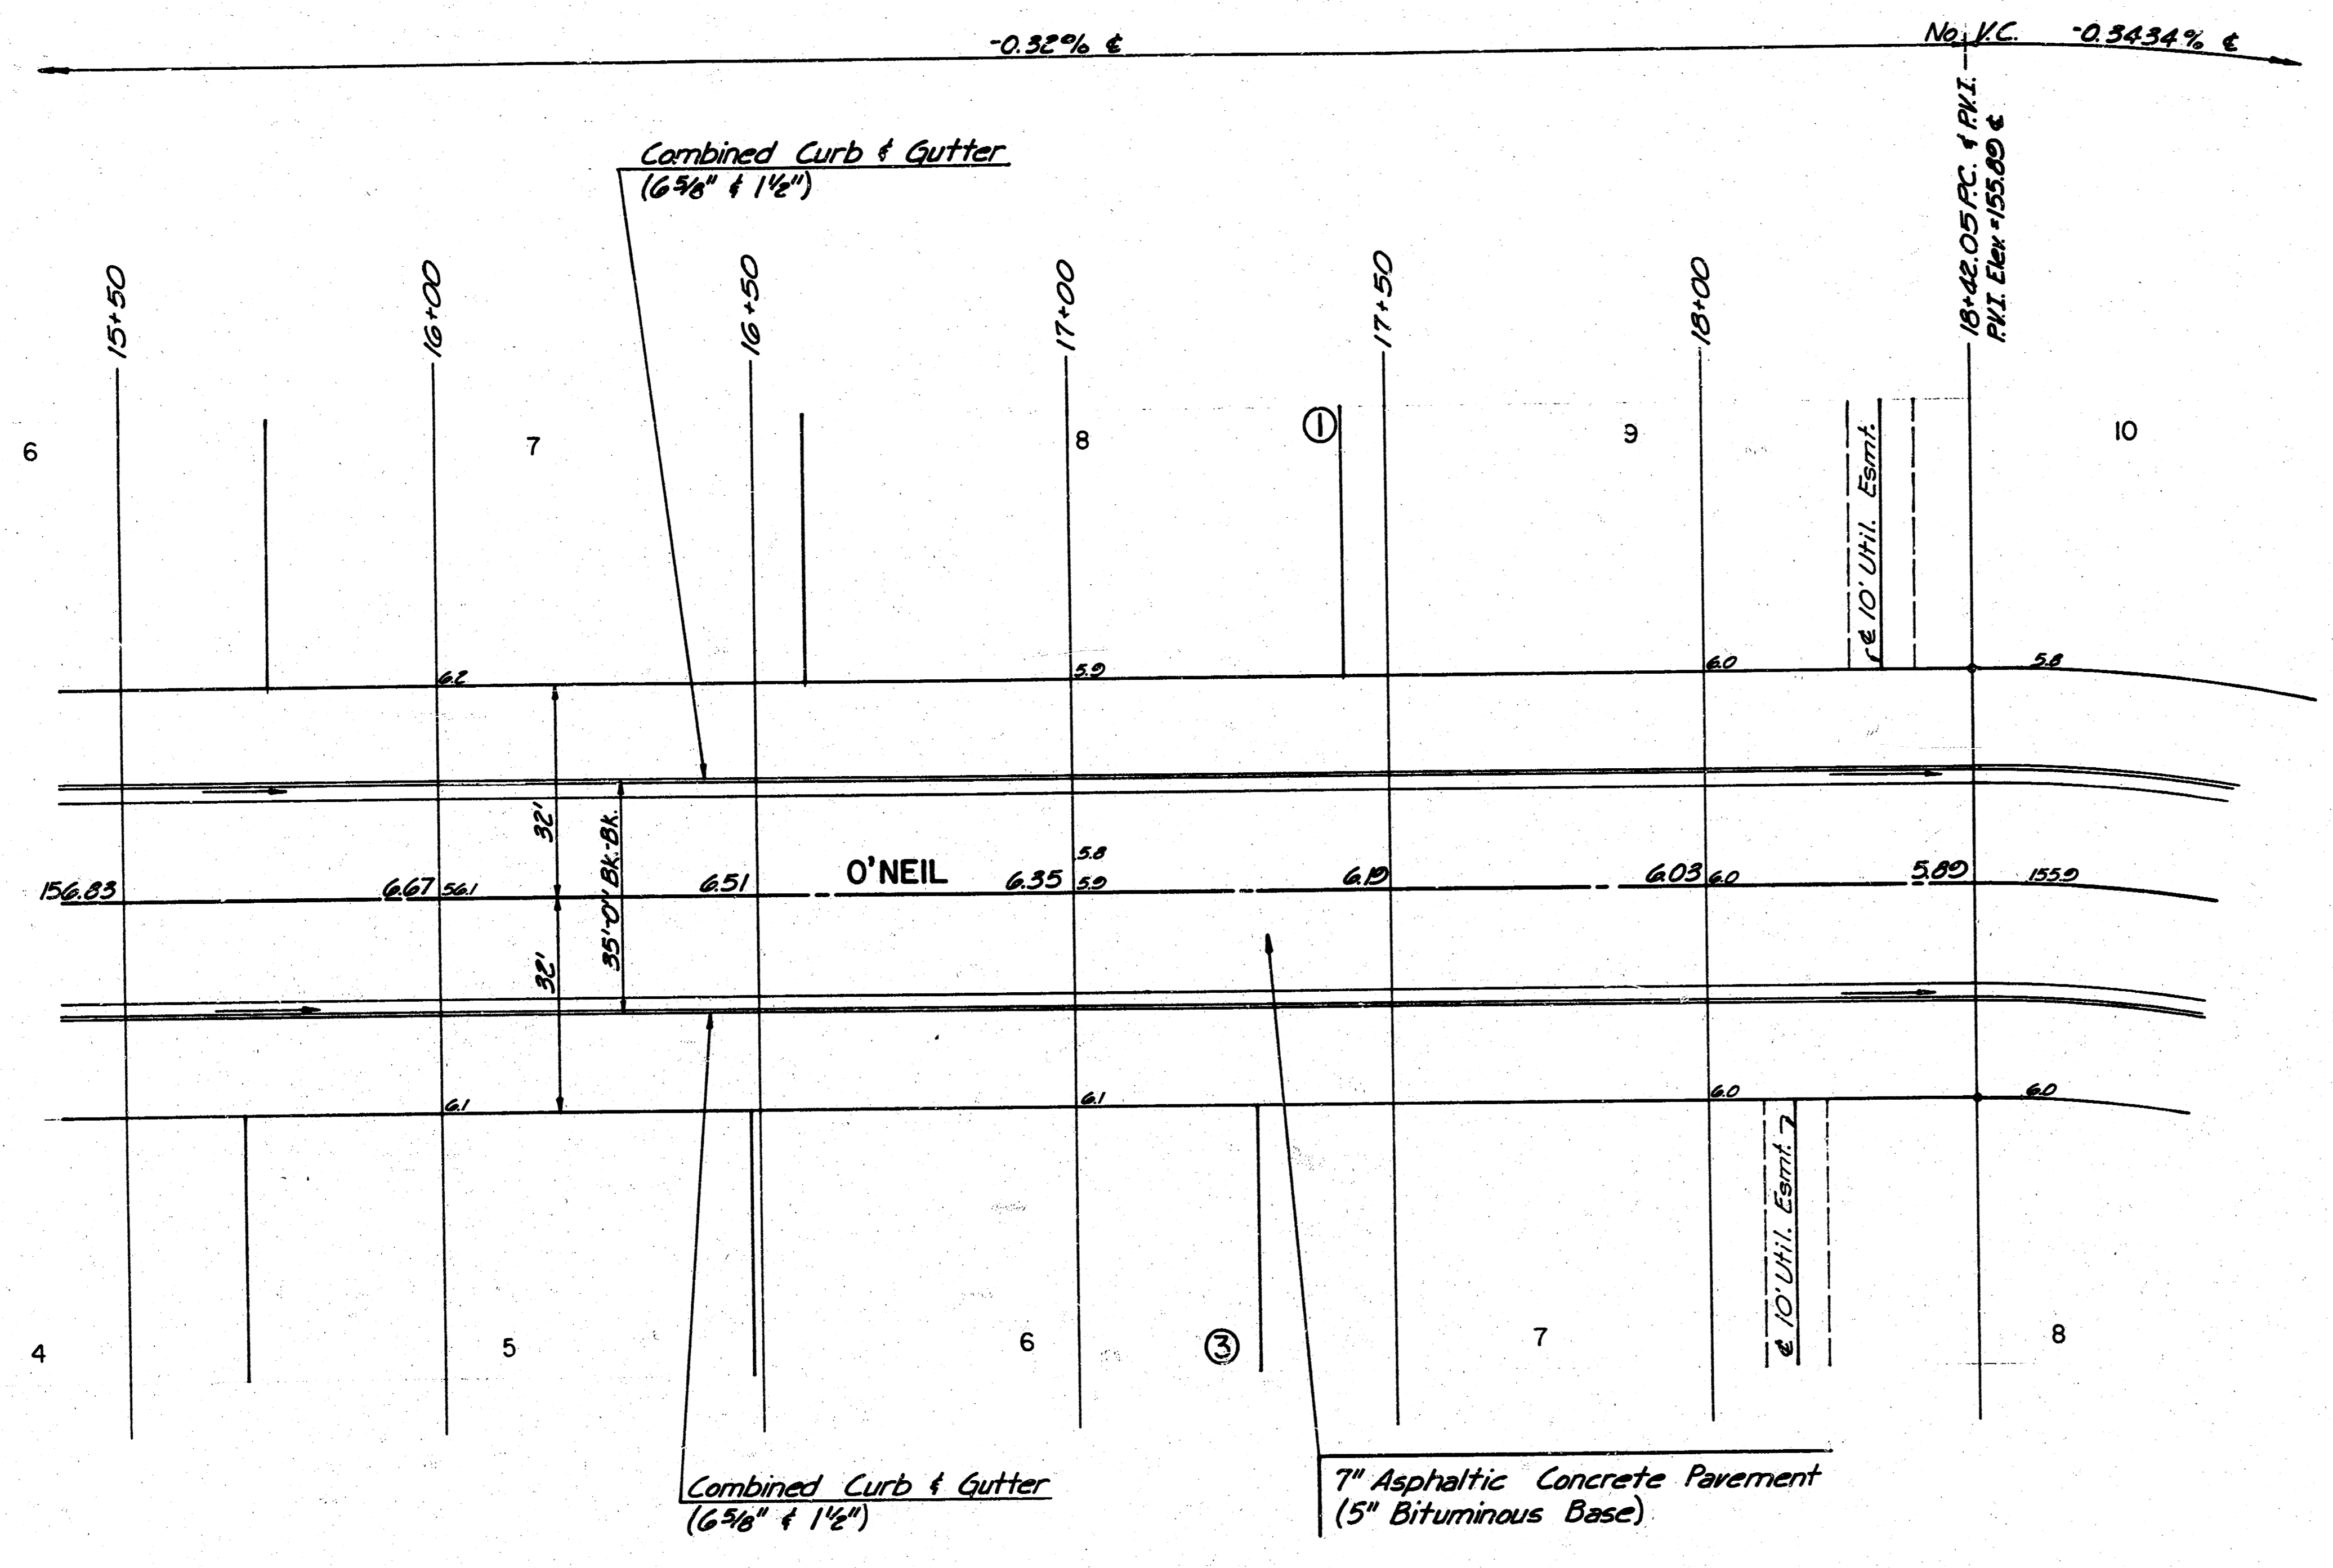


O' NEIL
STA. 15+50.00 TO STA. 18+42.05

PROFESSIONAL ENGINEERING CONSULTANTS, P.A.
ENGINEERS
WICHITA, KANSAS

Designed by <u>CSB</u>	Checked by <u>6/9</u>
Drawn by <u>GDD, BS</u>	Date <u>Dec. 1986</u> Job No. <u>86568</u>

FILMED FROM THE BEST AVAILABLE COPY

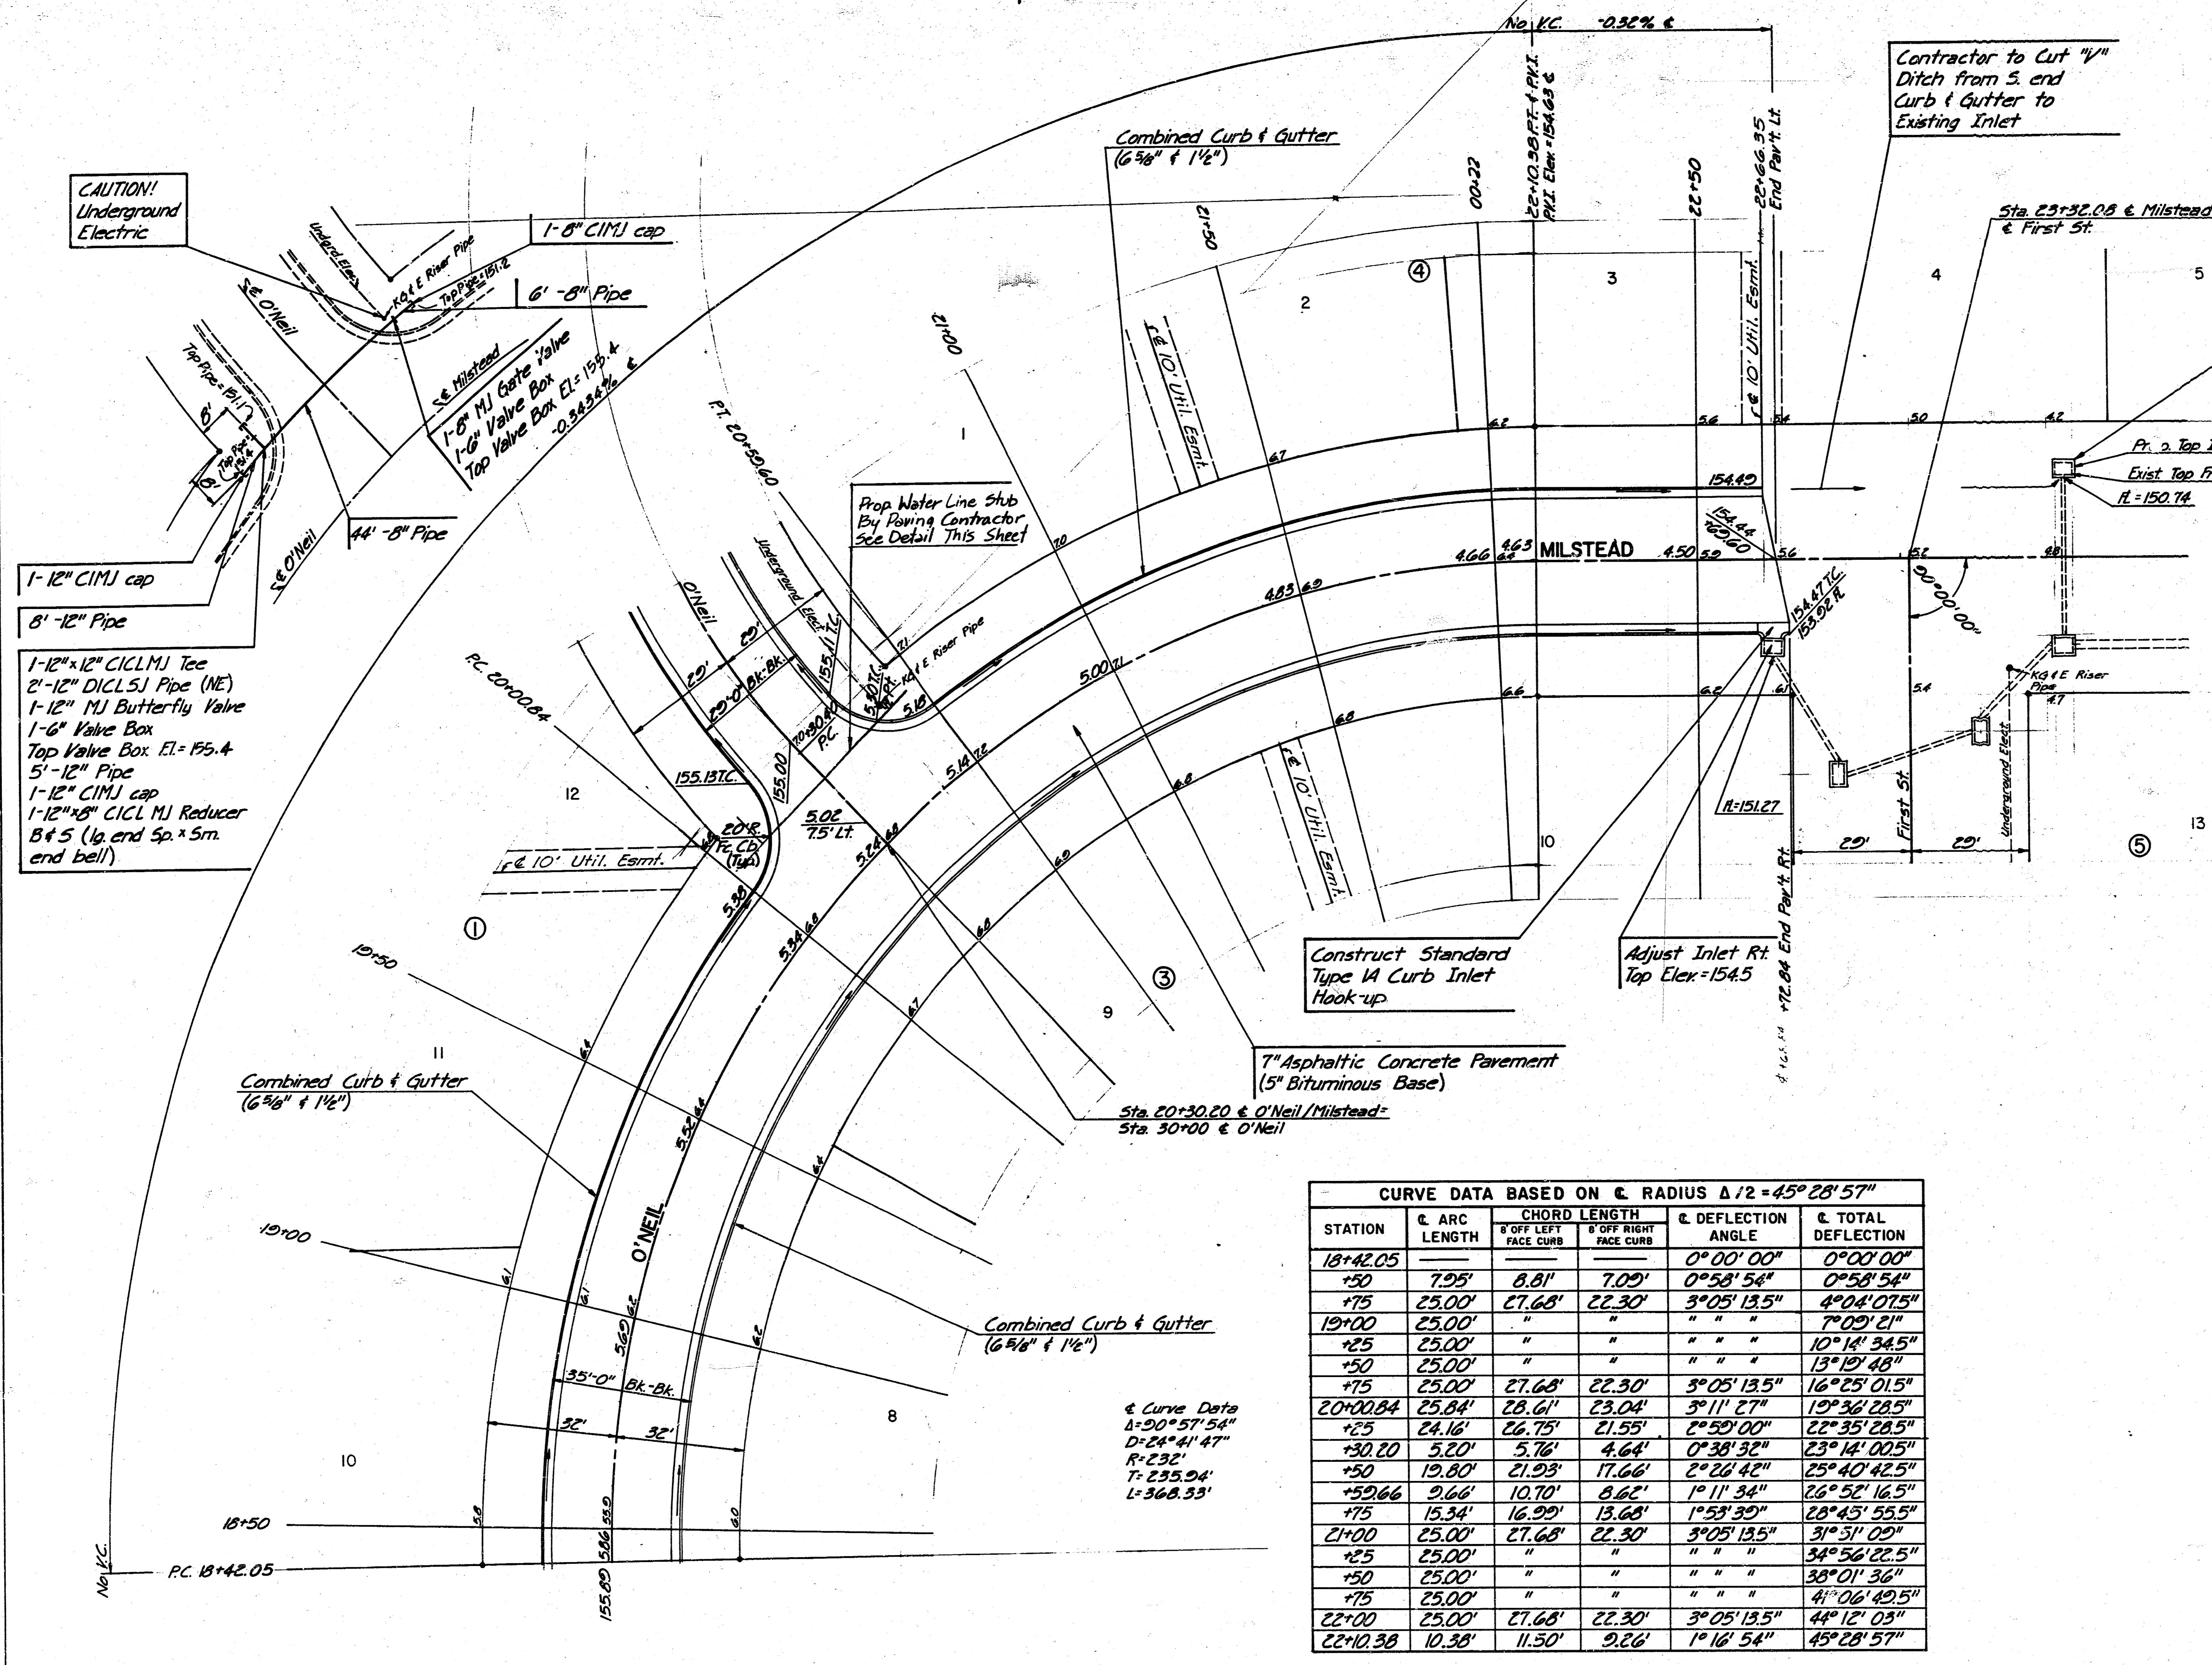

CAUTION!
Underground
Electric

1-12" CIMJ cap
8'-12" Pipe

1-12" x 12" CICALMJ Tee
2'-12" DICLSJ Pipe (NE)
1-12" MJ Butterfly Valve
1-6" Valve Box
Top Valve Box El. = 155.4
5'-12" Pipe
1-12" CIMJ cap
1-12" x 18" CICALMJ Reducer
B x 5 (lg. end Sp. x Sm. end bell)

CURVE DATA BASED ON RADIUS Δ/2 = 45° 28' 57"

STATION	ARC LENGTH	CHORD LENGTH	OFF LEFT FACE CURB	OFF RIGHT FACE CURB	DEFLECTION ANGLE	TOTAL DEFLECTION
18+42.05					0° 00' 00"	0° 00' 00"
+50	7.95'	8.81'	7.09'		0° 58' 54"	0° 58' 54"
+75	25.00'	27.68'	22.30'		3° 05' 13.5"	4° 04' 07.5"
19+00	25.00'	"	"		"	7° 09' 21"
+25	25.00'	"	"		"	10° 14' 34.5"
+50	25.00'	"	"		"	13° 19' 48"
+75	25.00'	27.68'	22.30'		3° 05' 13.5"	16° 25' 01.5"
20+00.84	25.84'	28.61'	23.04'		3° 11' 27"	19° 36' 28.5"
+25	24.16'	26.75'	21.55'		2° 59' 00"	22° 35' 28.5"
+30.20	5.20'	5.76'	4.64'		0° 38' 32"	23° 14' 00.5"
+50	19.80'	21.93'	17.66'		2° 28' 42"	25° 40' 42.5"
+52.66	9.66'	10.70'	8.62'		1° 11' 34"	26° 52' 16.5"
+75	15.34'	16.99'	13.68'		1° 53' 30"	28° 45' 55.5"
21+00	25.00'	27.68'	22.30'		3° 05' 13.5"	31° 51' 09"
+25	25.00'	"	"		"	34° 56' 22.5"
+50	25.00'	"	"		"	38° 01' 36"
+75	25.00'	"	"		"	41° 06' 49.5"
22+00	25.00'	27.68'	22.30'		3° 05' 13.5"	44° 12' 03"
22+10.38	10.38'	11.50'	9.26'		1° 16' 54"	45° 28' 57"

Curve Data
Δ = 90° 57' 54"
D = 24' 41' 47"
R = 232'
T = 235.94'
L = 368.33'


O'NEIL / MILSTEAD
STA. 18+42.05 TO STA. 22+72.84

PROFESSIONAL ENGINEERING CONSULTANTS, P.A.
ENGINEERS
WICHITA, KANSAS


Designed by: CSB
Checked by: []
Drawn by: GDD, BS
Date: Dec., 1986
Job No. 86568

FILMED FROM THE BEST AVAILABLE COPY

PROJECT NO.	SHEET NO.	TOTAL SHEETS
	8	9

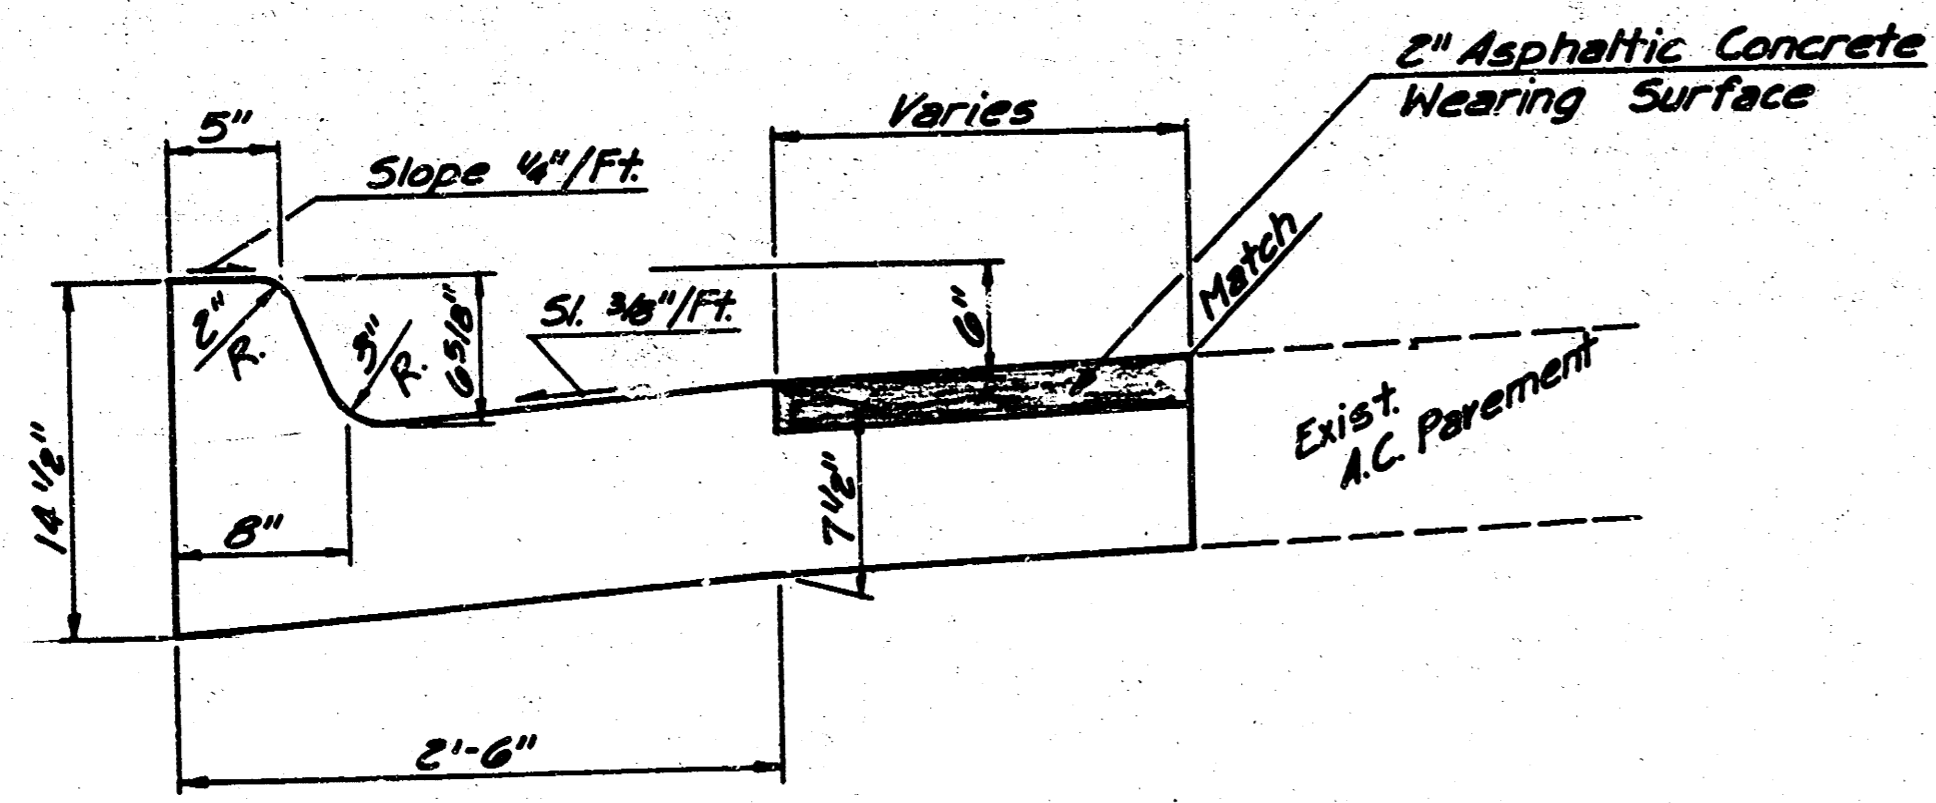

COMBINED CURB & GUTTER (SPECIAL)

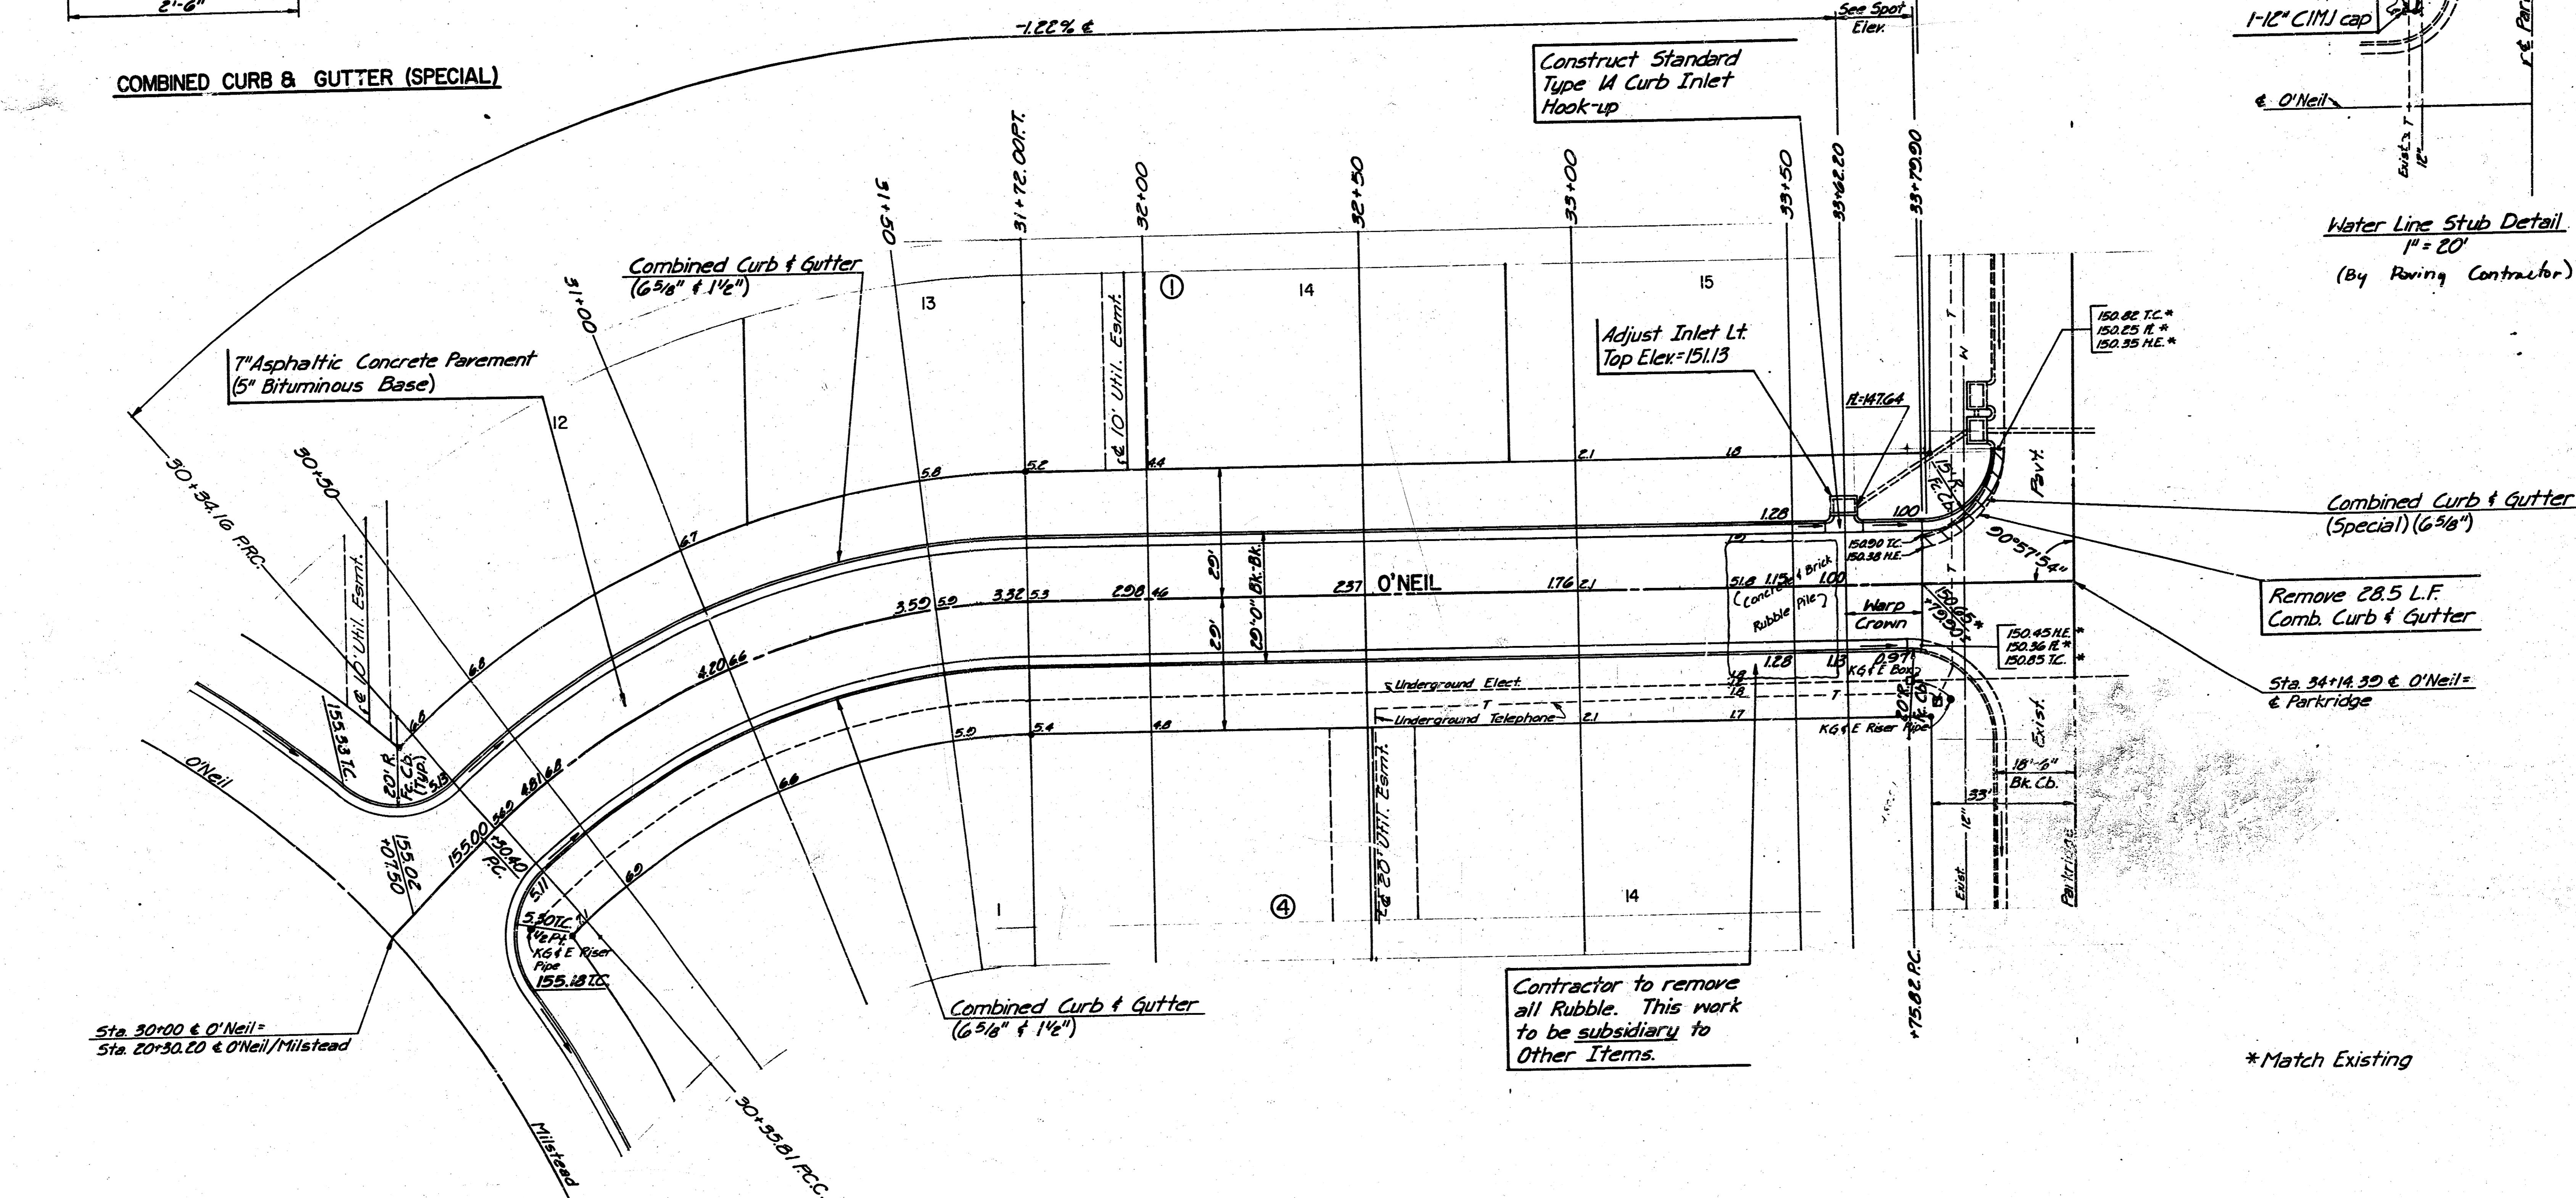

CAUTION!
Underground Telephone

Valve No. 19360
Verify location, add 12" pipe (W) to clear new pavement as required & cap.

Water Line Stub Detail
1" = 20'
(By Roving Contractor)

Combined Curb & Gutter (Special) (6 3/8")

Remove 28.5 L.F. Comb. Curb & Gutter

Sta. 34+14.39 @ O'Neil & Parkridge

Contractor to remove all Rubble. This work to be subsidiary to Other Items.

*Match Existing

Sta. 30+00 @ O'Neil
Sta. 20+30.20 @ O'Neil/Milstead

Curve Data
Δ = 43° 32' 06"
D = 30° 44' 47"
R = 104.35'
T = 14.41'
L = 141.50'





STATION	C ARC LENGTH	CHORD LENGTH		C DEFLECTION ANGLE	C TOTAL DEFLECTION
		OFF LEFT FACE CURB	OFF RIGHT FACE CURB		
30+30.40				0°00'00"	0°00'00"
+34.16	3.76'	4.21'	3.31'	0°34'40"	0°34'40"
+35.81	1.65'	1.85'	1.45'	0°15'13"	0°49'53"
+50	14.12'	15.86'	12.51'	2°10'53"	5°00'47"
+75	25.00'	27.23'	22.03'	3°50'35.5"	6°51'22.5"
31+00	25.00'	"	"	"	10°41'58"
+25	25.00'	"	"	"	14°32'33.5"
+50	25.00'	27.23'	22.03'	3°50'35.5"	18°23'08"
31+72.00	22.00'	24.52'	19.40'	3°22'55"	21°46'03"

O' NEIL
STA. 30+00.00 TO STA. 34+14.39

PROFESSIONAL ENGINEERING CONSULTANTS, P.A.
ENGINEERS
WICHITA, KANSAS



Designed by *CSB* Checked by _____
Drawn by *GDD, BS* Date *Dec. 1986* Job No. *86568*

FILED FROM THE BEST AVAILABLE COPY

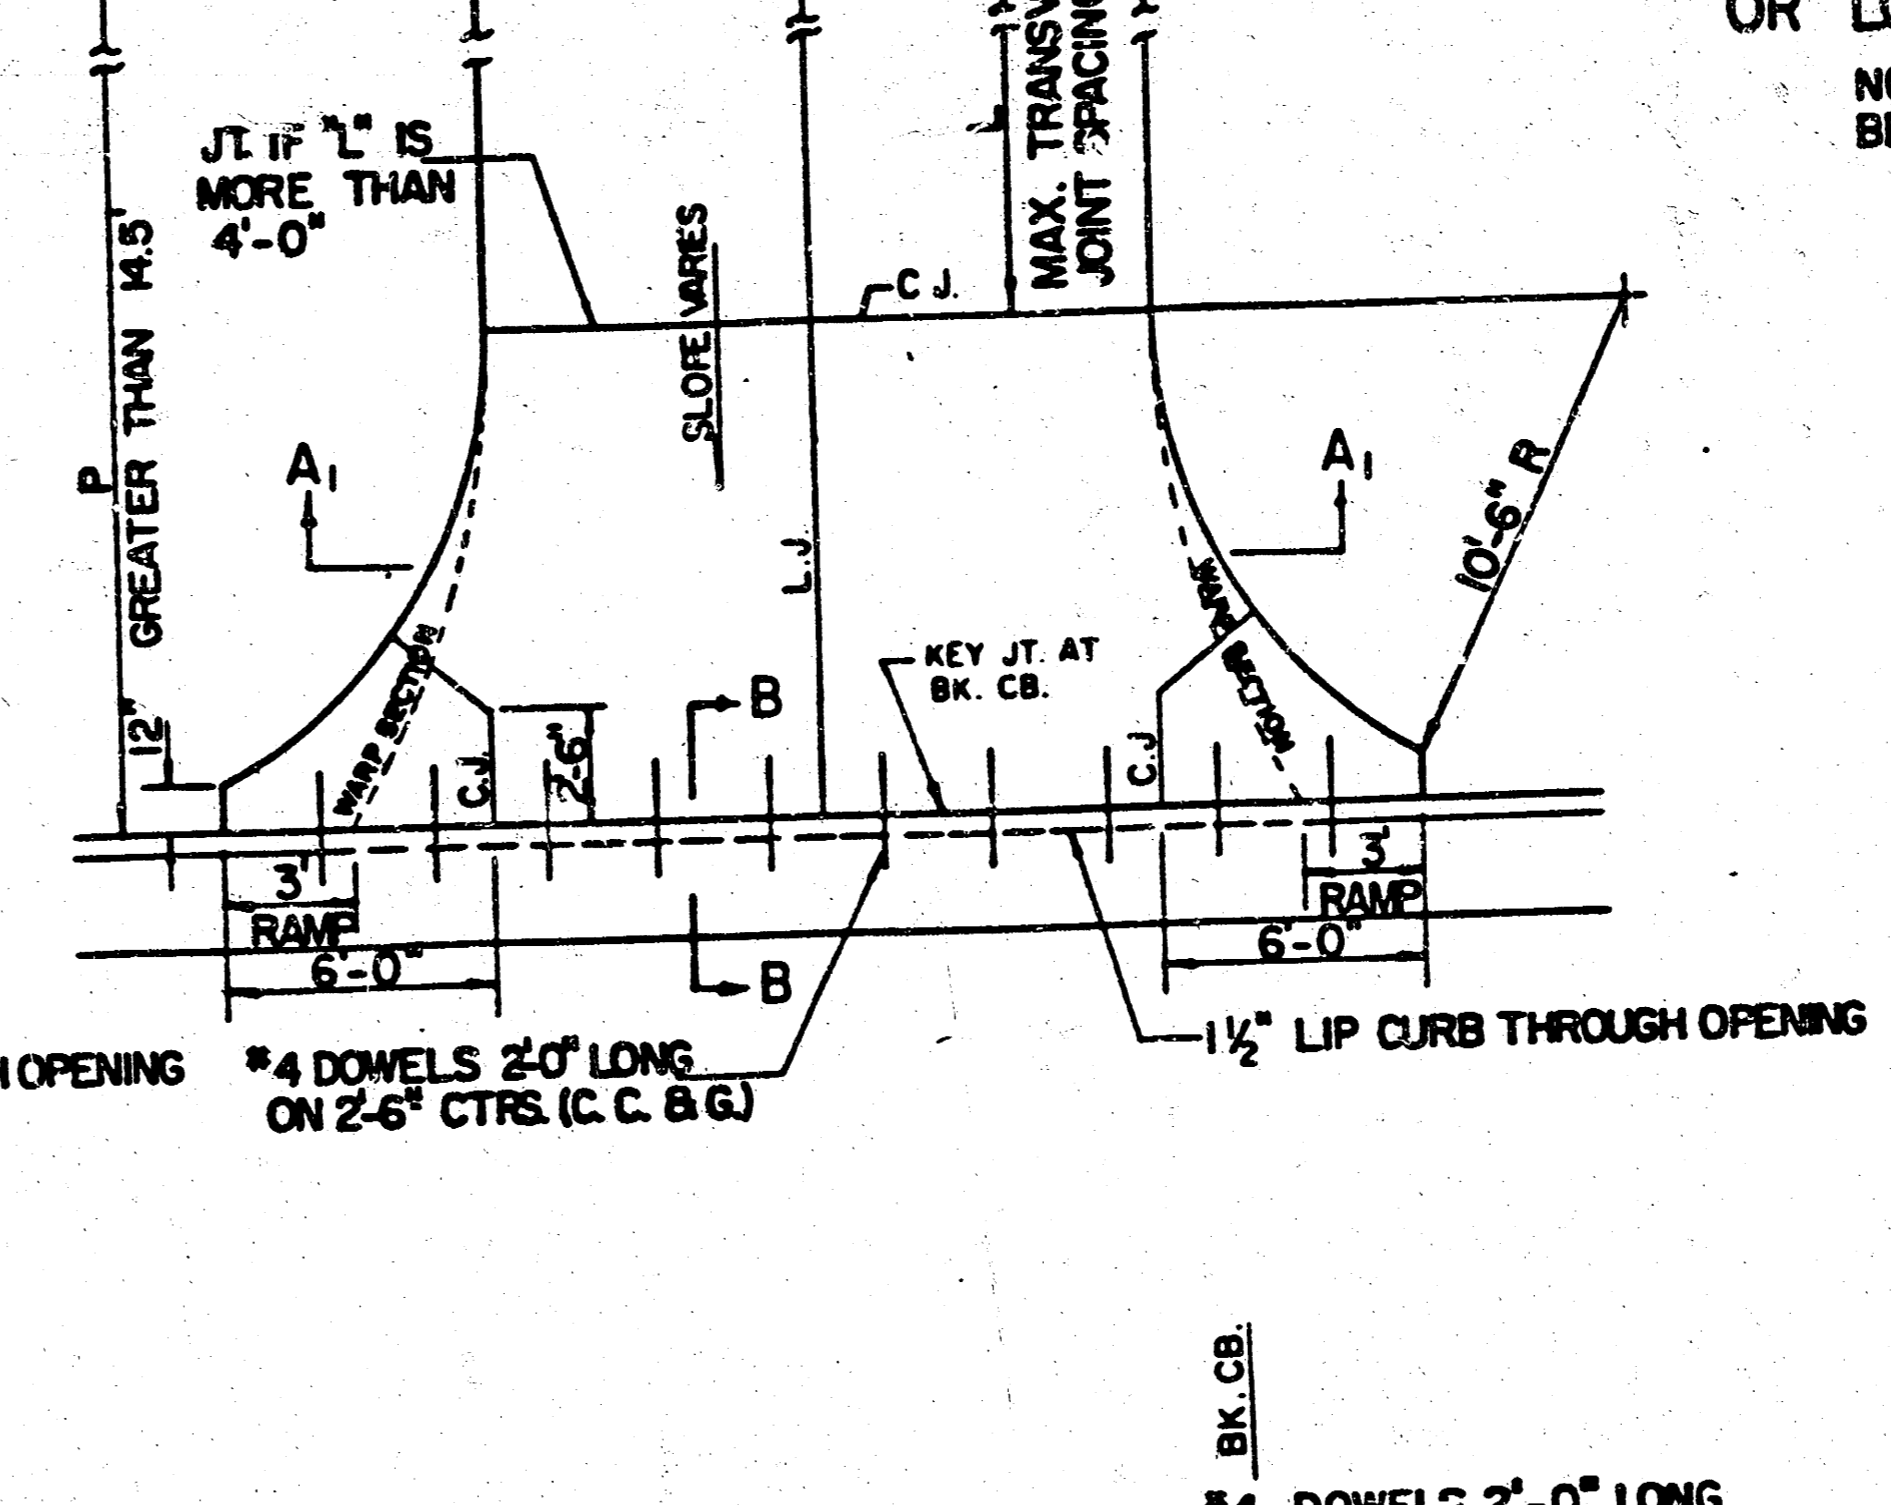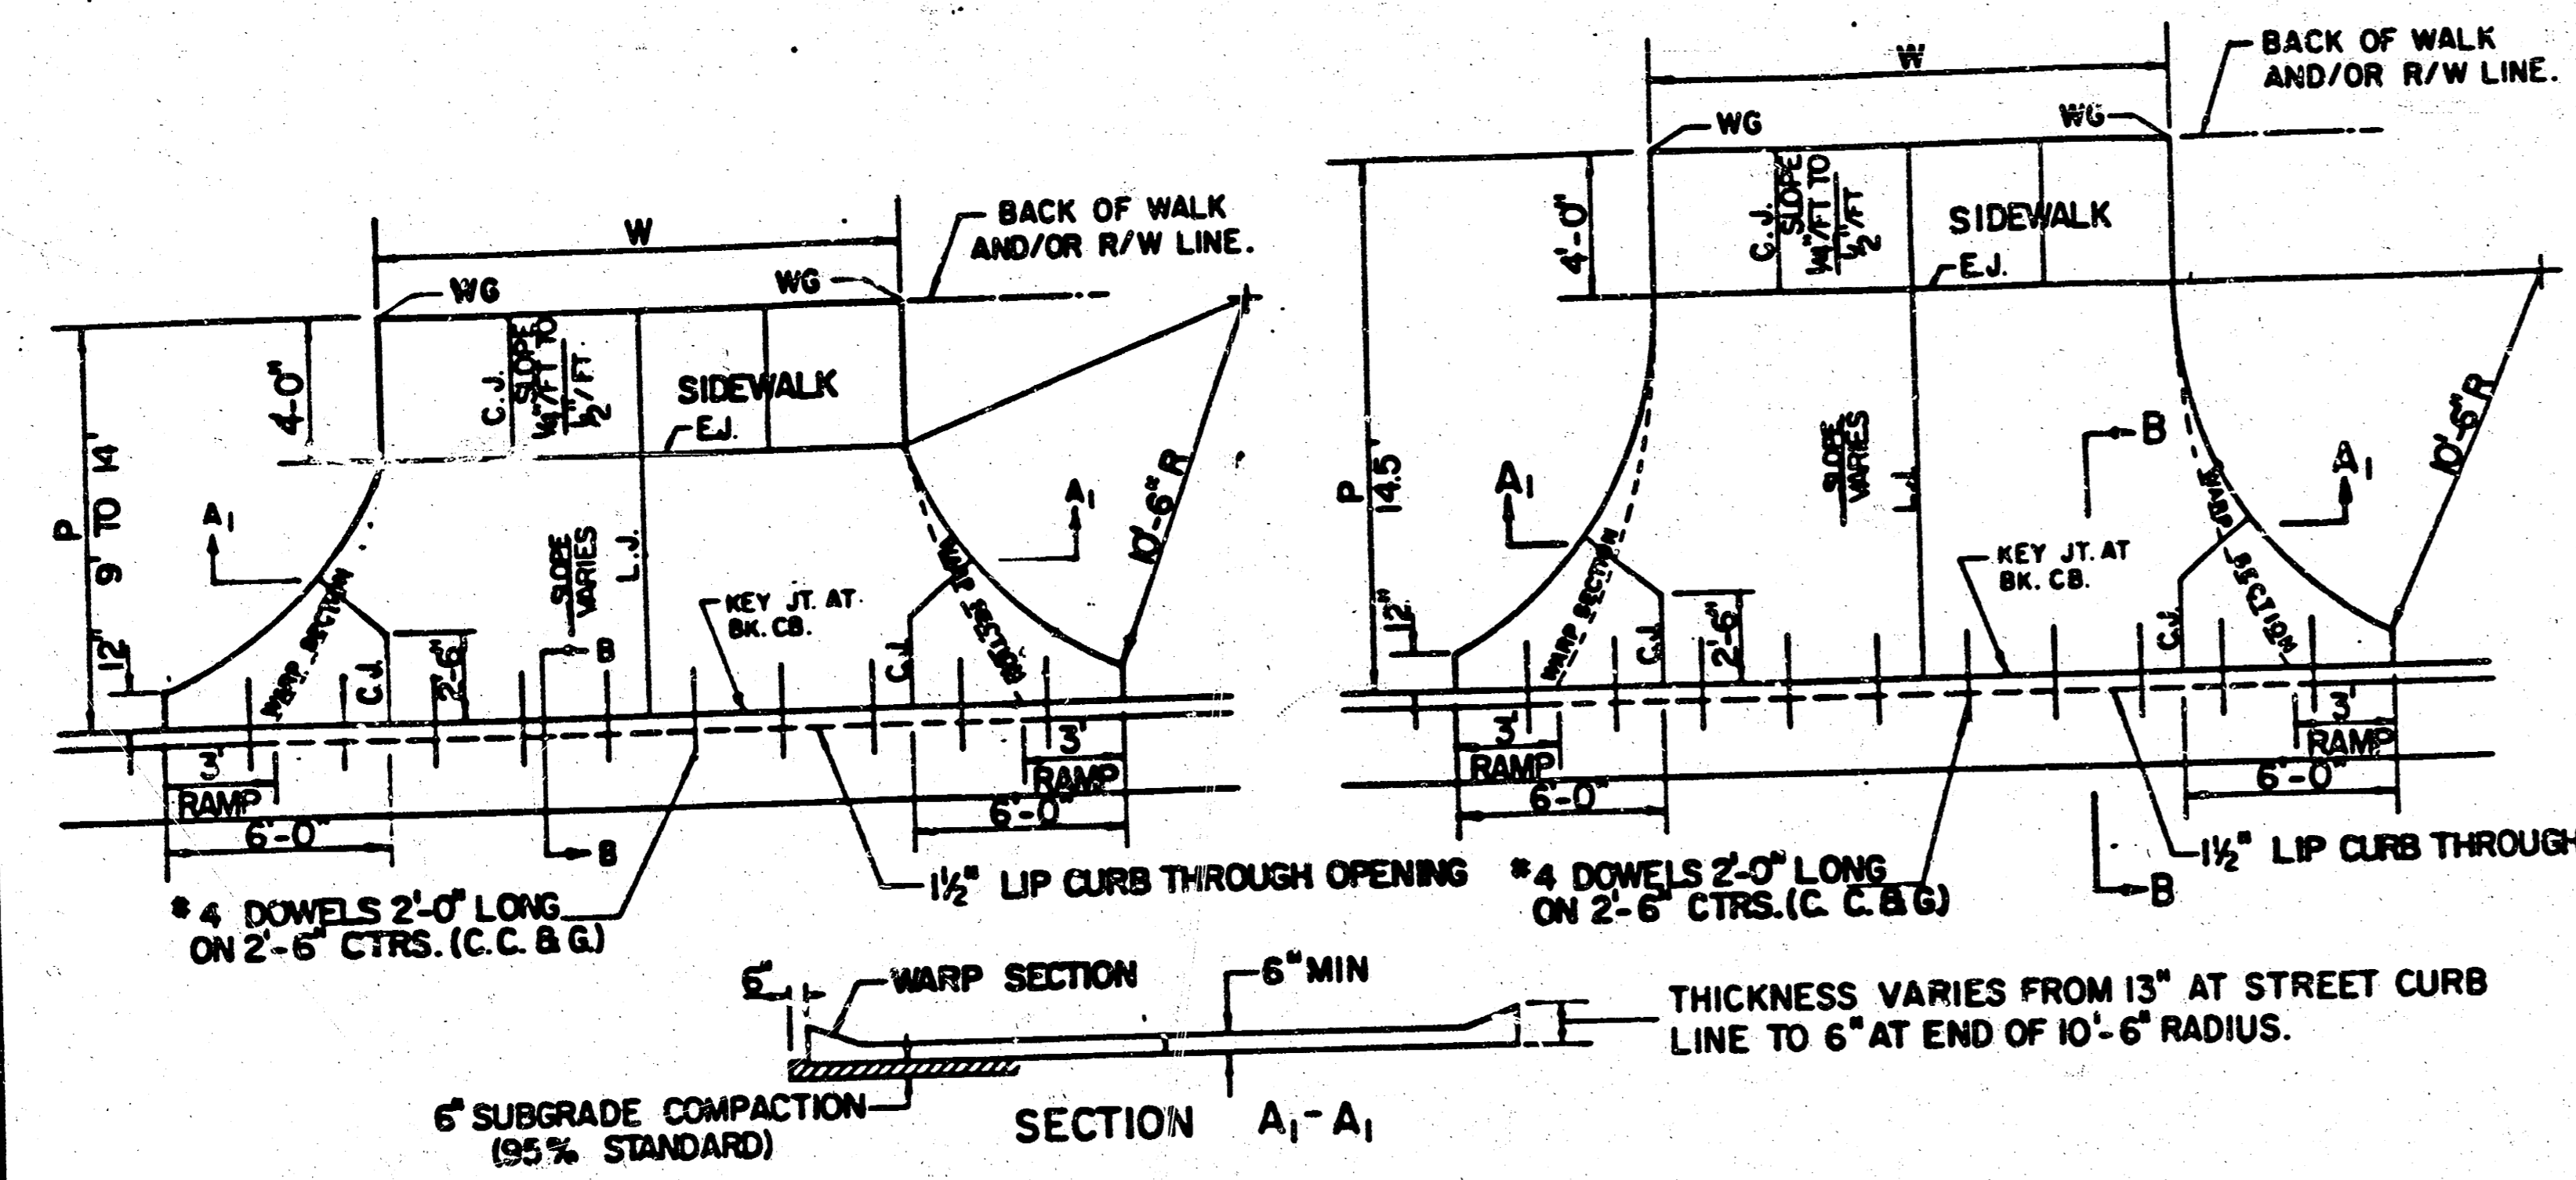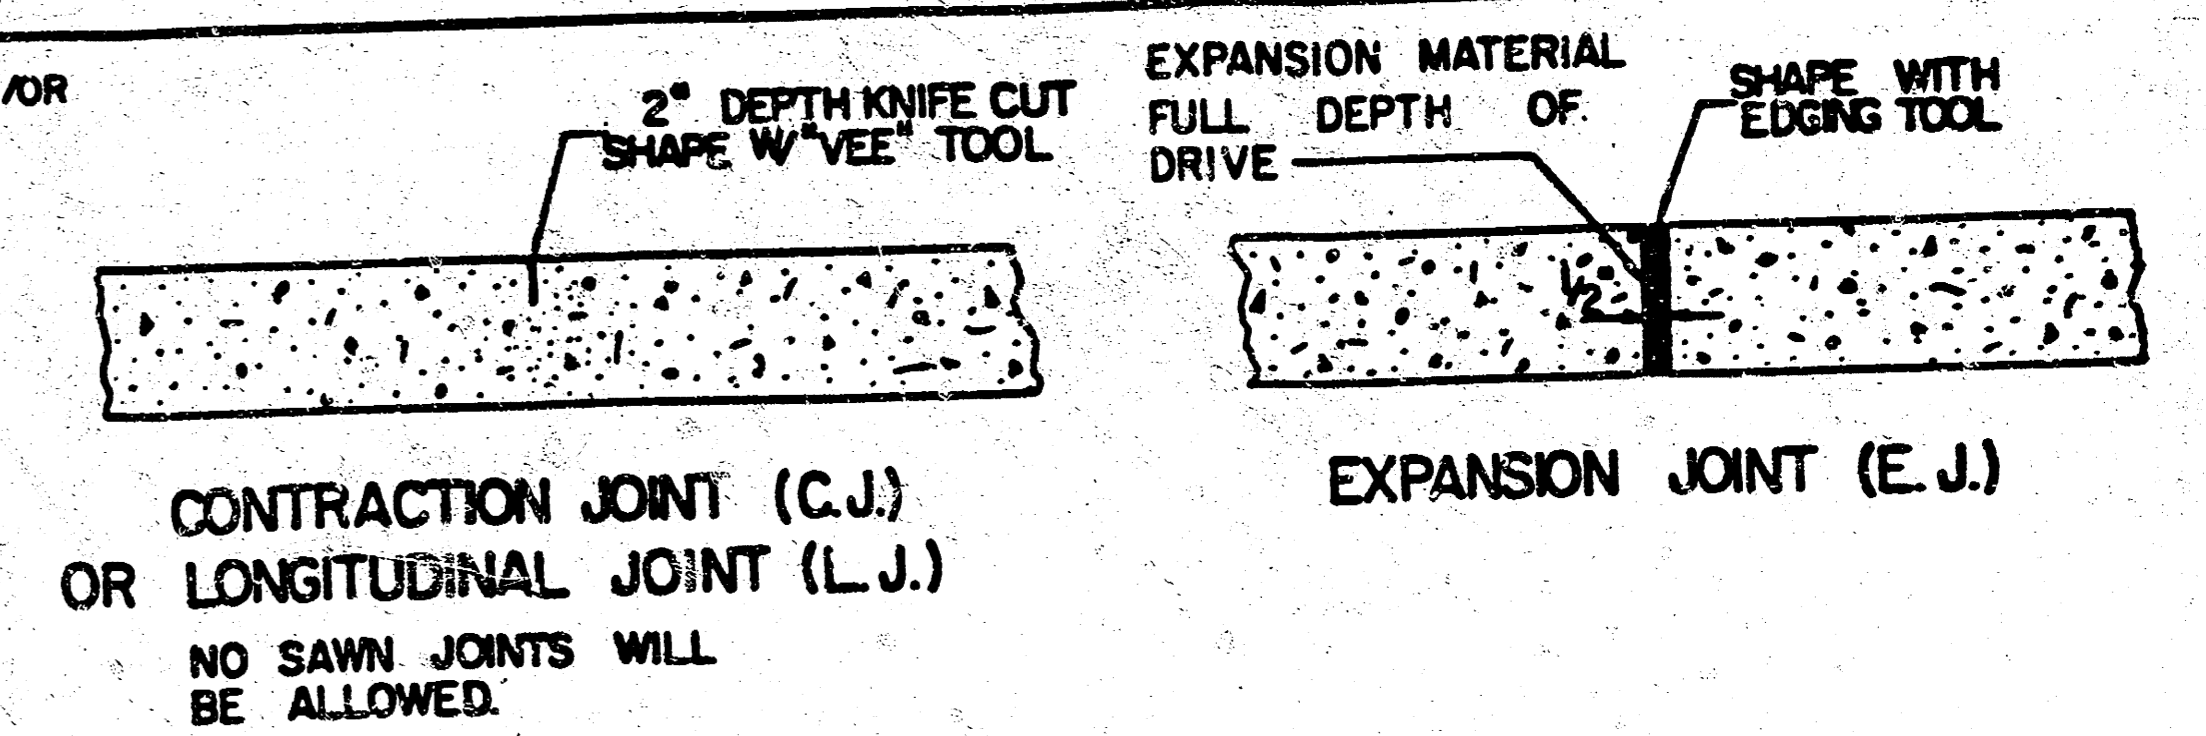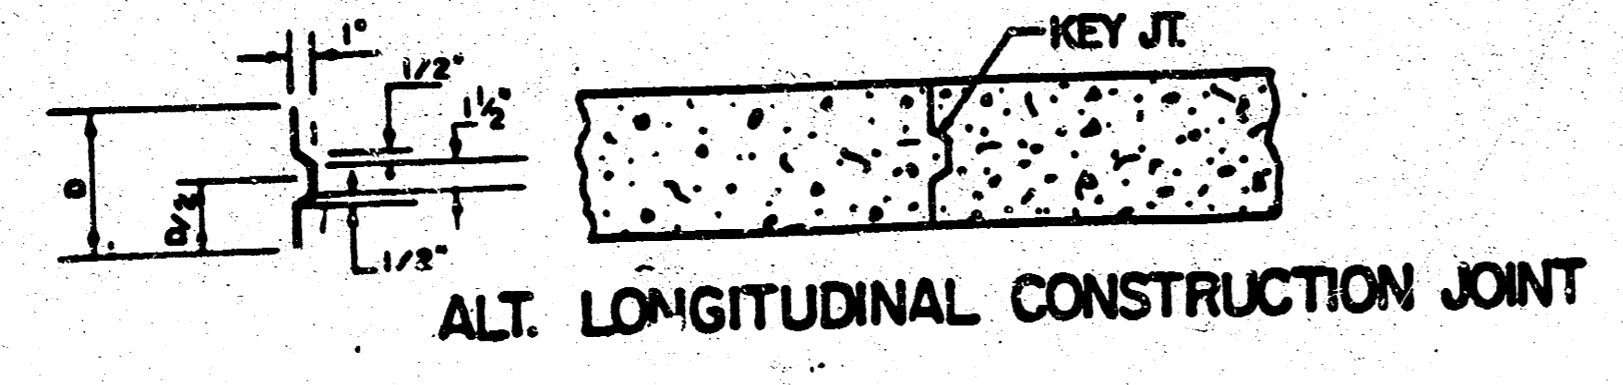


PARKING WIDTH "P"	9'	10'	11'	12'	13'	14.5'	20'	25'	30'	35'	40'	45'	50'
ABSOLUTE MAX. DIST. OF PT. "WG" ABOVE OR BELOW TOP OF FULL CURB	0.35	0.35	0.40	0.45	0.60	0.70	1.04	1.30	1.56	1.82	2.08	2.34	2.60
OPTIMUM MAX. DIST. OF PT. "WG" ABOVE OR BELOW TOP OF FULL CURB	0.19	0.21	0.23	0.25	0.27	0.30	0.42	0.52	0.62	0.72	0.82	0.92	1.02
ABSOLUTE MIN. DIST. OF PT. "WG" ABOVE OR BELOW TOP OF FULL CURB	-0.19	-0.16	-0.13	-0.10	-0.06	0.00	0.00	0.15	0.25	0.35	0.45	0.55	0.65

RADIUS RAMP DRIVES (P = 9.0' & GREATER)

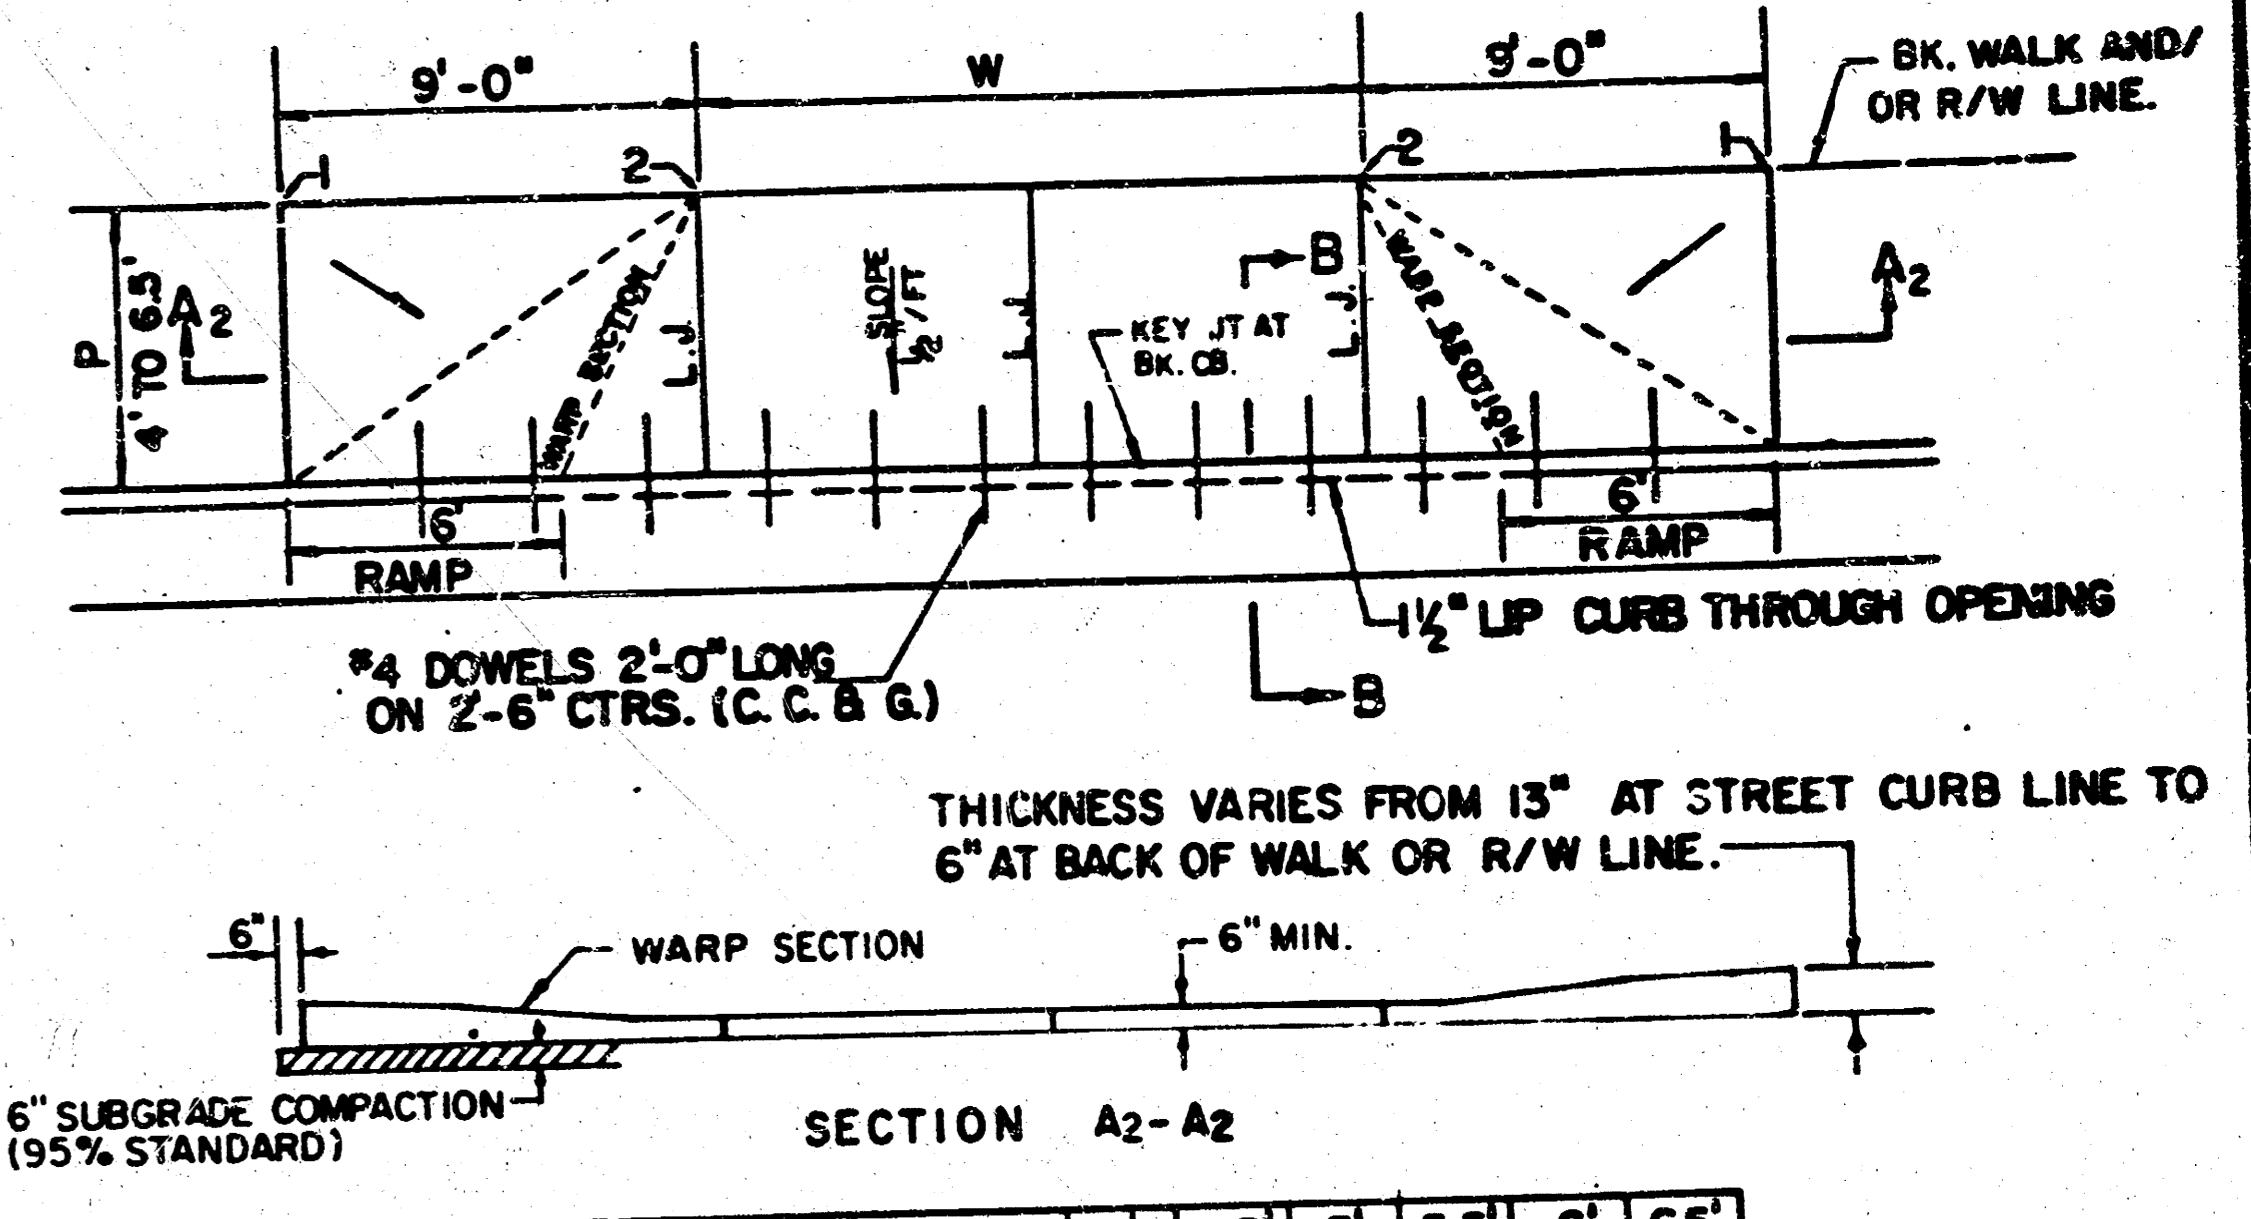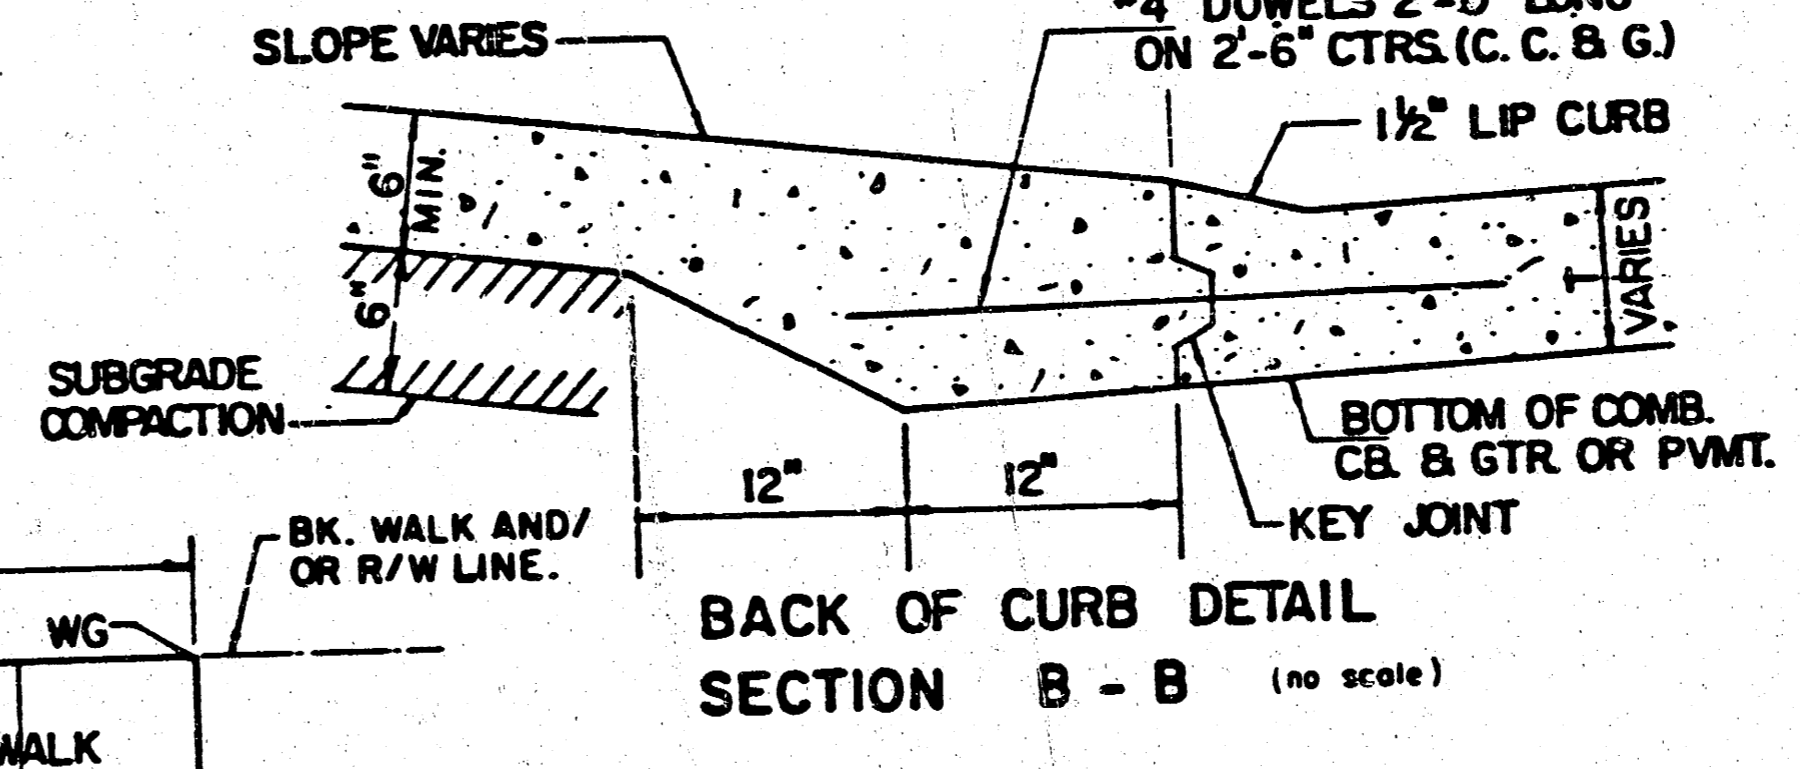


PARKING WIDTH "P"	4'	4.5'	5'	5.5'	6'	6.5'
DIST OF PT. "T" ABOVE TOP OF FULL CB.	0.08	0.09	0.10	0.12	0.13	0.14
DIST OF PT. "Z" BELOW TOP OF FULL CB.	-0.26	-0.24	-0.22	-0.20	-0.18	-0.16

FULL RAMP DRIVE (P=4.0' TO 6.5')

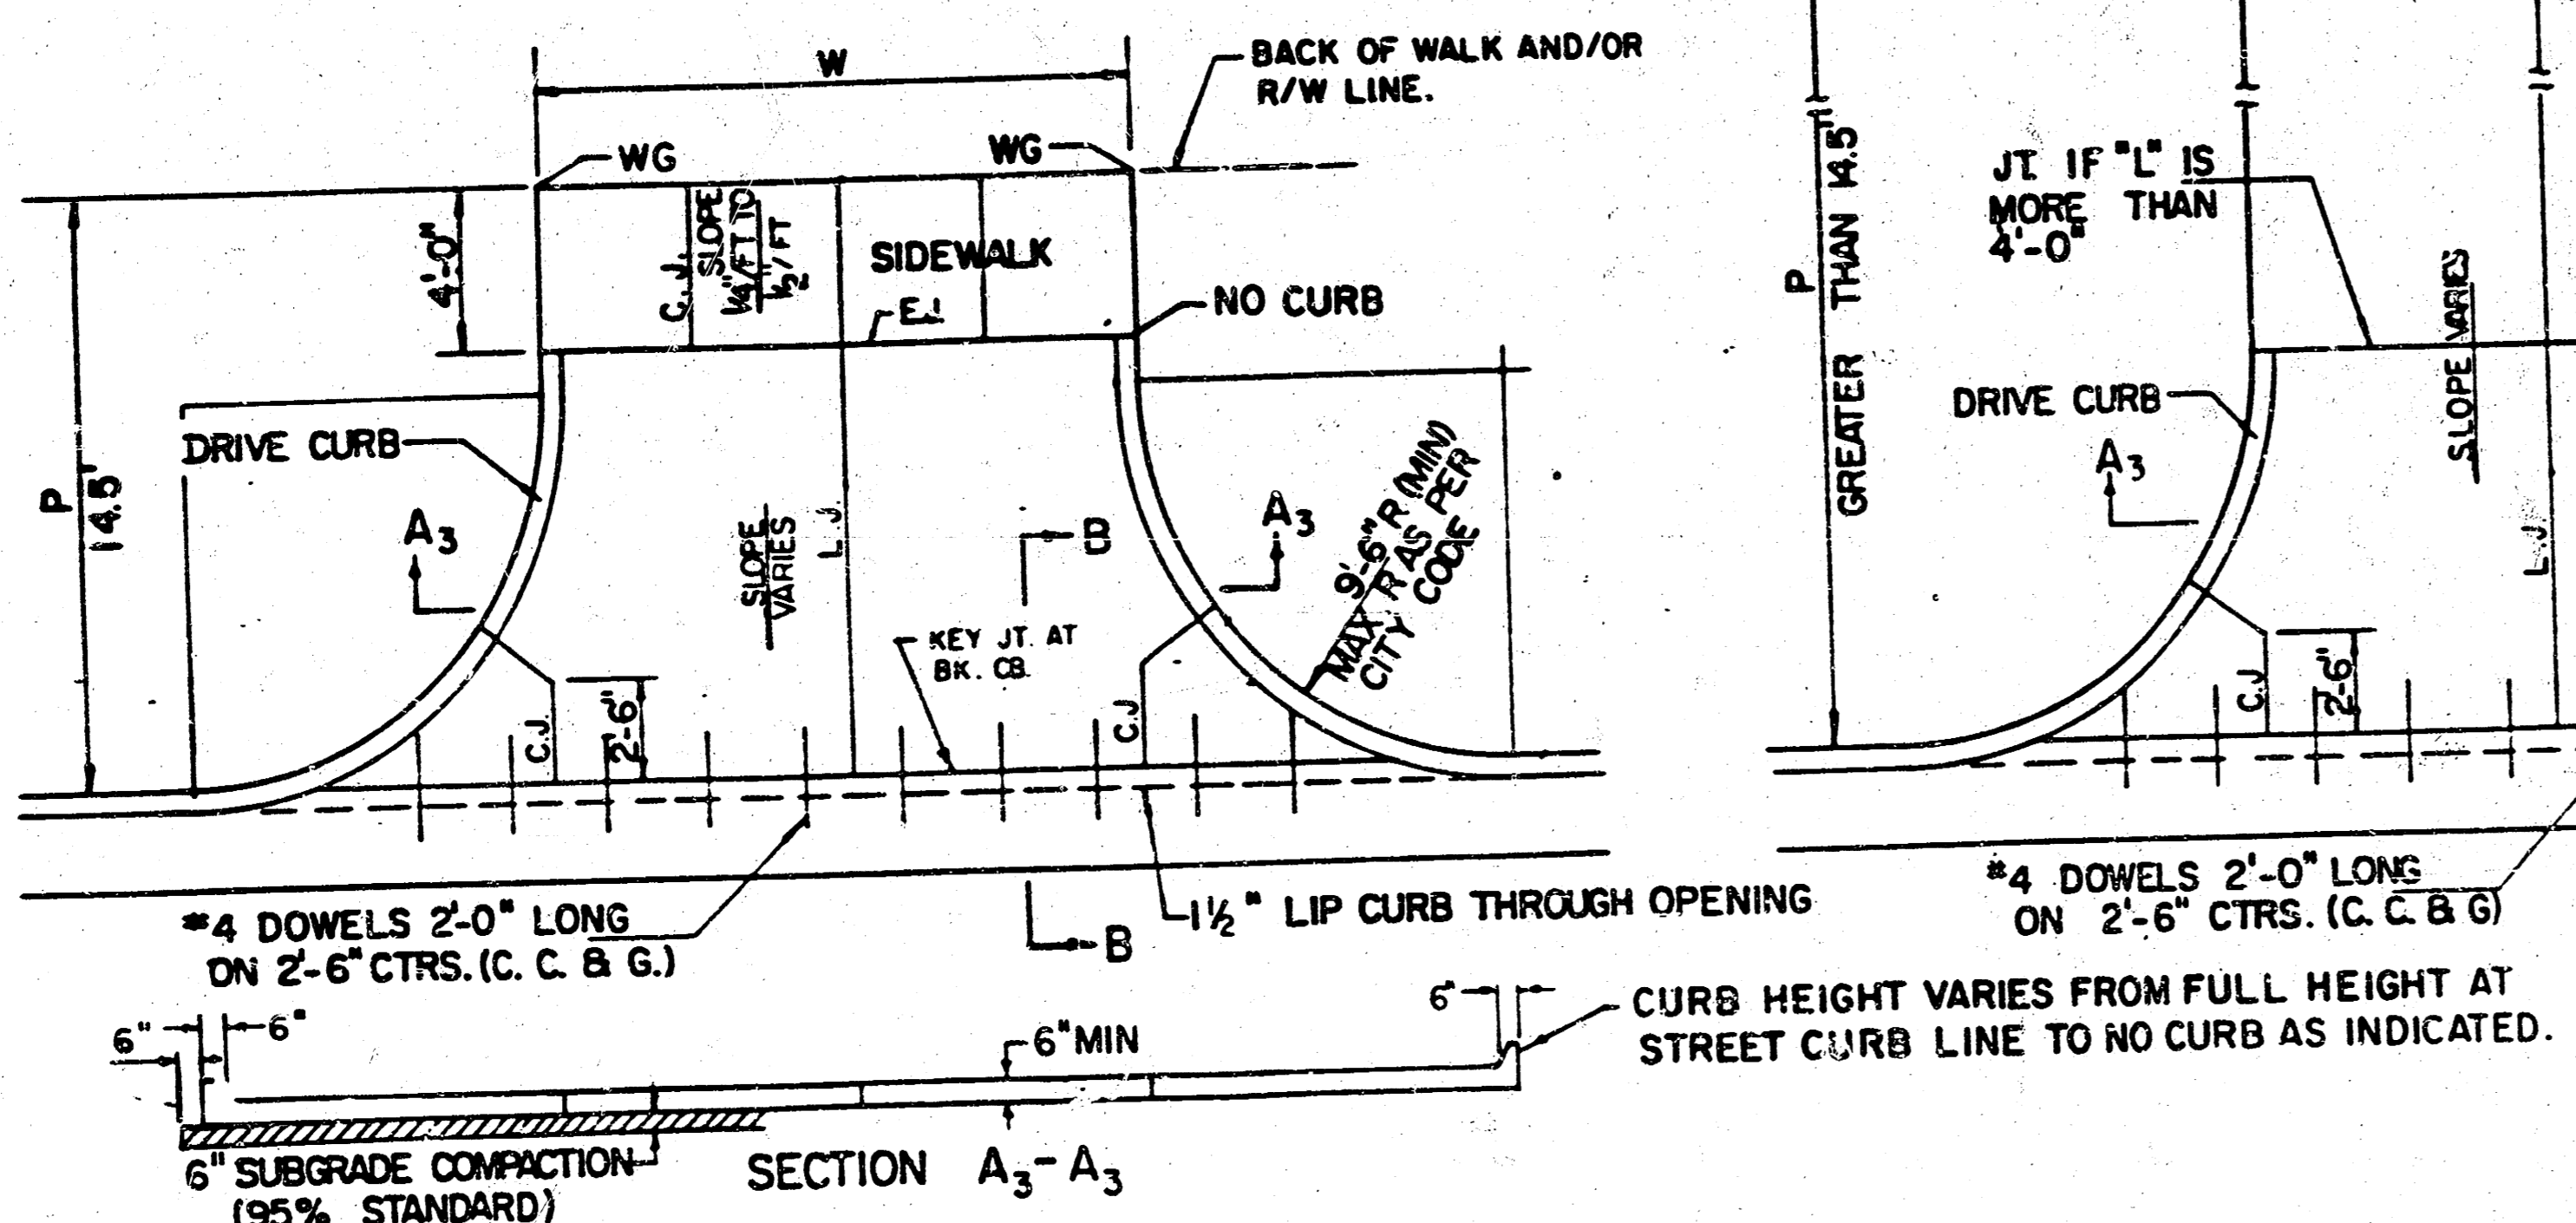

PARKING WIDTH "P"	14.5'	20'	25'	30'	35'	40'	45'	50'
ABSOLUTE MAX. DIST. OF PT. "WG" ABOVE TOP OF FULL CB.	0.80	1.35	1.85	2.35	2.85	3.35	3.85	4.35
OPTIMUM MAX. DIST. OF PT. "WG" ABOVE TOP OF FULL CB.	0.70	1.04	1.30	1.56	1.82	2.08	2.34	2.60
ABSOLUTE MIN. DIST. OF PT. "WG" ABOVE TOP OF FULL CB.	0.00	0.00	0.15	0.25	0.35	0.45	0.55	0.65

FULL RADIUS DRIVES (P=14.5' & GREATER)

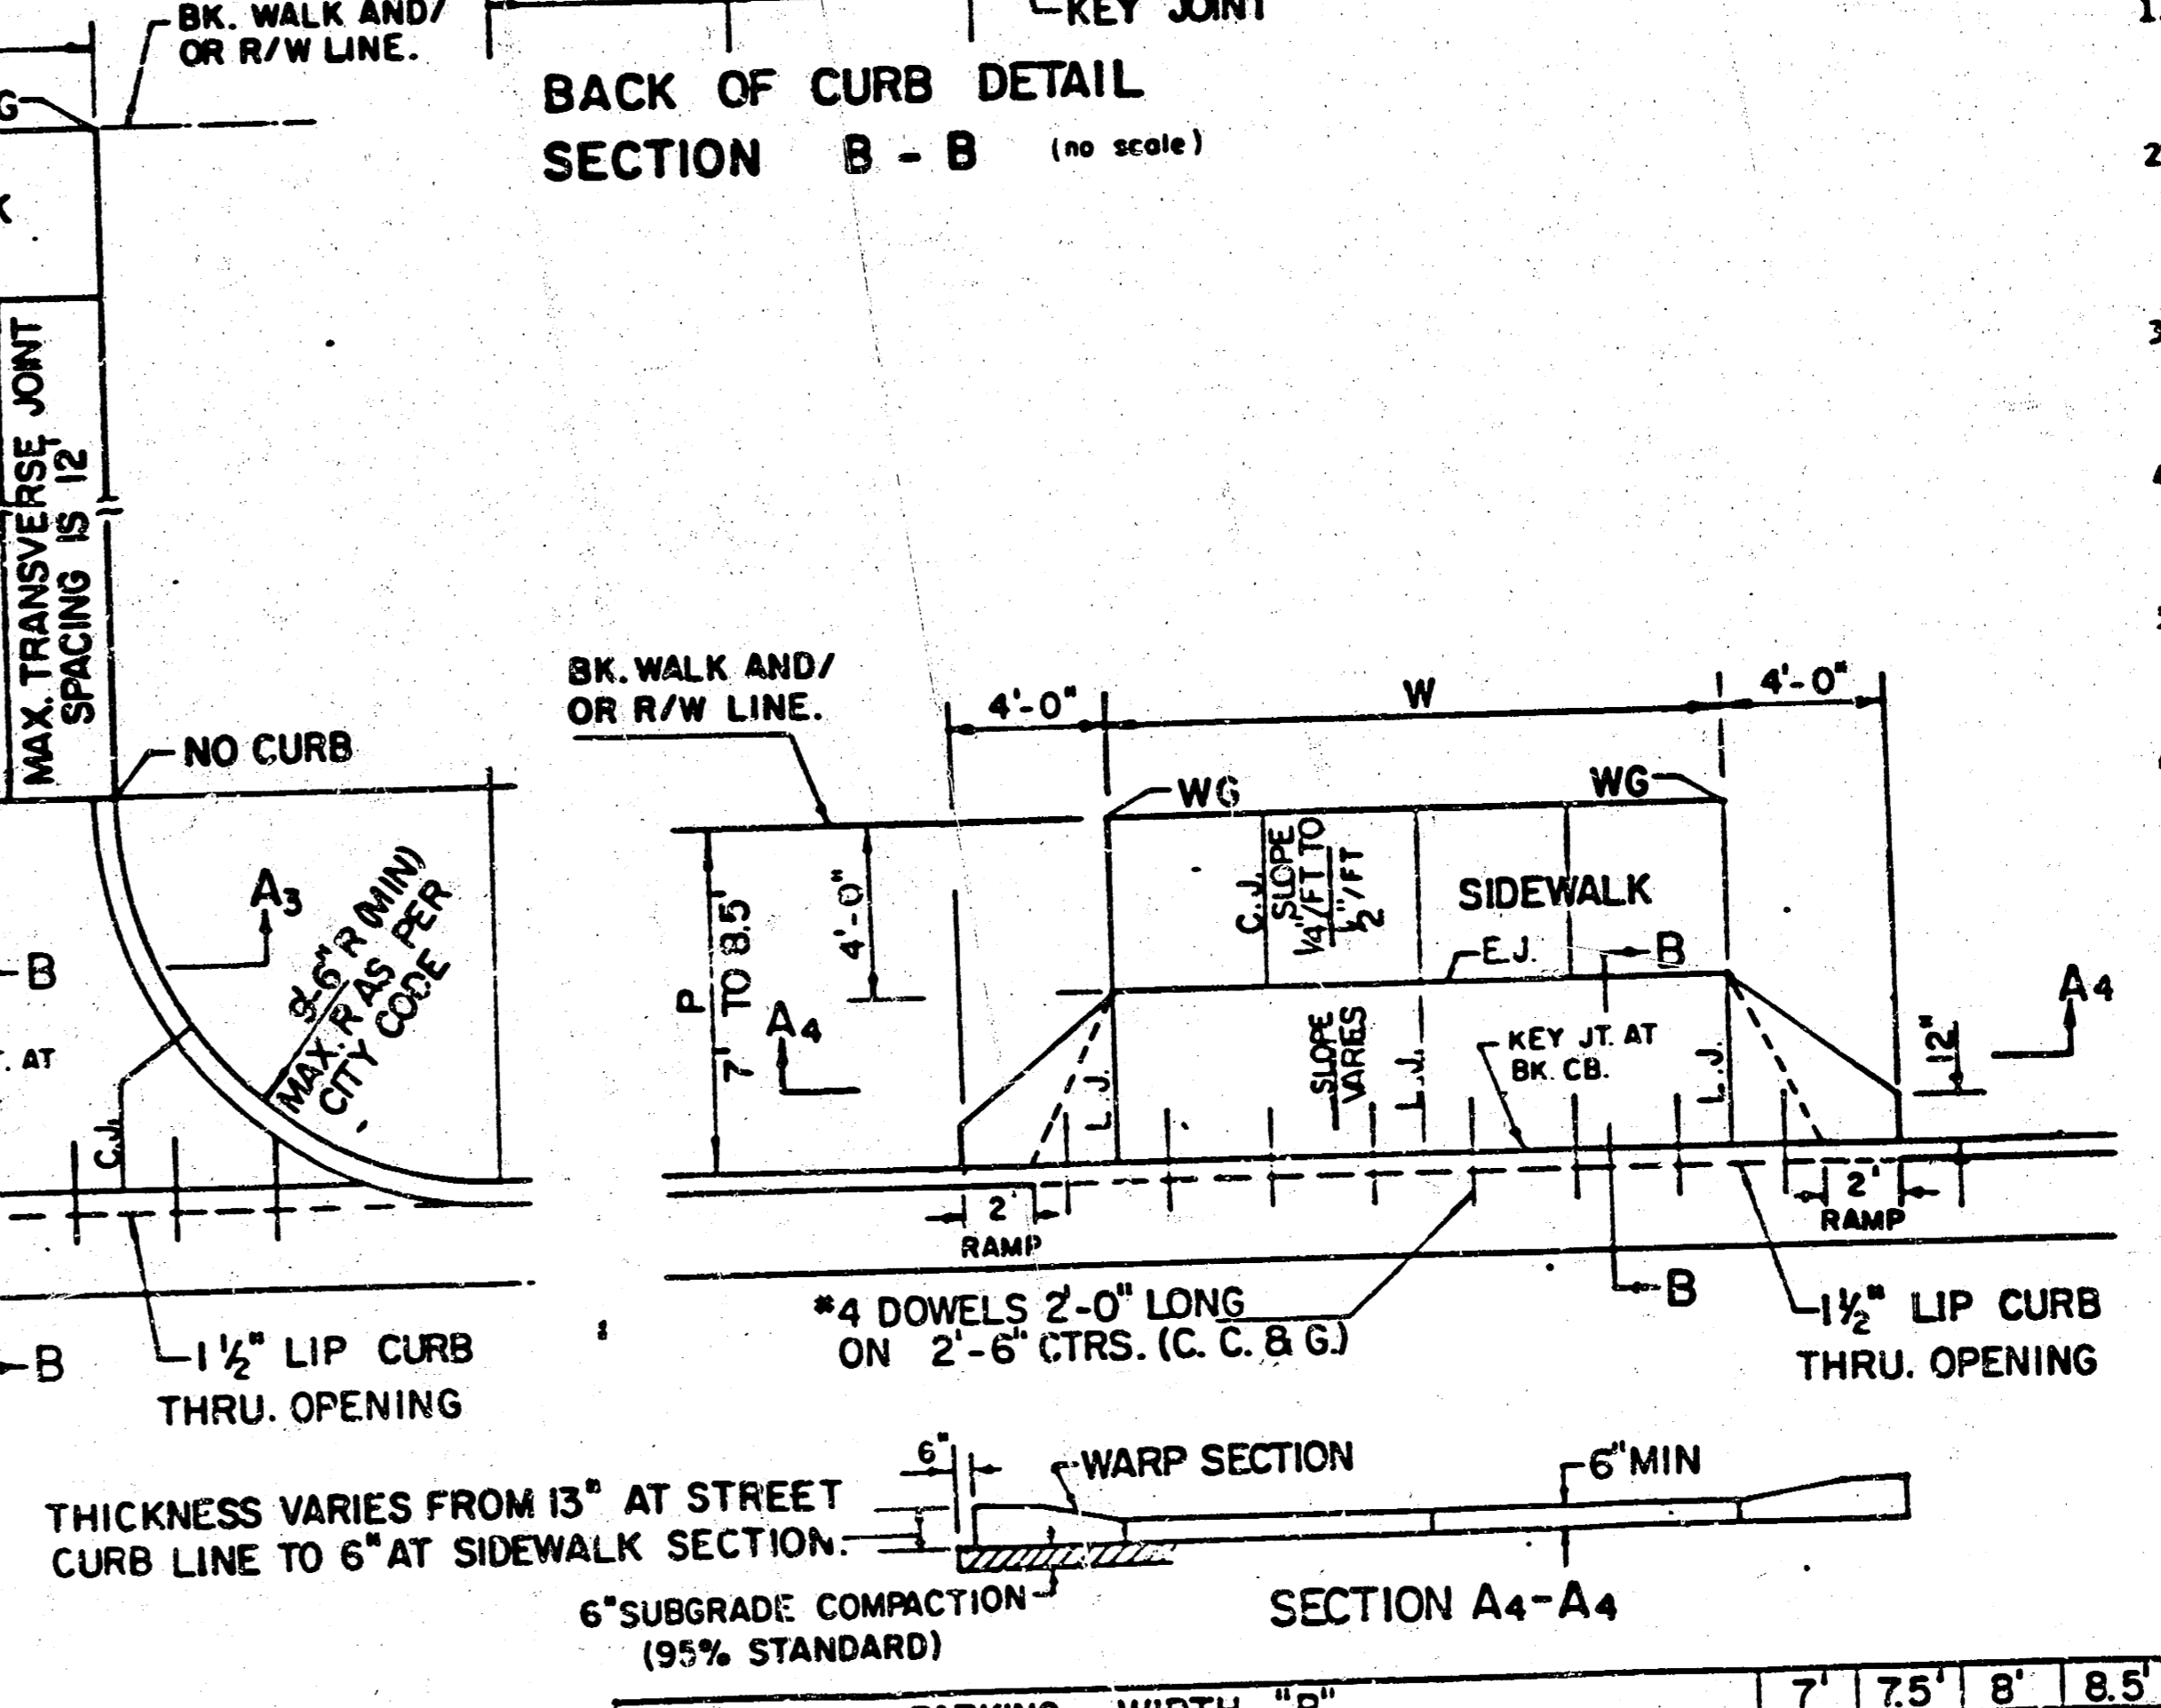

PARKING WIDTH "P"	7'	7.5'	8'	8.5'
ABSOLUTE MAX. DIST. OF PT. "WG" ABOVE TOP OF FULL CB.	0.00	0.10	0.20	0.30
OPTIMUM MAX. DIST. OF PT. "WG" ABOVE TOP OF FULL CB.	0.00	0.10	0.20	0.30
ABSOLUTE MIN. DIST. OF PT. "WG" BELOW TOP OF FULL CB.	-0.15	-0.16	-0.17	-0.17
OPTIMUM MIN. DIST. OF PT. "WG" BELOW TOP OF FULL CB.	-0.15	-0.16	-0.17	-0.17

FULL RAMP DRIVE (P=7.0' TO 8.5')

- GENERAL NOTES
- DRIVEWAY CONSTRUCTION DETAILED ON THIS SHEET IS FOR USE WITH FULL HEIGHT STREET CURBS AND IN AREAS WITHOUT FULL WALK CONSTRUCTION IN THE PARKING. SEE OTHER DETAIL SHEETS FOR DRIVEWAY CONSTRUCTION WITH ROLL CURBS AND/OR FULL WALK.
 - ONE LONGITUDINAL JOINT SHALL BE CONSTRUCTED ALONG THE CENTERLINE OF DRIVES HAVING A "P" DIMENSION OF 24' OR LESS. TWO LONGITUDINAL JOINTS SHALL BE CONSTRUCTED WITH EQUAL SPACINGS NOT TO EXCEED 10' FOR DRIVES WITH A "P" DIMENSION GREATER THAN 24'.
 - DRIVEWAY WIDTH DENOTED AS "P" ON THE DETAIL DRAWINGS SHALL BE A MINIMUM OF 10' AND A MAXIMUM OF 30'. THE MAXIMUM OPENING FOR RADIUS TYPE DRIVES WITH CURBS THROUGH THE RADIUS SHALL NOT EXCEED 50' AT THE STREET CURB LINE.
 - CONTRACTION JOINT SPACING IN THE DRIVEWAY WALK SECTION SHALL BE A MINIMUM OF 3' AND A MAXIMUM OF 6' AND ARE TO BE EQUALLY SPACED WITHIN THIS RANGE. WALK SECTION SHALL BE CONSTRUCTED TO THE SAME THICKNESS AS THE DRIVEWAY.
 - DOWEL BARS SHALL BE OMITTED FROM THE KEYED CONSTRUCTION JOINT ALONG THE BACK OF THE STREET CURB LINE WHEN DRIVEWAYS ARE CONSTRUCTED IN CONJUNCTION WITH NEW CONCRETE PAVEMENT CONSTRUCTION.
 - ADDITIONAL THICKNESS OF DRIVE AS INDICATED IN THE DRAWINGS WILL NOT BE PAID FOR DIRECTLY AND THIS COST SHALL BE INCLUDED IN THE UNIT PRICE BID FOR THE DRIVEWAY CONSTRUCTION.
 - ONE HALF INCH EXPANSION JOINTS SHALL BE INSTALLED WHEREVER DRIVE CONSTRUCTION ABUTS SIDEWALK. ONE HALF INCH EXPANSION JOINTS SHALL ALSO BE INSTALLED ALONG THE PROPERTY LINE AND/OR BACK OF WALK LINE WHEN DRIVE CONSTRUCTION ALONG THIS LINE ABUTS CONCRETE PARKING LOTS OR CONCRETE DRIVE EXTENSION.
 - ALL DRIVEWAYS SHALL BE A MINIMUM OF 6" IN THICKNESS AND SHALL BE WITHOUT REINFORCEMENT. DRIVEWAYS MAY BE CONSTRUCTED THICKER THAN 6" AND THEY MAY BE REINFORCED WITH #4@12" W4-W4 WELDED WIRE FABRIC WHEN PROPERLY AUTHORIZED BY THE PROPERTY OWNER WITH THE ENGINEER'S CONCURRENCE.
 - OPTIMUM DRIVEWAY ELEVATIONS SHOWN IN THE TABLES ARE TO BE USED WHEREVER POSSIBLE. ABSOLUTE MAXIMUM AND MINIMUM ELEVATIONS ARE TO BE USED ONLY WHEN THESE VALUES WILL PERMIT NEW CONSTRUCTION TO MATCH EXISTING DRIVES OR PARKING LOTS. VALUES SHOWN IN THE TABLES ARE BASED ON A FULL CURB HEIGHT ELEVATION OF 0.55' ABOVE THE GUTTER FLOW LINE AND MUST BE ADJUSTED ACCORDINGLY FOR OTHER CURB HEIGHTS. VALUES SHOWN IN THE TABLES WITH MINUS SIGNS INDICATE ELEVATIONS BELOW TOP OF FULL HEIGHT CURB.

REVISED OCTOBER 1985
SCALE: 1"=5'

STANDARD DRIVE ENTRANCES
FULL HEIGHT CURB
CITY OF WICHITA, KANSAS
PROJECT NUMBER
472-76-246-8000-000-000-022

FILMED FROM THE BEST AVAILABLE COPY