

PAVING PLANS FOR WILLOWBEND HEIGHTS

CHAMPIONS: FROM THE SOUTH LINE OF LOT 8 BLK. 1 TO THE EAST LINE OF WILLOWBEND HEIGHTS
SWEET BAY : FROM THE SOUTH LINE OF LOT 8 BLK. 1 TO THE SOUTH LINE OF CHAMPIONS

PROJECT NO.
472-76-245-80001-000-000-031

CITY OF WICHITA, KANSAS
MICHAEL E. LINDEBAK CITY ENGINEER

GENERAL NOTES


1. CURB AND GUTTER WITH WIDENED GUTTER TO BE PAID AS COMBINED CURB AND GUTTER.
2. ALL DRAINAGE STRUCTURES "BY OTHERS".
3. THE CONTRACTOR SHALL BE RESPONSIBLE FOR PRESERVING PROPERTY IRONS. THE CONTRACTOR SHALL BE REQUIRED TO RE-ESTABLISH ANY PROPERTY IRONS WHICH ARE DAMAGED OR DESTROYED BY HIS CONSTRUCTION OPERATIONS. SUCH IRONS SHALL BE RE-ESTABLISHED BY A LICENSED LAND SURVEYOR OR A LICENSED PROFESSIONAL ENGINEER IN ACCORDANCE WITH STATE LAWS.
4. PAYING CONTRACTOR TO COORDINATE WORK WITH STORM SEWER AND SANITARY SEWER CONTRACTORS AND TO CONTACT UTILITY COMPANIES FOR LOCATION OF ANY UNDERGROUND LINES.
5. TRANSITION CURB FROM FULL HEIGHT COMBINATION CURB AND GUTTER TO ROLL TYPE COMBINATION CURB AND GUTTER IS TO BE PAID AS BID FOR LINEAL FEET COMBINED CURB AND GUTTER (3 5/8" ROLL).
6. ALL WORK TO BE DONE ACCORDING TO CITY OF WICHITA SPECIFICATIONS.
7. ALL TREES & FENCES WITHIN RIGHT-OF-WAY SHALL BE REMOVED COST SUBSIDIARY TO C.Y. EXCAVATION.

NOTE: NOTIFY THE FOLLOWING COMPANIES PRIOR TO ANY EXCAVATION:

ARKLA GAS COMPANY	942-8350
BELL TELEPHONE	1-316-571-2115
CABLEVISION	262-0661
KPL GAS SERVICE	263-7511
KANSAS GAS & ELECTRIC	281-6248
KANSAS ONE-CALL	1-800-344-7233
CITIES SERVICE	524-0491
KANSAS GAS SUPPLY	316-254-7243
CONTINENTAL PIPELINE COMPANY	316-681-2081
CO-OP REFINERY PIPELINE	1-316-221-2107

BENCH MARKS

- B.M. #1 = $\square$ cut on SW corner of North cart path underpass on Rock Road. Elev. = 188.79
- B.M. #2 = $\square$ cut on NE corner of Big RCB under Rock Road + 900' N of E Quarter corner section 30, Township 25 South, Range 2 East. Elev. = 188.99
- B.M. #3 = NE cor of RCB under Rock + 415' Northerly of the N line of the NE Quarter, Section 30, Township 25 South, Range 2 East. Elev. = 188.33

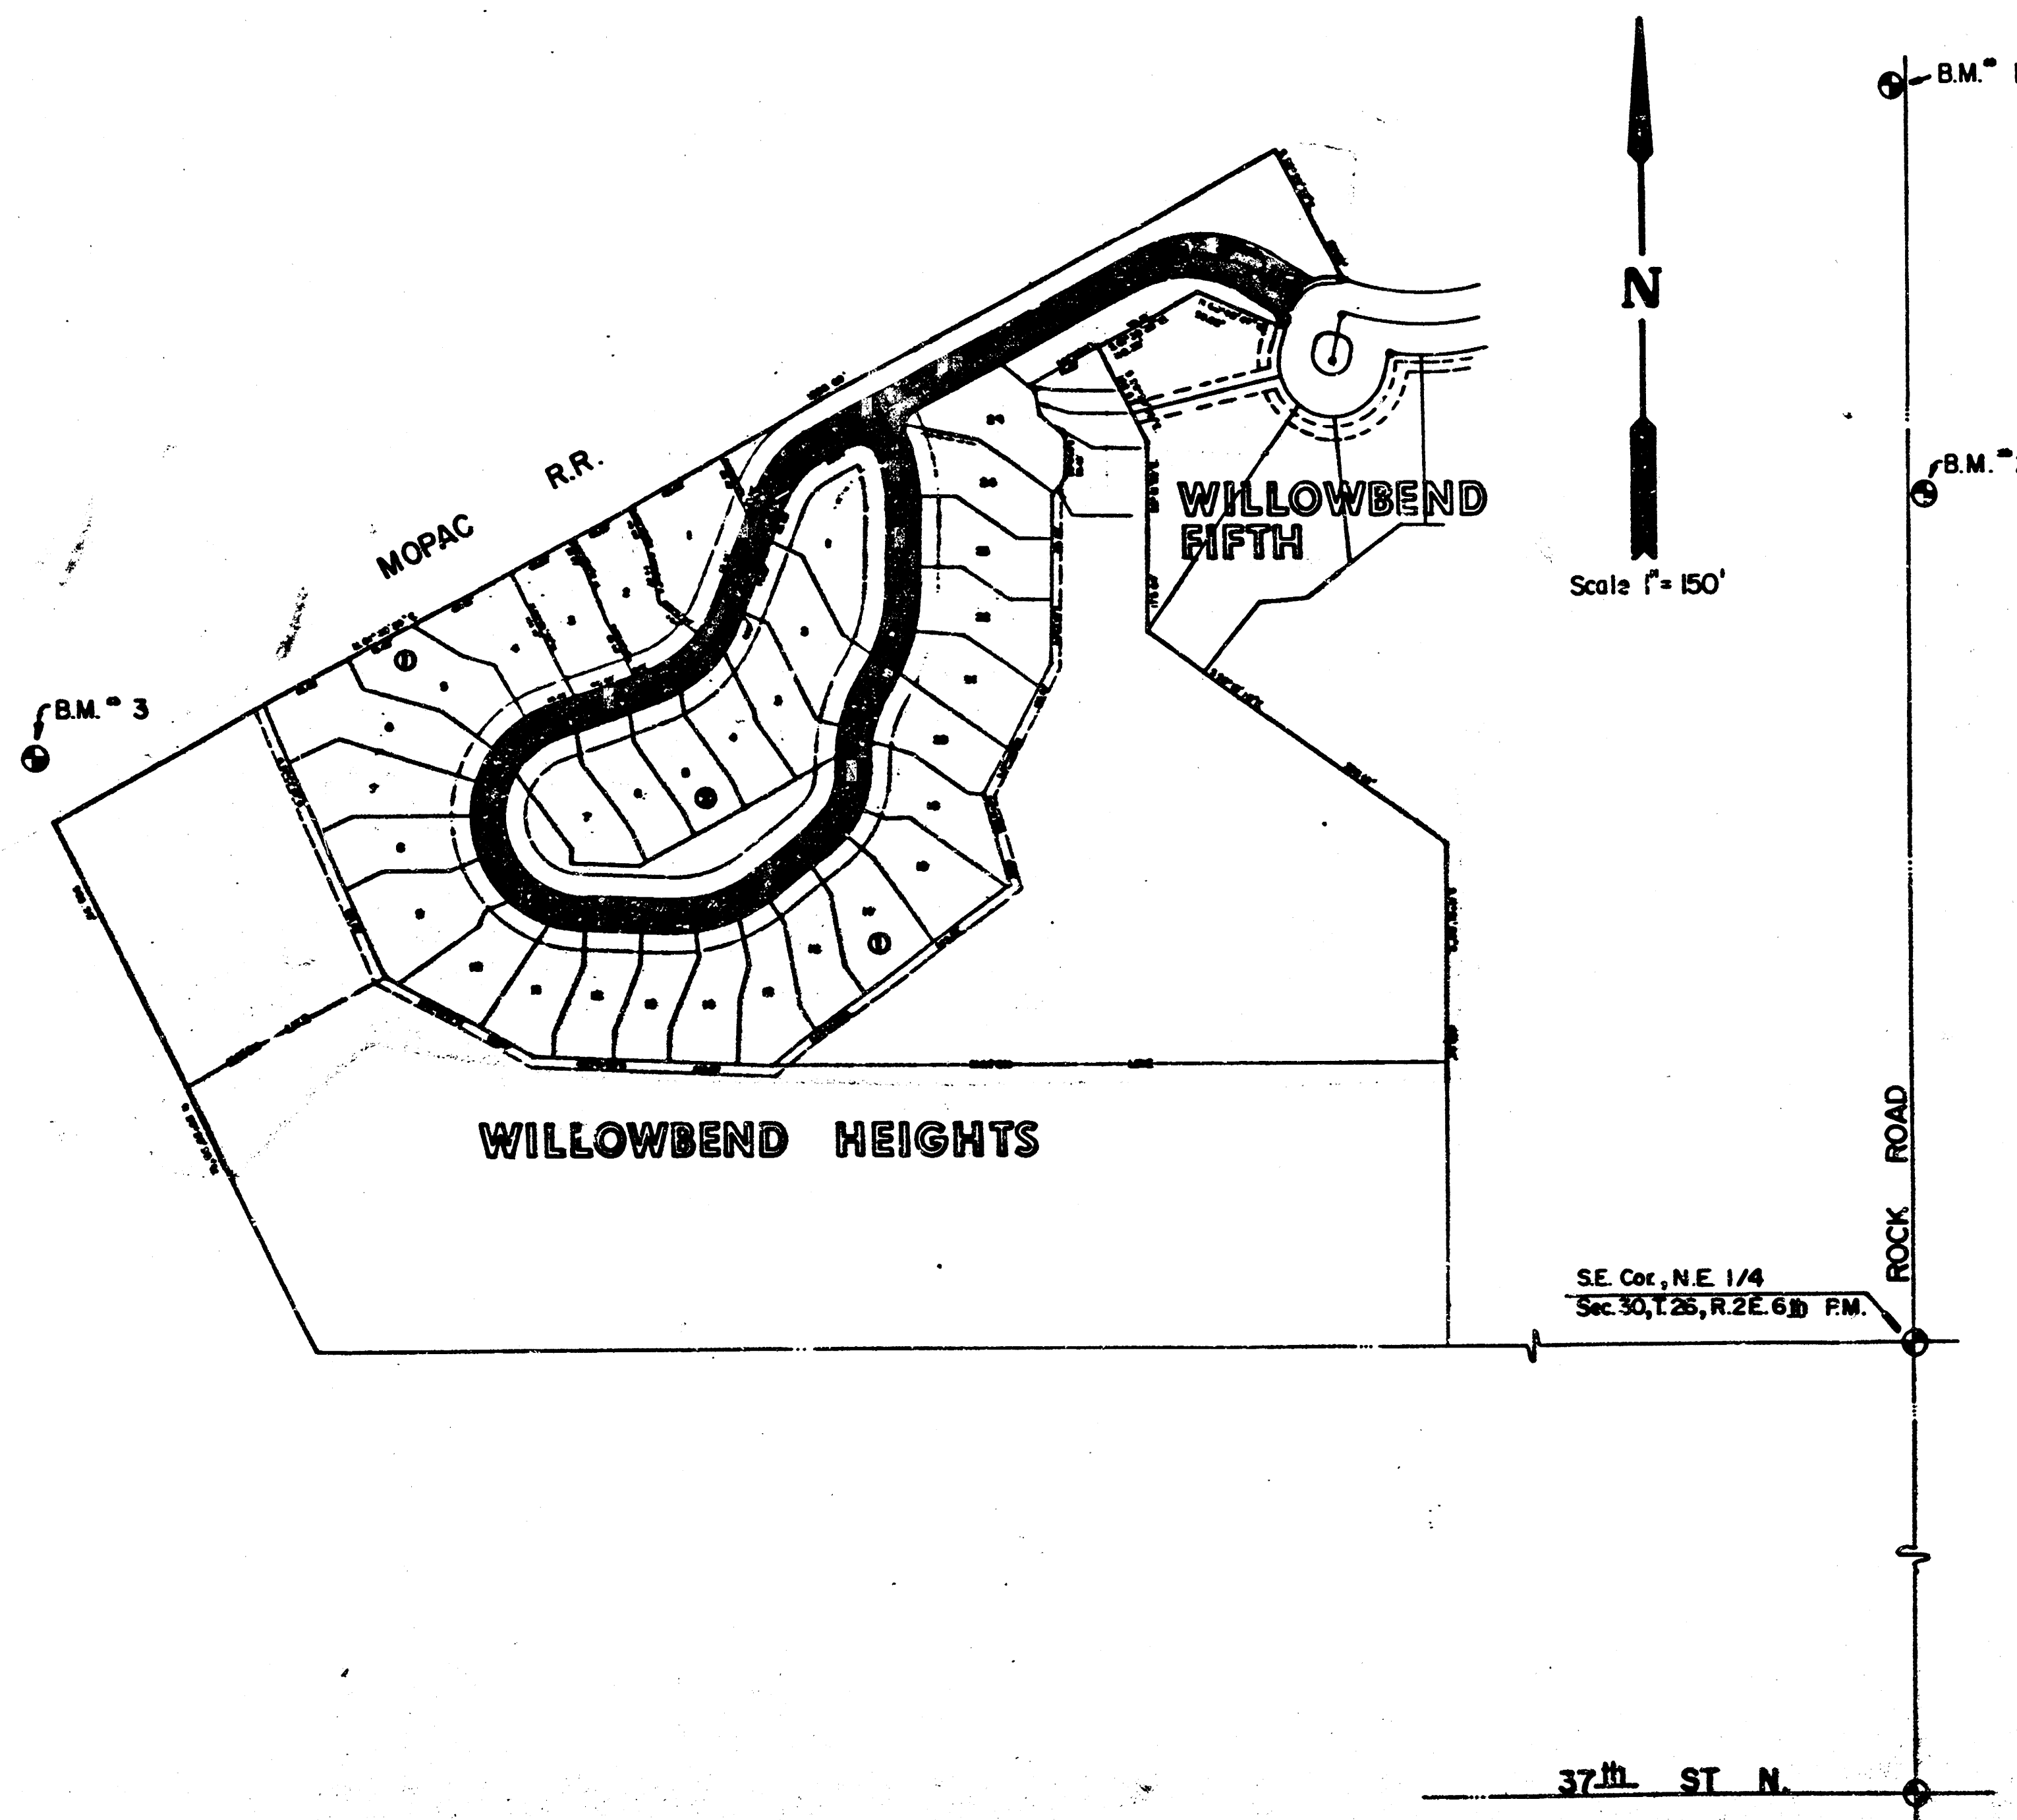

INDEX TO DRAWINGS

SHEET NO.	DESCRIPTION
1	TITLE SHEET
2	PAVING DETAILS
3-4	CHAMPIONS
5-6	SWEET BAY
7	FINAL PLAT



AS BUILT - NOV. 1988

	WILLOWBEND HEIGHTS		Design: F.F.
	PAVING PLANS		Drawn by: E.C.G.
			Checked by:
			Date:
MID-KANSAS ENGINEERING CONSULTANTS PA 3300 NORTH ROCK ROAD BUILDING 1800 WICHITA, KANSAS 67226			Sheet 1 of 7

NOV. 12, 1987


FILMED FROM THE BEST
AVAILABLE COPY

TYPICAL 29' PAVEMENT DETAILS

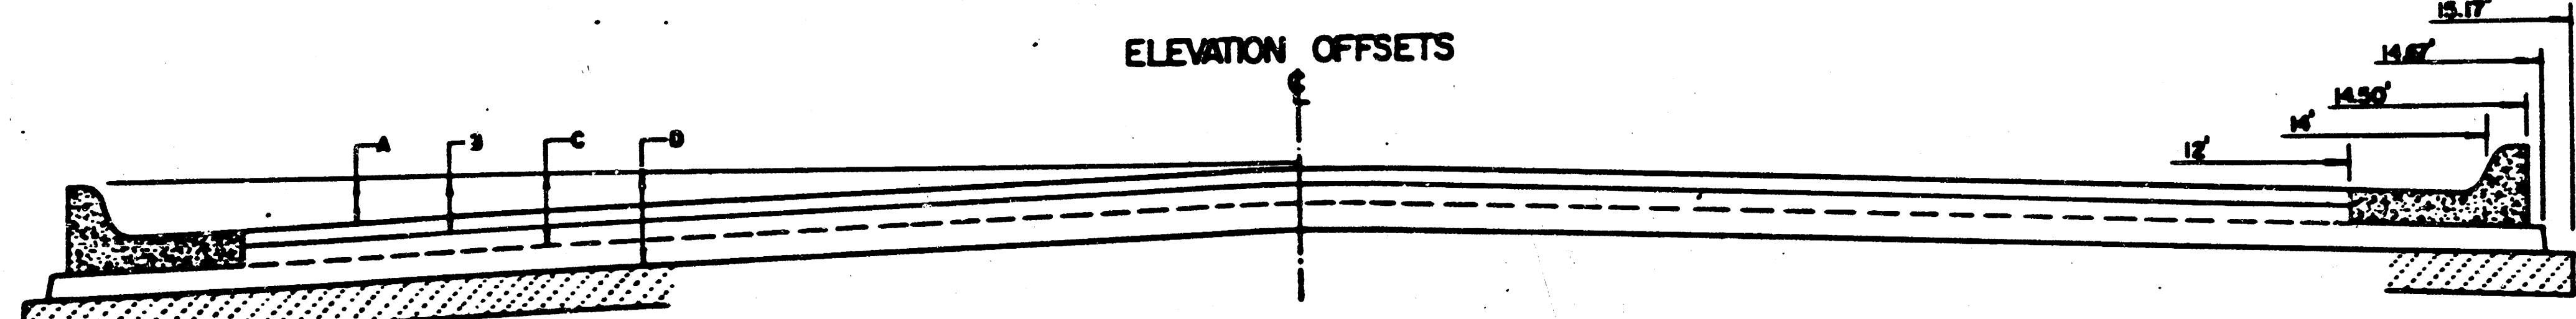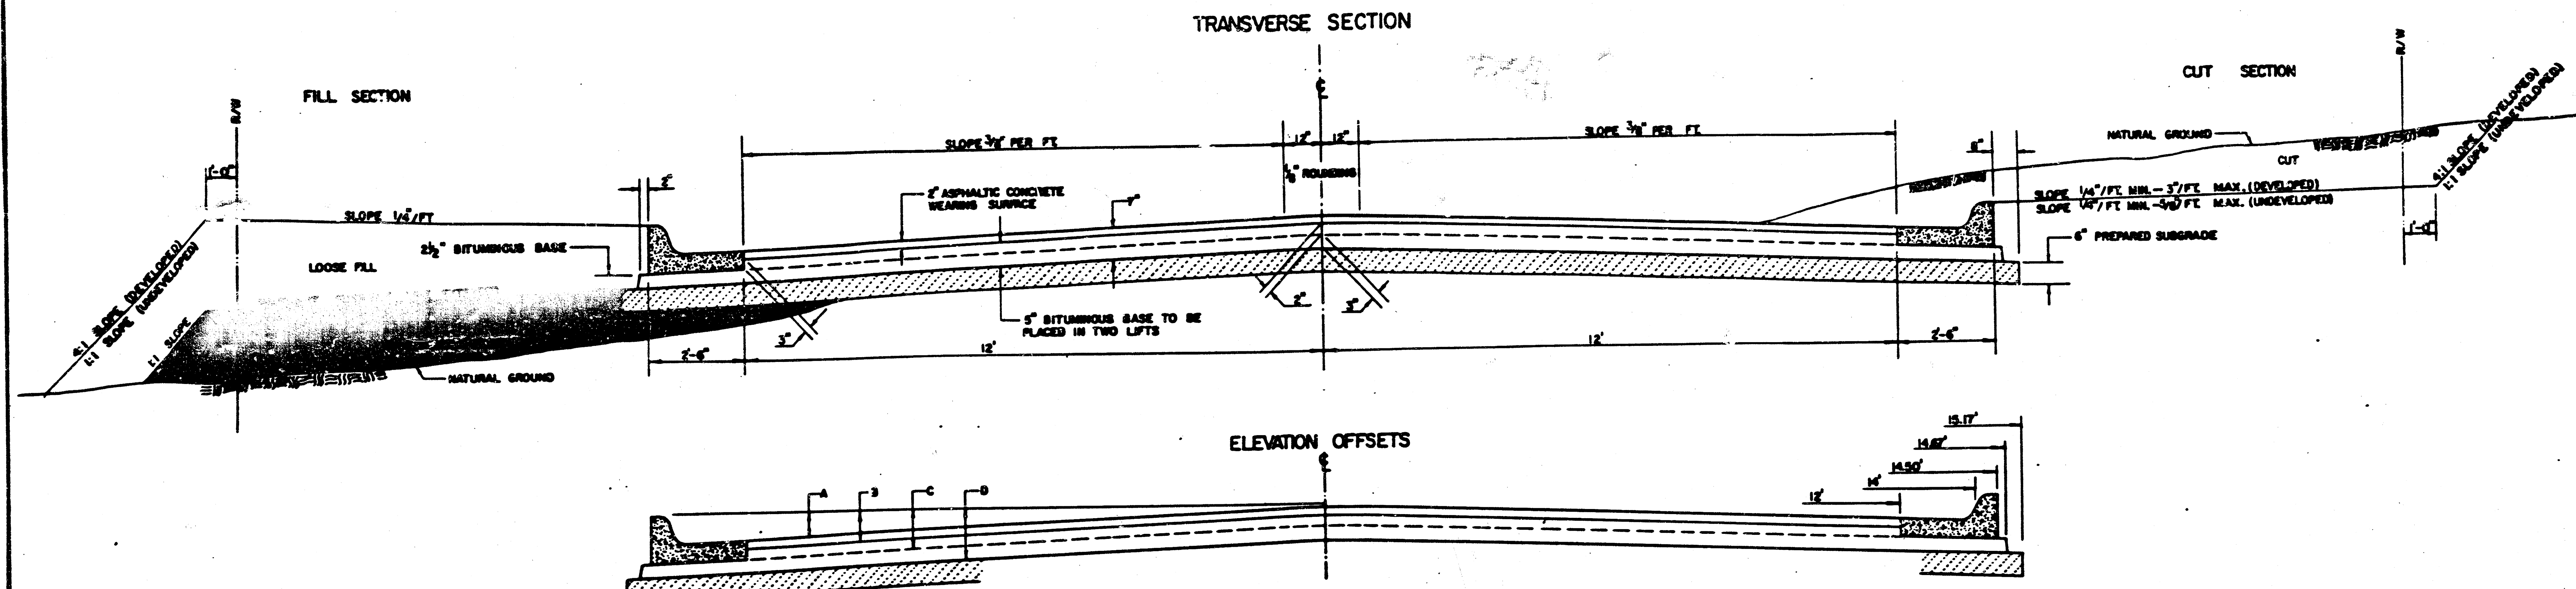


	DISTANCE FROM CENTERLINE (L & R)											
	0'	2'	4'	6'	7'	8'	10'	12'	14'	14.5'	14.5'	15.17'
A: TOP OF CURB TO TOP OF SURFACE LIFT	0.13	0.18	0.24	0.30	0.33	0.36	0.43	0.49	—	—	—	—
B: TOP OF CURB TO TOP OF UPPER BASE LIFT	0.30	0.35	0.41	0.47	0.50	0.53	0.60	0.66	—	—	—	—
C: TOP OF CURB TO TOP OF LOWER BASE LIFT	0.47	0.52	0.58	0.64	0.67	0.70	0.77	0.83	0.89	1.00	1.01	—
D: TOP OF CURB TO TOP OF SUBGRADE	0.72	0.77	0.84	0.90	0.94	0.96	1.05	1.12	1.19	1.21	1.21	1.23

COMBINED CURB & GUTTER

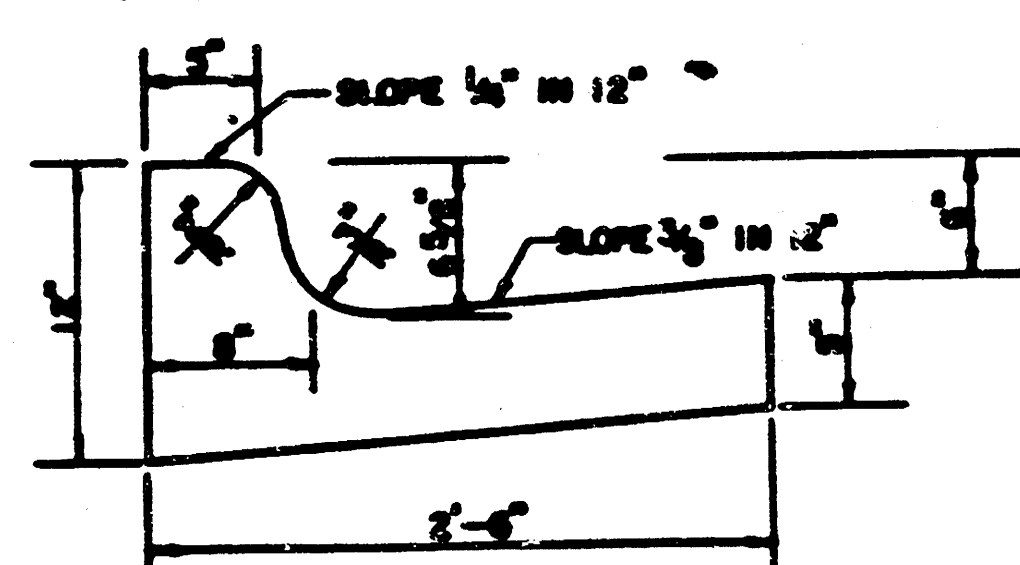


ROLL TYPE COMBINED CURB & GUTTER

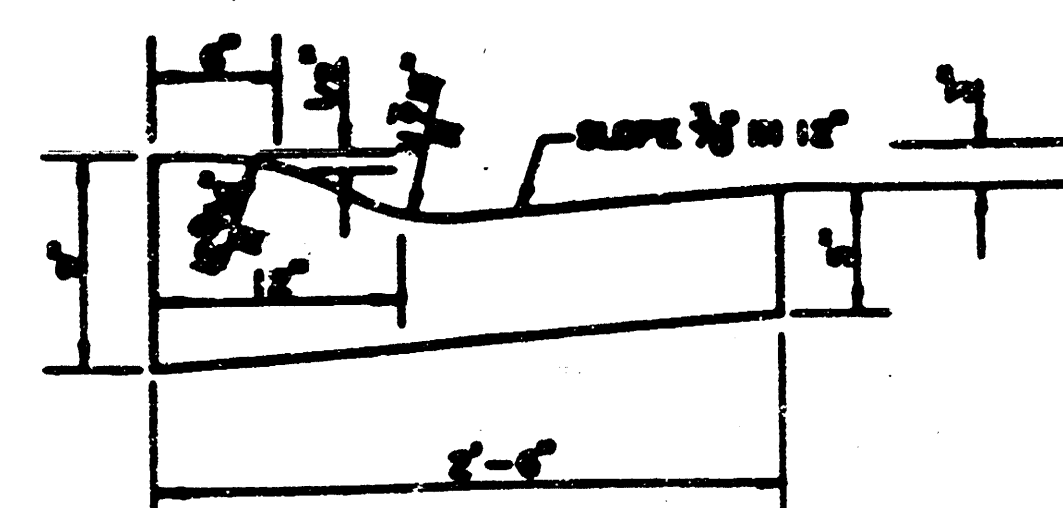

GENERAL NOTES

- 1) THE ASPHALTIC CONCRETE PAVEMENT BETWEEN THE COMBINED CURB AND GUTTER SHALL BE PAID AS SQUARE YARDS OF 7" ASPHALTIC CONCRETE (2" BITUMINOUS BASE).
- 2) THE BITUMINOUS BASE UNDER AND AROUND THE COMBINED CURB AND GUTTER SHALL BE PAID AS SQUARE YARDS OF 2 1/2" BITUMINOUS BASE.
- 3) A THICK COAT OF EMULSIFIED ASPHALT (SC-3H OR CSB-3H) SHALL BE APPLIED AT AN APPROXIMATE RATE OF 0.05 GALLONS PER SQUARE YARD BETWEEN EACH LIFT OF ASPHALTIC MATERIAL.
- 4) BITUMINOUS BASE AND ASPHALTIC CONCRETE WEARING SURFACE SHALL BE PLACED WITH A LAUNDRY MACHINE HAVING AUTOMATIC CONTROLS FOR LINE AND GRADE.
- 5) CONSTRUCTION JOINTS IN EACH LIFT SHALL BE STAGGERED A MINIMUM DISTANCE OF ONE (1) FOOT FROM JOINTS IN PRECEDING LIFTS AND PLACES SO THAT A JOINT WILL BE CONSTRUCTED ON THE CENTERLINE OF THE TOP LIFT.
- 6) CONTRACTOR TO BID ONLY ONE SUBGRADE TREATMENT ALTERNATE WHEN ALTERNATES ARE PROVIDED IN THE PROPOSAL AND CONTRACT. THE ALTERNATE CHOSEN BY THE SUCCESSFUL BIDDER SHALL BE USED IN CONSTRUCTING THIS PROJECT.

TRANSVERSE CONSTRUCTION JOINTS

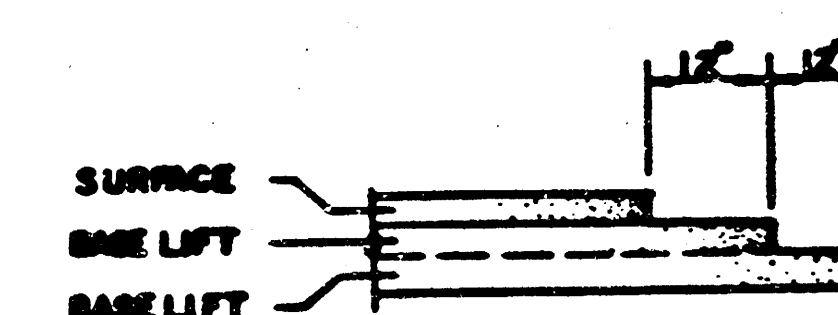


TRANSVERSE CONSTRUCTION JOINTS SHALL BE CONSTRUCTED IN FLEXIBLE BASE PAVEMENTS AT LOCATIONS WHERE PAVEMENT JOINS EXISTING FLEXIBLE BASE PAVEMENT AS SHOWN BY THE DETAIL. ALL COSTS ASSOCIATED WITH THE CONSTRUCTION OF THE TRANSVERSE JOINT SHALL BE INCLUDED IN THE BID PRICE FOR SQUARE YARDS 7" ASPHALTIC CONCRETE (2" BITUMINOUS BASE).

7 INCH RESIDENTIAL ASPHALTIC CONCRETE
PAVEMENT WITH 5 INCH BITUMINOUS BASE
CITY OF WICHITA, KANSAS
PROJECT NUMBER 2/6

NOV. 12, 1967



FILMED FROM THE BEST
AVAILABLE COPY

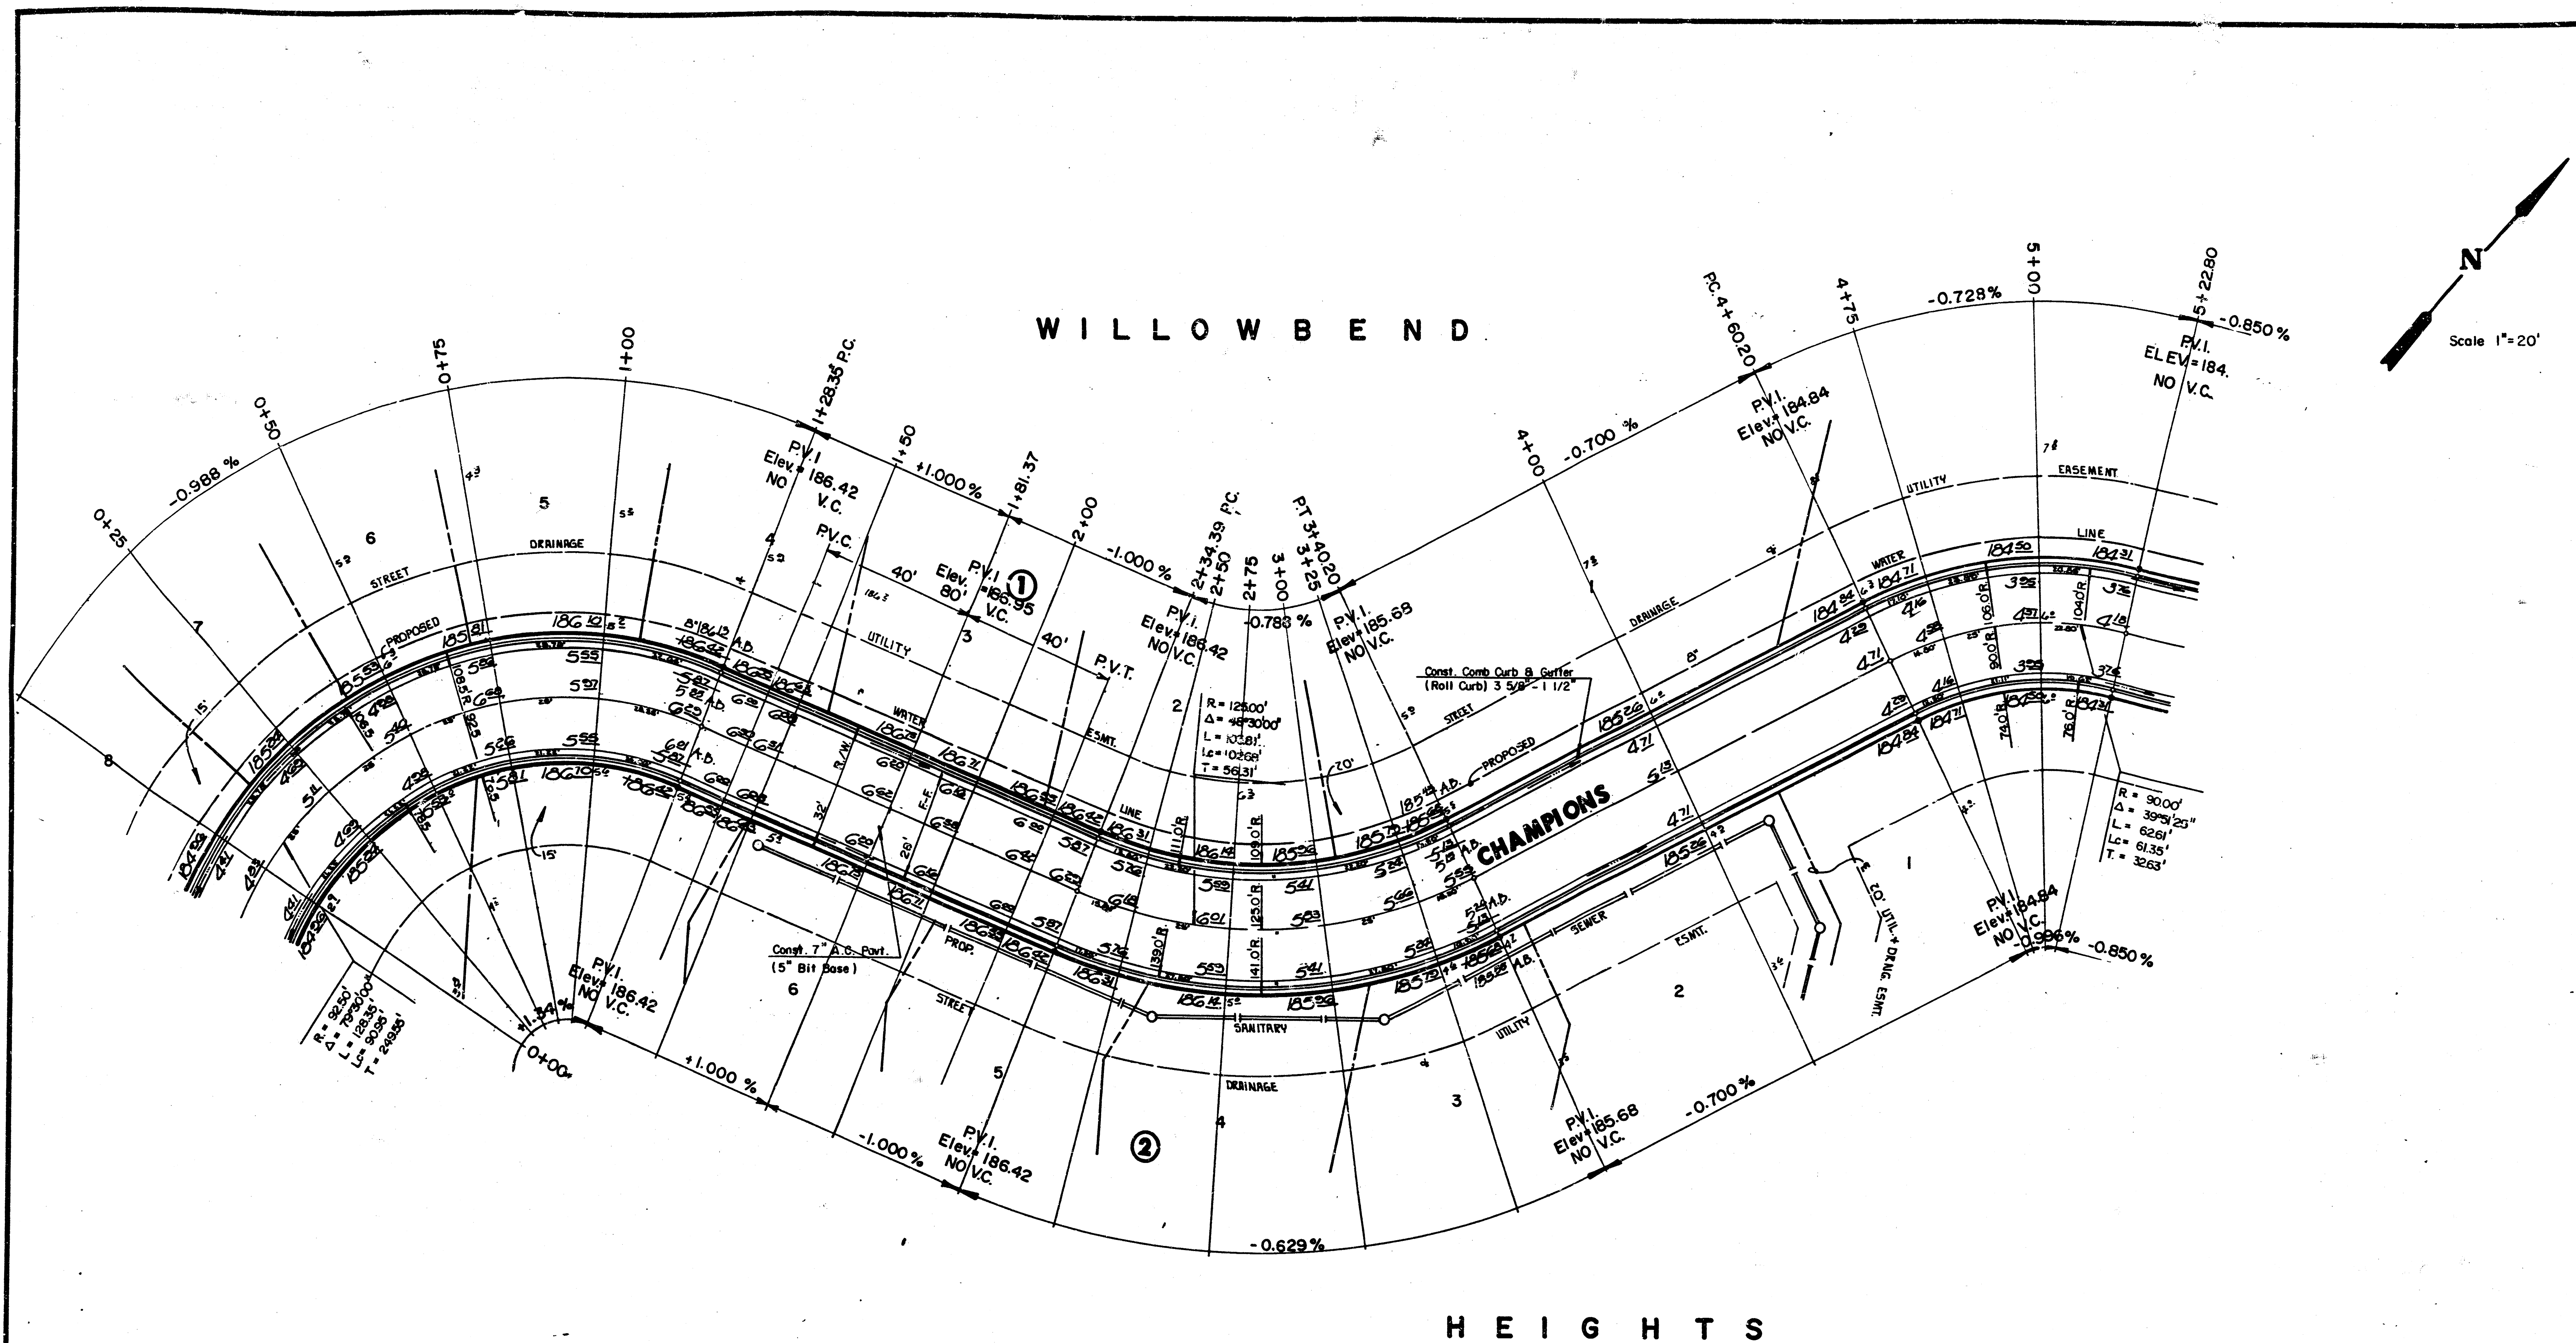

	CITY OF WICHITA	Design F.F.
	CHAMPIONS	Design E.C.G.
	PROJECT NO. 472-76-245-80001-000-000-031	Checked by
		Date
MID-KANSAS ENGINEERING CONSULTANTS PA 3500 NORTH ROCK ROAD BUILDING 1800 WICHITA, KANSAS 67226		Job no.
NOV. 12, 1987		Sheet 3 of 7

FILMED FROM THE BEST
AVAILABLE COPY

WILLOWBEND

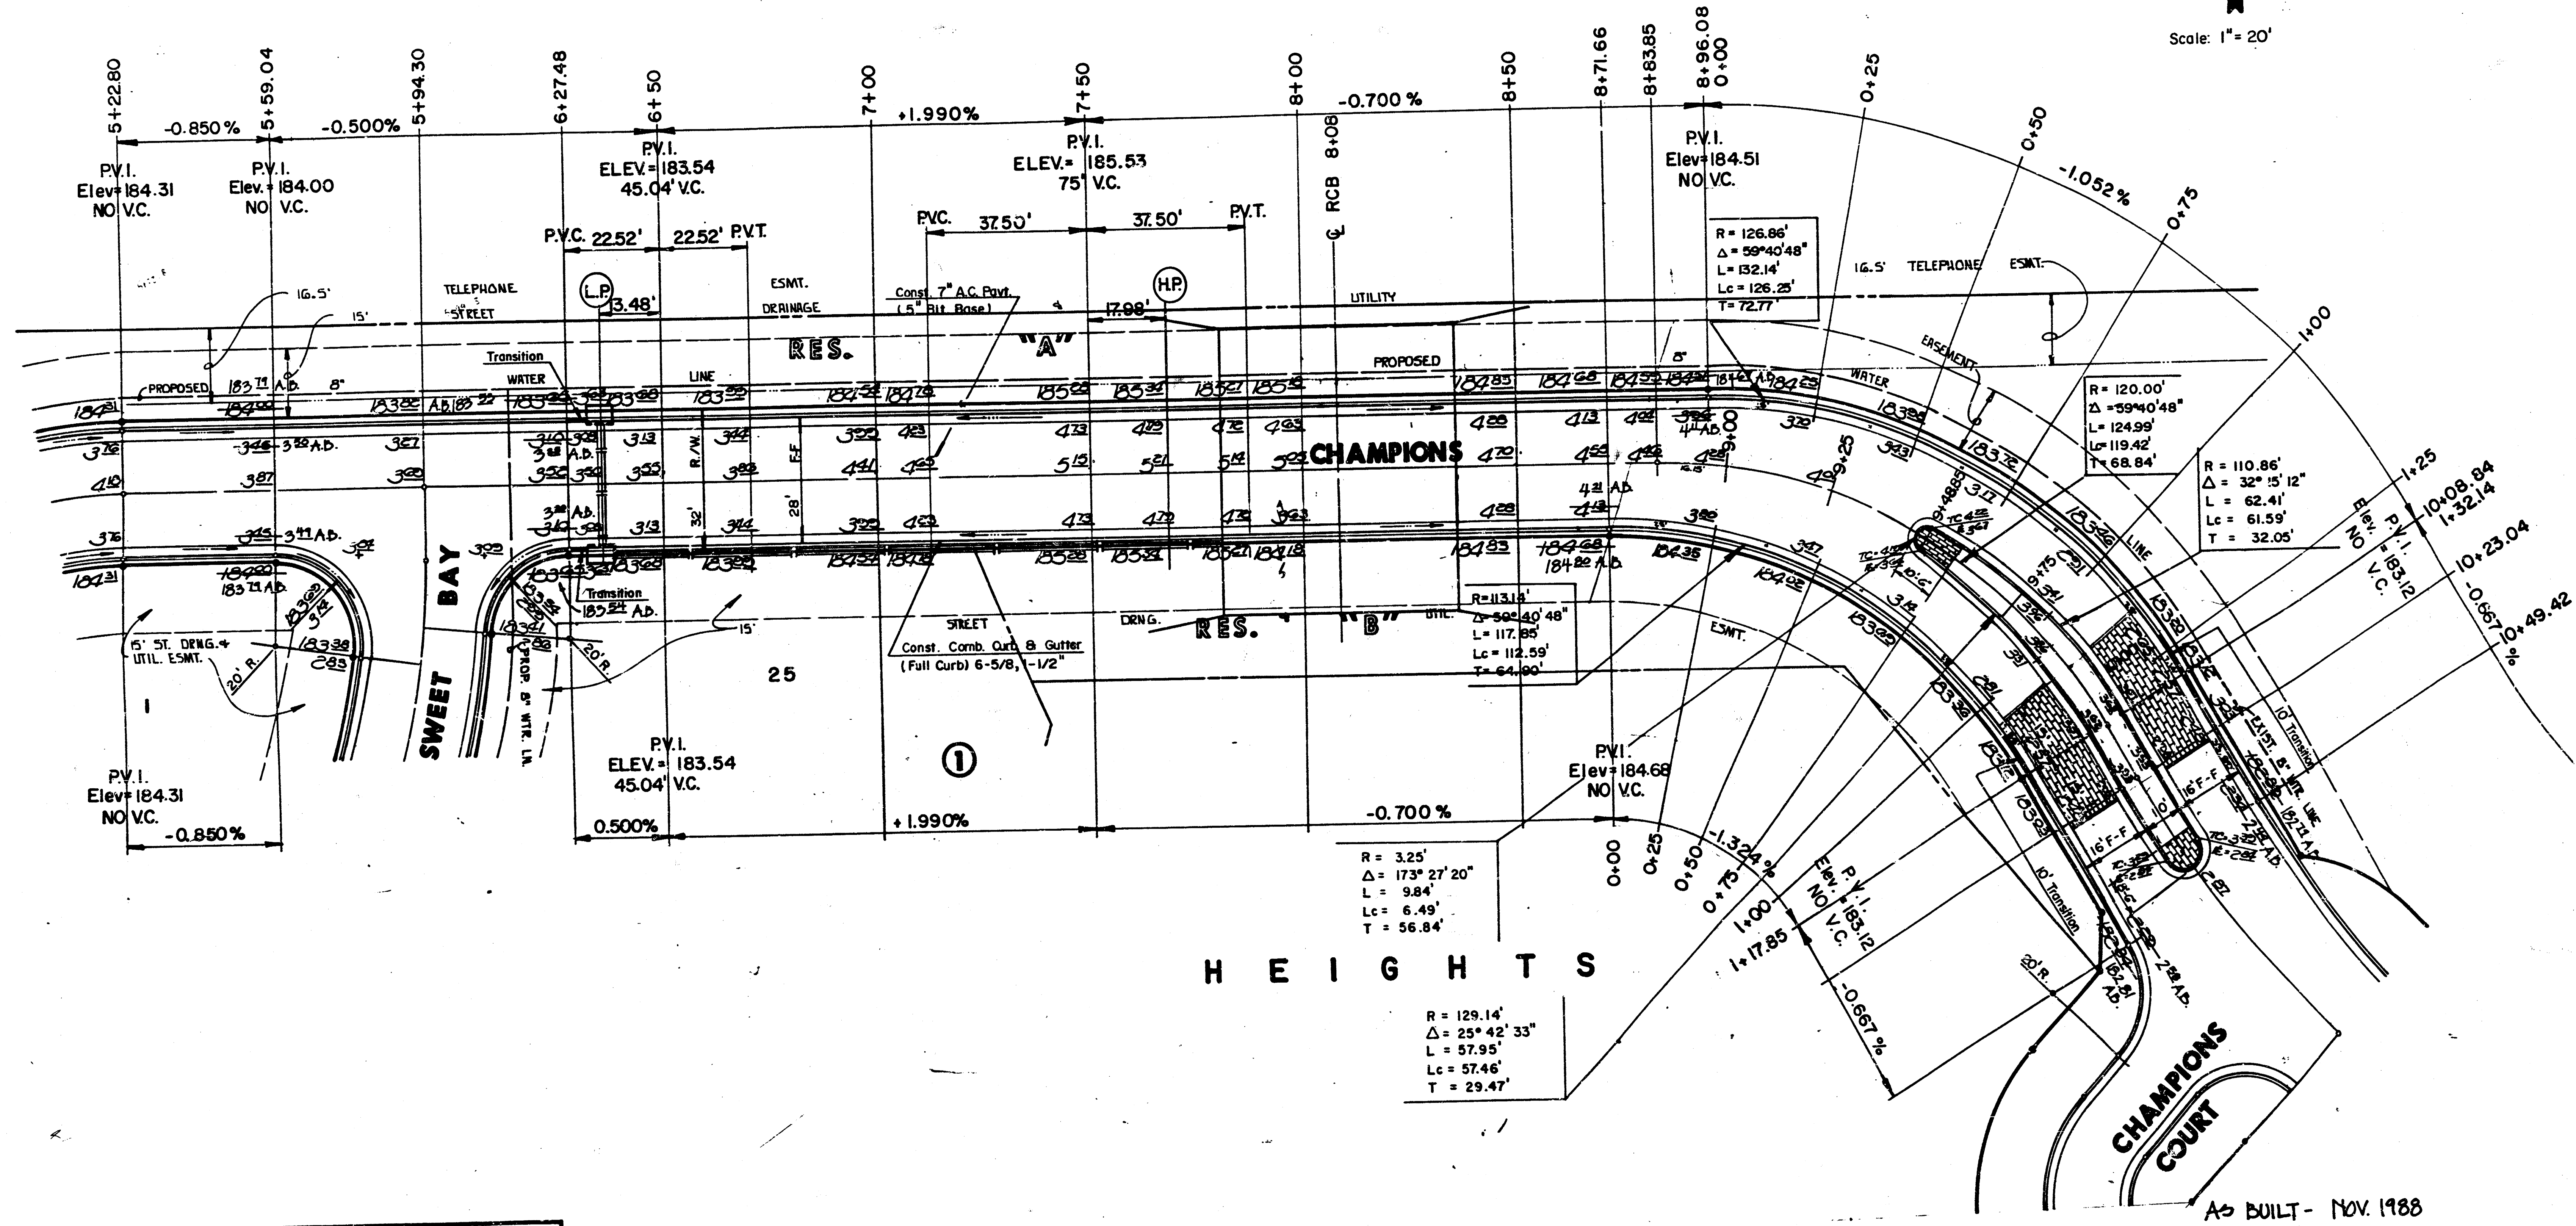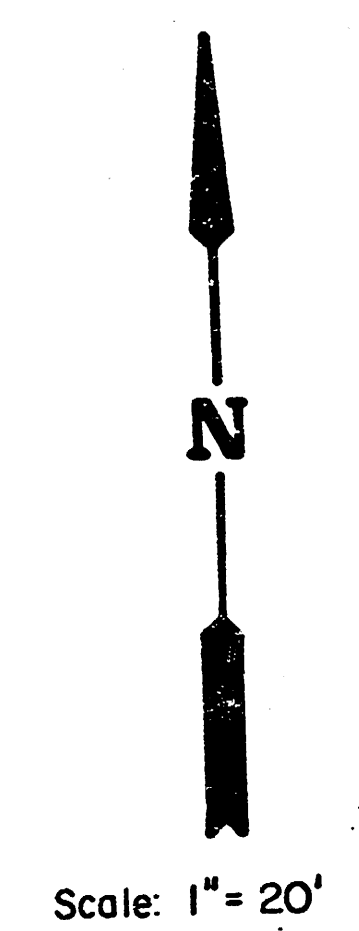

NOTE:
Top Of Curb Elevations Shown For
Full Curb, Construct Combined Curb
& Gutter (Roll Type).

	CITY OF WICHITA	Design FF
	CHAMPIONS	Drawn by E.C.G.
	PROJECT NO. 472-76-245-80001-000-000-031	Checked by
MID-KANSAS ENGINEERING CONSULTANTS PA 3500 NORTH ROCK ROAD BUILDING 1800 WICHITA, KANSAS 67226		Date Job no. Sheet 4 7 of 6


NOTE:

Top Of Curb Elevations Shown For
Full Curb, Construct Combined Curb
& Gutter (Roll Type).



Scale 1"=20'

W I L L O W B E N D

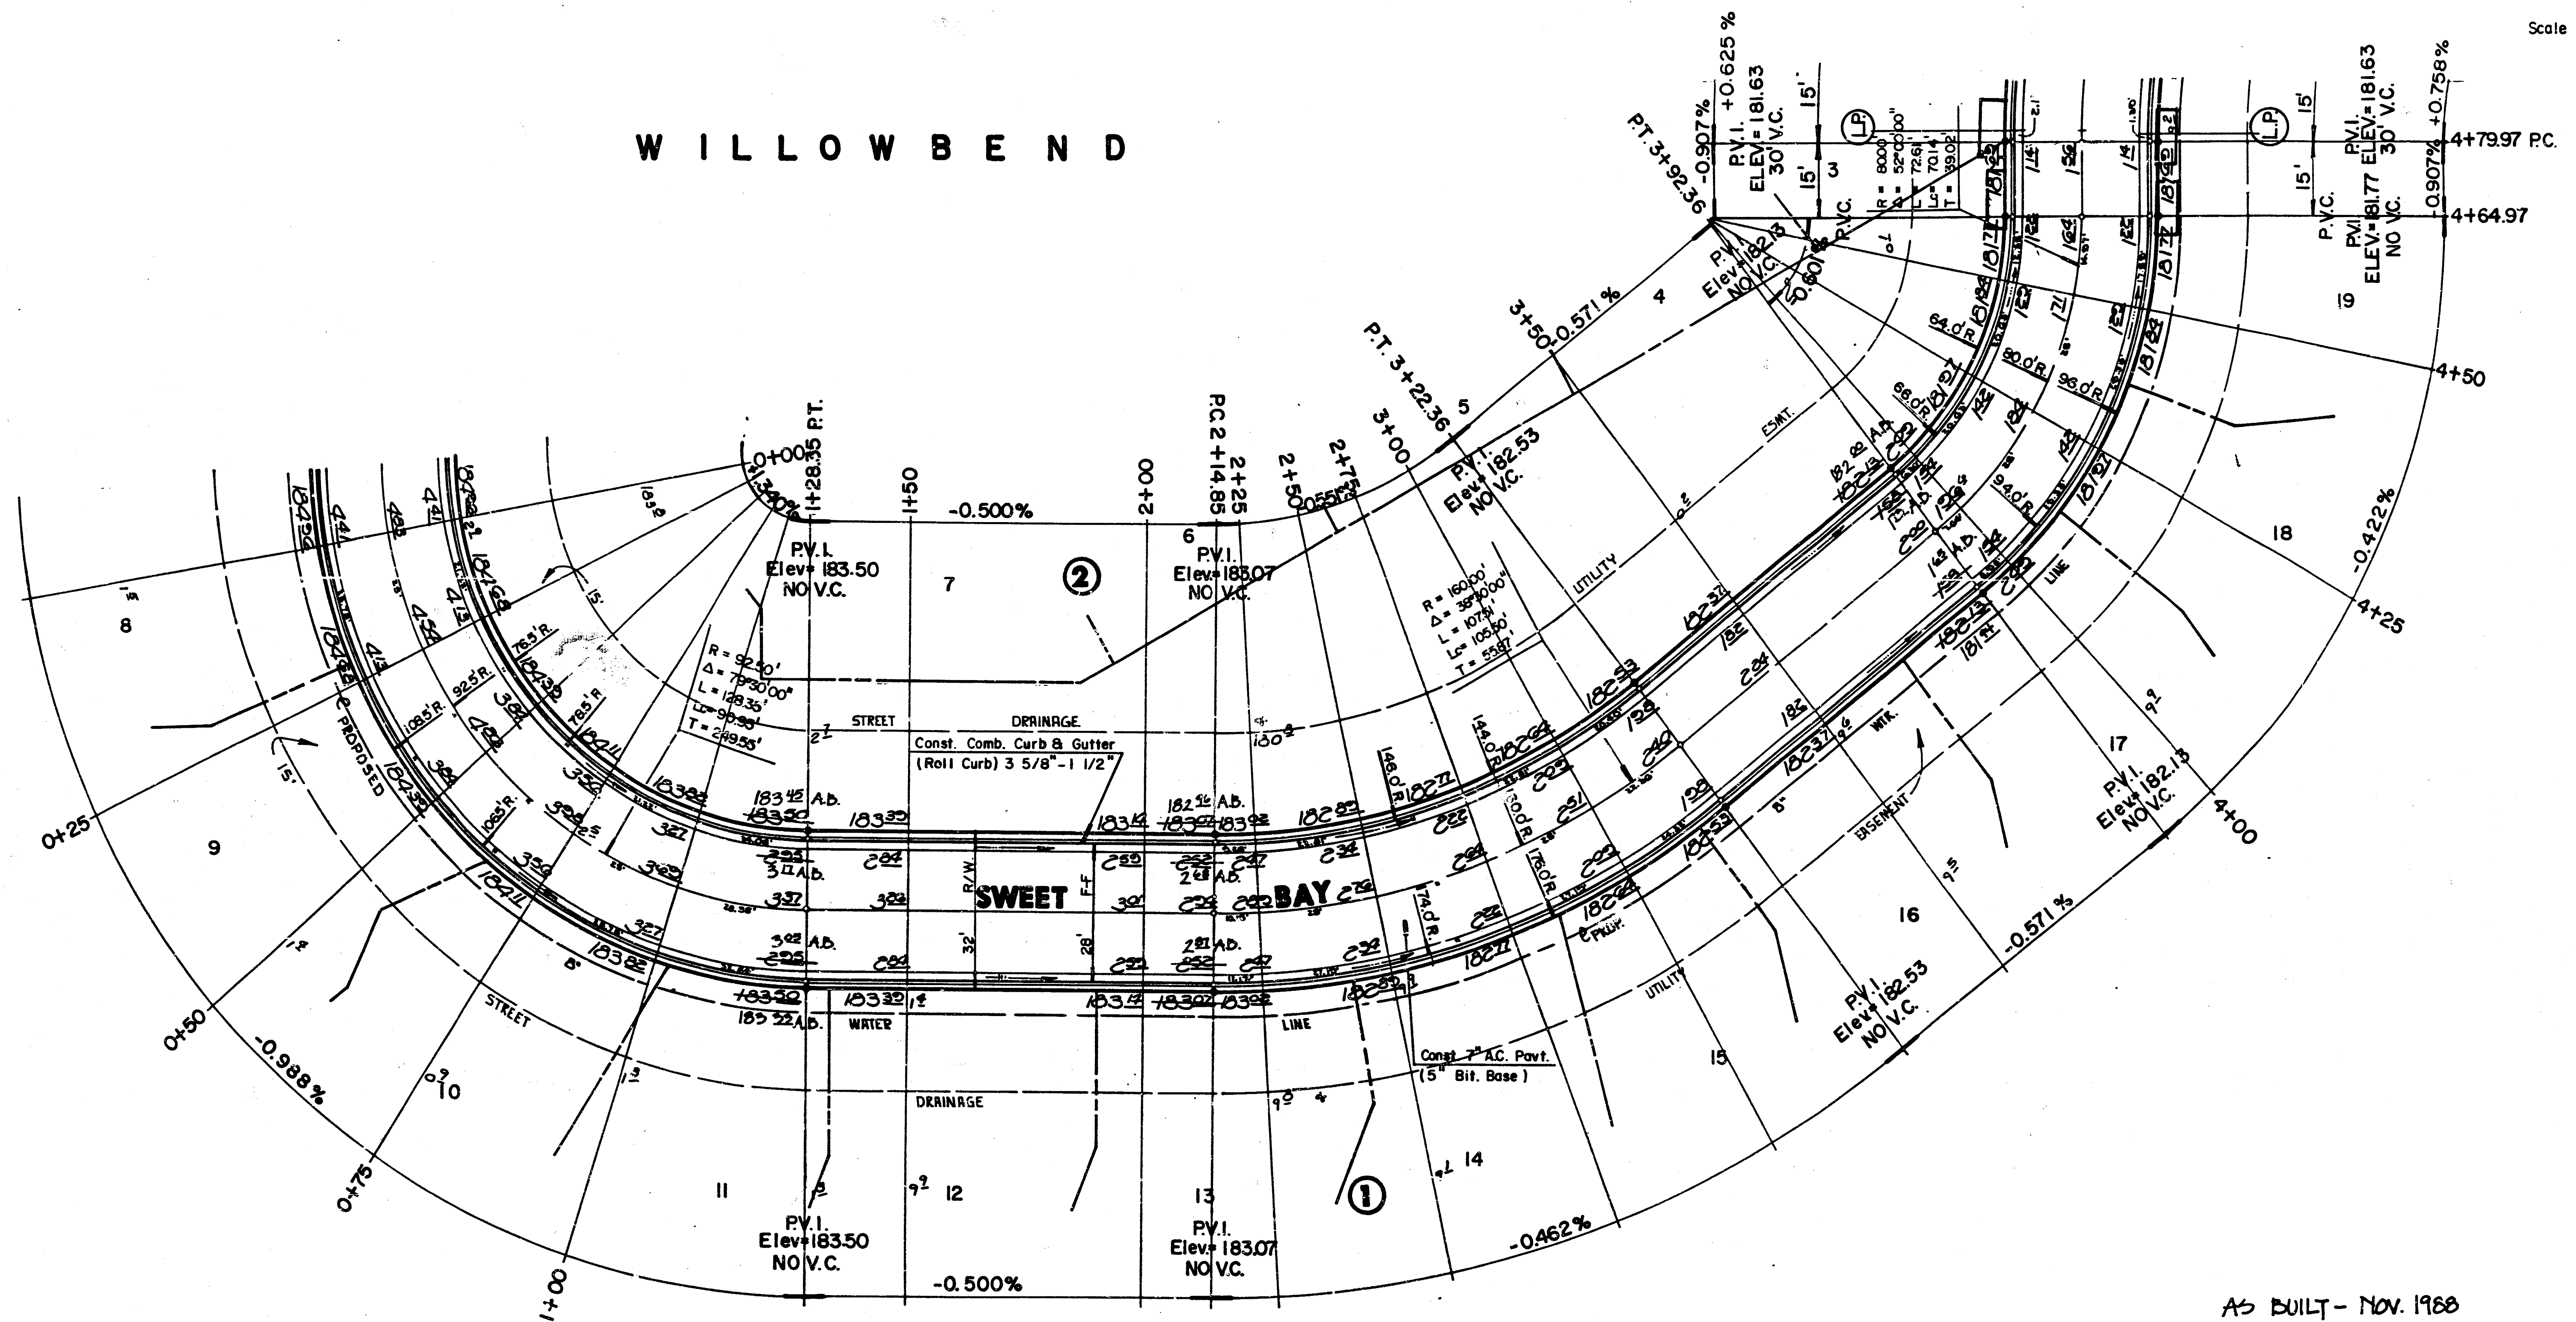

H E I G H T S

As BUILT - Nov. 1988

	CITY OF WICHITA	Design E.F.
	SWEET BAY	Drawn by E.C.G.
	PROJECT NO. 472-76-245-80001-000-000-031	Checked by
	MID-KANSAS ENGINEERING CONSULTANTS PA 3500 NORTH ROCK ROAD BUILDING 1800 WICHITA, KANSAS 67226	Date
		Job no.
		Sheet 5
		of 7 5/8

NOV. 12, 1987


FILMED FROM THE BEST
AVAILABLE COPY

NOTE:

Top Of Curb Elevations Shown For
Full Curb, Construct Combined Curb
& Gutter (Roll Type).



Scale 1"=20'

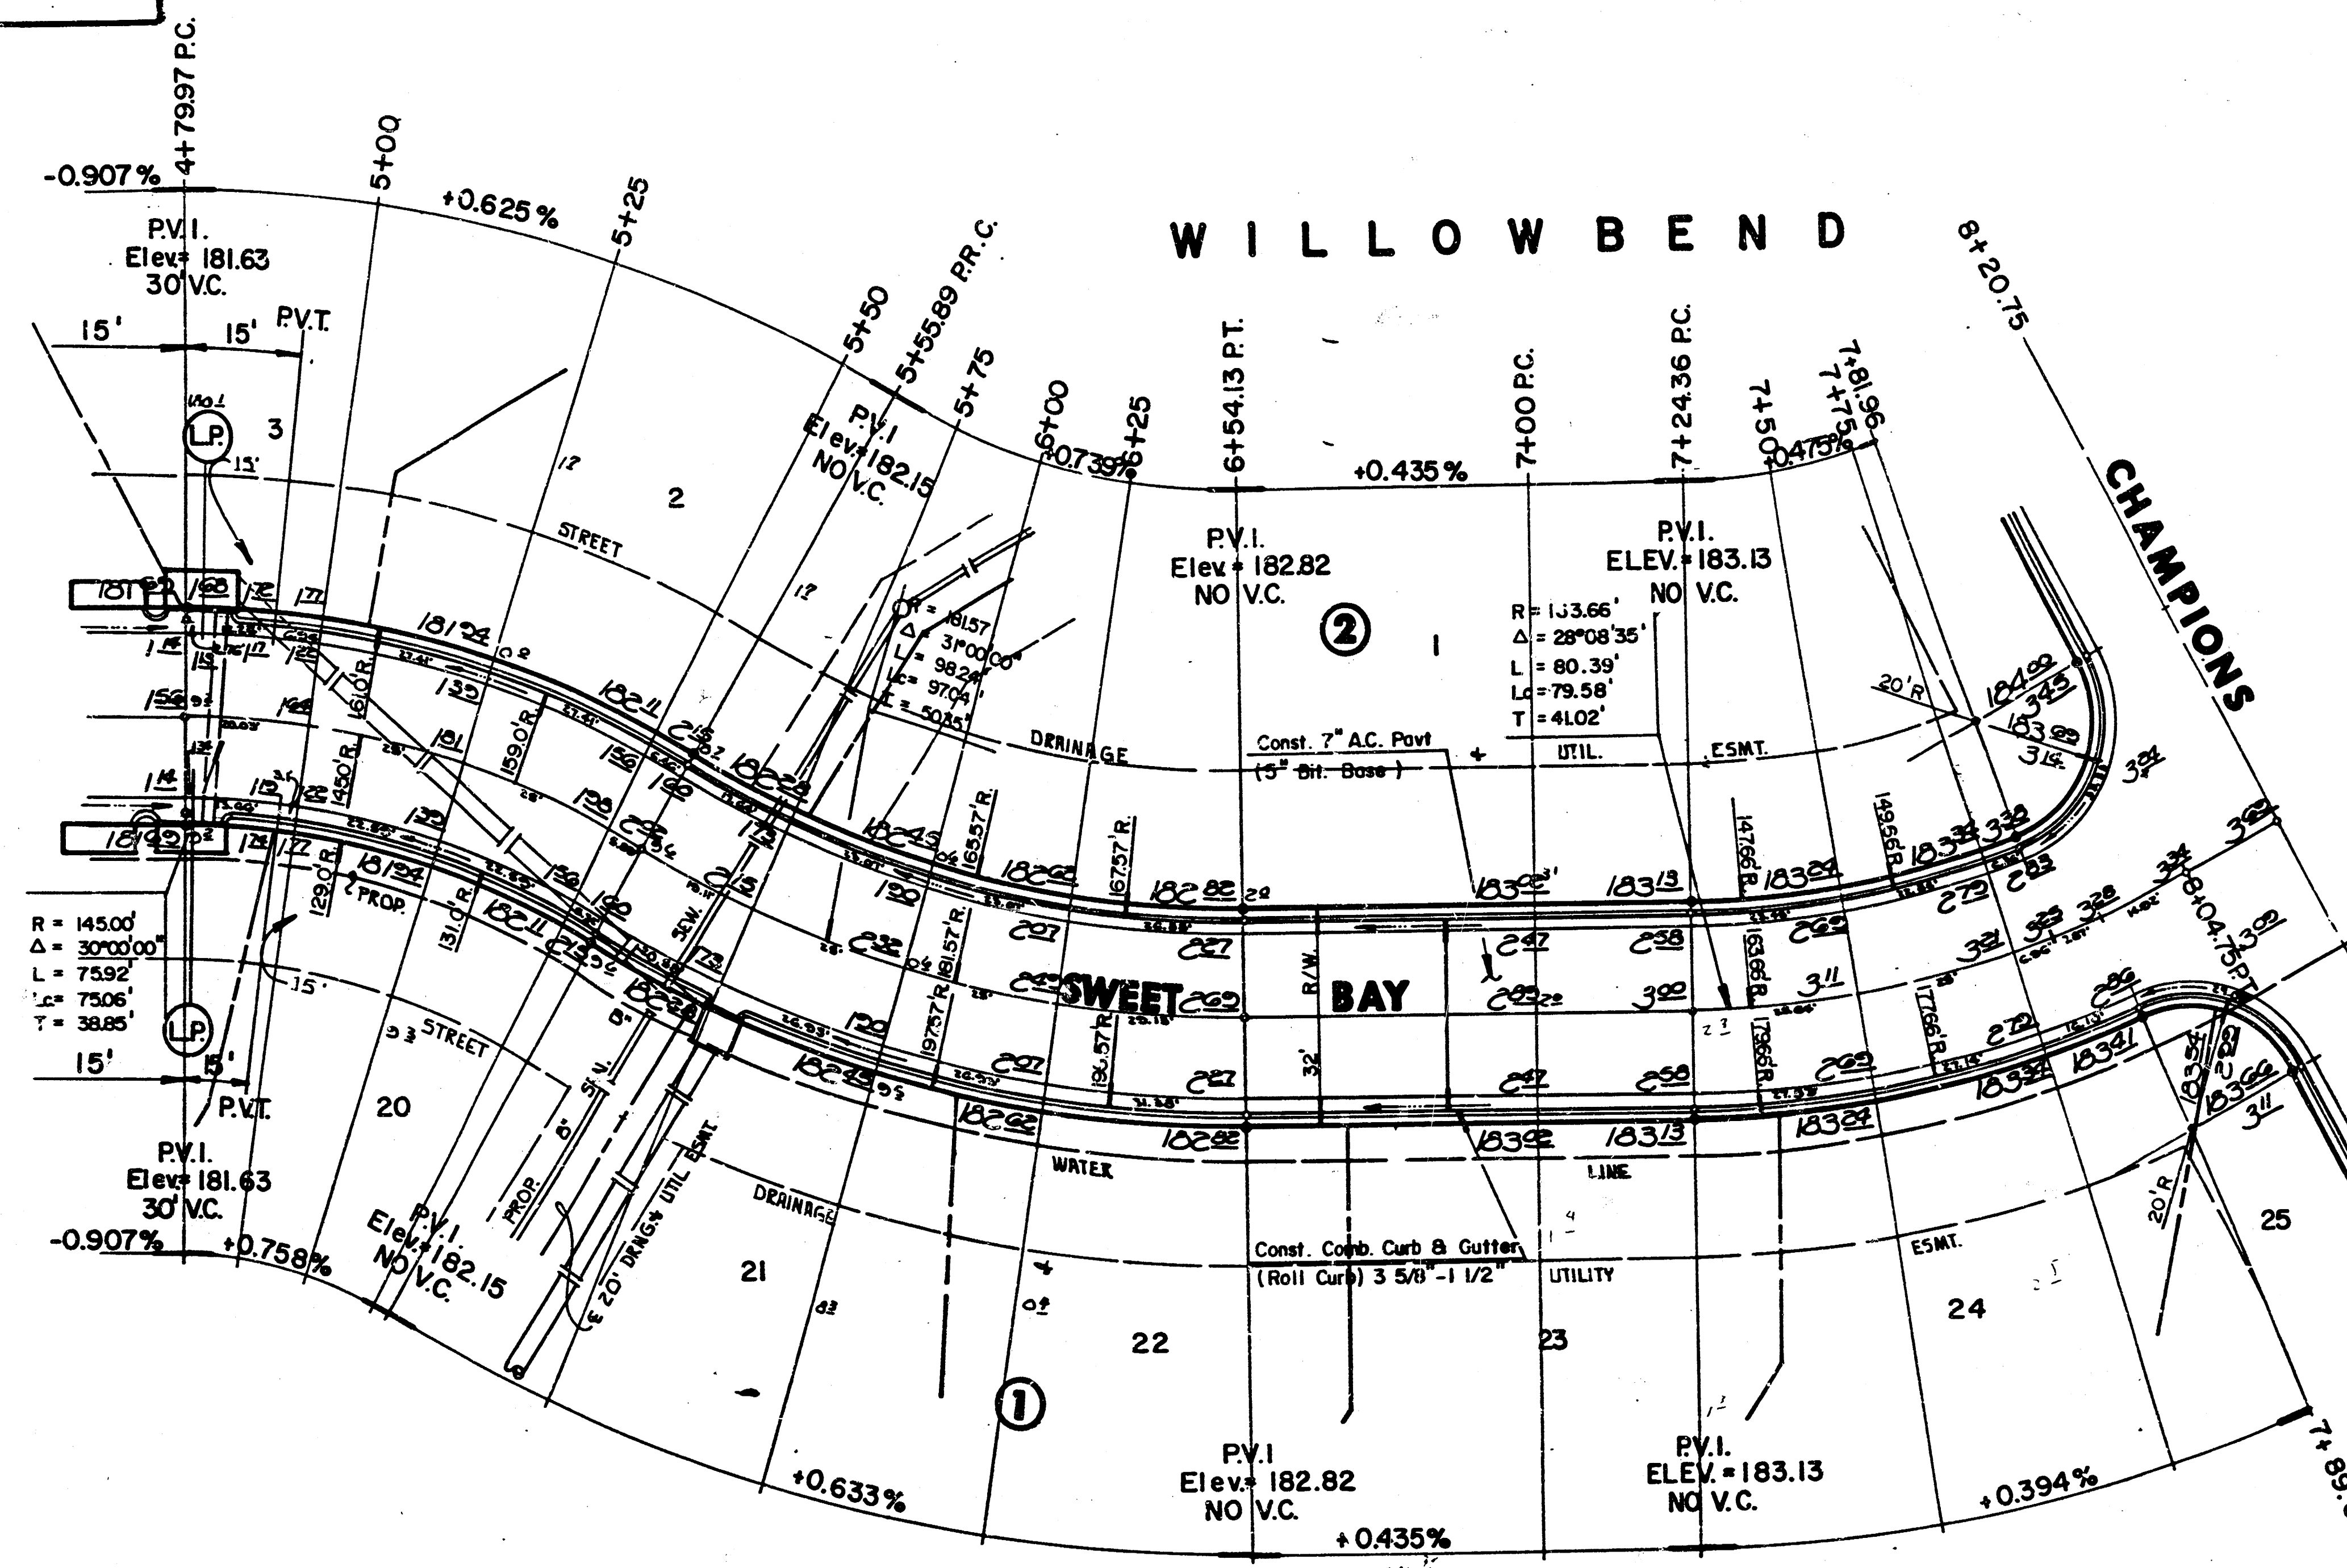

H E I G H T S

AS BUILT - NOV. 1988

	CITY OF WICHITA	Design F.F.
	SWEET BAY	Drawn by E.C.G.
	PROJECT NO. 472-76-245-80001-000-000-031	Checked by
	MID-KANSAS ENGINEERING CONSULTANTS PA 3500 NORTH ROCK ROAD WICHITA, KANSAS 67226	Date
		Job no.
		Sheet 6/6
		7

NOV. 12, 1987

FILMED FROM THE BEST
AVAILABLE COPY