


9-69

N. E. 1/4 SEC. 4, T. 28 S., R. 1 E.

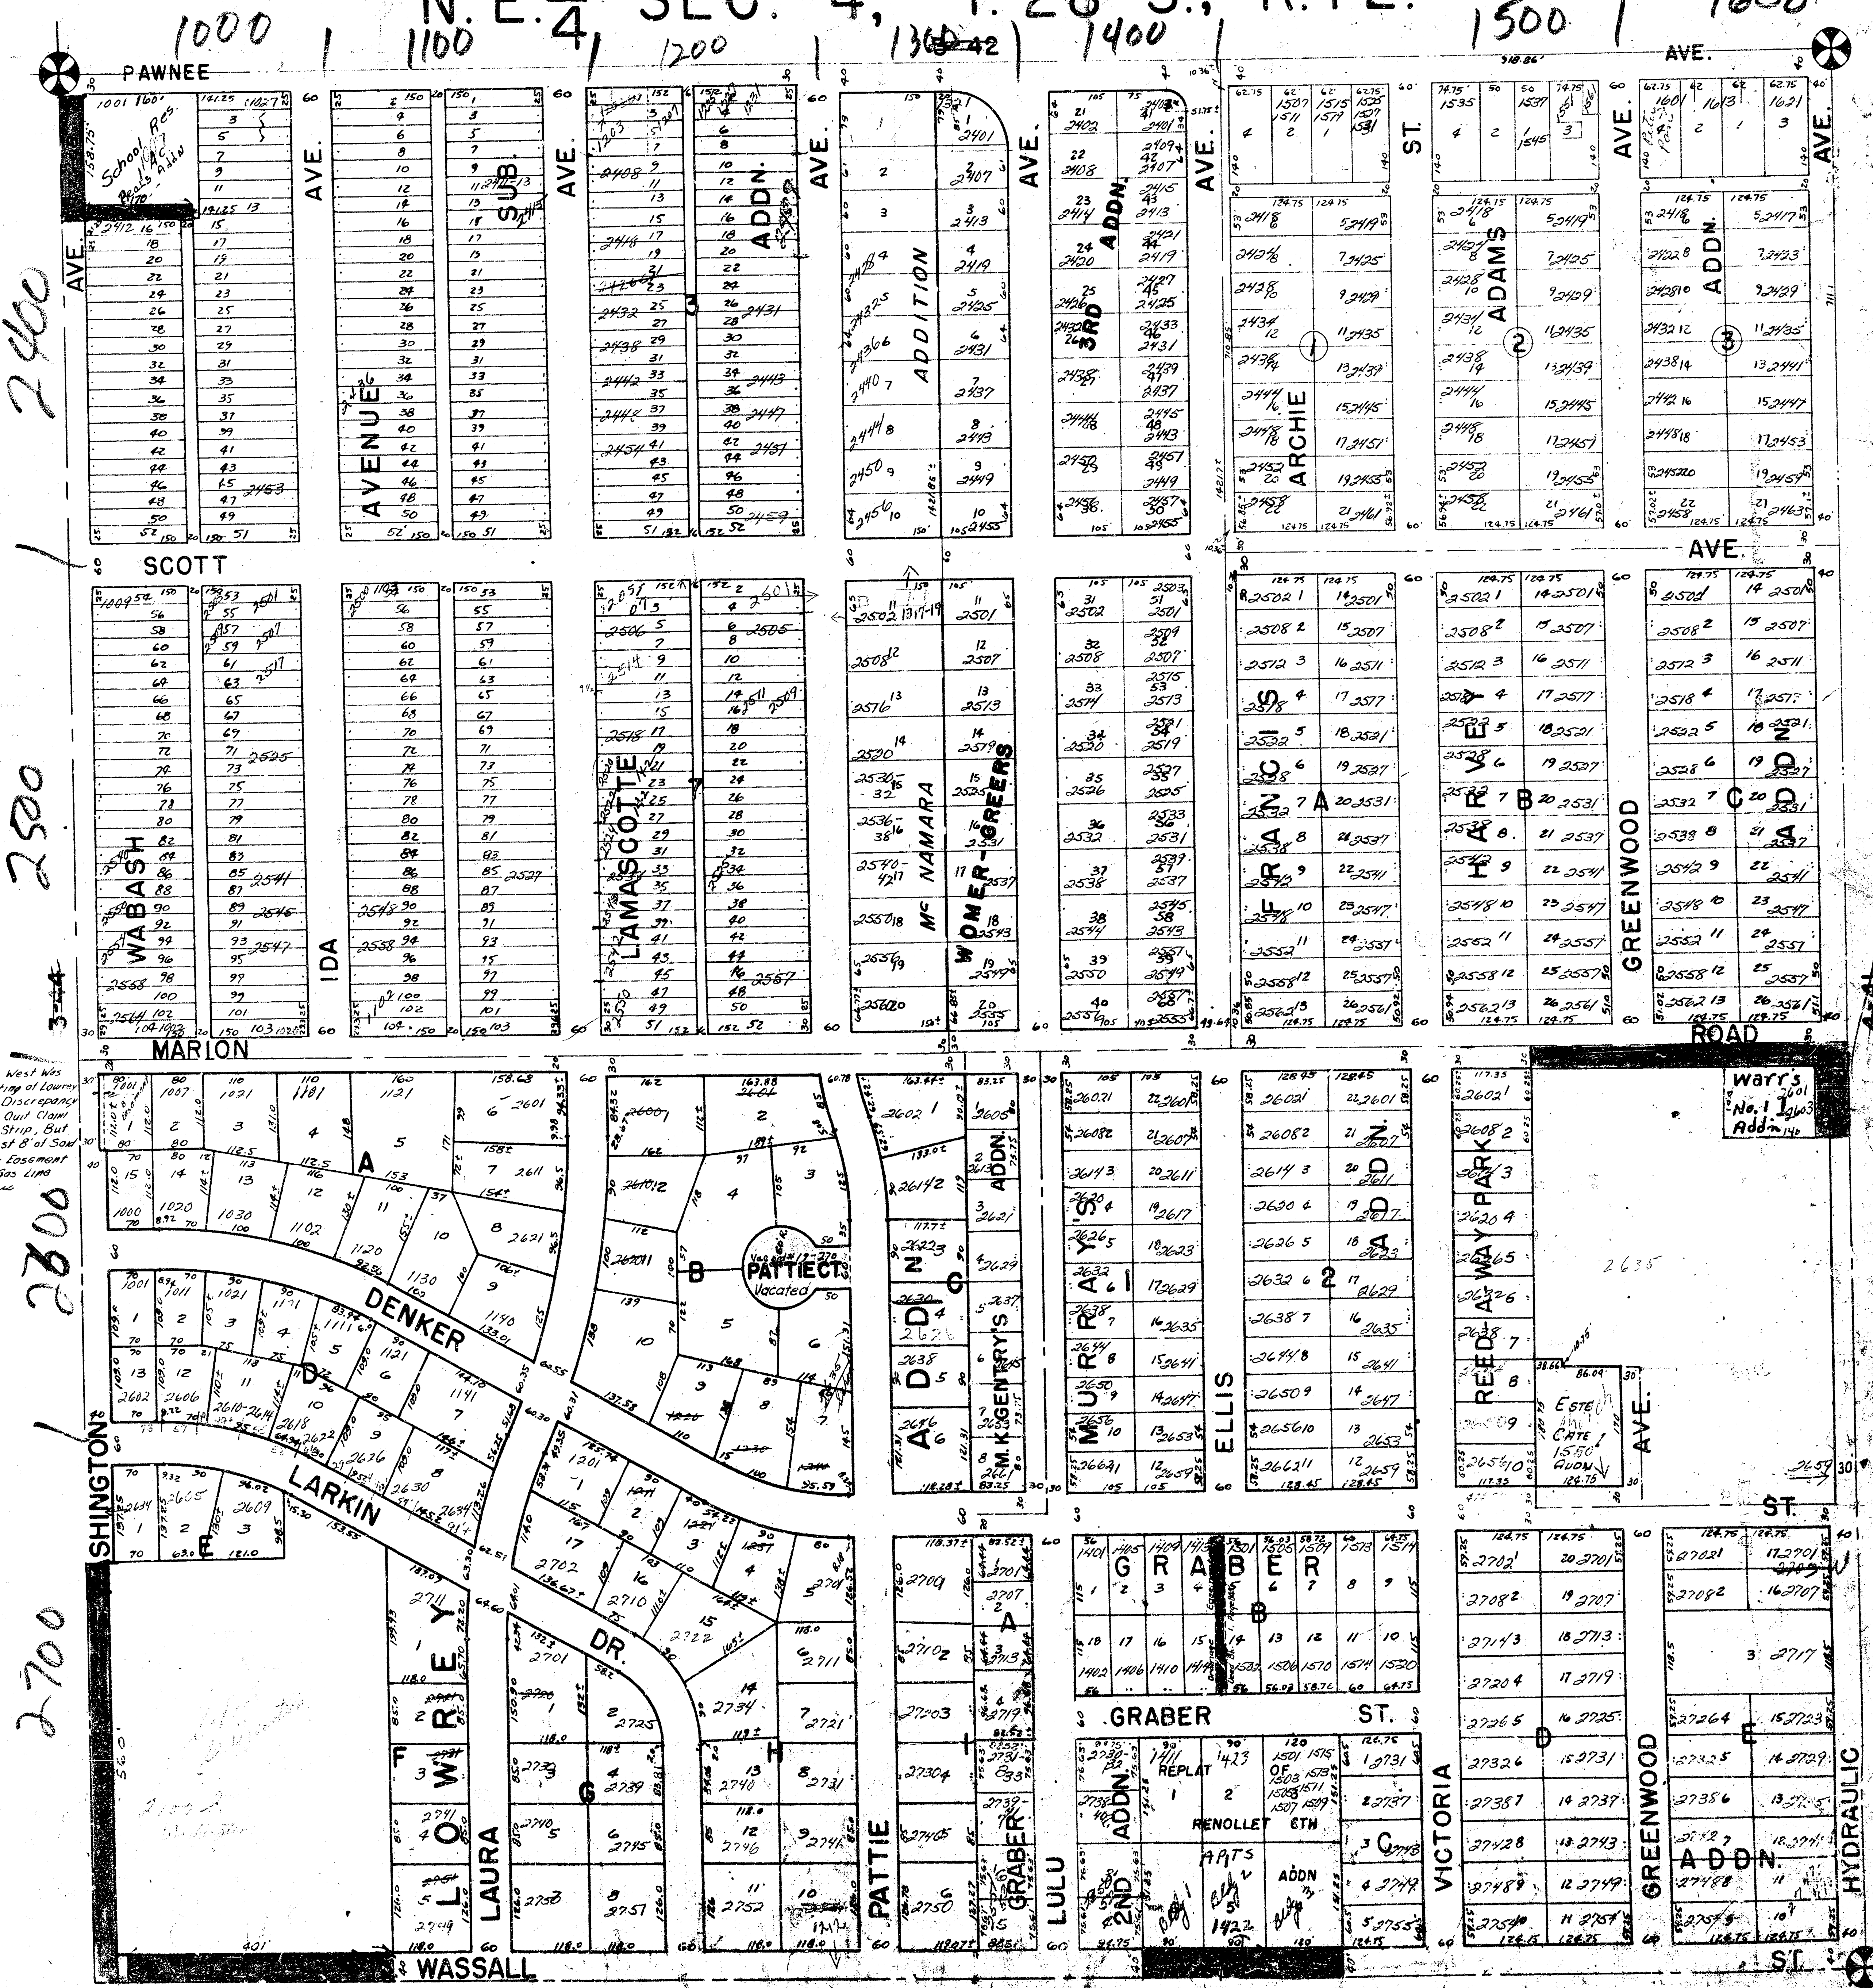

101 14' 10" W. on West line
Said line to Platting of Lower
Addn. Due to this discrepancy
The Ch. Granted a Quit Claim
Deed to said 10' Strip, but
retained the West 8' of said
Strip as a Utility Easement
for an existing Gas line
4/20/57 JWC