


B.M. Elev 106.79 Iron in thimble C.Ellis S.S. Lincoln
 B.M. Elev 106.03 Iron in thimble C.Harris S.S. Harris

26-2-30 Conc.

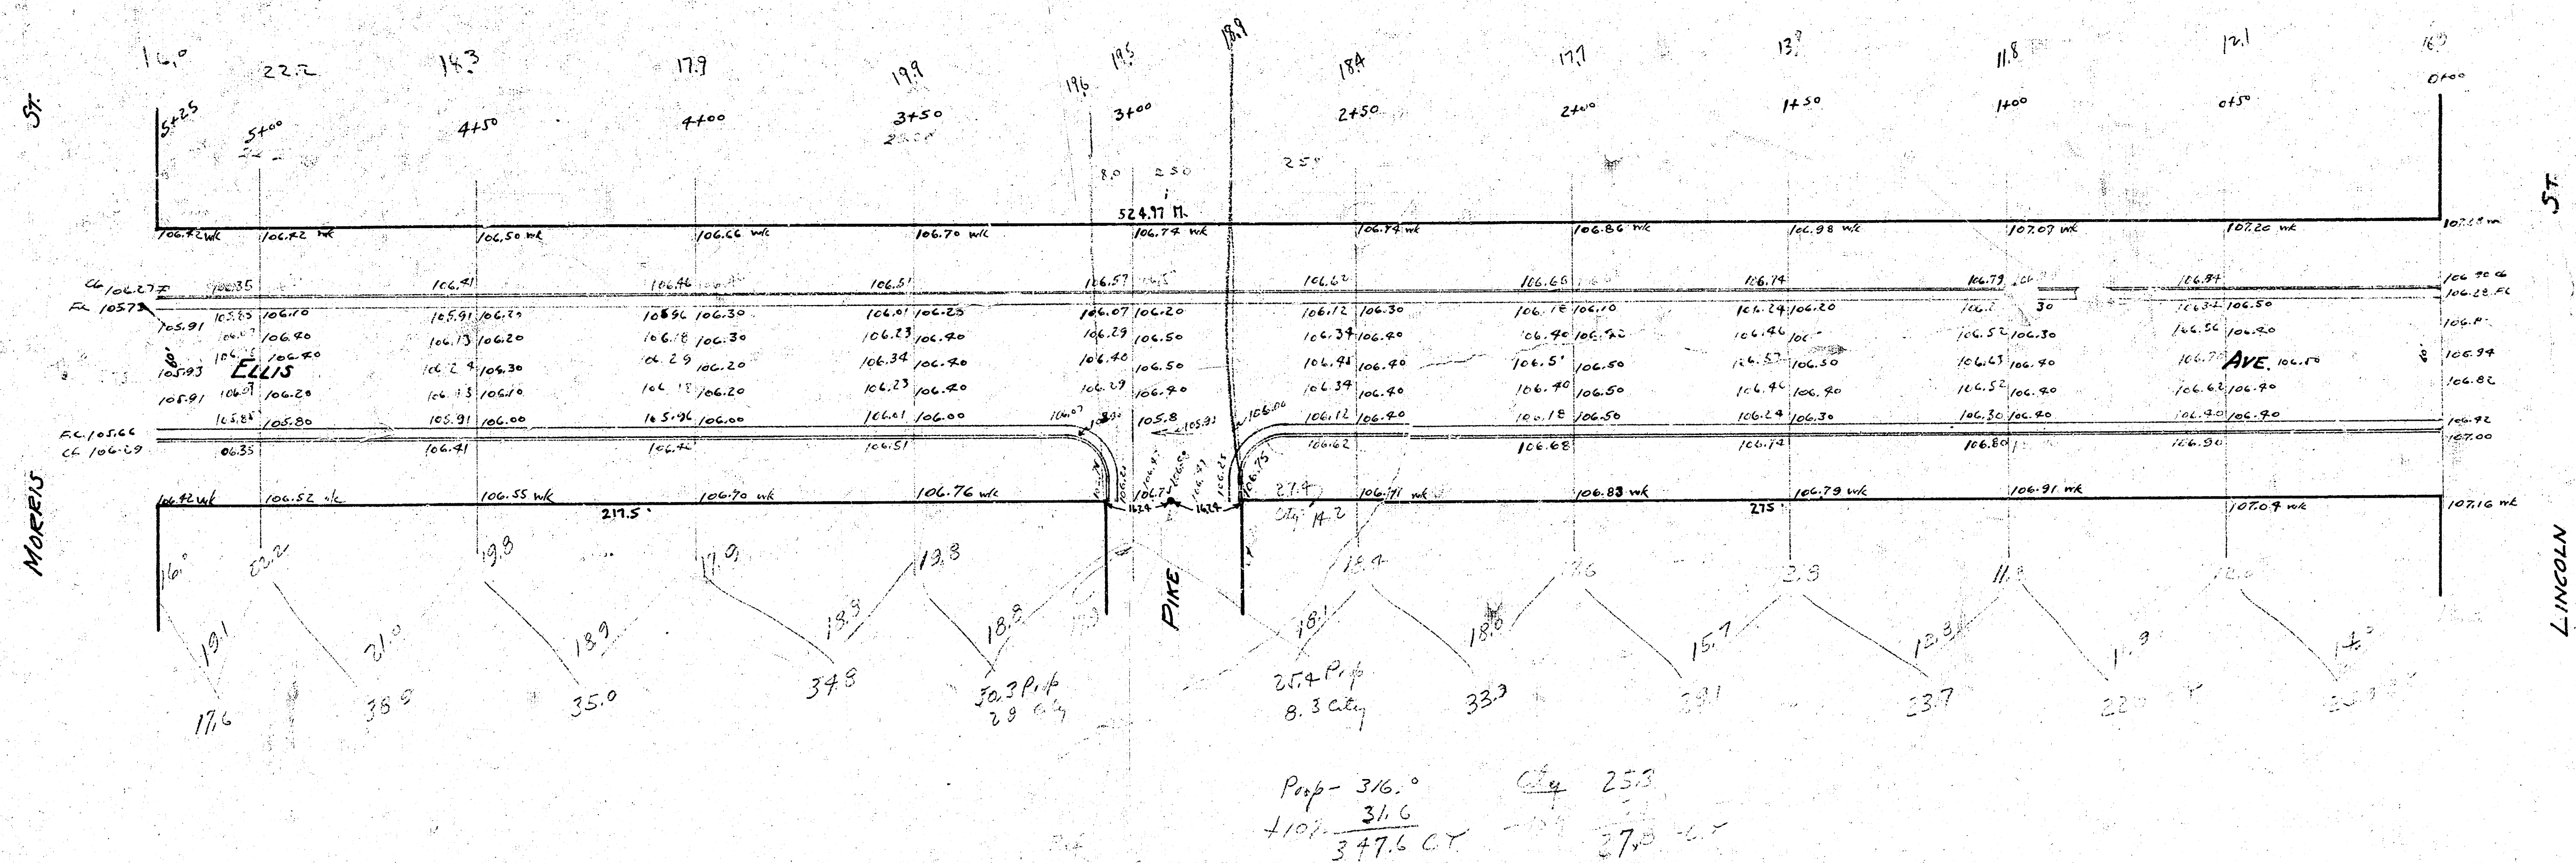

Survey Plot
 1739
 Ellis Ave
 N. Lincoln
 S. Harris