


THE URBAN RENEWAL AGENCY
OF THE
WICHITA, KANSAS, METROPOLITAN AREA

R. S. DELAMATER & ASSOCIATES
CONSULTING ENGINEERS
WICHITA, KANSAS

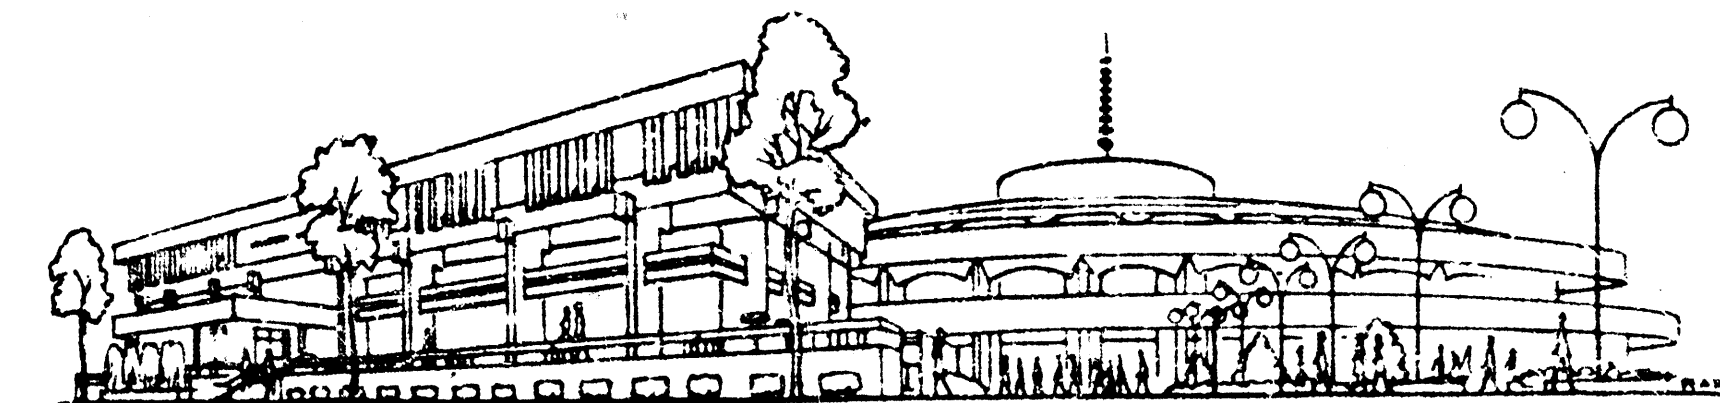

1. Title Sheet
2. Storm Sewer Plan I
3. Storm Sewer Plan II
4. Sewer Appurtenances
5. Curb Inlet Details
6. Pavement Plan I
7. Pavement Plan II
8. Pavement Plan III
9. Pavement Plan IV
10. Pavement Plan V
11. Pavement Plan VI
12. Pavement Plan VII
13. Pavement Details
14. Auxiliary Details

Arkansas River

Little

Brady

Salina Street

Alcott Street

26th Street

Woodland

27th Street

Mascot

Shelton

Avenue

26th St

AS BUILT PLANS
Feb. 15, 1973



OWNER FIELD OFFICE
4529


R. S. DELAMATER & ASSOCIATES
513


260-B

AS BUILT PLANS
FEB. 15, 1973










260-B-1

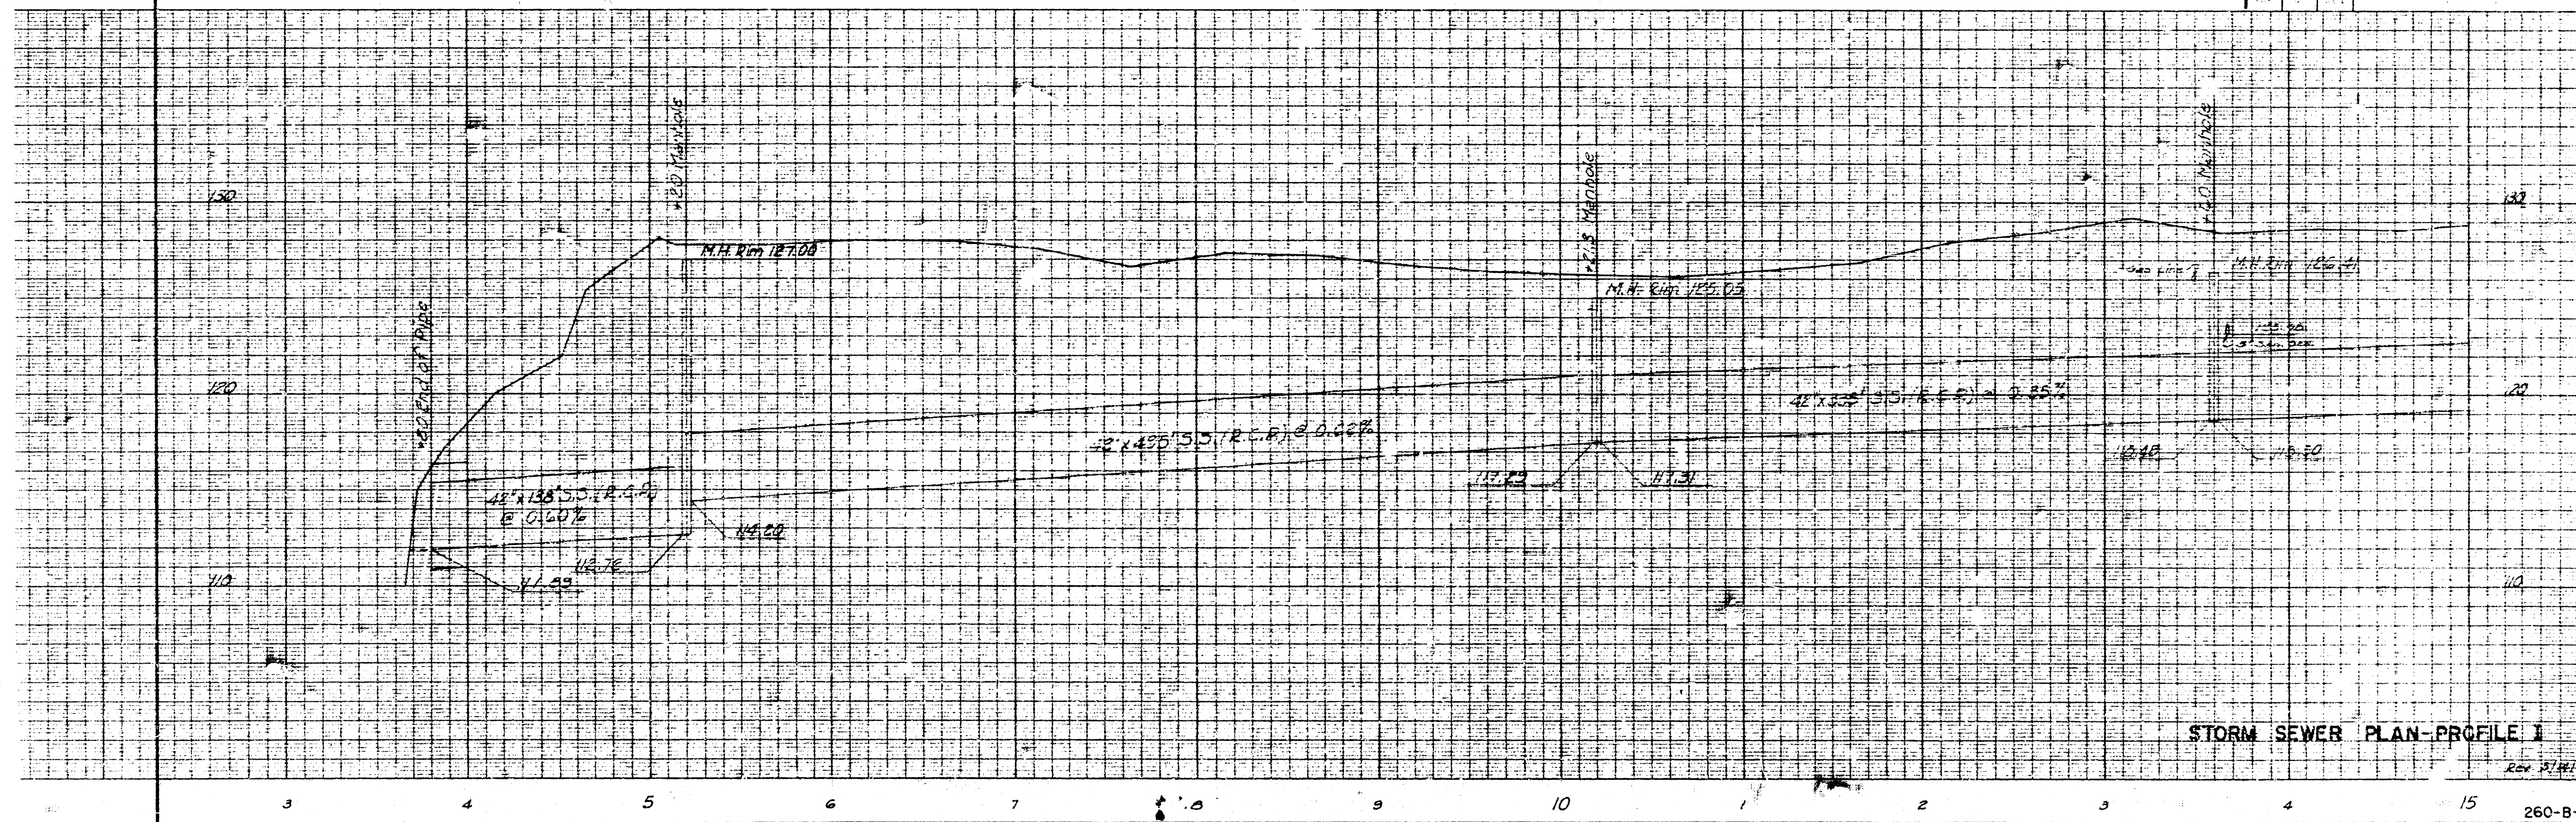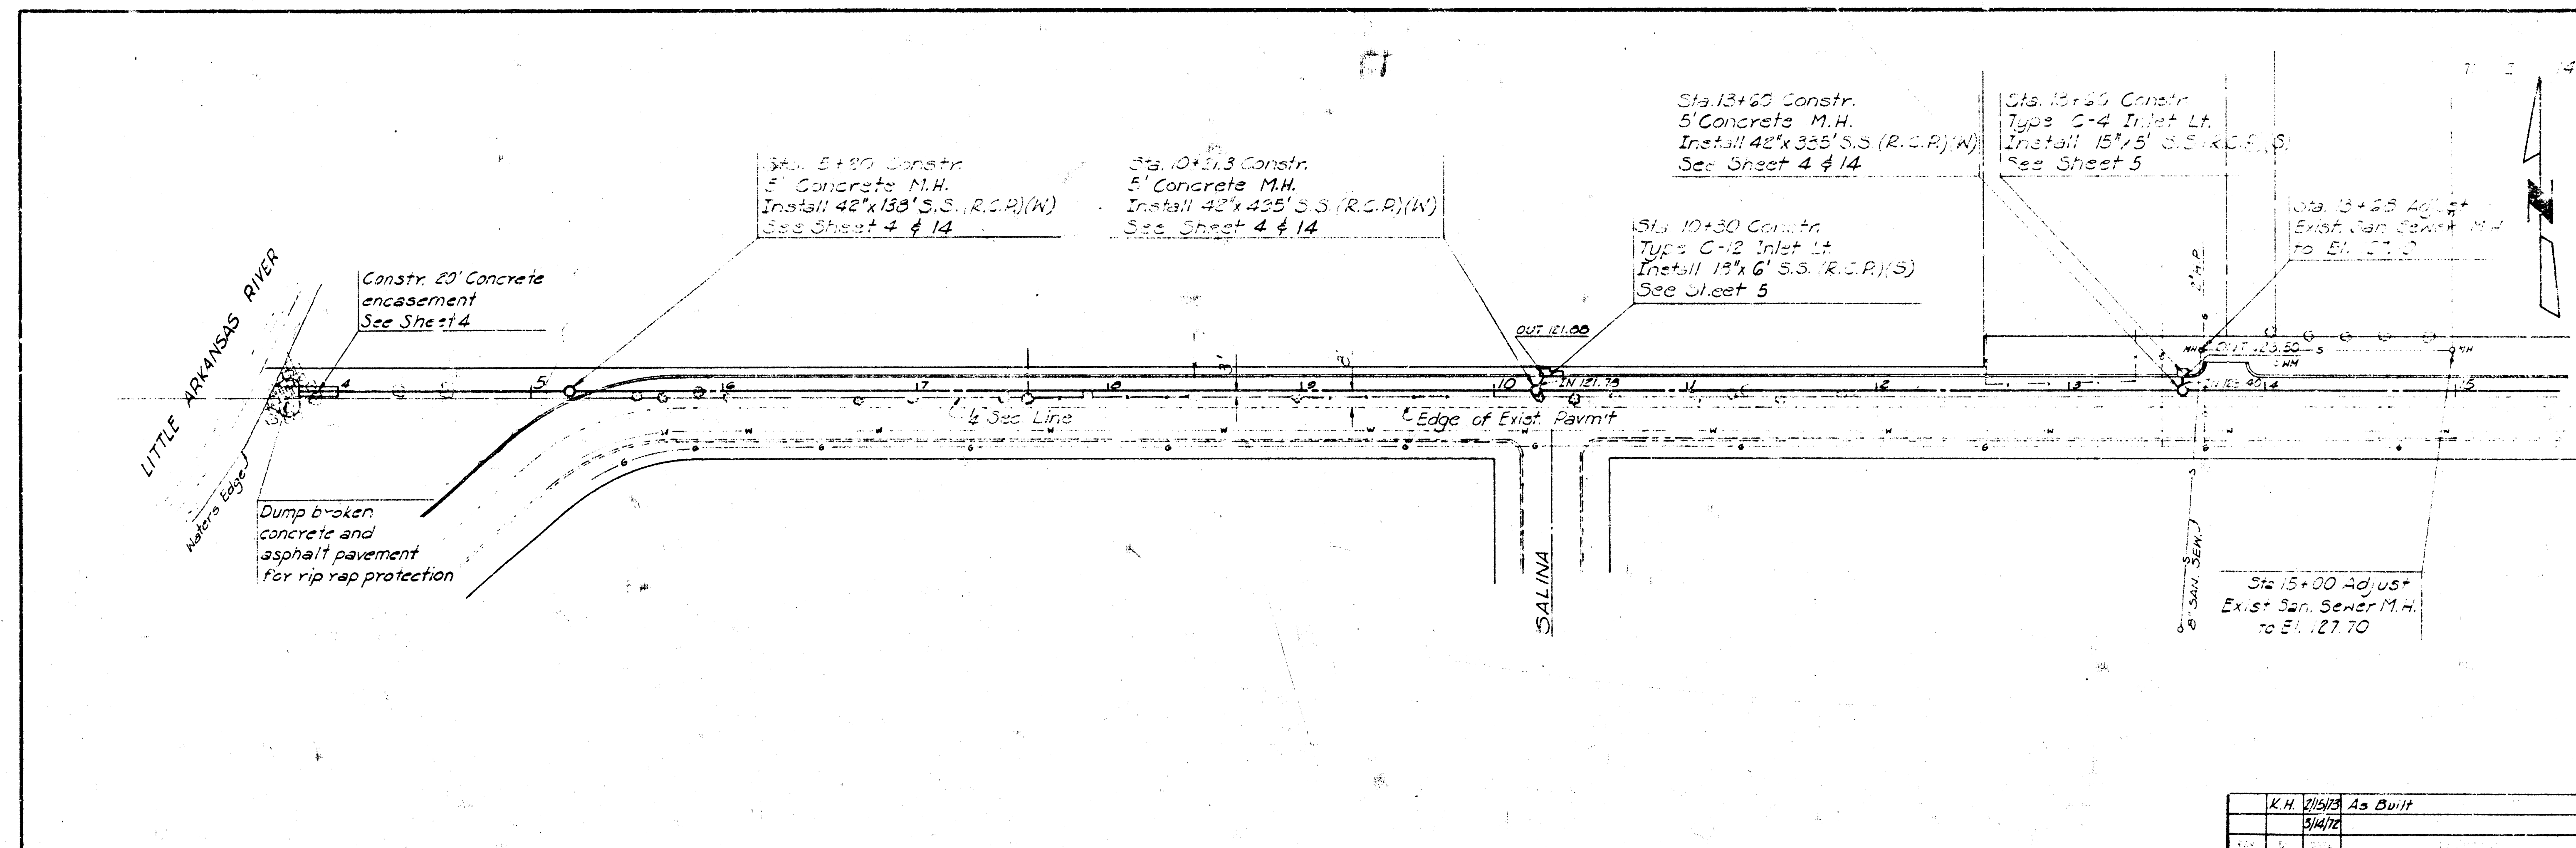

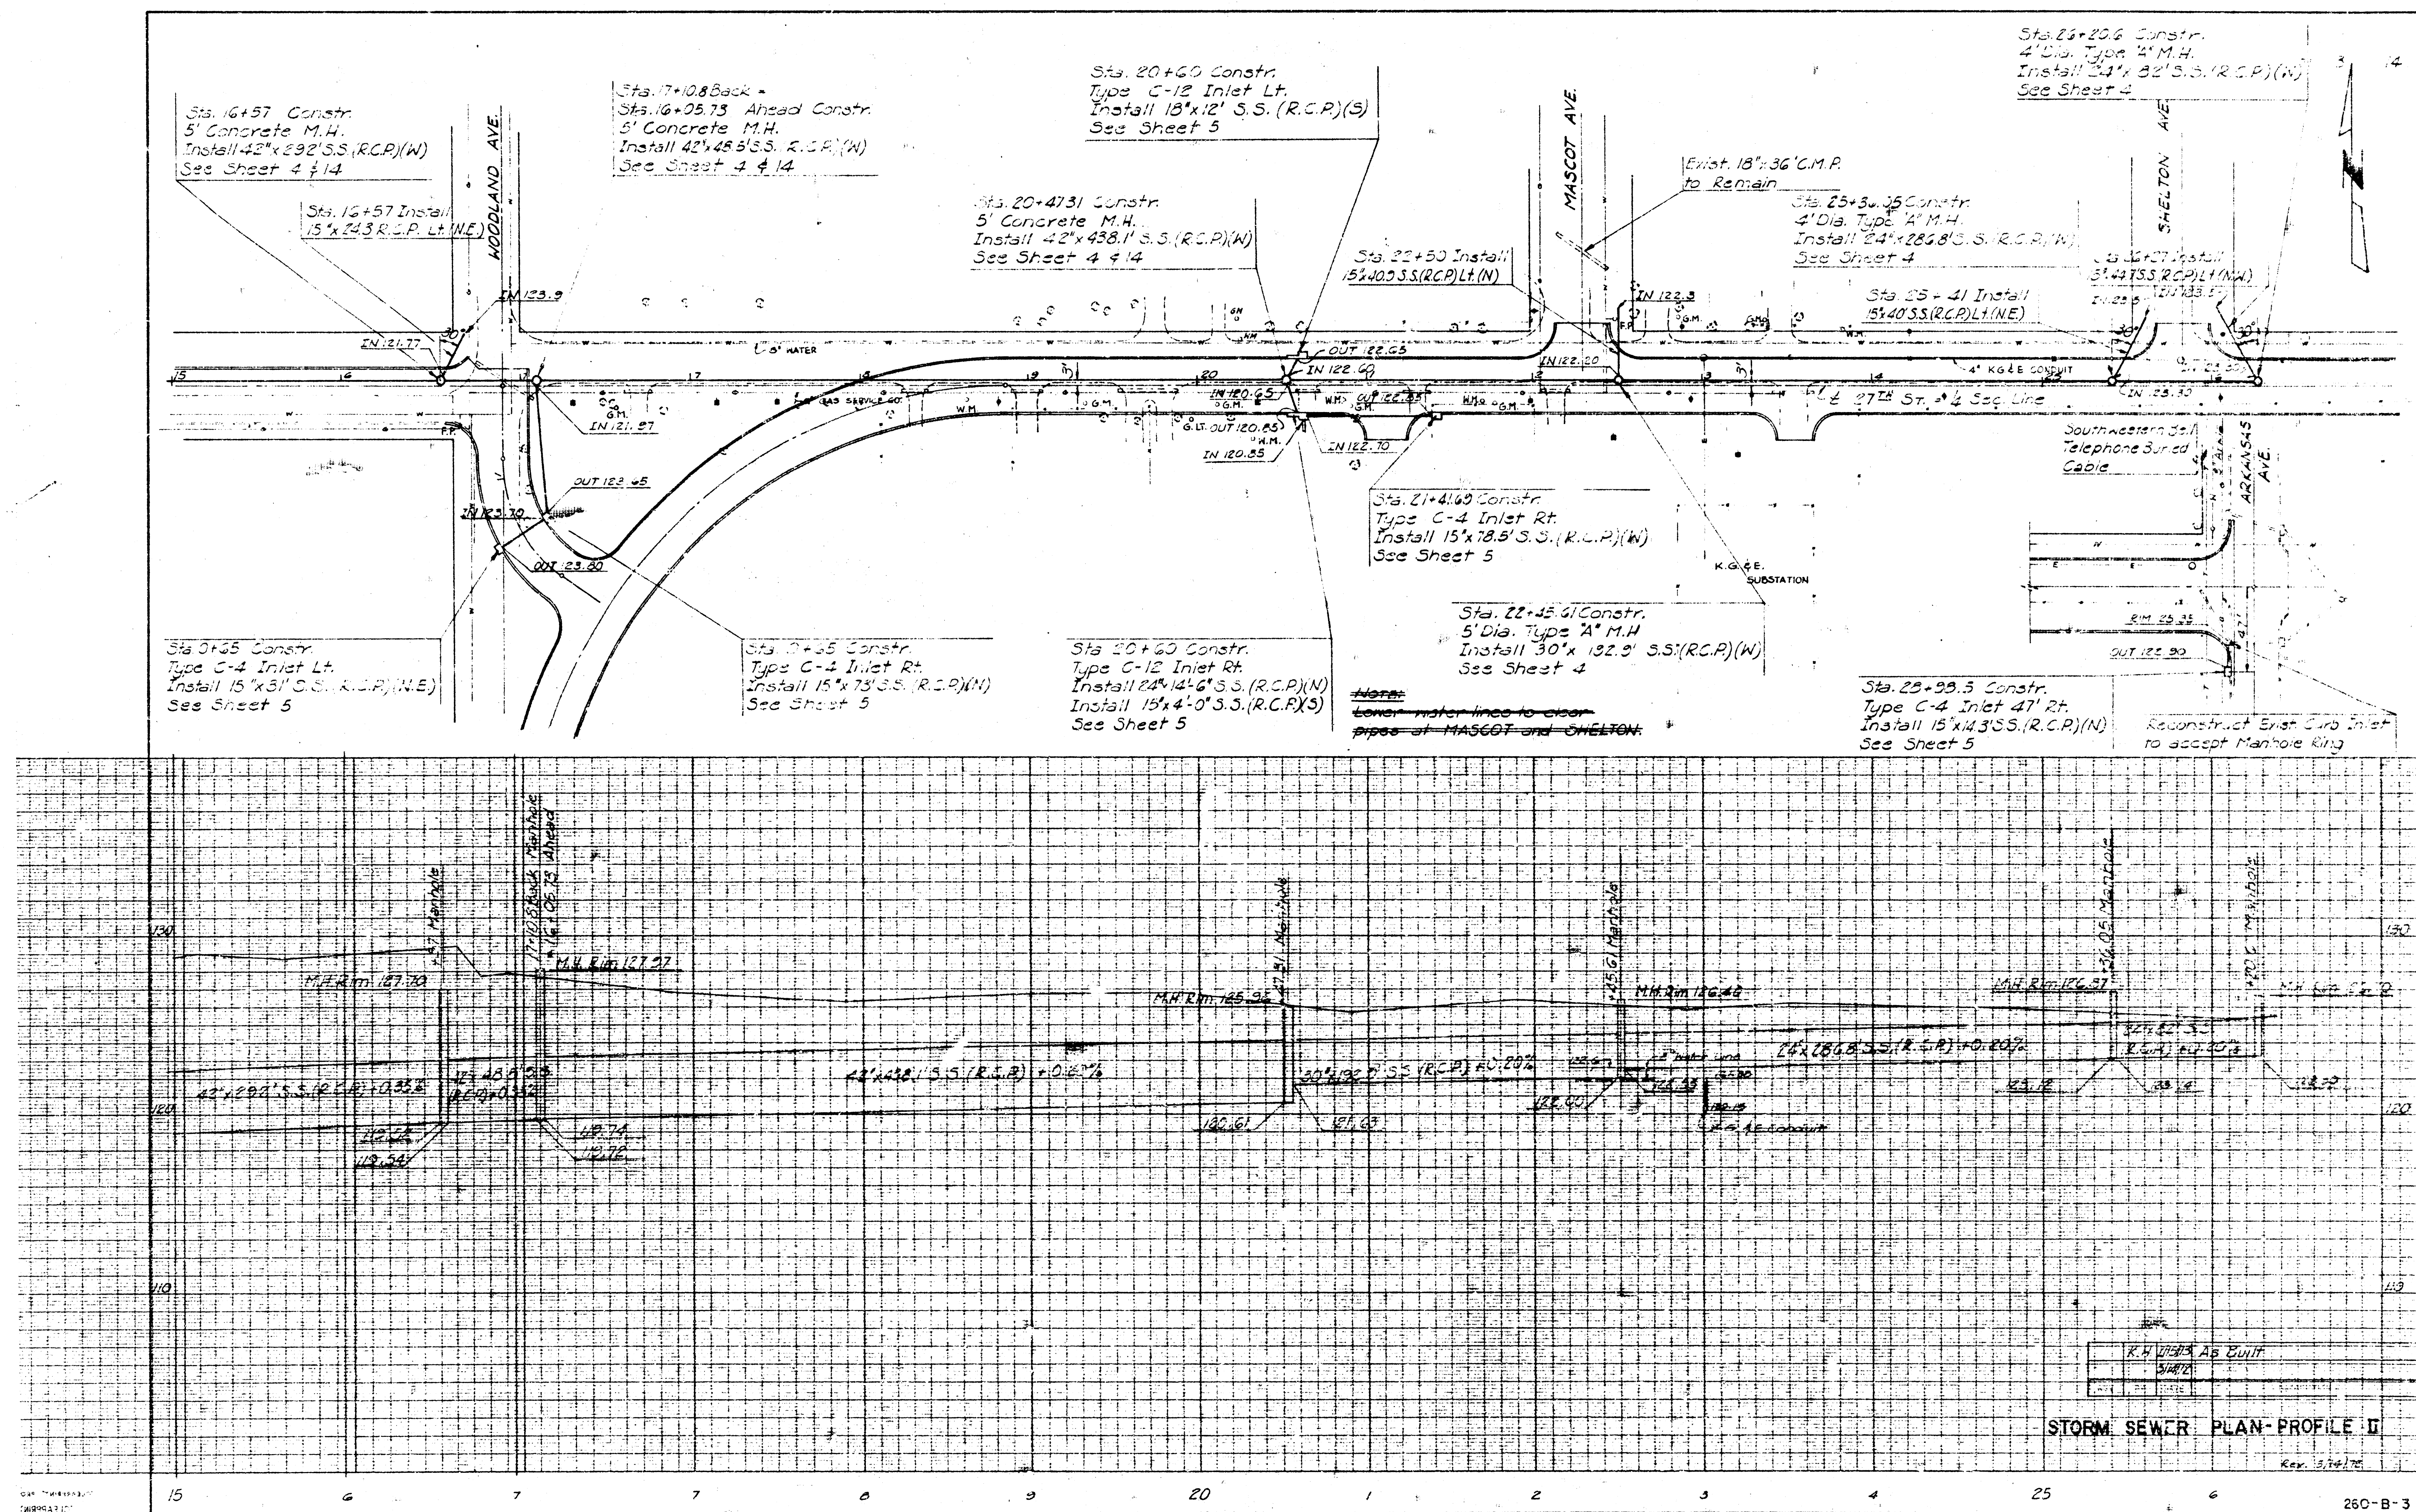

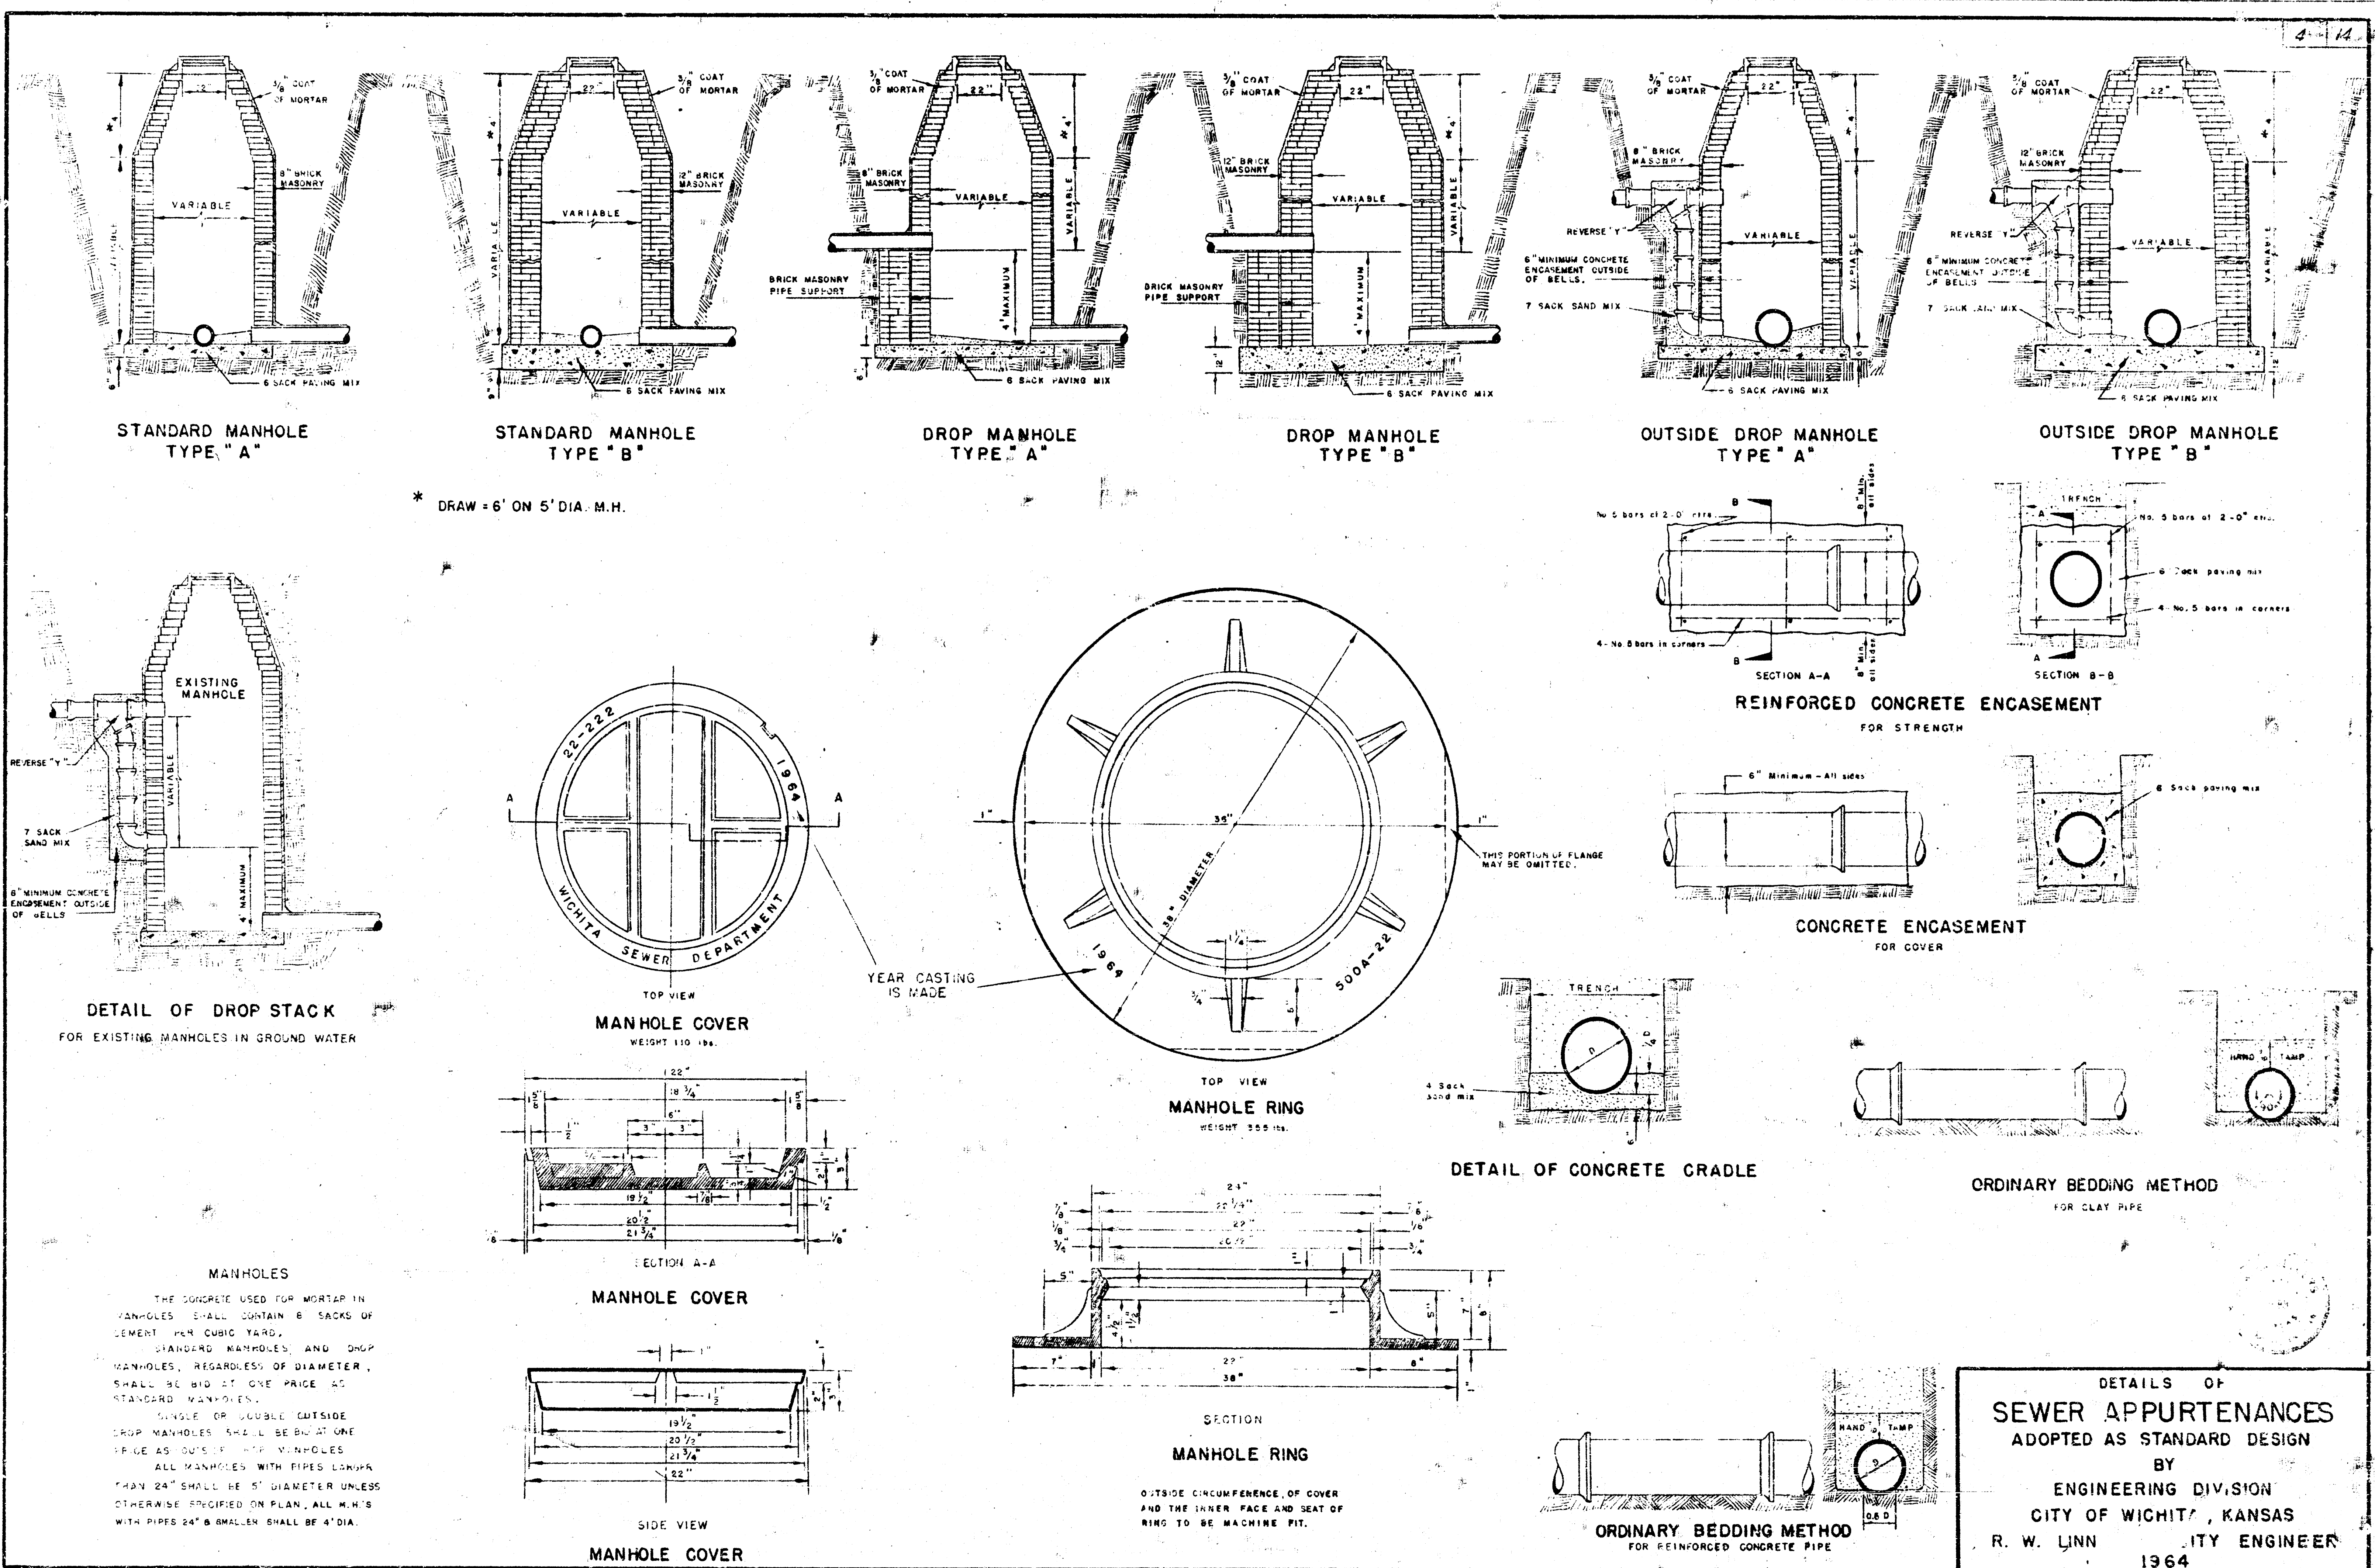


PUB. ROAD DIST. NO.	STATE	PROJECT NO.	FISCAL YEAR	SHEET NO.	TOTAL SHEETS
5	KANSAS			30	

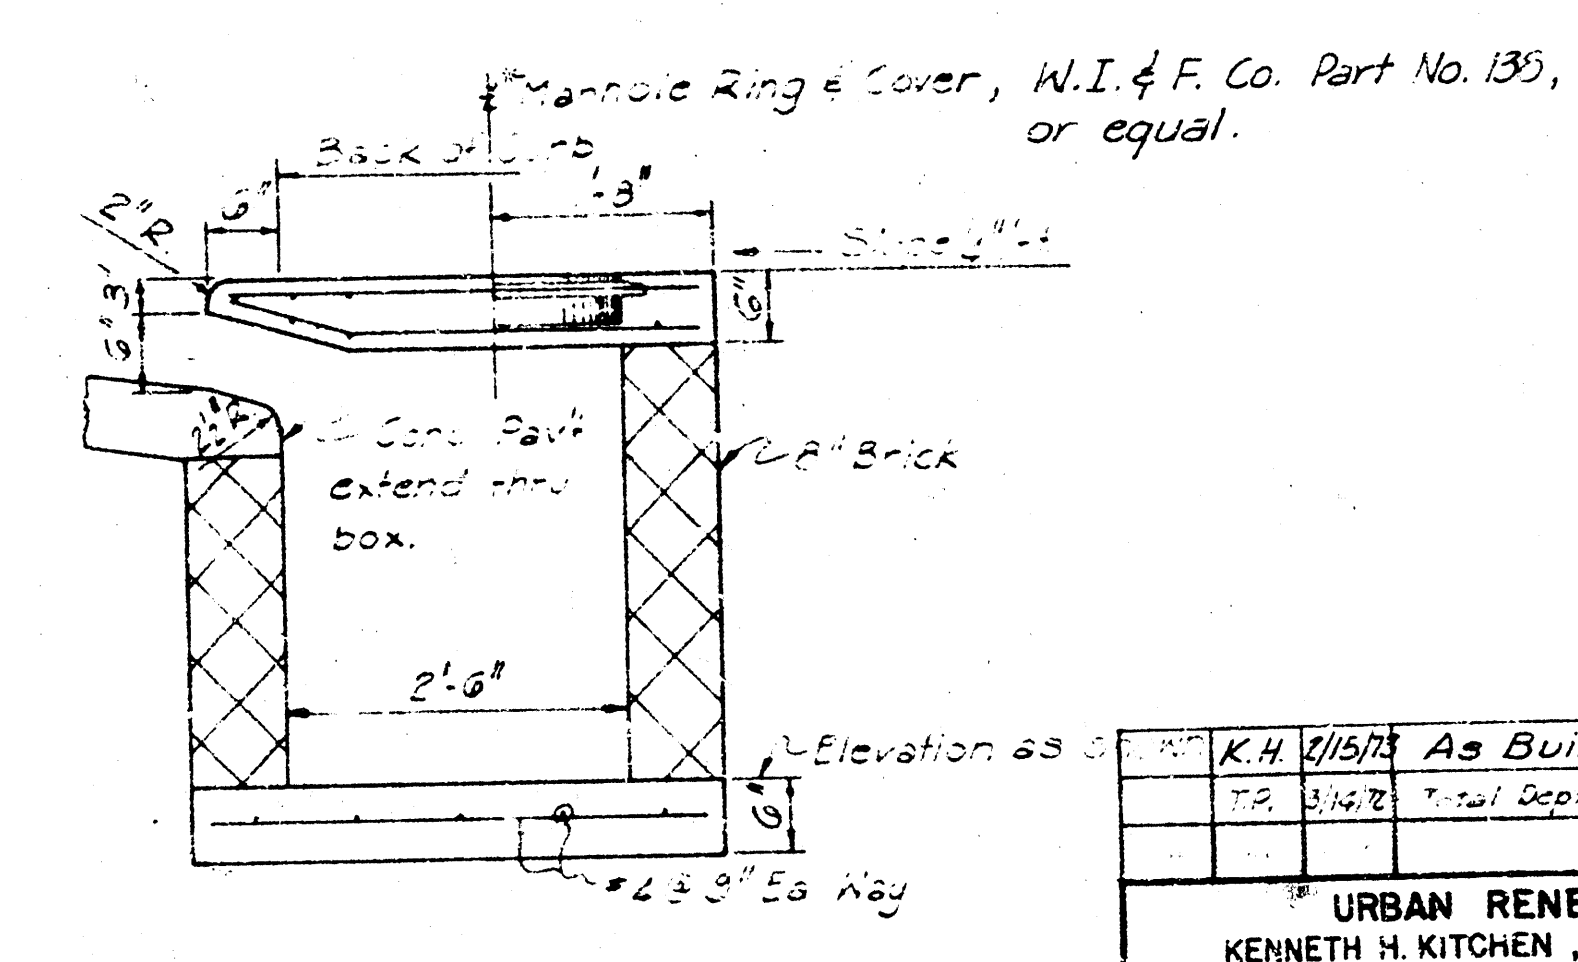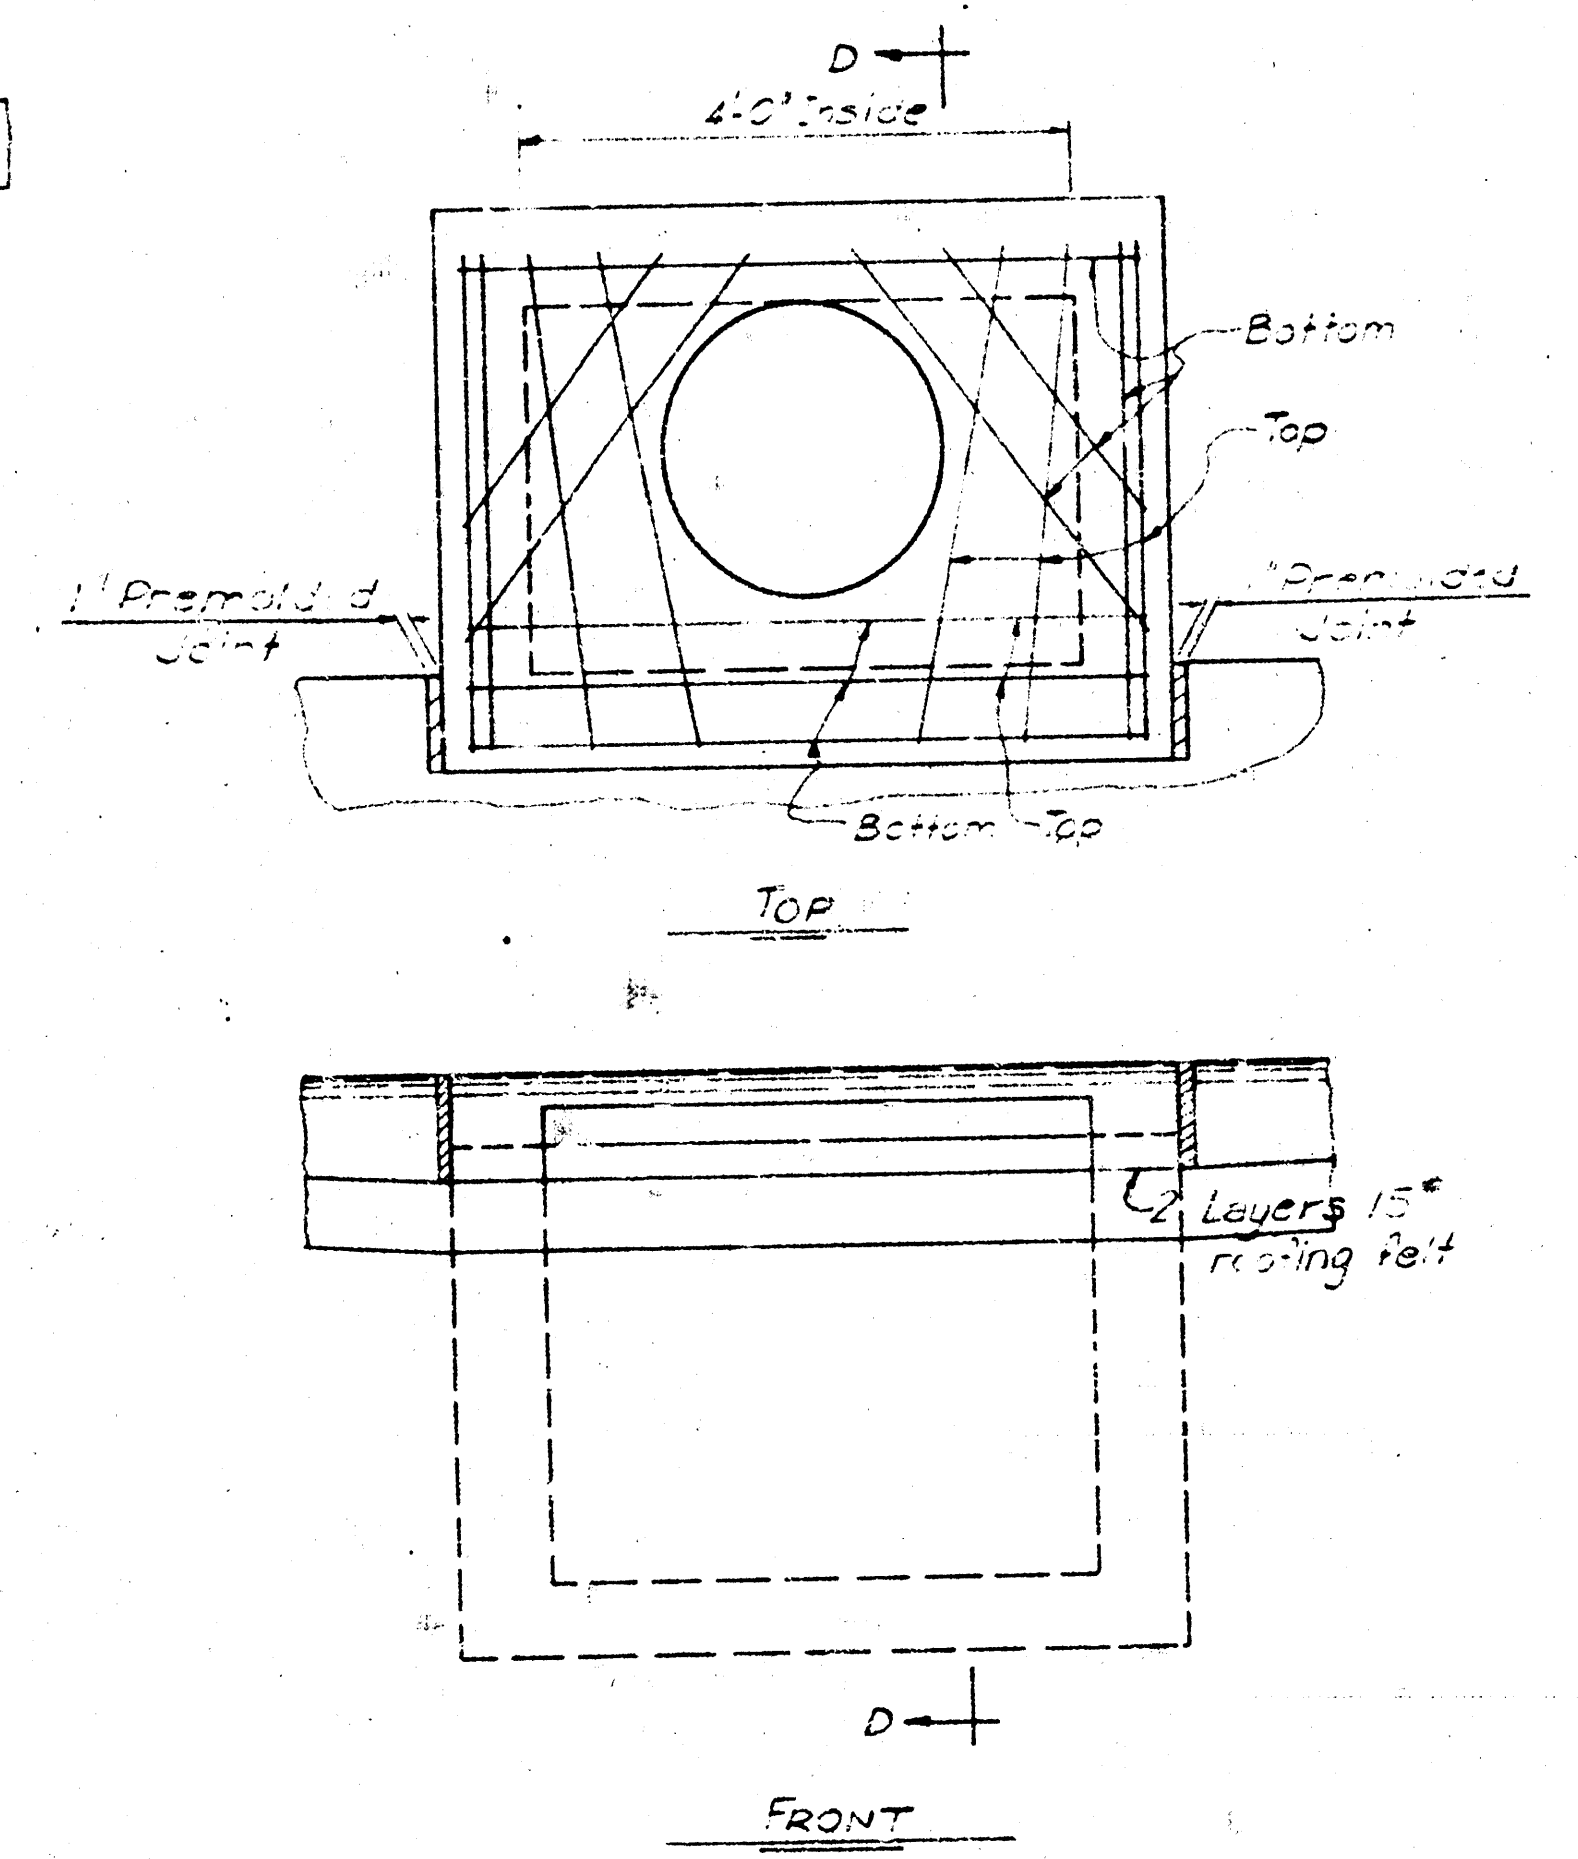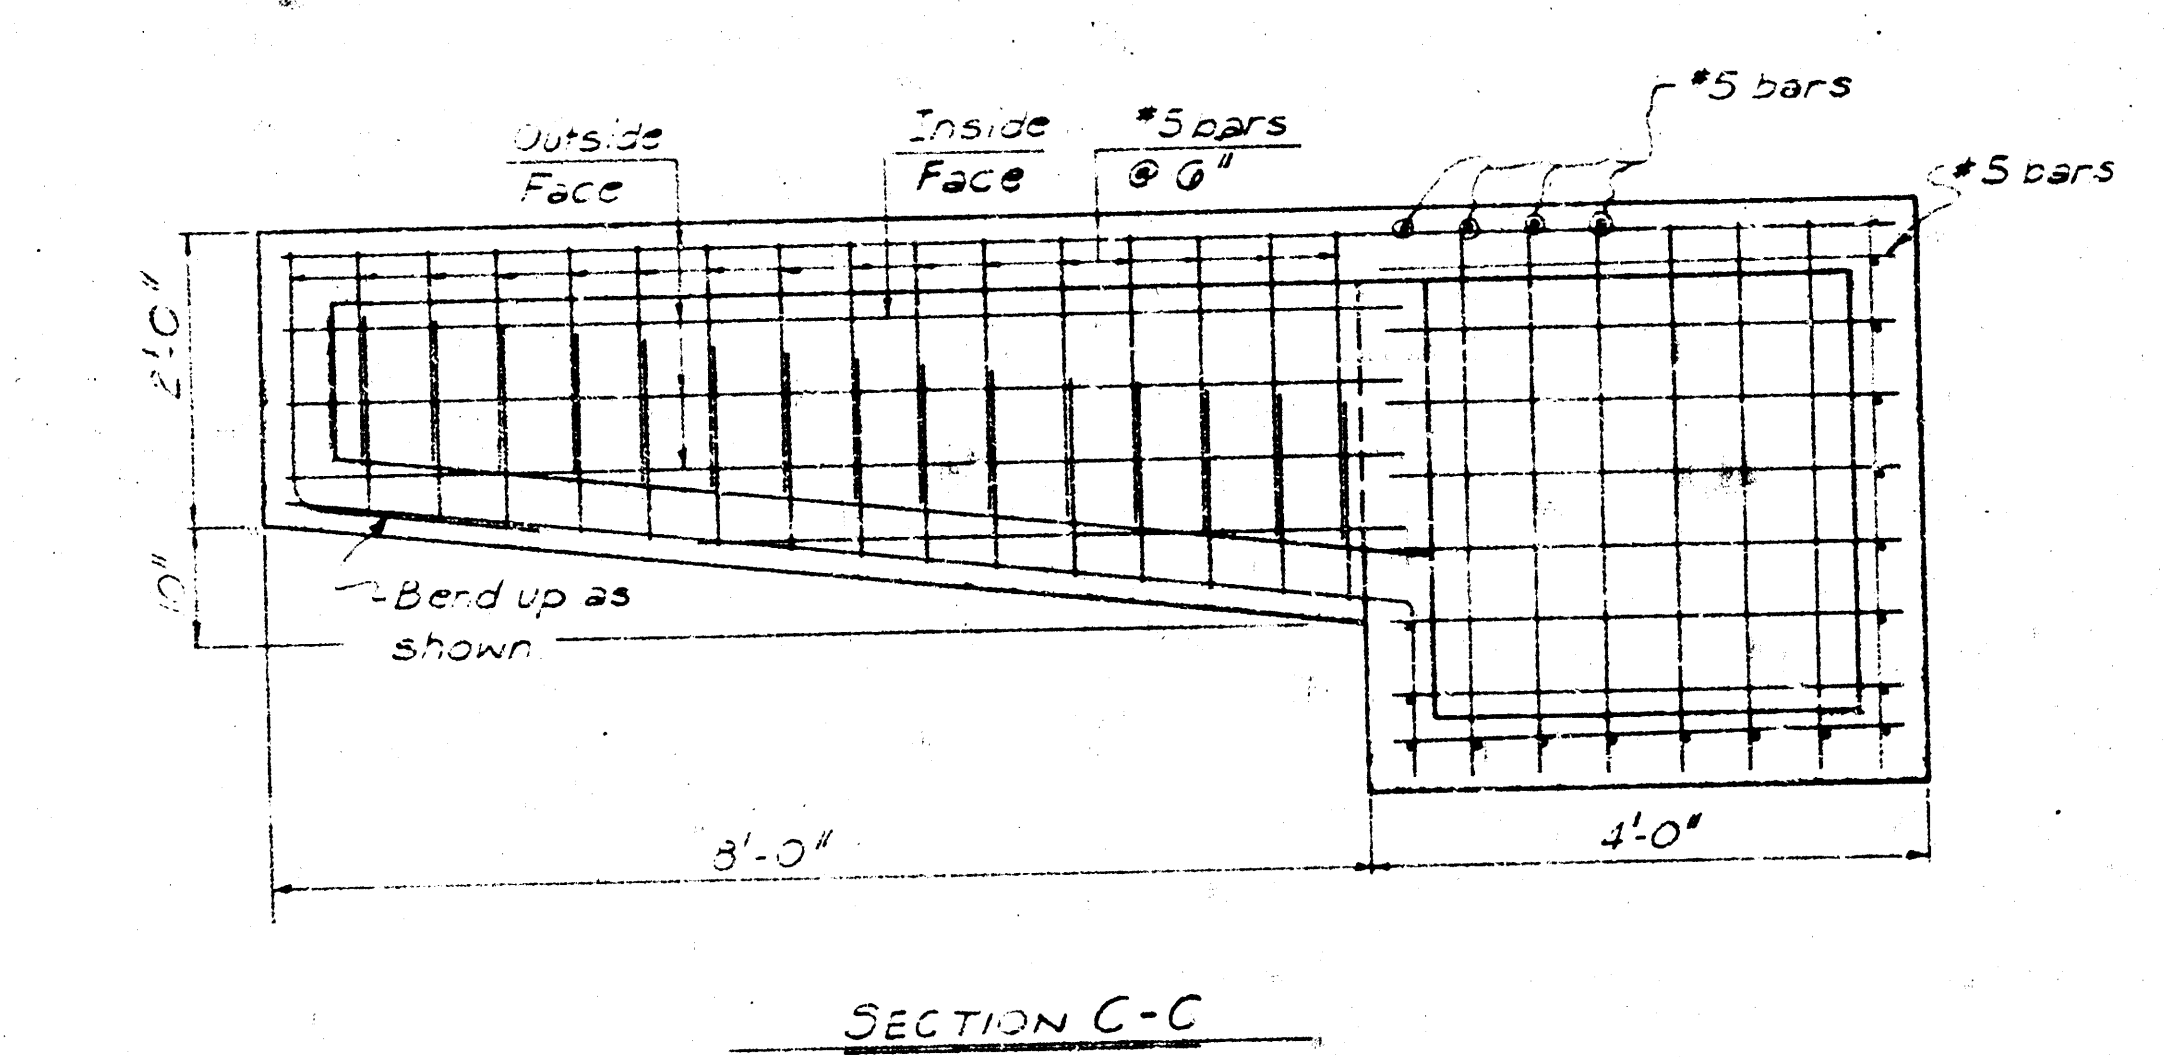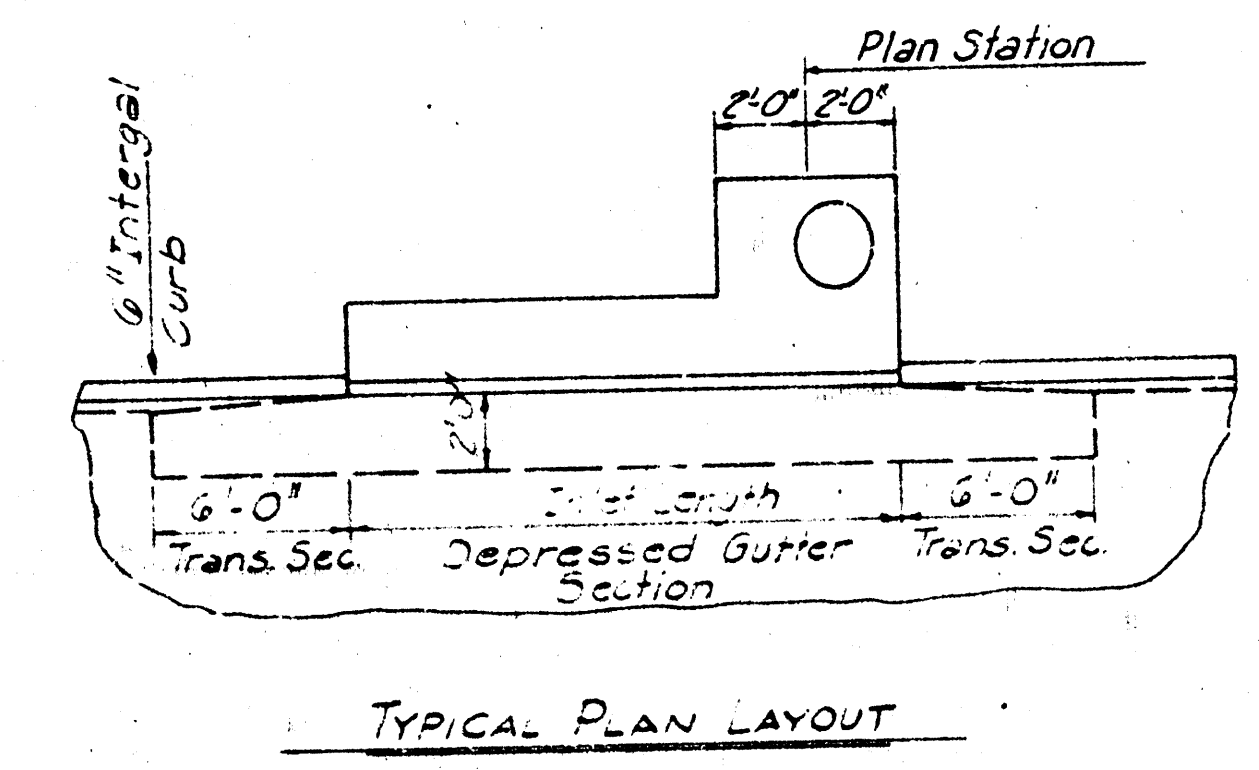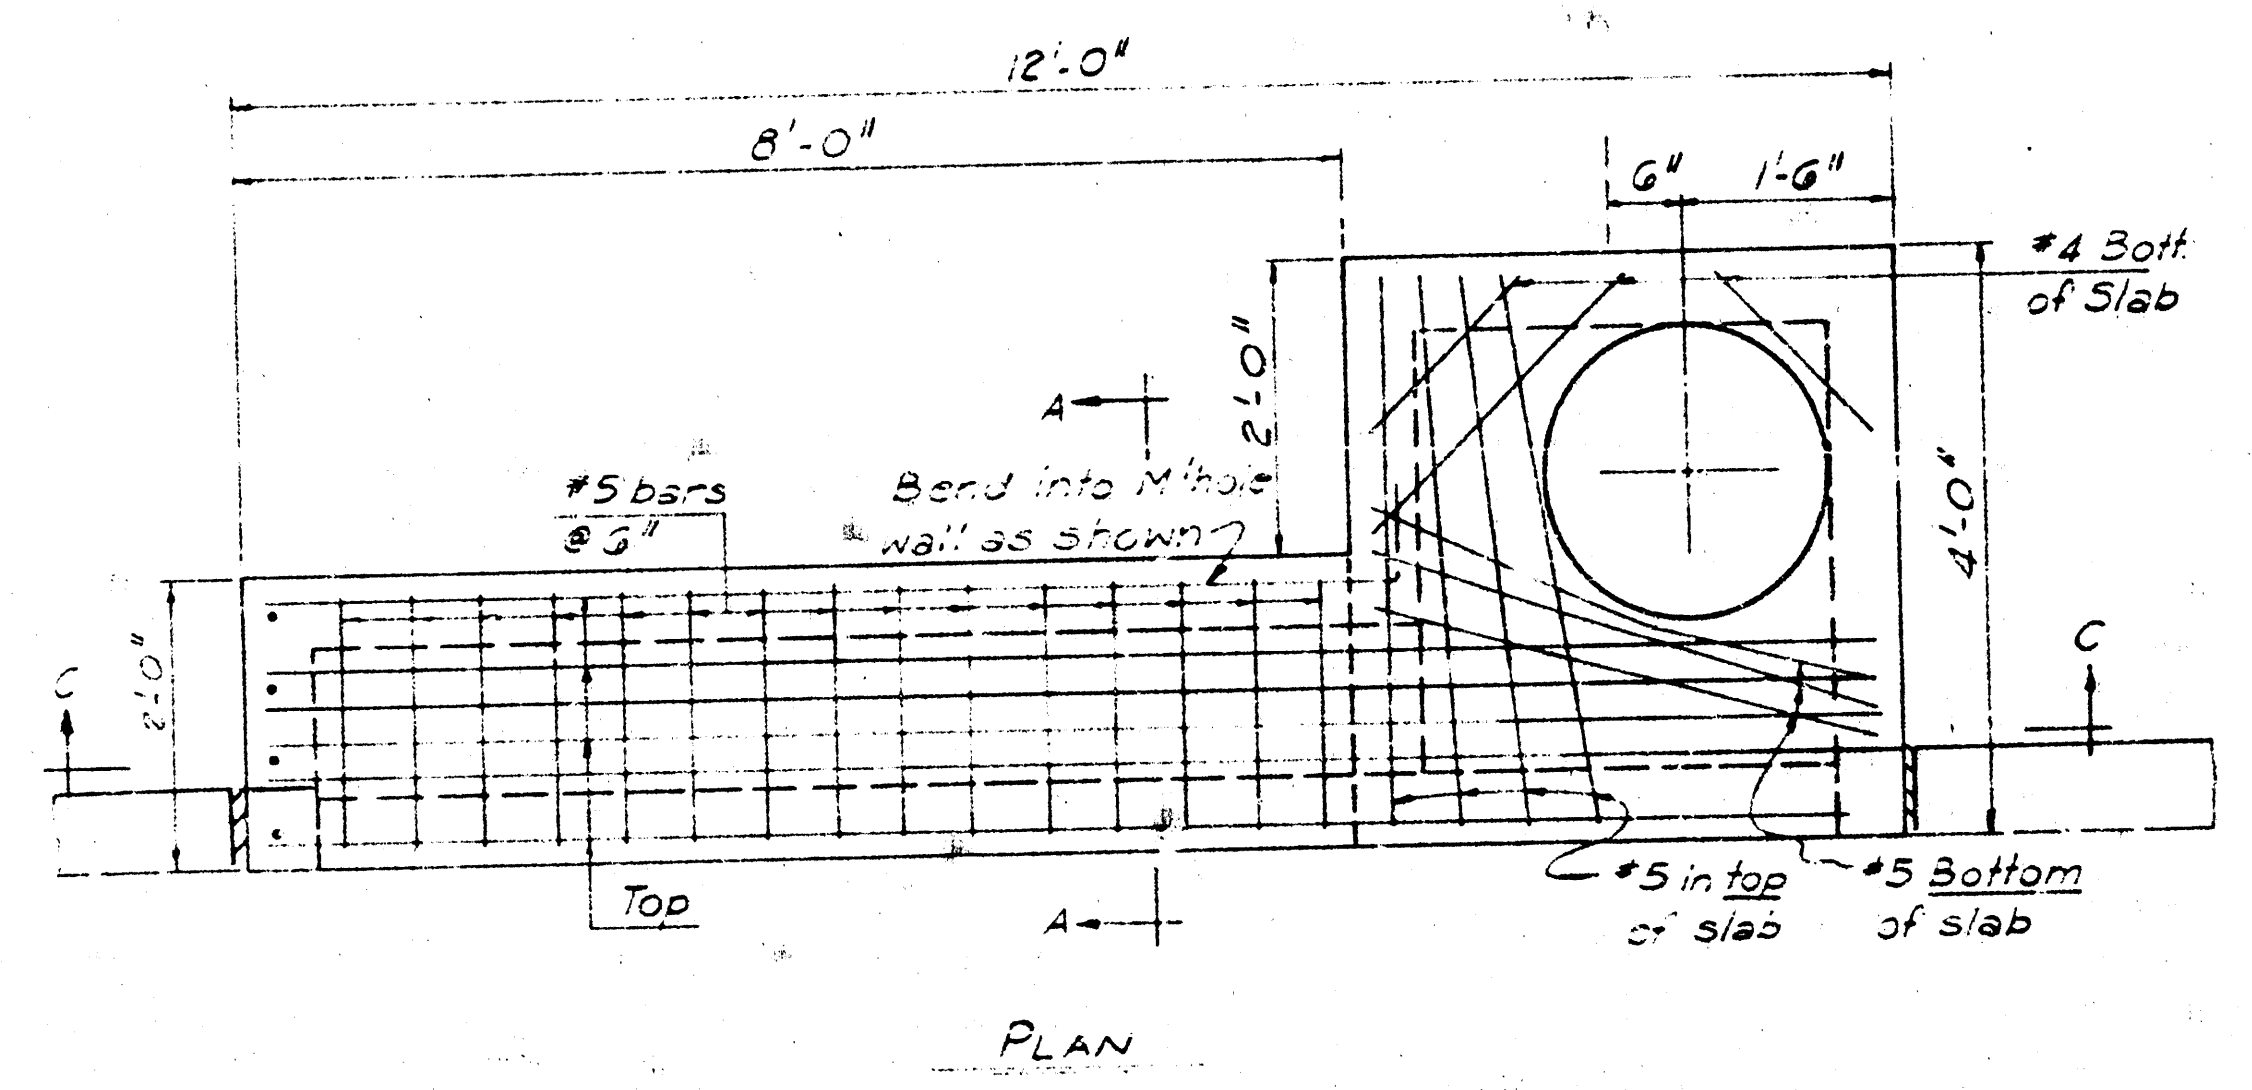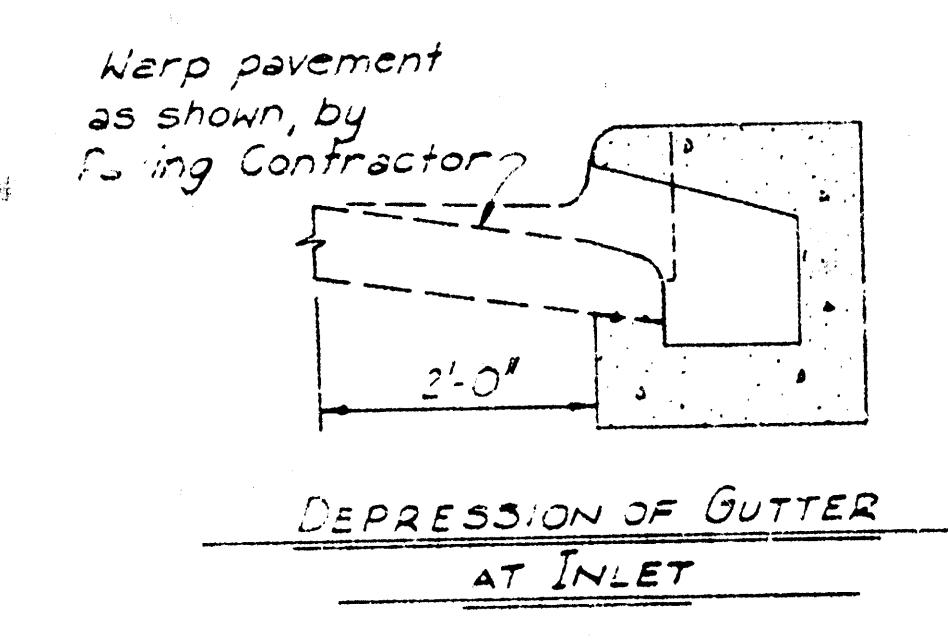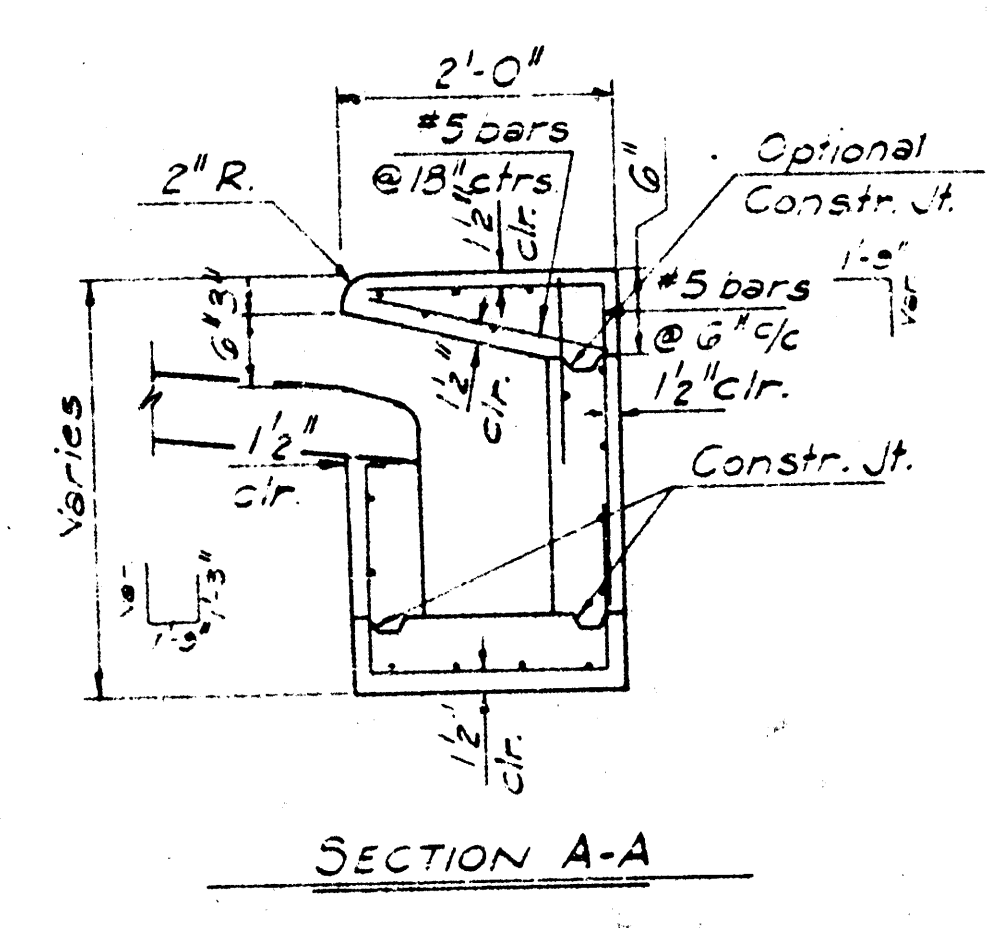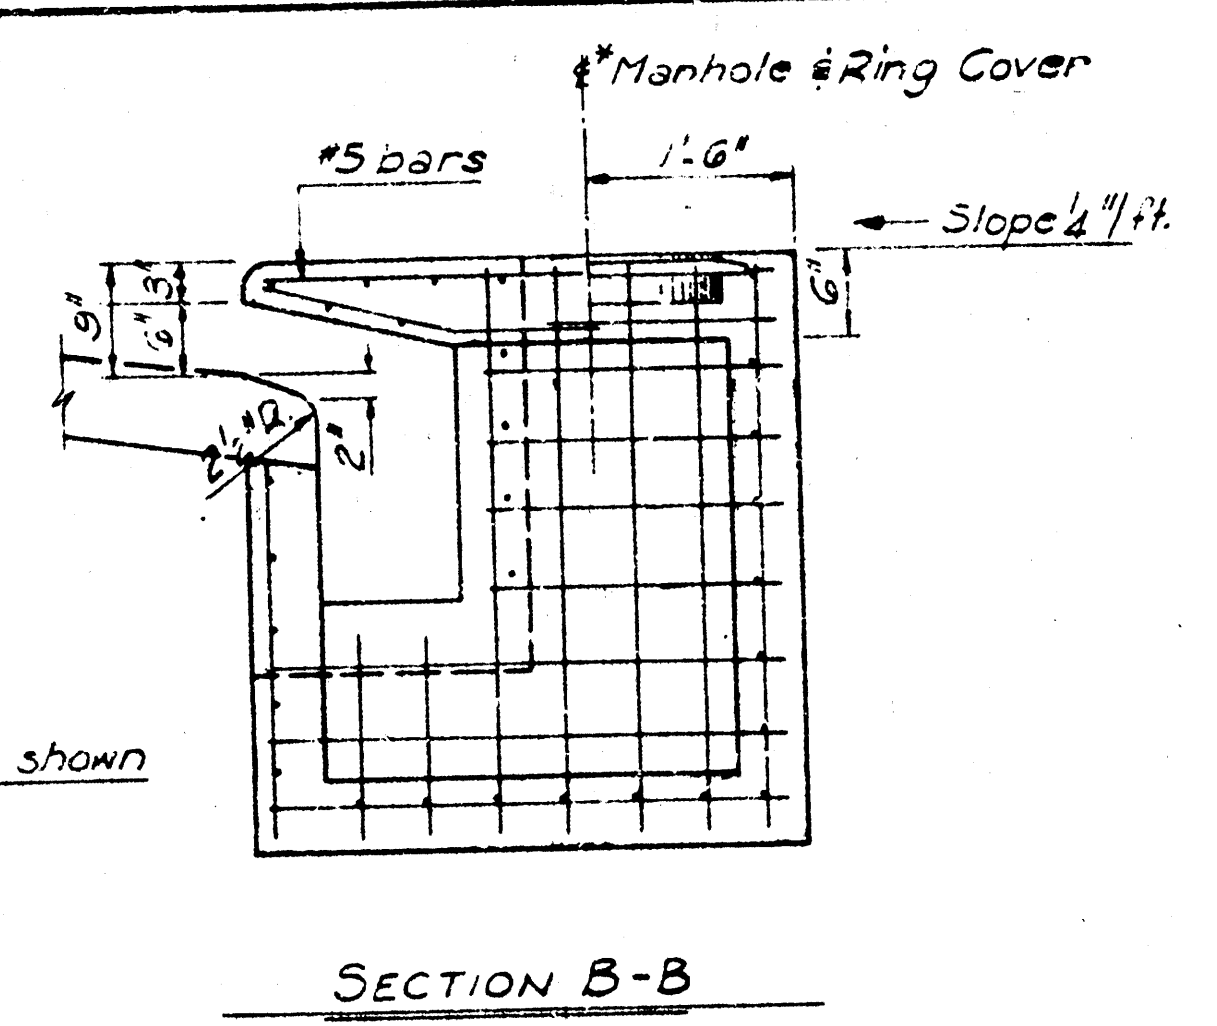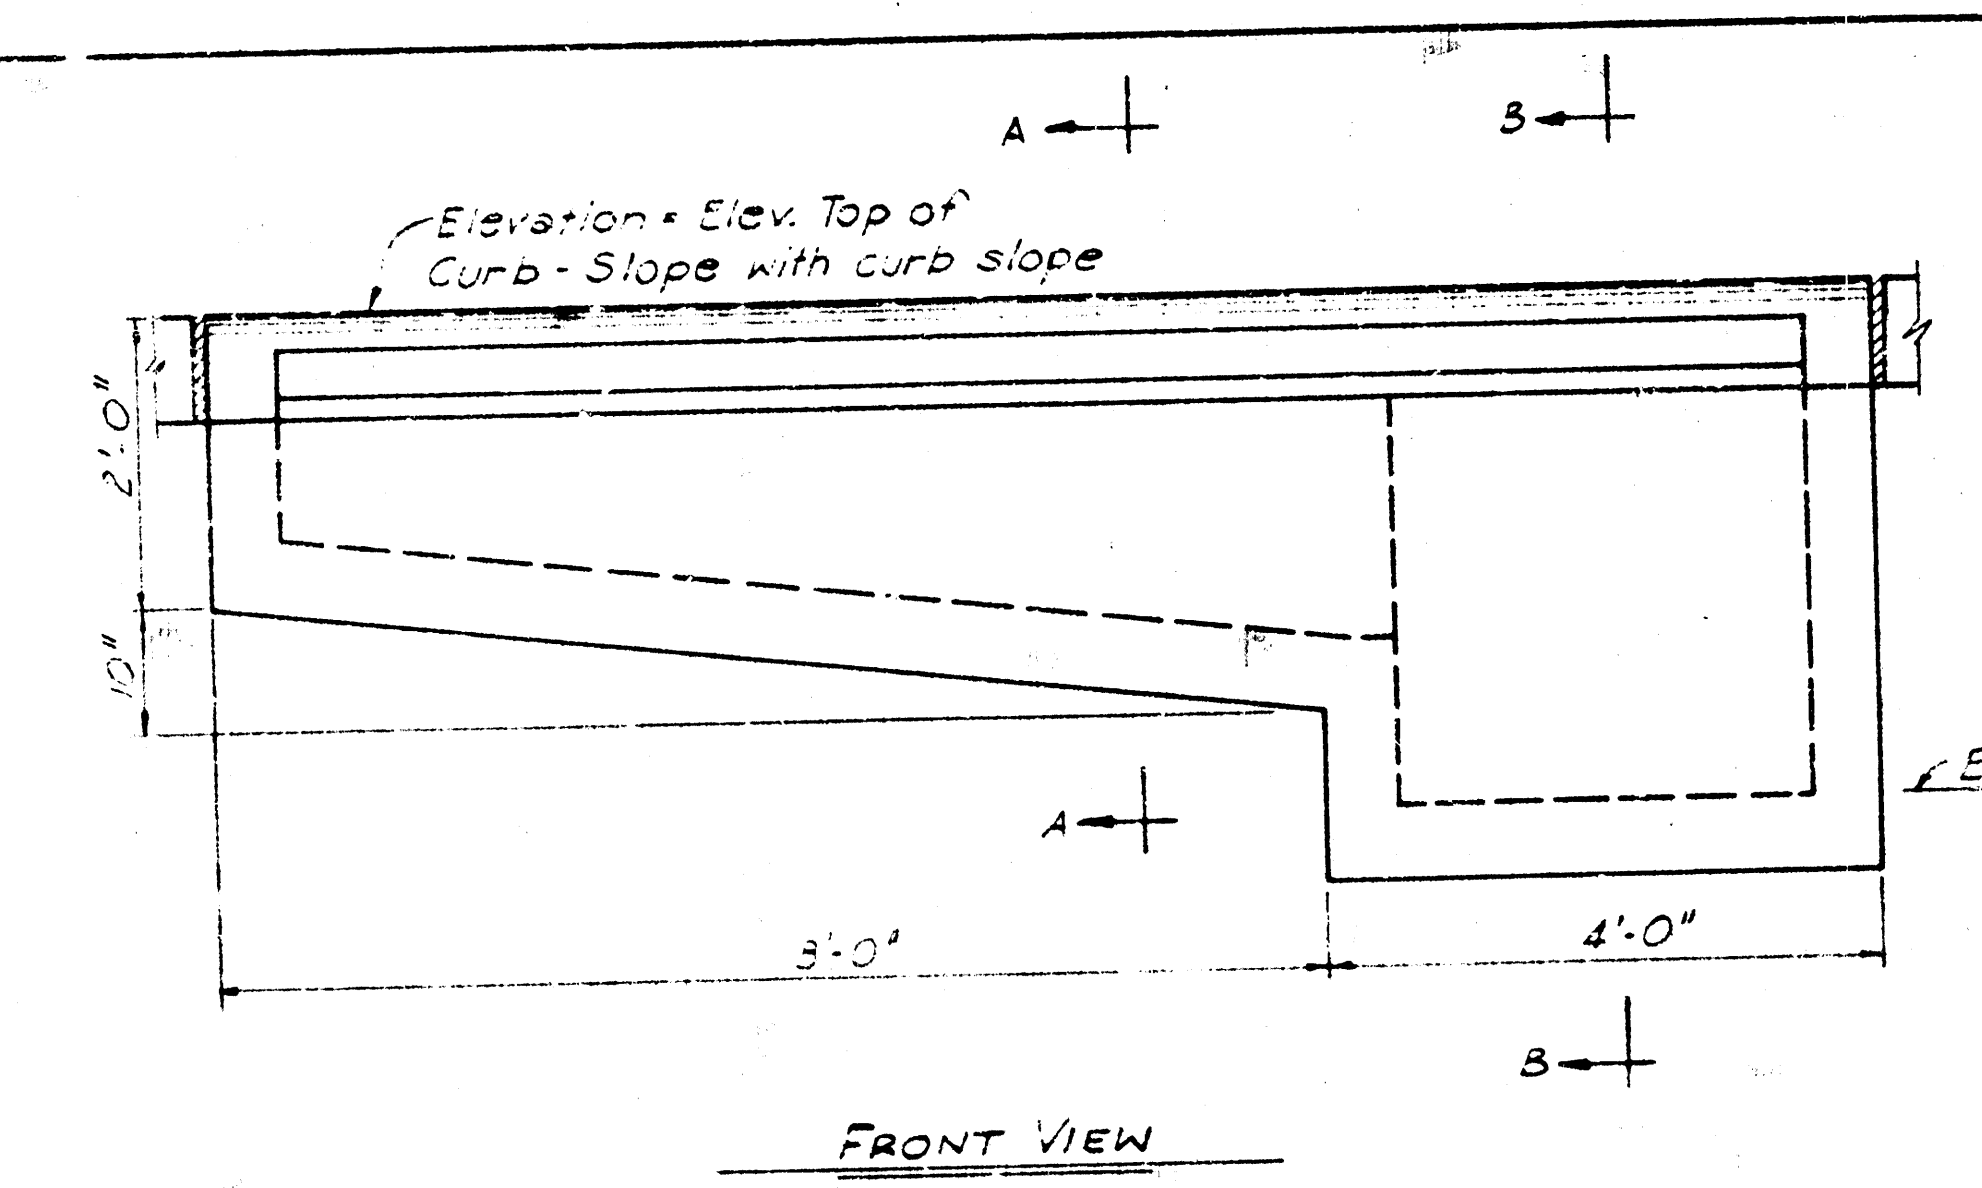


NOTE:
 Use Class A or A(AE) concrete thru-out. Chamfer all exposed edges with a 1/4" radius edge.
 All walls, slabs and floors are 6" thick unless otherwise noted.
 Use #4 bars @ 6" c/c, unless otherwise noted.
 Pour manhole section monolithically with Inlet-Flume Section.

NOTE:
 Use Class A or A(AE) concrete
 All bars #5 in top, #4 in base
 Top may be cast in place or precast
 Finish all exposed edges with a 1/4" radius edge.


K.H. 1/15/72 As Built	
DATE	1/15/72
DESCRIPTION	STREET IMPROVEMENTS EVERGREEN PARK
CURB INLET DETAILS	
R. S. DELAMATER CONSULTING ENGINEER WICHITA, KANSAS	DATE February 1, 1972 SCALE SHEET NO. 260-B-5

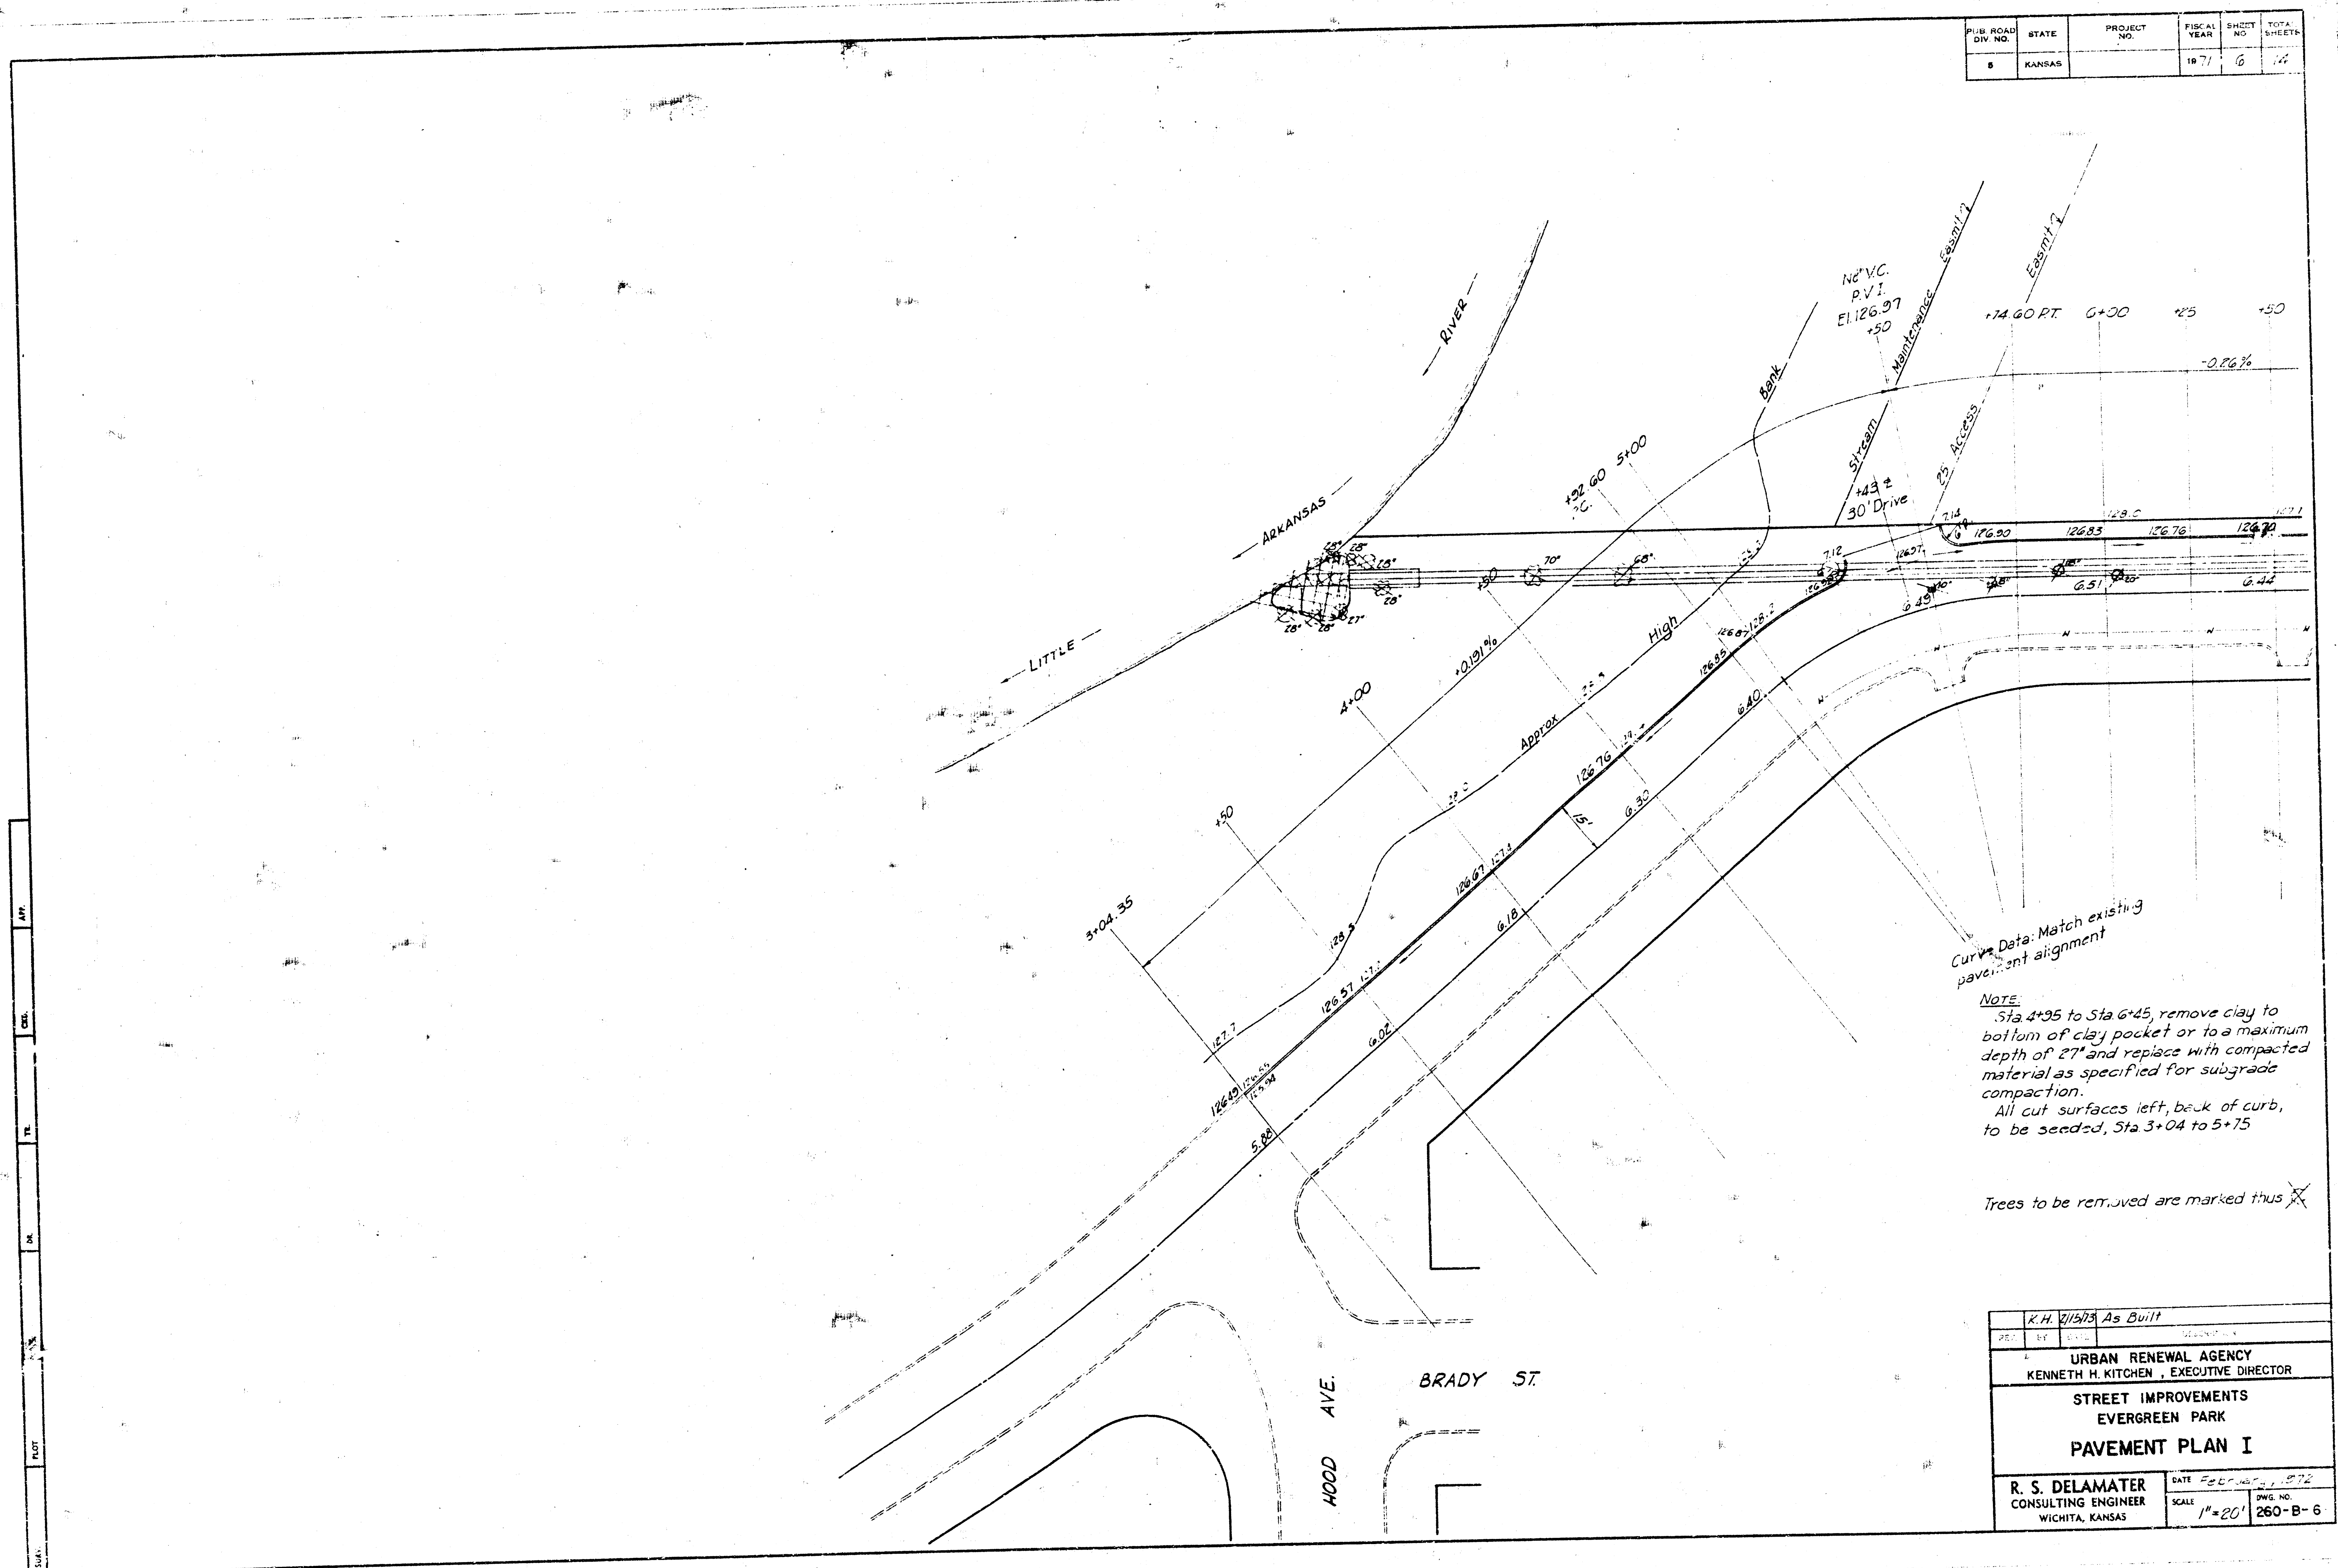


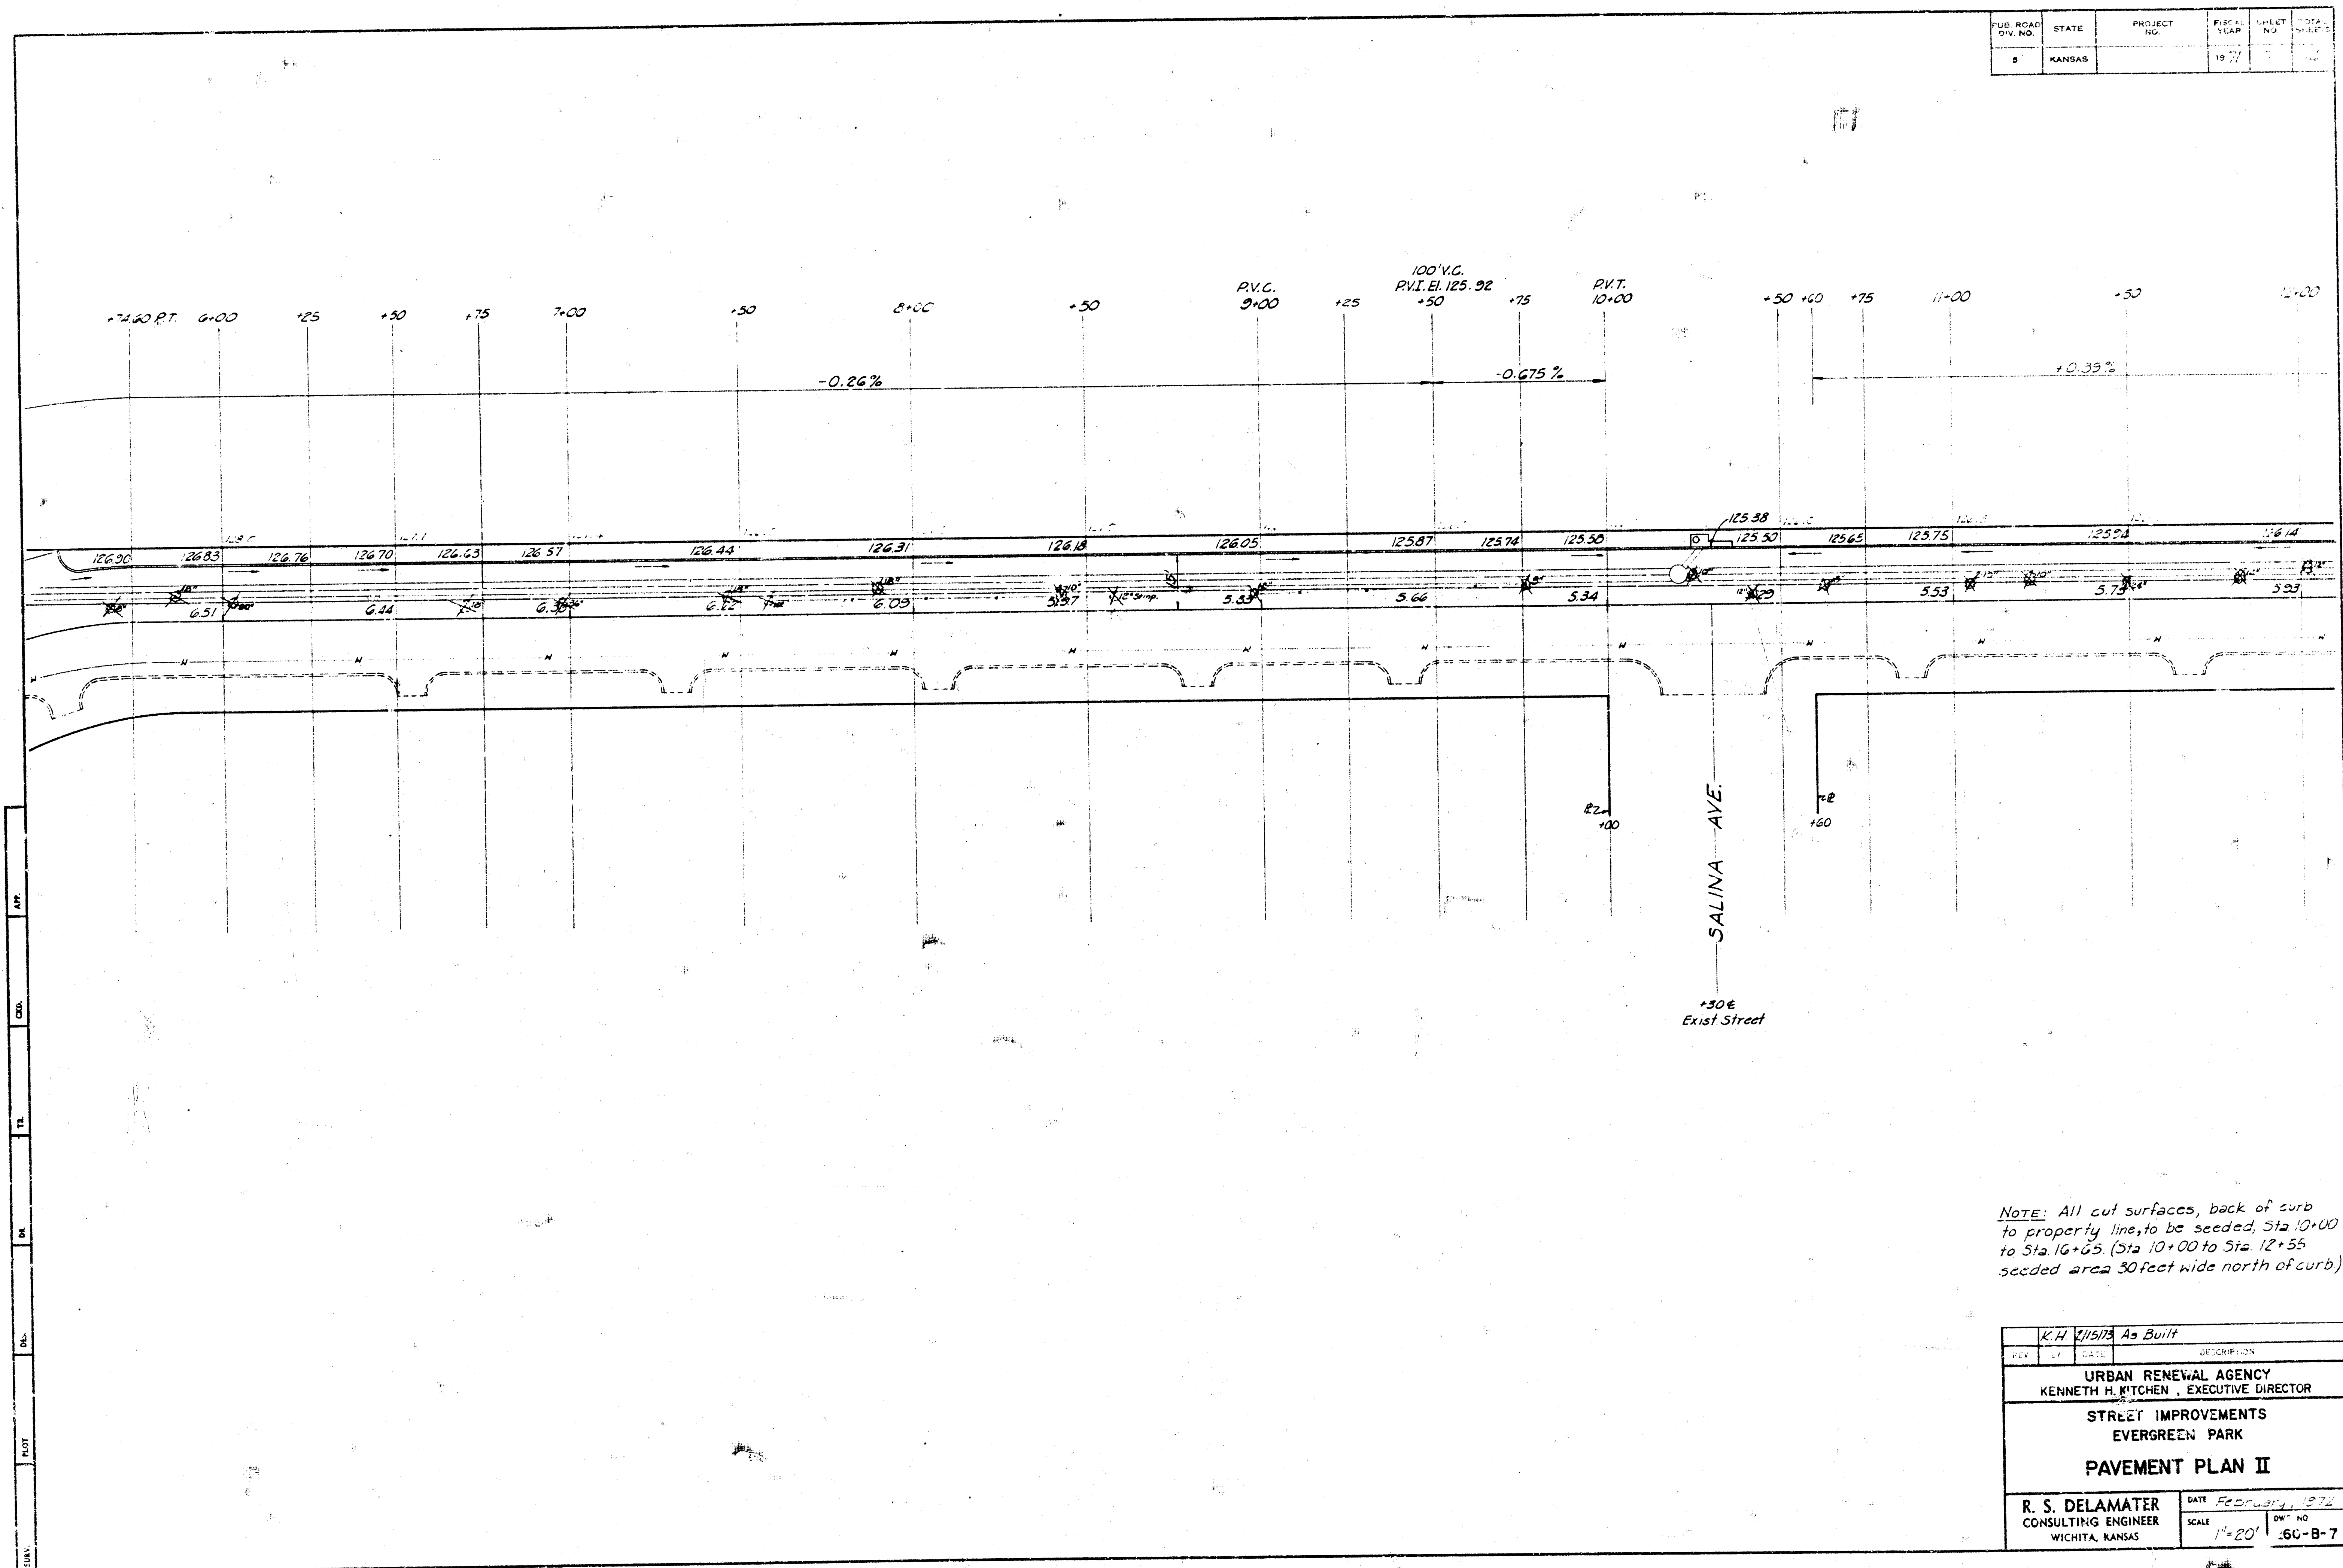



PUB. ROAD DIV. NO.	STATE	PROJECT NO.	FILE YEAR	SHEET NO.	TOTAL SHEETS
8	KANSAS		1977		

K.H. 2/15/78 As Built	
REV.	DATE
URBAN RENEWAL AGENCY KENNETH H. KITCHEN, EXECUTIVE DIRECTOR	
STREET IMPROVEMENTS EVERGREEN PARK	
PAVEMENT PLAN II	
R. S. DELAMATER CONSULTING ENGINEER WICHITA, KANSAS	DATE February, 1978 SCALE 1"=20' DWG. NO. 60-B-7

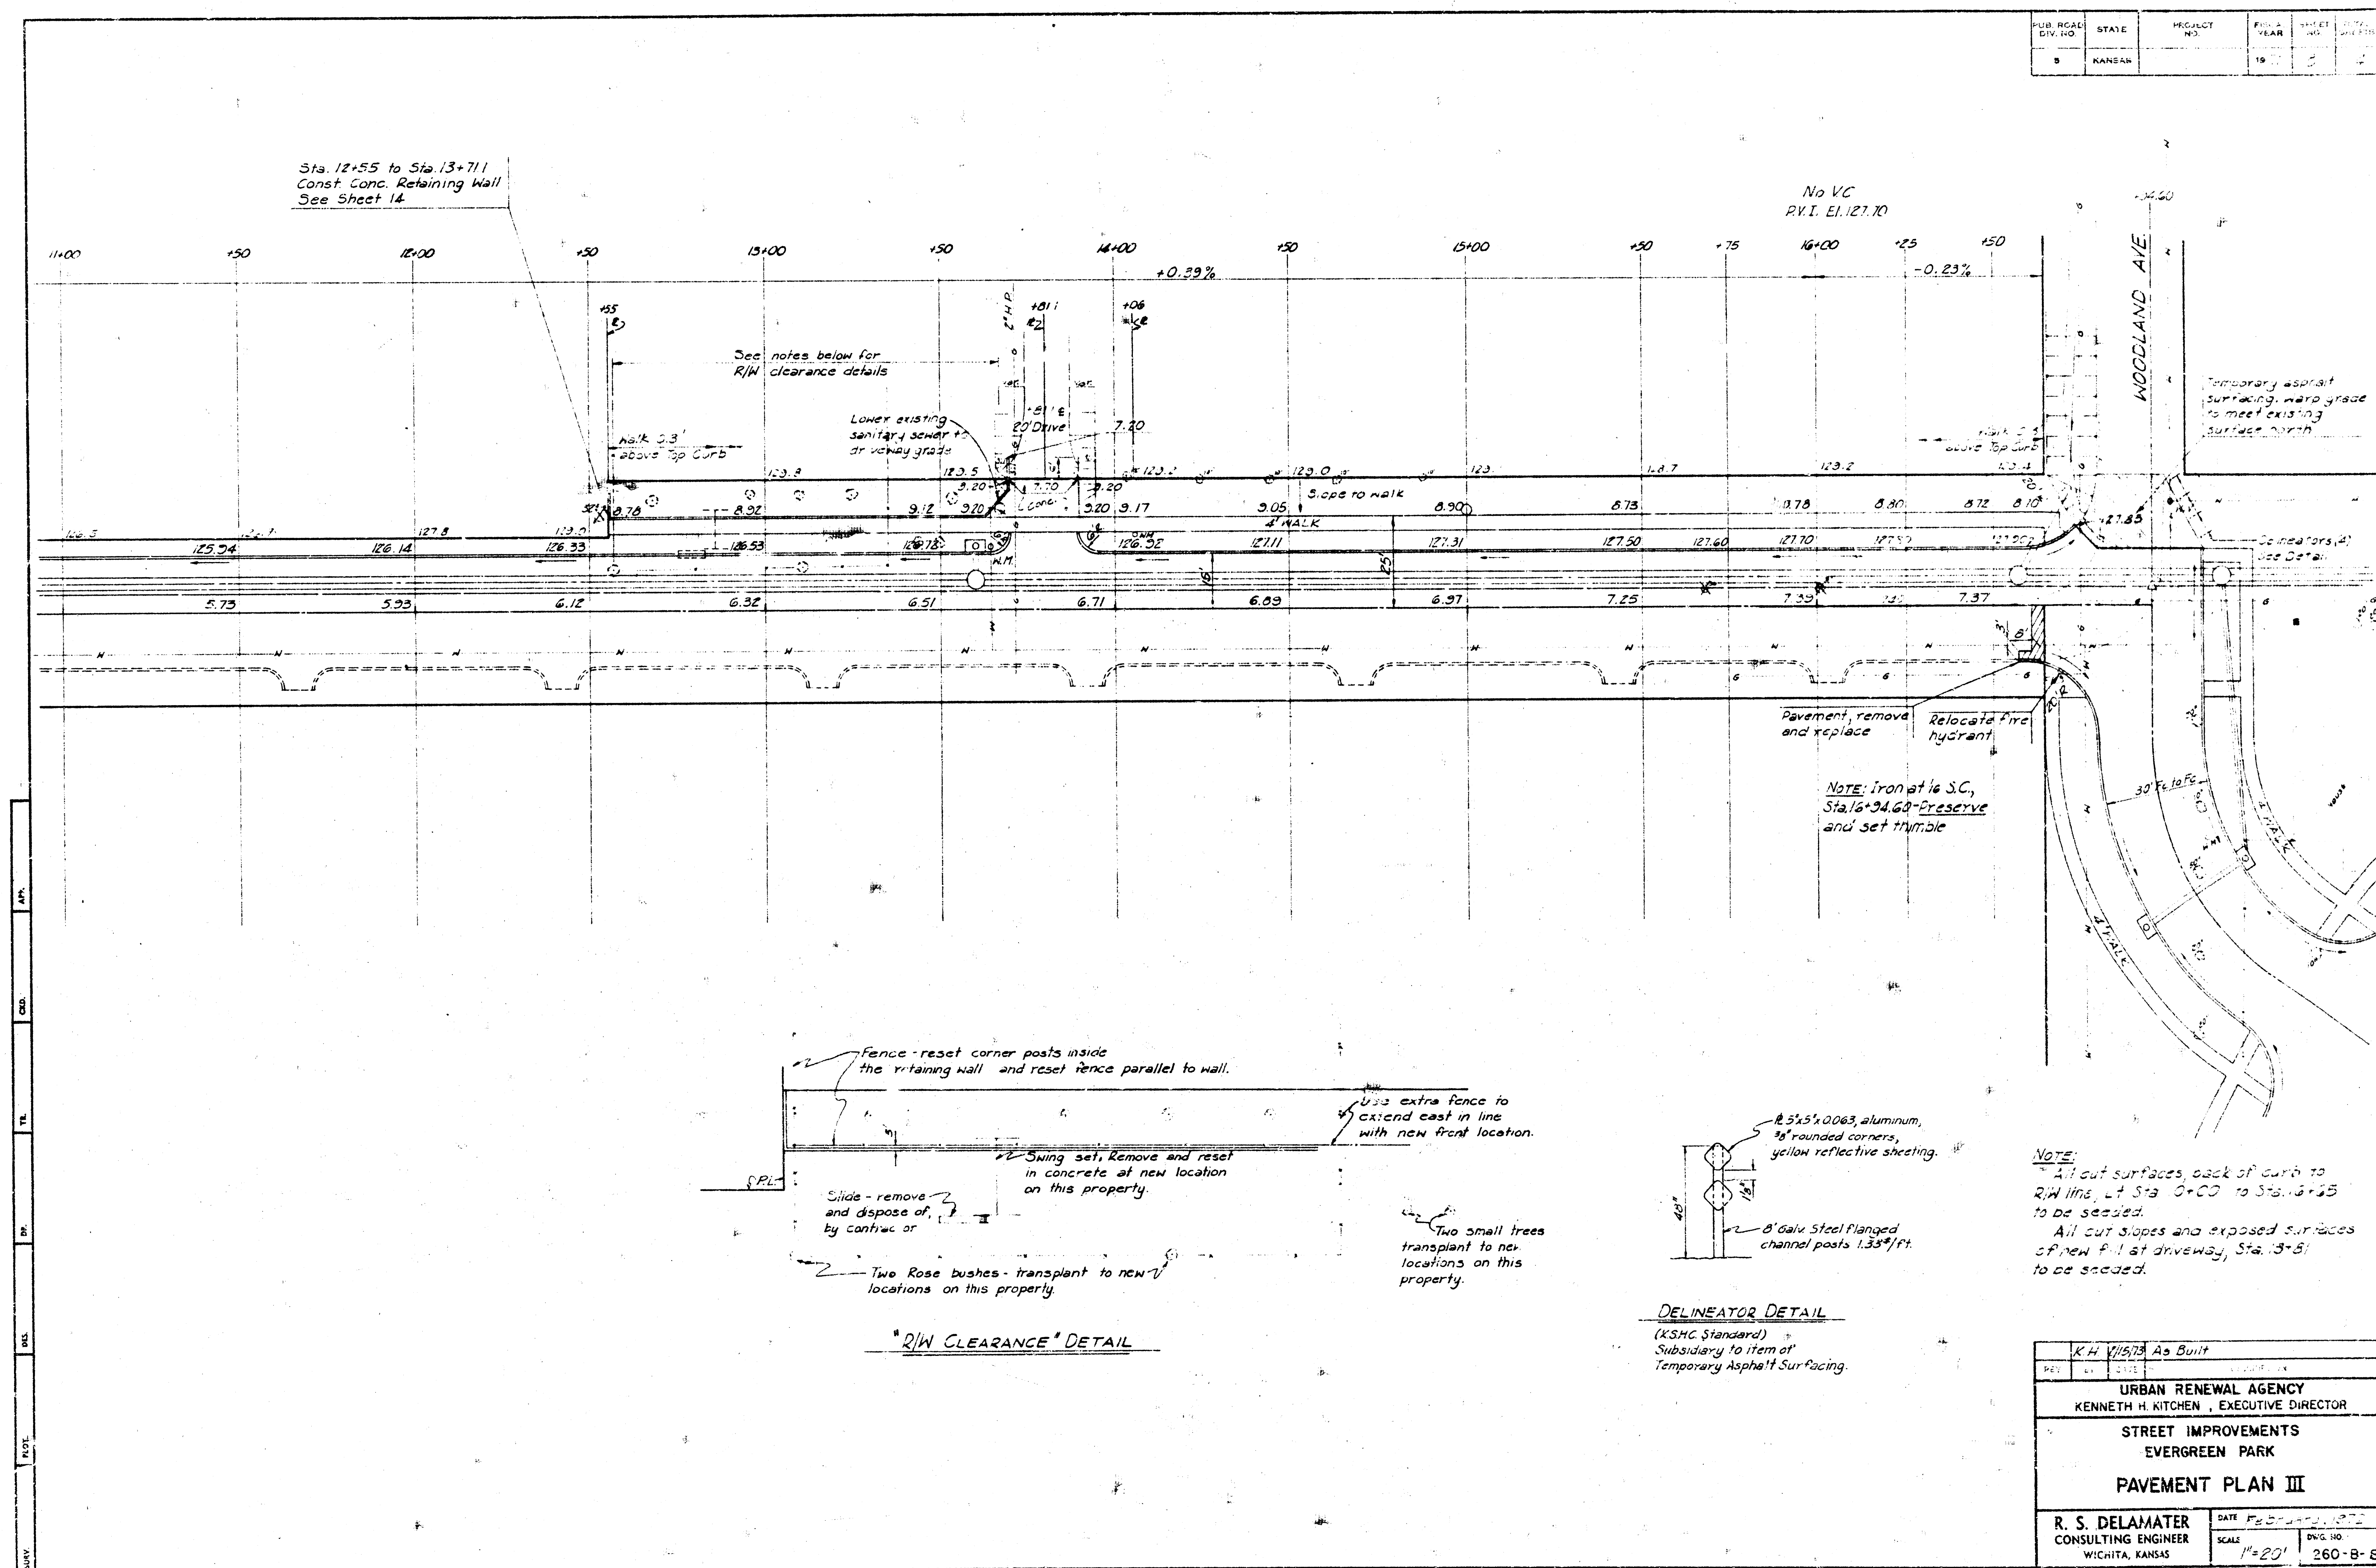

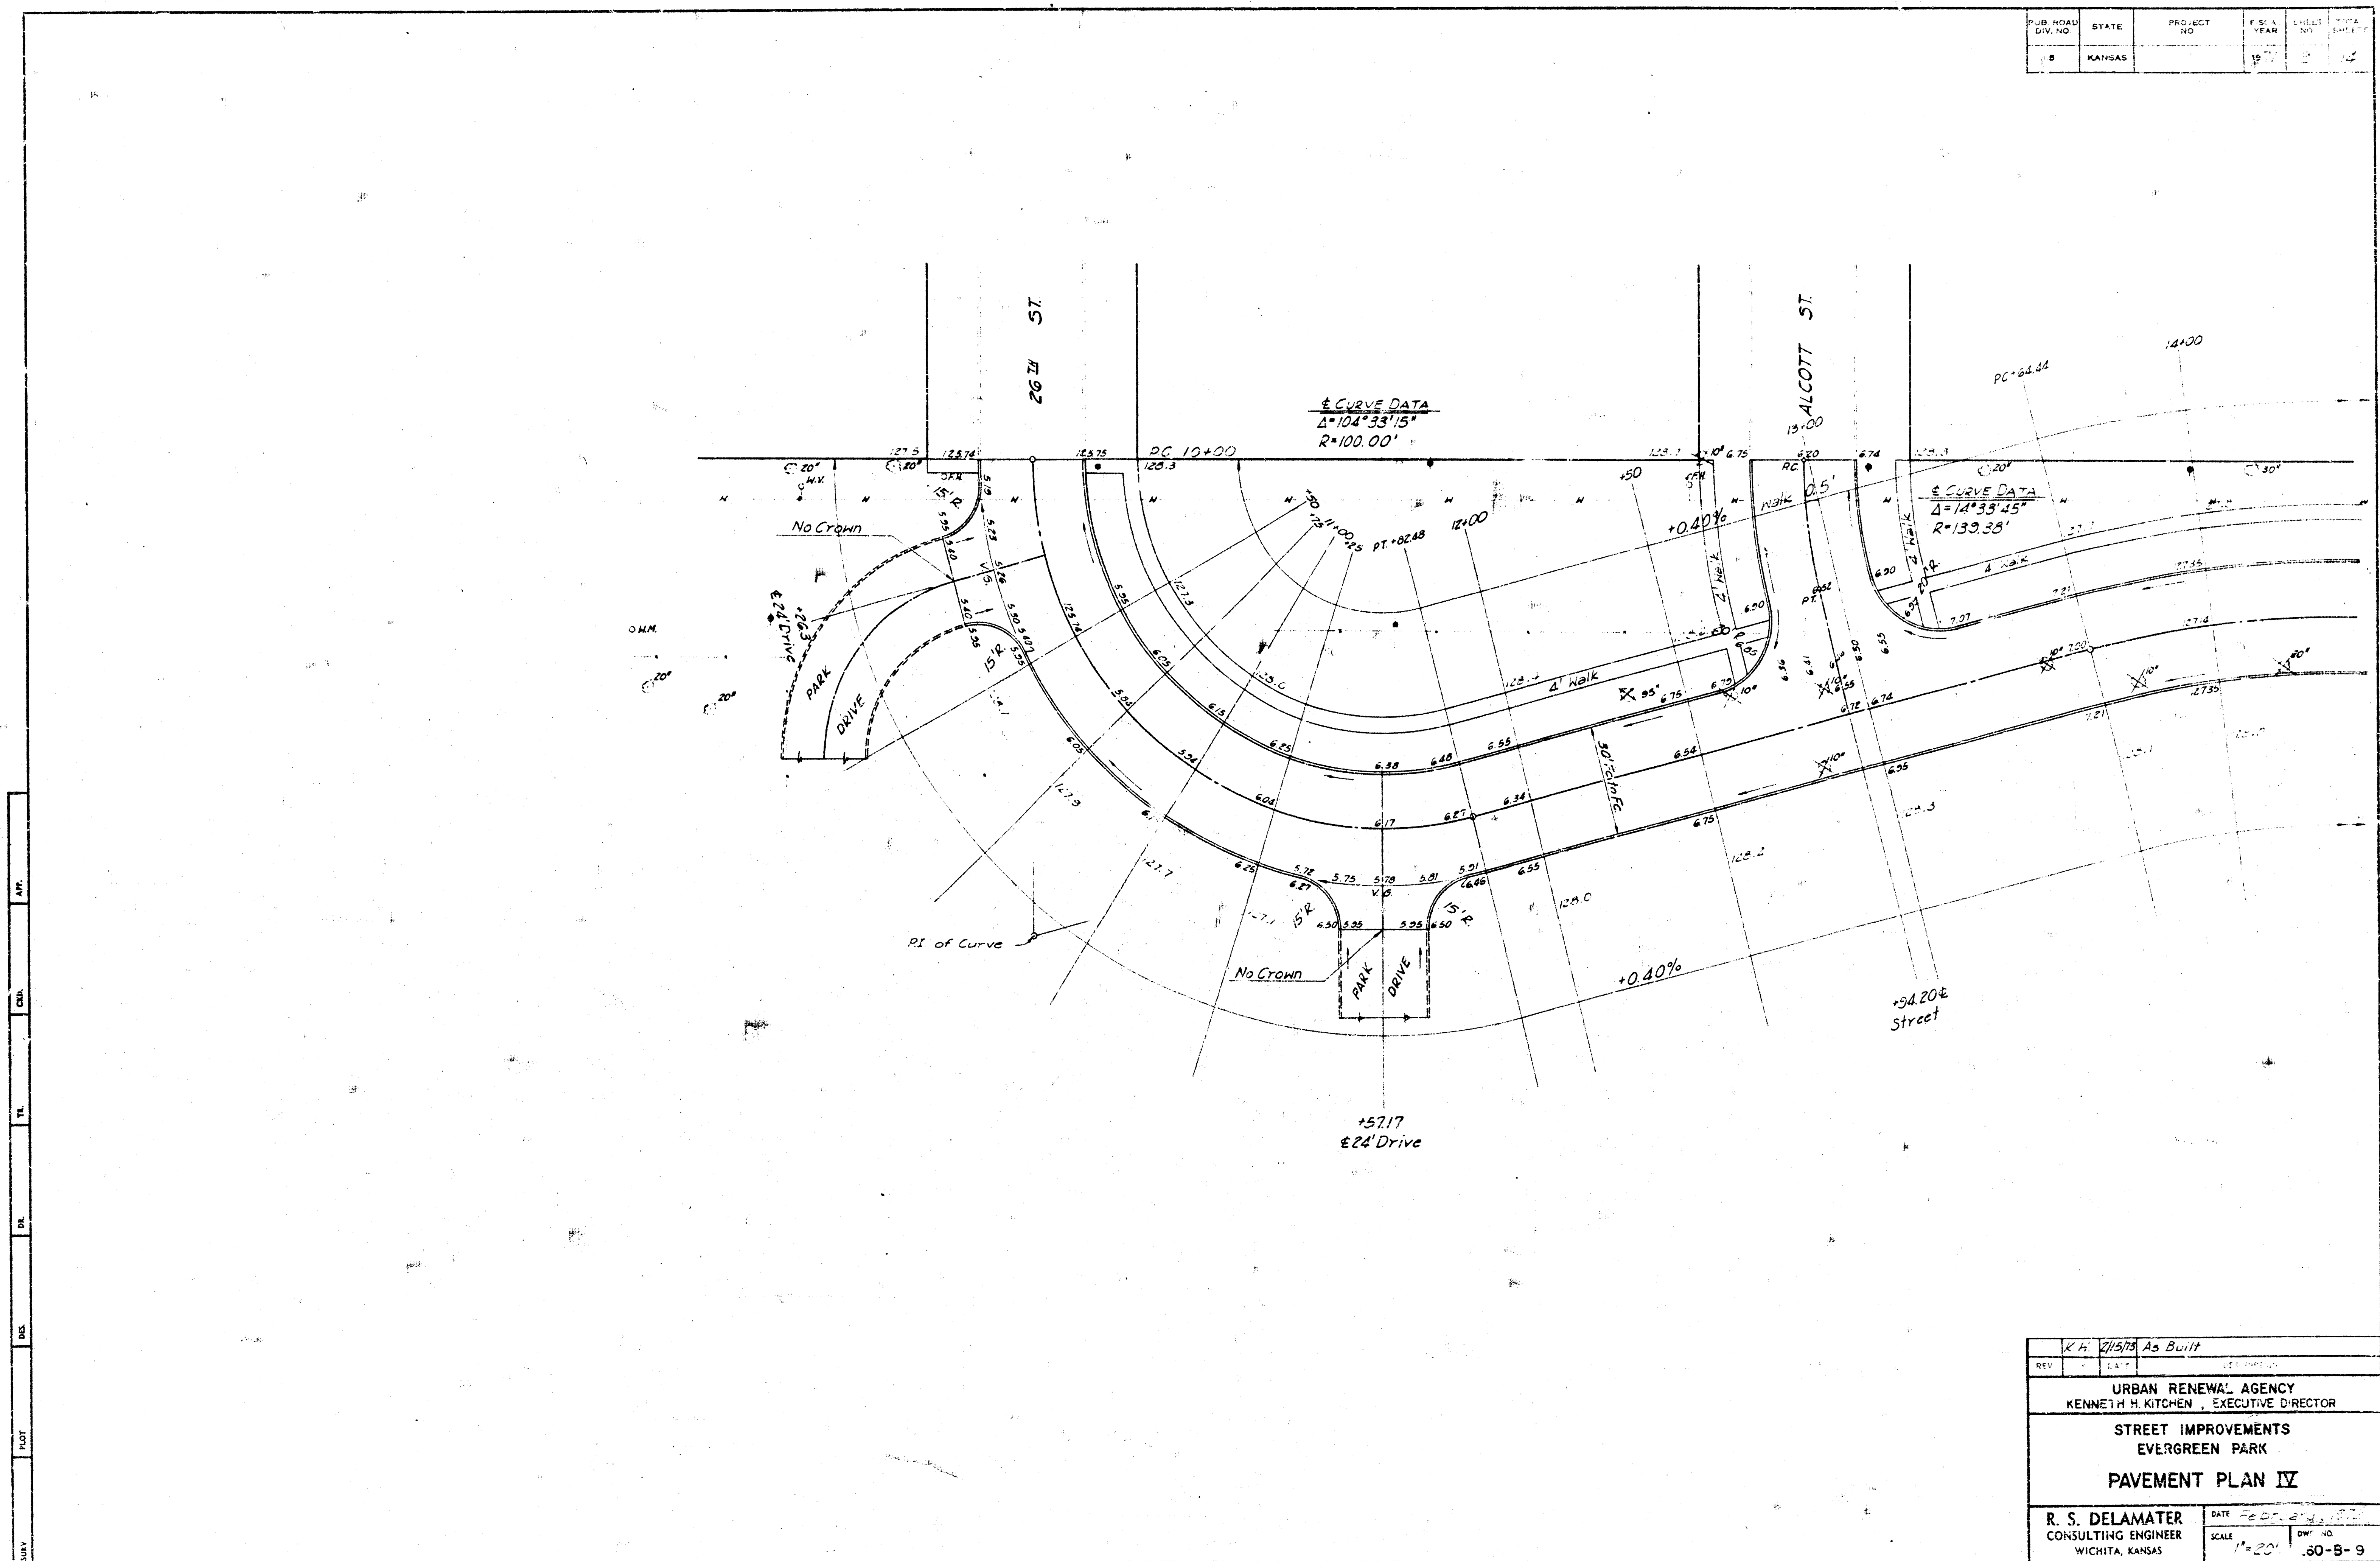


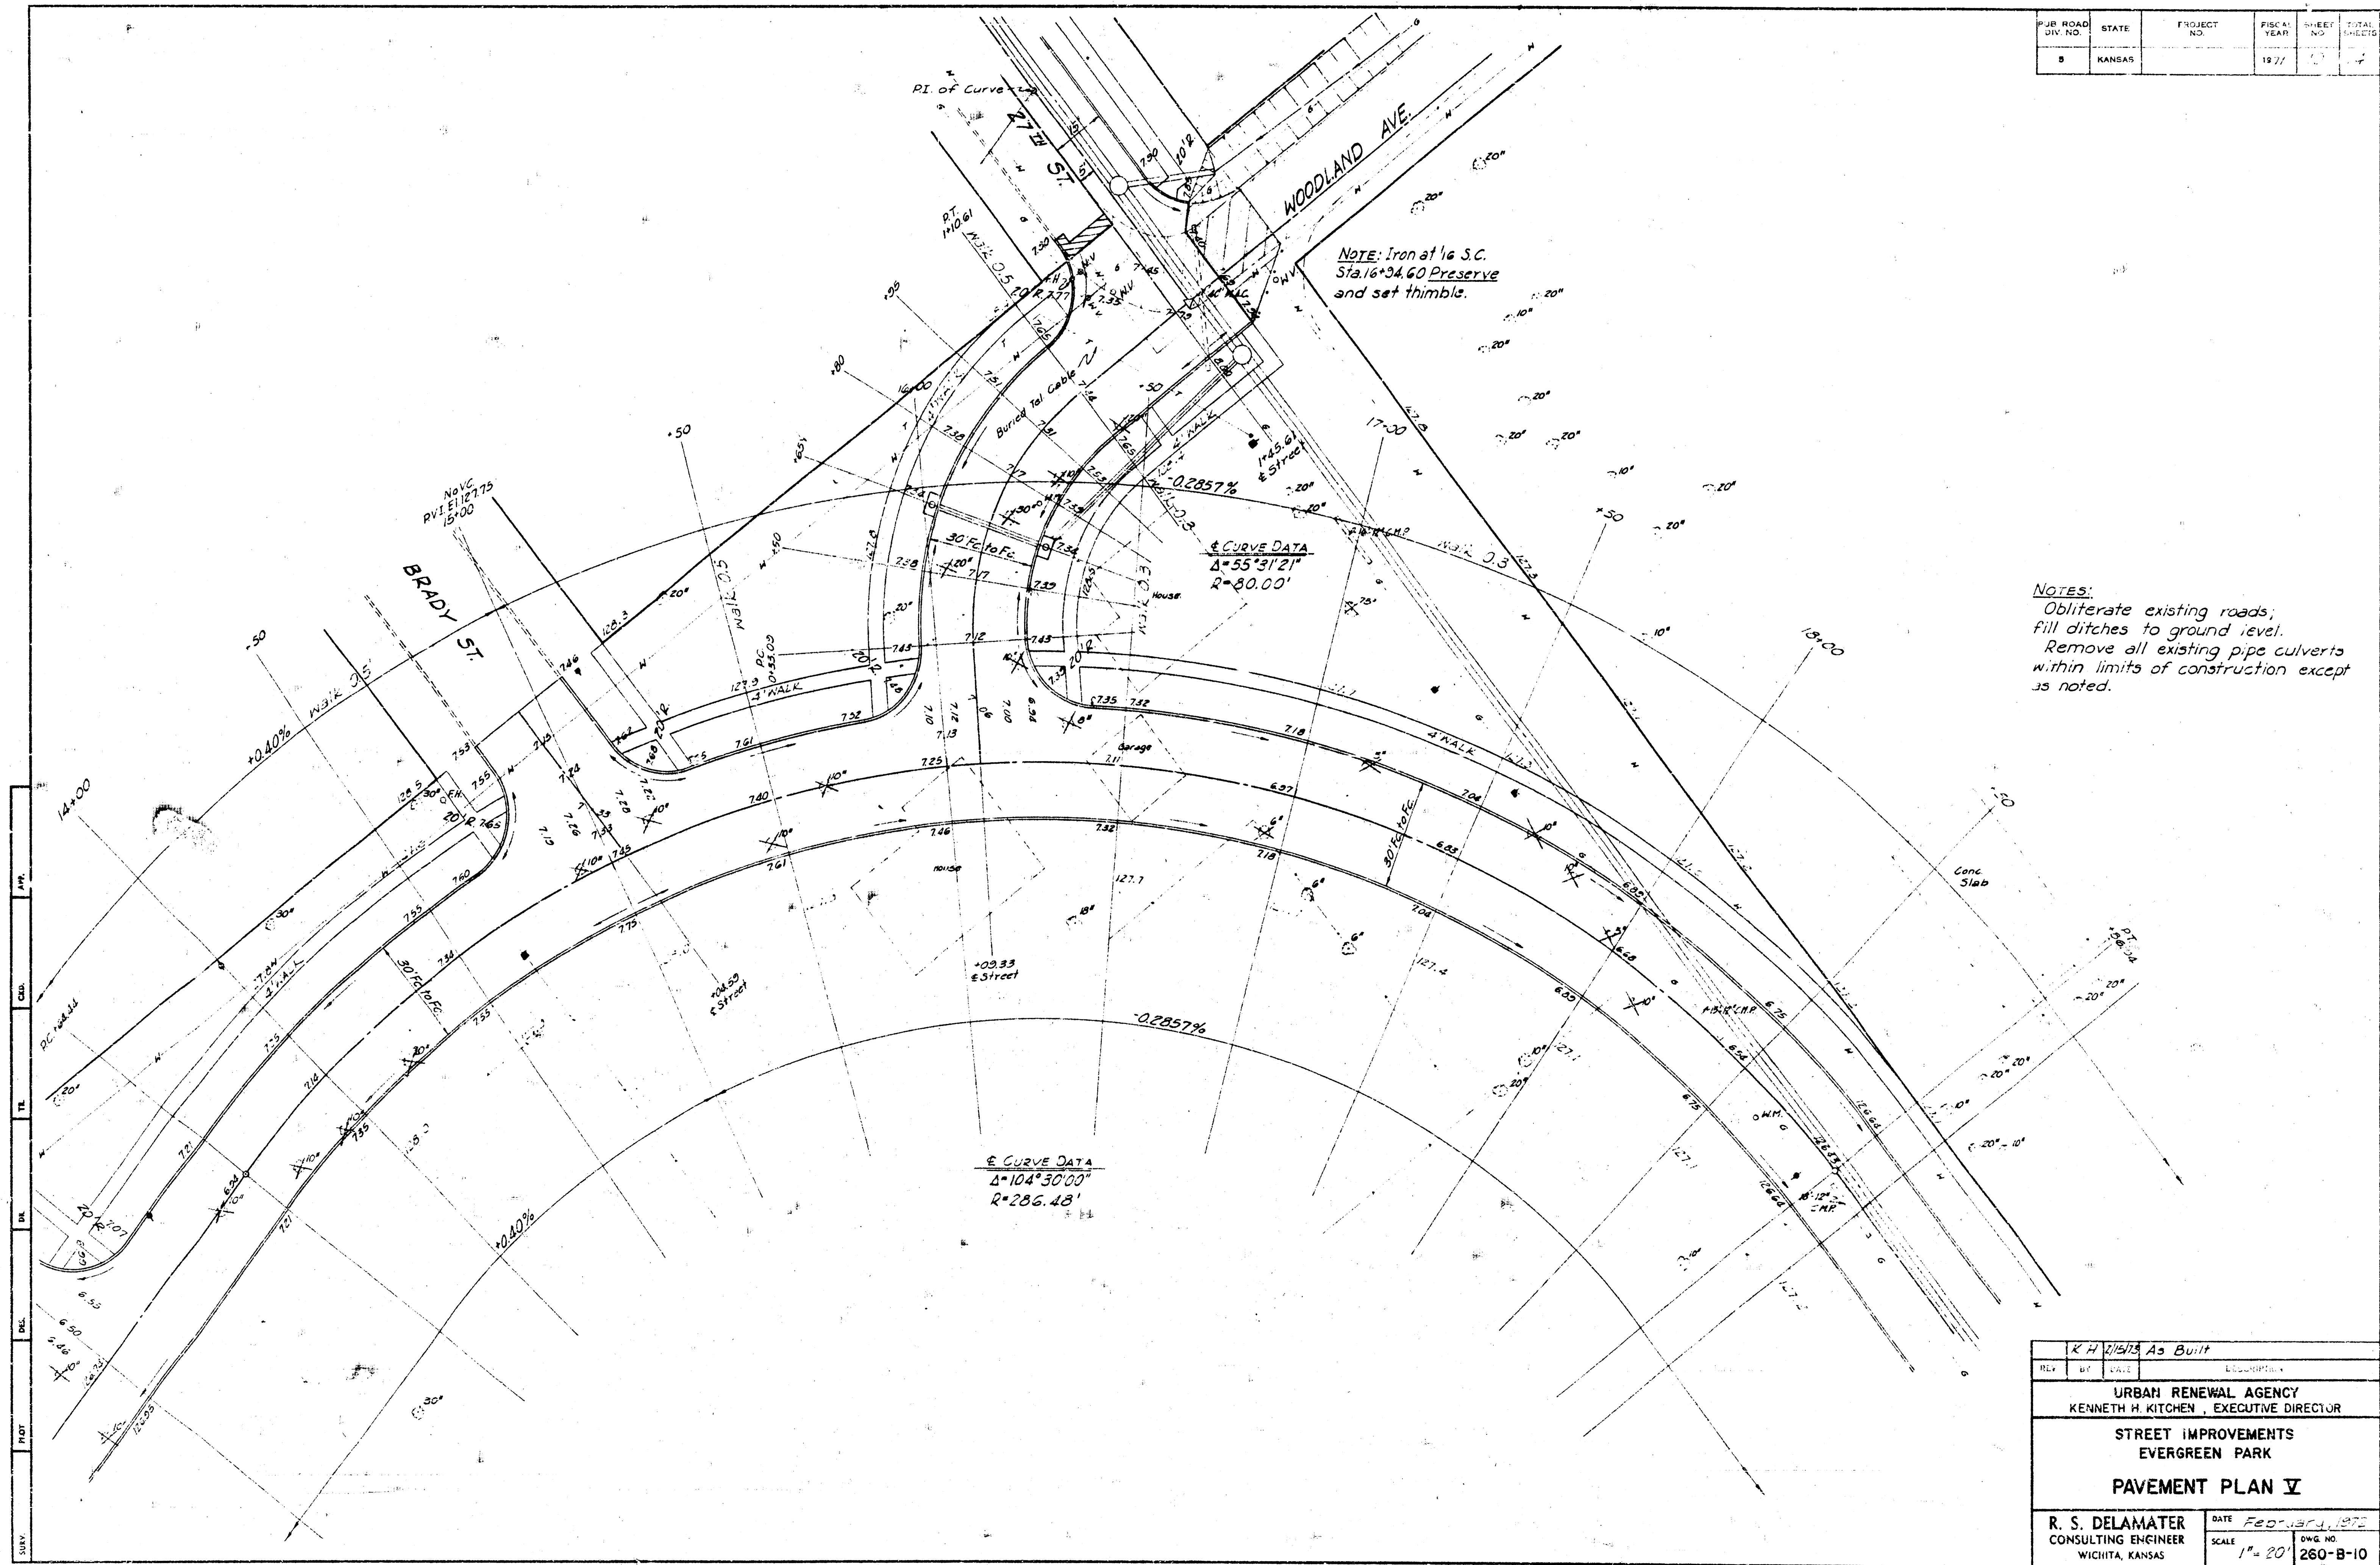

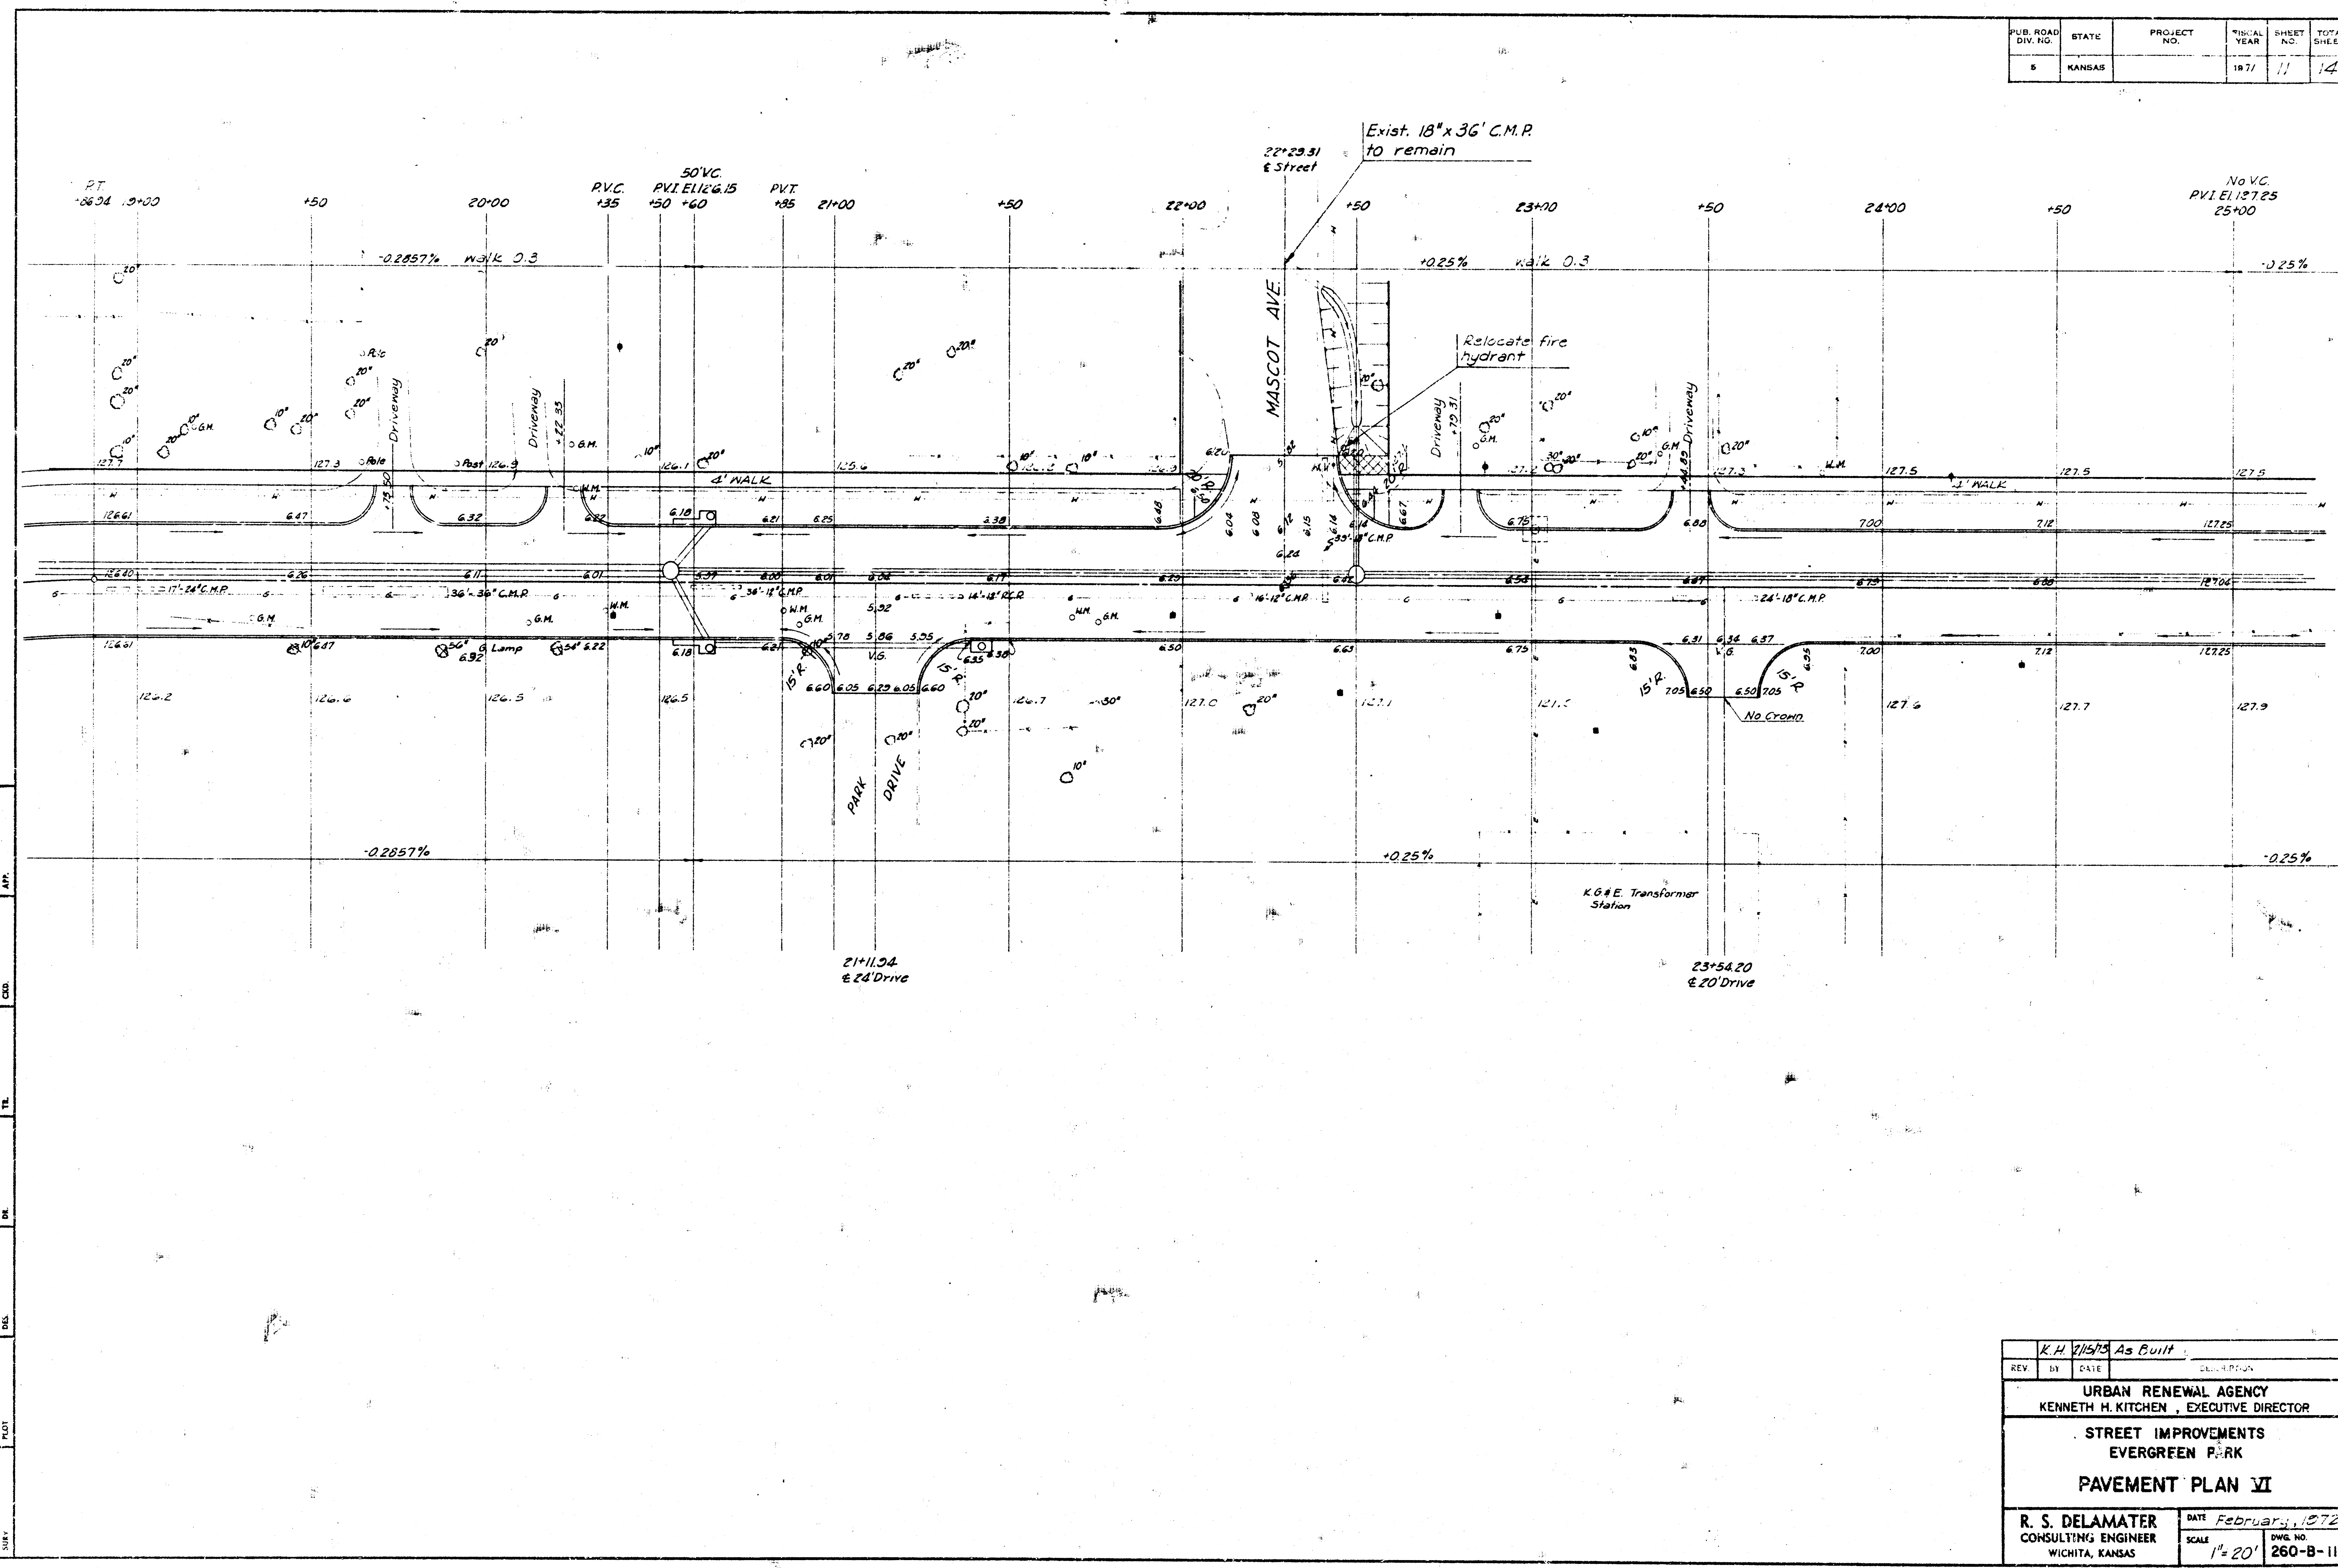


PUB. ROAD DIV. NO.	STATE	PROJECT NO.	TRIAL YEAR	SHEET NO.	TOTAL SHEETS
8	KANSAS		1971	11	14


PUB. ROAD DIV. NO.	STATE	PROJECT NO.	FISCAL YEAR	SHEET NO.	TOTAL SHEETS
5	KANSAS		1971	12	14

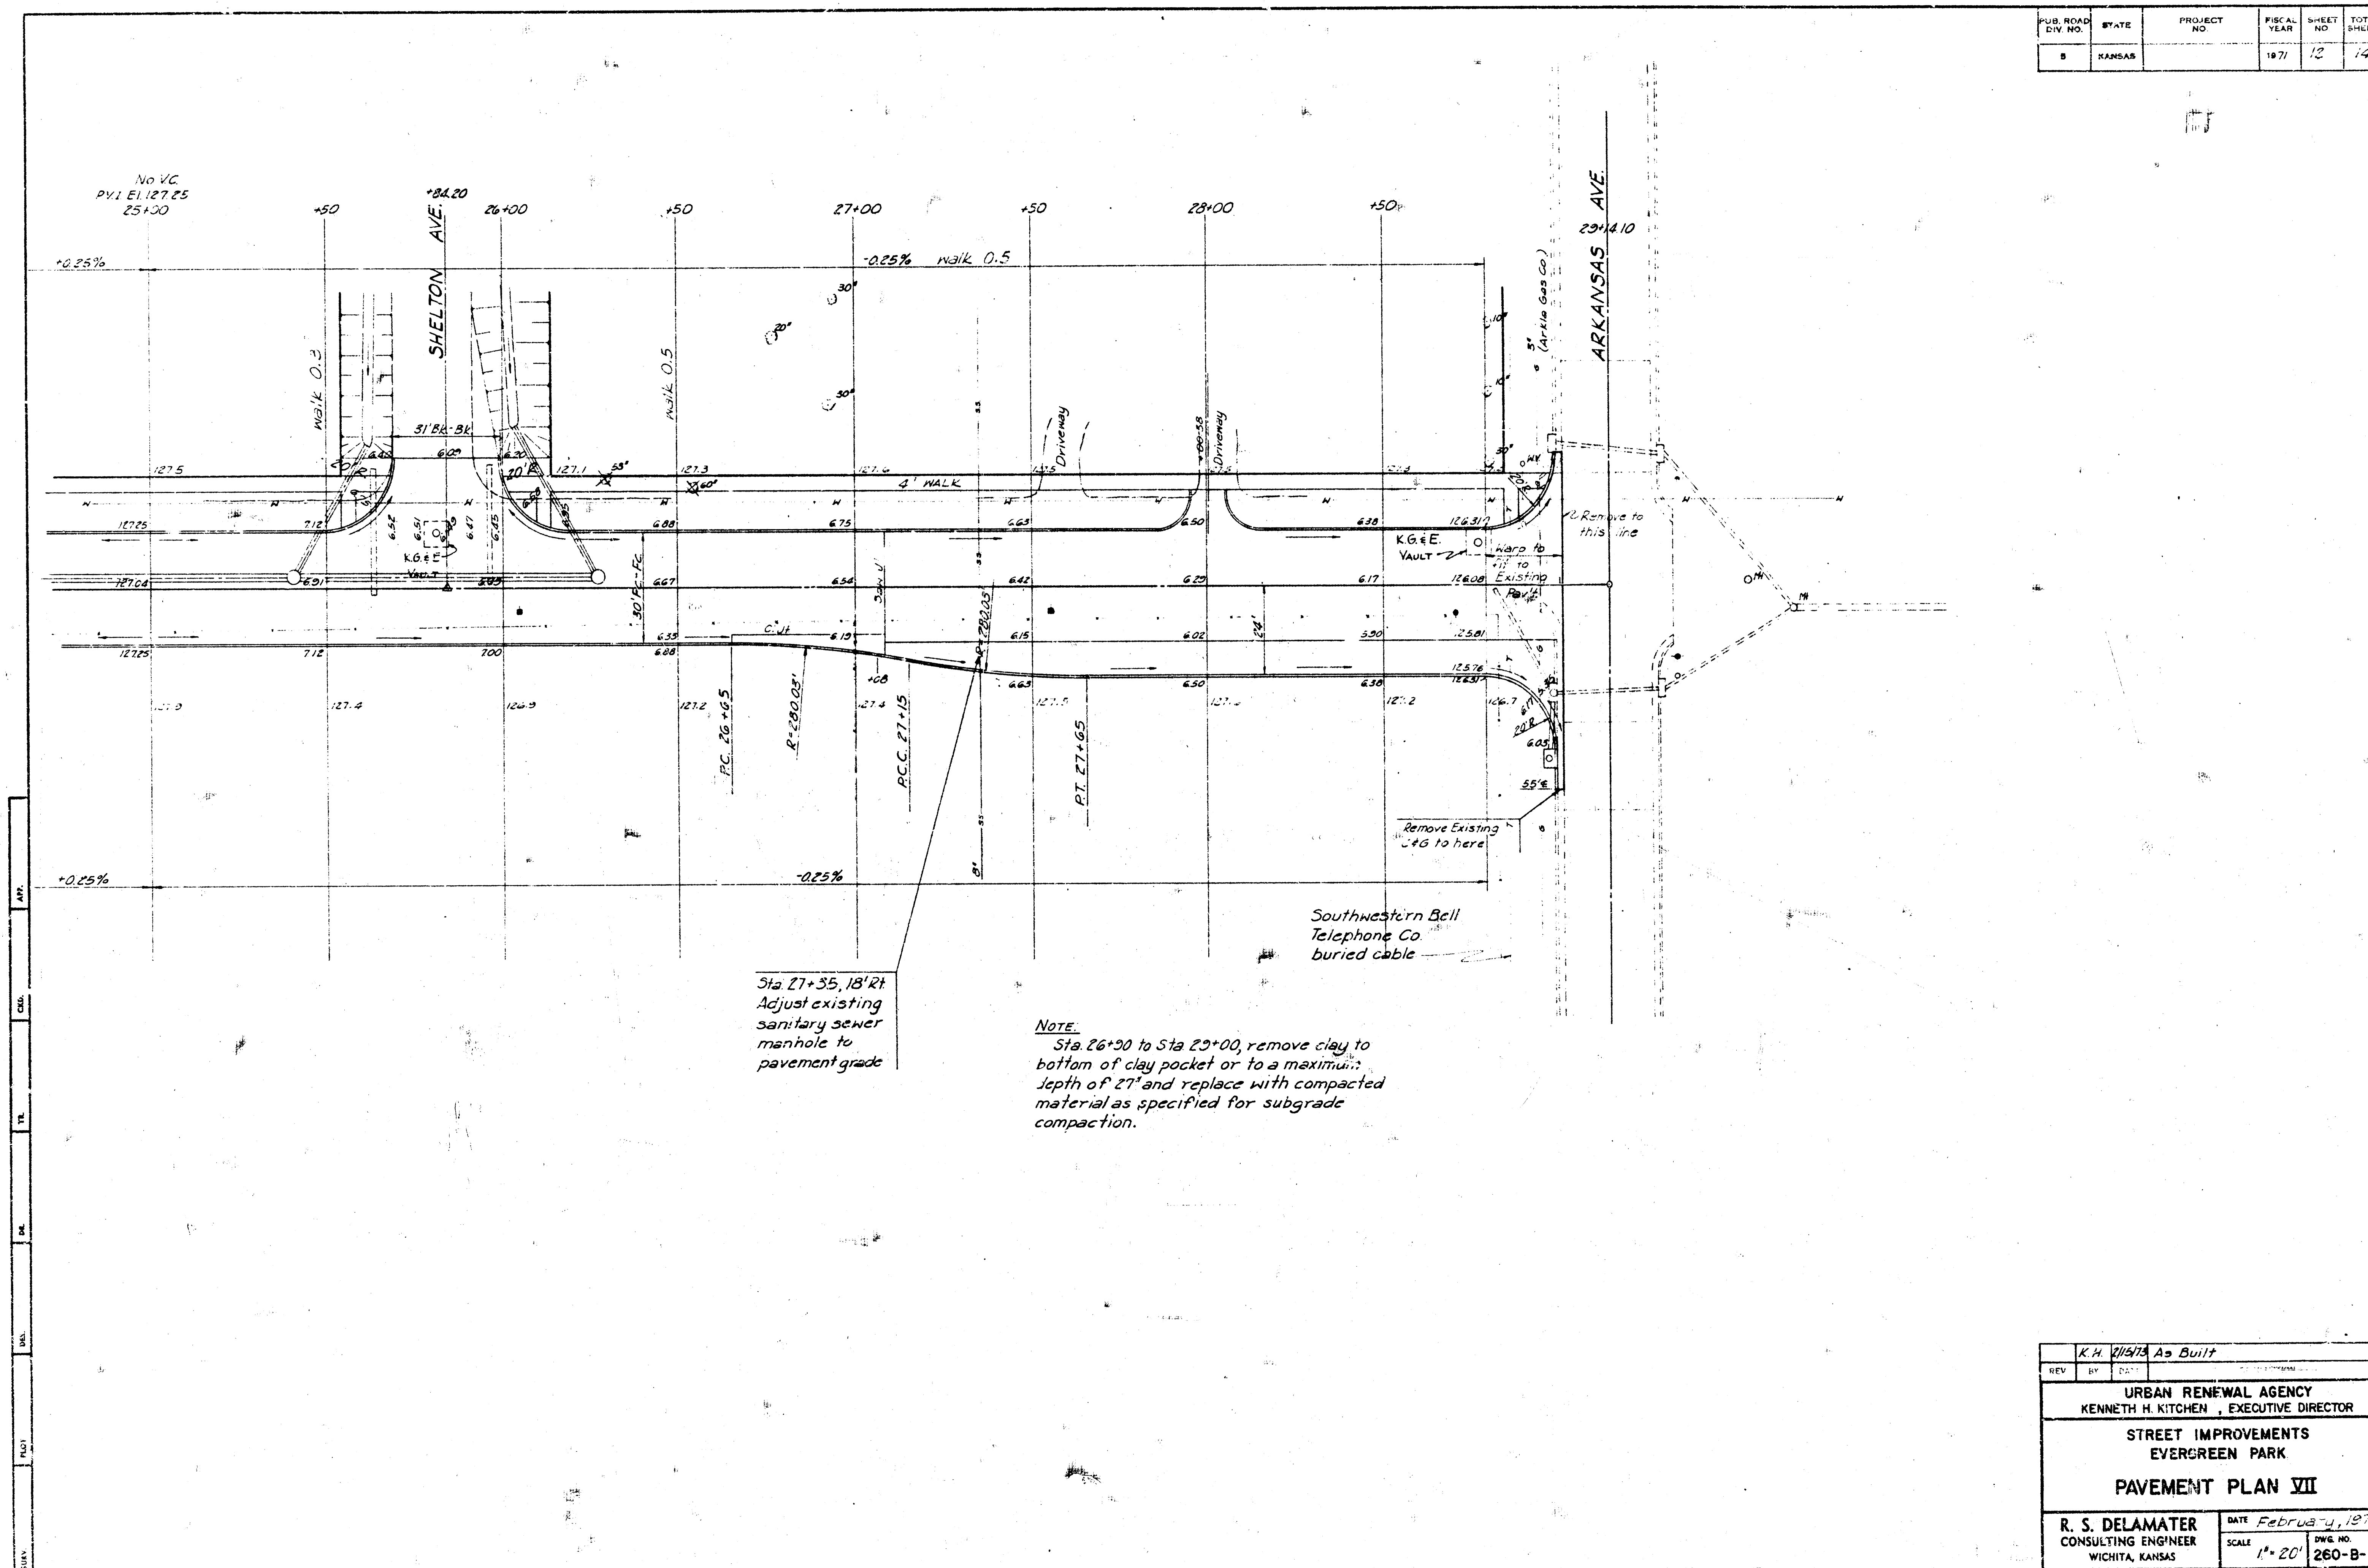


PUB. ROAD	STATE	PROJECT	FILE	SHEET
DIV. NO.	NO.	NO.	NO.	NO.
5	KANSAS		10	1

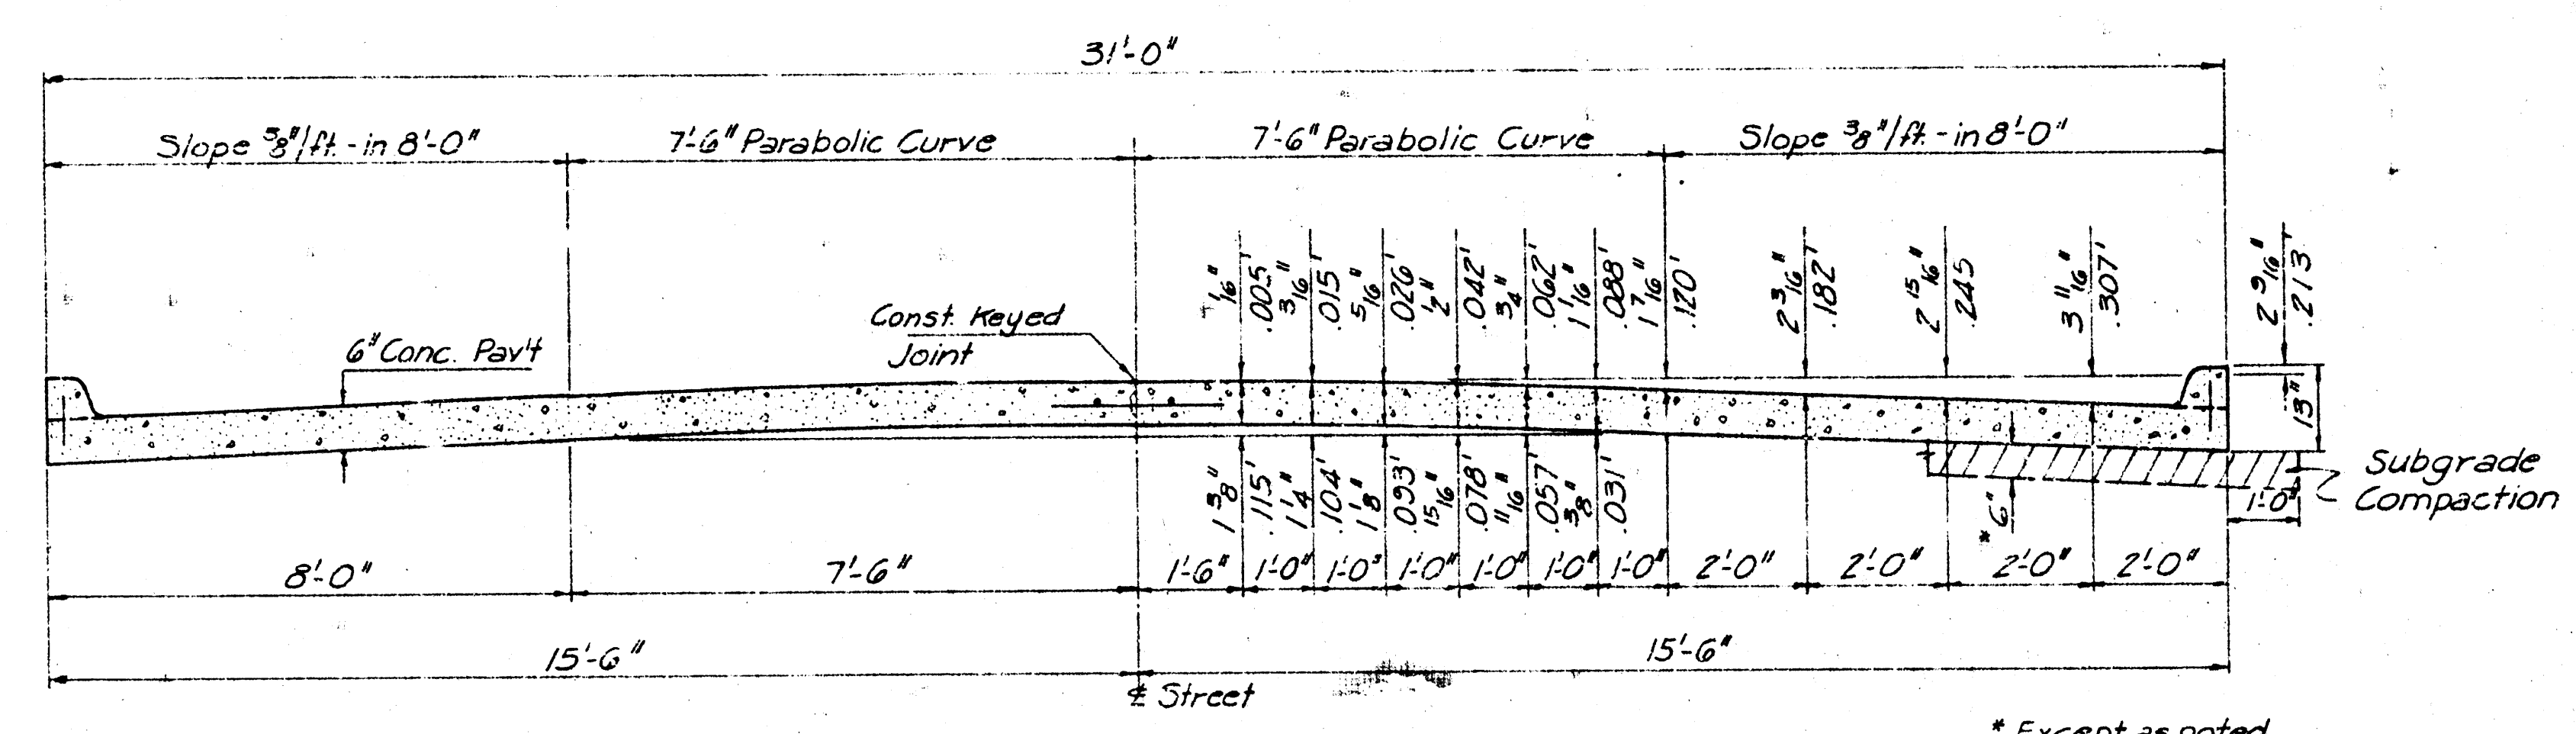


TYPICAL SECTION 31'-0" CONCRETE PAVEMENT

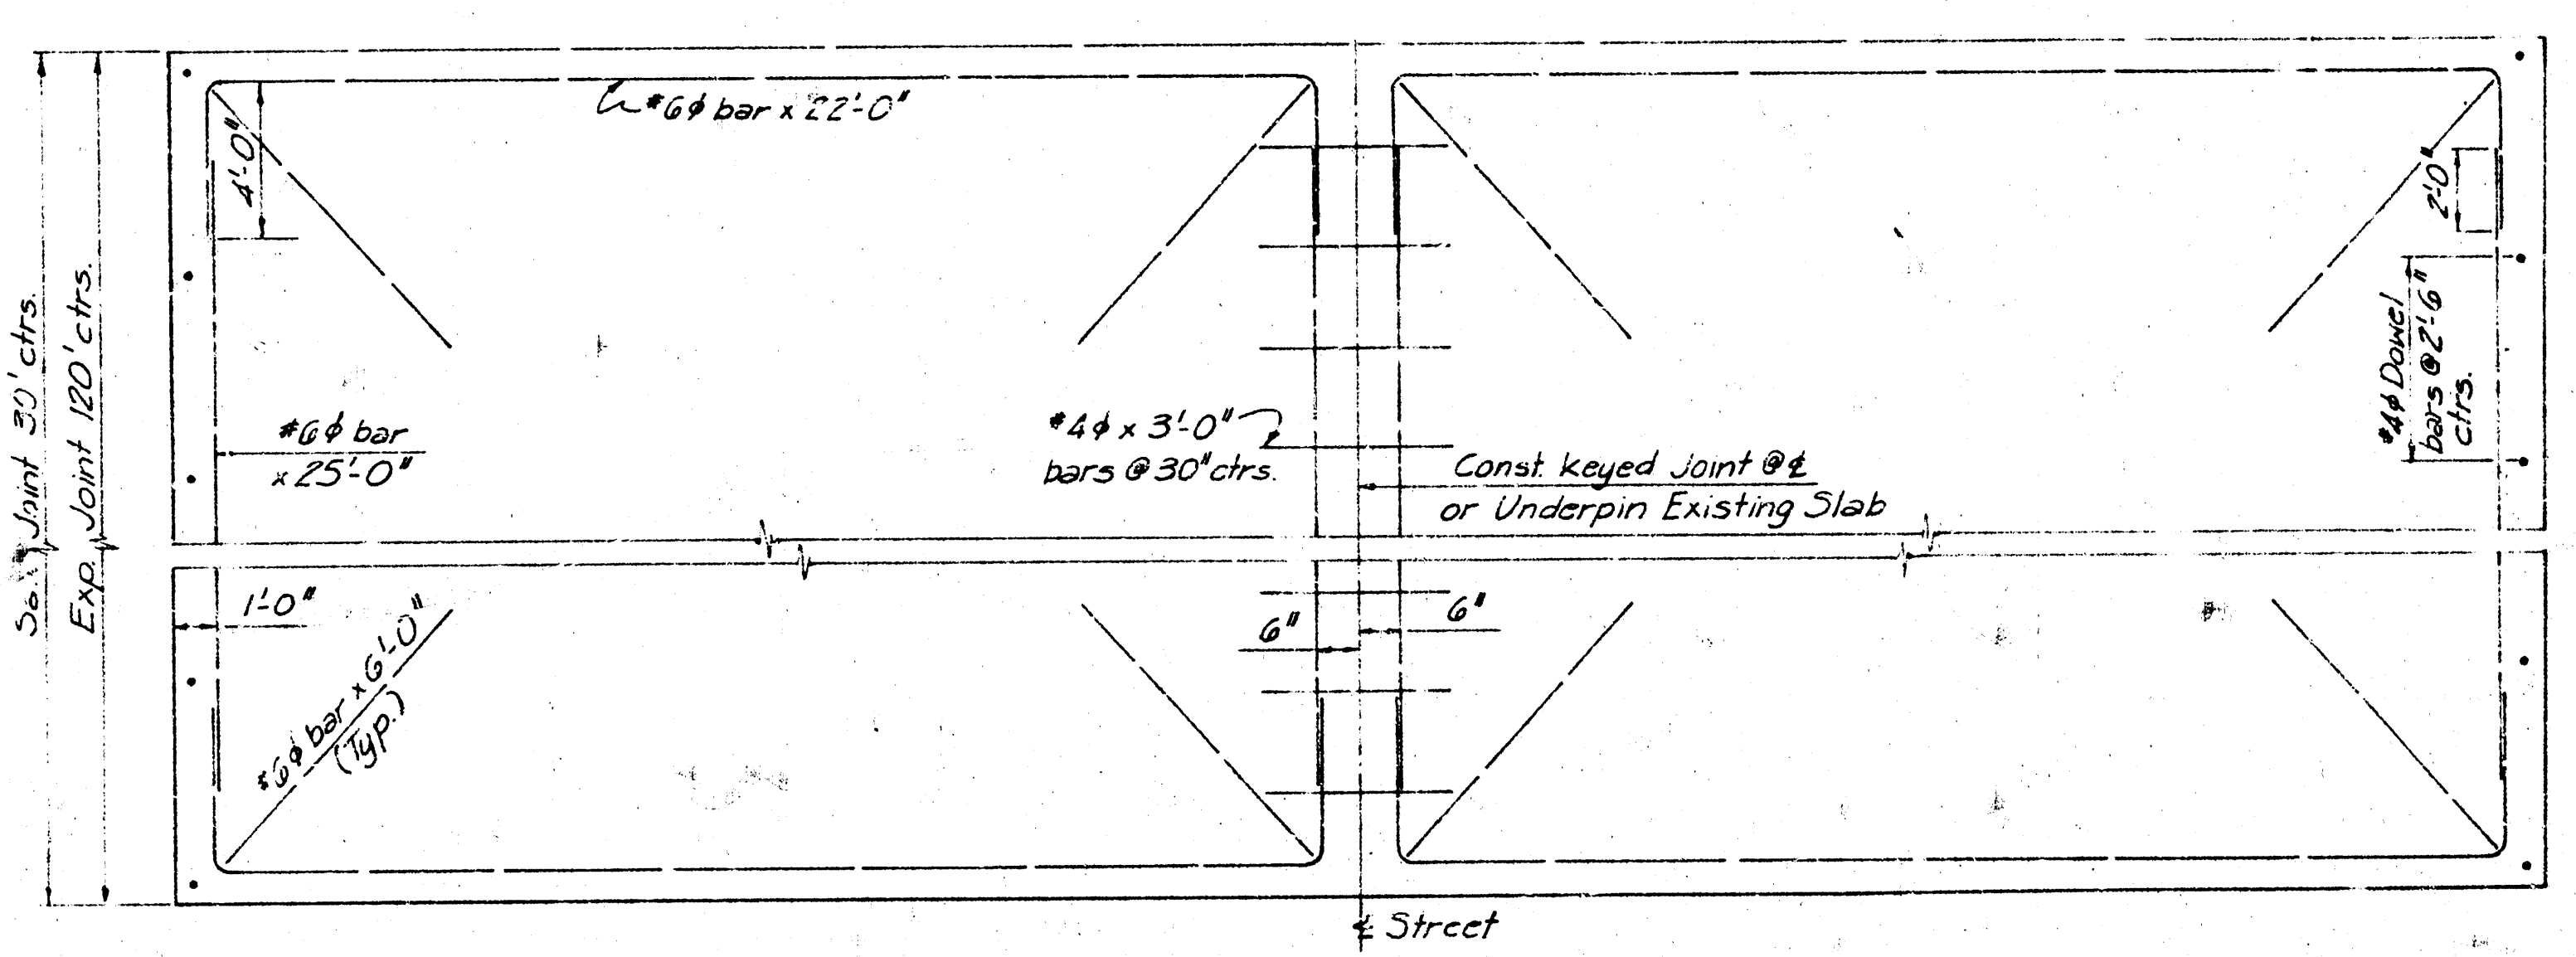


STEEL PATTERN

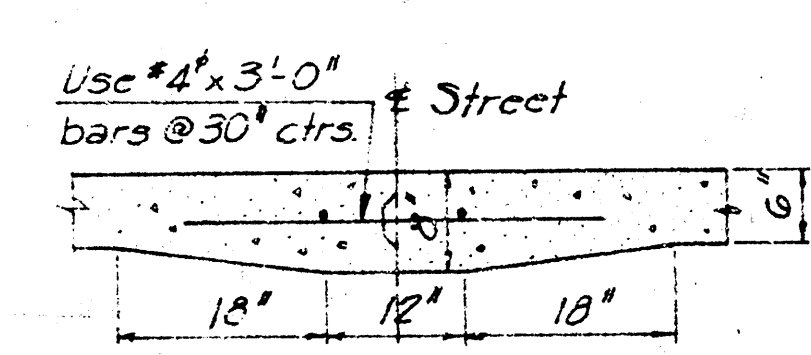


KEY JOINT DETAIL

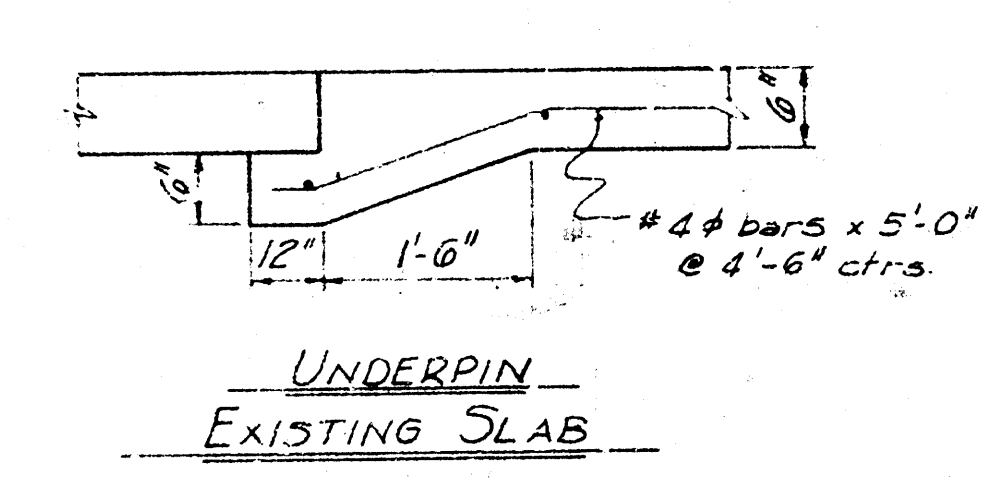


UNDERPIN EXISTING SLAB

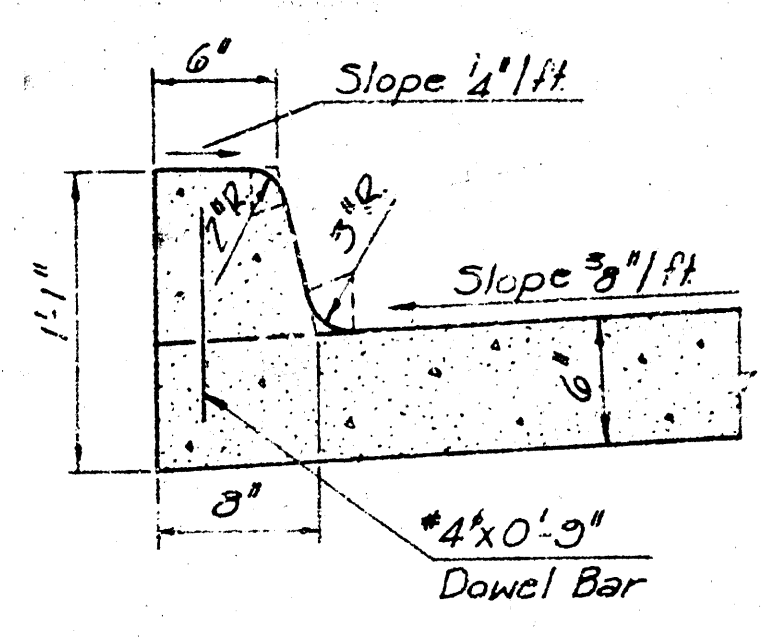


TYPICAL SECTION INTEGRAL CURB

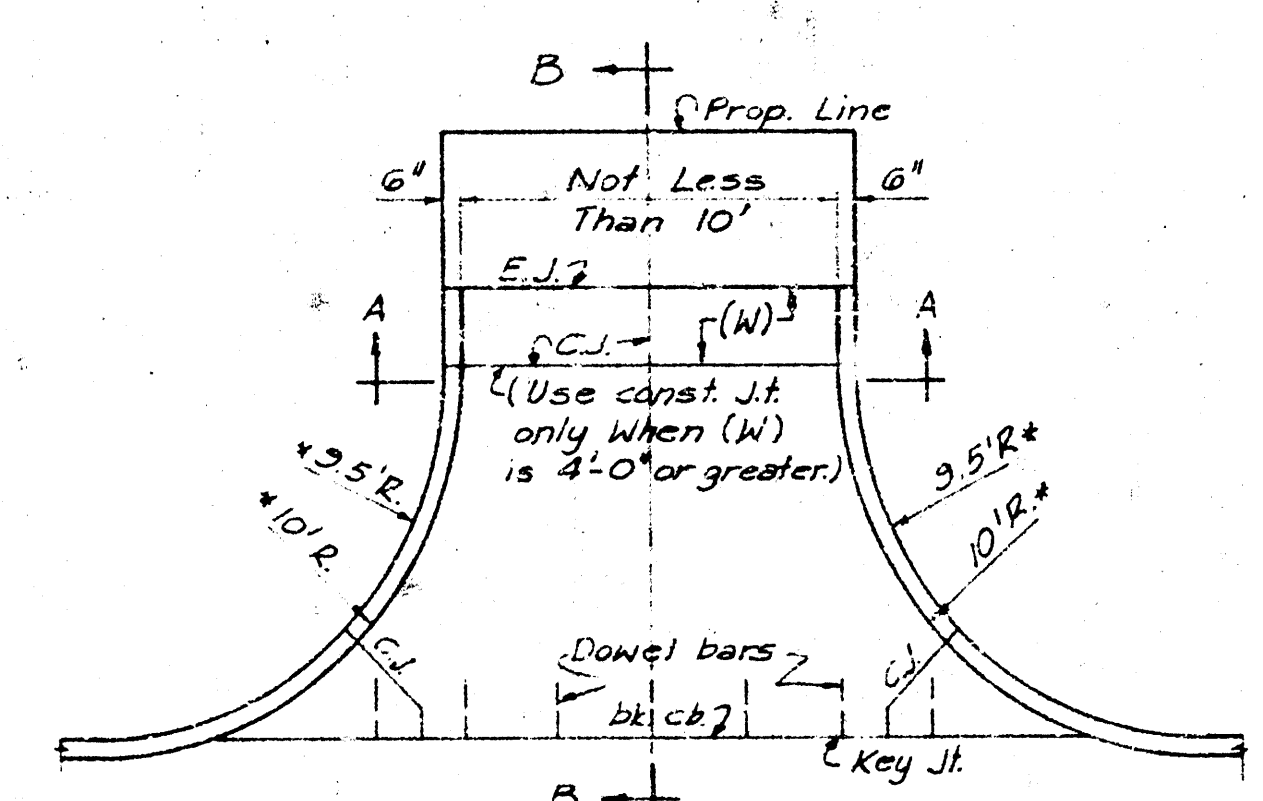


PLAN OF DRIVE (RECOMMENDED 10'-0" RADIUS)

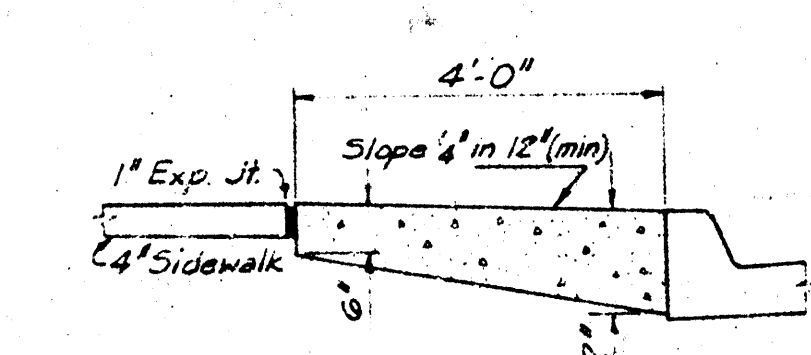


STANDARD 9" WALK SECTION AT INTERSECTIONS

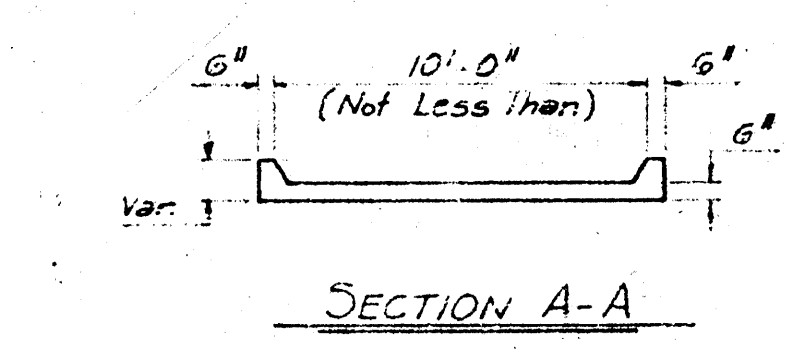

SECTION A-A

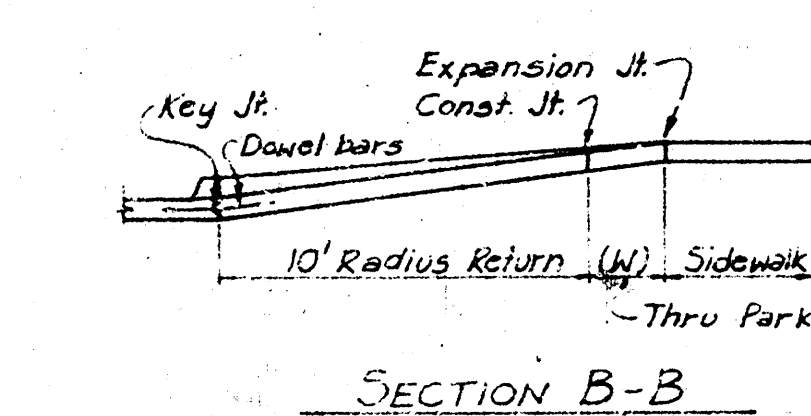


SECTION B-B

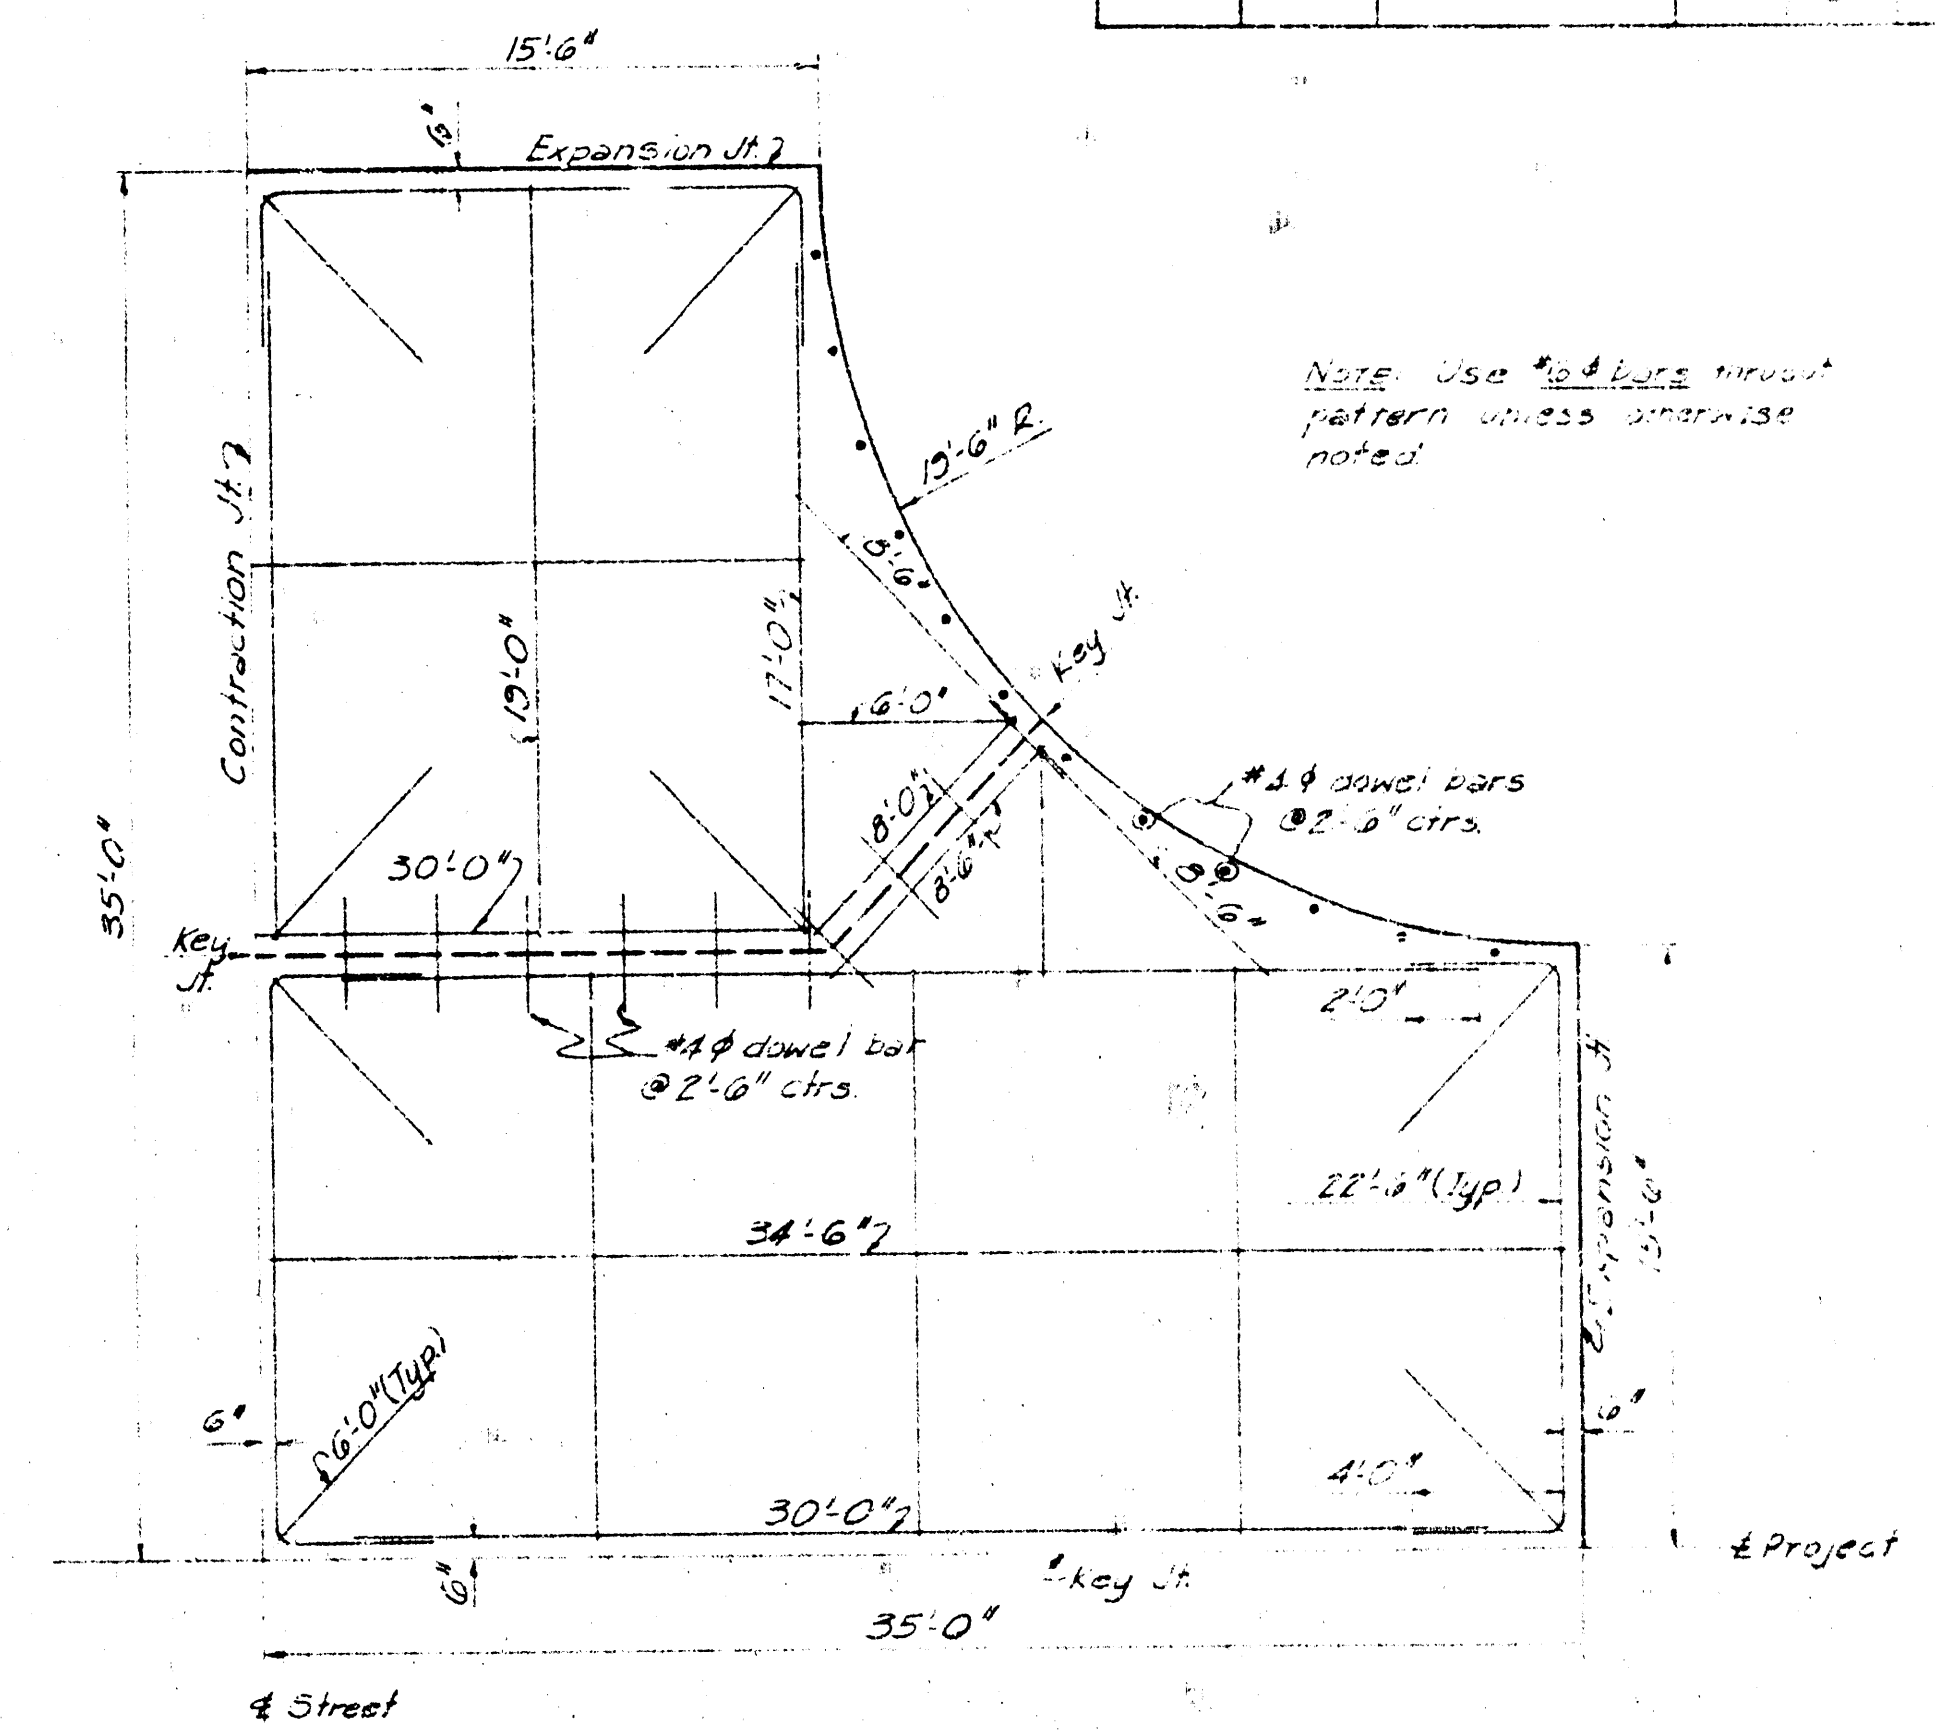

TYPICAL INTERSECTION DETAIL

TYP Sta 10+00 to 16+10

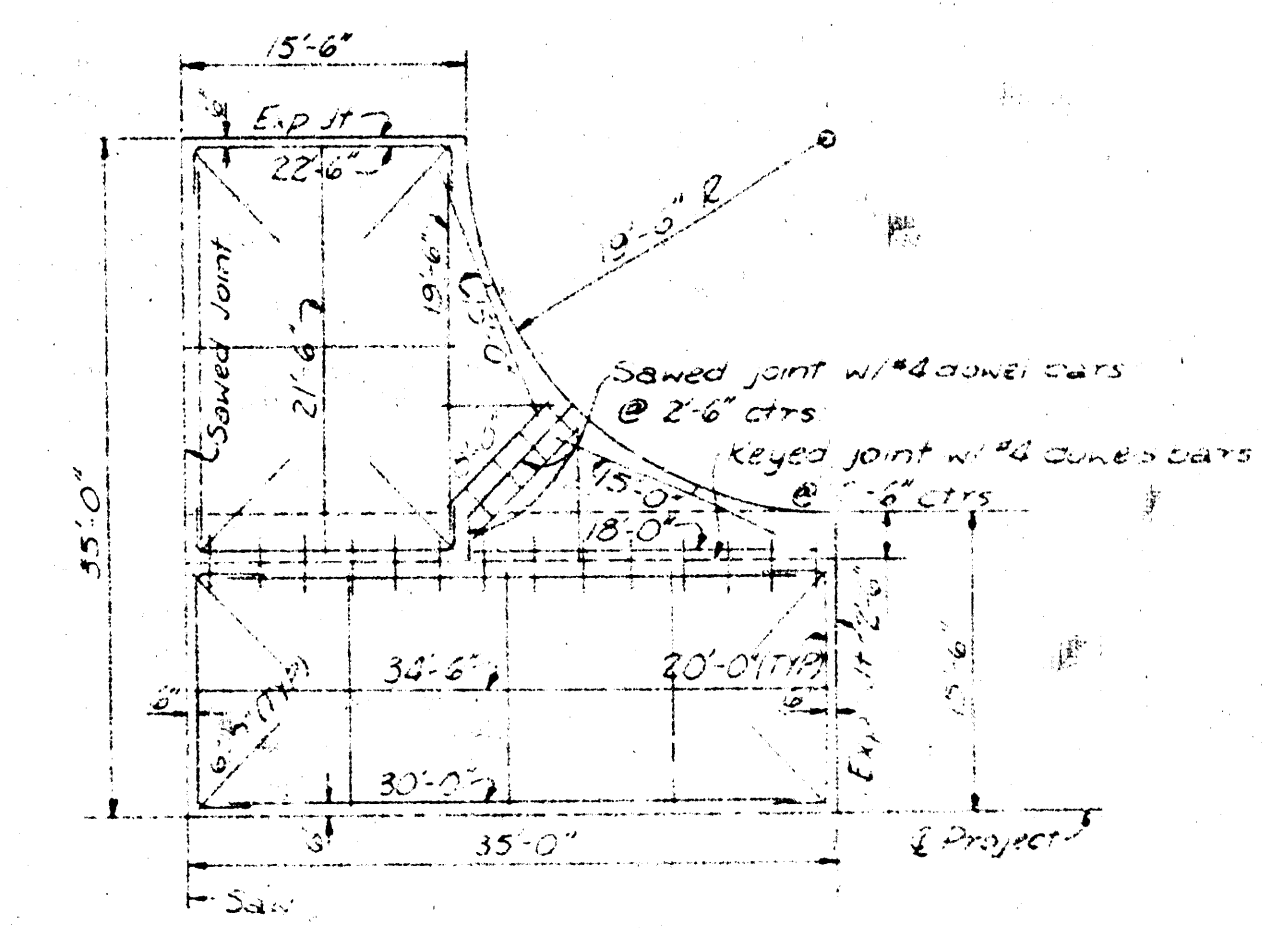


MODIFIED INTERSECTION DETAIL


TYP Lt Sta 22+29.31 & Sta 25+84.20 (As Built)

K.H. GALT As Built	
REV	BY
URBAN RENEWAL AGENCY	
KENNETH H. KITCHEN, EXECUTIVE DIRECTOR	
STREET IMPROVEMENTS	
EVERGREEN PARK	
PAVEMENT DETAILS	
R. S. DELAMATER	DATE FEBRUARY 1962
CONSULTING ENGINEER	SCALE
WICHITA, KANSAS	260-B-13

FILE NO.	DATE	PROJECT NO.	REV. NO.	DATE
5	KANSAS		1971	

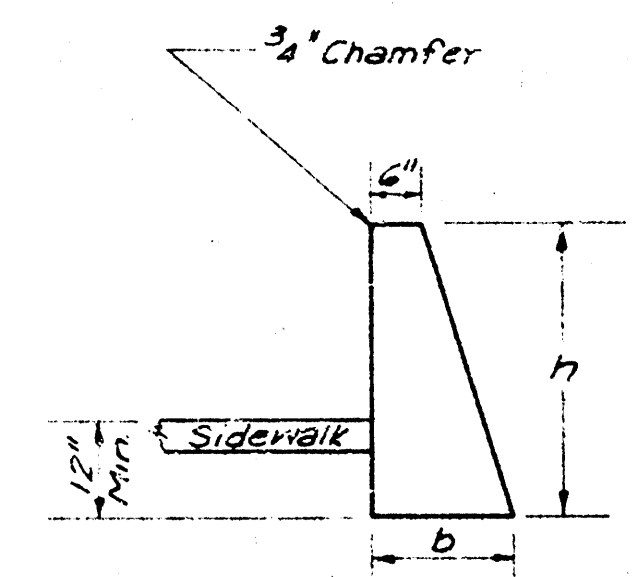


DIMENSIONS			Con. / FR
H	D		Cu Yds
1'-0"	11"		0.42
2'-0"	13"		0.55
2'-3"	15"		0.73
2'-6"	17"		0.89
2'-9"	18"		1.04
3'-0"	20"		1.20

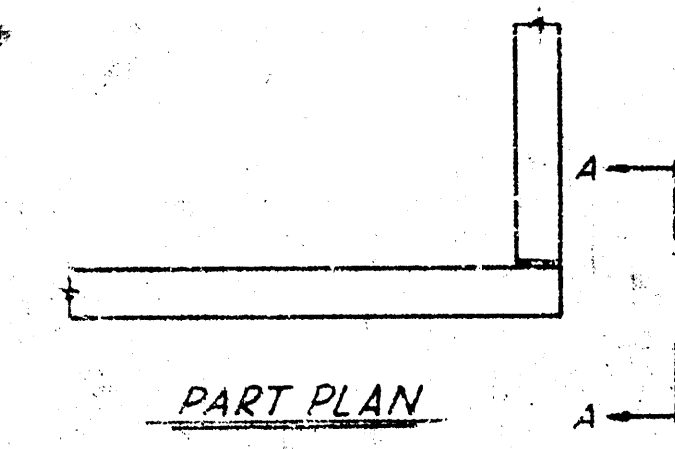


CORNER DETAIL


NOTE: Space cut joints thru wall at approximately 20' and as indicated at right. Chamfer all exposed edges and corners with 1/4" triangular molding.

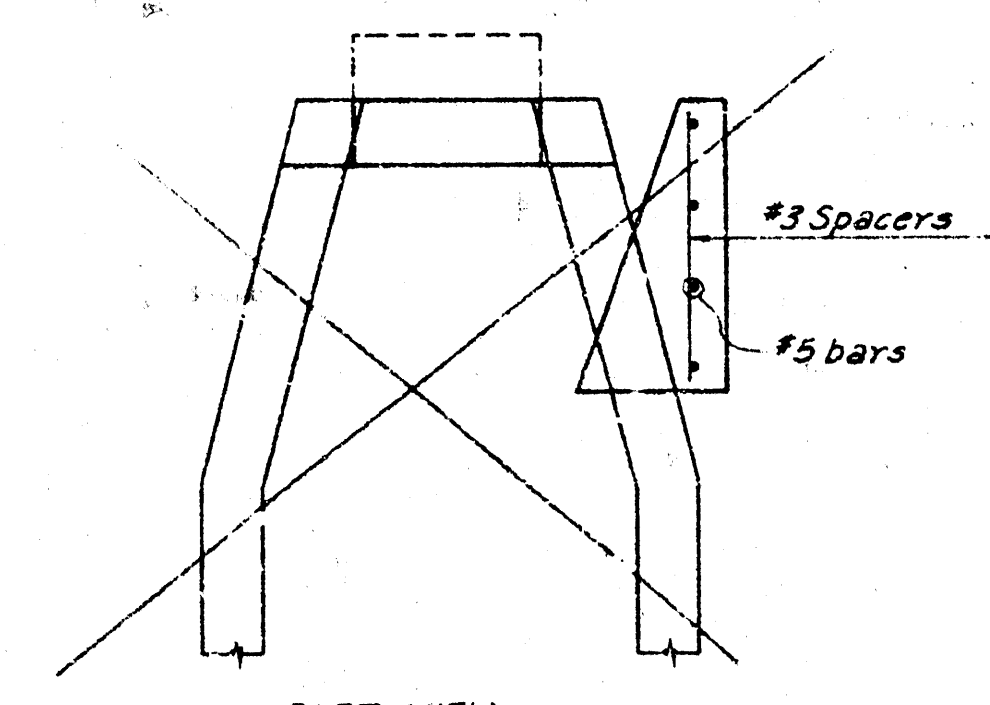


PART VIEW

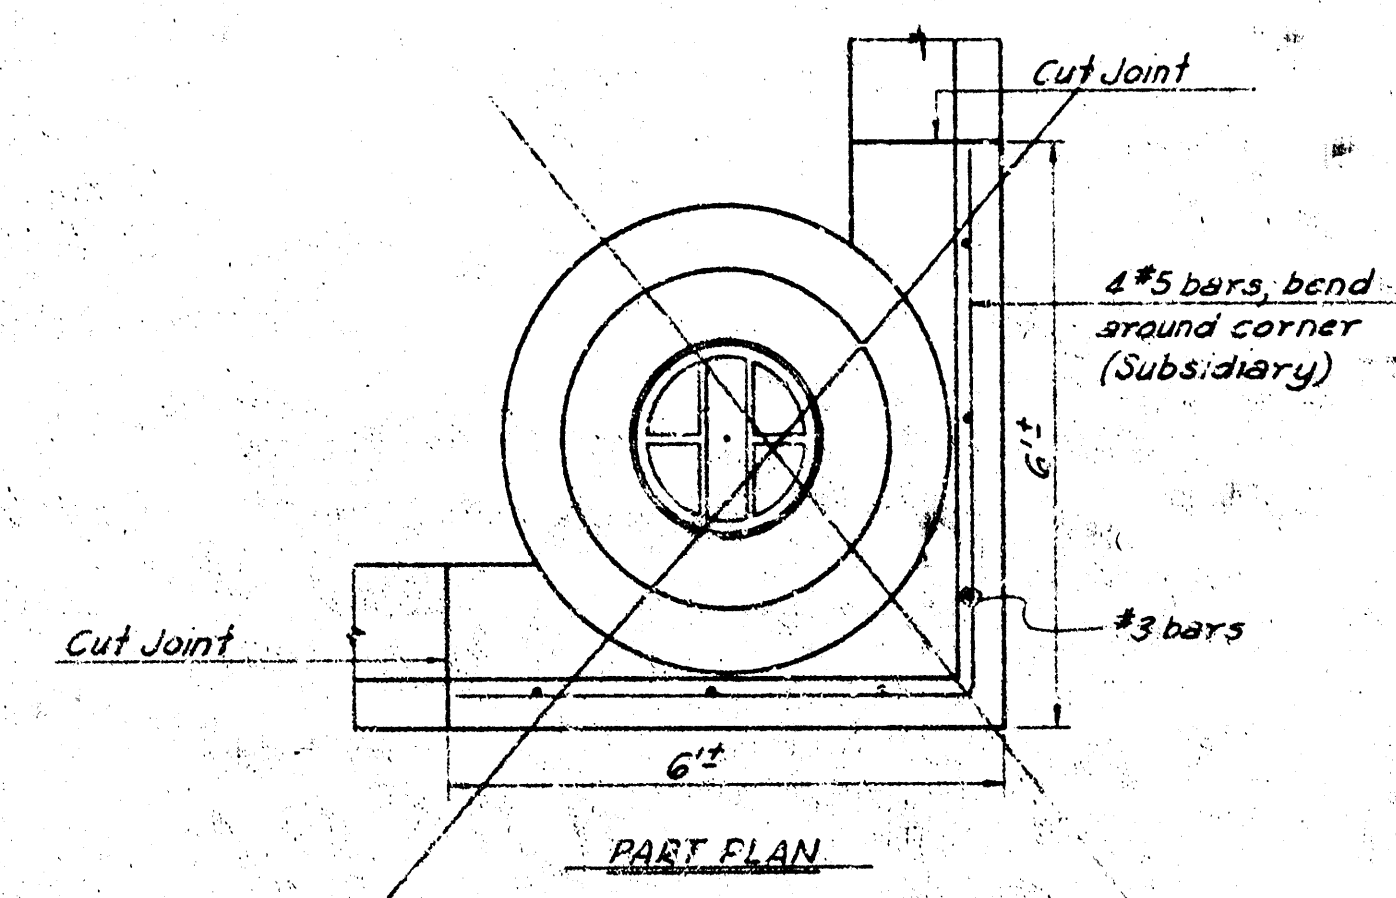


SPECIAL DETAIL AT MANHOLE STA 13+68.15

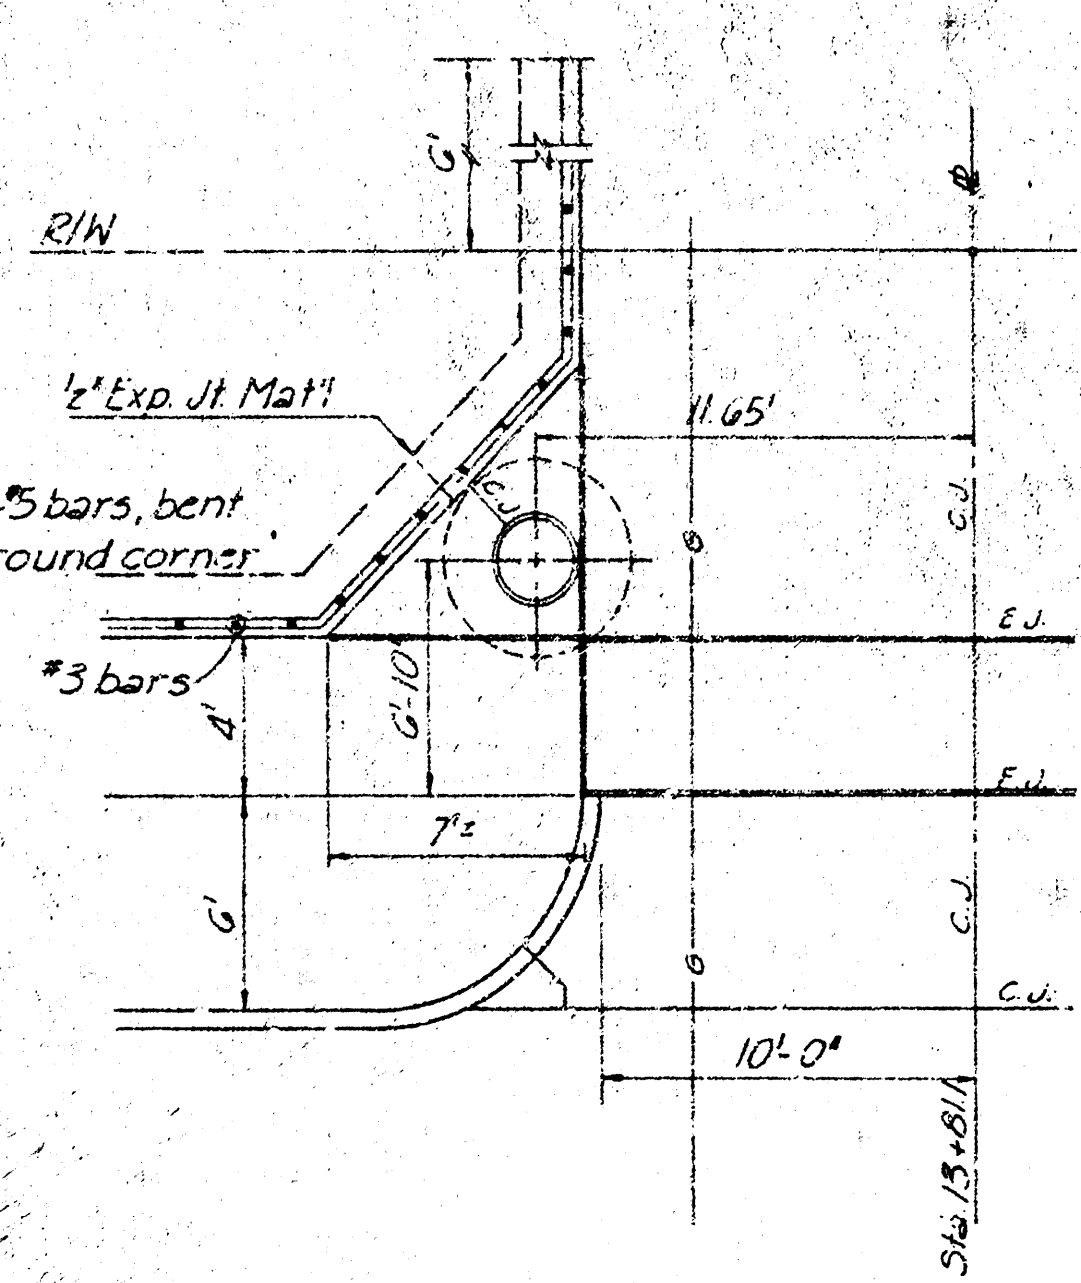

SPECIAL DETAIL AT MANHOLE STA 13+69.45 (As Built)

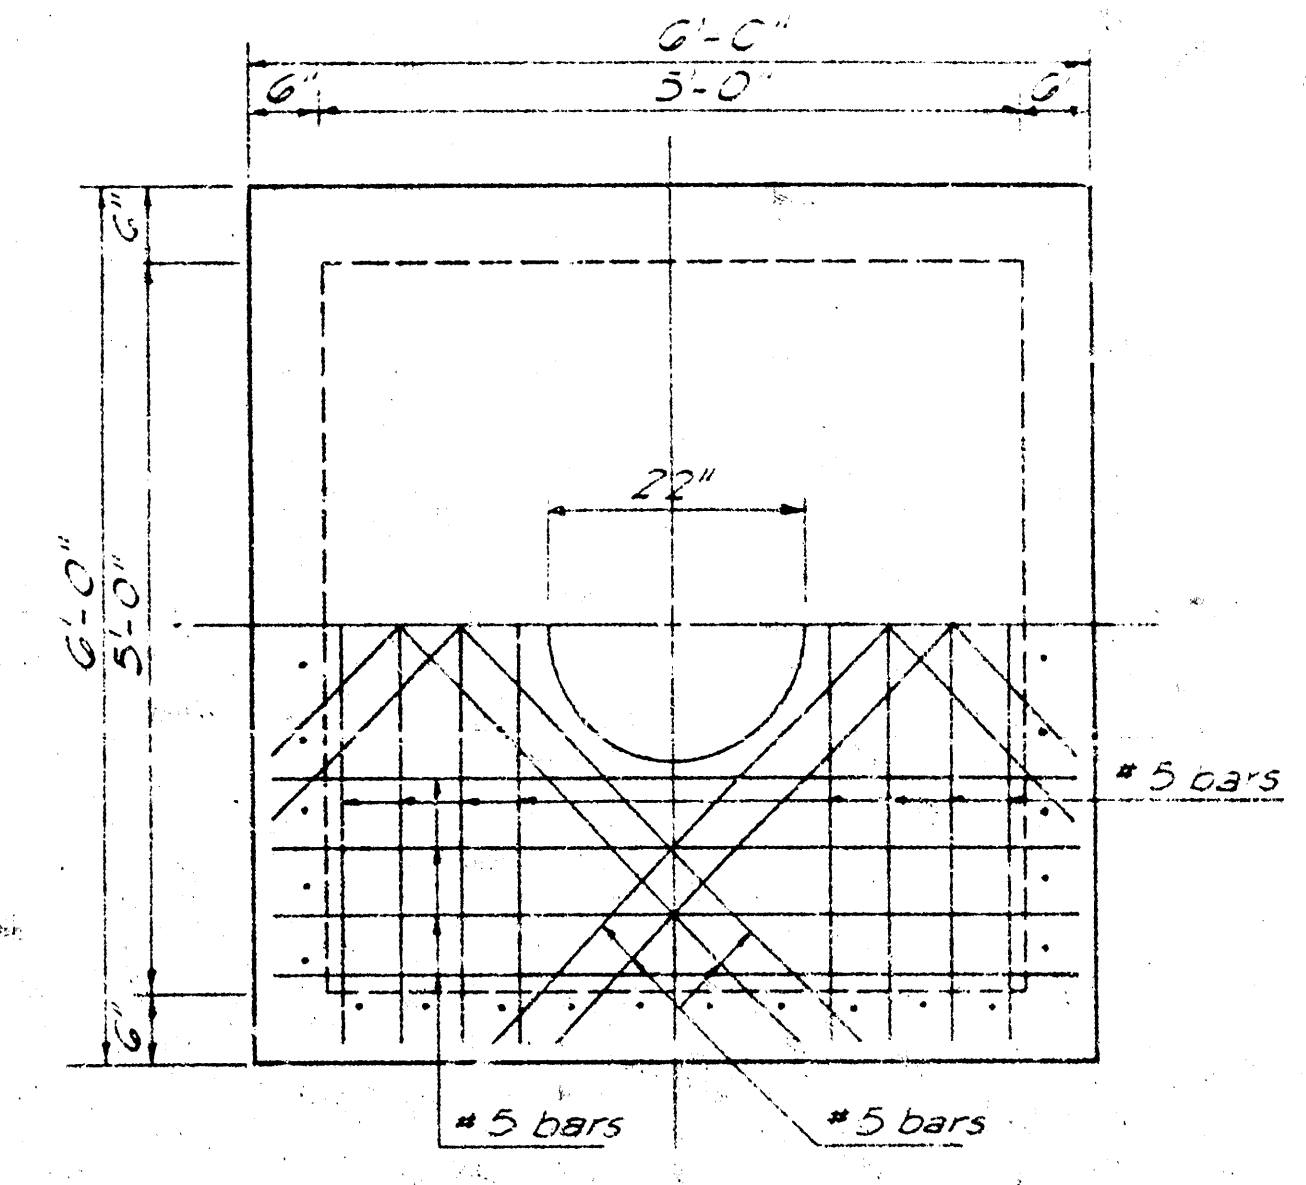


PLAN

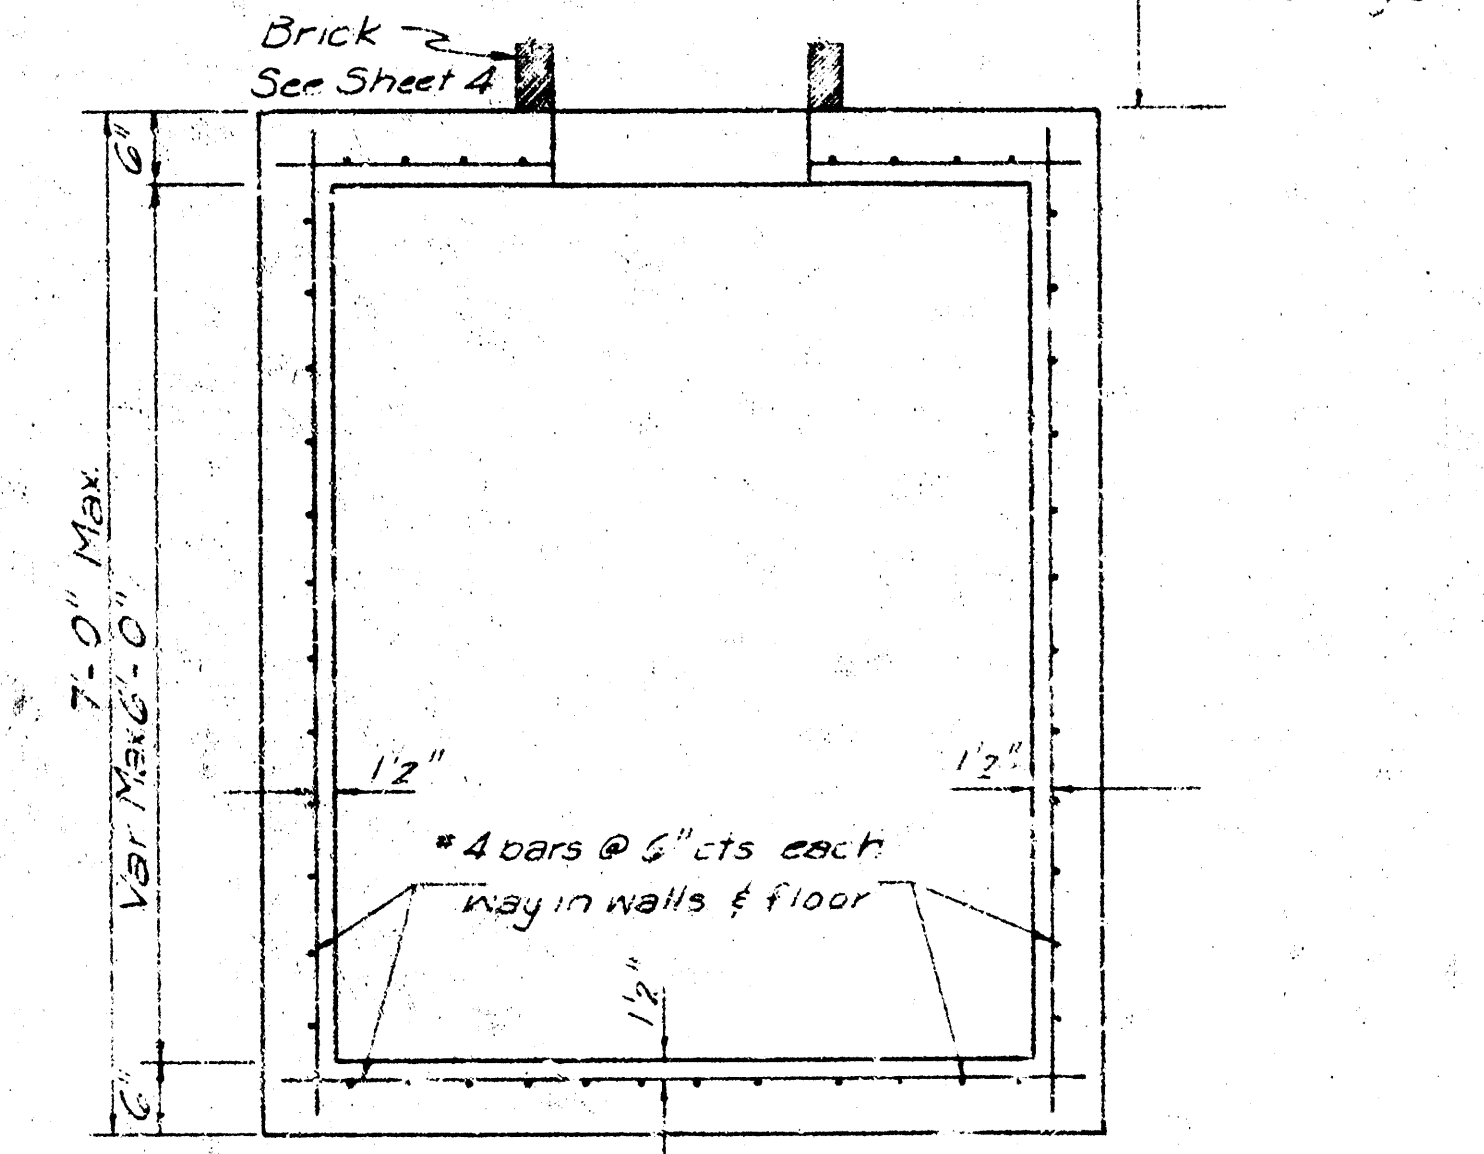


SECTION


5' CONCRETE MANHOLE

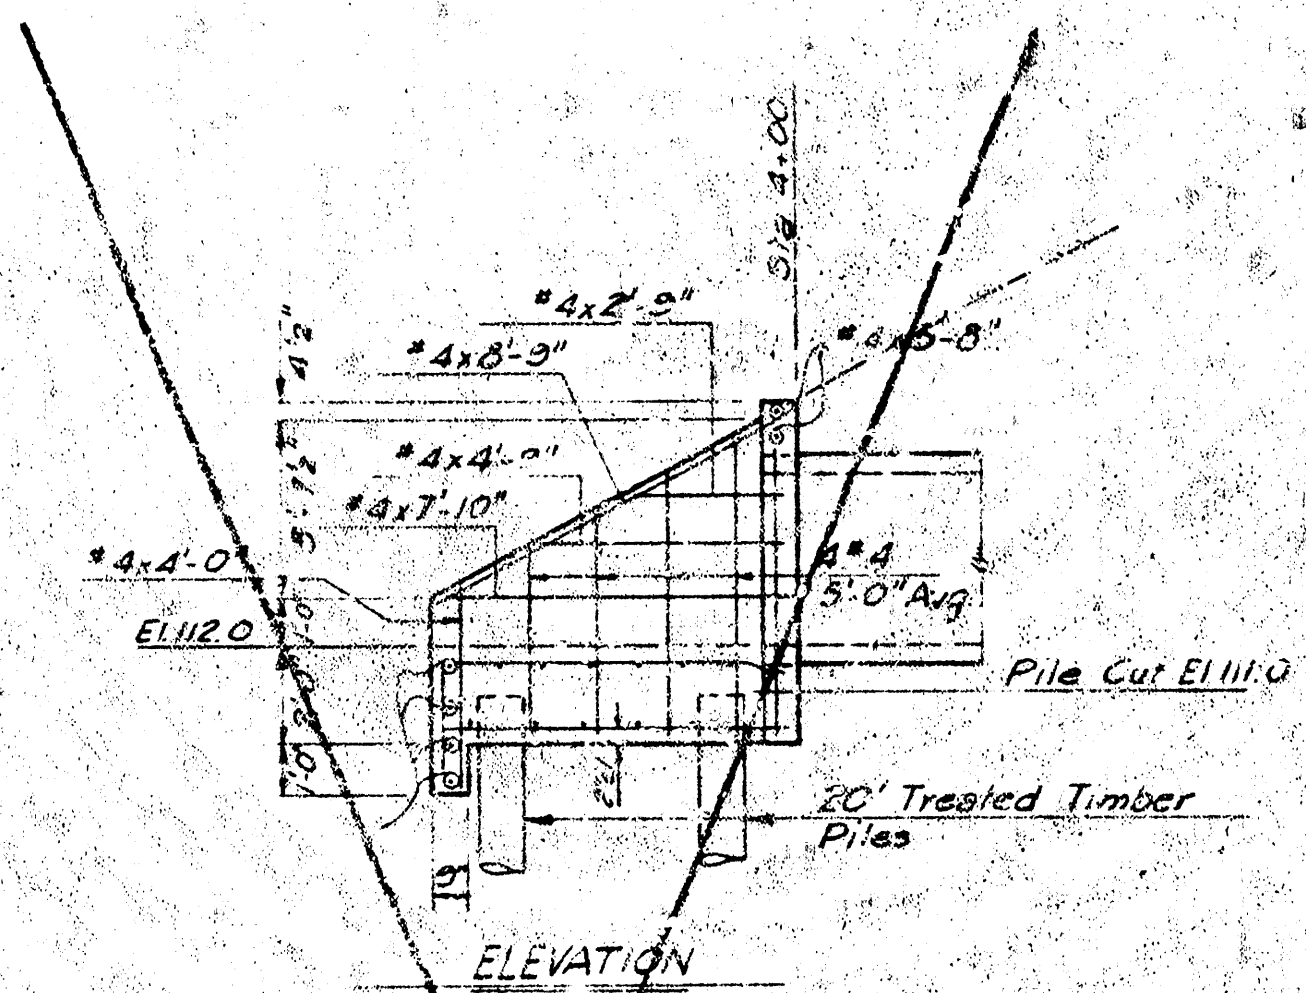

ELEVATION

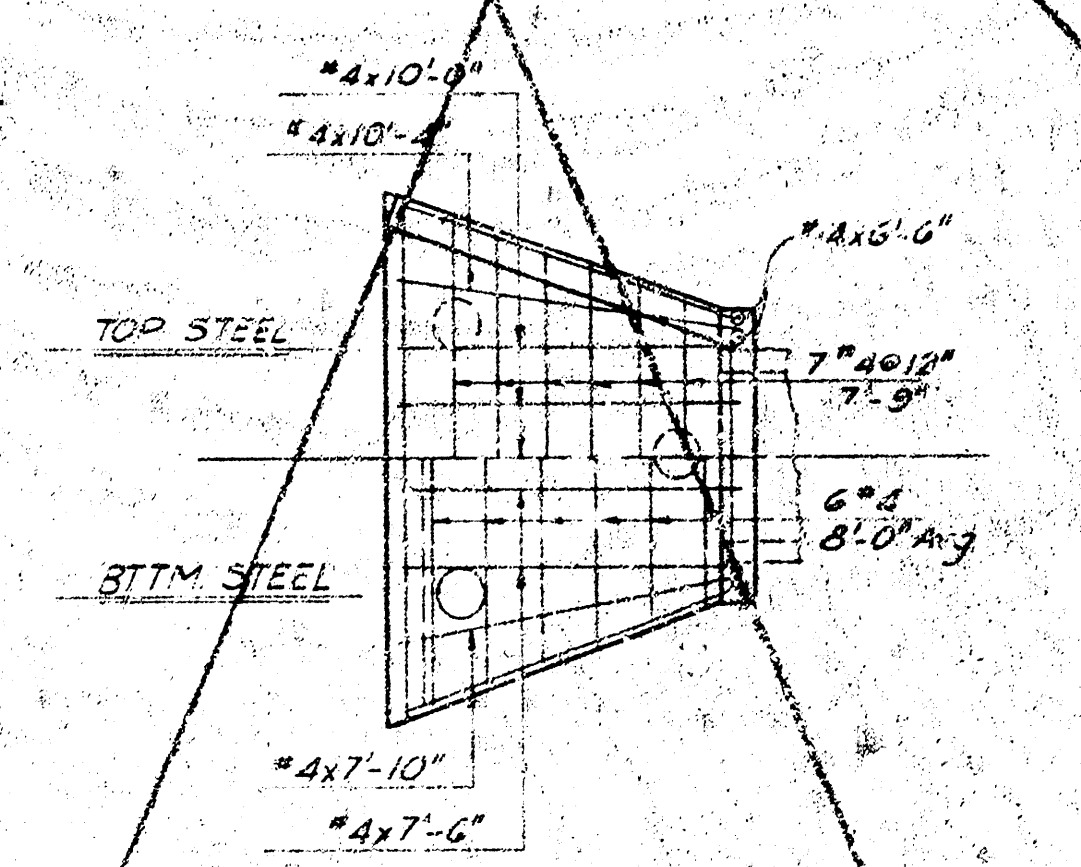

PLAN SHOWING REINFORCING

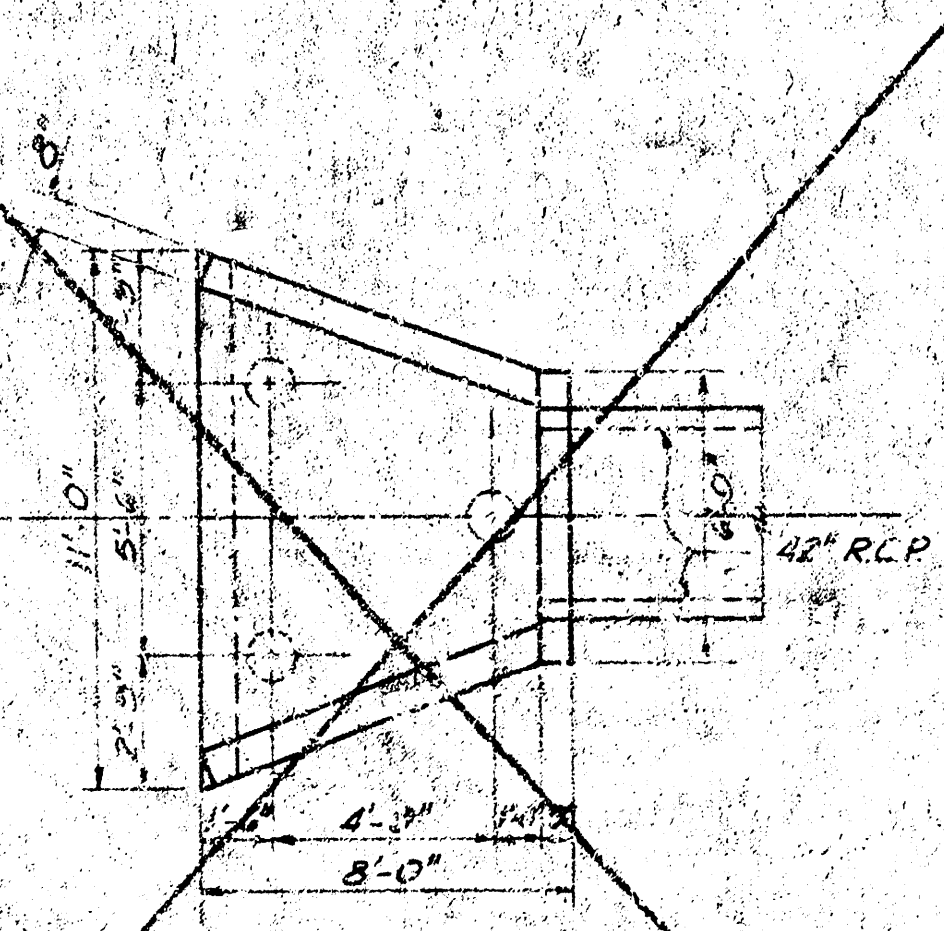

PLAN

NOTE: Chamfer all exposed edges with a 1/4" triangular molding.

K.H. 12/5/75 As Built	
DATE	3/14/72
BY	SALE
DESCRIPTION	
URBAN RENEWAL AGENCY	
KENNETH H. KITCHEN, EXECUTIVE DIRECTOR	
STREET IMPROVEMENTS	
EVERGREEN PARK	
AUXILIARY DETAILS	
R. S. DELAMATER	DATE February, 1971
CONSULTING ENGINEER	SCALE
WICHITA, KANSAS	DWG. NO. 260-8-14