


1. No traffic will be carried through the project .
2. Existing utilities and their locations, as shown on the plan, represent the best information obtainable for design. The Contractor shall contact the utilities for verification of locations prior to any excavation. The Contractor shall be required to work around any utilities within the right-of-way.
3. The City of Wichita's Sewer Maintenance Division has televised sewers within the limits of the project and has found no defects requiring repair. The Division shall be notified and afforded the opportunity to re-televise sewer lines after all grade work has been completed prior to pavement construction, to determine if such sewer lines have been damaged by the Contractor's operations. Damaged sewers will be repaired by the Contractor, as directed by the Engineer, at the Contractor's expense. Television logs are available for inspection by the Contractor during normal office hours at the Sewer Maintenance Division office at City Hall.
4. All work on this project shall be performed in accordance with the City of Wichita Standard Specifications for Concrete Pavement.
5. The Contractor shall give all property owners and/or tenants abutting the project a minimum of 48 hours notice prior to start of construction.



SLAB REINFORCEMENT DETAIL

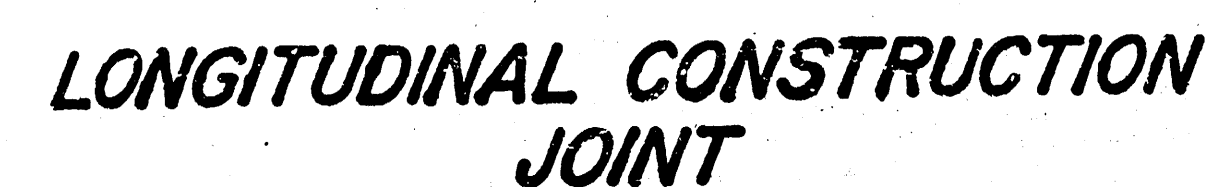


NOTE TO CONTRACTOR

[illegible]

APPROVED AS NOTED
By CITY ENGINEER OF WICHITA

Sanitary Sewers _____
Storm Sewers _____
Driveway Approaches _____
Water Mains _____

VRH 1/13/89

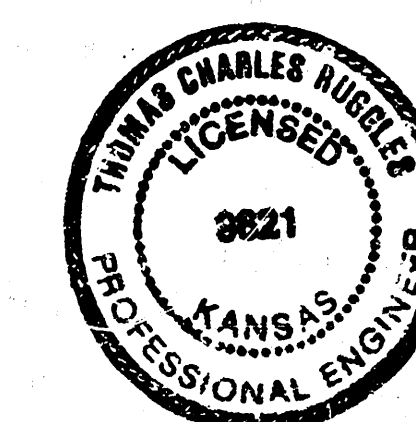

Rev. as built 4-7-89 TCR
Rev. parking lot removal / repl. 1-16-89

Rev. parking lot removal/rep. 1-10-05

**ALLEY N. OF CENTRAL
FROM 126' W. OF HYDRAULIC TO W.L. HYDR.
PROJ. NO. 472-76-245-80001-000-000-049
INDEX NO.**

INDEX NO. 1 BAUGHMAN COMPANY P. A. SURVEYING & ENGINEERING 316/262-7271 • 315 ELLIS • WICHITA, KANSAS 67211				
DESIGN <i>TH</i>	DRAWN <i>TH</i>	APPROVED	DATE 1-12-89	SCALE 1" = 20'

BENCH MARK:
"D" on S.W. cor. of walk section in
drive @ sta. 1+70.5, 28.0' Lt. of C.
Elev. 112.84

3A 34

FILMED FROM THE BEST
AVAILABLE COPY