

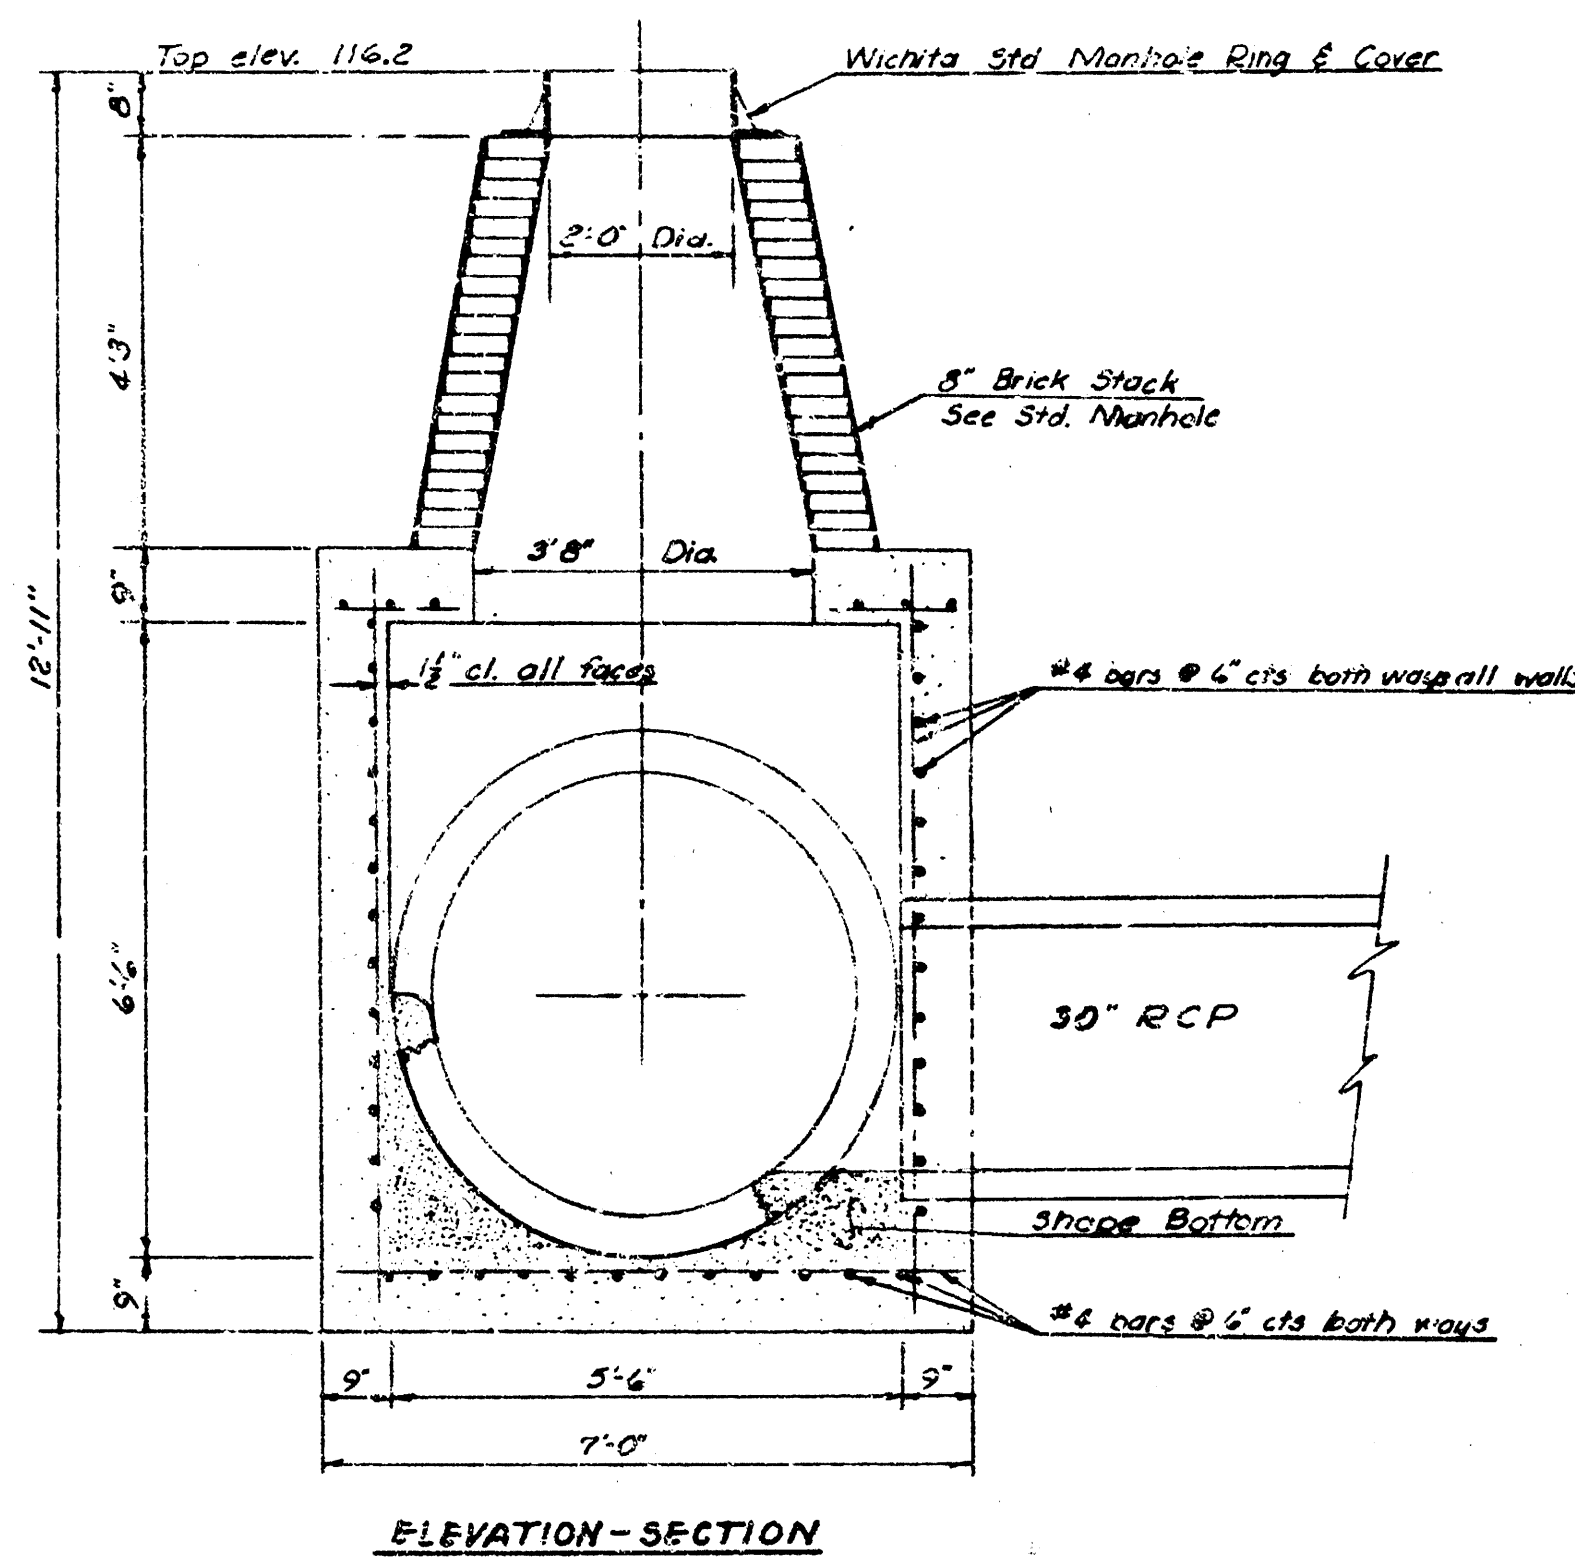
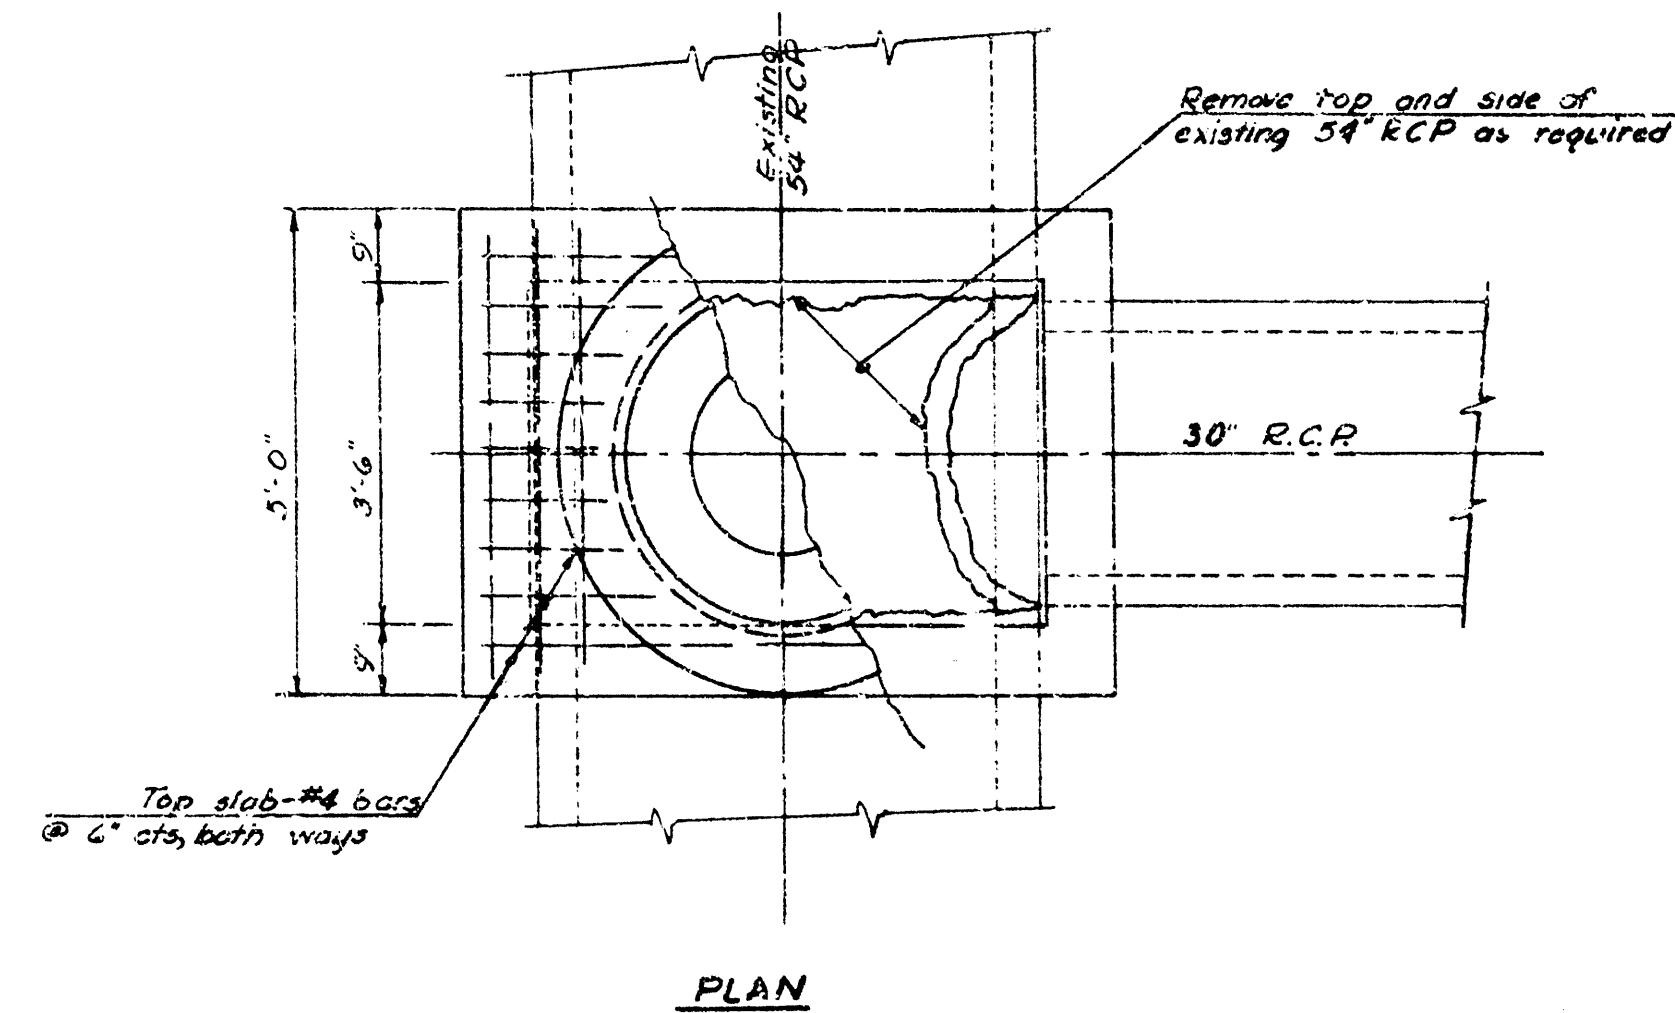


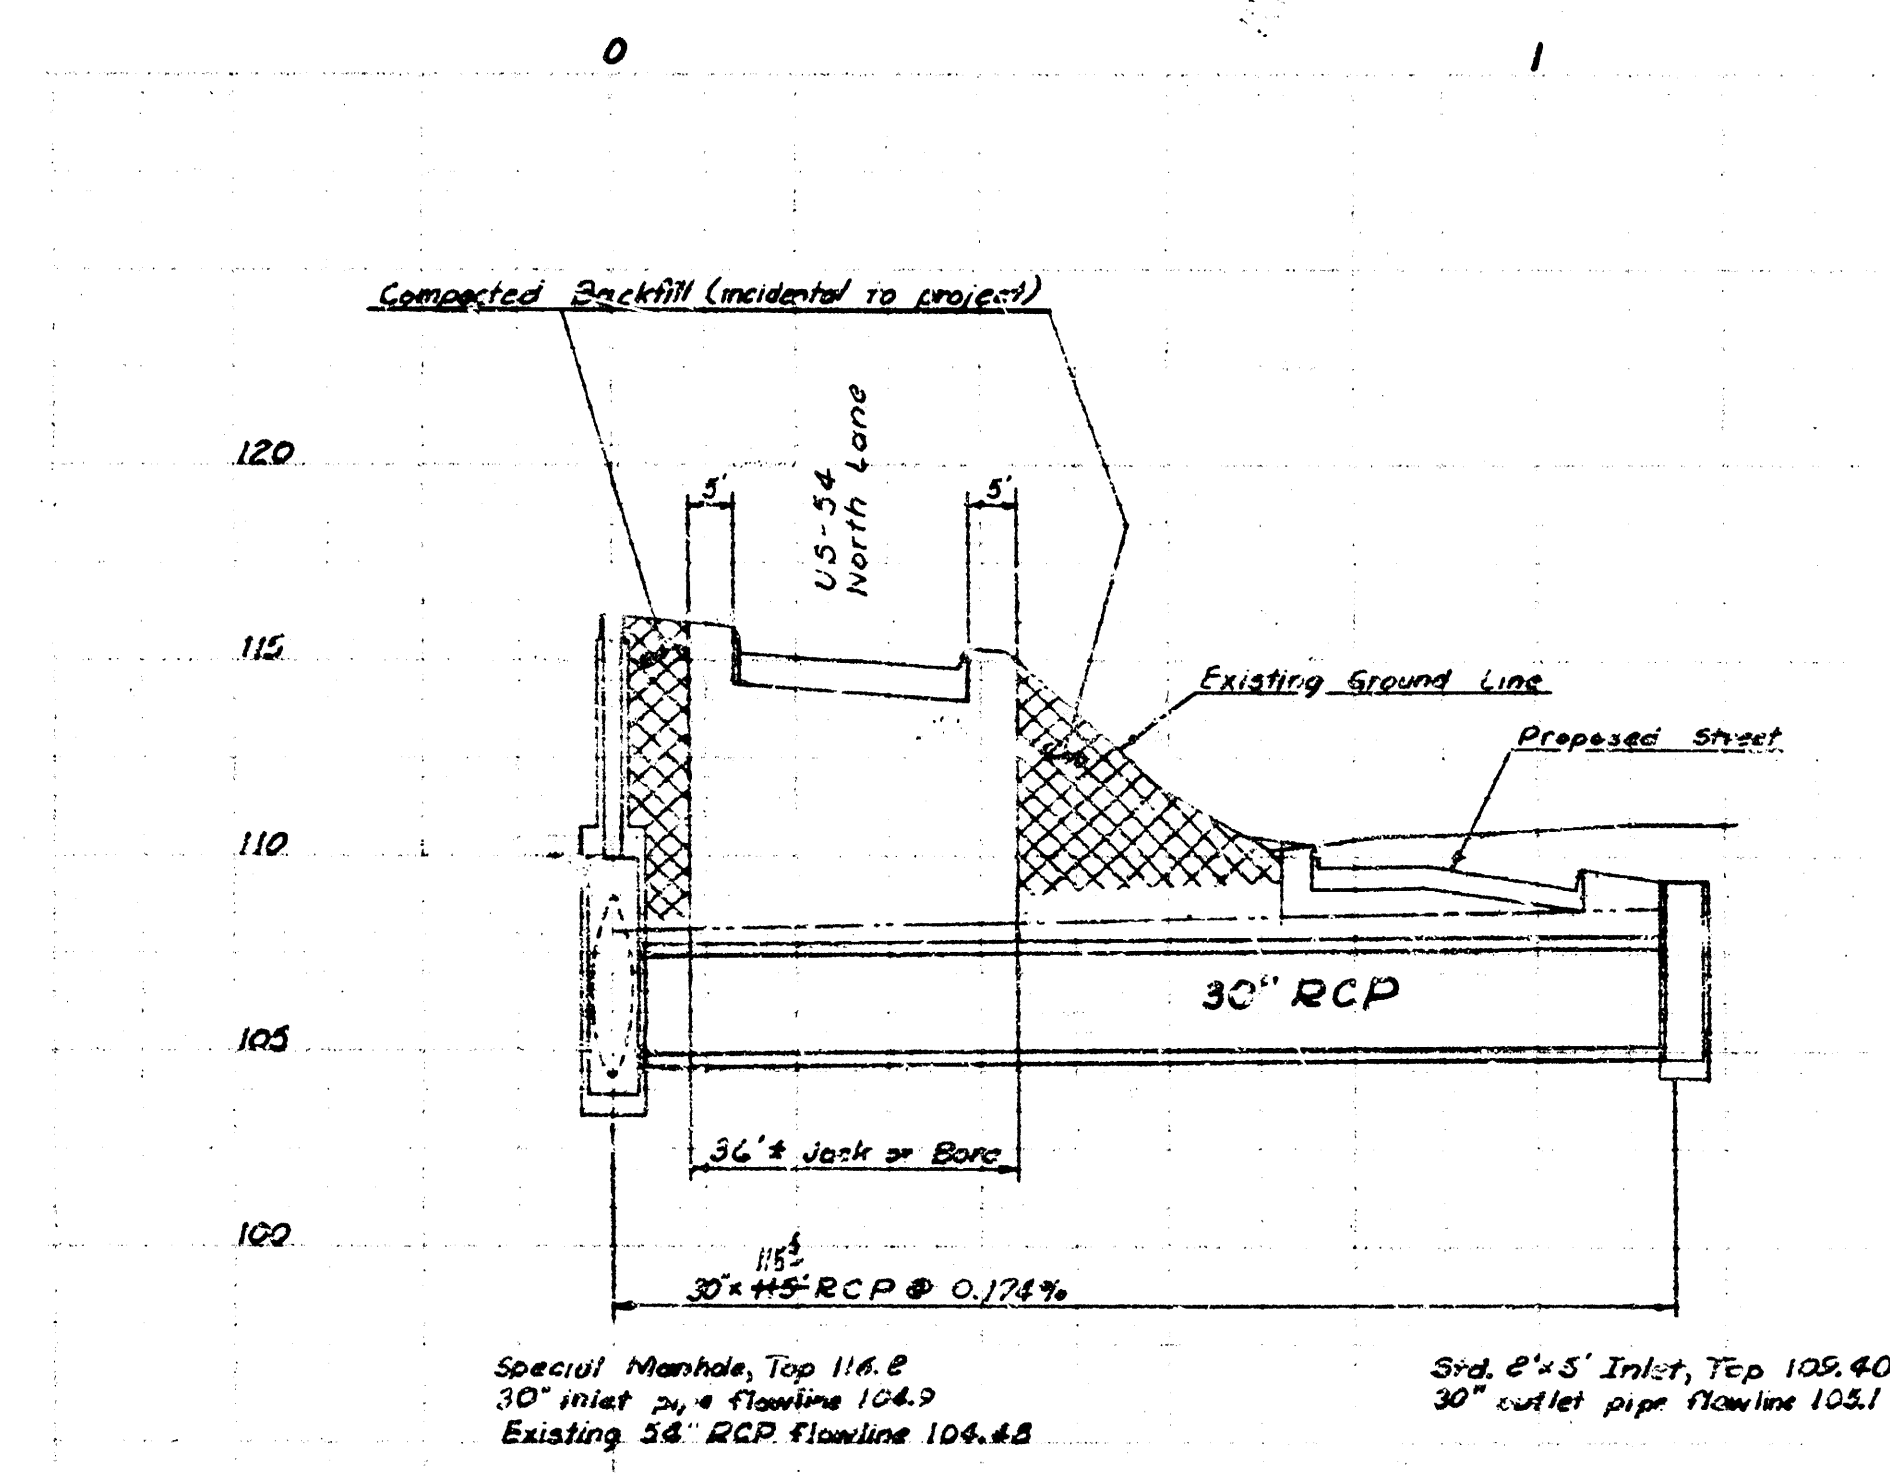

SPECIAL MANHOLE DETAIL
Scale: 1/4"=1'-0"

NOTE:
Jack or Bore Pipe to be Class II reinforced concrete pipe with joints so formed that when the pipes are laid together, the outside shell will make a continuous and uniform line. Maximum length of pipe to be 8' with reinforcement in both tongue and groove portion of joint. Gasket shall be installed between sections to be pushed. One 2" grout nipple shall be installed per section of pipe. After pipe is in place, all interior joint voids to be filled and made smooth, and voids on outside of pipe to be filled by pumping grout through 2" nipples.

Bid Price for Pipe includes all material and work (jacking, etc.) required for pipe in place.

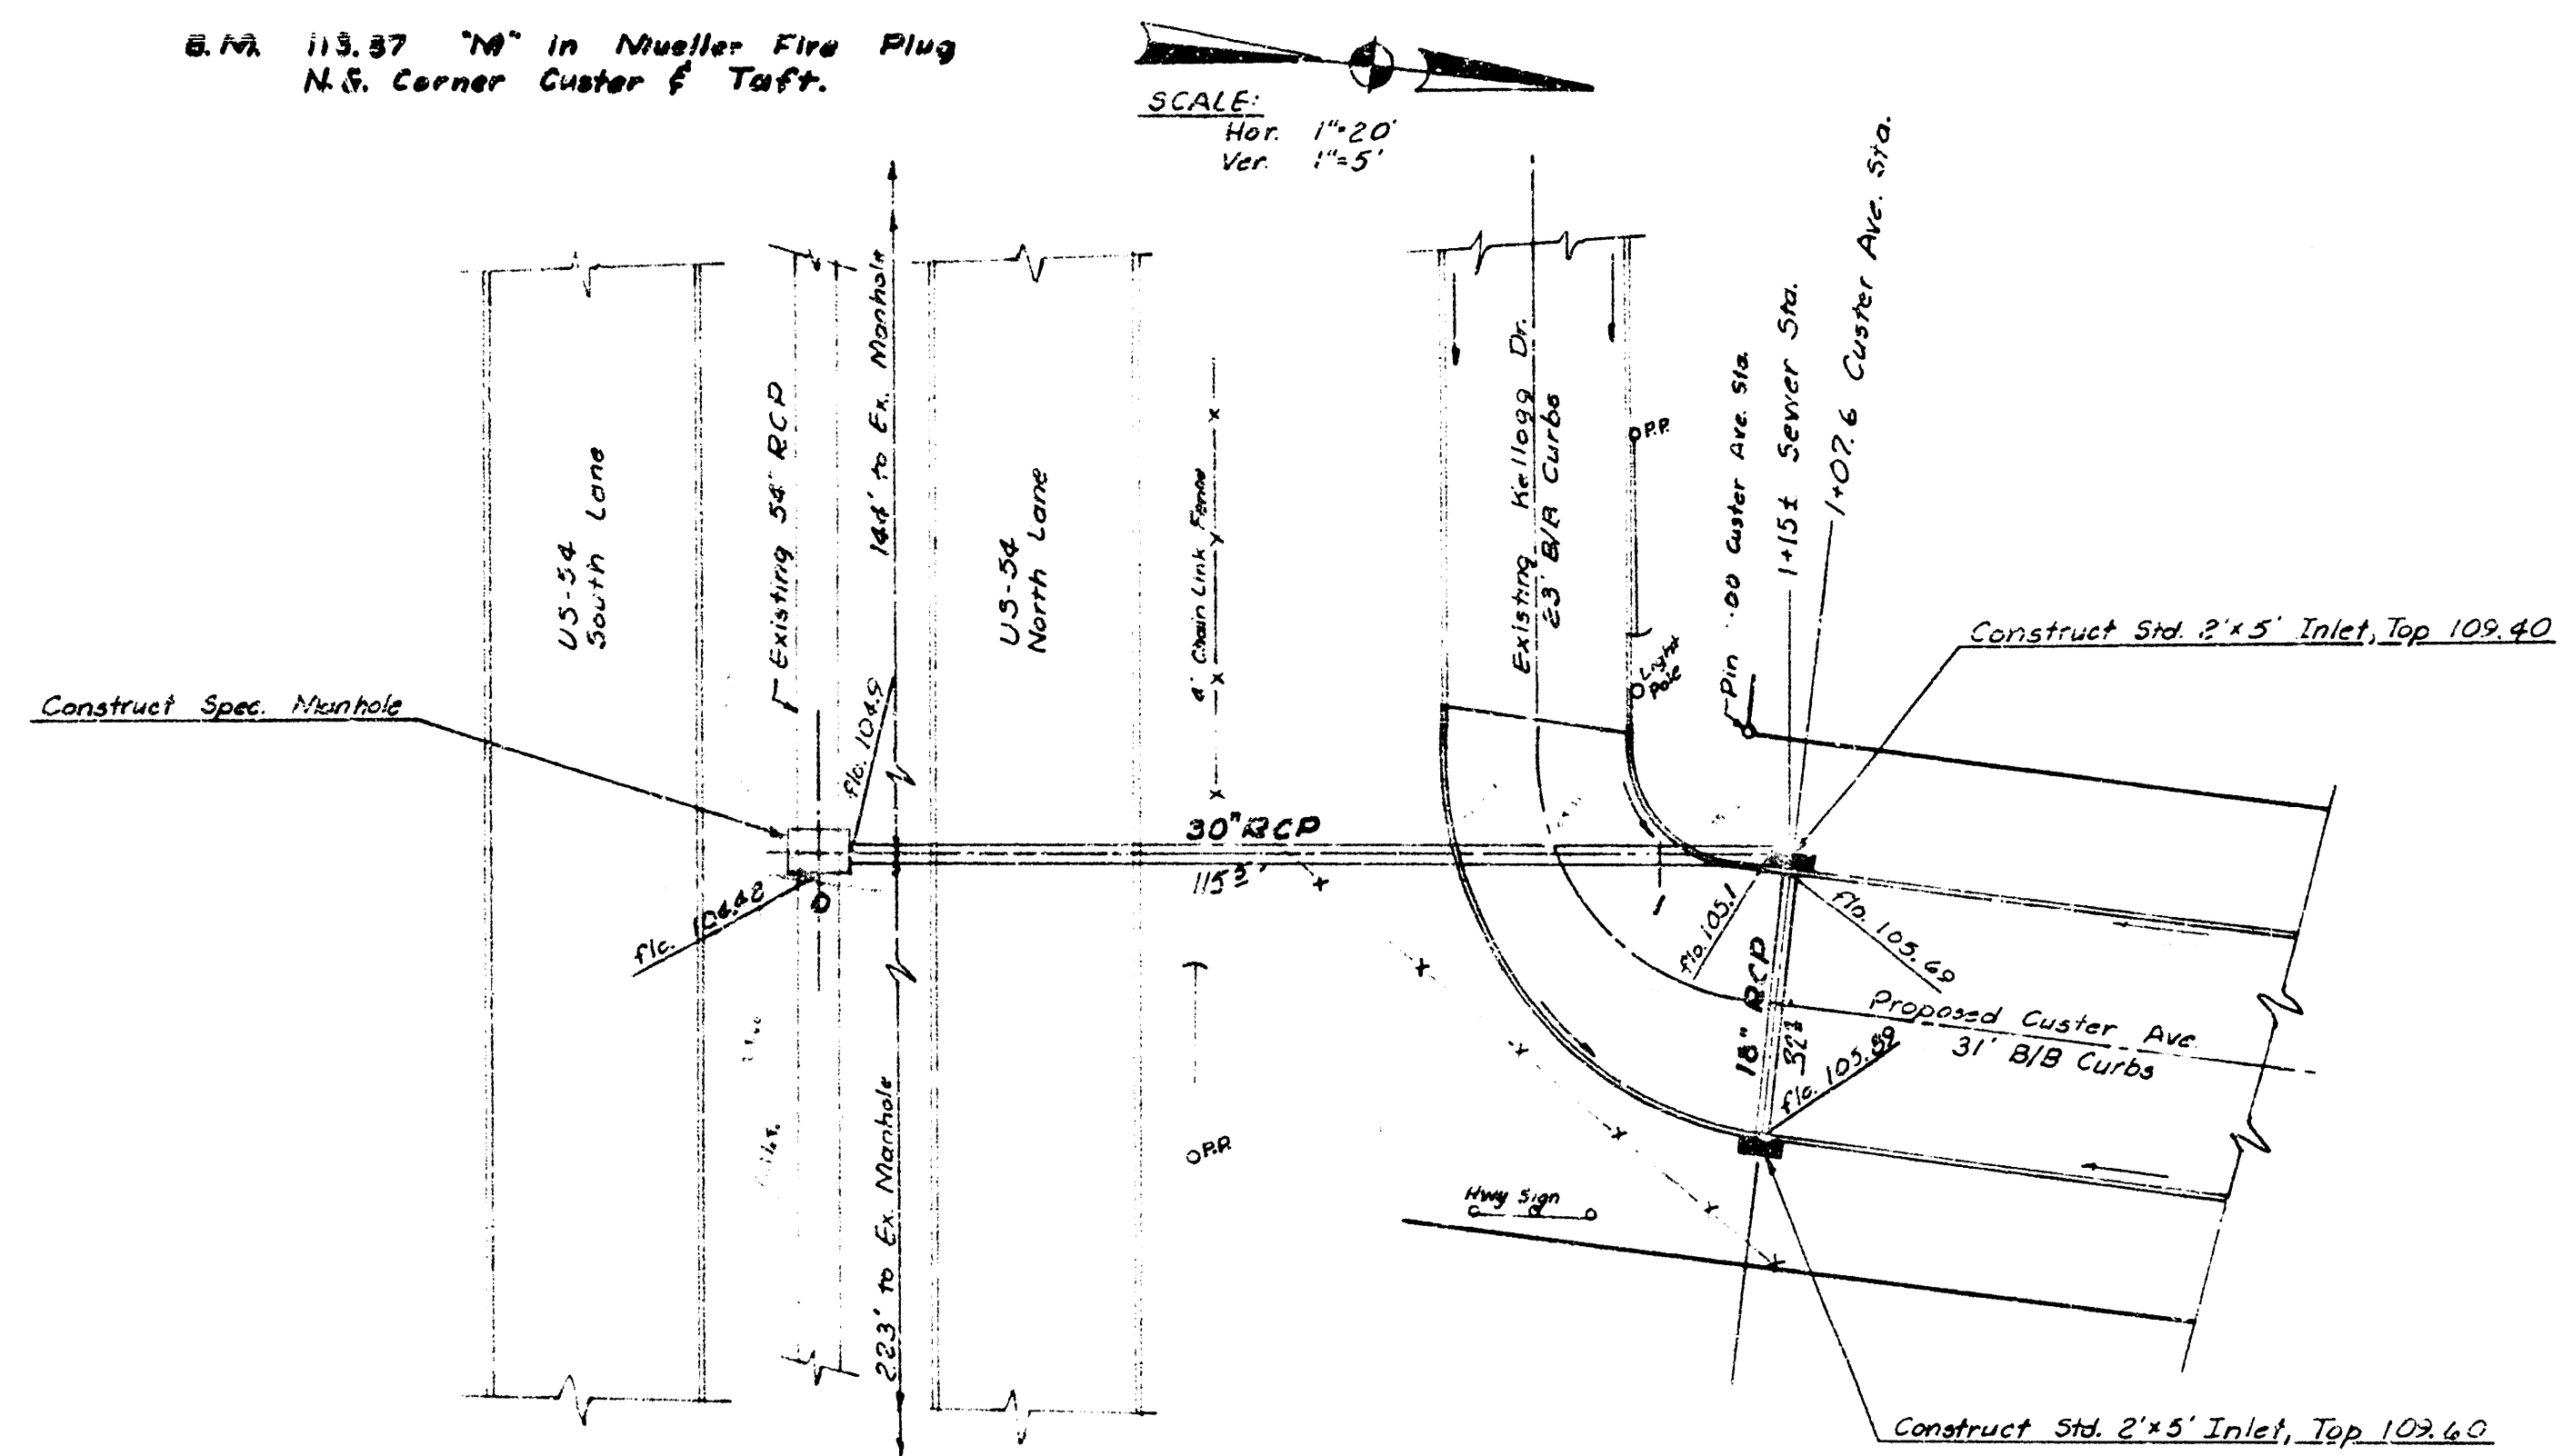

AS BUILT FROM FINAL MEASUREMENTS IN S.W.S. #1 LK
DRAINAGE IN CONNECTION WITH CUSTER AVE
PAVING FROM KELLOGG DR. TO TAFT ST.
R. W. LINN, CITY ENGINEER
CITY OF WICHITA, KANSAS
DATE MAY 1972

PROJECT NO. DAKD 371034

SHEET 1 OF 1

3M 113.87" IN MUELLER FIRM PLUS
NE CORNER CUSTER & TAFT

