
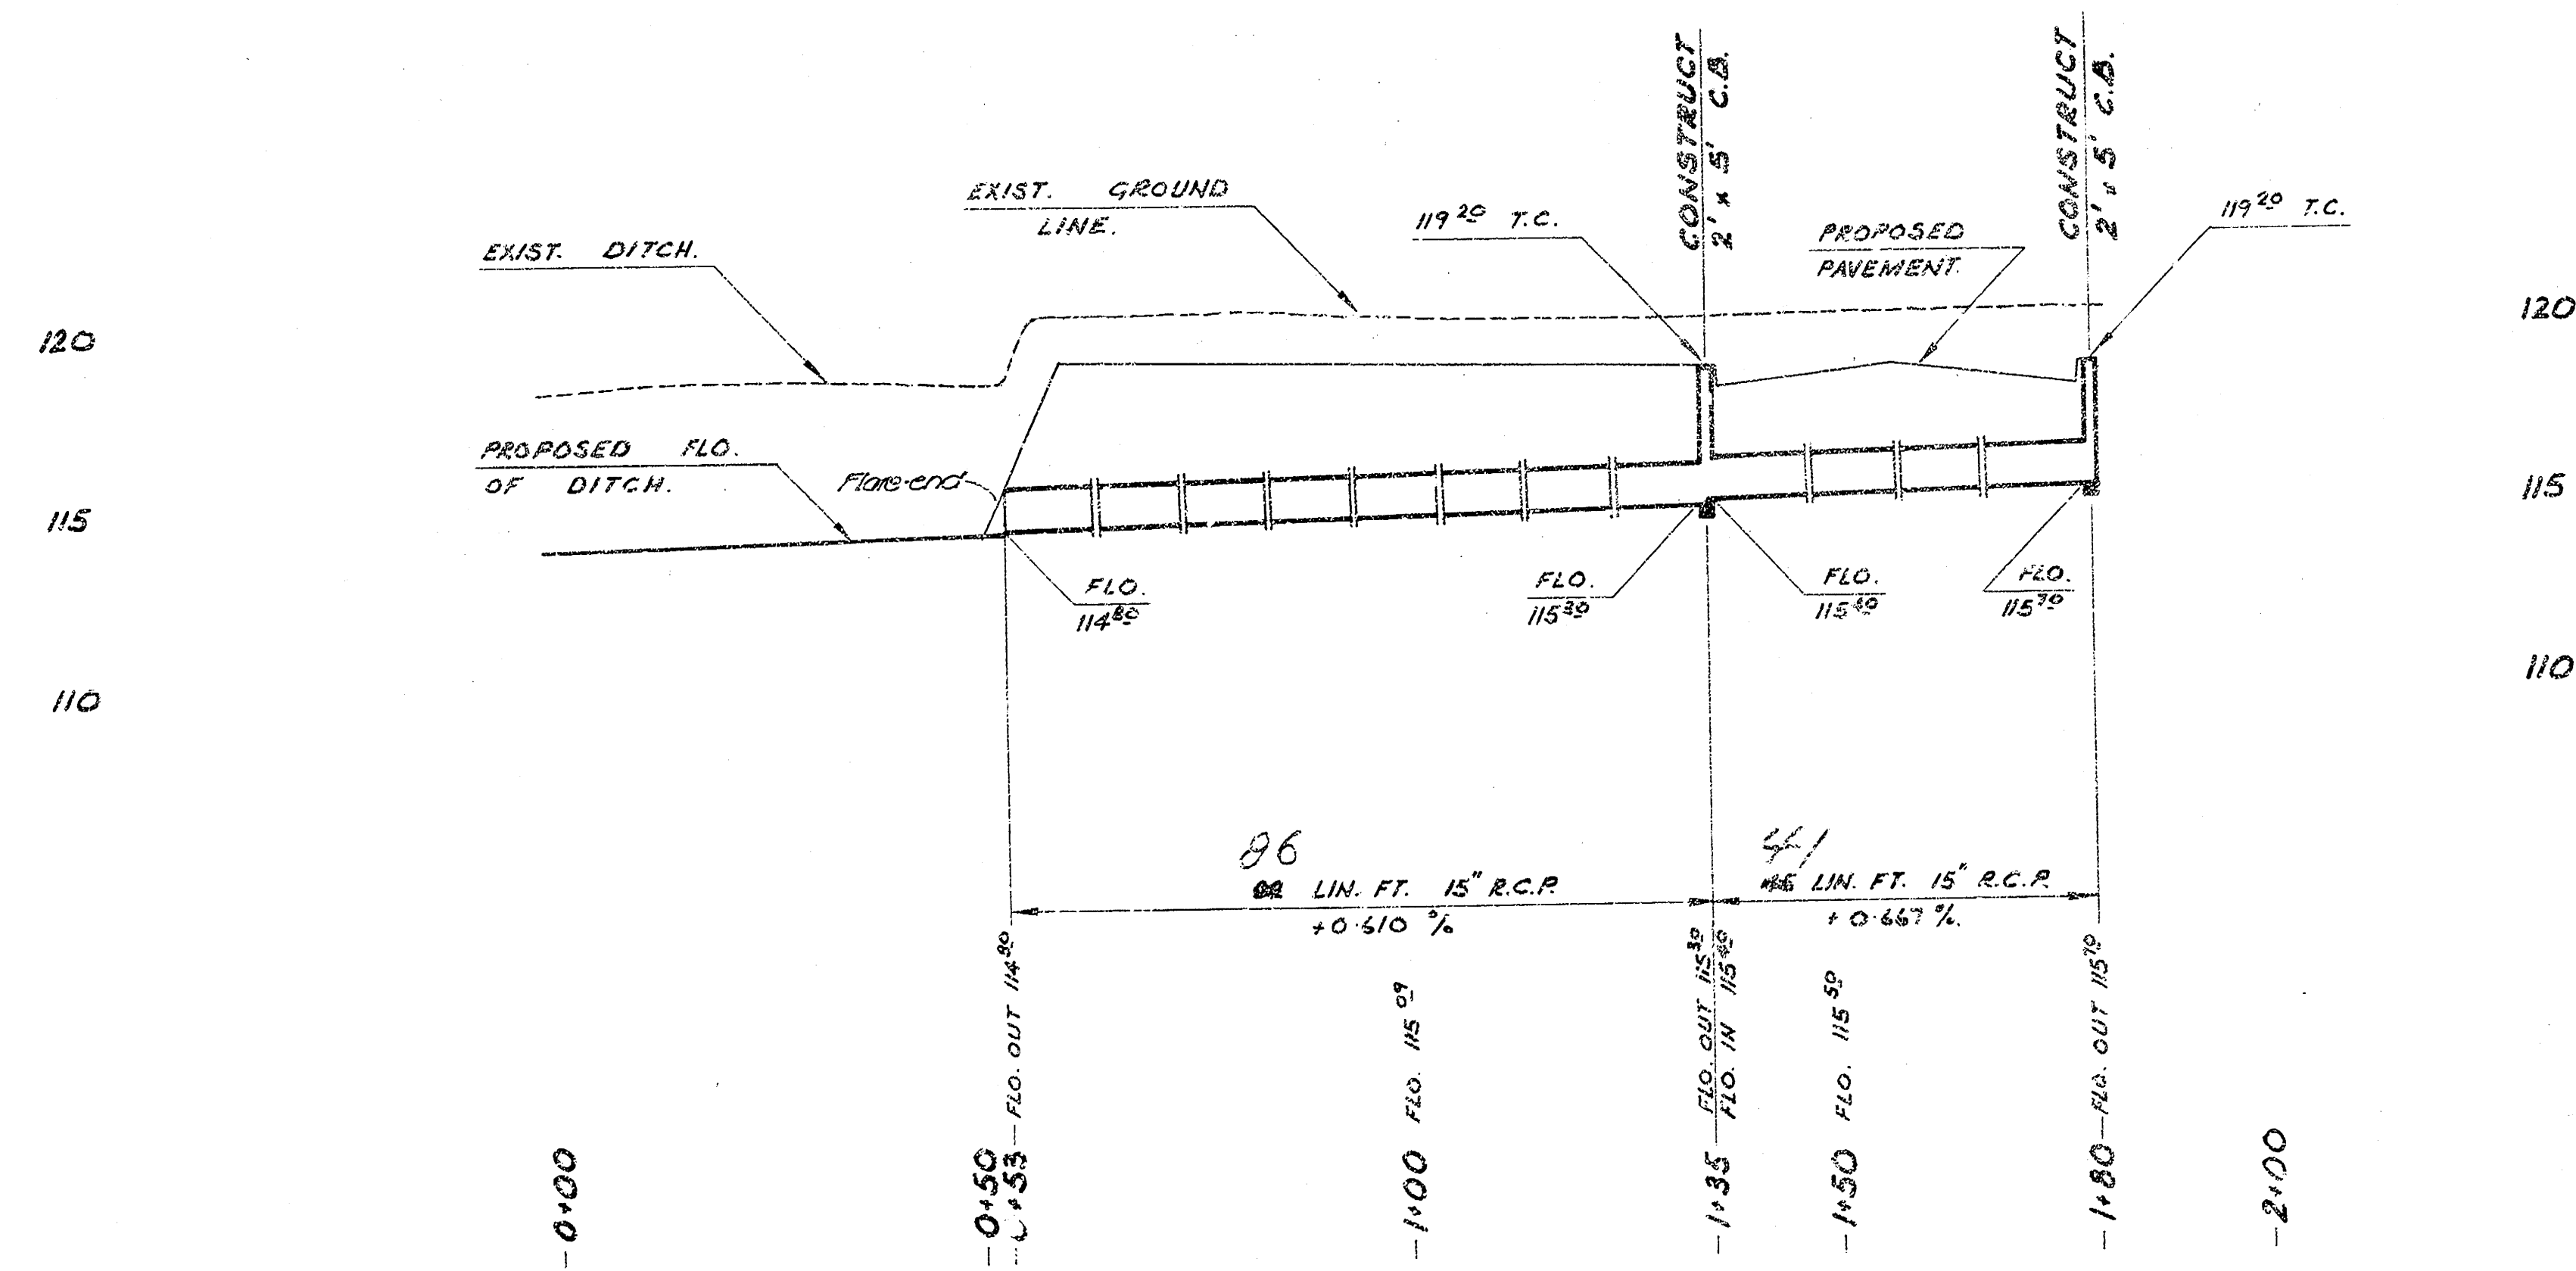


SCALES.
PLAN. 1" = 20'
PROFILE 1" = 20'
HORIZ. 1" = 20'
VERT. 1" = 5'

B.M. 120.60 - R.R. SPIKE EAST
FACE POWER POLE S.W.
COR. DUGAN & IRVING.

D.L. KRUG,
CITY ENGINEER

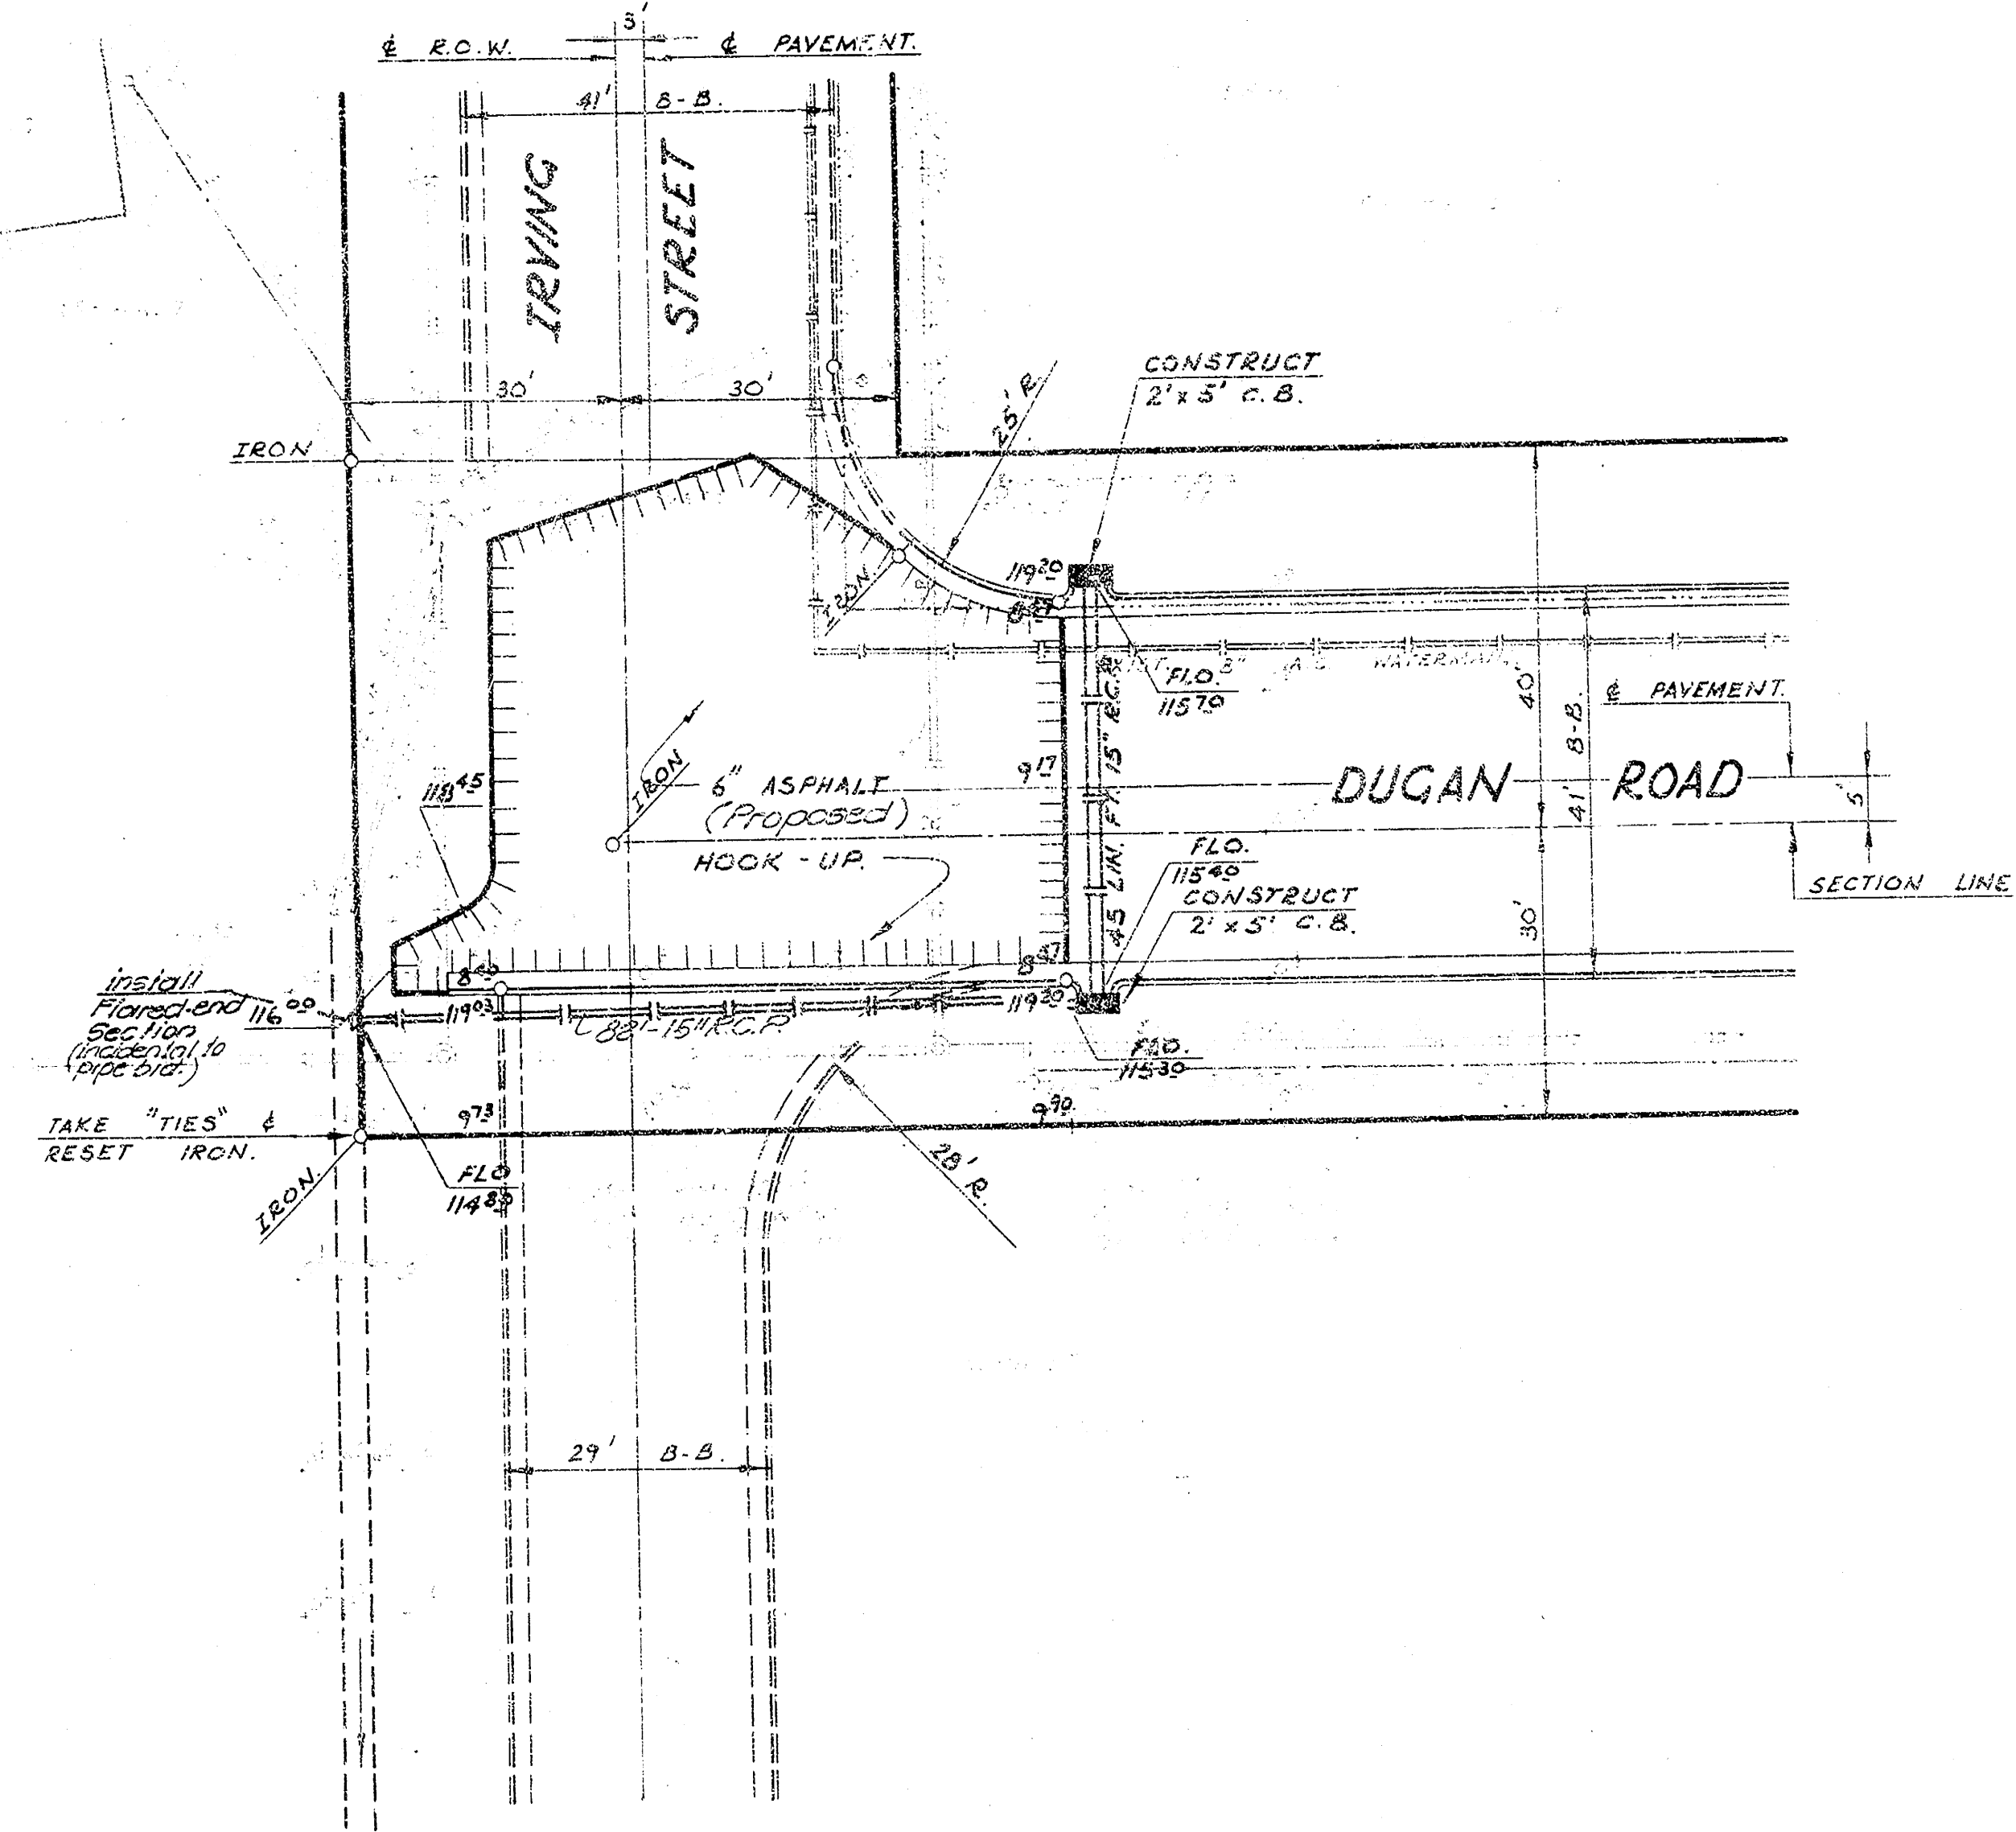


As Built 4-8-76

"DRAINAGE" IN CONNECTION WITH PAVING OF
DUGAN RD. FROM S.L. IRVING TO S.L. KELLOGG.
CITY OF WICHITA, KANSAS.
R. W. LINN. CITY ENGINEER.
DATE. PROJ. NO. DAKO 574131.


PLAN
 D.L. KRUG,
 J. BUTTERFIELD & SONS
 NOTE BOOK NO. 146

B.M. = 120.60 - R.R. SPIKE EAST
 FACE POWER POLE S.W.
 COR. DUGAN & IRVING.

SCALES.
 PLAN 1" = 20'
 PROFILE 1" = 20'
 HORIZ. 1" = 20'
 VERT. 1" = 5'

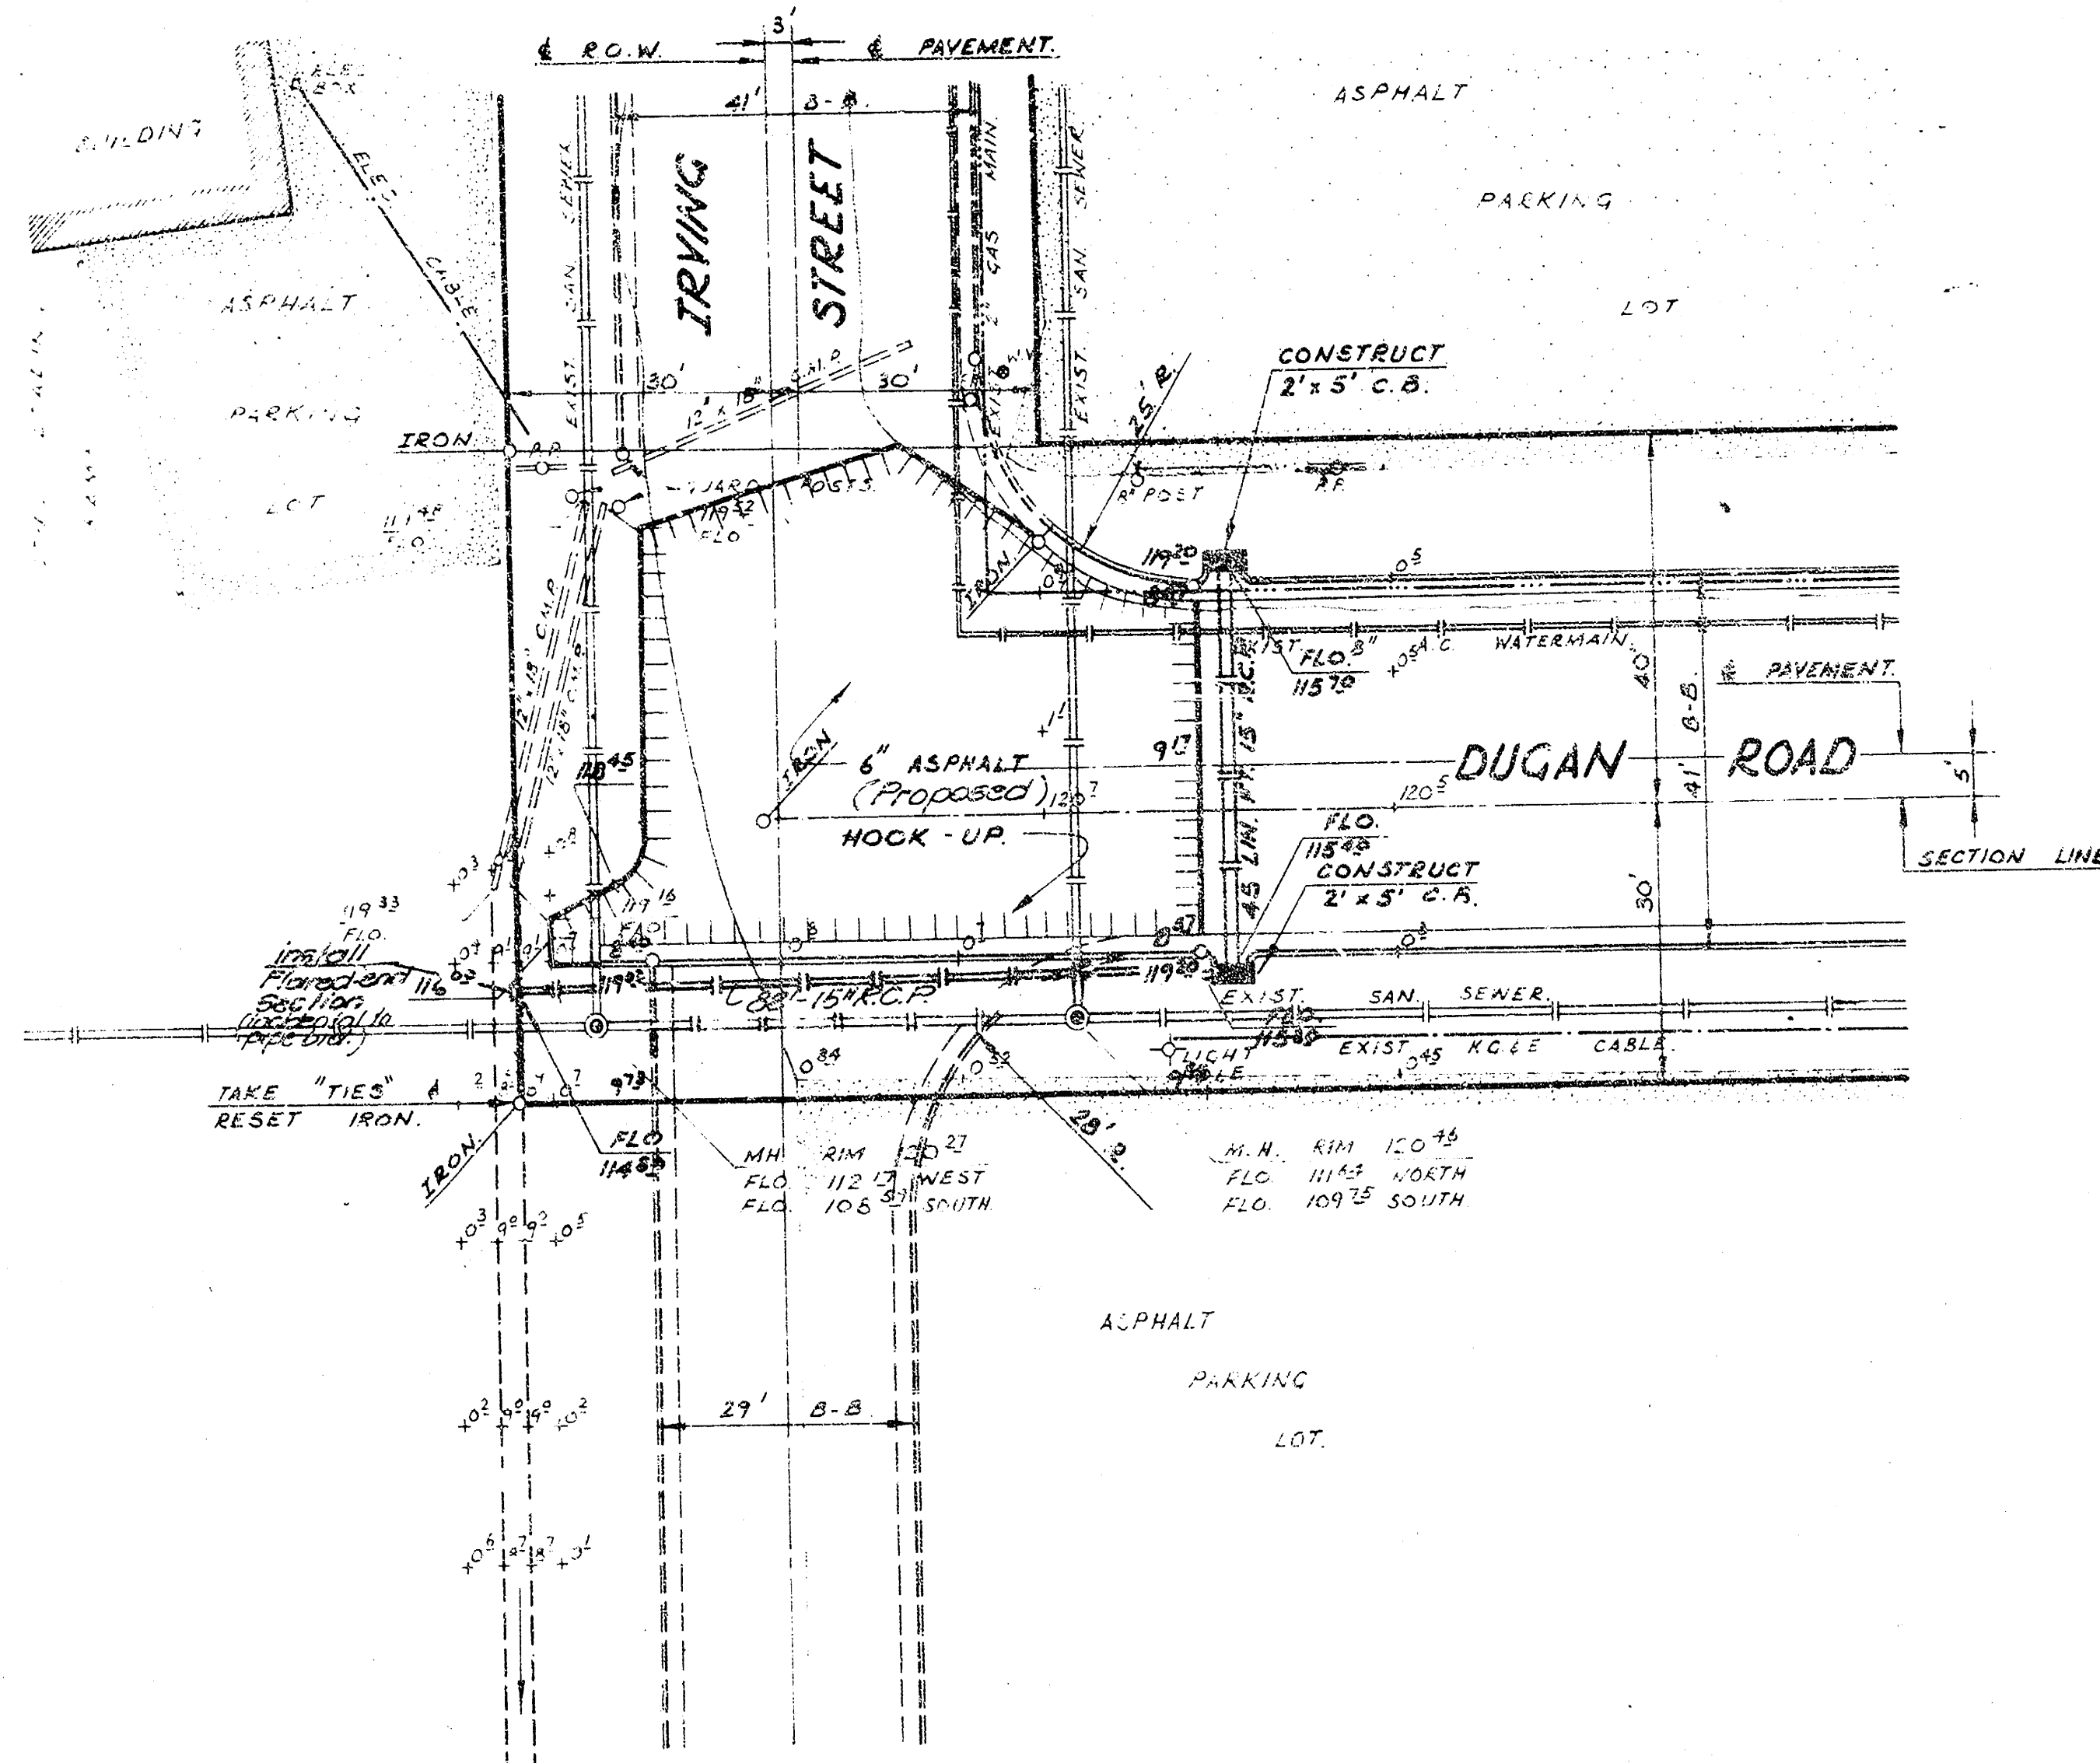

PROFILE
 D.L. KRUG,
 J. BUTTERFIELD & SONS
 NOTE BOOK NO. 146

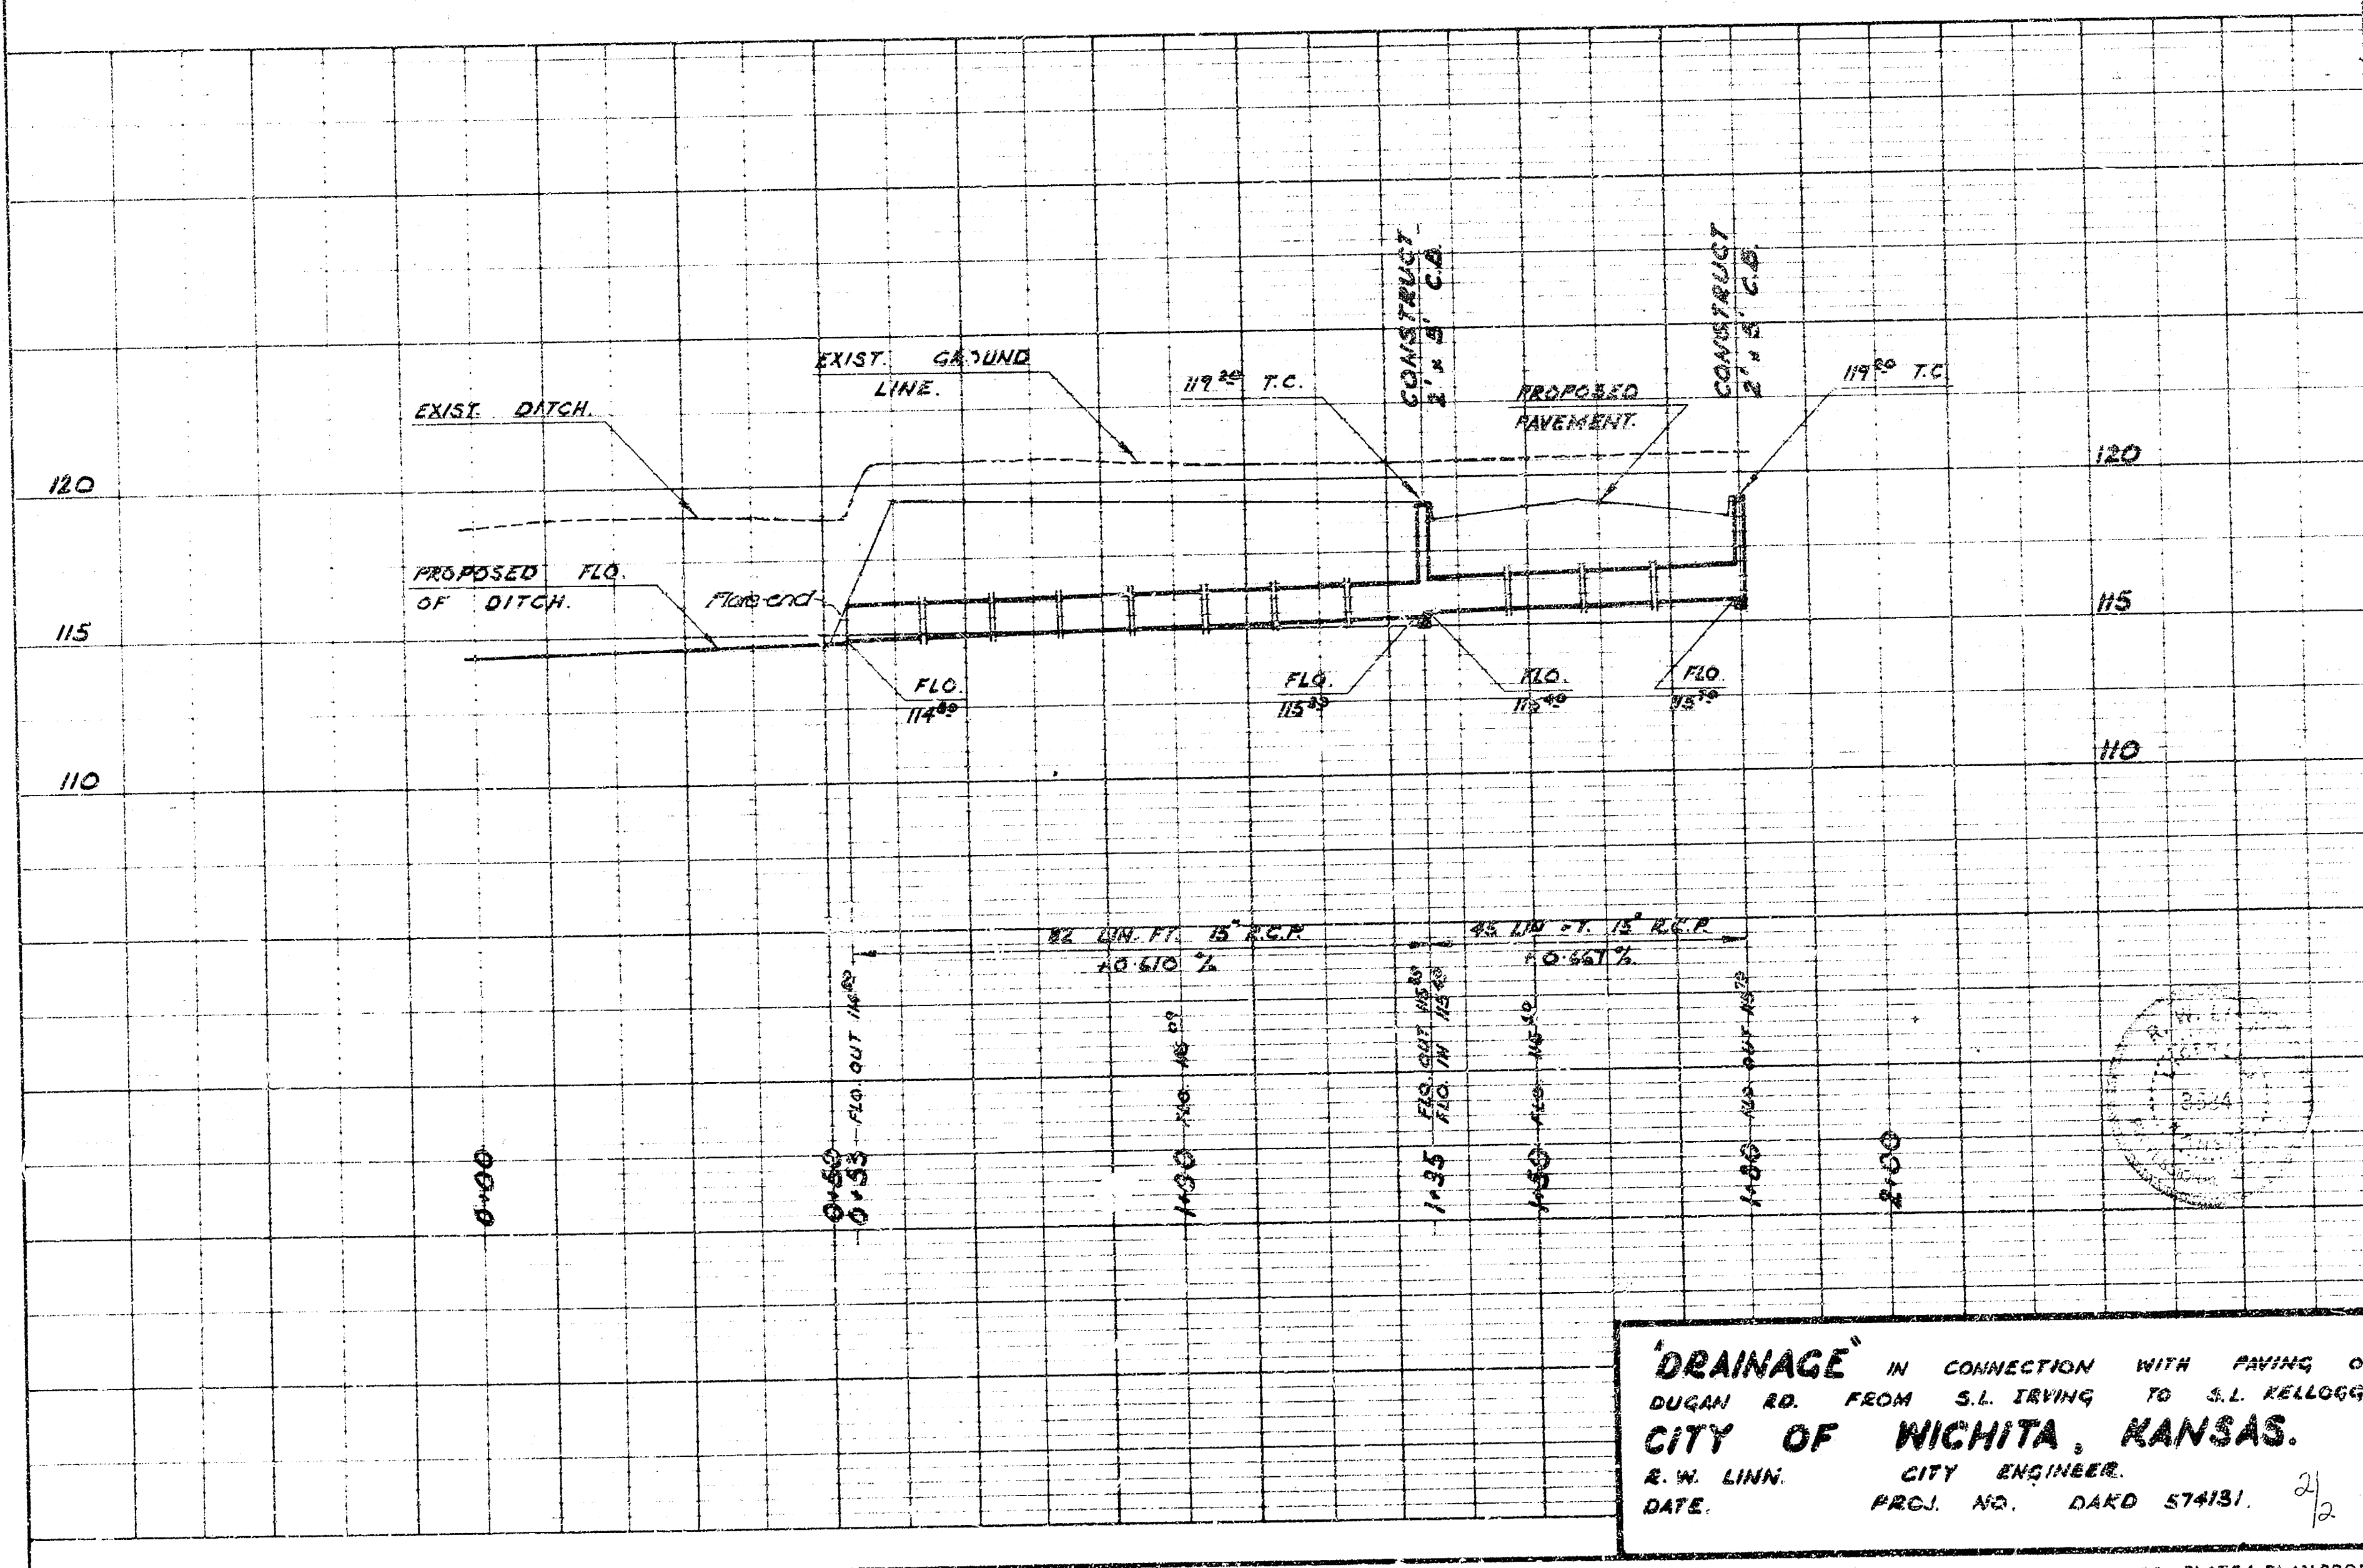

'DRAINAGE' IN CONNECTION WITH PAVING OF
 DUGAN RD. FROM S.L. IRVING TO S.L. KELLOGG.
CITY OF WICHITA, KANSAS.
 R.W. LINN. CITY ENGINEER.
 DATE. PROJ. NO. DAOD 574131.