


HI-2

NOTE: STATIONING ON C. ASH  
B.M. S.F. COR. CONC. PORCH HOS. N.E. COR. ASH & RULE


Note: Point moved 5' East

# EXCAVATION

| CITY  | PROD.  |
|-------|--------|
| 191.5 | 1365.6 |
| 192   | 36.4   |
| 210.7 | 502.2  |

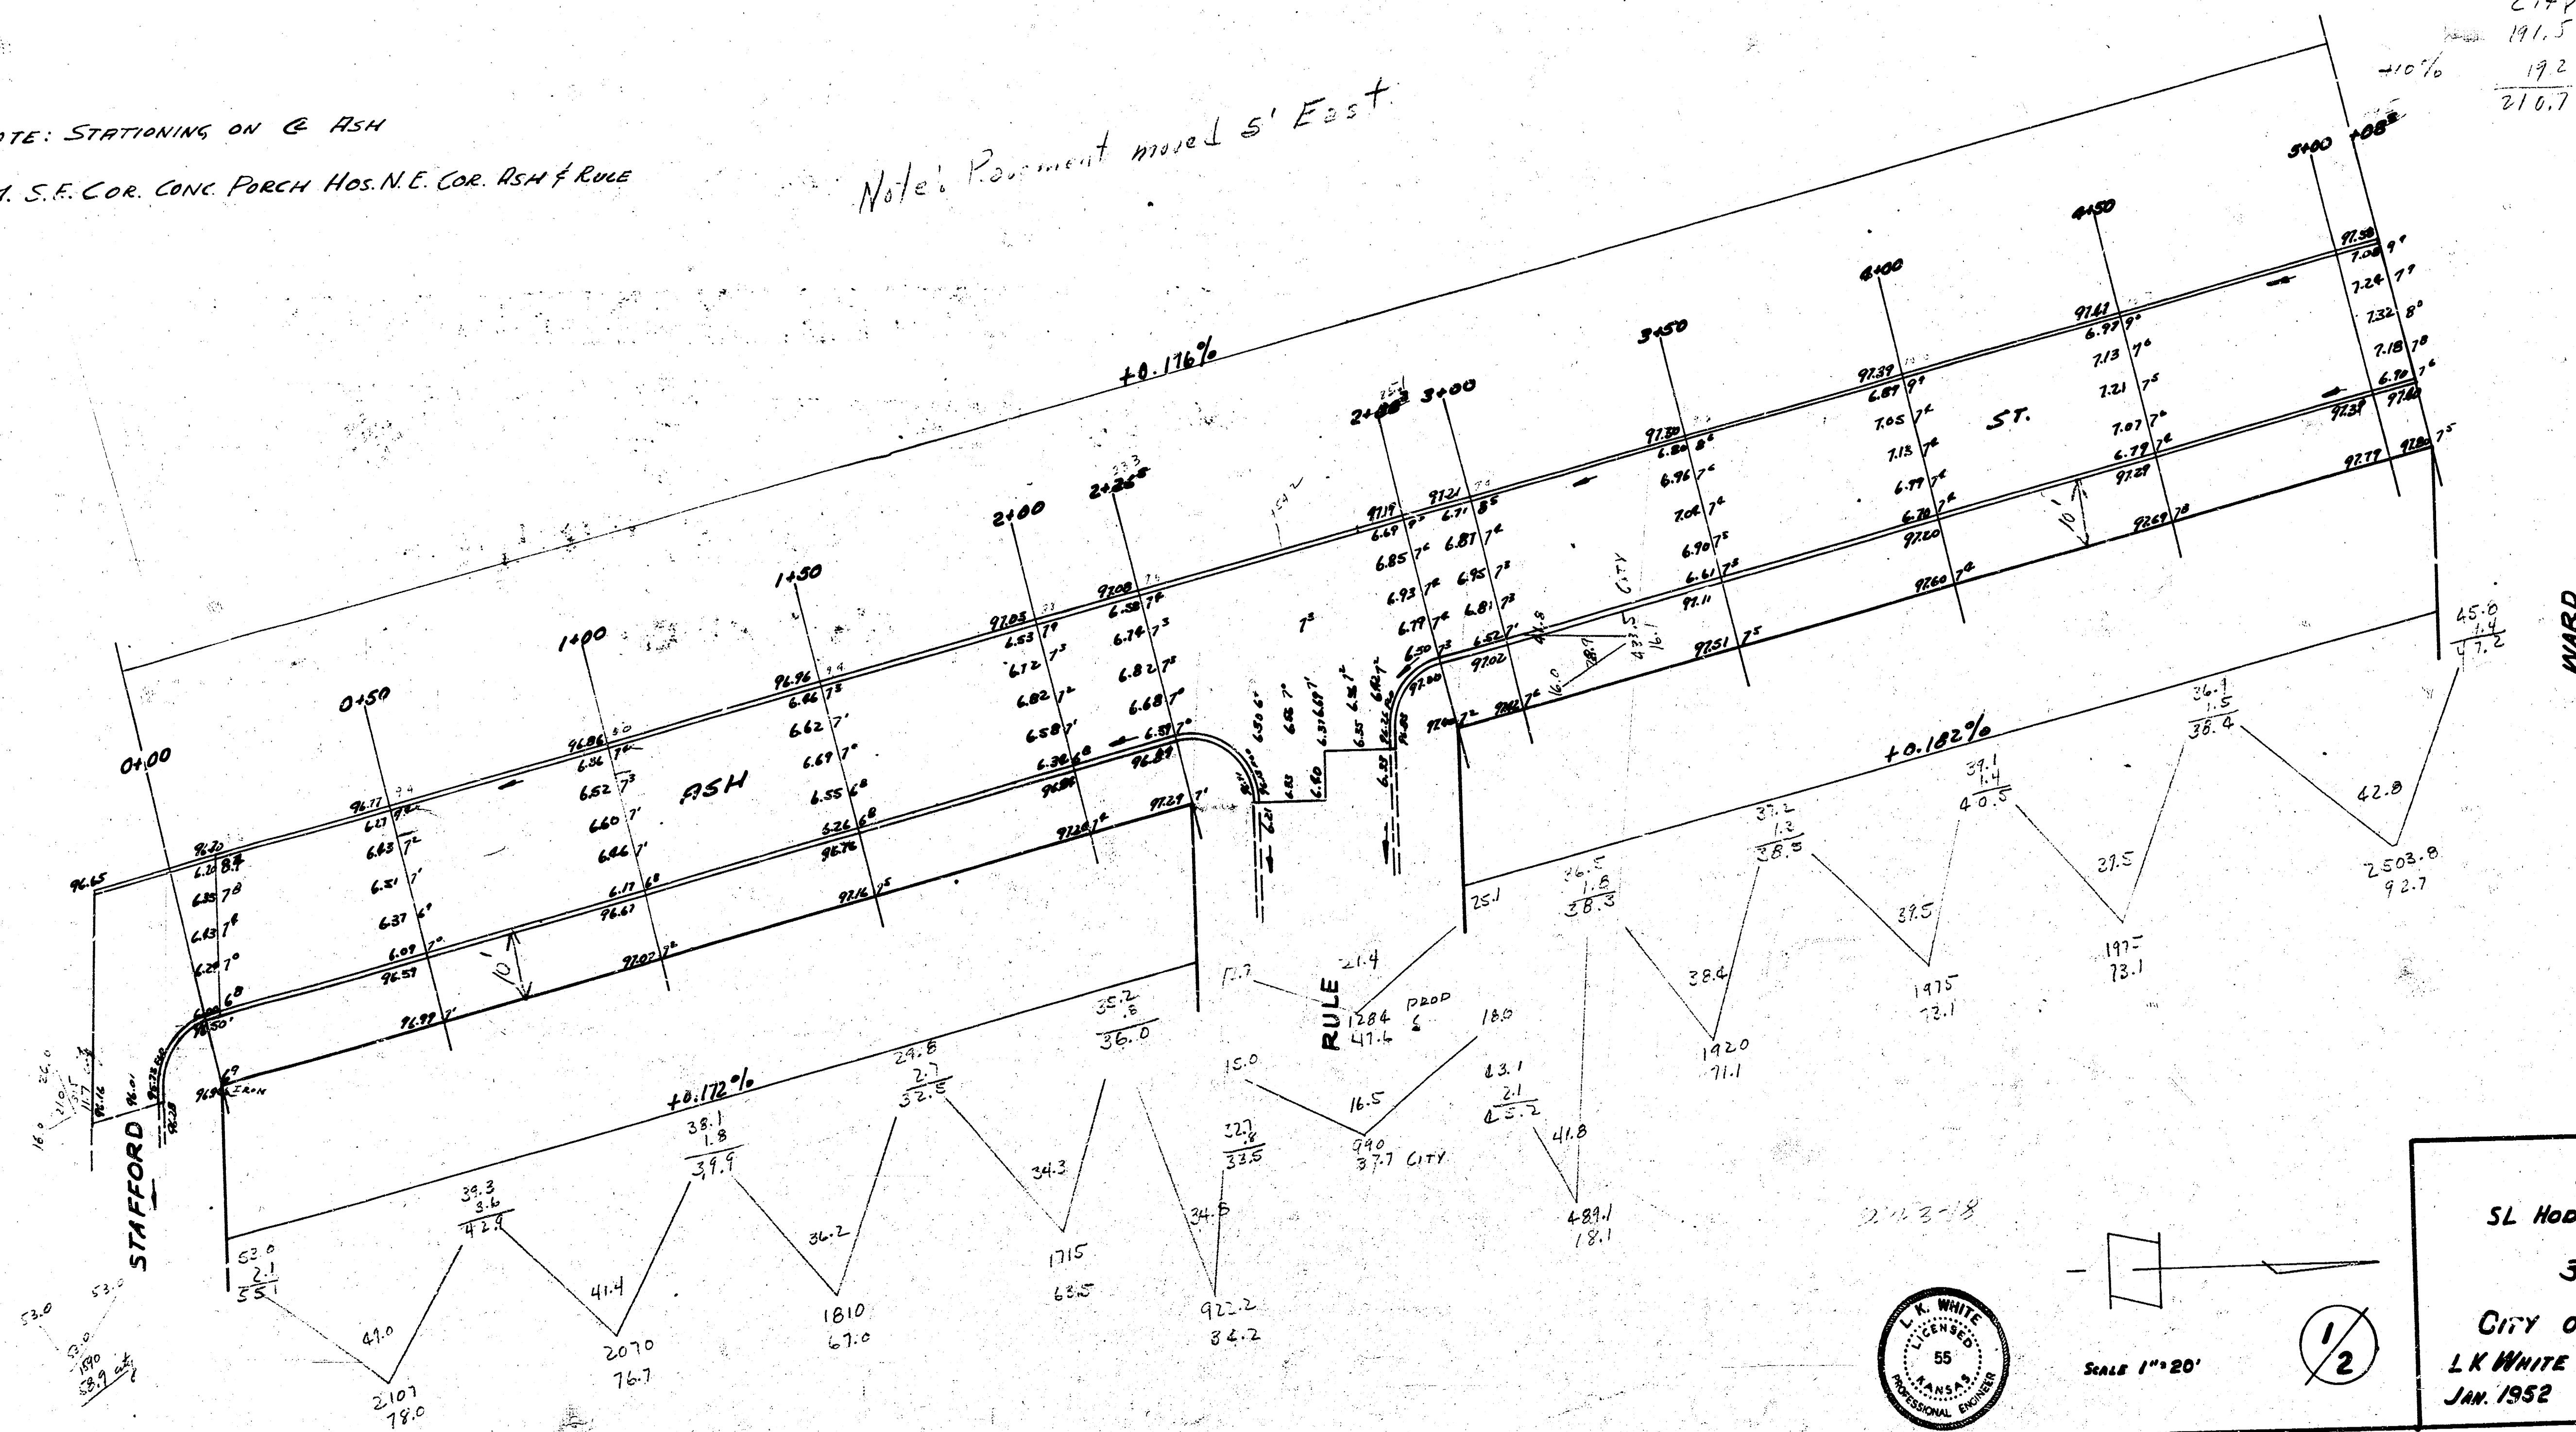

SCALE 1"=20'

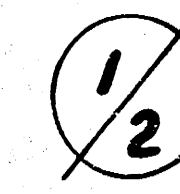

**ASH**  
SL. HODSON TO N.E. STAFFORD  
30' CONC. & CO.  
CITY OF WICHITA  
L.K. WHITE CITY ENGINEER  
JAN. 1952 PROJ. CH-241

NOTE: STATIONING ON E ASH

B.M. 6" IN GLOBE N END N.E. RET. ASH & HODSON.

