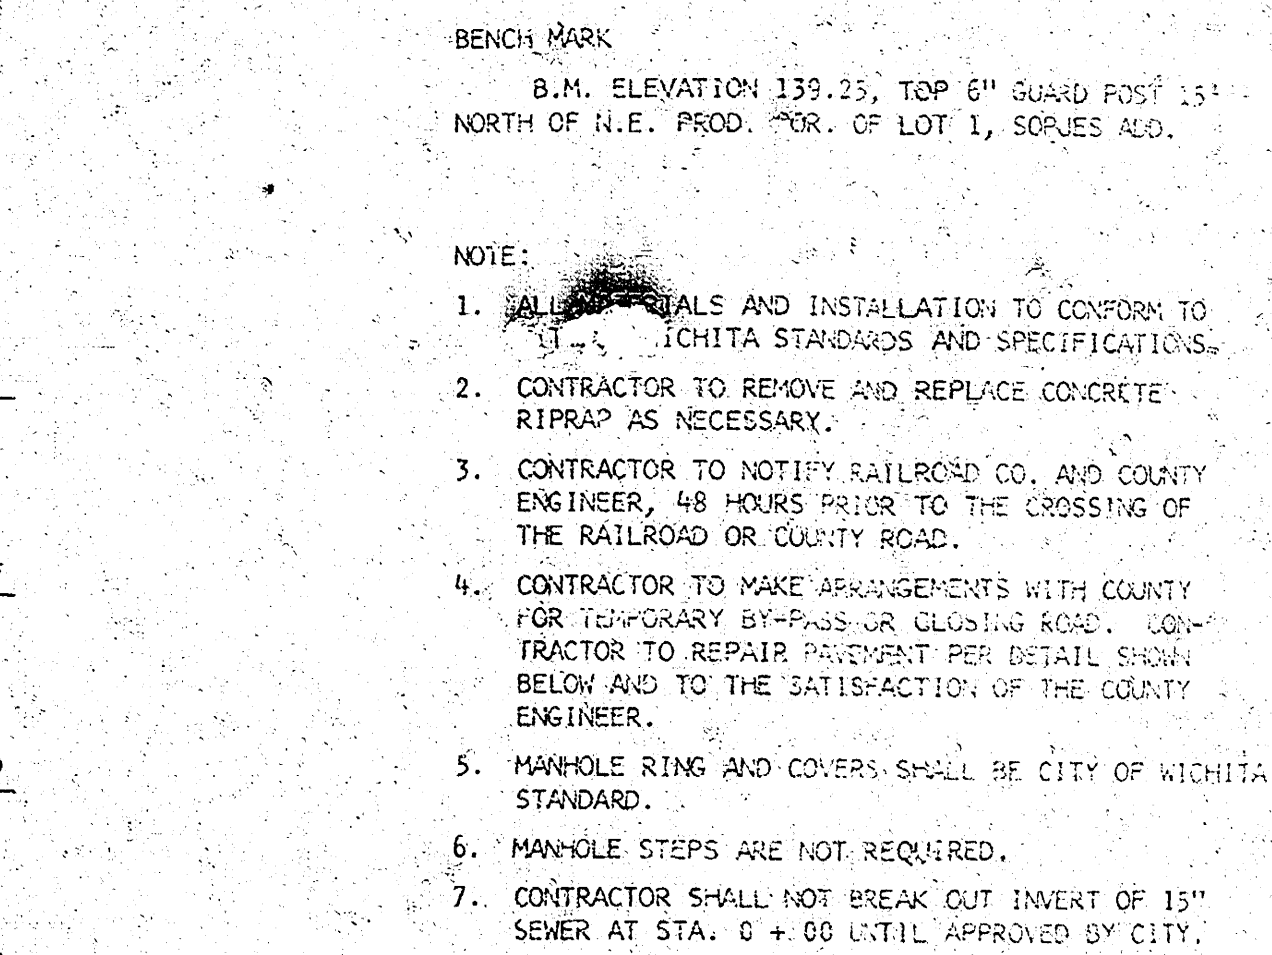


FOR CONSTRUCTION: JAN 14 72

**THE LAW COMPANY**

This is a scan of a blank page from a document. The page contains no text or figures. It shows some minor scanning artifacts, such as small dark specks and faint horizontal lines near the top edge.

MANUFACTURING FACILITIES  
FOR  
DE BOER BUILDING  
SYSTEMS CORP. INC.  
WICHITA, KANSAS  
PROJECT NUMBER 103

|                                                 |                                                |
|-------------------------------------------------|------------------------------------------------|
| TENANT<br>SANITARY<br>SEWER PLAN<br>SHEET TITLE |                                                |
| TENANT<br>NUMBER                                | SHEET NUMBER<br><br>SU 2<br><br>OF _____ SHEET |

AS BUILT 3-1-72  
BANKED 3-3-72  
© I-45 BY W.D.U.

| SHEET TITLE      |                                              |
|------------------|----------------------------------------------|
| TENANT<br>NUMBER | SHEET PRIMER<br><br>1<br><br>OF _____ SHEETS |