


|                                                 |                                                                                                   |
|-------------------------------------------------|---------------------------------------------------------------------------------------------------|
| TENANT<br>SANITARY<br>SEWER PLAN<br>SHEET TITLE |                                                                                                   |
| TENANT<br>NUMBER                                | SHEET NUMBER<br><br><div style="font-size: 2em; font-weight: bold;">SU 2</div><br>OF _____ SHEETS |

AS BUILT 3-1-72  
BANKED 3-3-72  
© T-45 BY W.D.U.

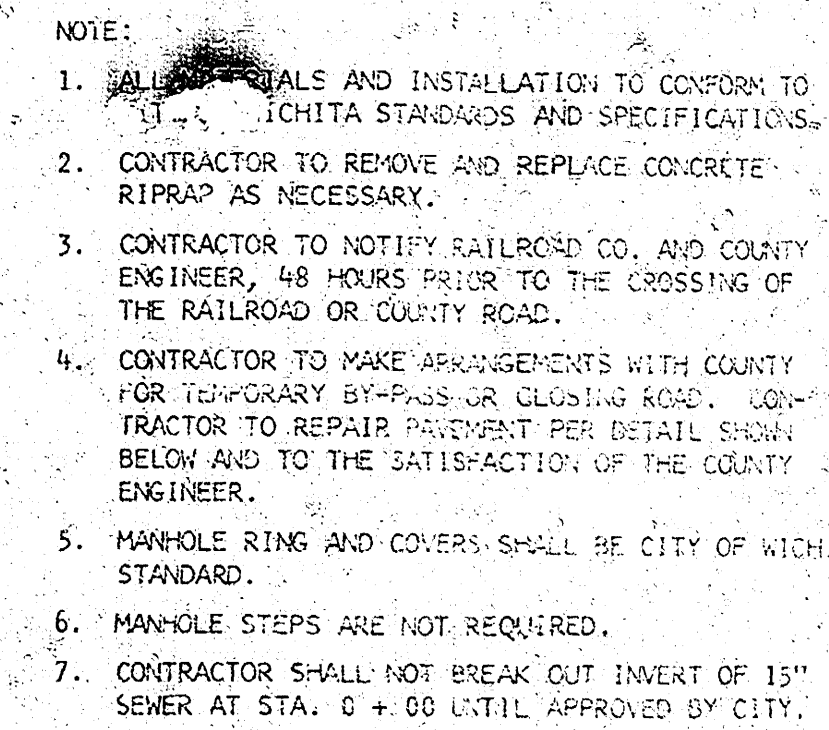