




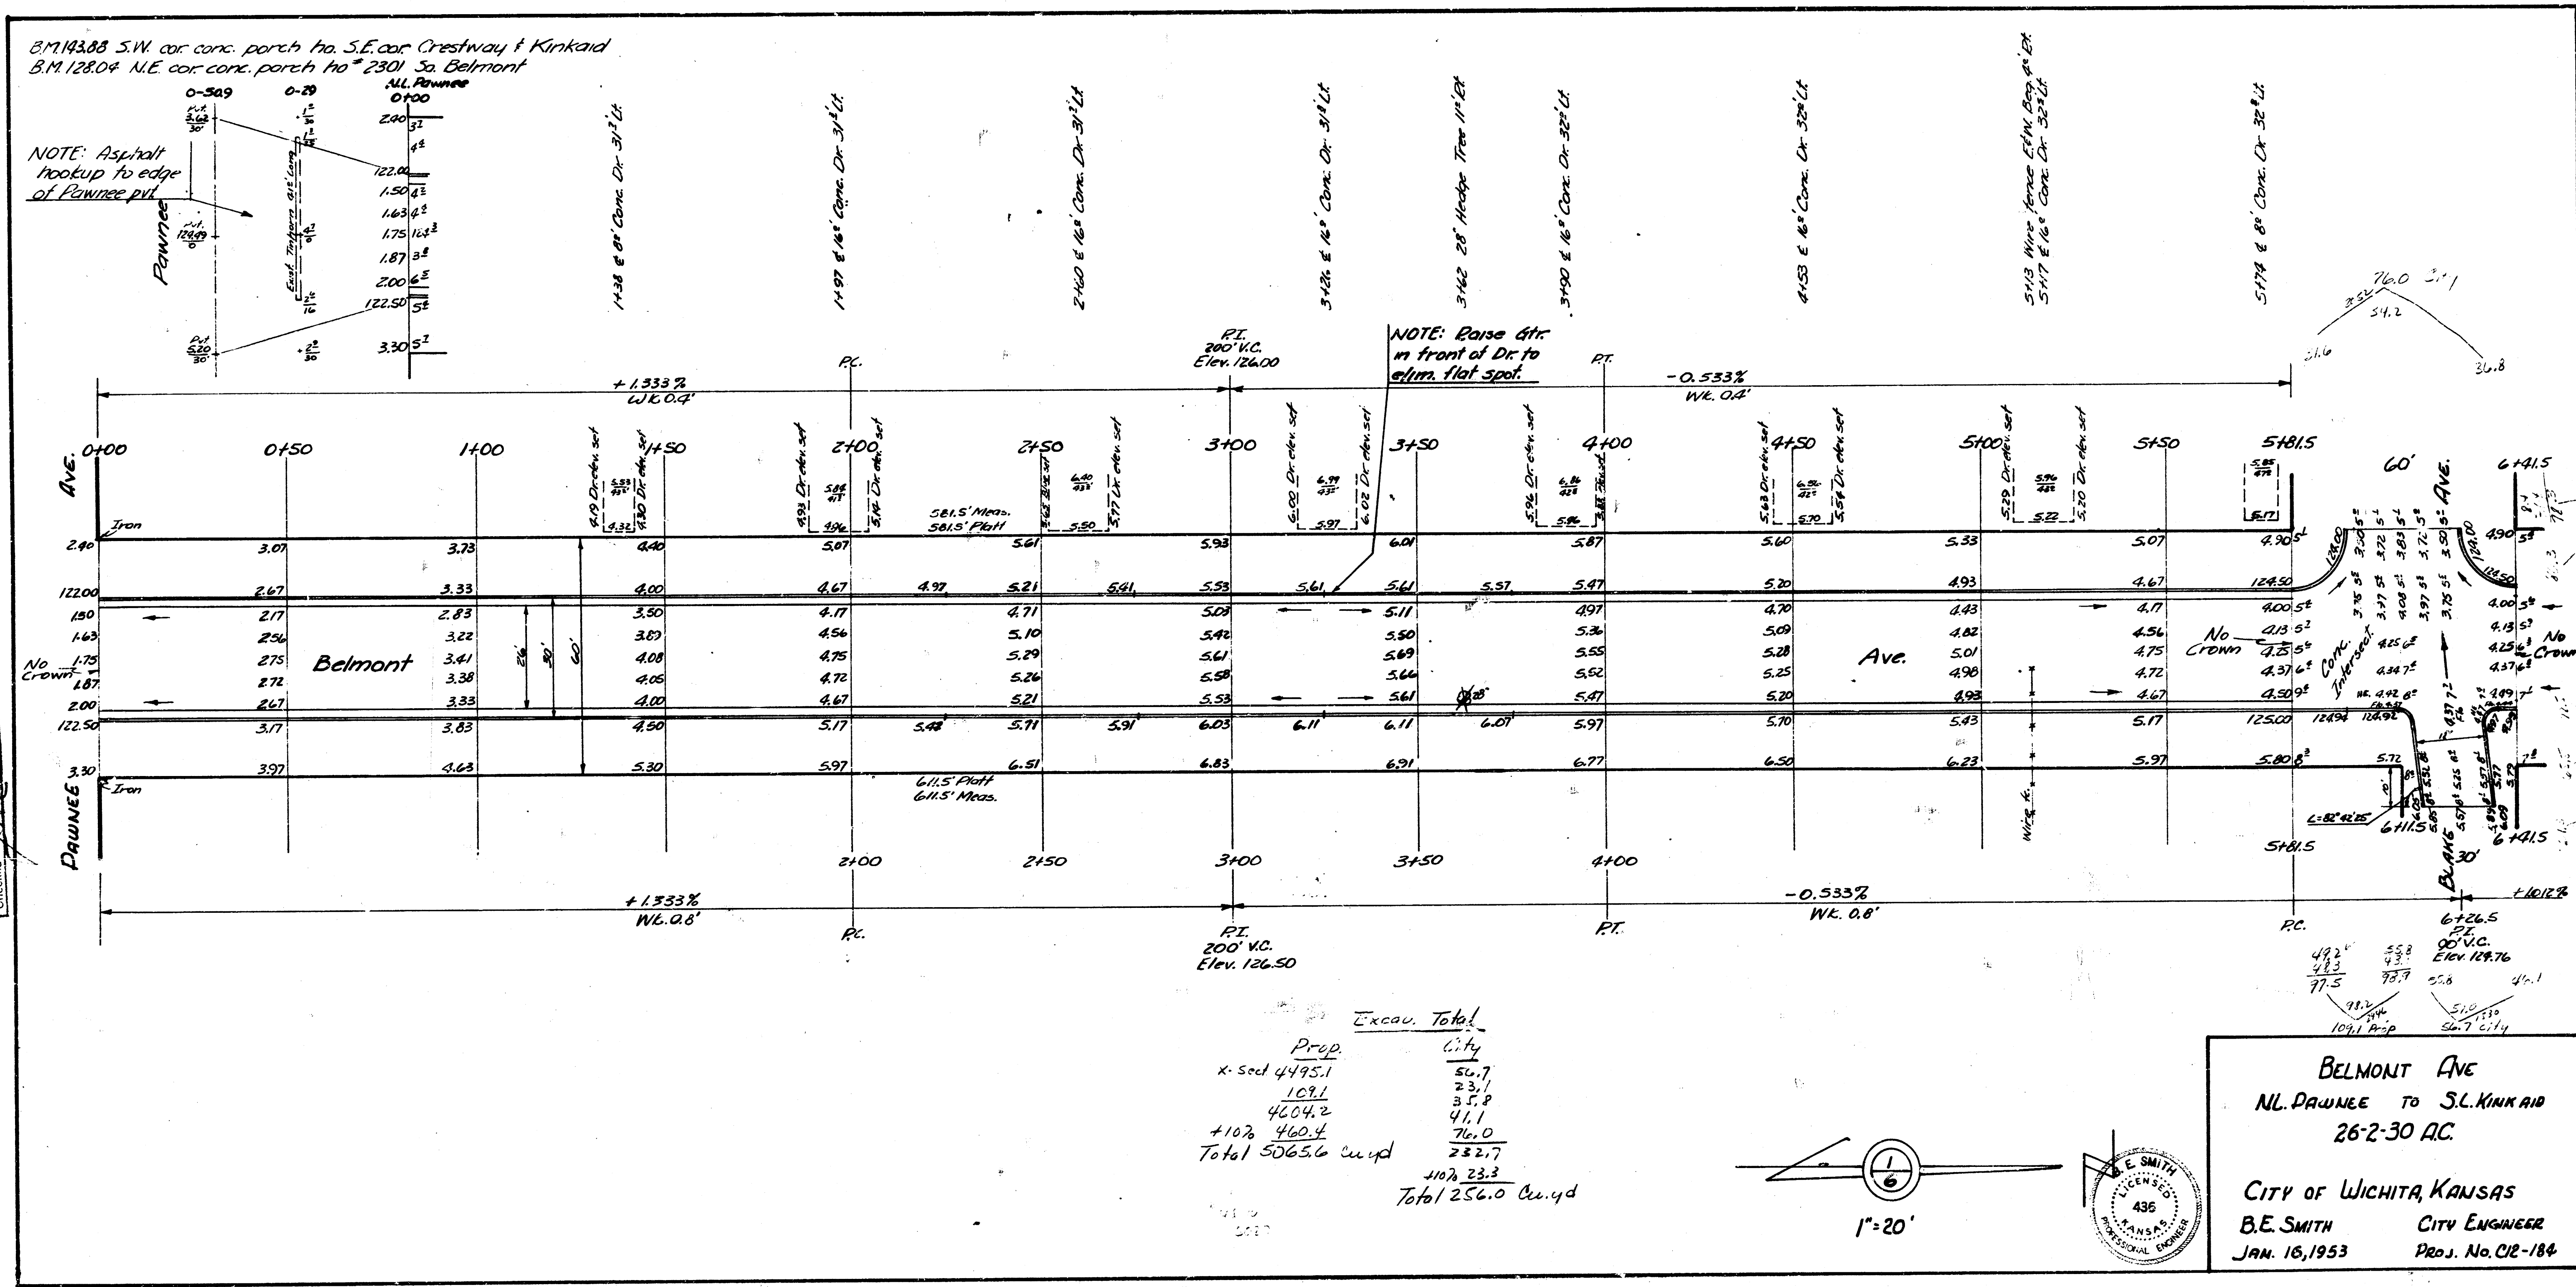

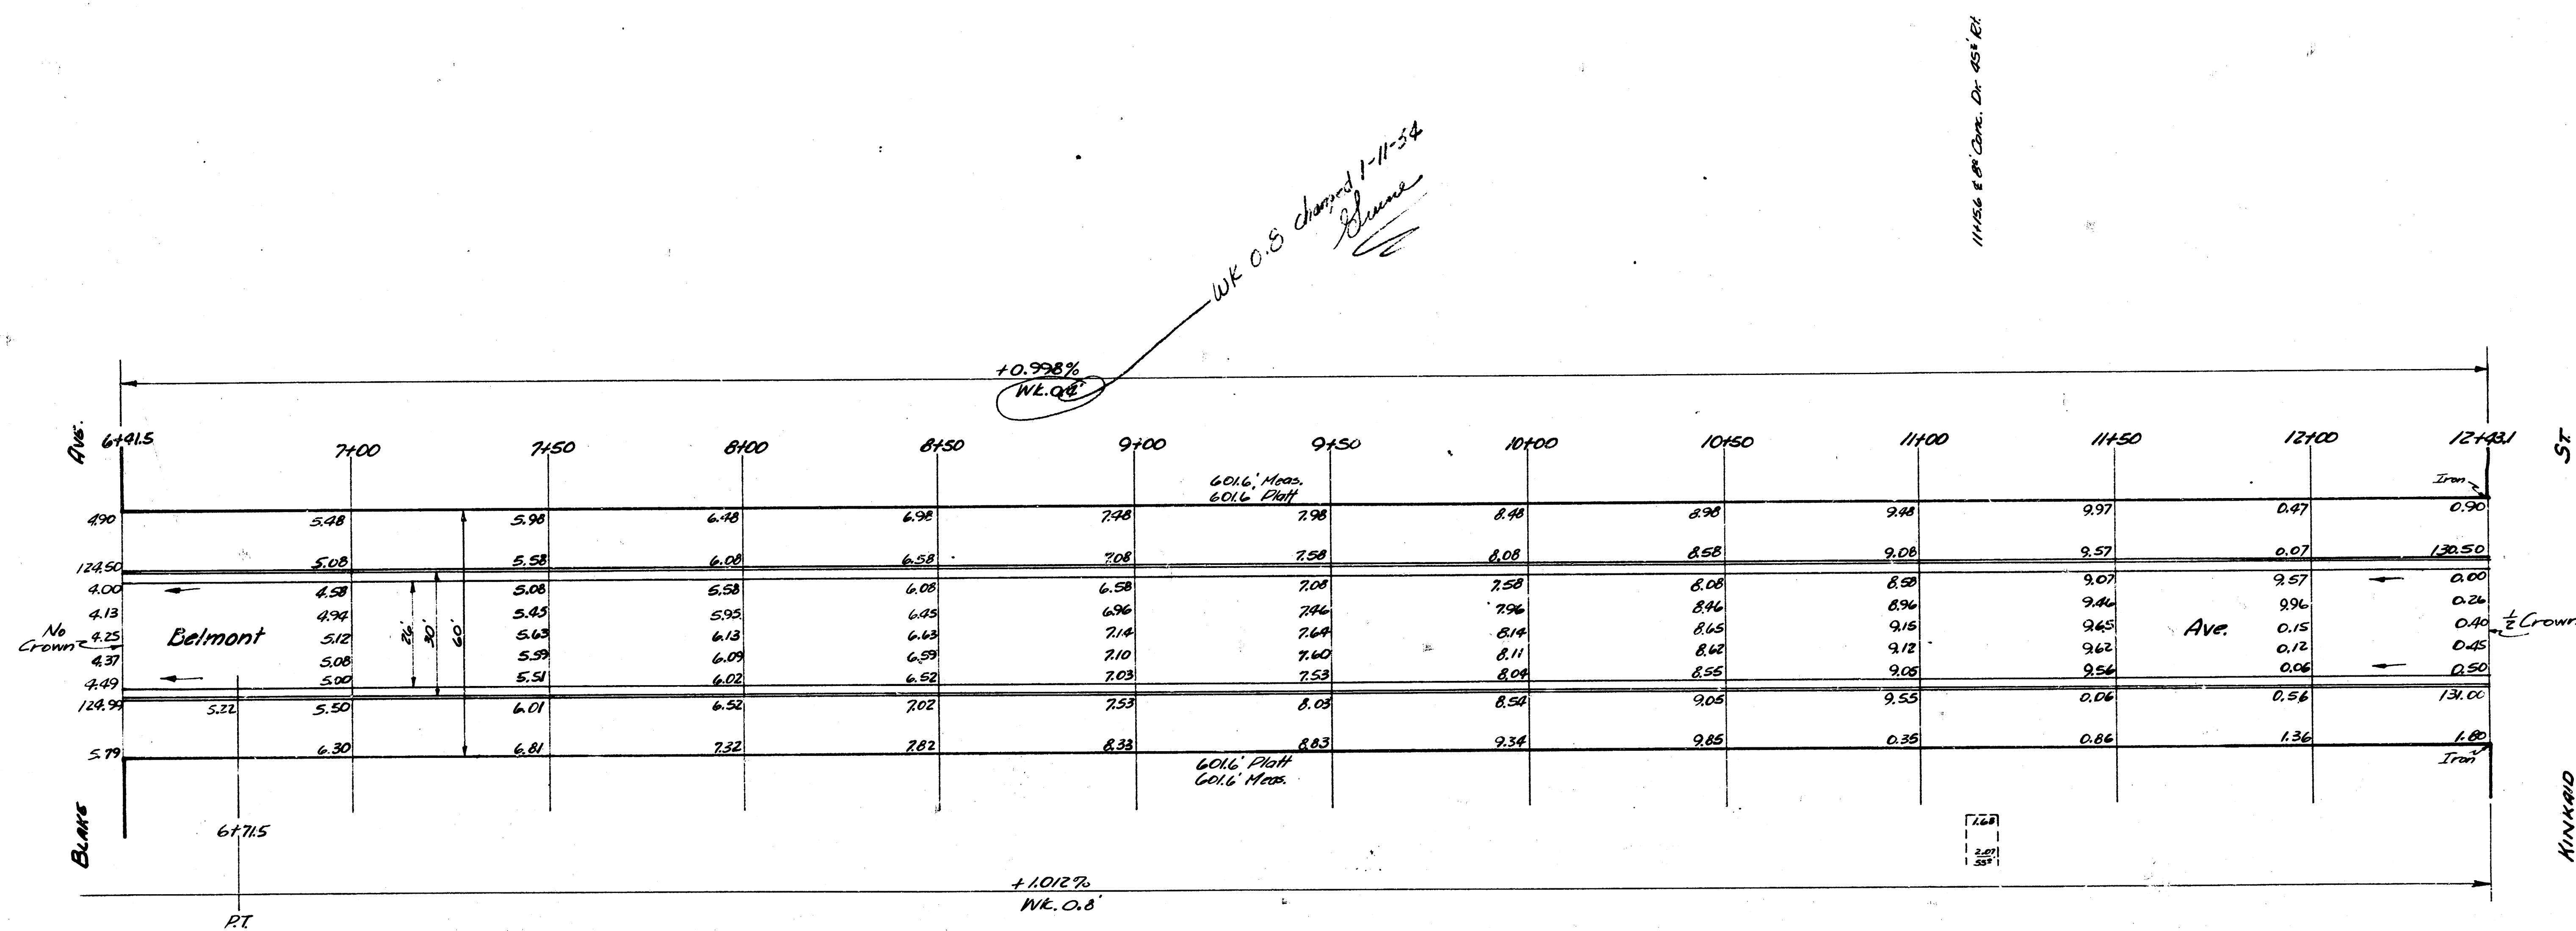

WL. Q. 8' changed 1-11-34
[Signature]

11/15/36 E. & W. Corners Dr. 451' E. 1/4

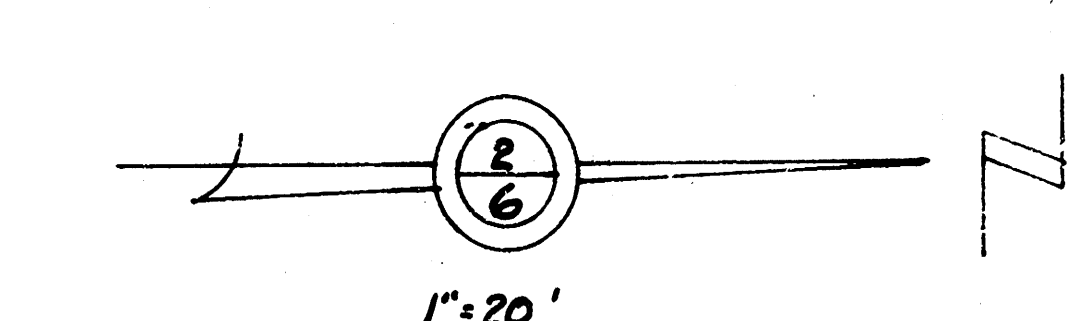

BELMONT AVE.