

Revised April, 1949. Substituted
1948 traverse for original (1932)
traverse begun Seneca & Douglas Ave.

RIVER	COUNTY	MILEAGE	SHEET	TOTAL
Arkansas	Sedgwick	20 to 21	17	40

GENERAL NOTE:
All traverse points above Douglas Ave. are 1948 traverse points. Points indicated thus ● are points on original (1932) traverse. Dotted line traverse indicates original traverse. All 1948 traverse points are marked by iron pins unless otherwise indicated.
1948 traverse is balanced and adjusted with closure lines as shown. Azimuths and coordinates are from assumed data. Bank lines below Douglas Ave. are as traced from original tracing. Bank lines above Douglas Ave. are from topography, June, 1948.

- LEFT BANK**

23E
18' N. to yard to E.W.
147' E. to W. face of house
10.6' N.W. to steel clothes line post
9.4' N. to cor. of post at fc. N.
Lat. 4,151.45 Dep. 10,772.76

23E
3.6' E. to SW cor. of metal bldg.
18.0' SE. to SW cor. of brick bldg.
5.2' S. to 2" pipe (prop. cor.)
Lat. 4,472.06 Dep. 10,747.98

25E
5.65' N.E. to SW cor. of brick fire burner
10.0' N.E. to NW " " " "
4.8' E. to steel fc.
Lat. 4,683.34 Dep. 10,787.62

26E
2.6' E. to steel fc.
27.7' S. to N. H.P. of "N" frame
3.55' S. to fc. cor. of metal bldg.
Lat. 4,684.76 Dep. 10,797.35

27E
3.0' E. to W. rail of RR siding
5.3' SW to SE cor. of steel cor. post
70' S. to RR switch
Lat. 4,652.07 Dep. 10,882.94

28E
7.2' E. to W. rail of E. siding
2.2' W. to E. " " " "
22.5' SE. to steel cor. post of fc. 3.8E.
37.8' N.E. to SW cor. of Garage Bldg.
Lat. 4,574.13 Dep. 10,907.27

29E
1.2' E. to E. corner of wingwall
1.2' S. to SW cor. of unloading dock
Lat. 4,575.57 Dep. 10,819.23
- RIGHT BANK**

21W
9.1' S. to H.L. guy pole
30.2' WSW to H.L.P.
5.4' W. to E. curb McLean Blvd.
Lat. 4,247.92 Dep. 10,268.28

22W
4.7' W. to "on E. curb McLean Blvd.
53.0' S. to 8" hackberry tree
Lat. 4,186.94 Dep. 10,380.62

23W
10.75' W. to "on E. curb McLean Blvd.
20.7' NW " " " "
20.0' SW " " " "
Lat. 5,639.87 Dep. 10,412.20

24W
16.2' NW to cor. of bulkhead of wingwall
2.0' W. to E. curb McLean Blvd.
33.0' N. to conc. light post
Lat. 6,083.46 Dep. 10,357.87

25W
2.3' W. to E. edge of E. curb
8.2' SE. to 6" hackberry
89.2' S. to conc. light pole (2nd S. of Br.)
102.2' W. " " " " (2nd S. of Br.)
Lat. 7,200.56 Dep. 10,237.64

30E
3.7' N.E. to cor. of post of fc. N.E.E.
2.9' N. to line of fc. E.
2.7' E. " " " "
Lat. 7,704.67 Dep. 10,144.87

TIES AND COORDINATES

- RIGHT BANK**

Sta. 1131+15.36
N. 9,746.78 E. 7,611.55
"X" on E. sidewalk S. end Seneca St. Bri.
1.6' E. to handrail post.
0.25' S. to end of bridge.

Sta. 1125+14.01
N. 9,632.24 E. 8,201.90
9.5' S. to edge of N. curb McLean Blvd.
9.4' S.W. to Handley & McLean Blvd. Marker
49.2' N. to St. light conc. post.

Sta. 1119+65.14
N. 9,616.79 E. 8,740.55
9.6' S. to base of light post.
9.7' S. to U.S. Engrs. B.M. TSB-89-1947

Sta. 1112+58.24
N. 9,634.24 E. 9,388.35
U.S. Engrs. B.M. TSB-90-1947

Sta. 1108+00.89
N. 9,968.02 E. 9,748.36
"X" on N. curb of N. end 2nd St. Bri.
6.25' E. to N.N. railroad.

Sta. 1103+07.68
N. 8,519.02 E. 9,949.01
Concrete Monument, pipe in center
193' N. to E. curb McLean Blvd.

Sta. 1098+99.9
N. 8,119.70 E. 7,056.25
10.3' S. to N. rail McLean Blvd. Bri. Abut.
16.0' SE. to N. A. cor. McLean Blvd. Bri. Abut.
11.6' S.W. to Western Union T.P.
16.6' N.W. to base of light pole = 485'-10

Sta. 1094+75.5
N. 7,704.67 E. 10,144.87
"X" on S. sidewalk of N. end Douglas Ave. Bri.
6.5' S. to handrail abut.
3.7' W. to W. end of bridge.
- LEFT BANK**

Sta. 1123+48.68
N. 10,209.67 E. 7,810.18
"X" on S. curb N. of bri. at Seneca
85.3' S. to N. abut.
9.5' E. to 2nd Hackberry E. of bri.
10.4' N. to S. edge of storm dr.
14.5' E. to N. edge of sidewalk.

Sta. 1119+78.68
N. 10,041.58 E. 7,939.79
34.6' S.W. to rail "X" on C.W.
40.3' E. to steel fc. cor. post.
City of Wichita Material Yard

Sta. 1115+67.36
N. 9,946.40 E. 8,338.96
1.9' N. to fc. corner angle.
16.6' E. to N. end of conc. spillway


Sta. 1113+19.21
N. 9,912.28 E. 8,665.27
53.3' W. to S.W. cor. of fc.
6.7' S. to cor. of conc. wall.
17.6' N.E. to S.E. cor. of conc. wall.
14.8' N. to face of S. H.L.P.
20.7' N.W. to " " " "

Sta. 1109+94.38
N. 10,000.00 E. 8,898.03
Pipe at center 3rd St. & Nims Ave.
32.8' N.E. to St. Marker.
49.0' S.E. to fire plug.

Sta. 1098+92.38
N. 10,000.00 E. 10,000.00
Thimble at Sherman & 5th St.

Sta. 1093+17.93
N. 9,425.33 E. 9,996.98
6' nail in expansion joint.

Sta. 1088+44.92
N. 9,017.88 E. 10,236.91
54' N.E. to S.W. cor. post S.E.T.T. Co. B.
26.6' E. to N. cor. of diamond shaped
brick building.

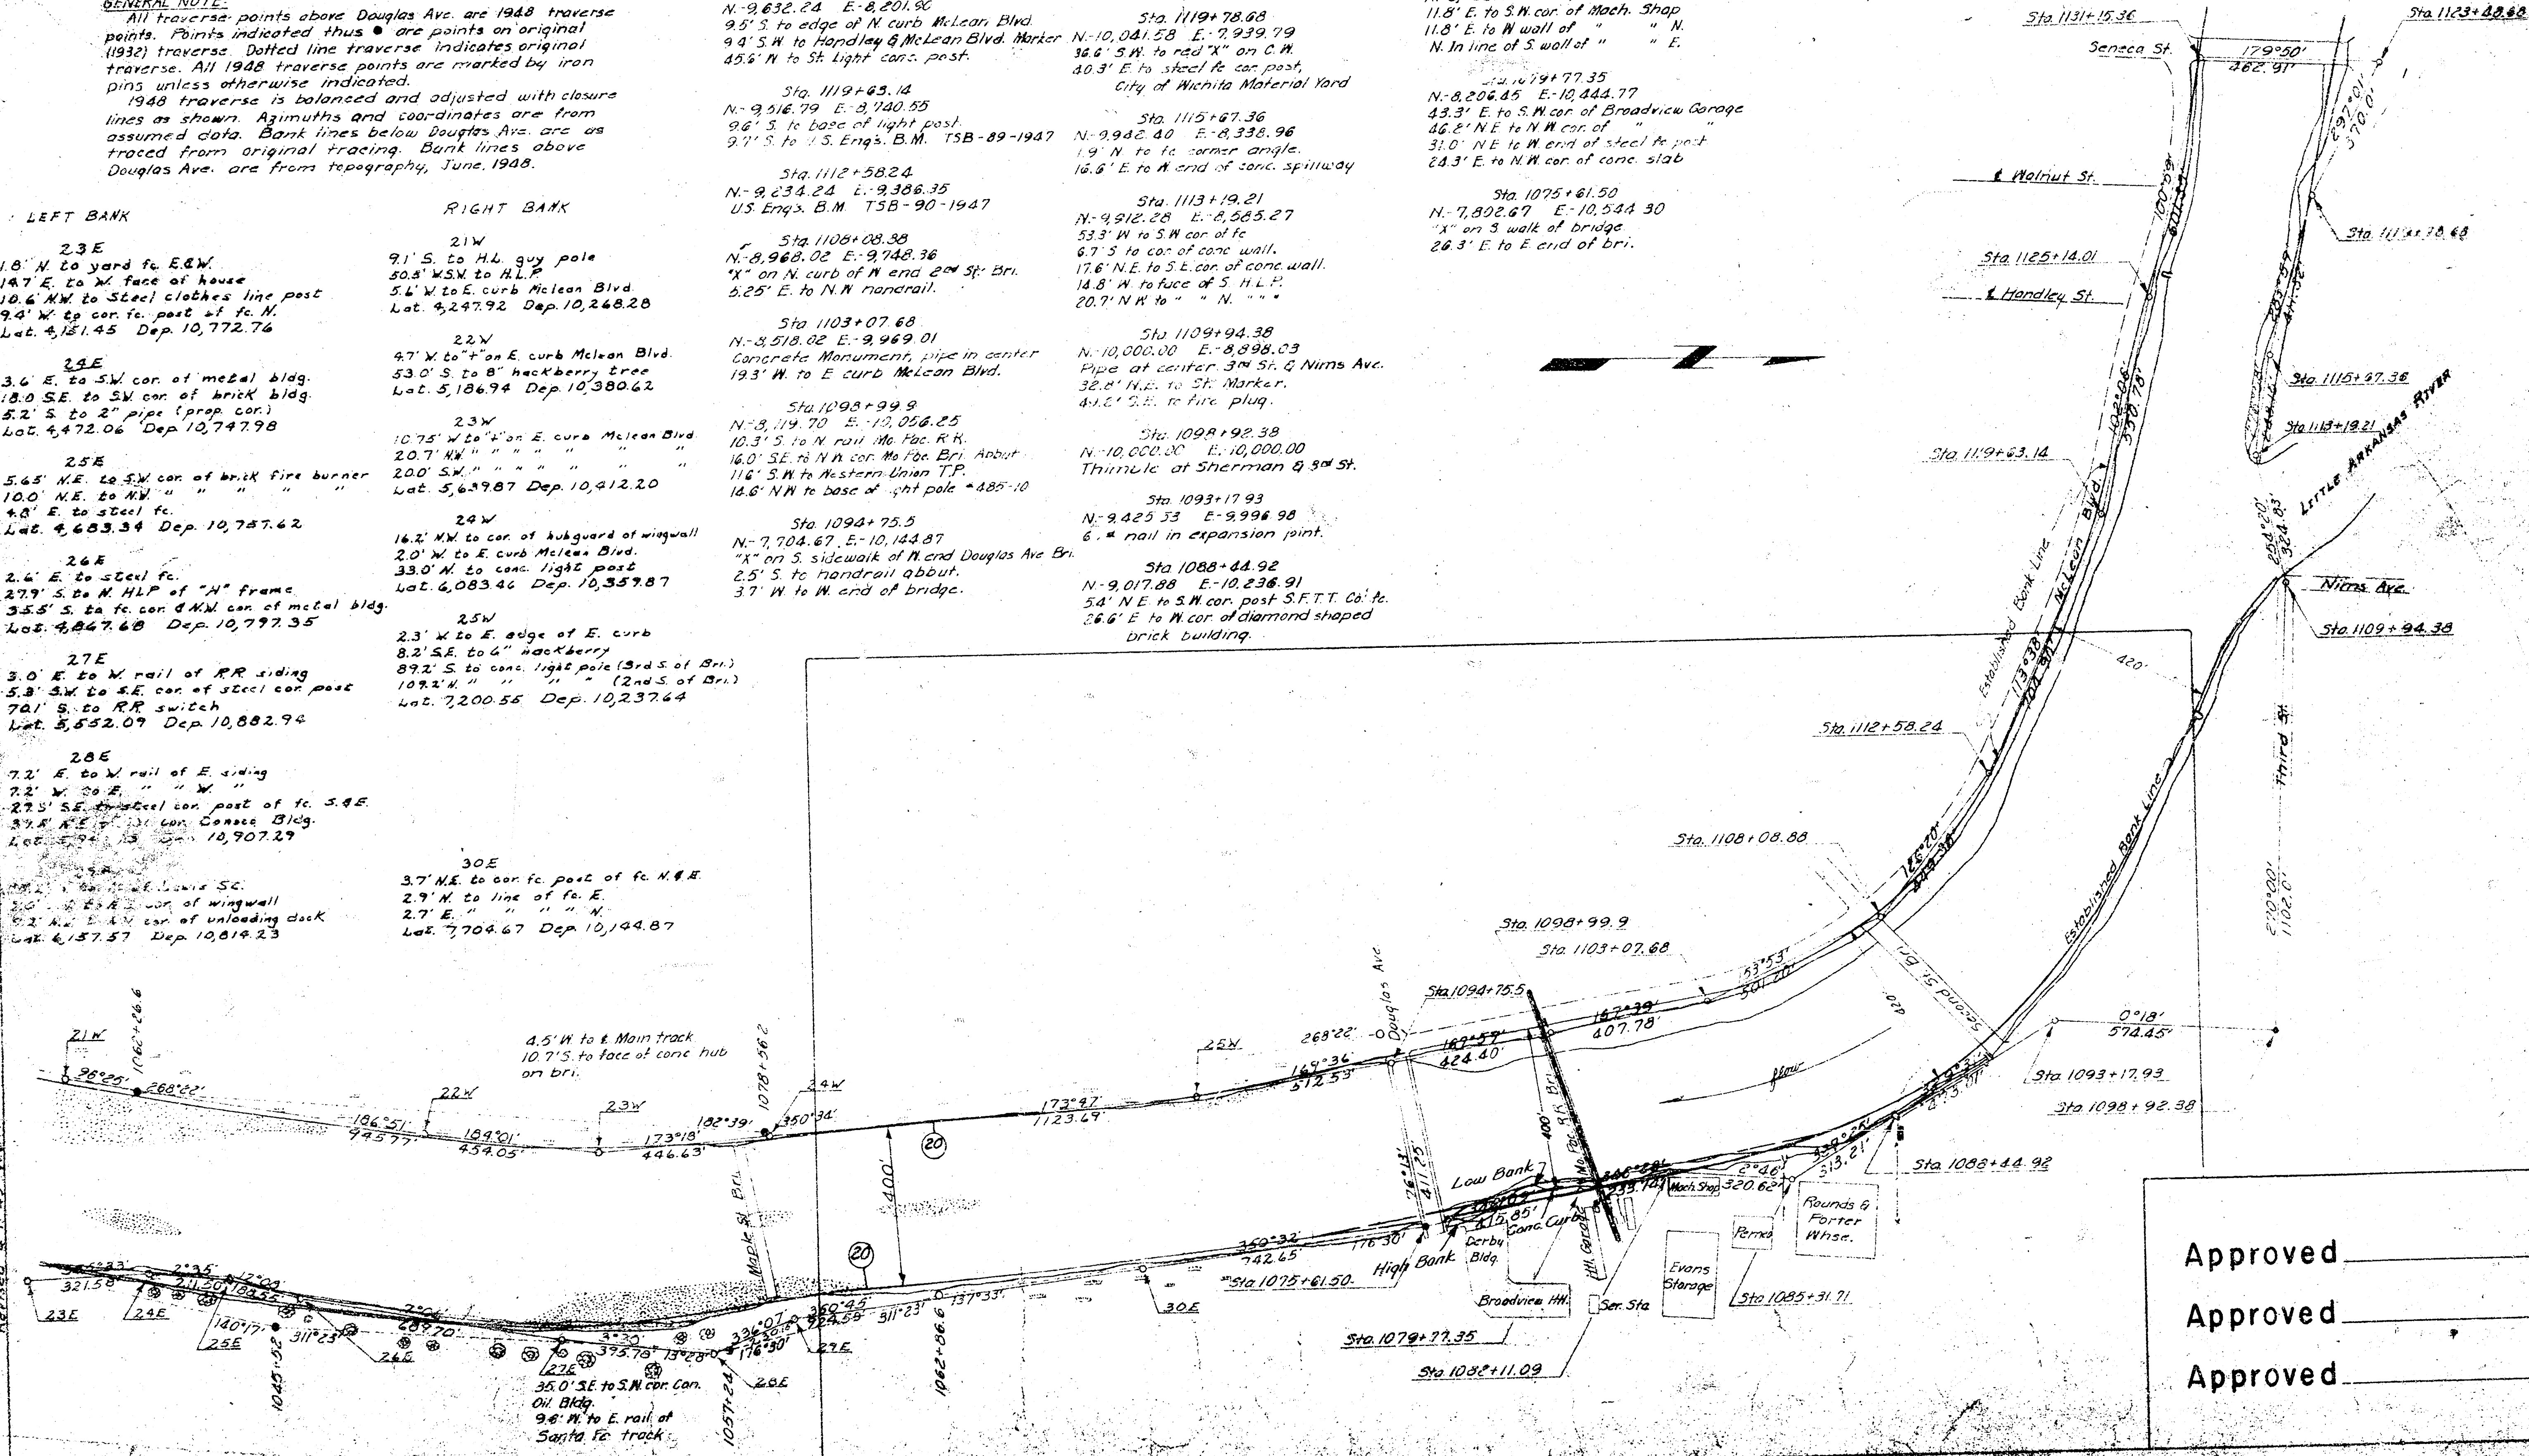

Approved _____
Approved _____
Approved _____

