



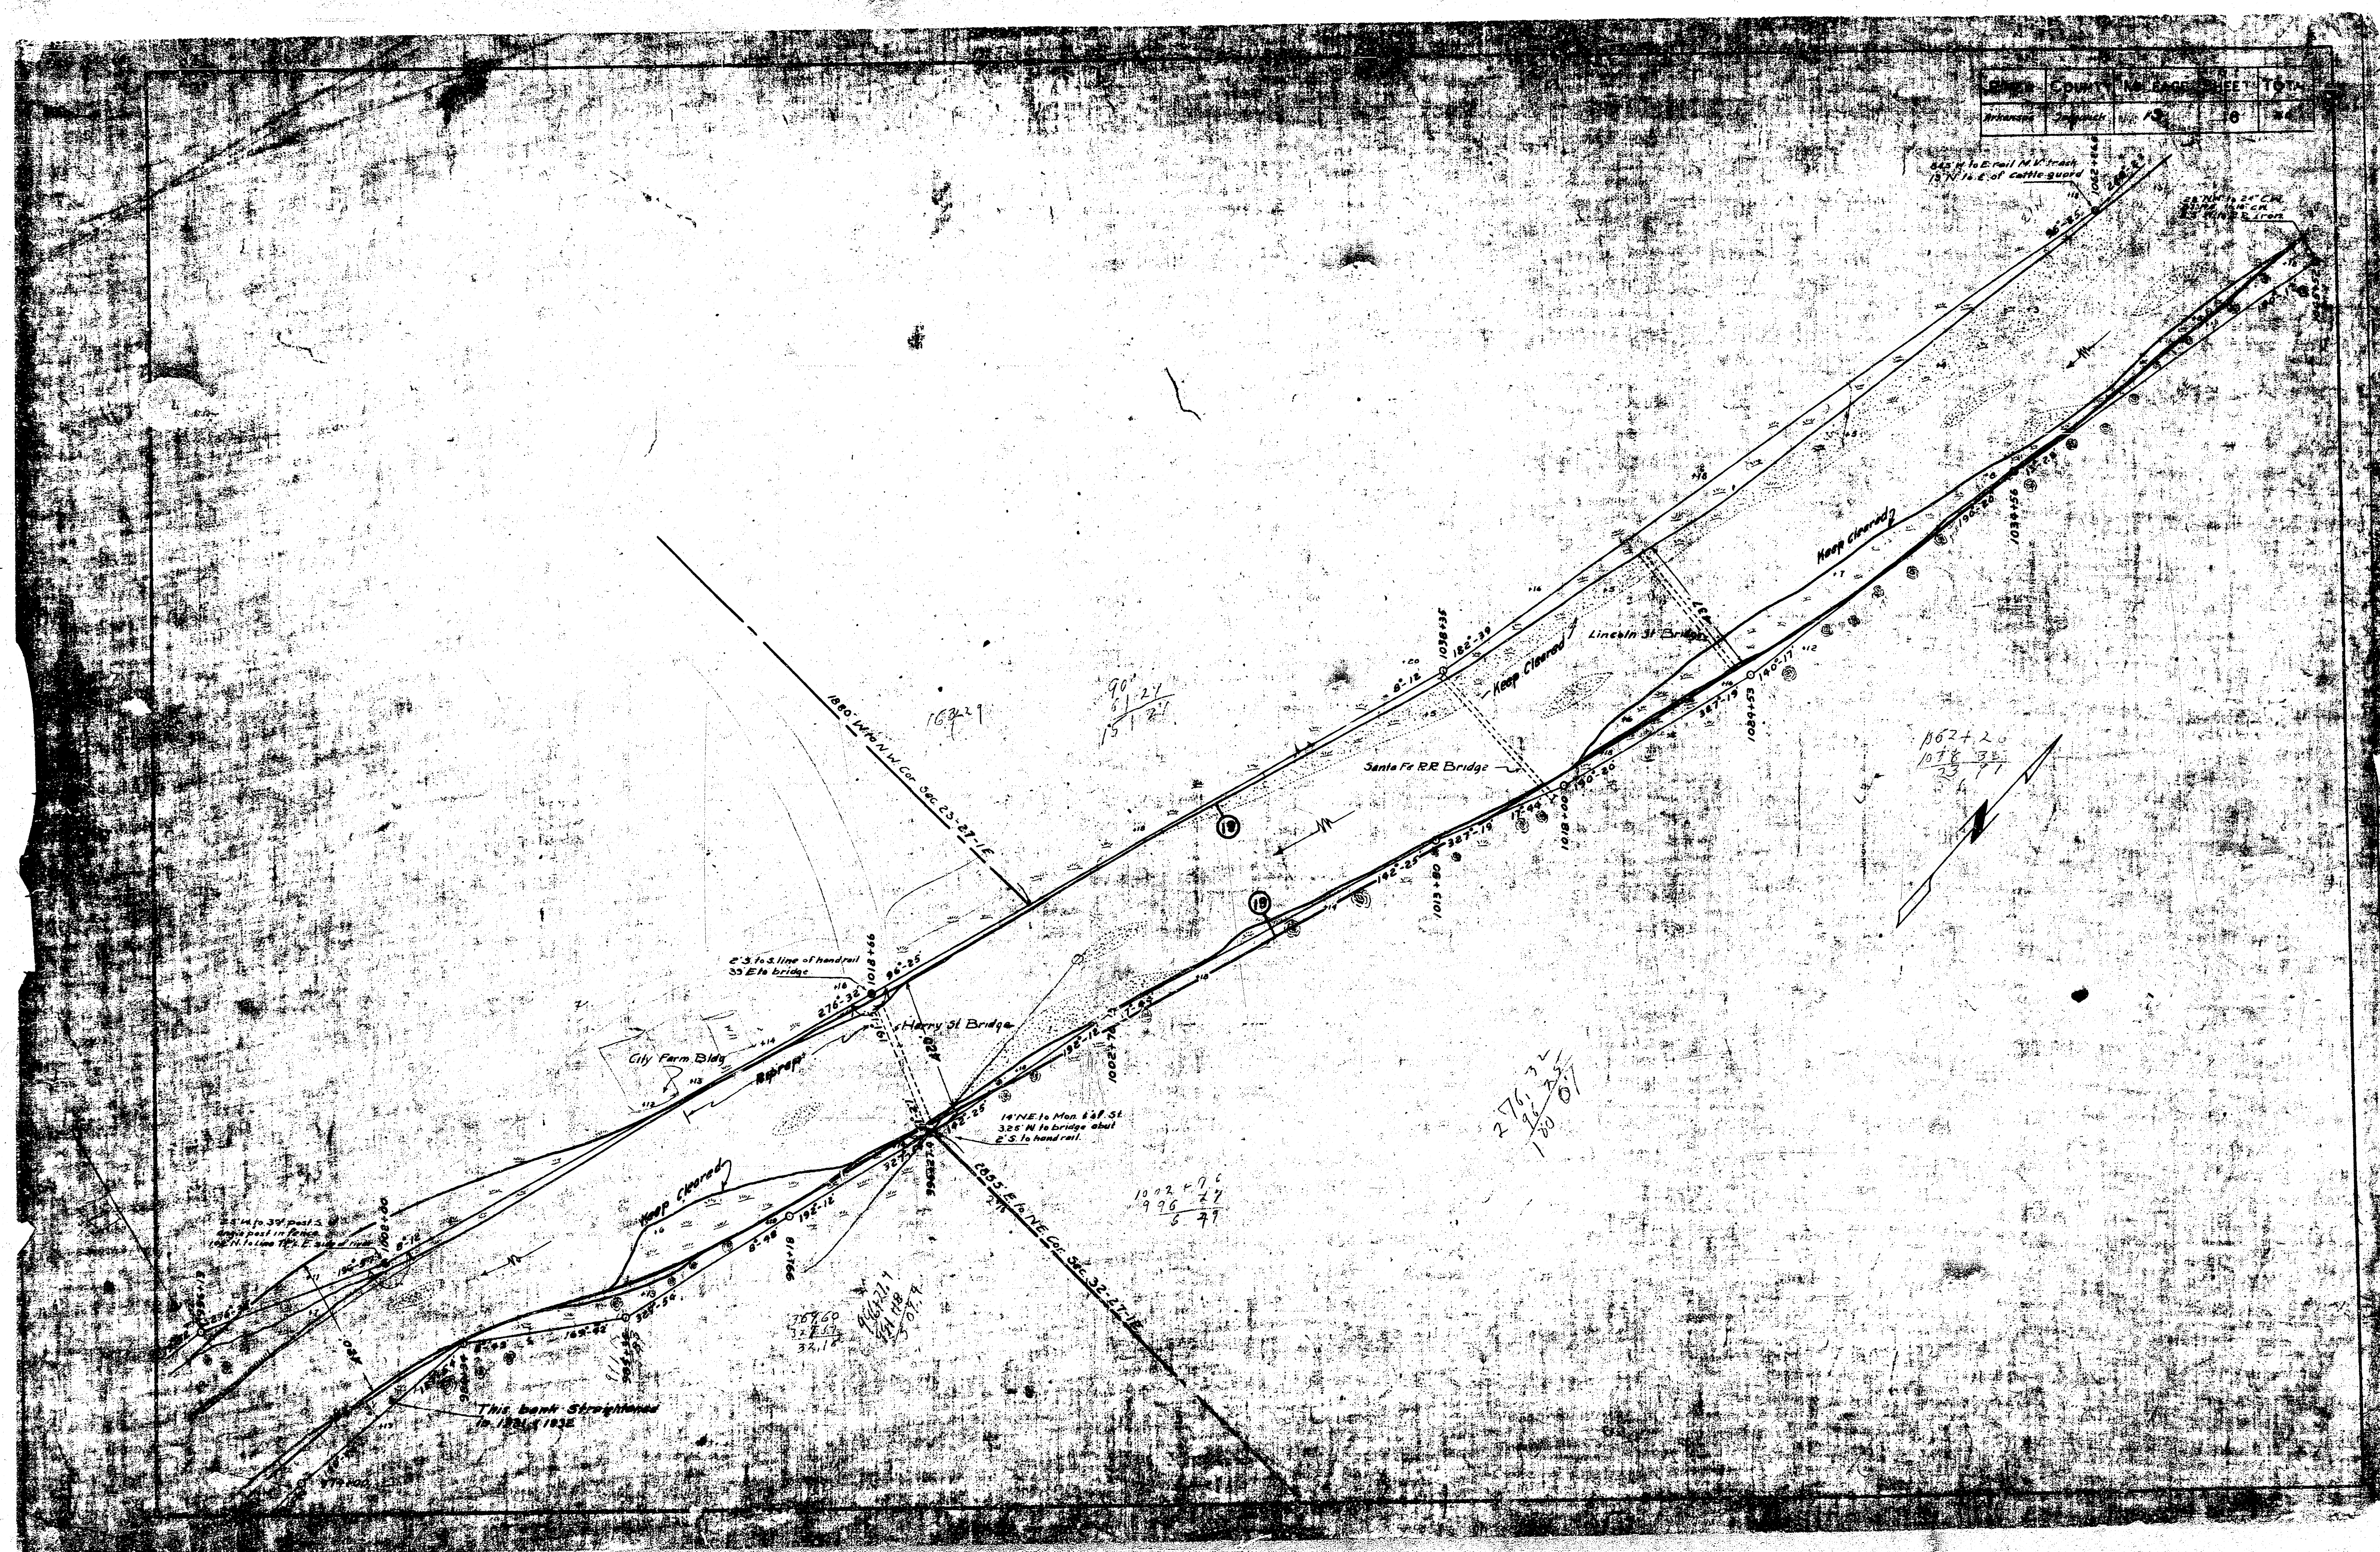

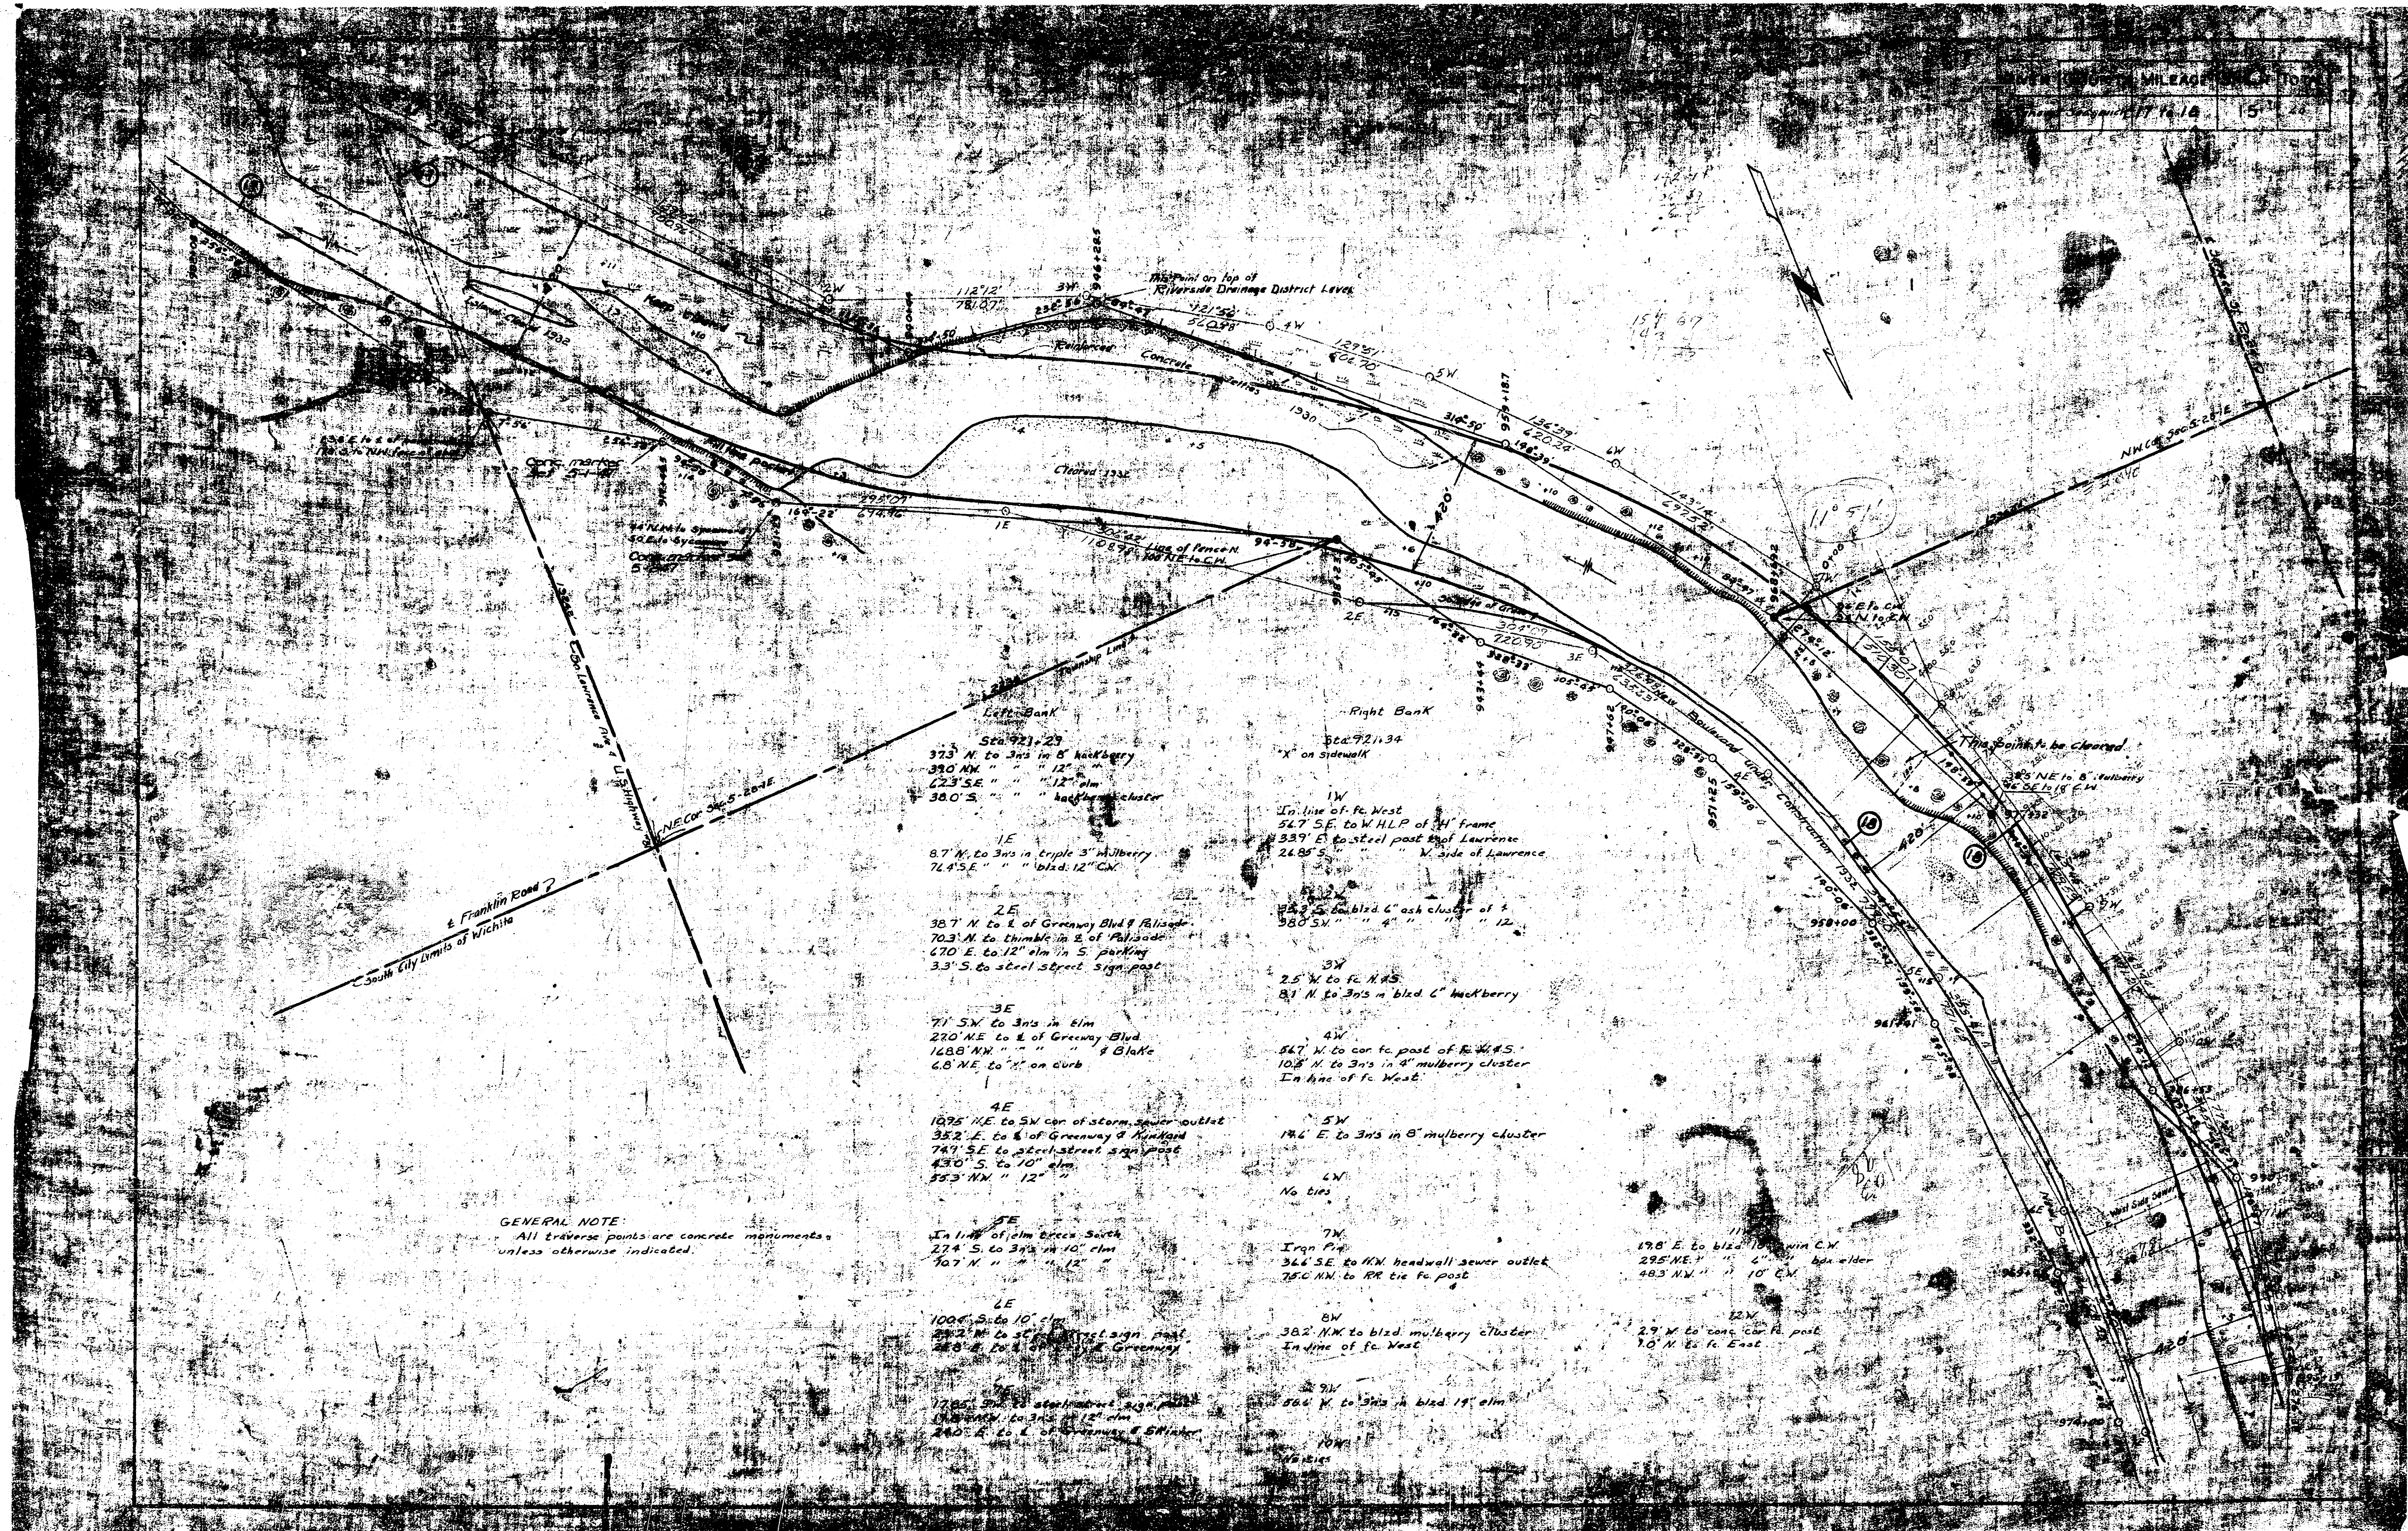

GENERAL NOTE:
All traverse points are concrete monuments
unless otherwise indicated.

Sta. 92+25
373' N to 3rd in 8' mulberry
340' NW " " " 12" elm
123' SE " " " 12" elm
380' S " " " mulberry cluster

1E
87' N to 3rd in triple 5' mulberry
74' SE " " " 12" elm
380' S " " " mulberry cluster

2E
387' N to E of Greenway Blvd & Allard
703' N to thimble in E of Allard
670' E to 12" elm in S parking
33' S to steel street sign post

3E
71' SW to 3rd in Elm
270' NE to E of Greenway Blvd
1488' NW " " " Blake
60' NE to 12" on curb

4E
1025' NE to SW cor of storm sewer outlet
353' E to E of Greenway & Allard
747' SE to steel street sign post
430' S to 10" elm
553' NW " 12" "

5E
In line of elm across South
274' S to 3rd in 10" elm
707' N " " " 12" "

6E
1004' S to 10" elm
282' N to steel street sign post
288' E to 10" elm in Greenway

7E
1725' S to steel street sign post
1004' NW to 3rd in 12" elm
280' E to E of Greenway & Allard

Right Bank
Sta. 92+34
X on sidewalk

1W
In line of R. West
347' SE to W.H.P. of 34' frame
337' S to steel post 8th Lawrence
2485' S " " " side of Lawrence

2E
347' S to steel post 8th Lawrence
380' SW " " " " 12" "

3W
25' N to R.H.S.
81' N to 3rd in 12" mulberry cluster

4W
347' N to cor to post of R.H.S.
108' N to 3rd in 12" mulberry cluster
In line of R. West

5W
174' E to 3rd in 8' mulberry cluster

6W
No ties

7W
Iron Pipe
364' SE to NW headwall sewer outlet
750' NW to R.R. tie to post

8W
382' NW to 12" mulberry cluster
In line of R. West

9W
384' N to 3rd in 12" elm

10W
1004' S to 10" elm

11W
170' E to 12" elm in NW
295' NE " " " 4" box elder
483' NW " " " 10" elm

12W
29' N to cor to post
10' N to R. East