

S. NO.	TOTAL
13	9


THE URBAN RENEWAL AGENCY
OF THE
WICHITA, KANSAS METROPOLITAN AREA
WICHITA, KANSAS
AS CONSTRUCTED
PLANS FOR

DRAINAGE & STREET IMPROVEMENTS

WACO-FINN PROJECT KANSAS A-5-1
PHASE II, PART 3


INDEX

1. TITLE SHEET
2. TYPICAL SECTIONS
3. 23RD STREET SIDEWALK AND RETAINING WALL PLAN
4. 24TH STREET SIDEWALK AND RETAINING WALL PLAN
5. WOODLAND AVENUE SIDEWALK AND RETAINING WALL PLAN
6. JEANETTE AVENUE SIDEWALK AND RETAINING WALL PLAN
7. MASCO AVENUE AND SHELTON AVENUE SIDEWALK AND RETAINING WALL PLAN
8. SHELTON AVENUE SIDEWALK AND RETAINING WALL PLAN
9. SHELTON AVENUE SIDEWALK AND RETAINING WALL PLAN

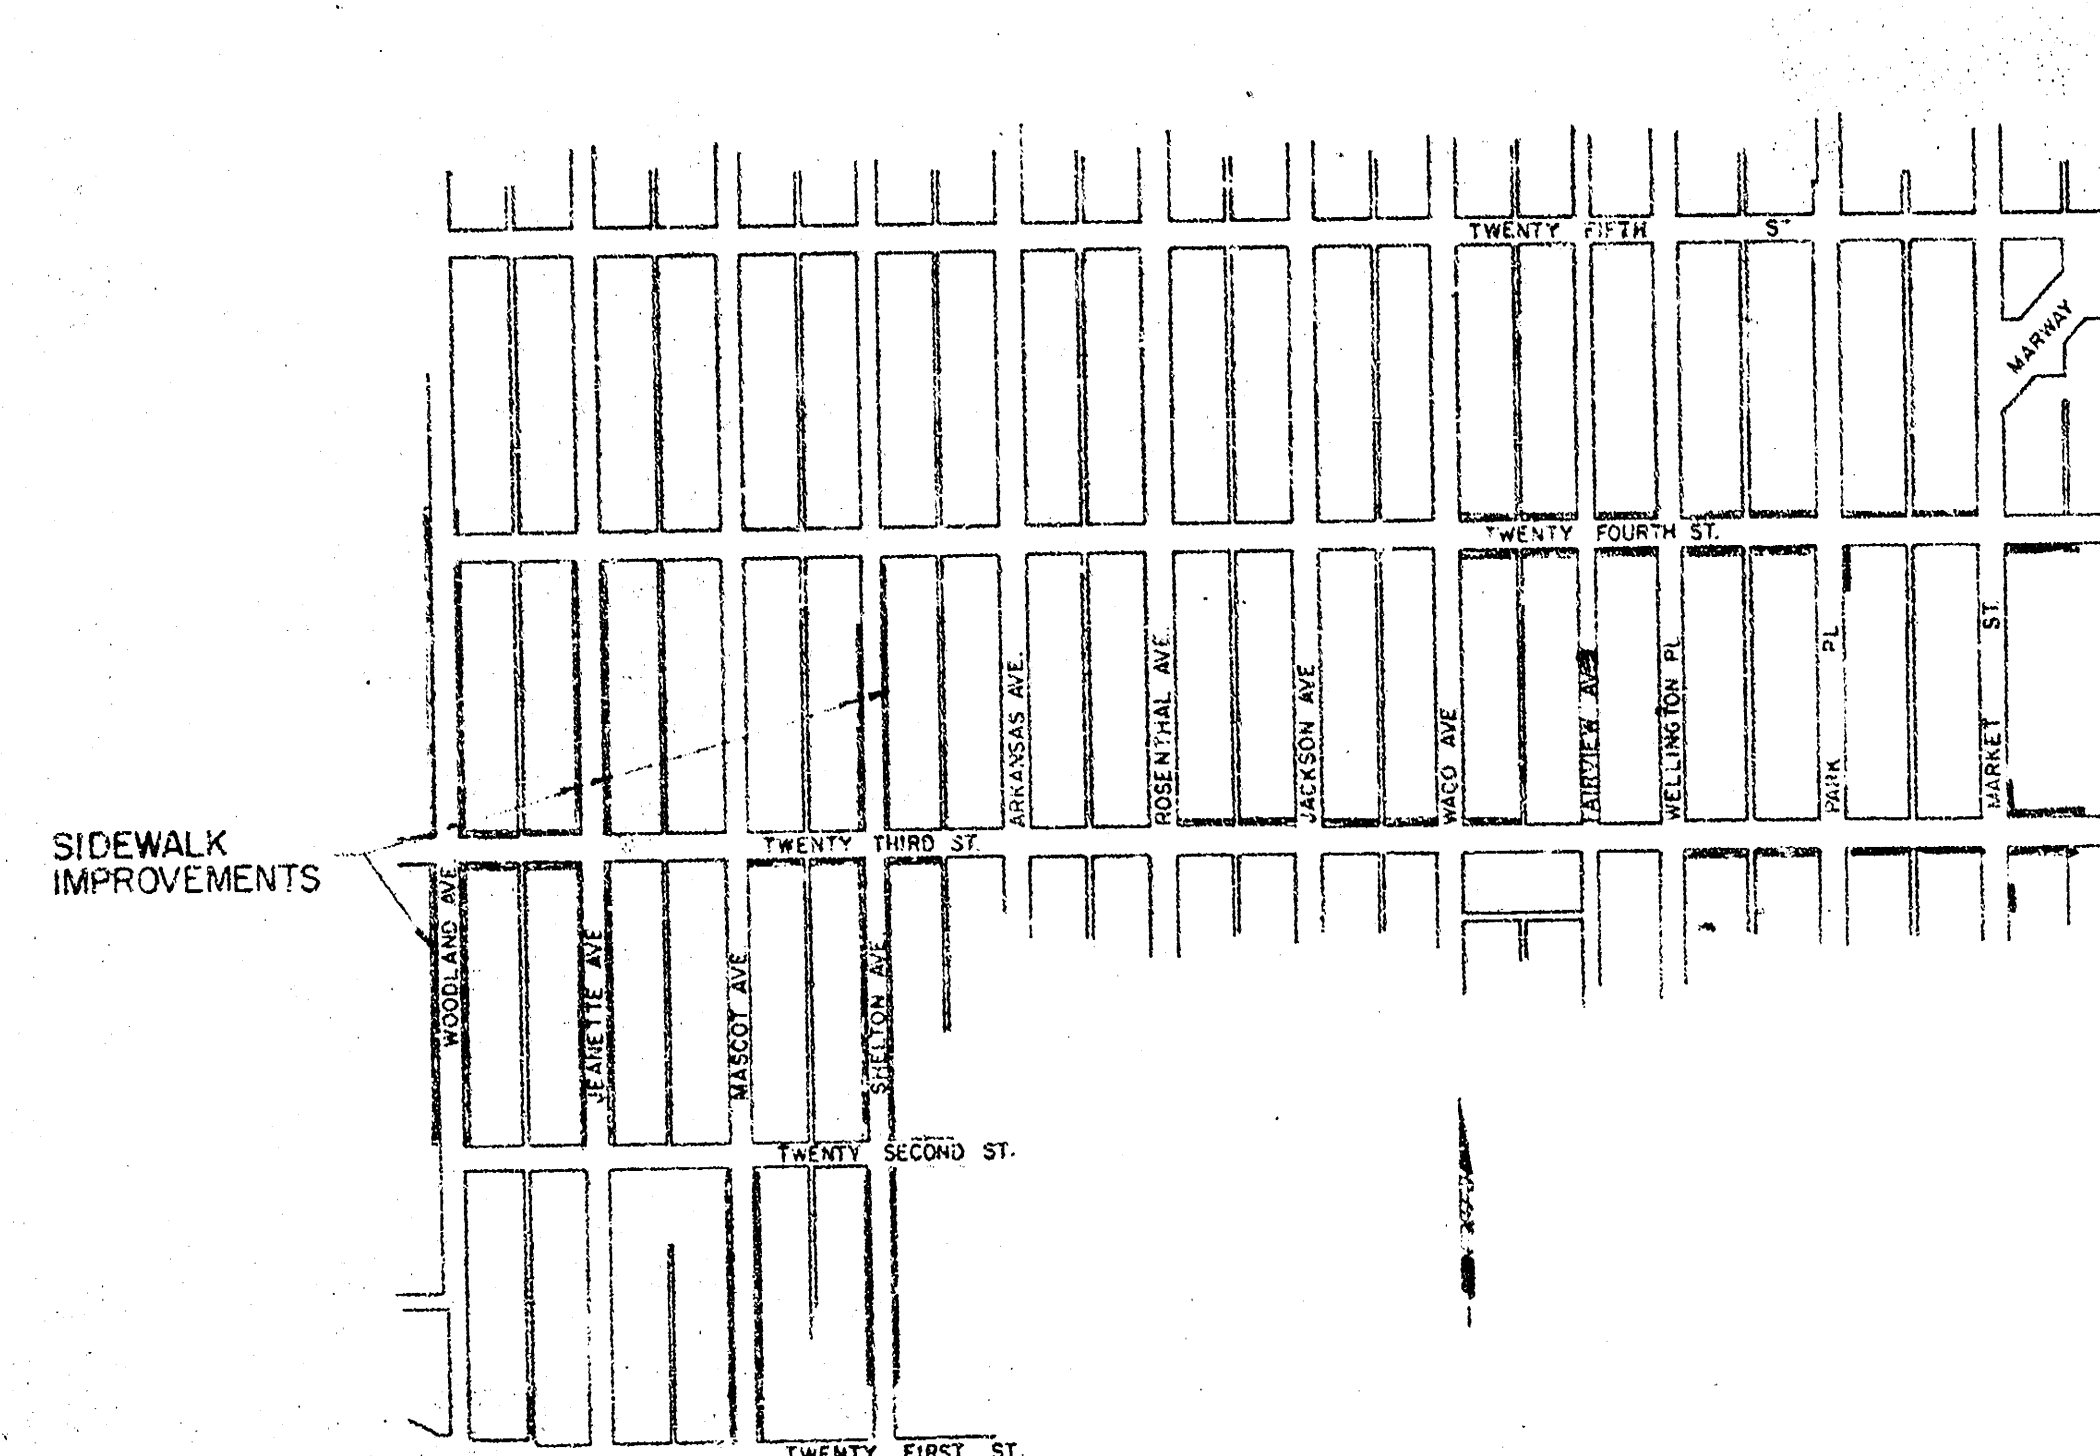


JULY, 1971

PROFESSIONAL ENGINEERING CONSULTANTS
ENGINEERS
WICHITA, KANSAS

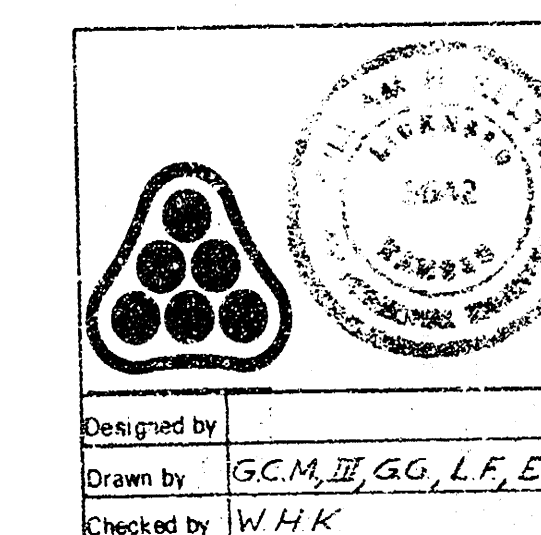


REV. NO.	DESCRIPTION	DATE	BY
1	As Constructed	8-31-72	G.L.K.
SUBMITTED JUL 14 1971			
PHASE II, PART 3			
THE URBAN RENEWAL AGENCY WICHITA, KANSAS METROPOLITAN AREA			
TITLE SHEET & INDEX			
WACO-FINN PROJECT KANS. A-5-1			
PROFESSIONAL ENGINEERING CONSULTANTS ENGINEERS WICHITA, KANSAS			


SHEET NO.	TOTAL SHEETS
2-3	9

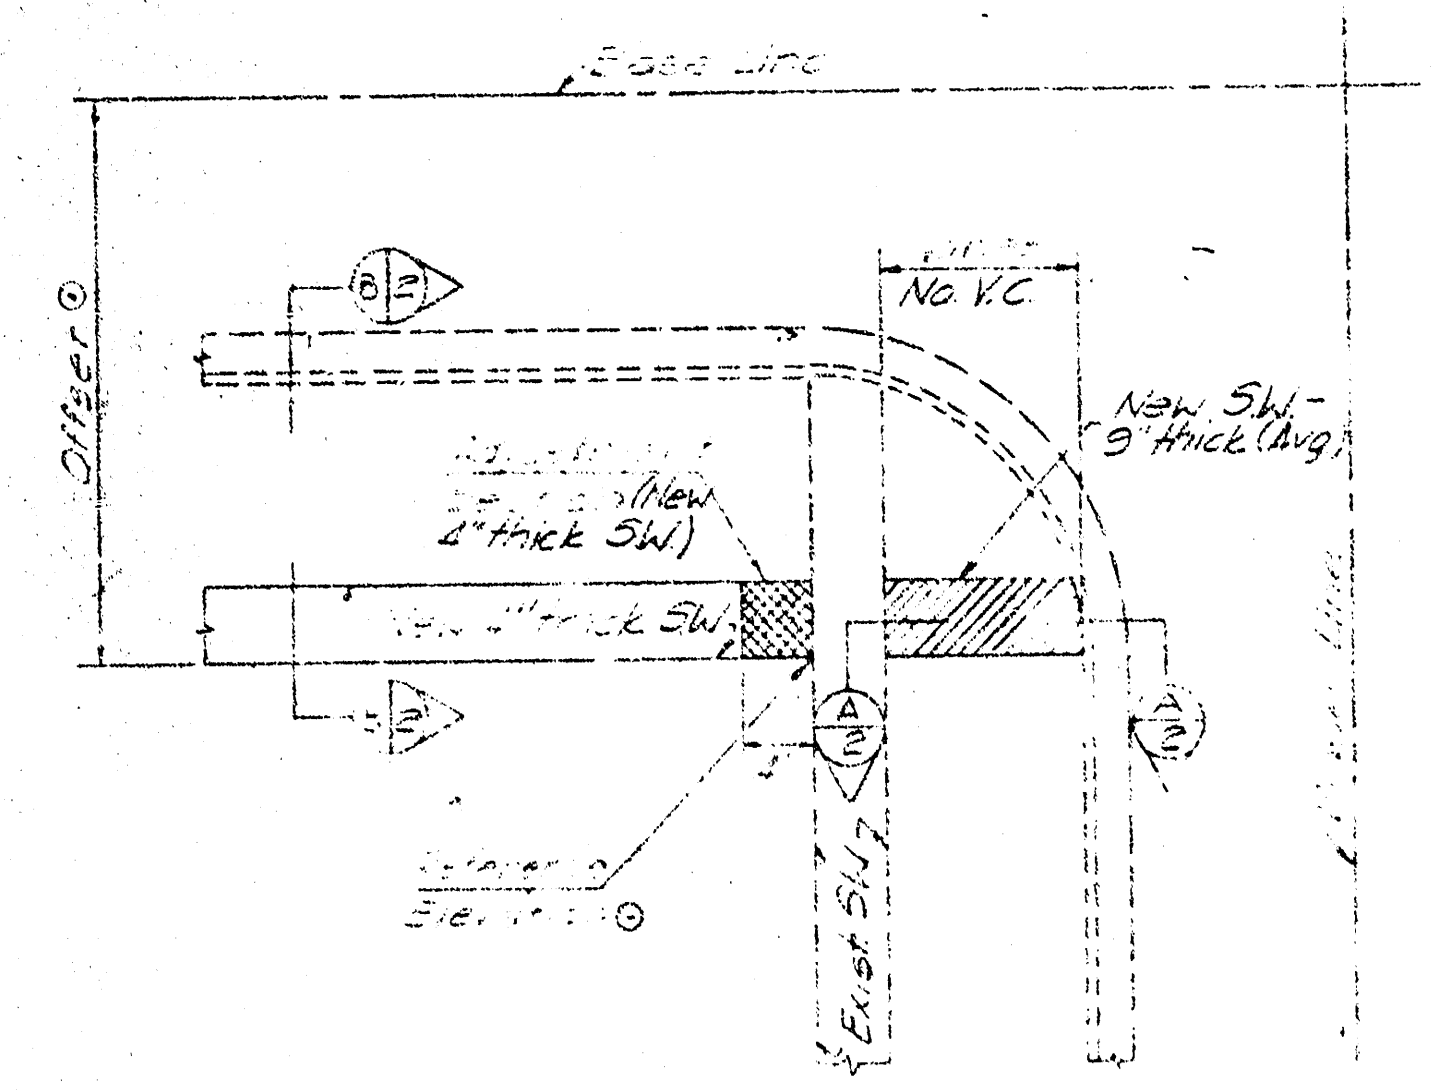

TYPICAL SIDEWALK INTERSECTION
(New Sidewalk)

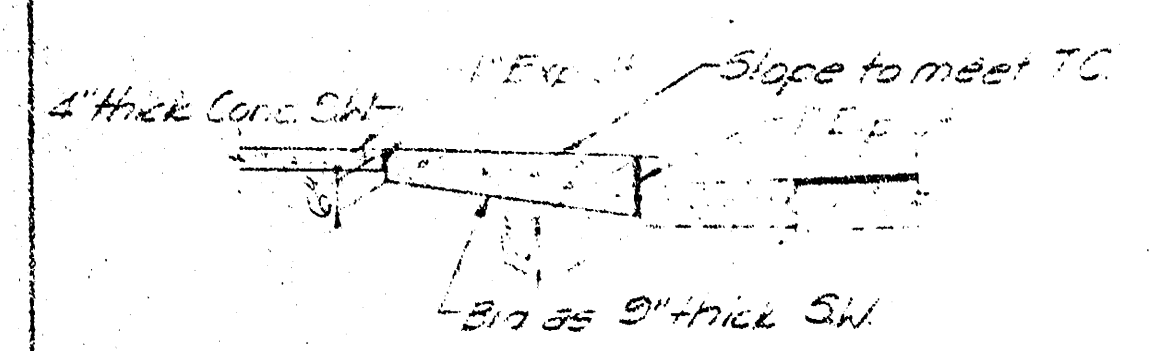


SECTION 1

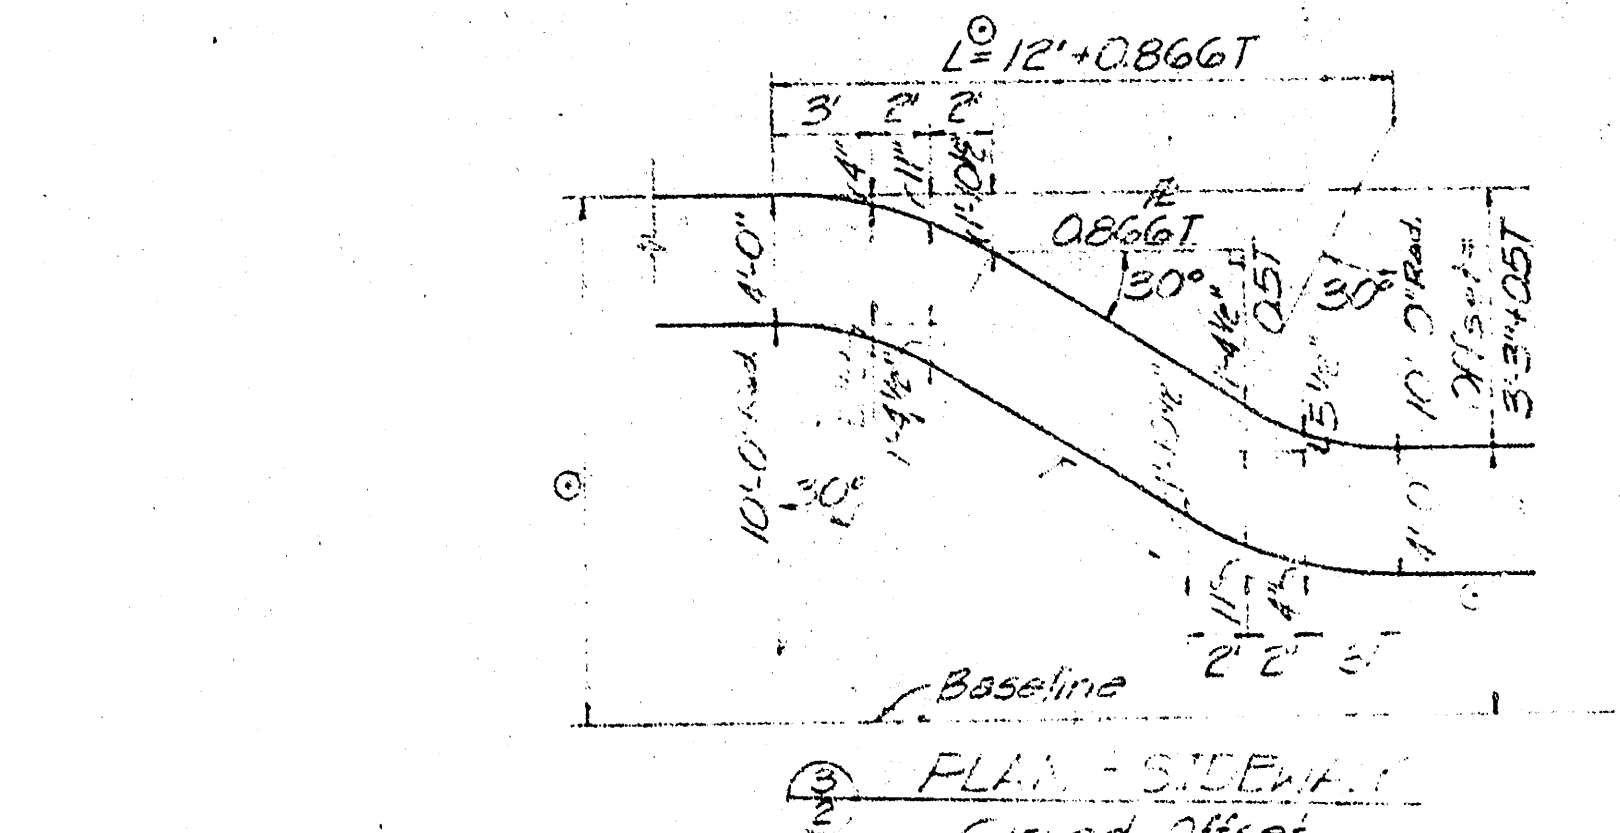


PLAN - SIDEWALK
Curb Offset

4'-0\"/>

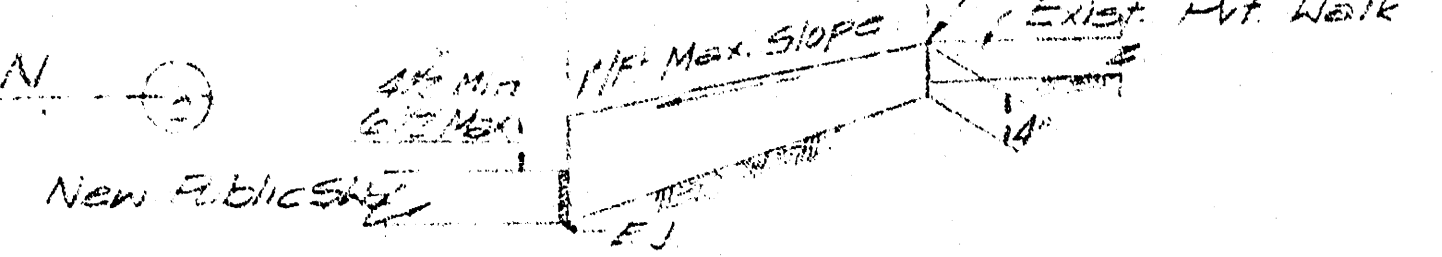


SECTION 2

CONNECTION TO EXISTING
Private Residence Walk

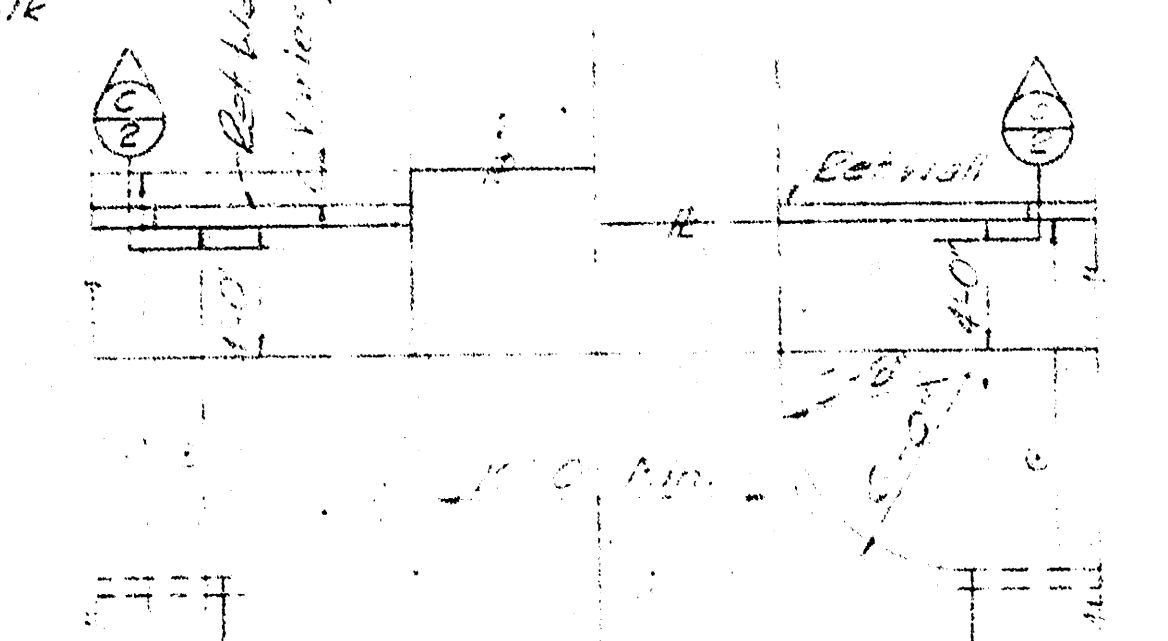


SECTION 3

PLAN - TYPED RETAINING WALL
to Standard Residence Drive

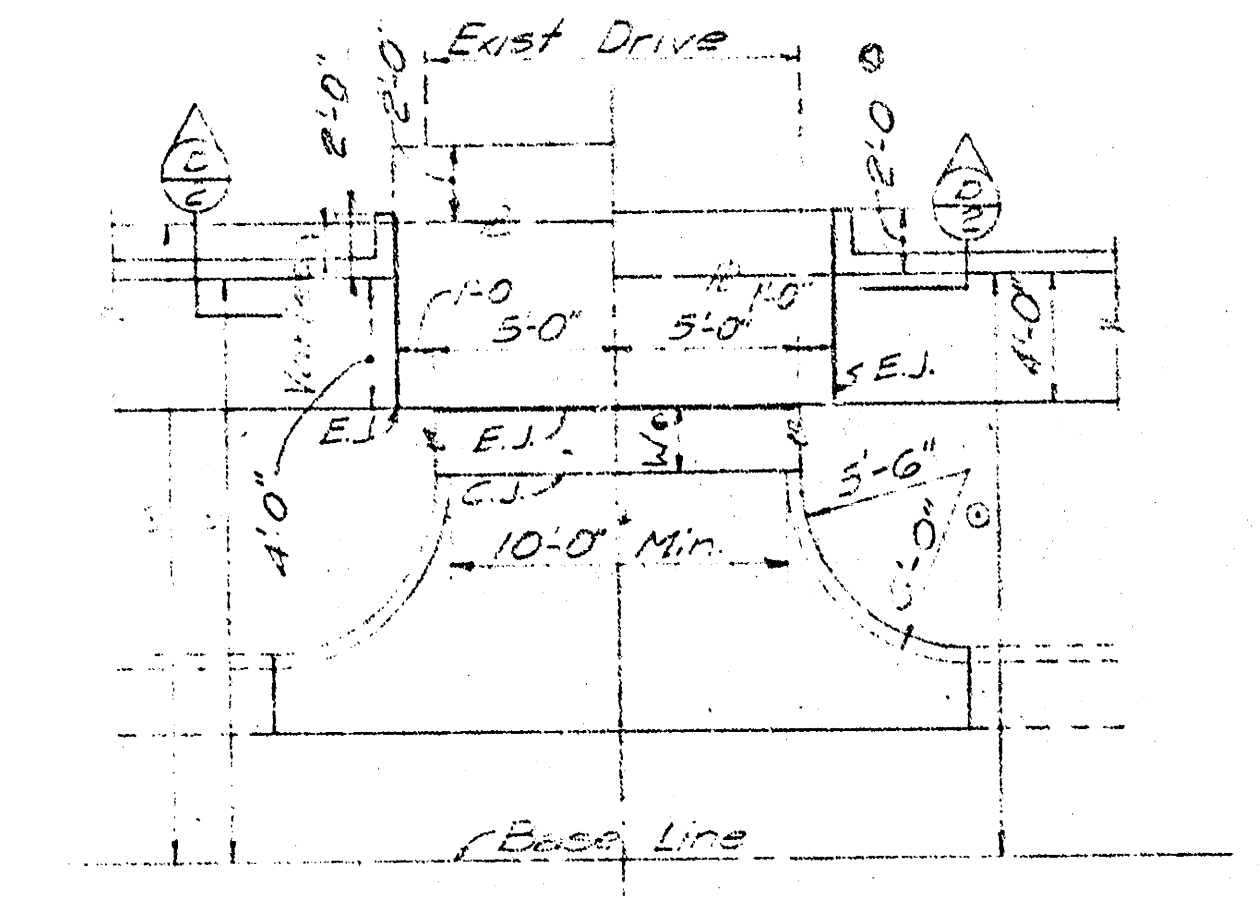


SECTION 4


PLAN - TURNED RETAINING WALL
to Standard Residence Drive

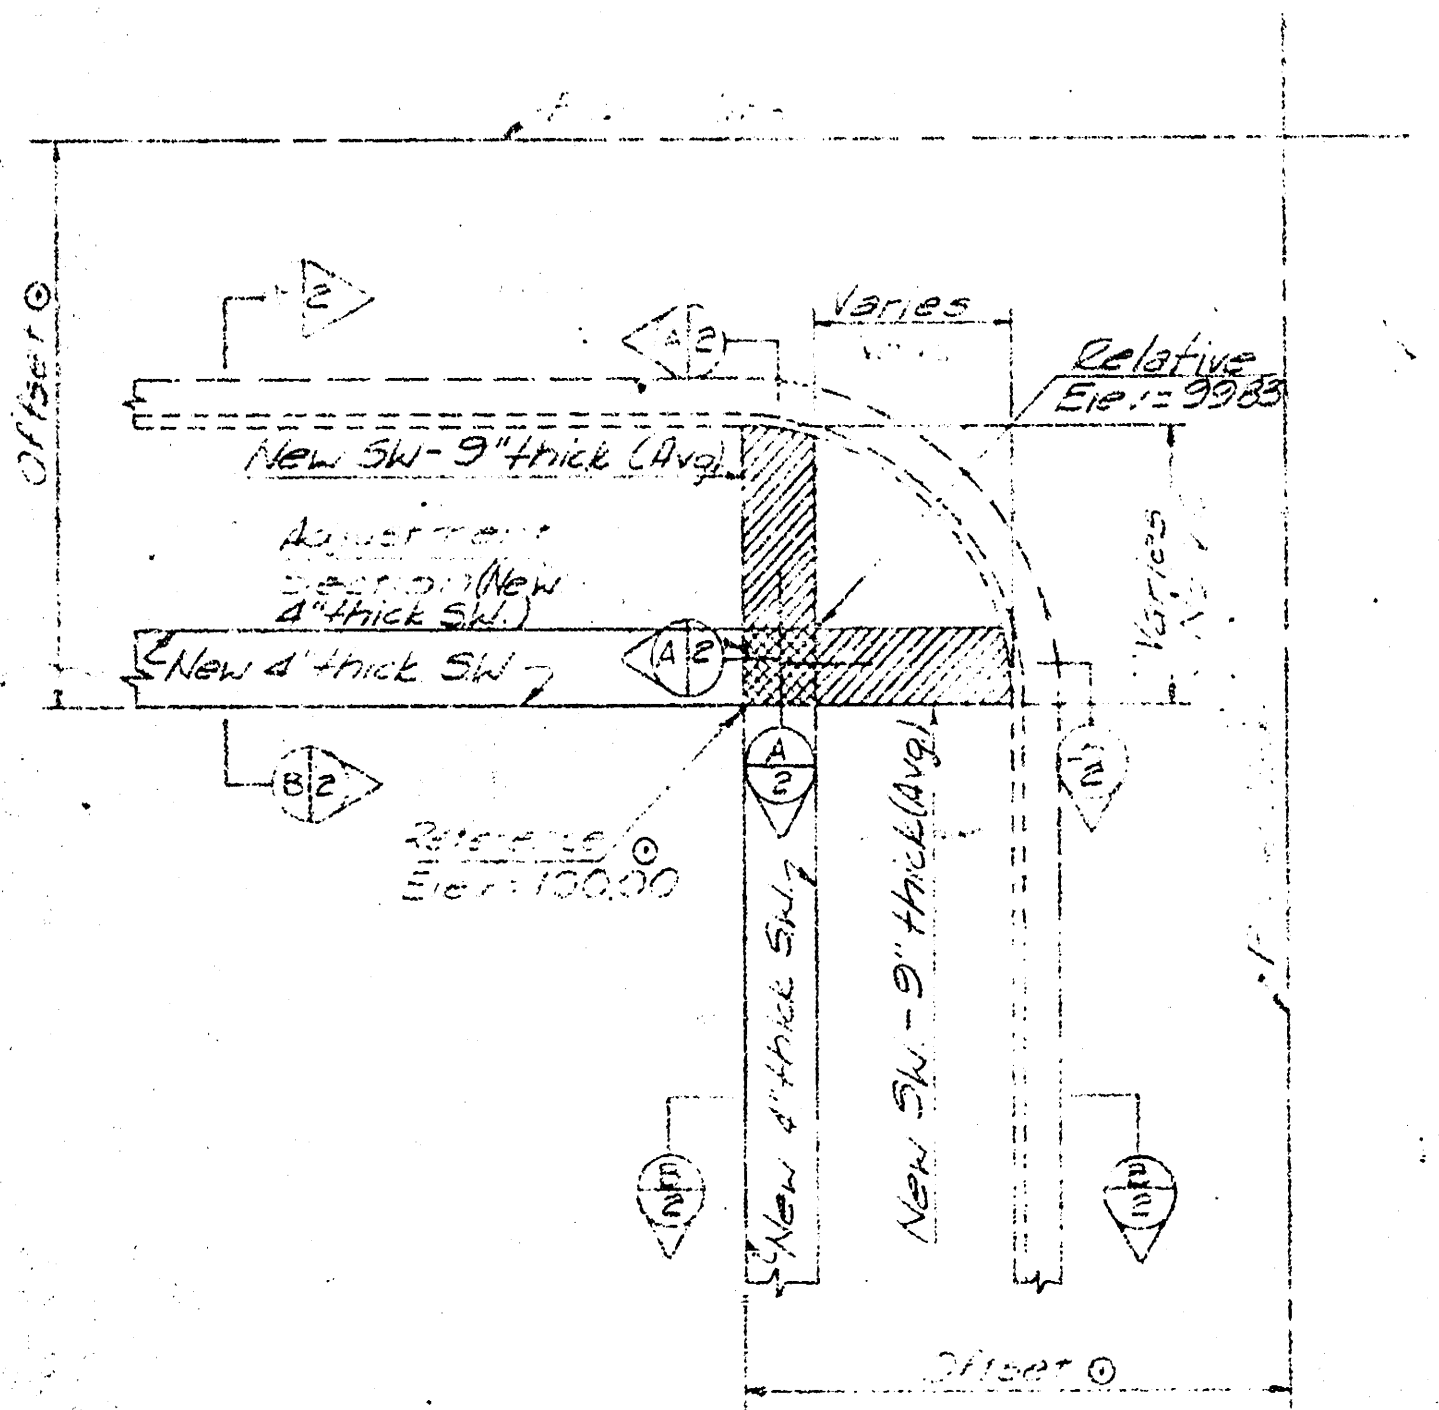

TYPICAL SIDEWALK INTERSECTION
(All New Sidewalk)

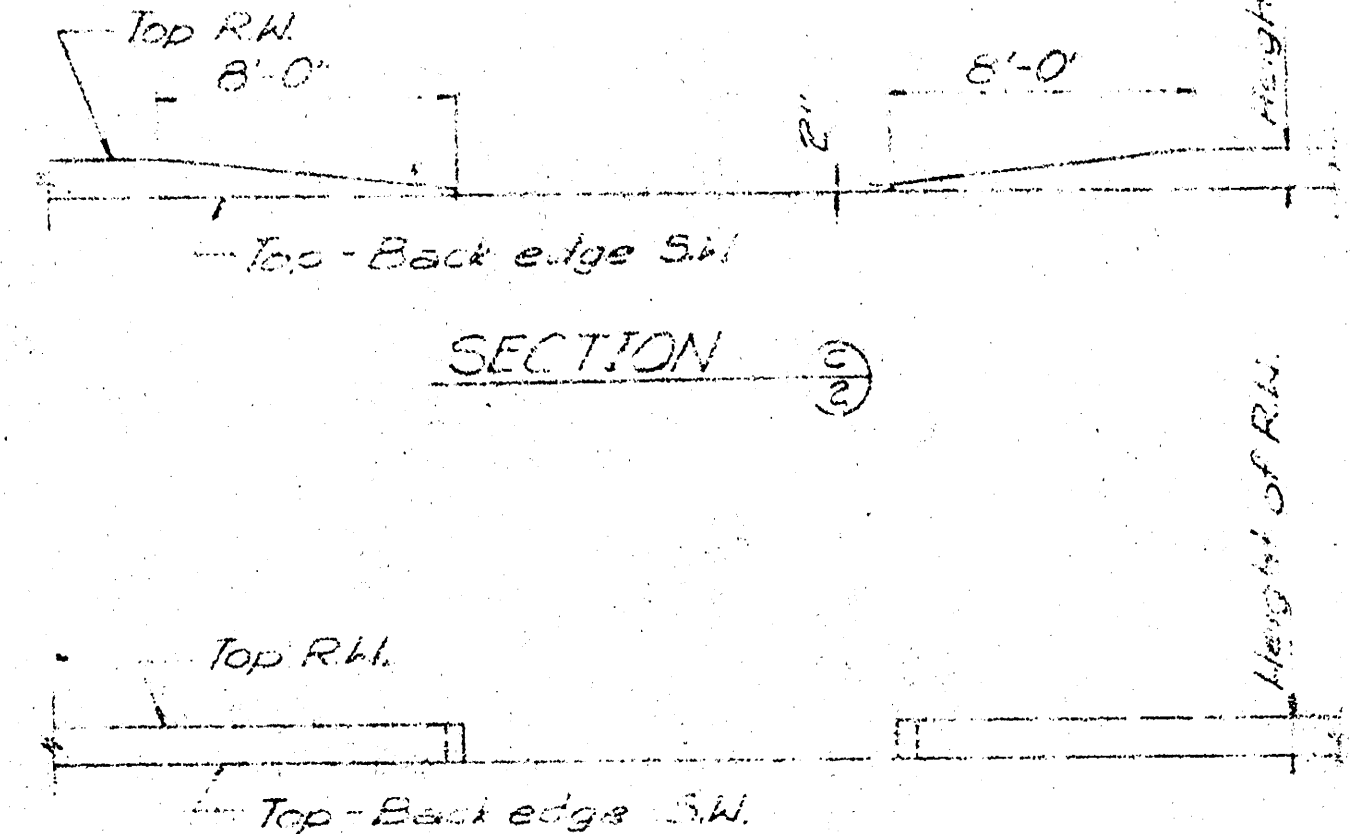


SECTION 5

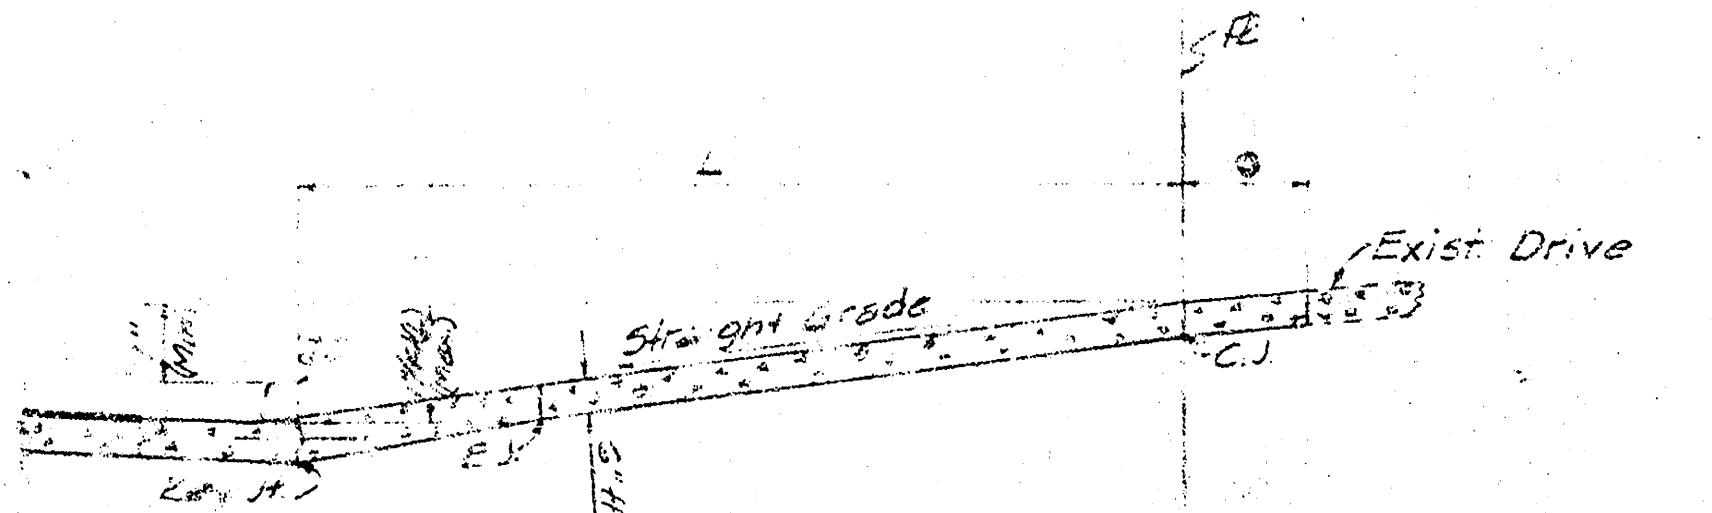


SECTION 6

- Noted on Plan Sheets
- Except as noted on plan sheets.
- Const connection to Exist drive -
- Use Const Joint (C.J.) only when W is greater than 4'-0\"/>

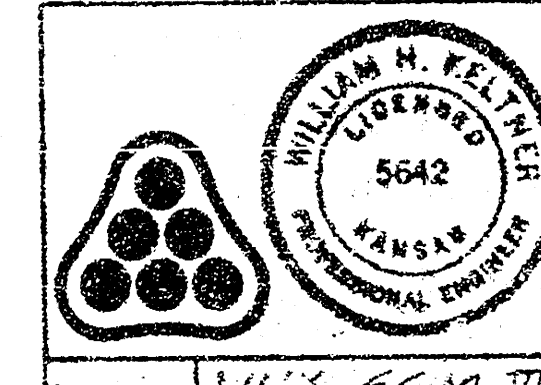

1	As Constructed	8-31-72	G.L.R.
REV. NO.	DESCRIPTION	DATE	BY
SUBMITTED	JUL 21 1971		
PHASE II, PART 3			
THE URBAN RENEWAL AGENCY WICHITA, KANSAS METROPOLITAN AREA			
TYPICAL SECTIONS SIDEWALK IMPROVEMENTS 1			
WACO-FINN PROJECT KANS. A-5-1			
PROFESSIONAL ENGINEERING CONSULTANTS ENGINEERS WICHITA, KANSAS			

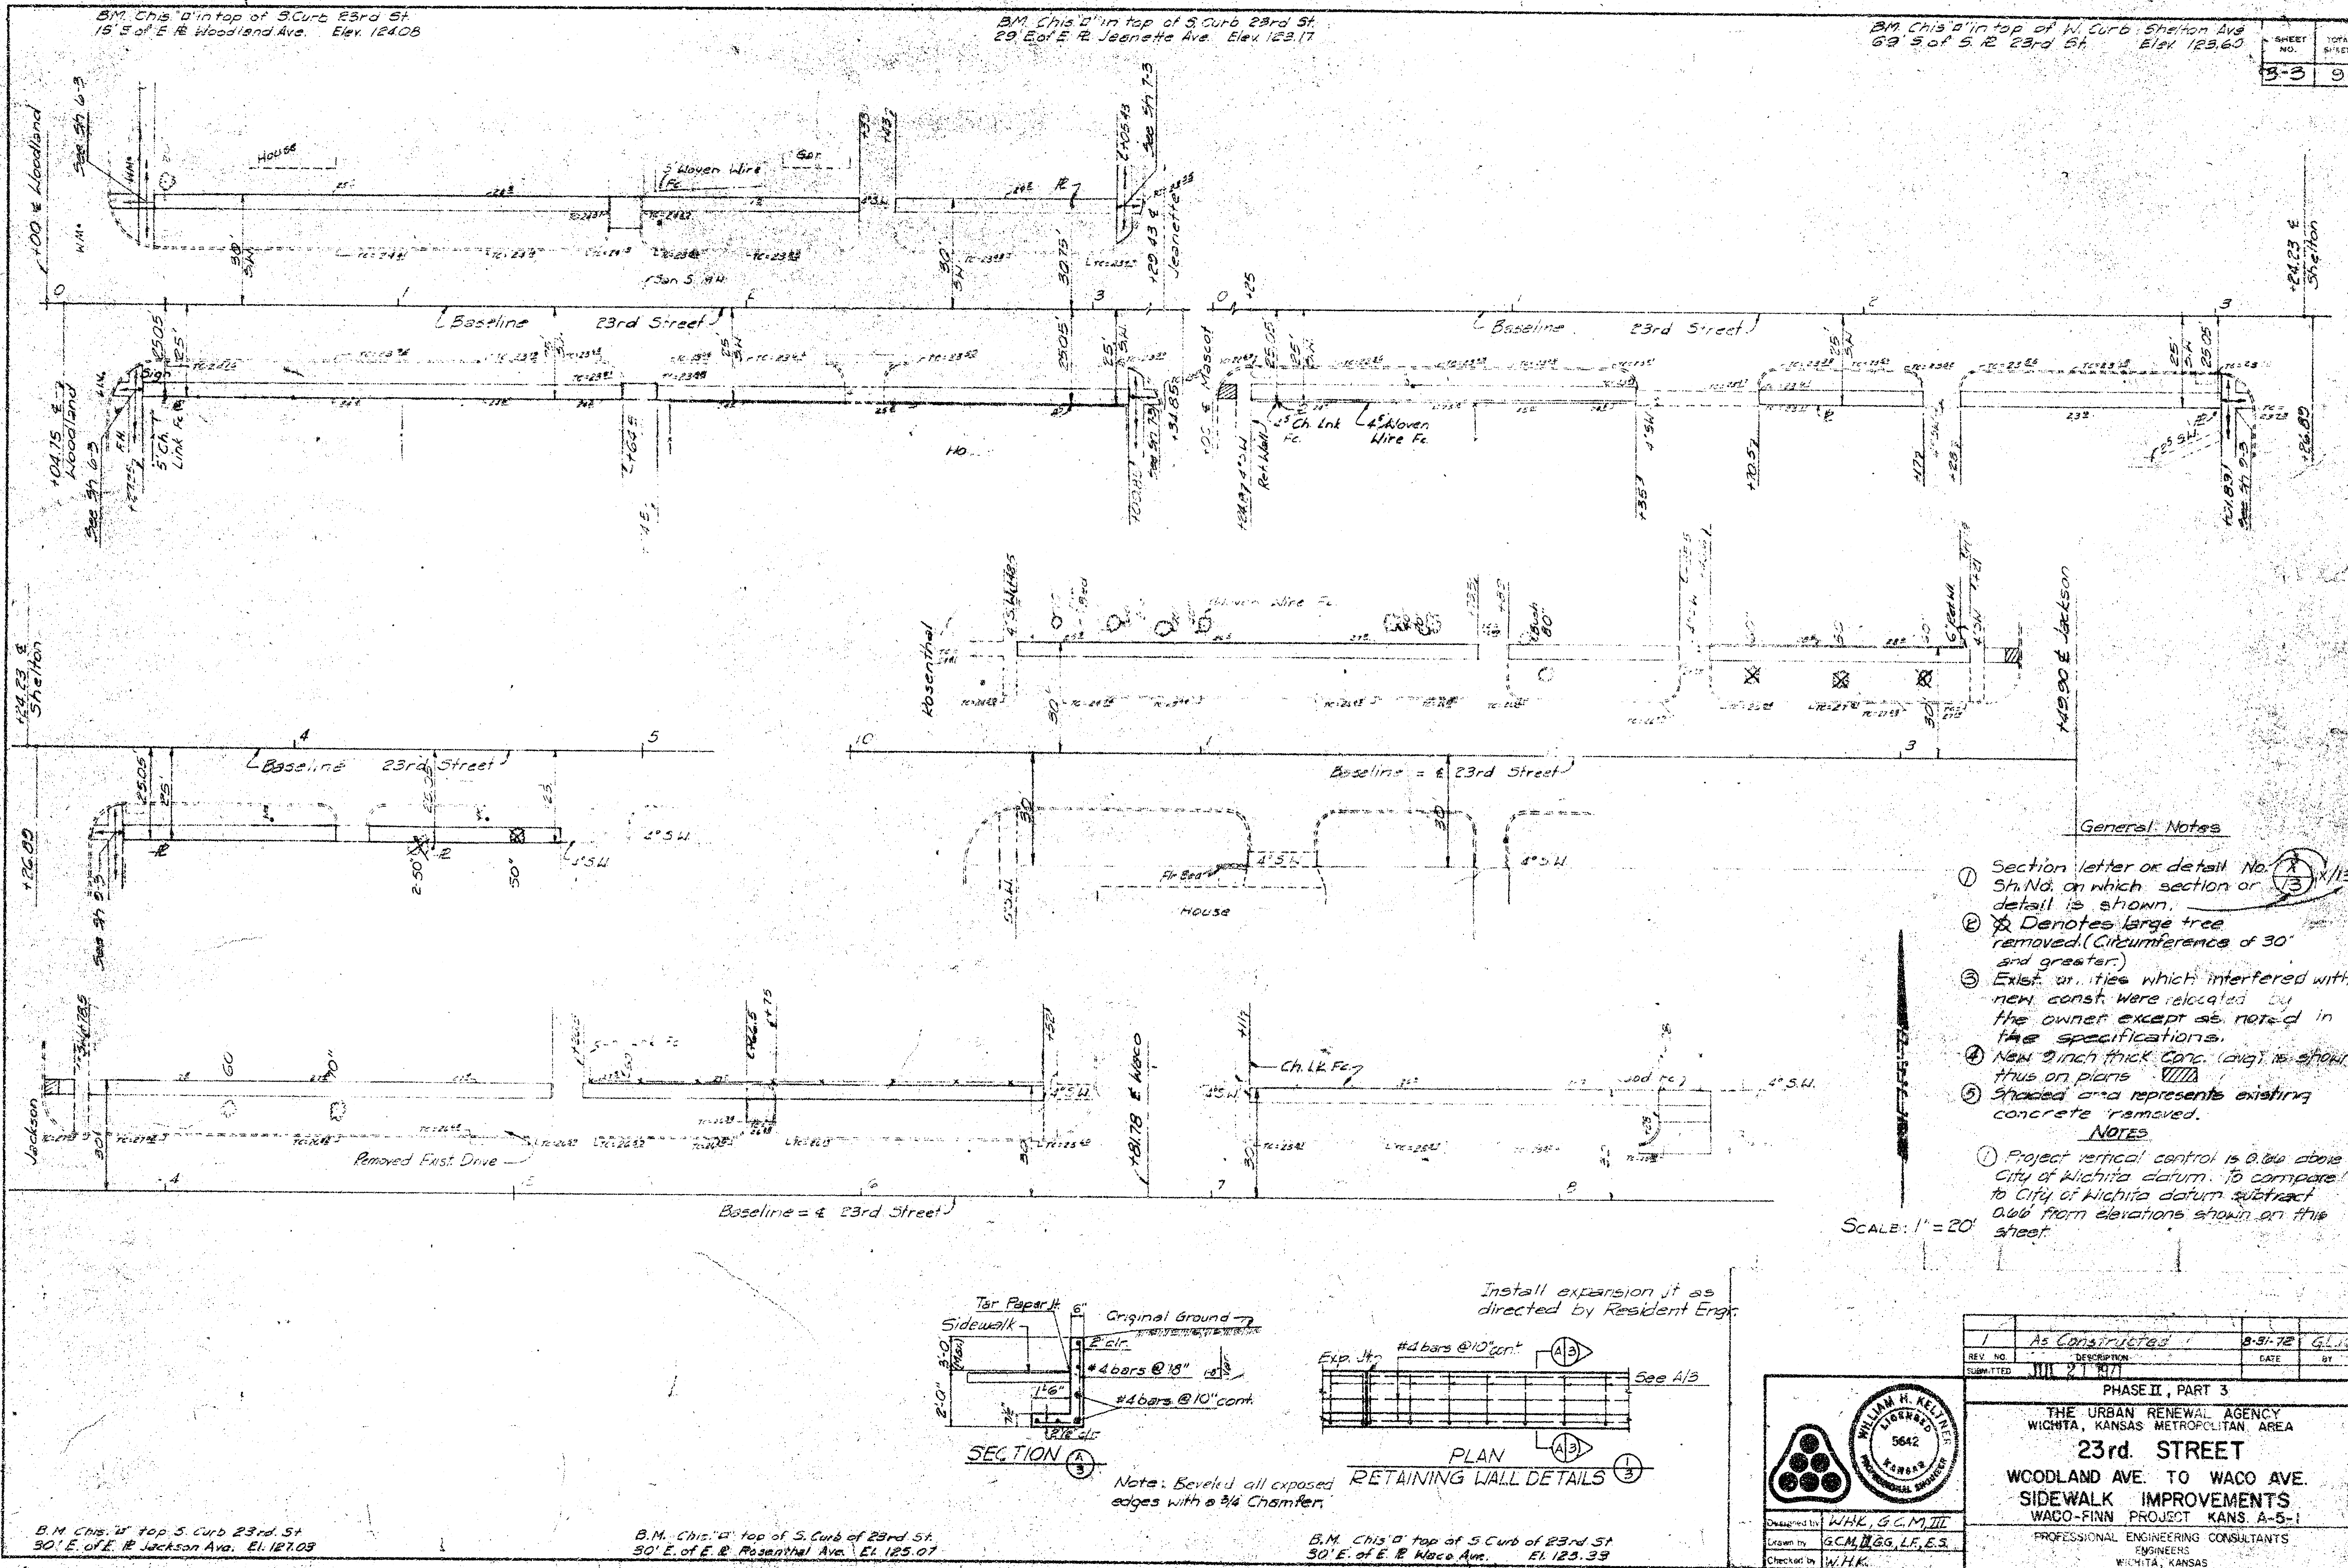


General Notes

- 1 Section letter or detail No. 13/13 Sh. No. on which section or detail is shown.
- 2 Denotes large tree removed (Circumference of 30" and greater).
- 3 Exist. utilities which interfered with new const. were relocated by the owner except as noted in the specifications.
- 4 New 2 inch thick conc. (light) is shown true on plans.
- 5 Shaded area represents existing concrete removed.

NOTES


- 1 Project vertical control is 0.40 above City of Wichita datum. To compare to City of Wichita datum subtract 0.40 from elevations shown on this sheet.

Scale: 1" = 20'

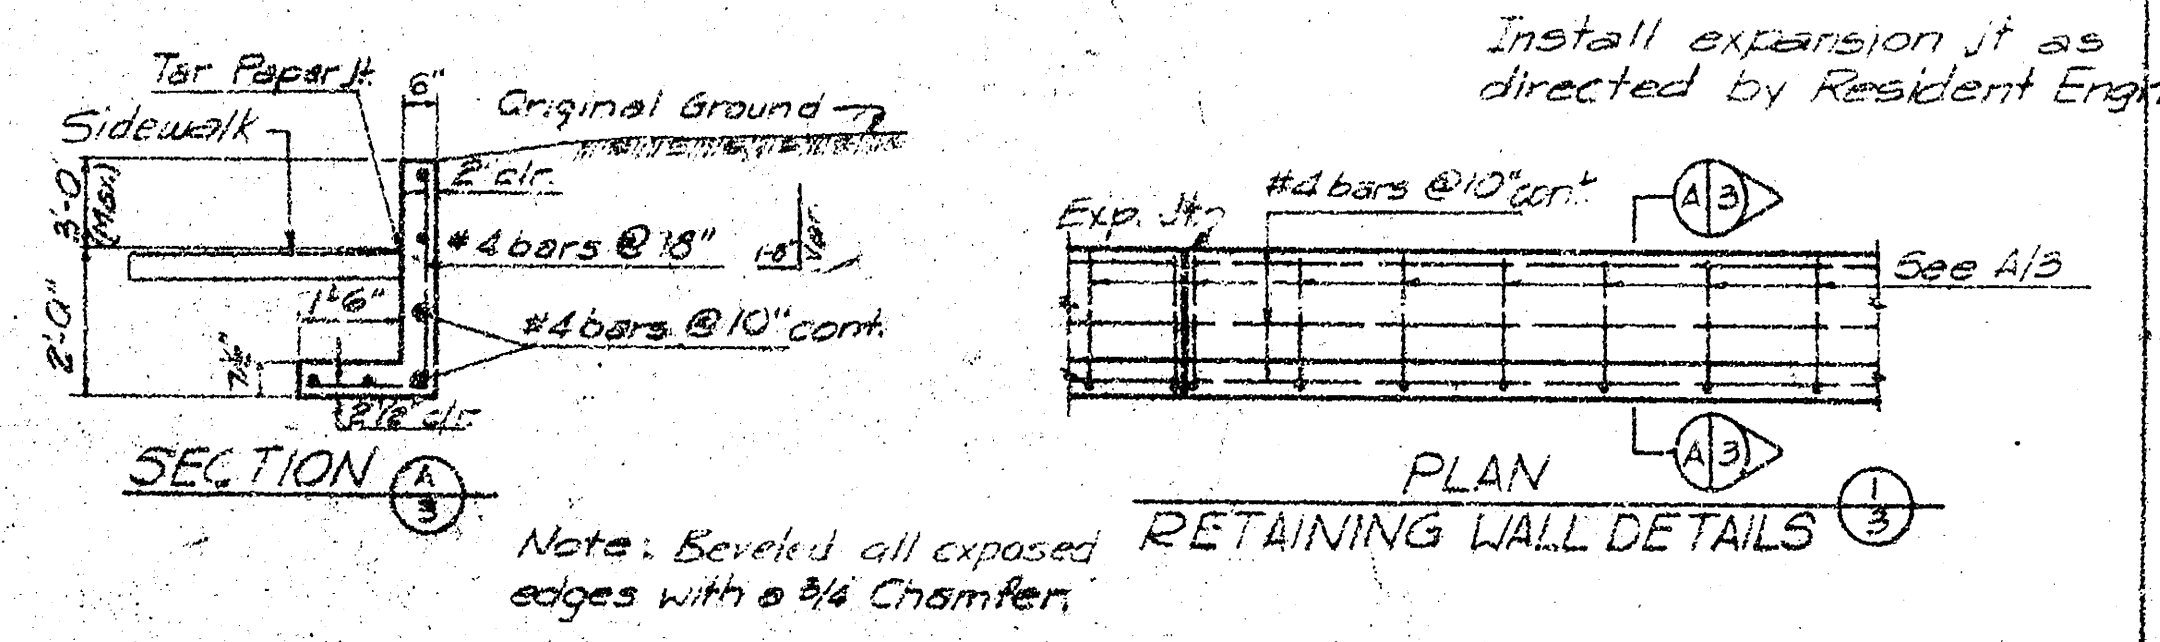

Note: Beveled all exposed edges with a 3/4 Chamfer.

RETAINING WALL DETAILS

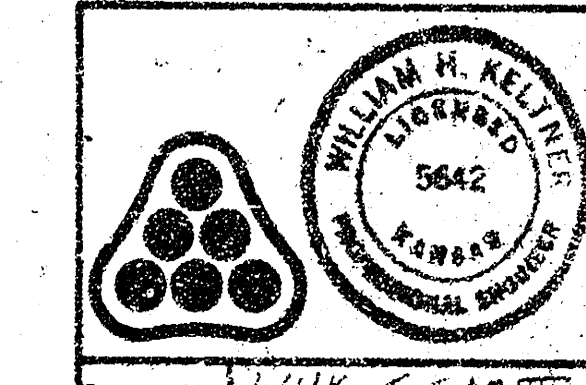









Designed by: W.H.K. G.C.M. III
Checked by: G.C.M. III, L.E., E.S.
Checked by: W.H.K.

1	As Constructed	8-31-78	G.L.K.
REV. NO.	DESCRIPTION	DATE	BY
SUBMITTED	JUL 21 1977		
PHASE II, PART 3			
THE URBAN RENEWAL AGENCY WICHITA, KANSAS METROPOLITAN AREA			
23rd STREET			
WOODLAND AVE. TO WACO AVE.			
SIDEWALK IMPROVEMENTS			
WACO-FINN PROJECT KANS. A-5-1			
PROFESSIONAL ENGINEERING CONSULTANTS			
WICHITA, KANSAS			

B.M. Chis. "D" top of E. Curb of Wellington Pl.
25' S. of S. R. 23rd St. El. 124.70

B.M. Chis. "D" top of E. Curb of Park Pl.
25' S. of S. R. of 23rd St. El. 125.98


SHEET NO.	TOTAL SHEETS
4-5	5

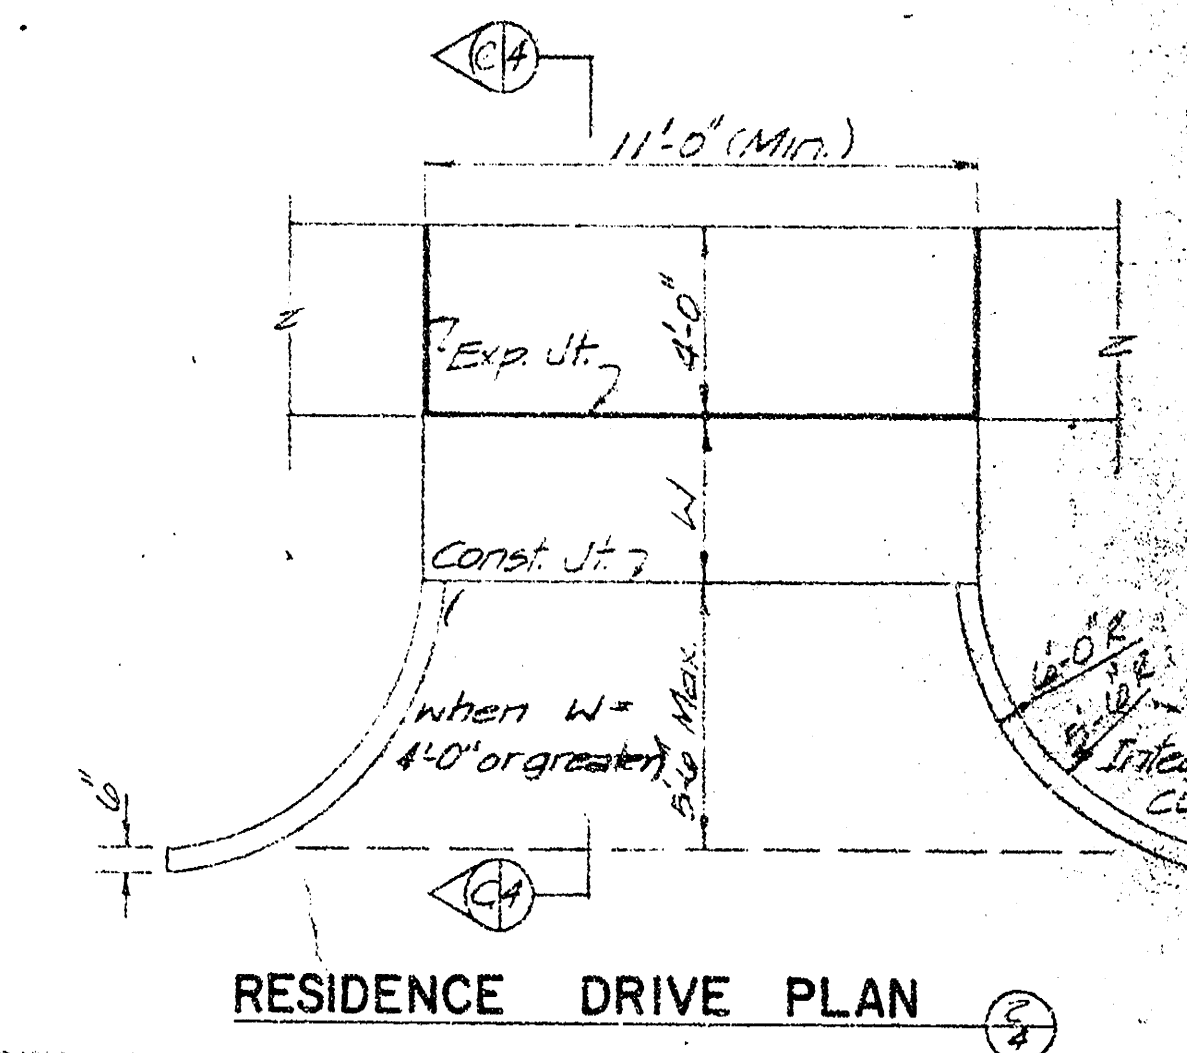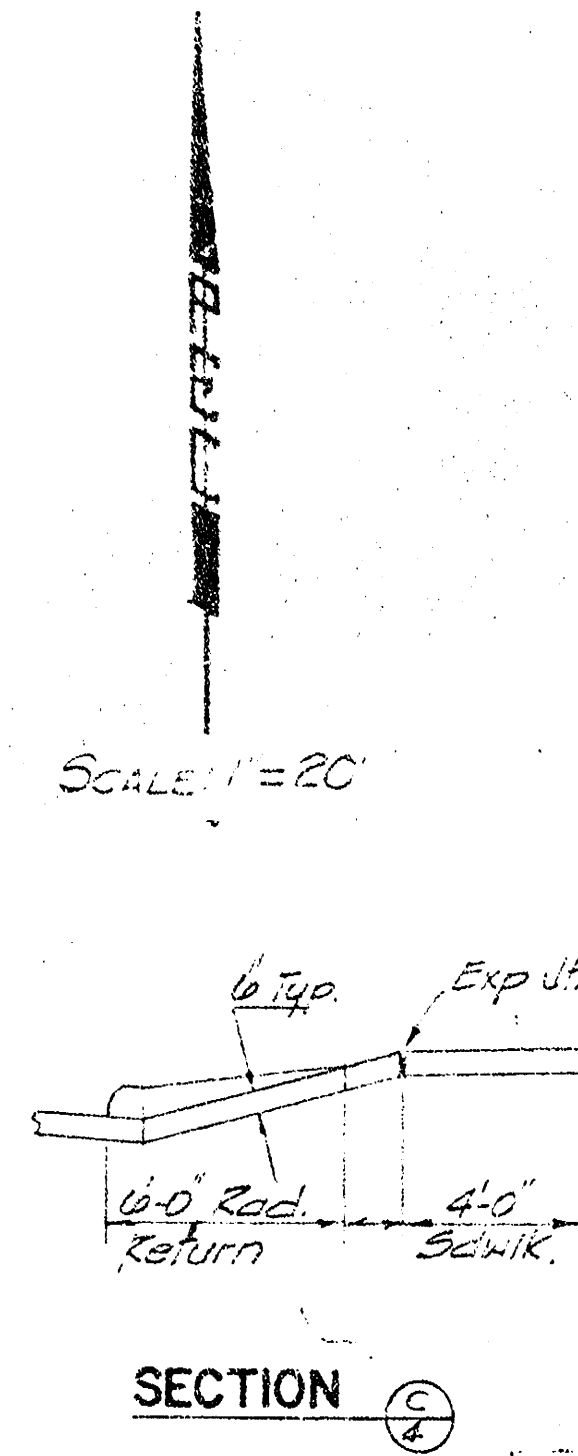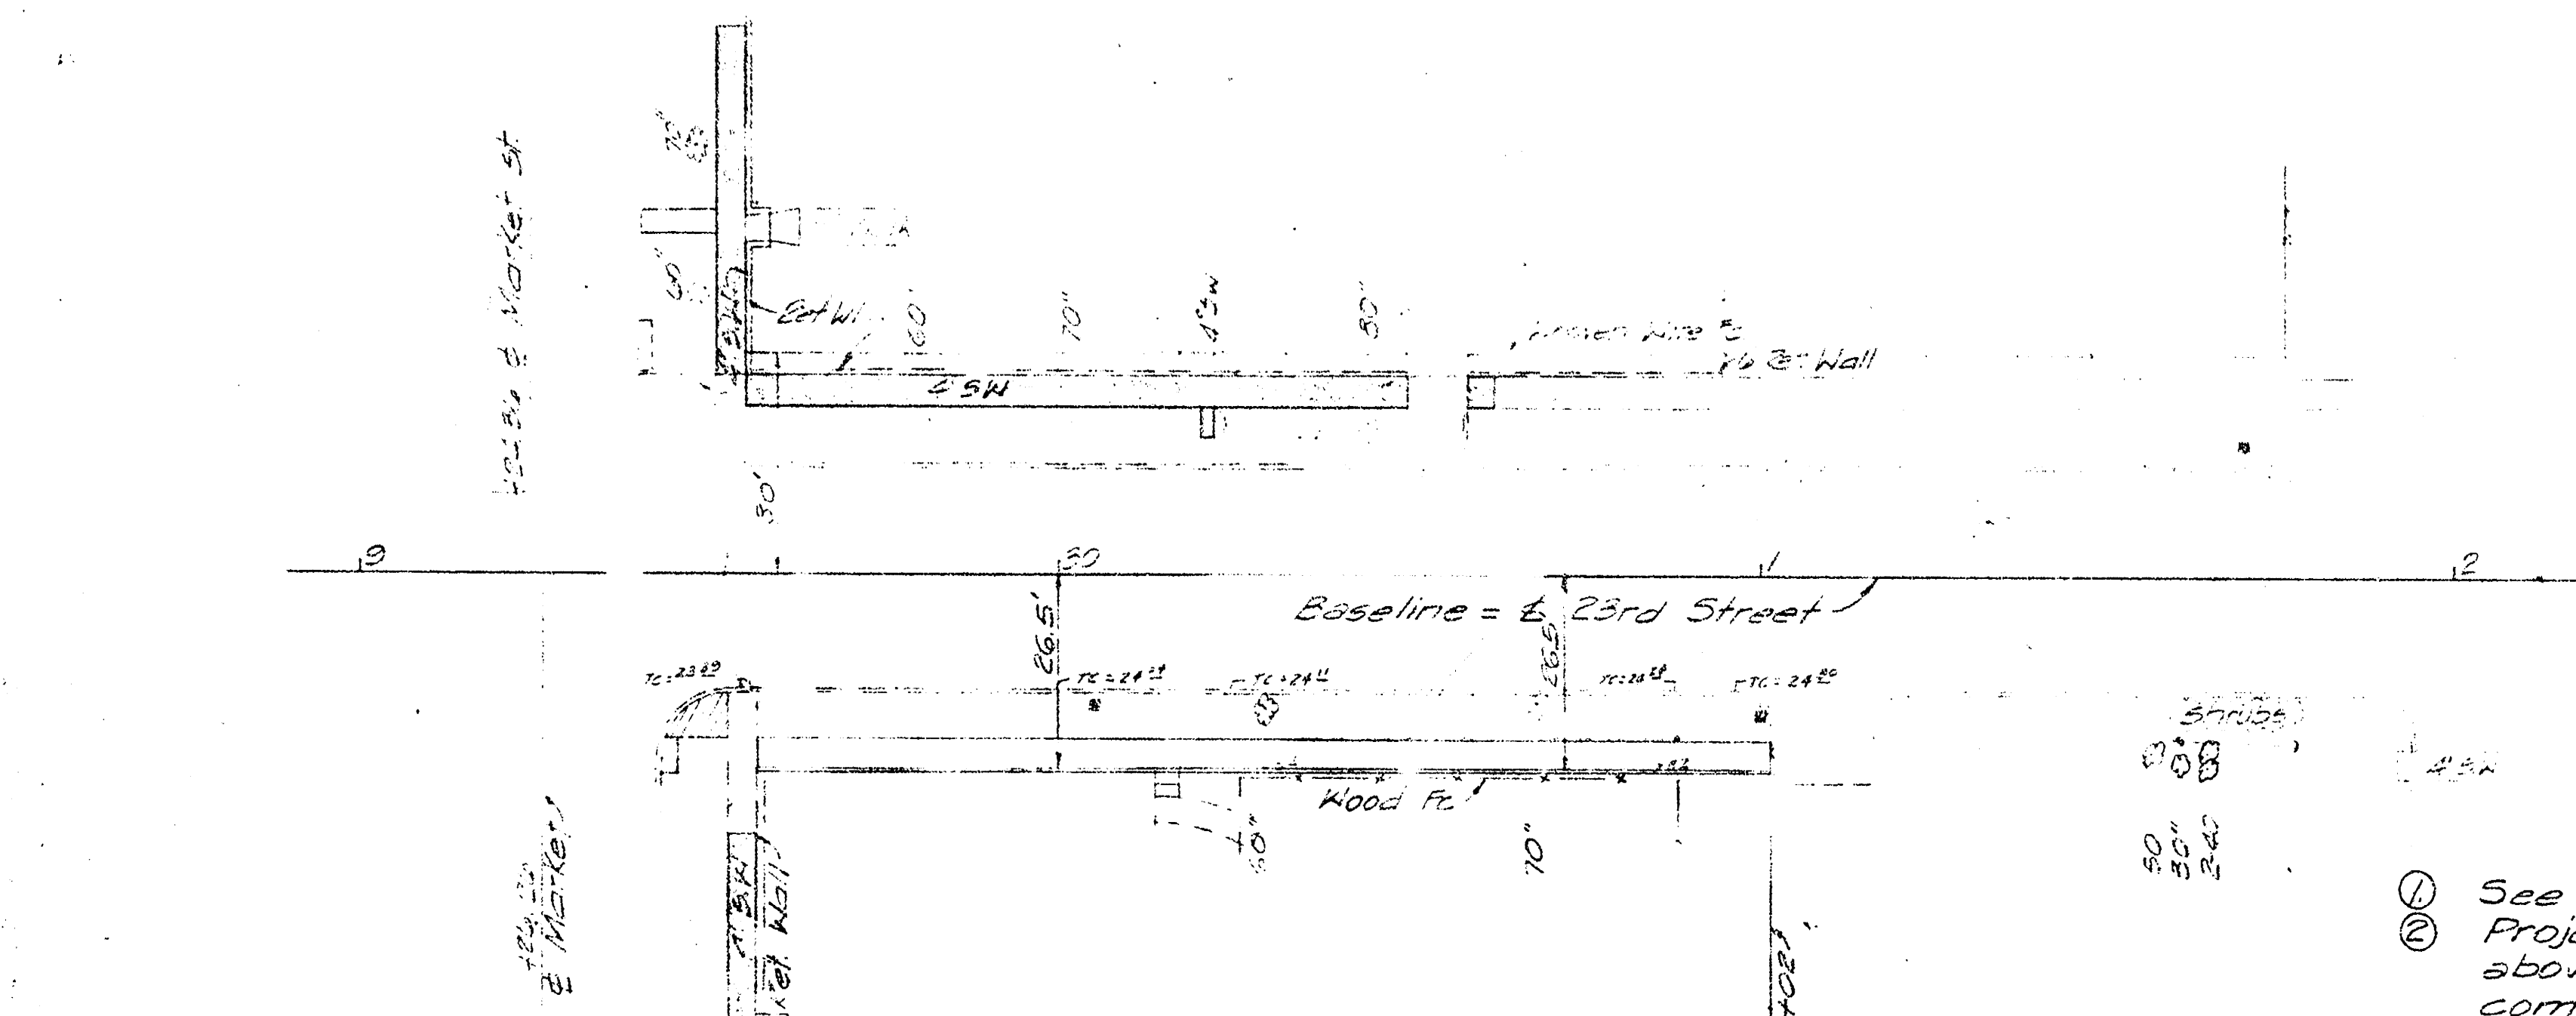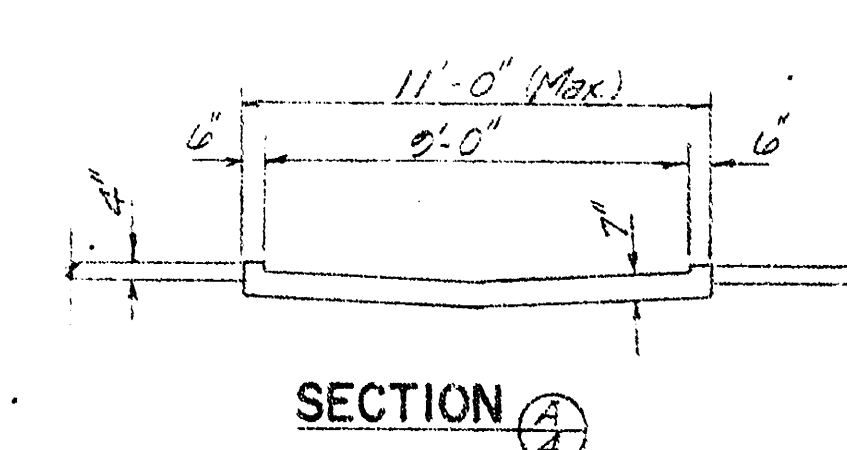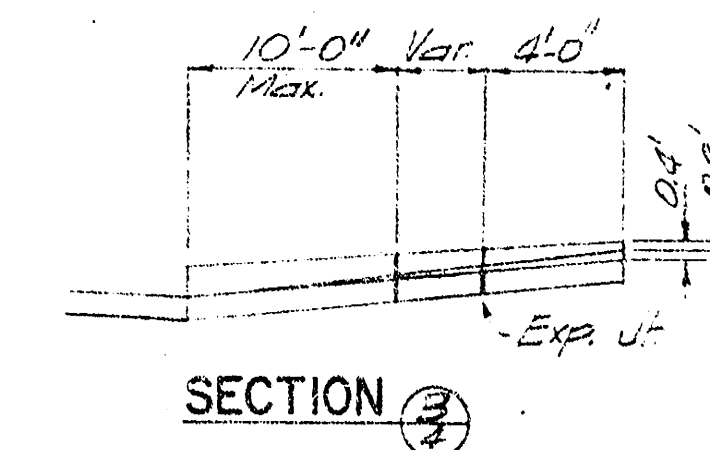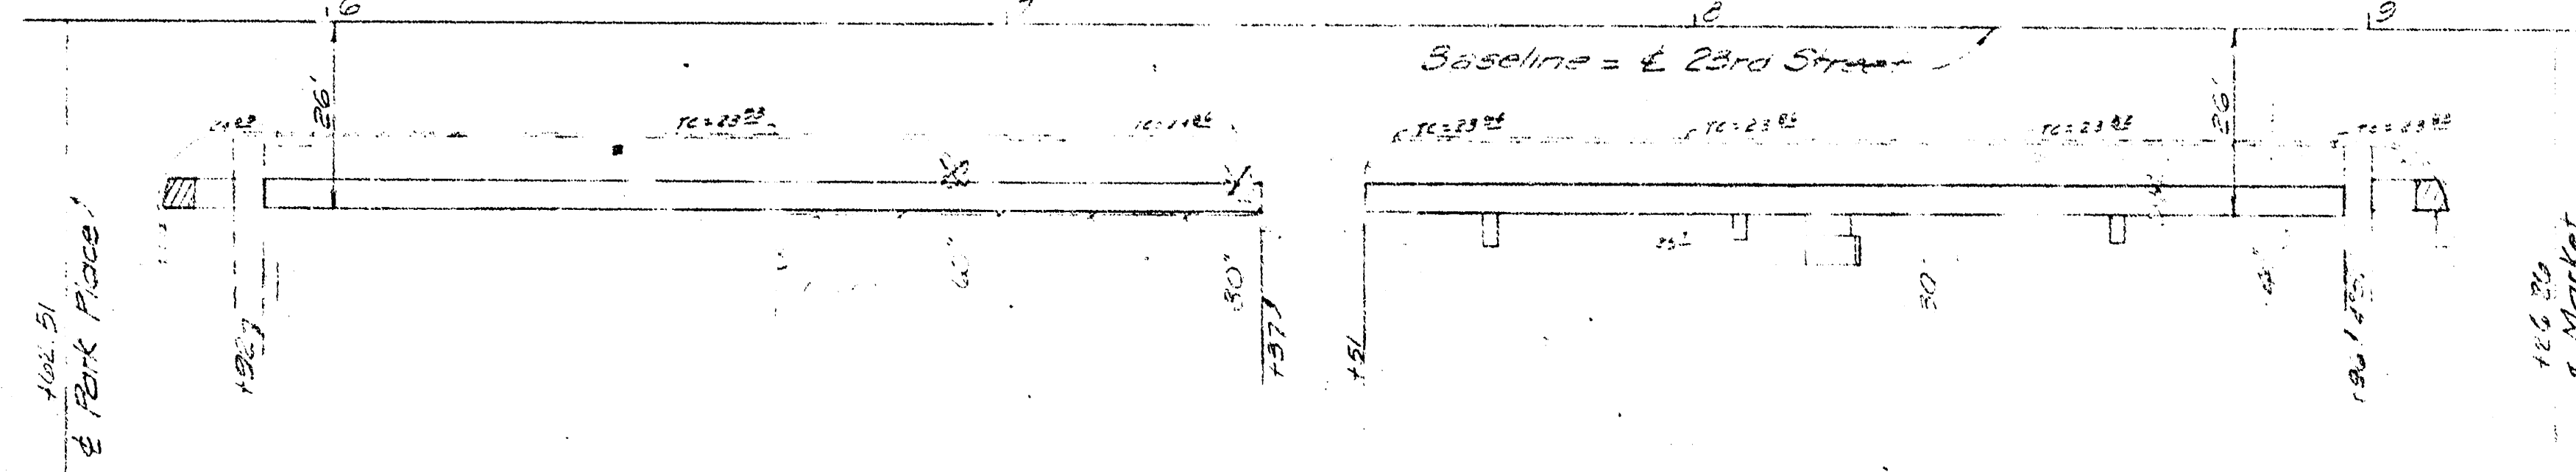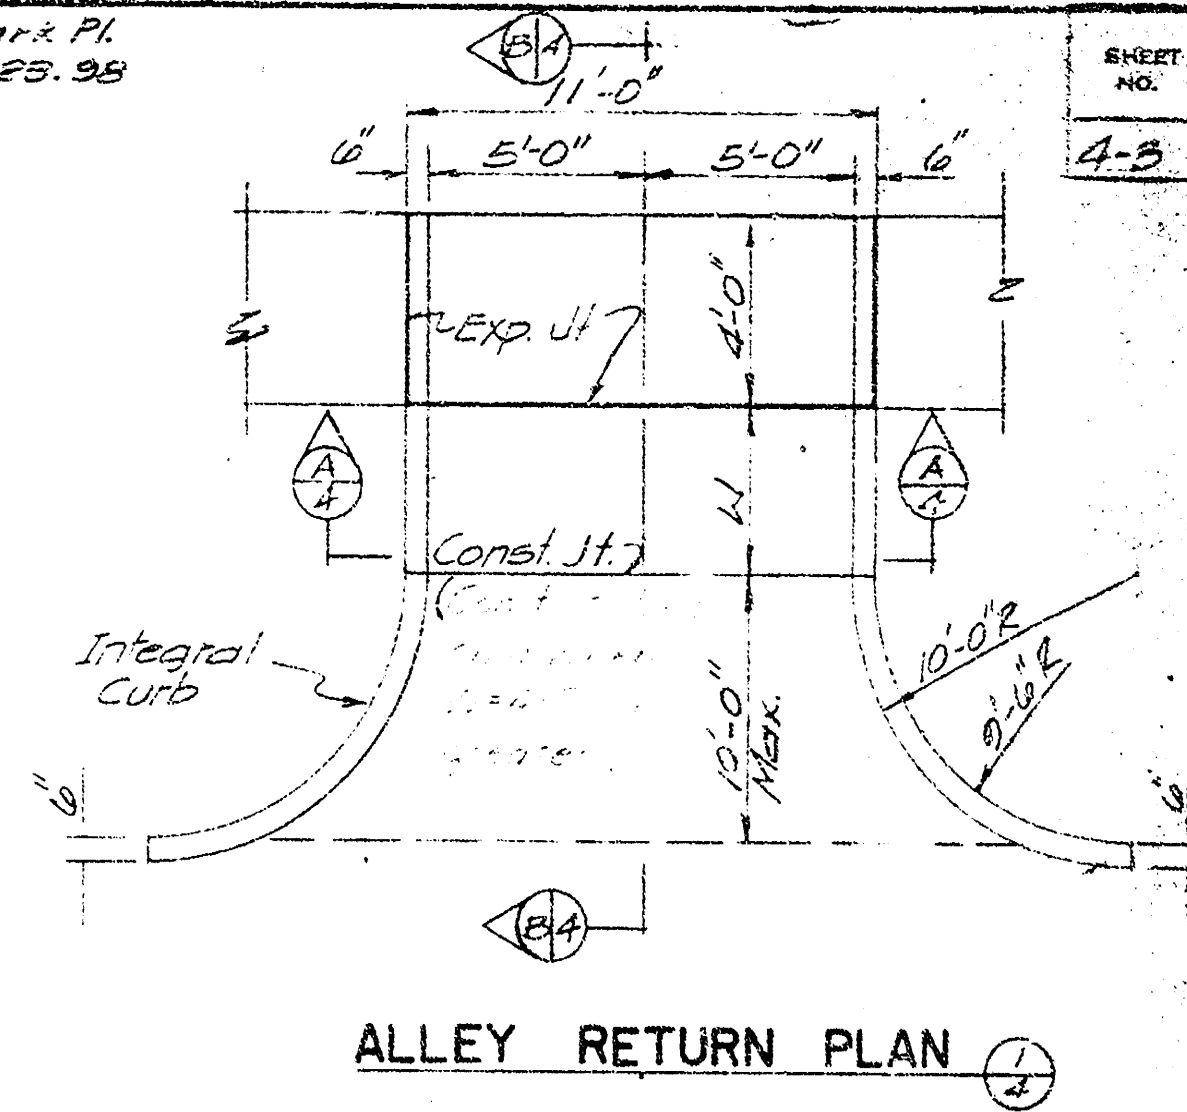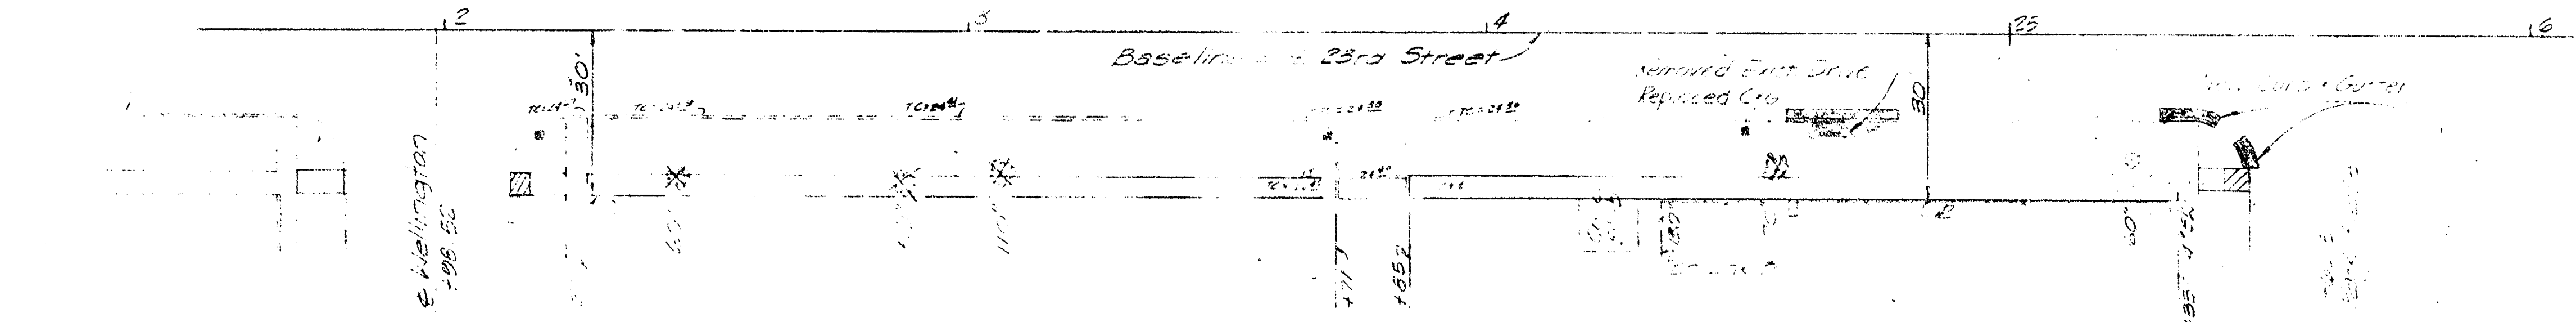

- Notes
- See Sh. No. 3-3 for General Notes.
 - Project vertical control is 0.66' above City of Wichita datum. To compare to City of Wichita datum, subtract 0.66' from elevations on this sheet.

B.M. Chis. "D" top of S. Curb of 23rd St.
30' E. of E. R. of Market St. El. 125.96


B.M. Chis. "D" top of S. Curb 23rd St.
40' W. of W. R. of Broadway El. 124.52

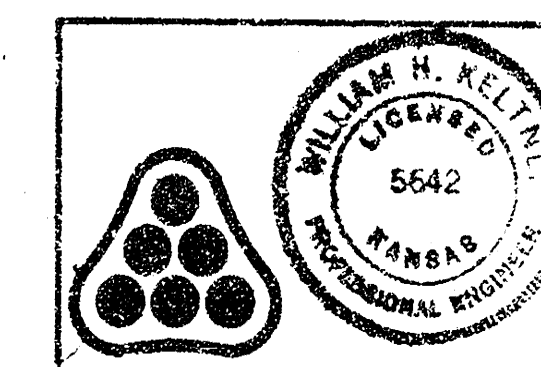

Designed by: W.H.K. G.C.M.
Drawn by: G.C.M. J.G.G. L.E.S.
Checked by: W.H.K.

REV. NO.	DESCRIPTION	DATE	BY
1	PHASE II, PART 3	4.1.75	L.P.G.
2	THE URBAN RENEWAL AGENCY WICHITA, KANSAS METROPOLITAN AREA		
3	23rd STREET WELLINGTON PLACE TO BROADWAY SIDEWALK IMPROVEMENTS WACO-FINN PROJECT KANS. A-5-1		
4	PROFESSIONAL ENGINEERING CONSULTANTS ENGINEERS WICHITA, KANSAS		


APPROVED OCT. 2 - 1972

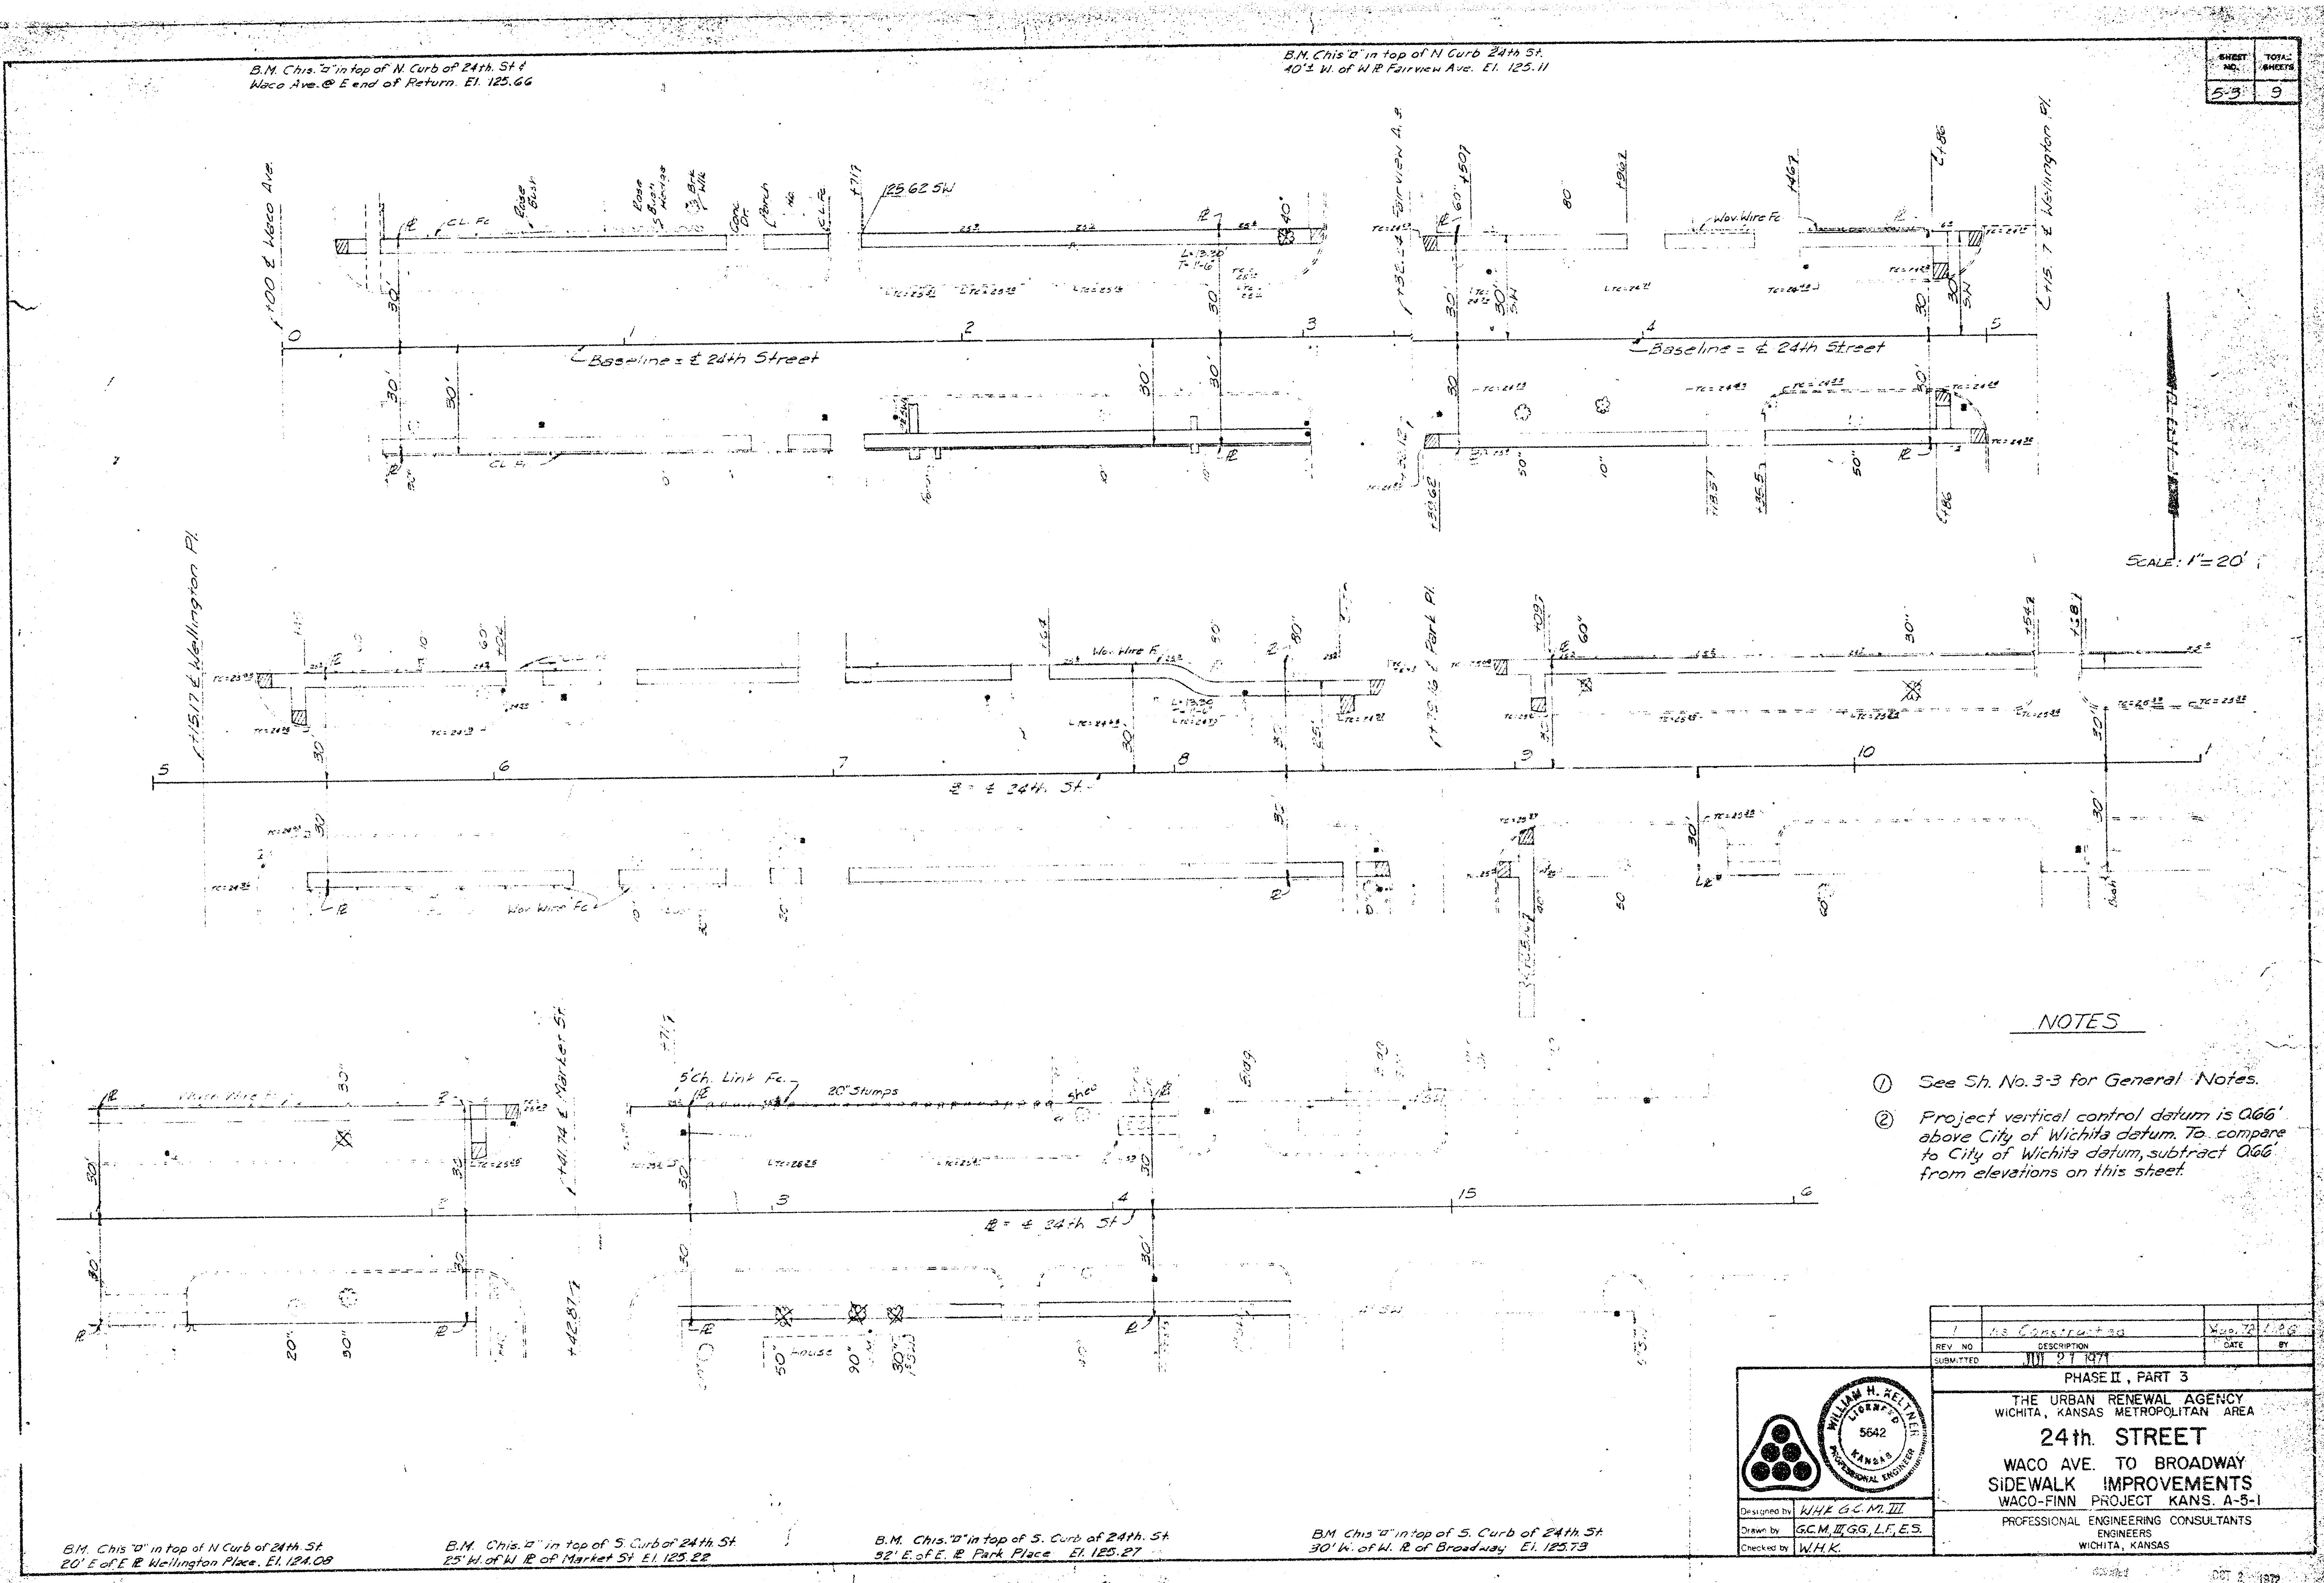

SHEET NO.	TOTAL SHEETS
53	9

NOTES


- ① See Sh. No. 3-3 for General Notes.
- ② Project vertical control datum is 0.66' above City of Wichita datum. To compare to City of Wichita datum, subtract 0.66' from elevations on this sheet.

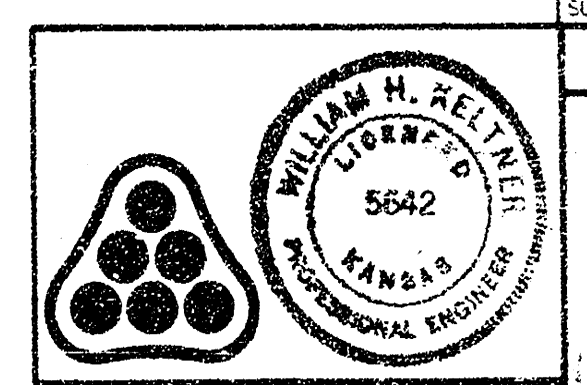

Designed by: W.H.B. G.C.M. III
Drawn by: G.C.M. III, G.S. L.F.E.S.
Checked by: W.H.B.

REV. NO.	1	DESCRIPTION	DATE	BY
SUBMITTED	10/17/71	10/17/71		
PHASE II, PART 3				
THE URBAN RENEWAL AGENCY WICHITA, KANSAS METROPOLITAN AREA				
24th STREET				
WACO AVE. TO BROADWAY				
SIDEWALK IMPROVEMENTS				
WACO-FINN PROJECT KANS. A-5-1				
PROFESSIONAL ENGINEERING CONSULTANTS				
WICHITA, KANSAS				

B.M. Chis. D. in top of N. Curb of 24th St. 20' E of E. Wellington Place. El. 124.09
B.M. Chis. D. in top of S. Curb of 24th St. 25' W. of W. R. of Market St. El. 125.28
B.M. Chis. D. in top of S. Curb of 24th St. 35' E of E. Park Place. El. 125.27
B.M. Chis. D. in top of S. Curb of 24th St. 30' W. of W. R. of Broadway. El. 125.73

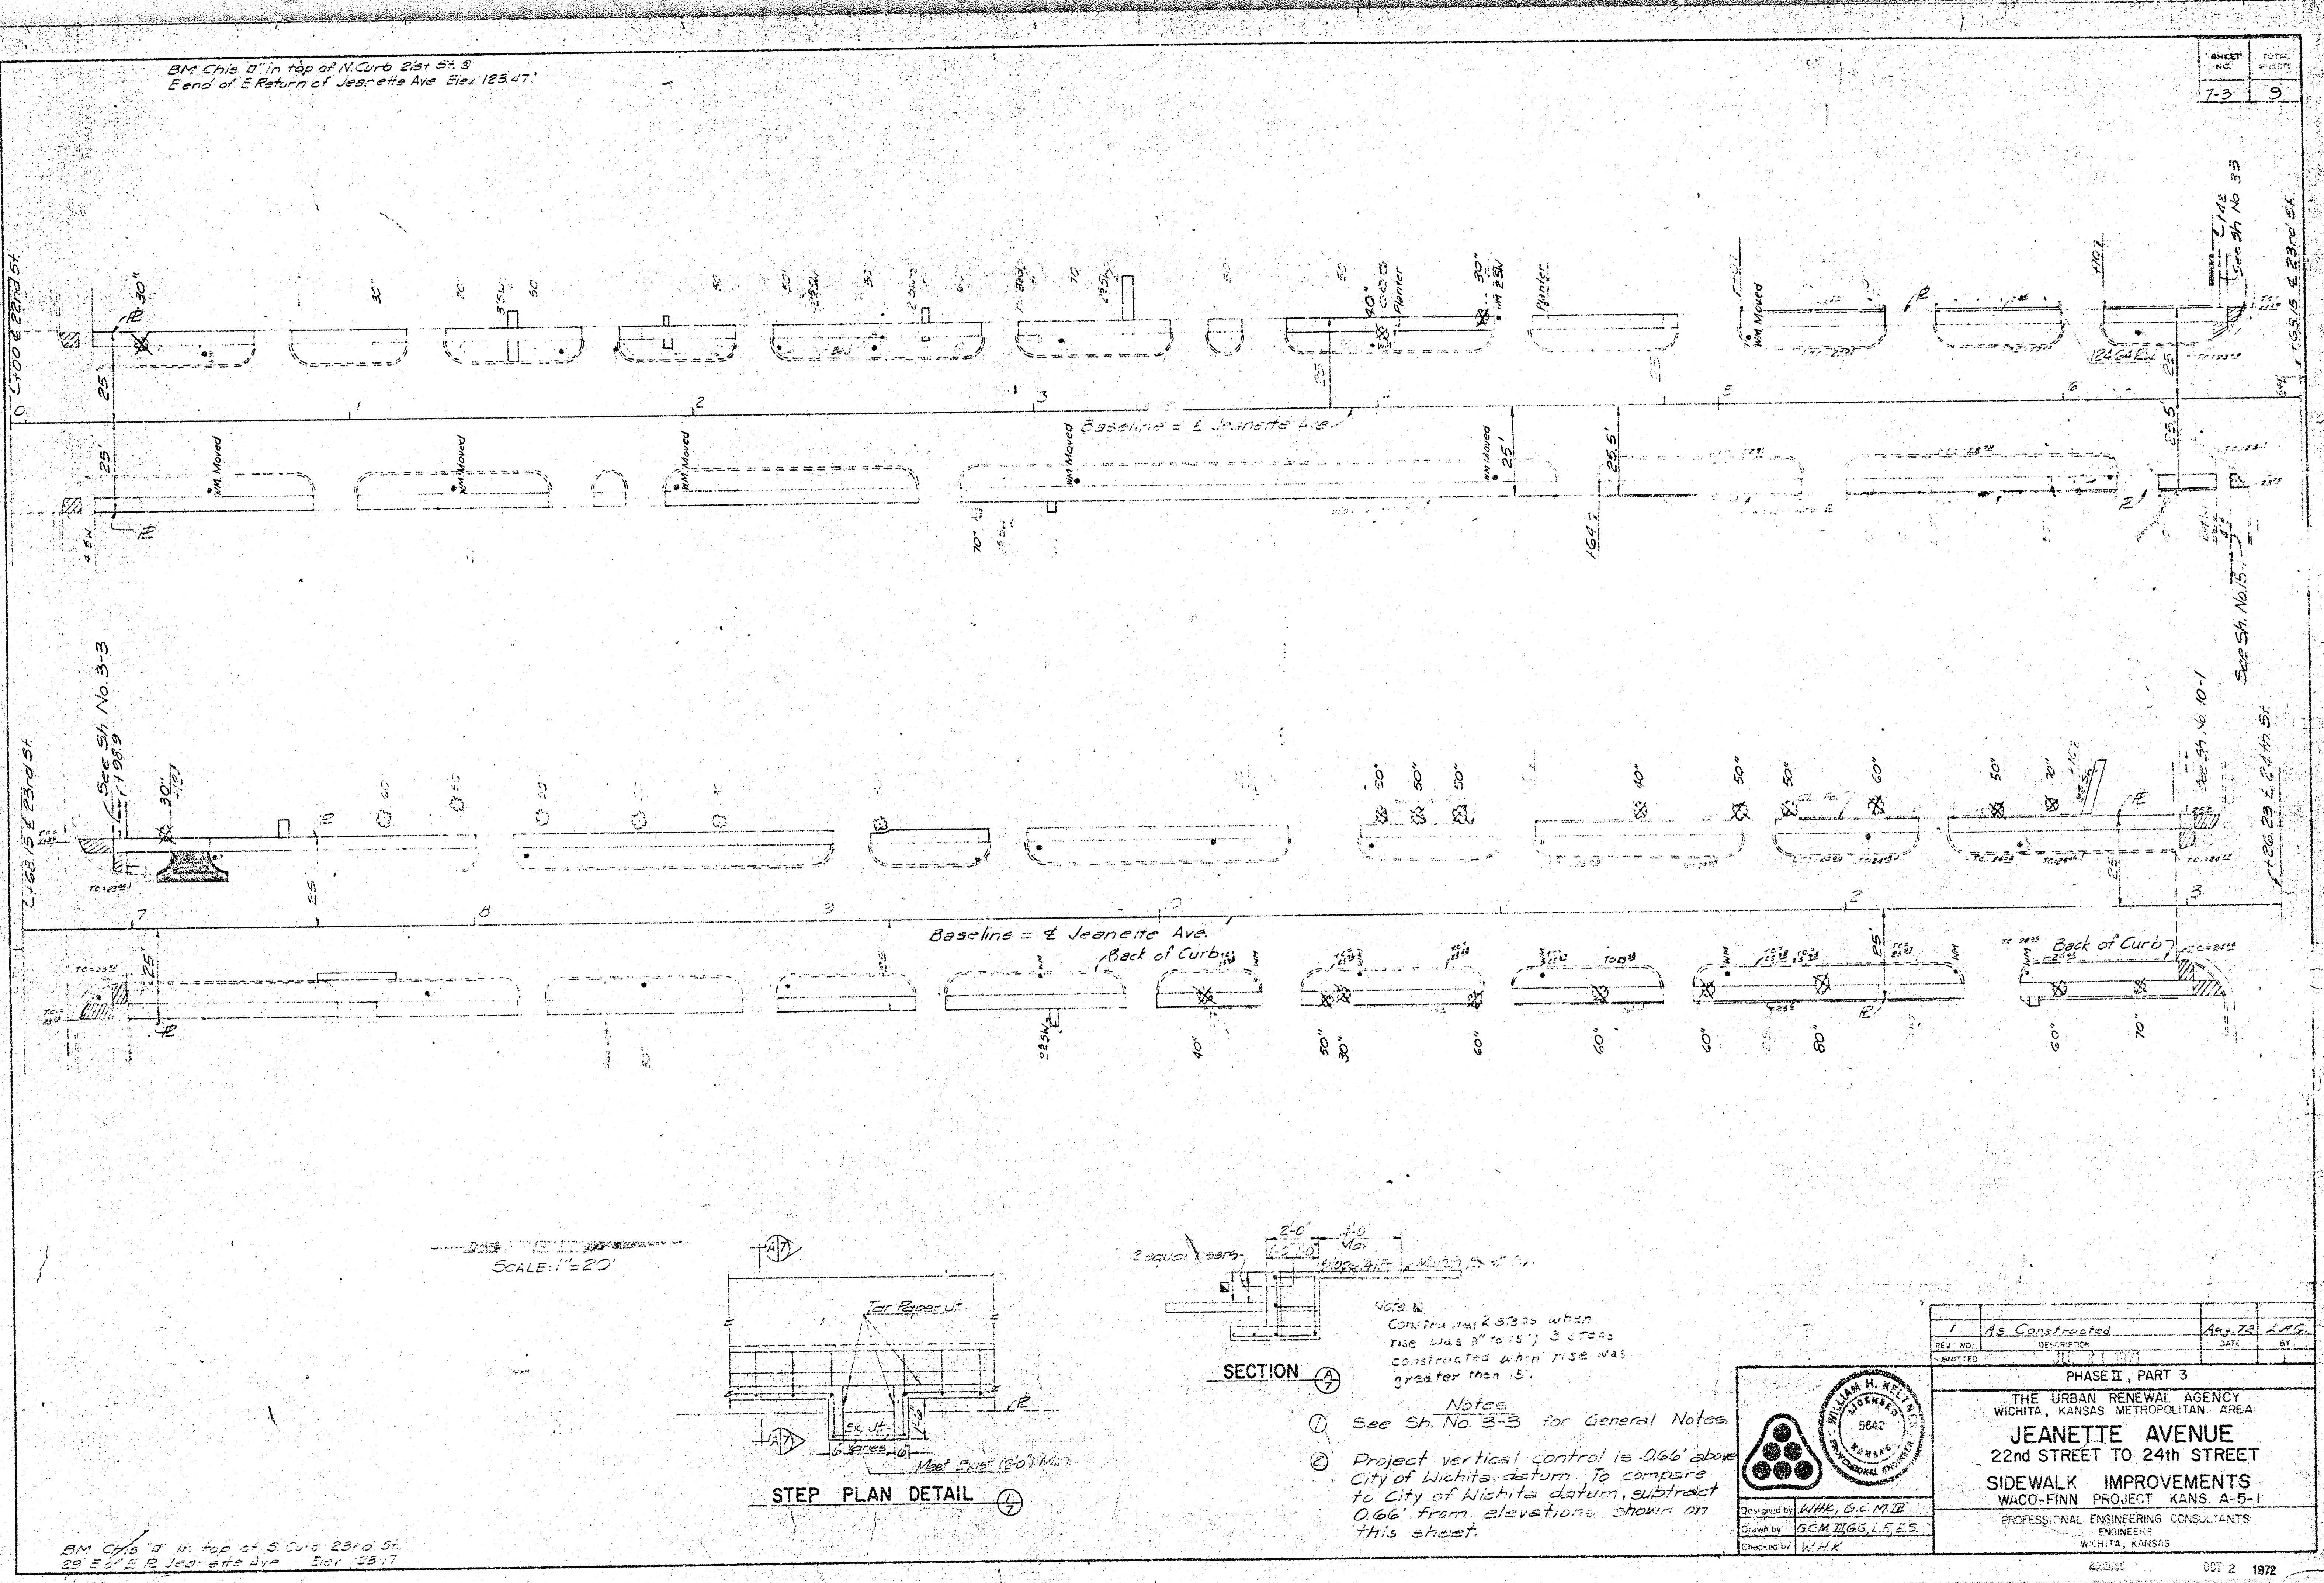

BM Chis. 11" in top of N. Curb 23+54.8
End of E Return of Jeanette Ave Elev 123.47


SHEET NO.	TOTAL SHEETS
7-3	9

Sewer No. 3-3
1198.9


Baseline = Jeanette Ave
Back of Curb

Sewer No. 10-1
1202.29 E 24th St

SCALE: 1"=20'

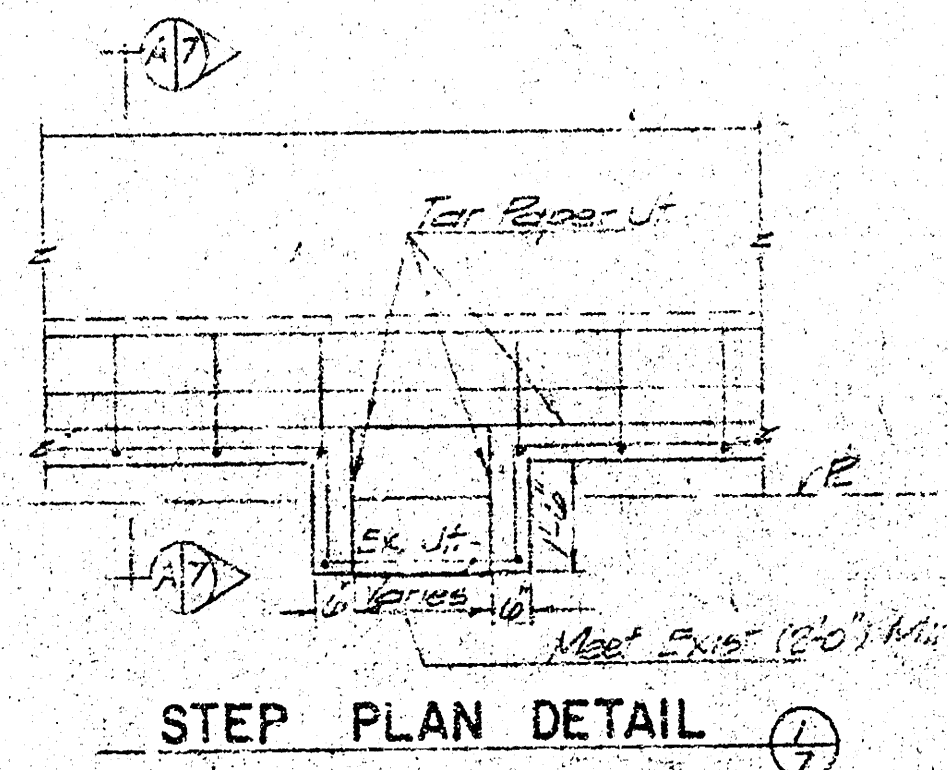


STEP PLAN DETAIL

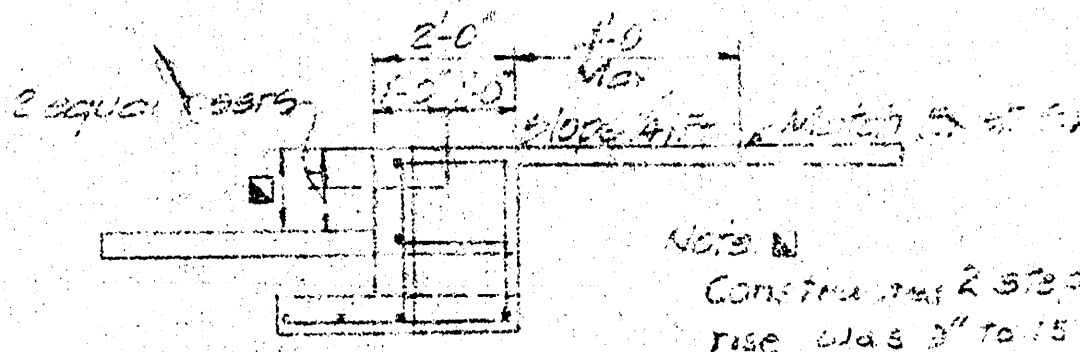

SECTION A-A


Notes:
1. Constructed 23+55 when rise was 9" to 15"; 3 cross constructed when rise was greater than 15".

- Notes:
- See Sh. No. 3-3 for General Notes
 - Project vertical control is 0.66' above City of Wichita datum. To compare to City of Wichita datum, subtract 0.66' from elevations shown on this sheet.

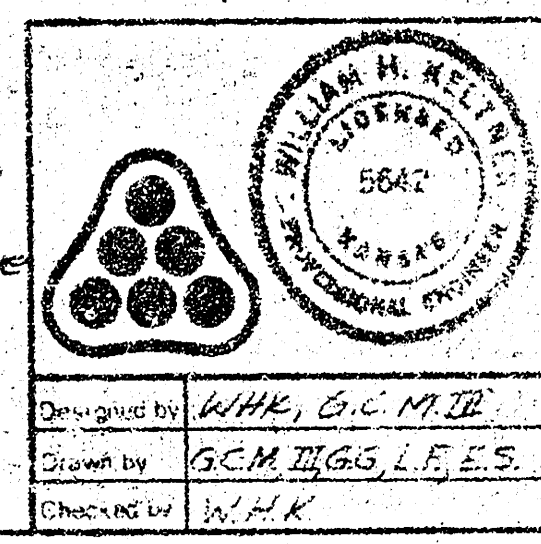


1	As Constructed	Aug. 75	W.H.K.
REV. NO.	DESCRIPTION	DATE	BY
1	PHASE II, PART 3		
THE URBAN RENEWAL AGENCY WICHITA, KANSAS METROPOLITAN AREA			
JEANETTE AVENUE 22nd STREET TO 24th STREET			
SIDEWALK IMPROVEMENTS WACO-FINN PROJECT KANS. A-5-1			
PROFESSIONAL ENGINEERING CONSULTANTS ENGINEERS WICHITA, KANSAS			

BM Chis. 11" in top of S. Curb 23+05.1
22 E 24th St Jeanette Ave Elev 123.17

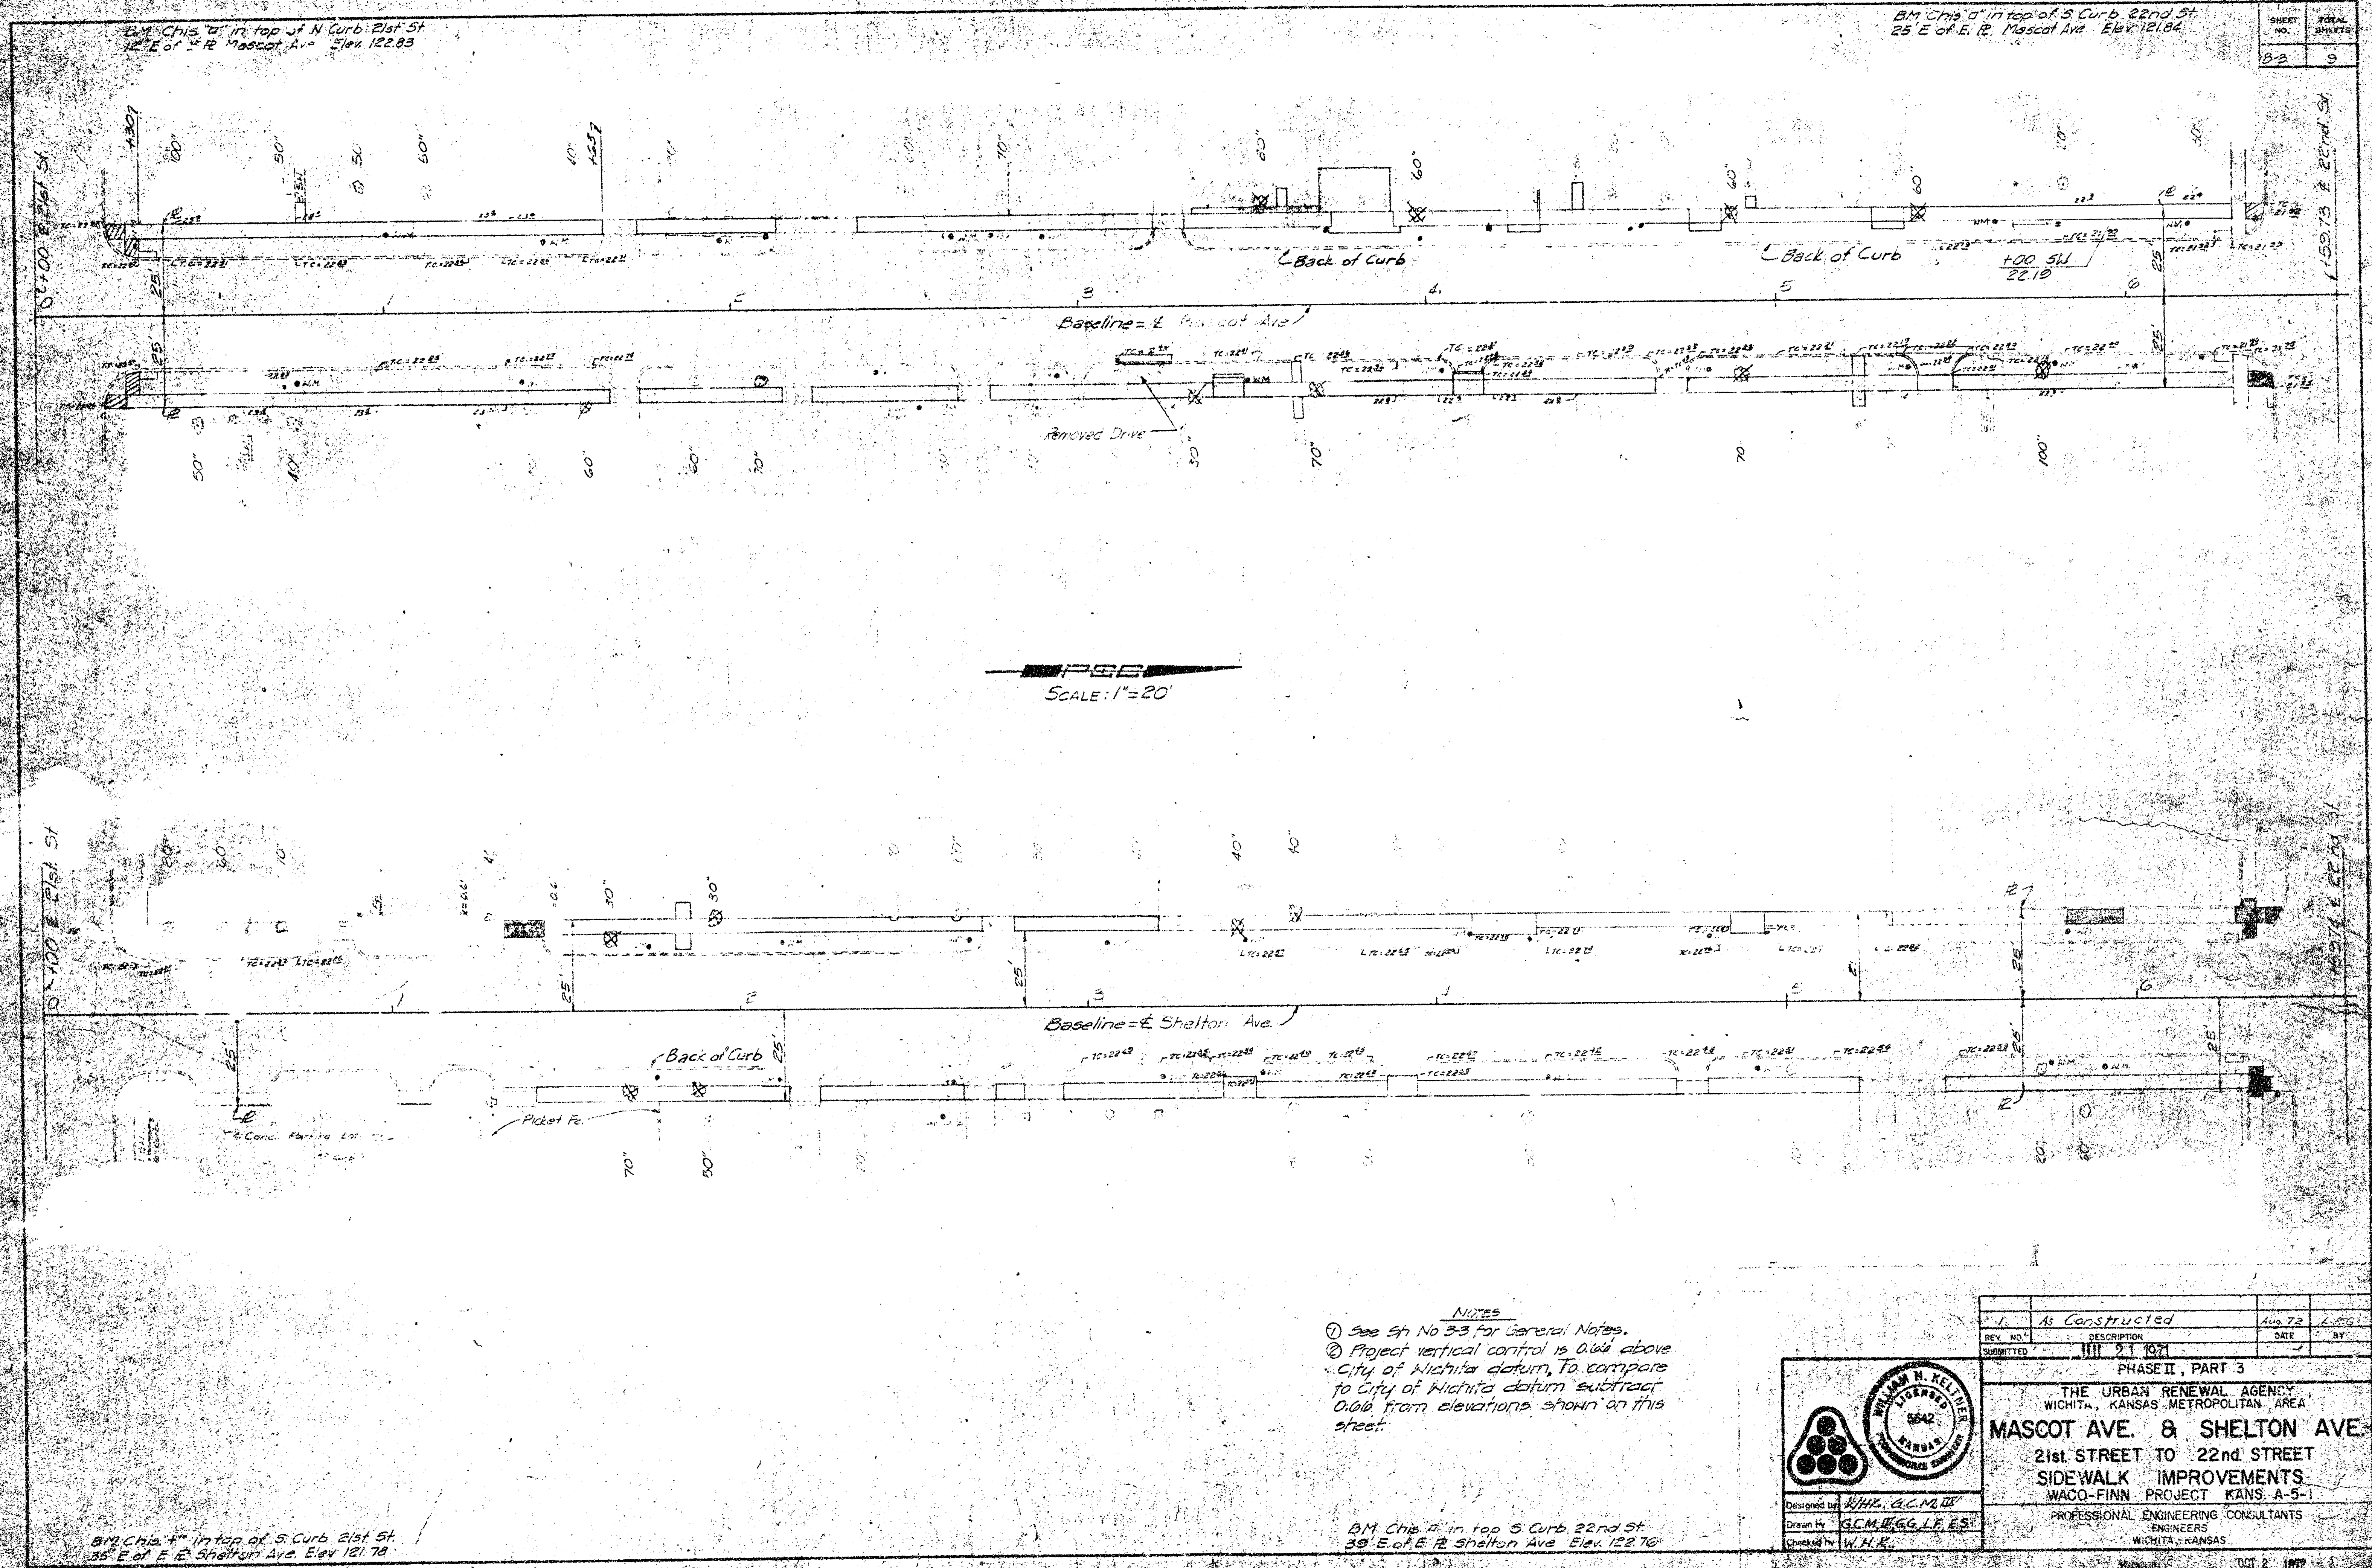

- NOTES
- 1 See Sp No 2-3 for General Notes.
 - 2 Project vertical control is 0.45' above City of Wichita datum. To compare to City of Wichita datum subtract 0.45' from elevations shown on this sheet.

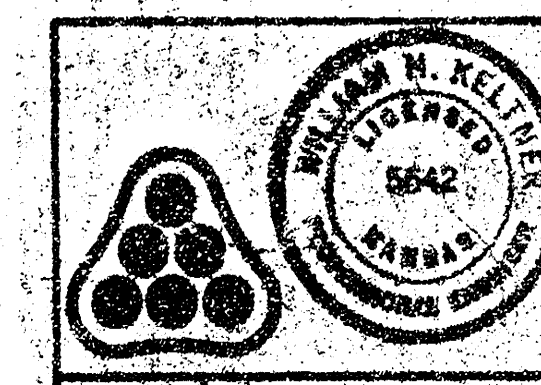

REV. NO.	1	AS CONSTRUCTED	DATE	Aug 72	BY	L.H.G.
SUBMITTED	III	9-1-67				
PHASE II, PART 3						
THE URBAN RENEWAL AGENCY WICHITA, KANSAS METROPOLITAN AREA						
MASCOT AVE. & SHELTON AVE.						
21st STREET TO 22nd STREET						
SIDEWALK IMPROVEMENTS						
WACO-FINN PROJECT KANS. A-5-1						
PROFESSIONAL ENGINEERING CONSULTANTS						
ENGINEERS						
WICHITA, KANSAS						

