


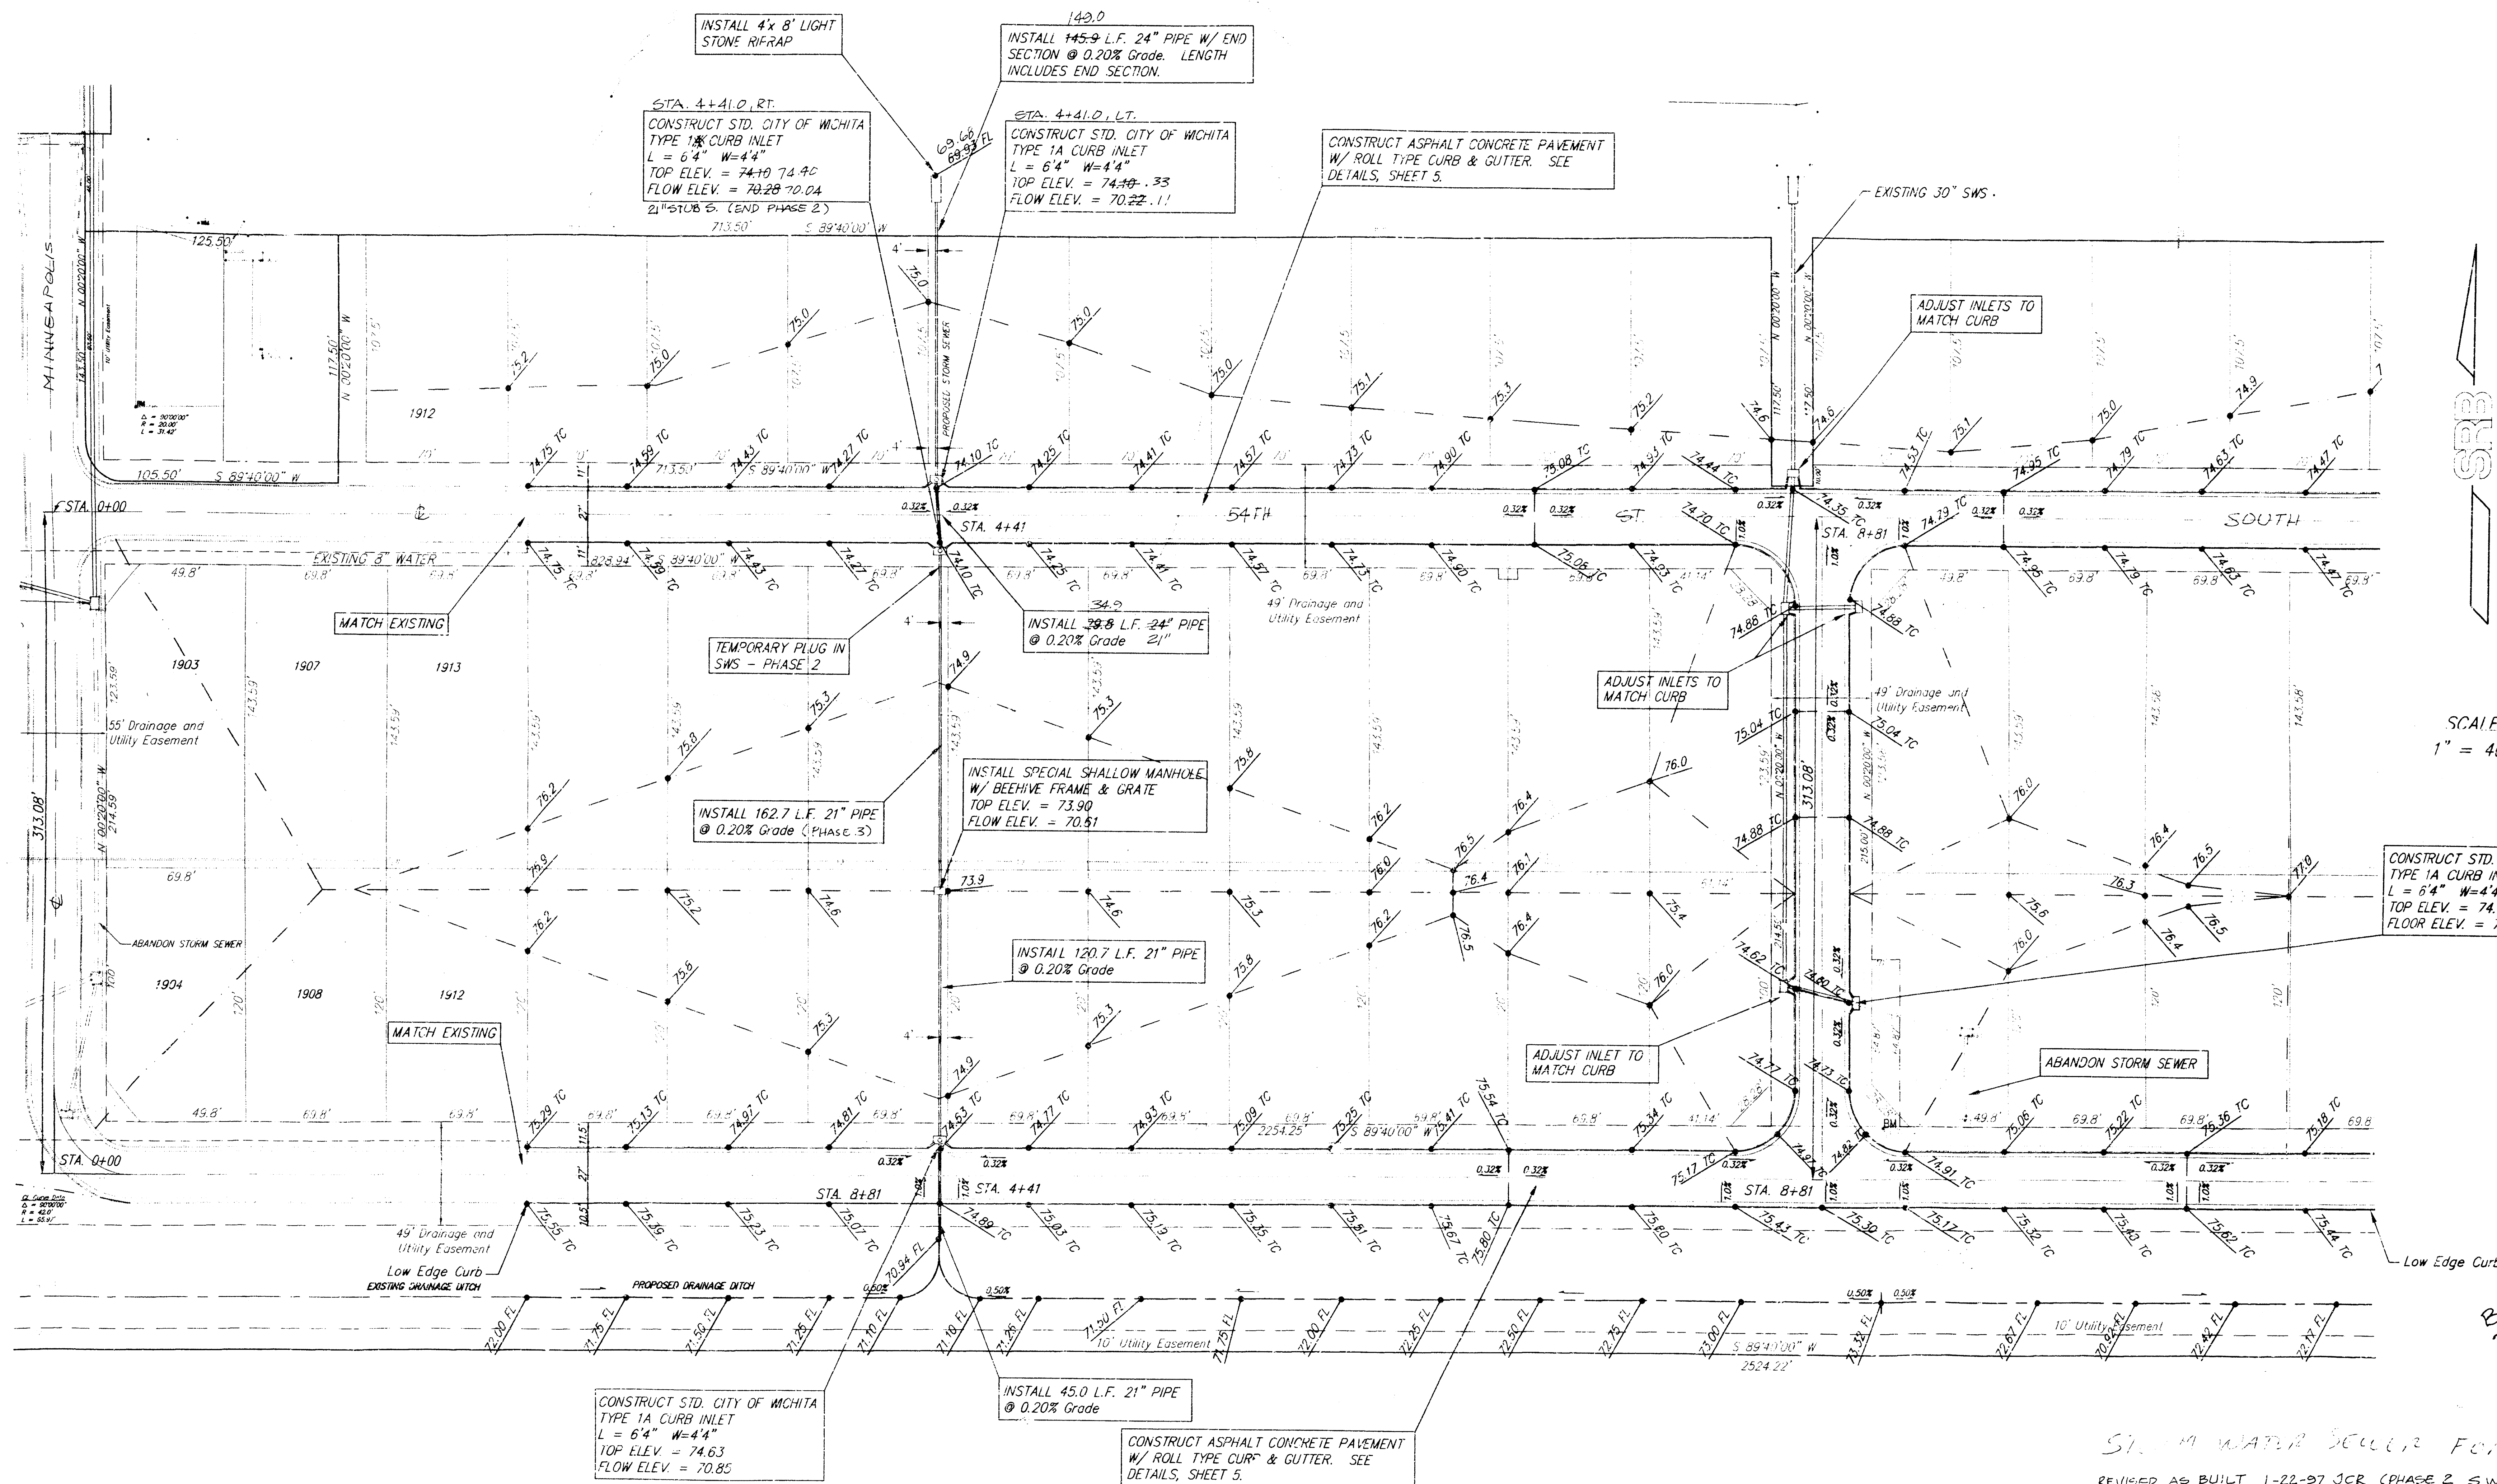

SCALE
1" = 40'

BOOKED
7-18-97
MCG
D-352

NOTE: Low edge curb to be constructed on the south side of Campus. See detail, Sheet 5.


TYPICAL DITCH CROSS-SECTION



ST. M. WATER SELLER FORM
REVISED AS BUILT 1-22-97 SCR (PHASE 2 S.W.S. ONLY)

**SITE GRADING PLAN - PHASE II
RIVER OAKS MOBILE HOME PARK
WICHITA, KANSAS**

SRB 924 NORTH MAIN WICHITA, KANSAS 67203 318-264-8000 FAX 318-264-8622		PROJECT NUMBER 1 5
SAVOY, RUGGLES & BOHM, P.A. ENGINEERING & SURVEYING		
DRAWN K.W.L.	DESIGN K.W.L.	CHECKED K.W.L. DATE 7-12-96 UTILITY TCR SRB JOB 531E

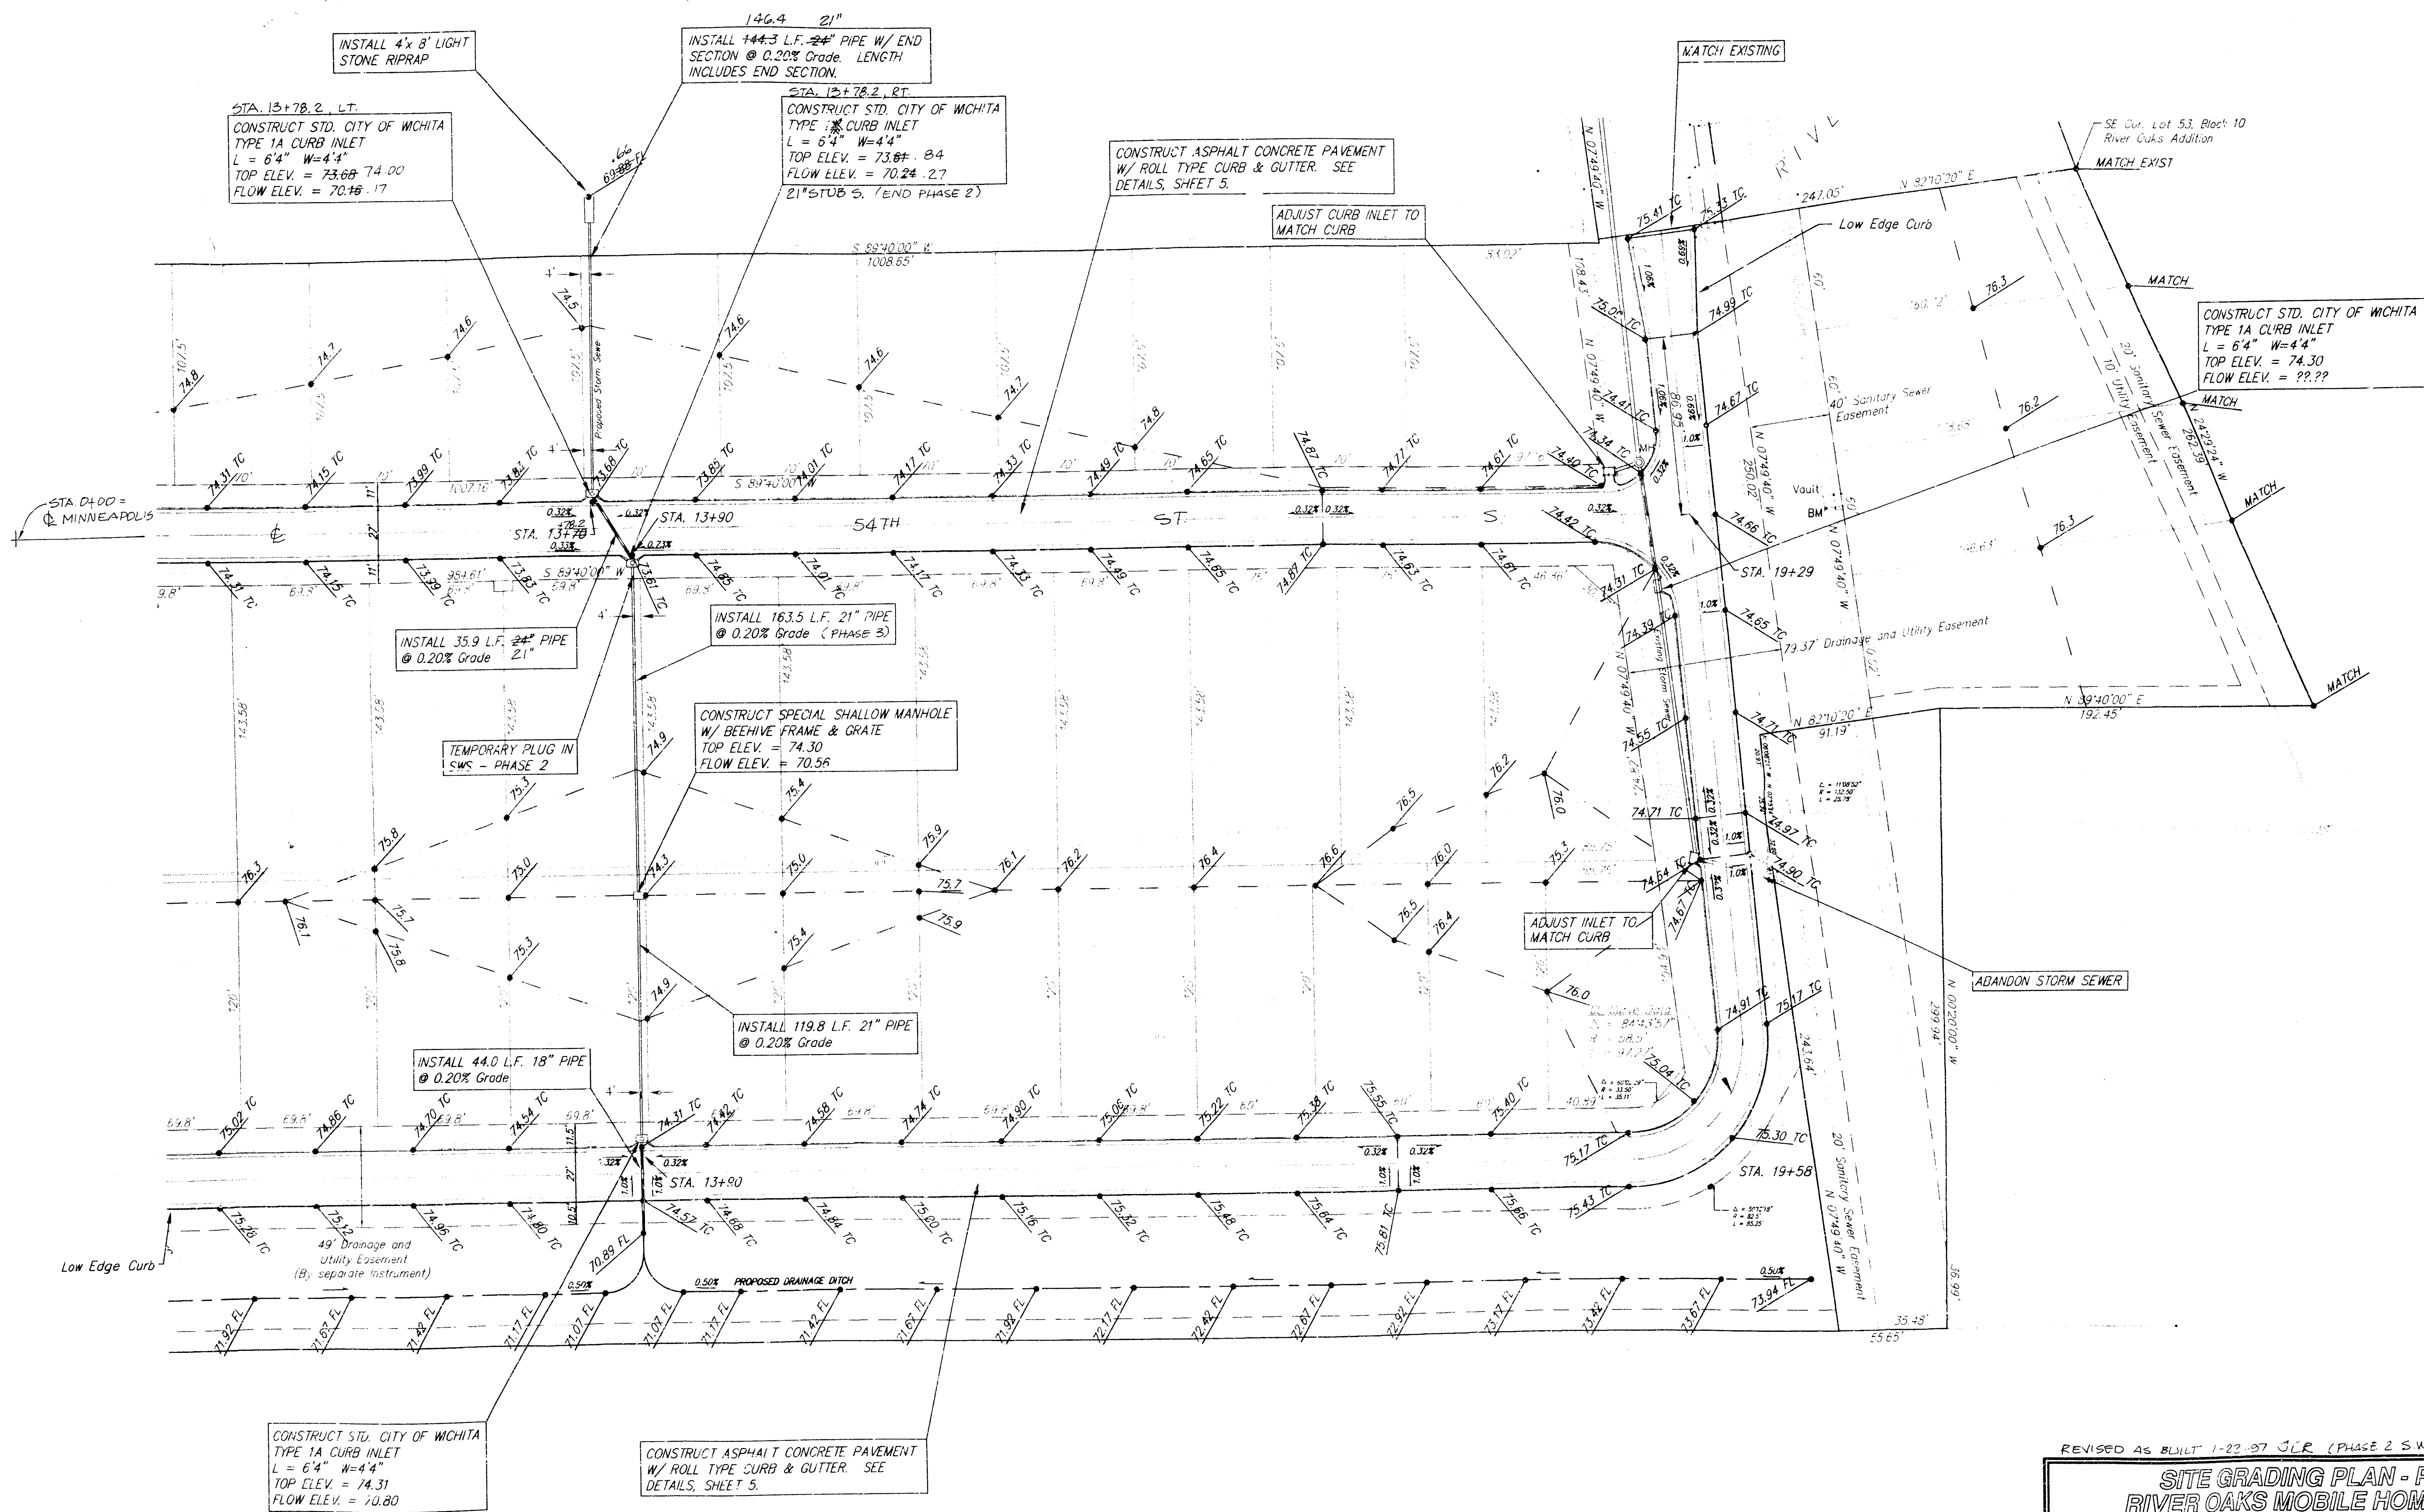

SCALE
1" = 40'

NOTE: Low edge curb to be constructed on the south side of Campus and east side of Spruce. See detail, Sheet 5.

REVISED AS BUILT 1-22-97 J.L.P. (PHASE 2 SWS ONLY)					
SITE GRADING PLAN - PHASE II RIVER OAKS MOBILE HOME PARK WICHITA, KANSAS					
SRB		315-284-3303		REVISED	
SAVOY, RUGGLES & BOHM, P.A.		315-284-4621		2	
ENGINEERING & SURVEYING		PROJECT NUMBER		5	
DRAWN	DESIGN	REVIEW	DATE	UTILITY	SHEET
K.M.	K.M.		7-12-95		5/12