



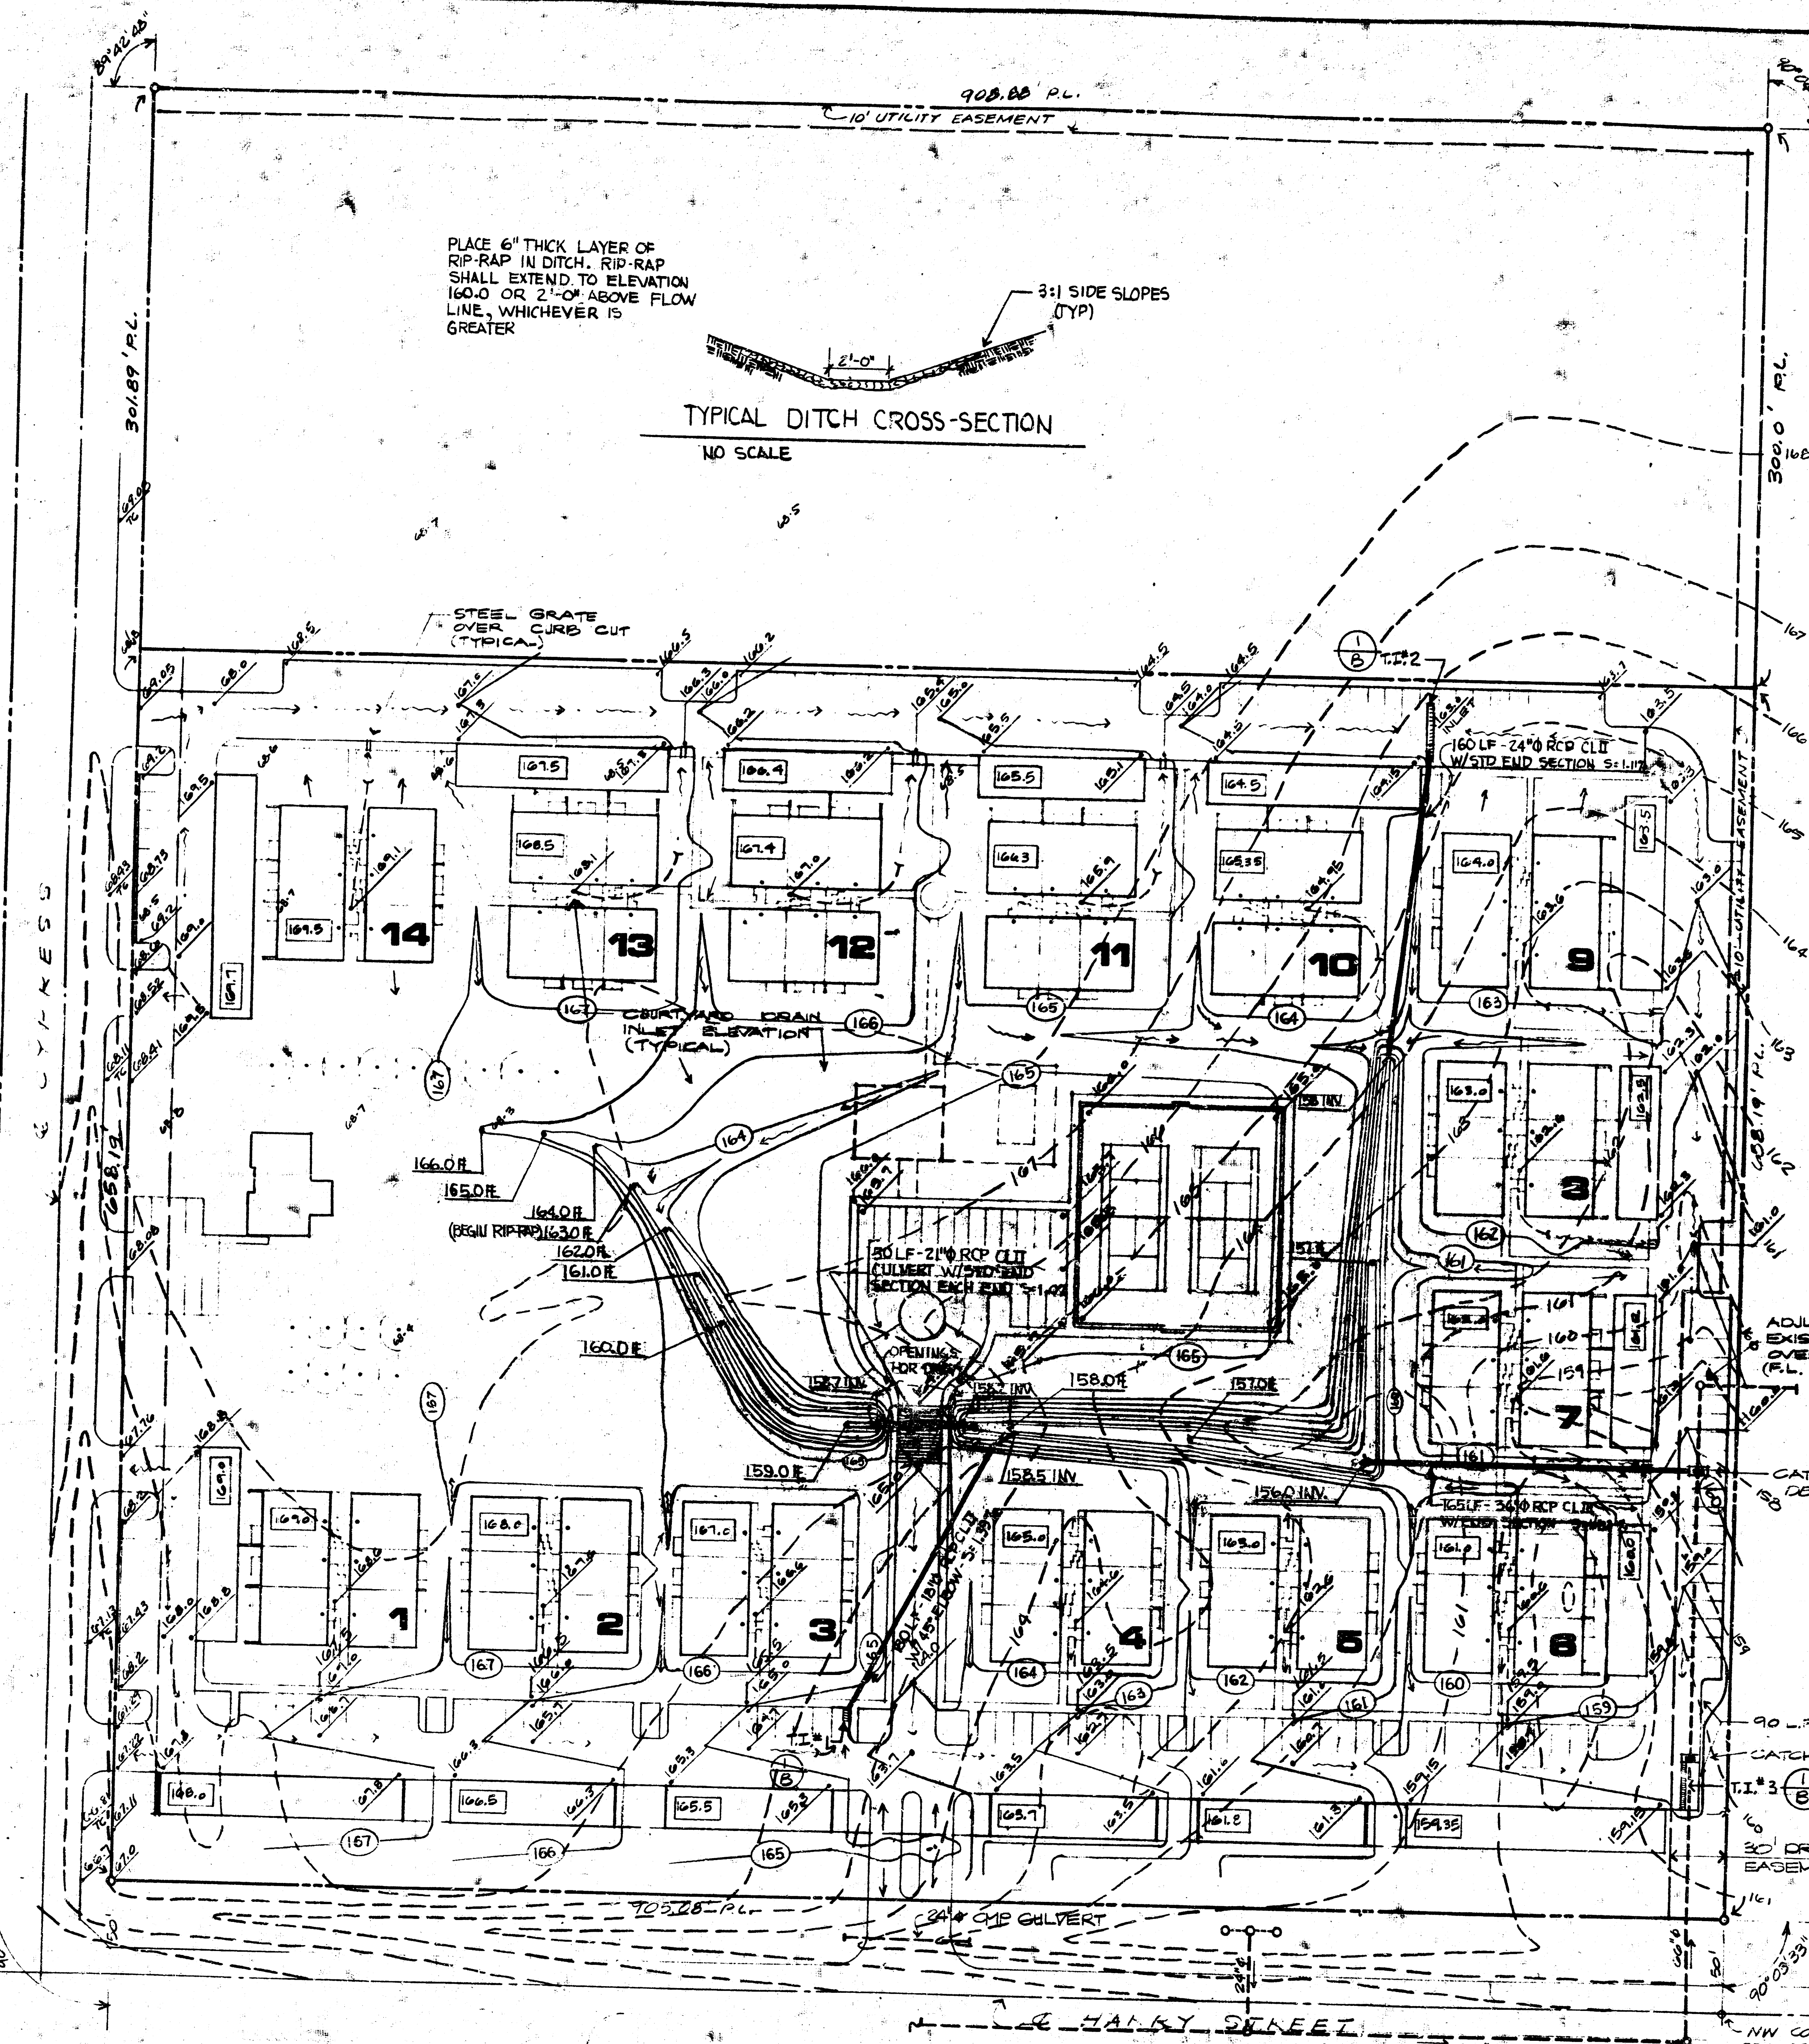

TYPICAL DITCH CROSS-SECTION
NO SCALE

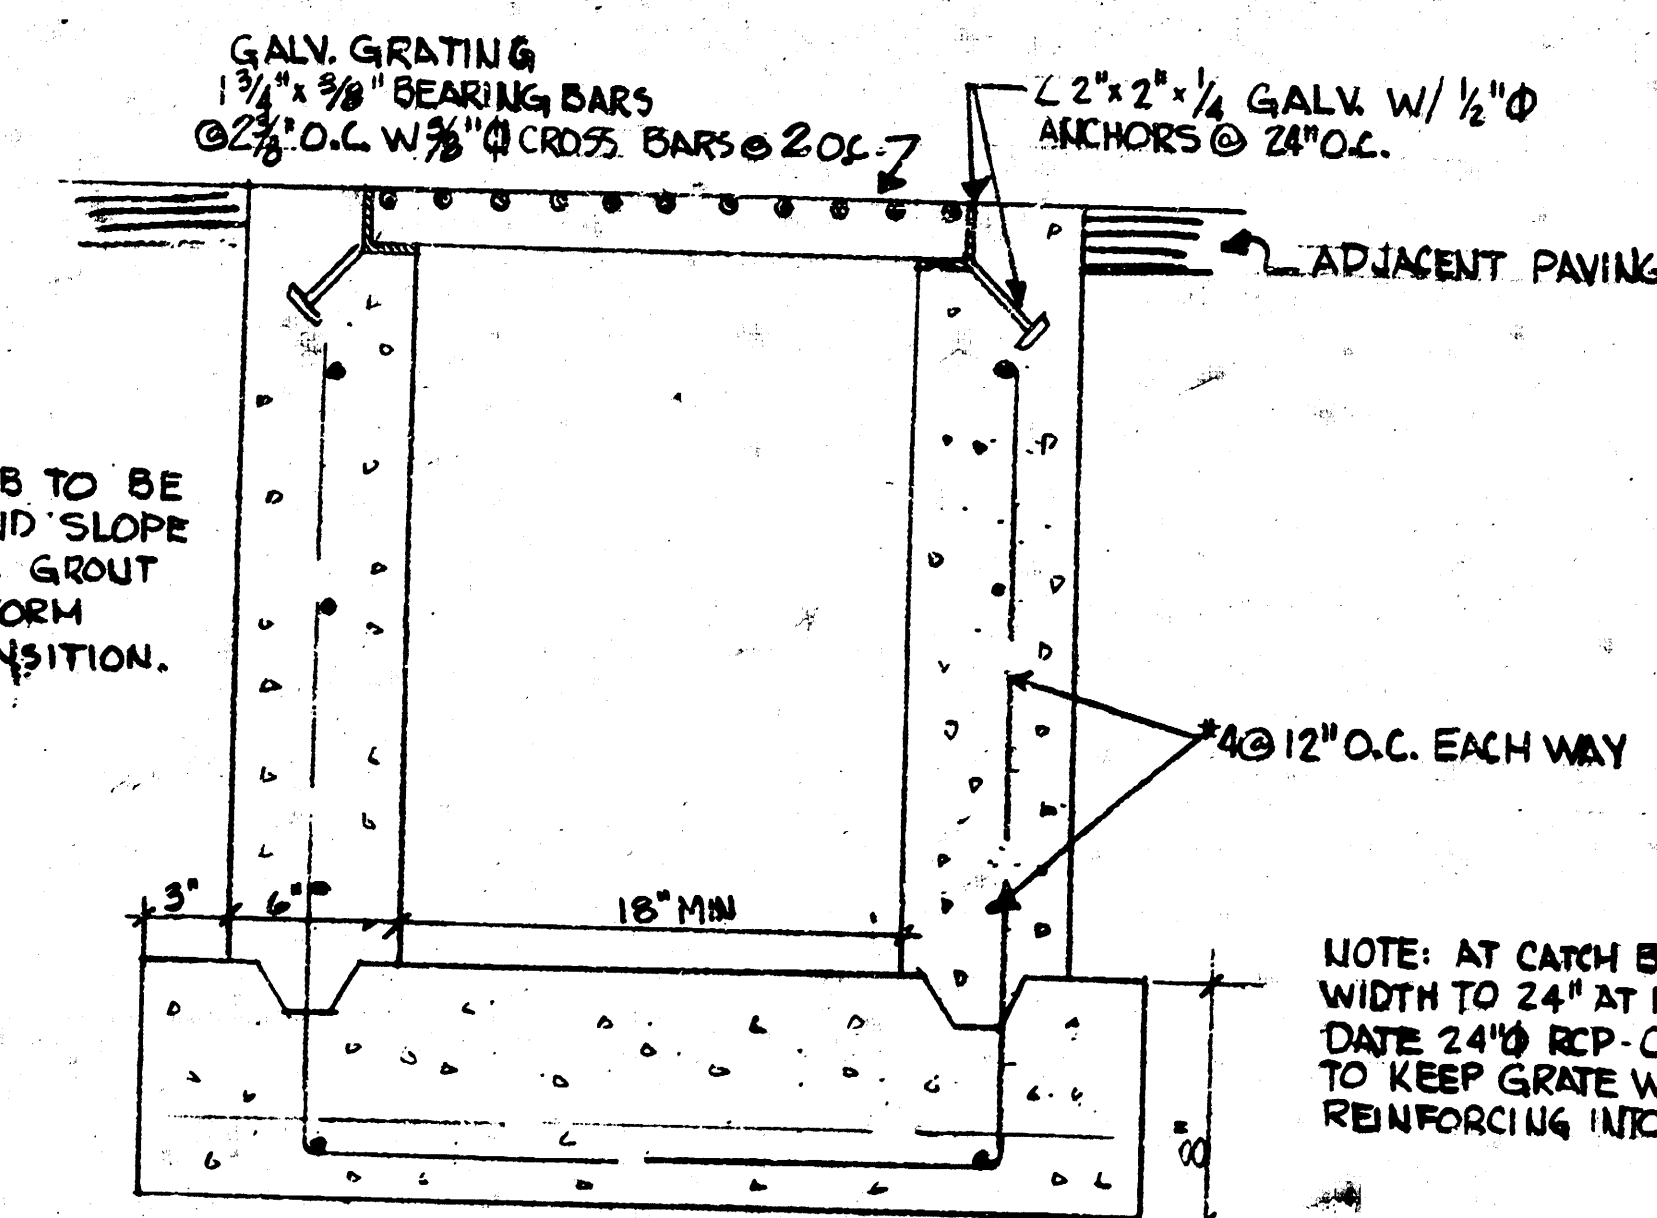

1
B

TYPICAL TRENCH INLET

NO SCALE

STORM SEWER SCHEDULE					
LOCATION	GRATE ELEV.	INV. 14 ELEV.	INV. QUIT ELEV.	FRAME OPENING SIZE	REMARKS
T.I.#1	164.0		161.0	1'-6" x 6'-0"	
T.I.#2	163.0		160.0	1'-6" x 25'-0"	
T.I.#3	158.0		155.0	1'-6" x 25'-0"	
C.B.#1	160.0	36" x 153.5		24" x 48"	CONST & SIZE OF MH TO BE PER CITY STD'S.
C.B.#2	156.0	T.I. x 156.0		24" x 48"	
EXISTING CITY MH.	ADJUST	#49.9 FELD VERIFY	#49.8 FELD VERIFY	EXISTING	

NOTE: ALL STORM SEWER WORK SHALL BE IN ACCORDANCE WITH ALL LOCAL AUTHORITIES HAVING JURISDICTION.

LEGEND	
EXISTING CONTOUR	— — 164 —
NEW CONTOUR	①6
NEW SPOT ELEVATION	163.2
SWALE	→ → →
SURFACE RUNOFF DIRECTION	→
NEW CATCH BASIN & STORM SEWER	— — — CB#1
DITCH FLOW LINE ELEVATIONS	159.0 ft
INVERT ELEVATION	158.0 INV
EXISTING SPOT ELEVATION	60.4

PRIVATE STORM SEWER
462-76-245-80663-000-000-008

ARAGON APARTMENTS - 8909 E. HARRY
SITE PLAN - GRADING


NOTE: FINISH GRADE AT ALL STRUCTURES SHALL
BE 6" BELOW INDICATED FINISH FLOOR ELEVATIONS

RODGER A BROOKS • ARCHITECT
p r o f e s s i o n a l a r c h i t e c t
EAST SIDE FINANCIAL CENTER
7701 EAST KELLOGG AVENUE
SUITE 708
WICHITA KANSAS 67267
913 262-2247
913 262-2247

77-323





11-21-78

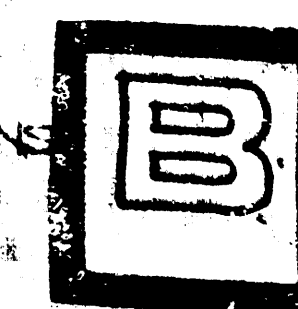


ALL AVAILABLE COPY ...
FILMED FROM THE BEST

NOTE: Grates shall be imprinted on the top surface with "CITY OF WICHITA" using letters at least 1" in height. Other marking methods may be used only if approved by the engineer.

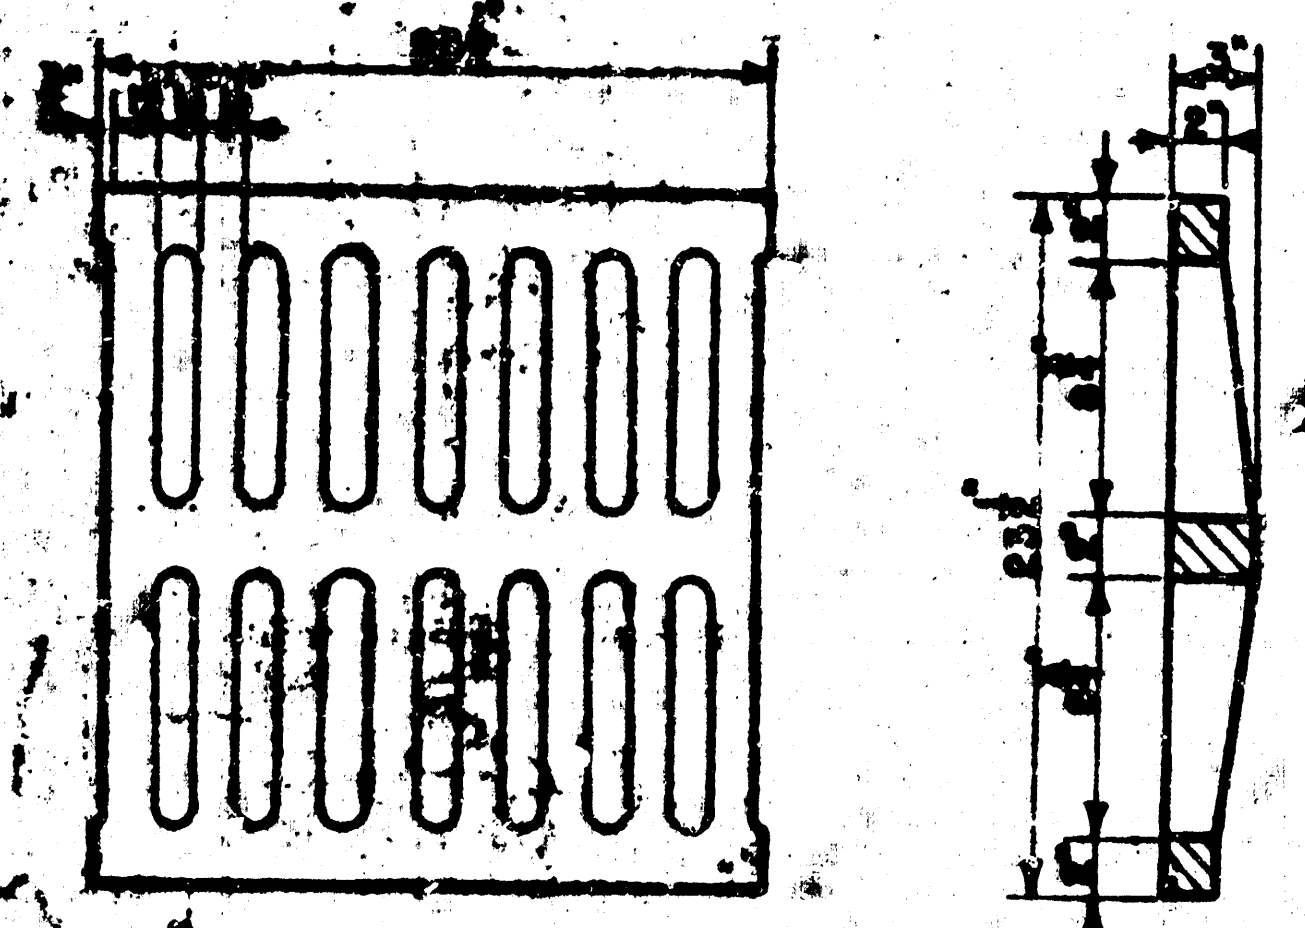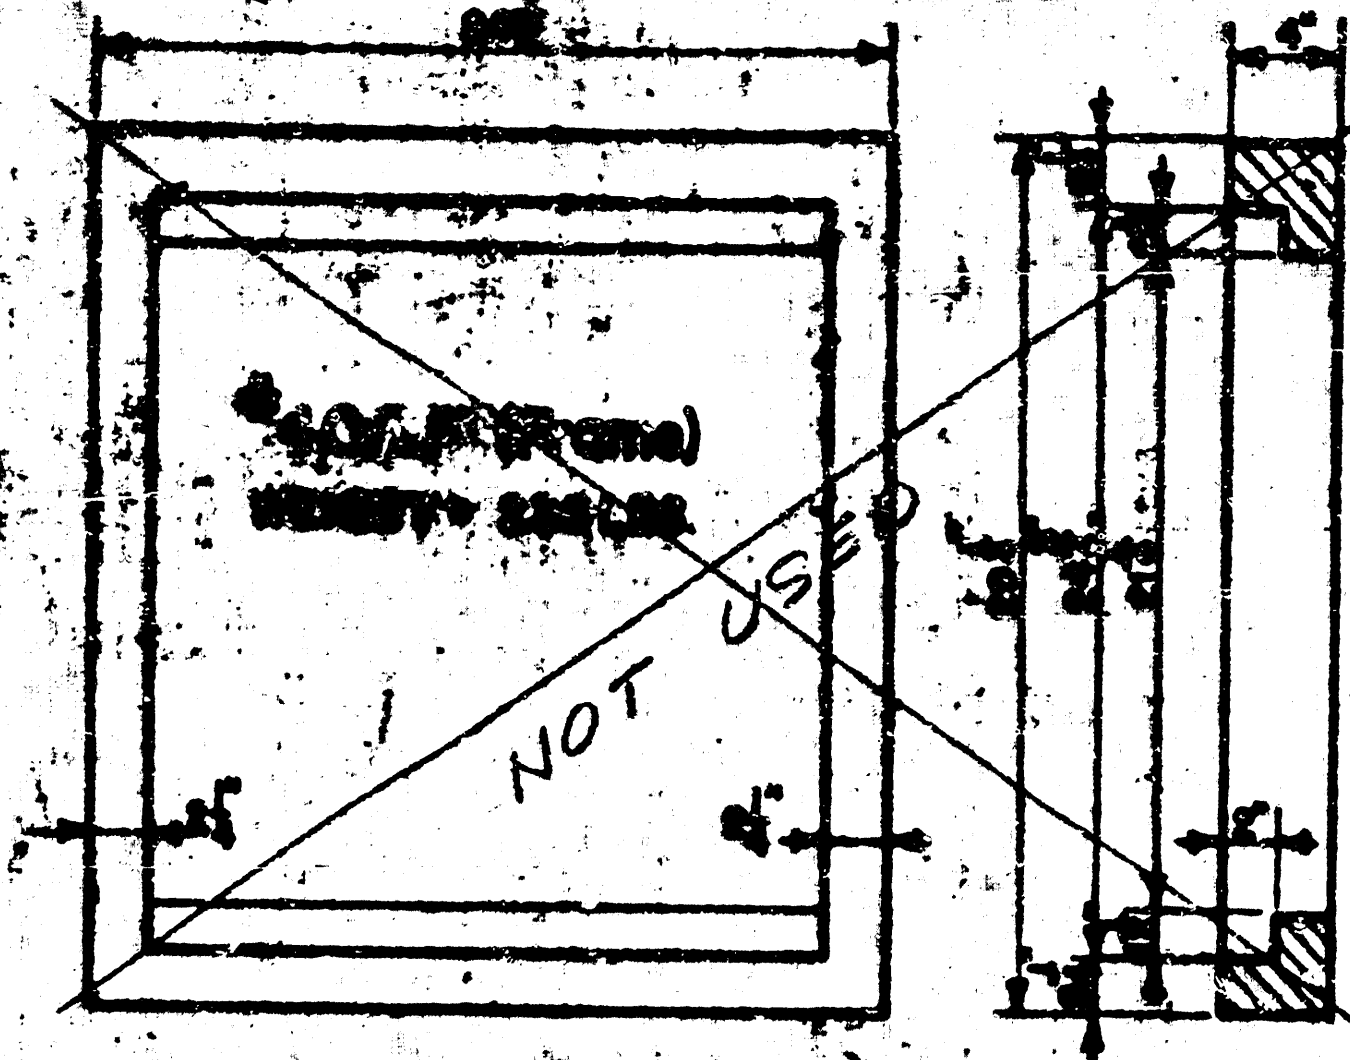

4006 (Grate)
WEIGHT - 225 LBS


24"x24" Frame & Grate Detail

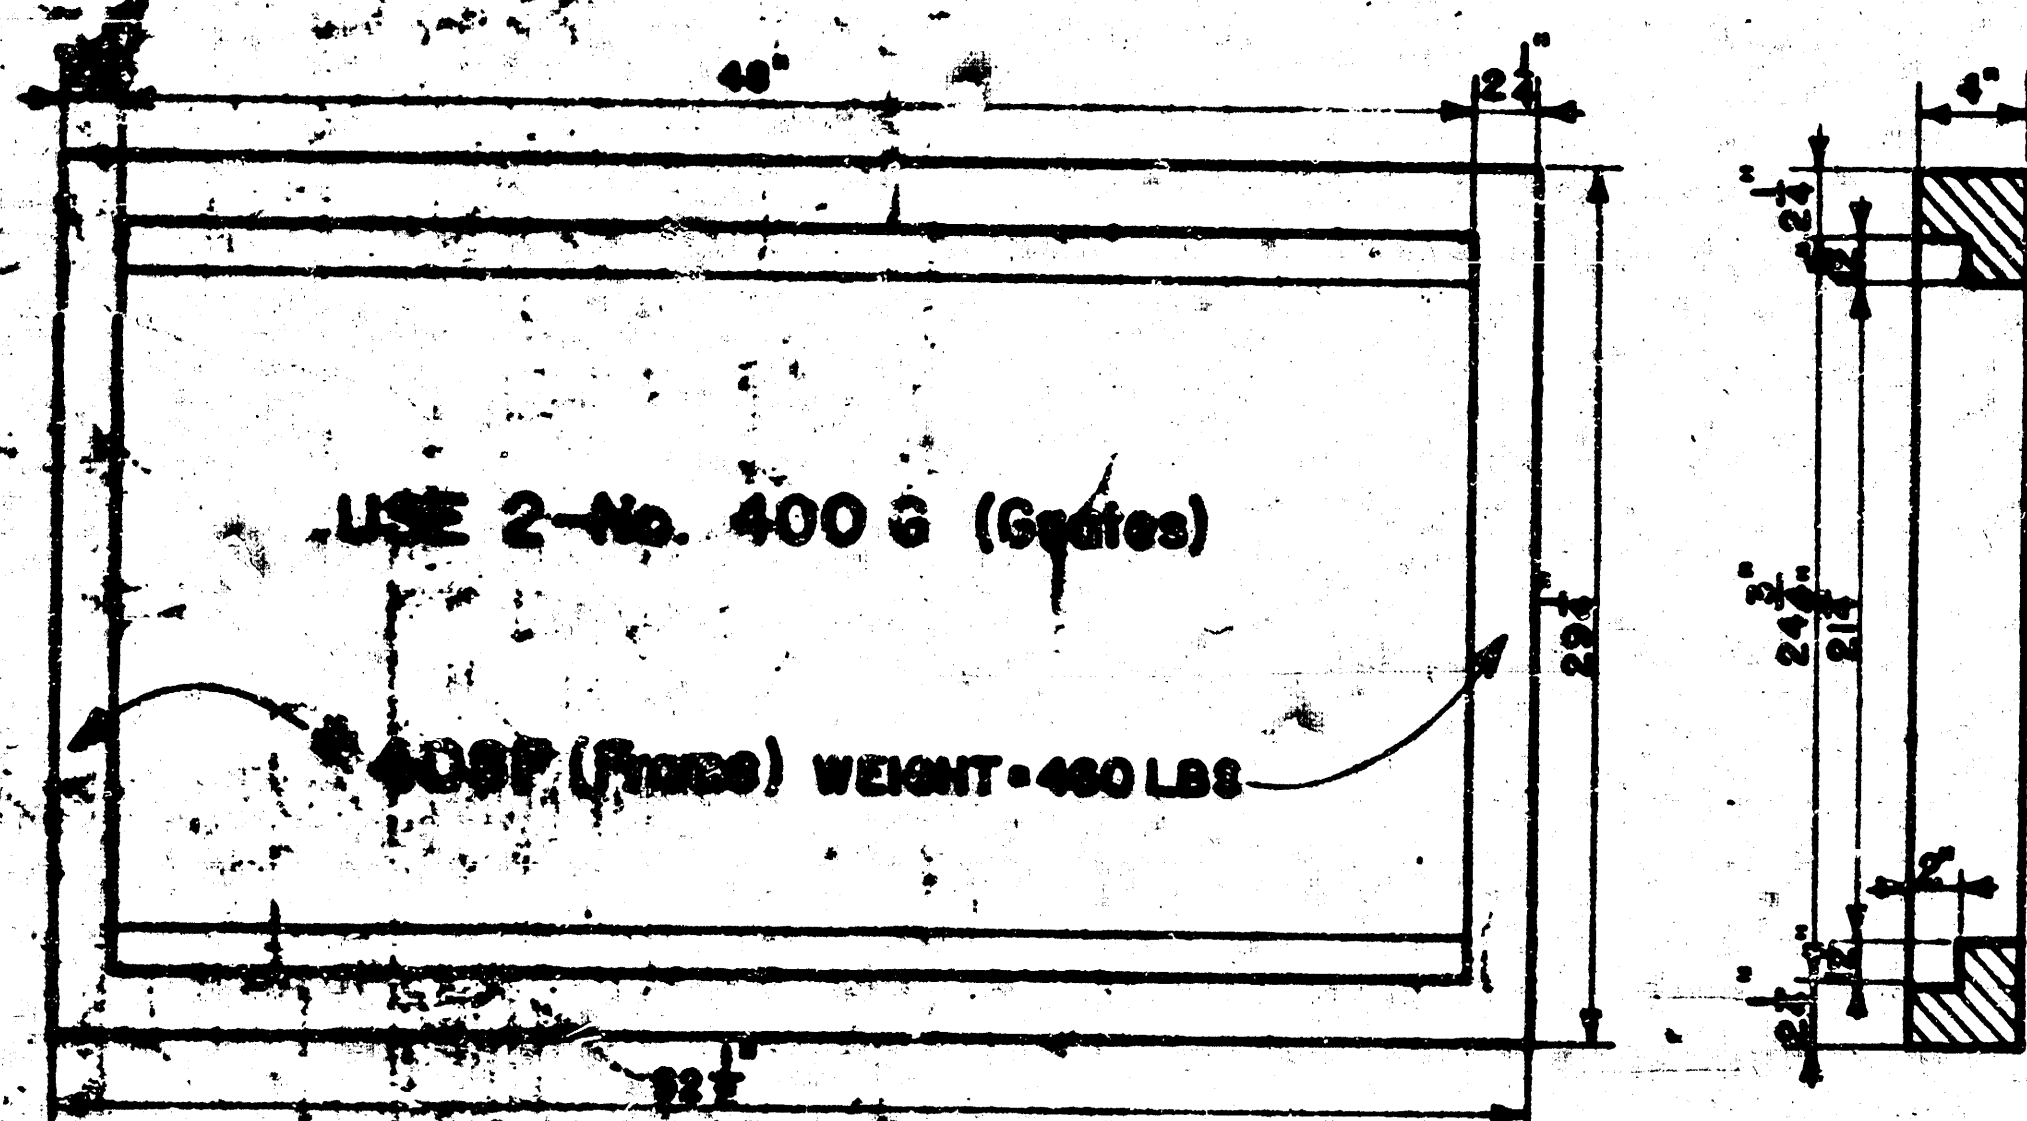


USE 2-No. 400 6 (Grates)

4006 (Frame) WEIGHT - 460 LBS


DOUBLE 24"x24" Frame Detail

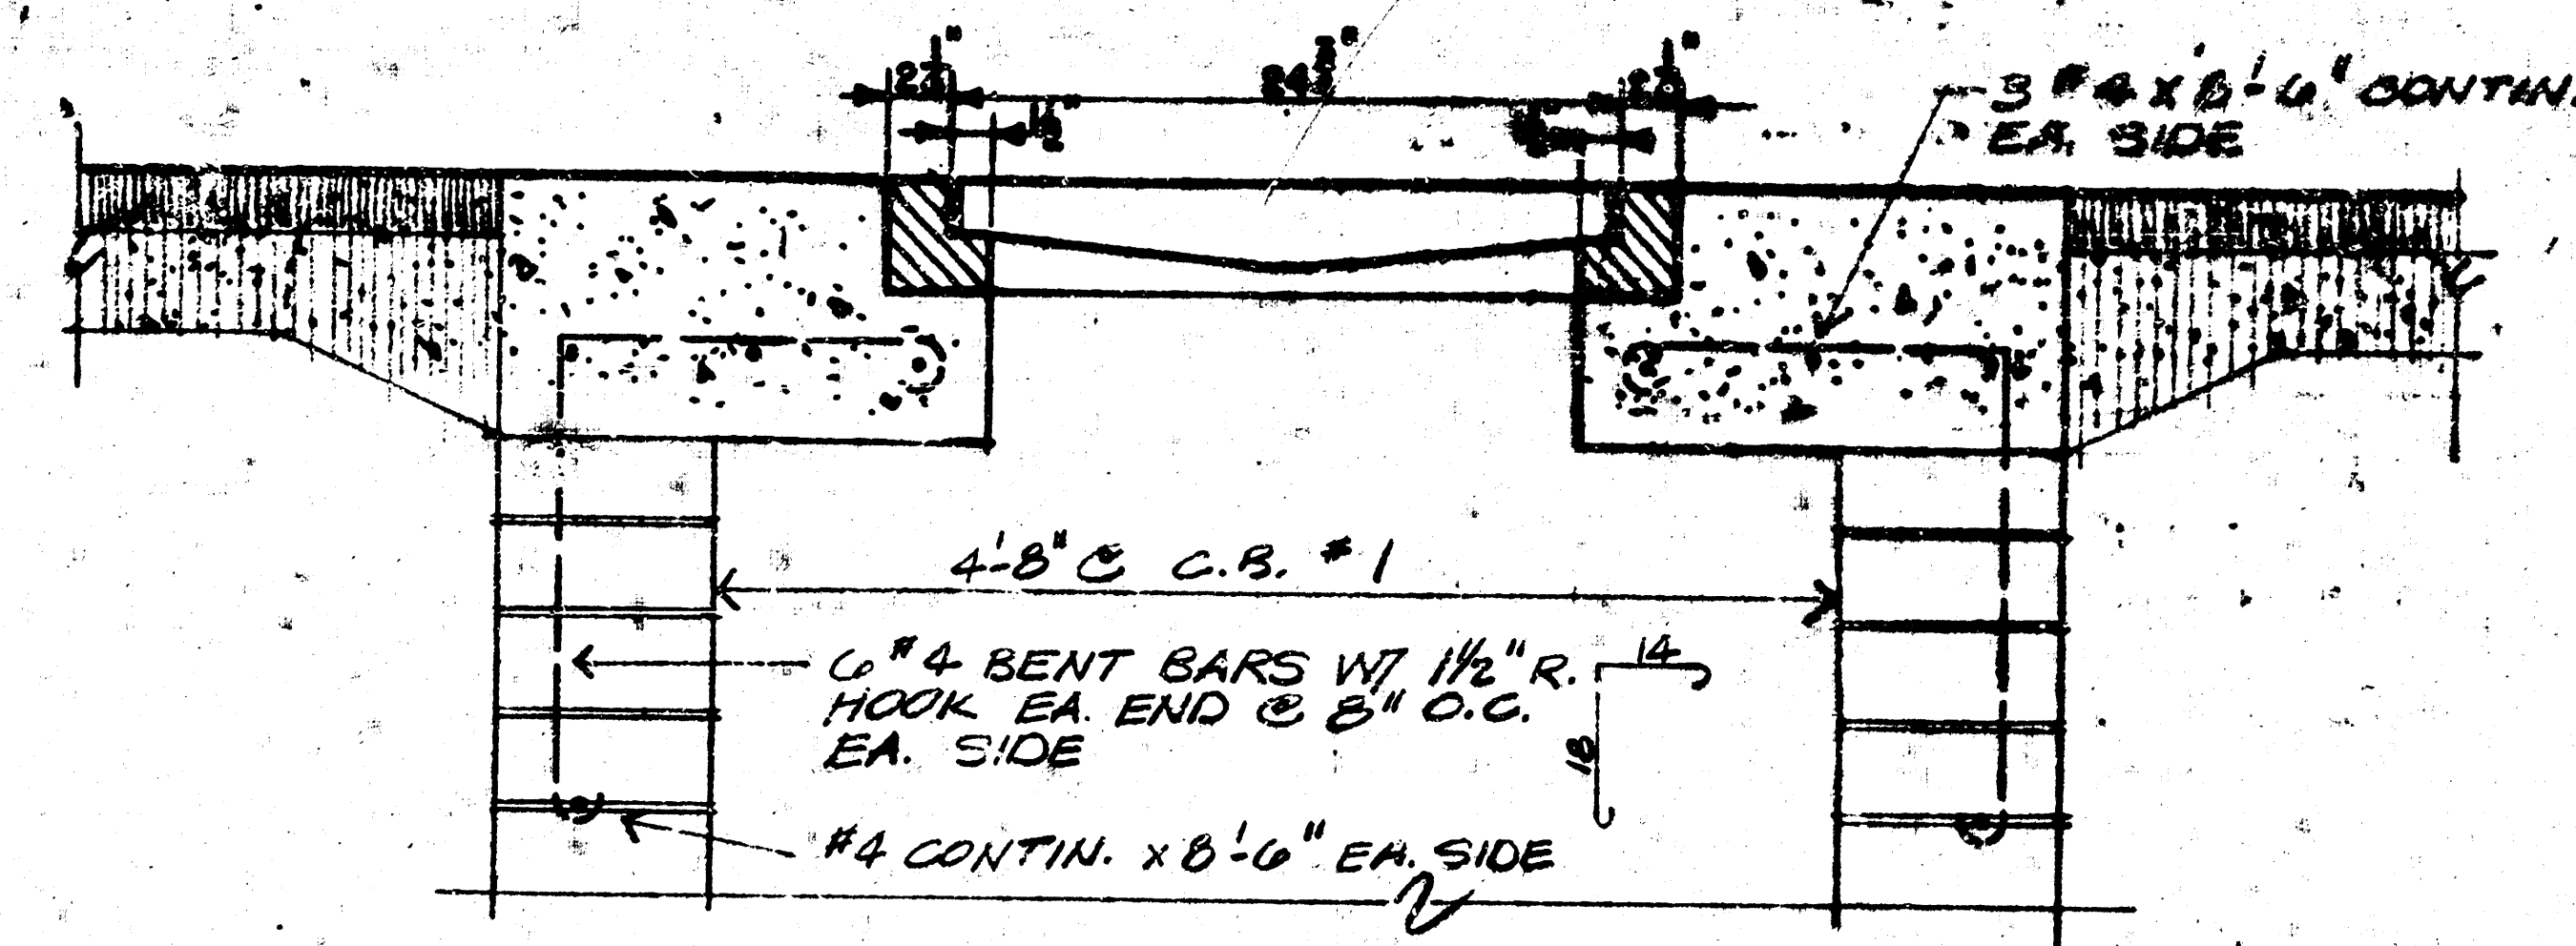

TRANSVERSE TOP SECTION CB #1

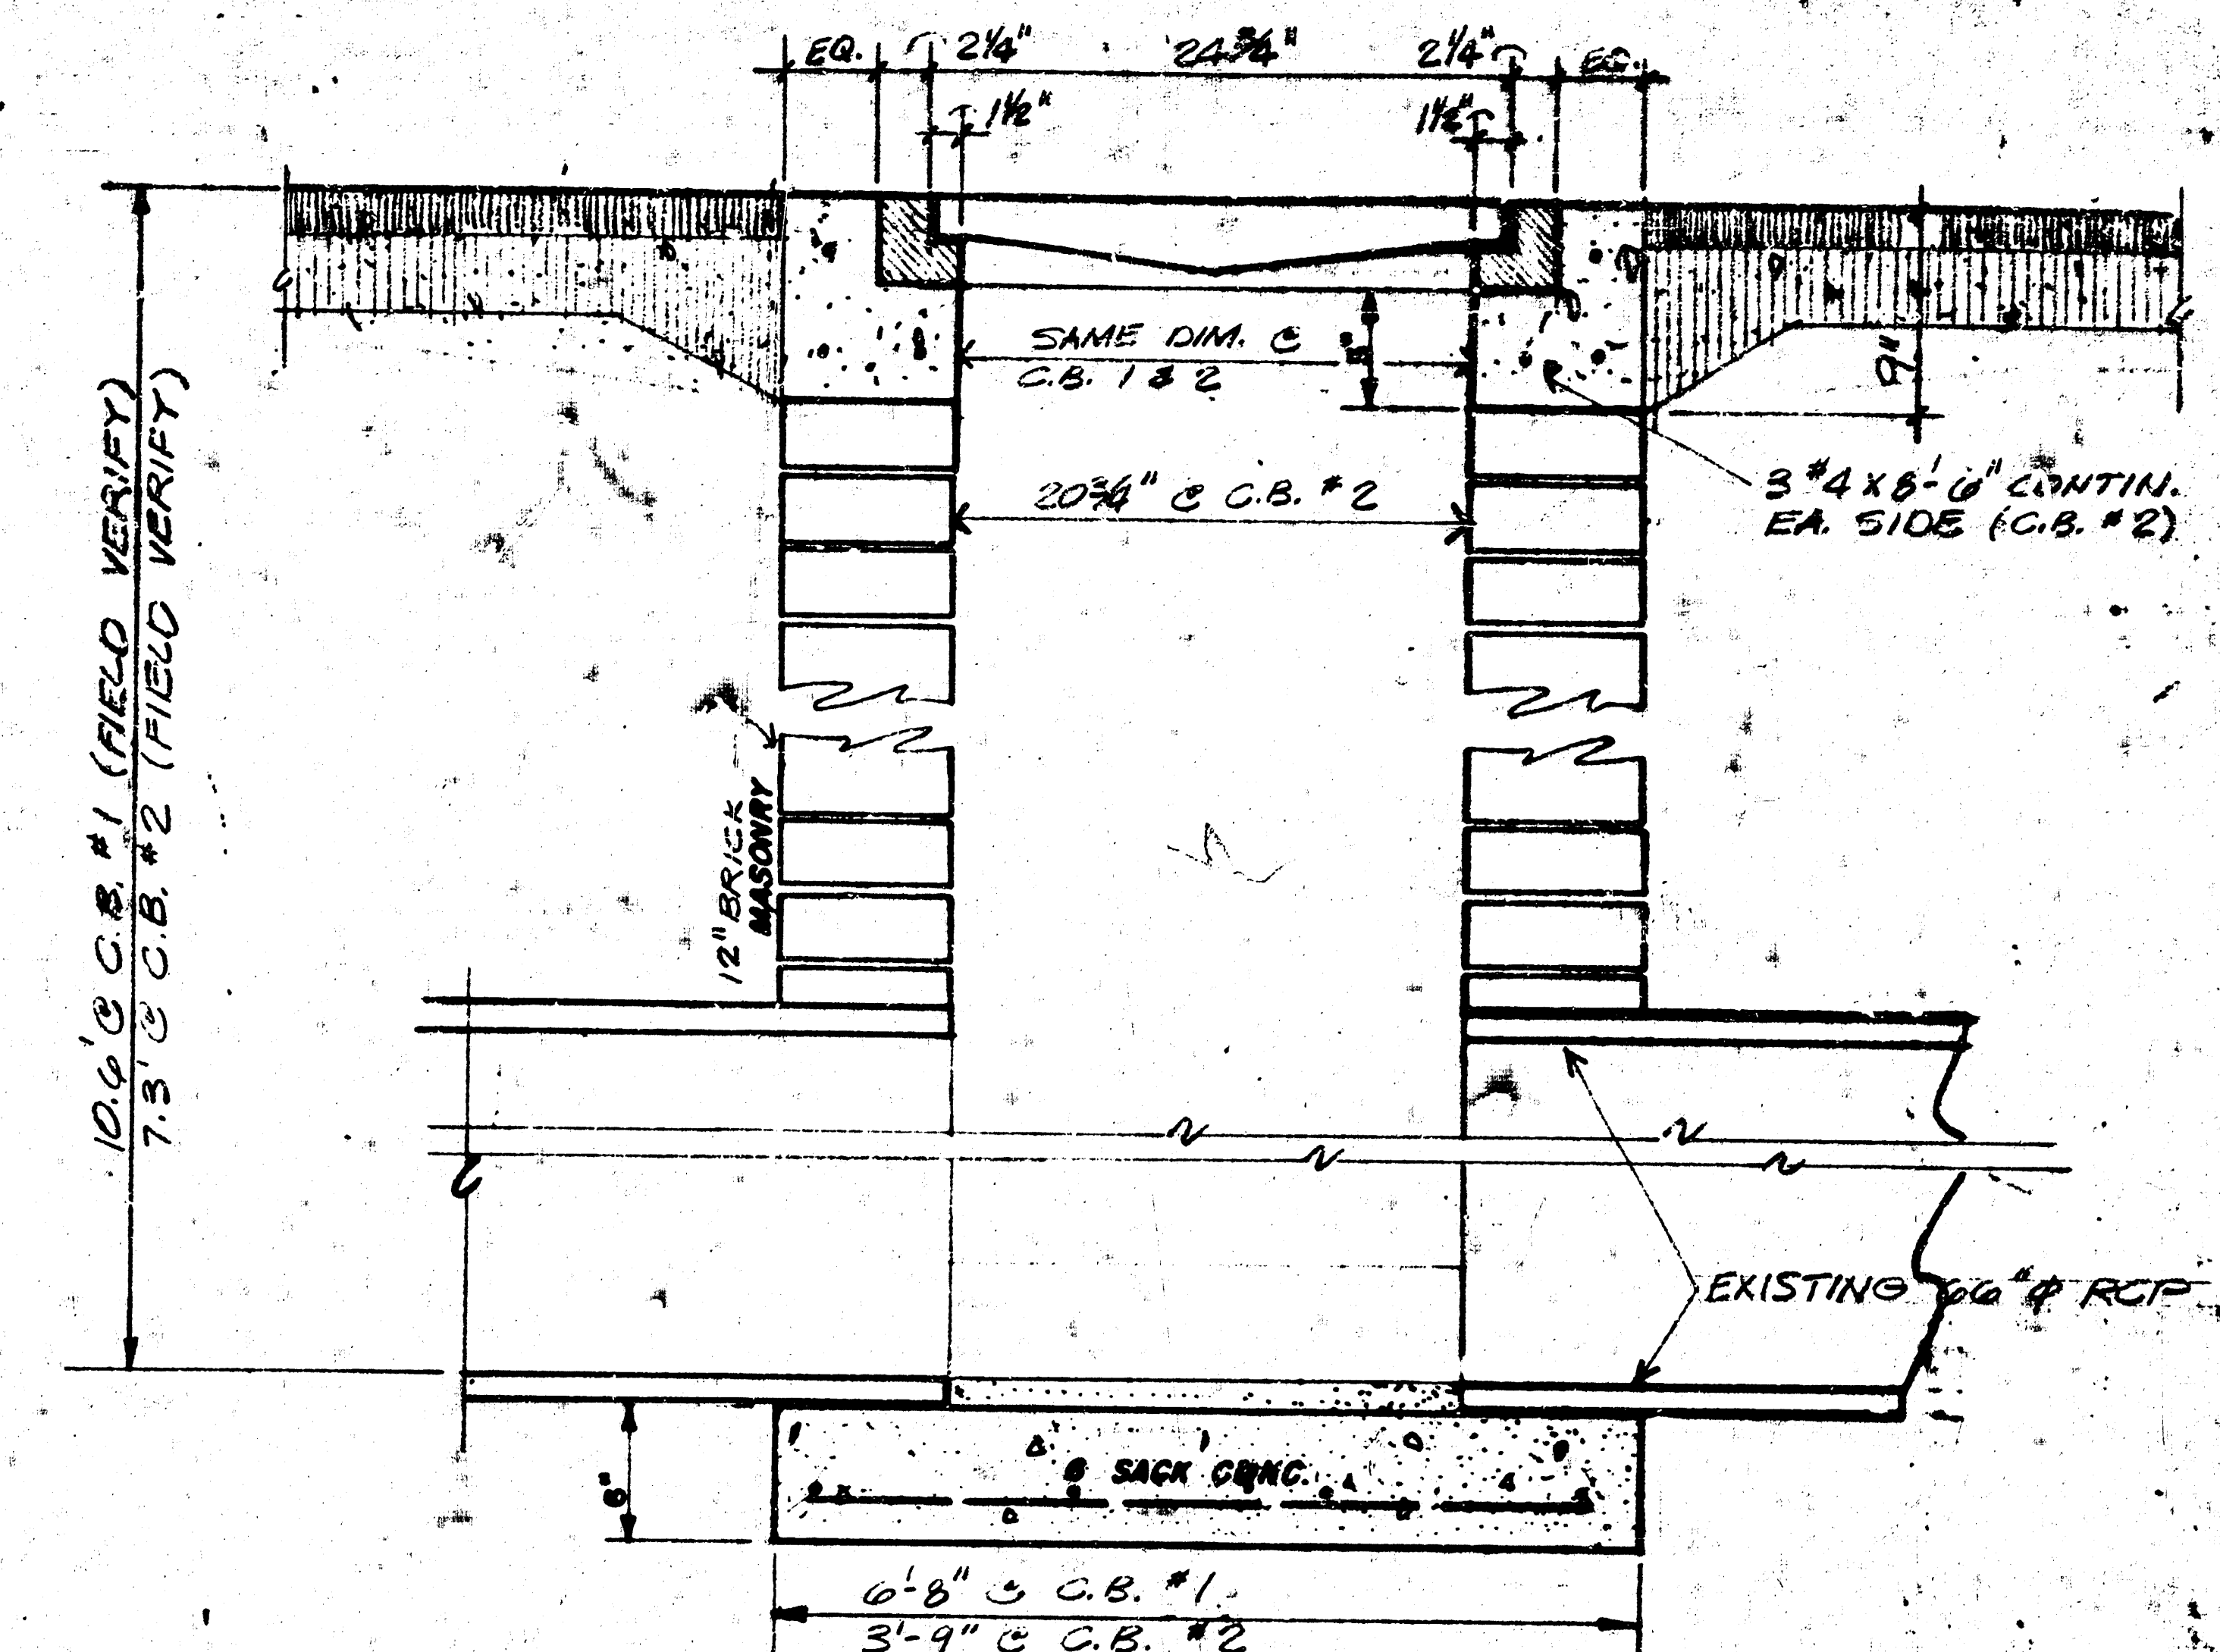

TRANSVERSE SECTION (TYPICAL)

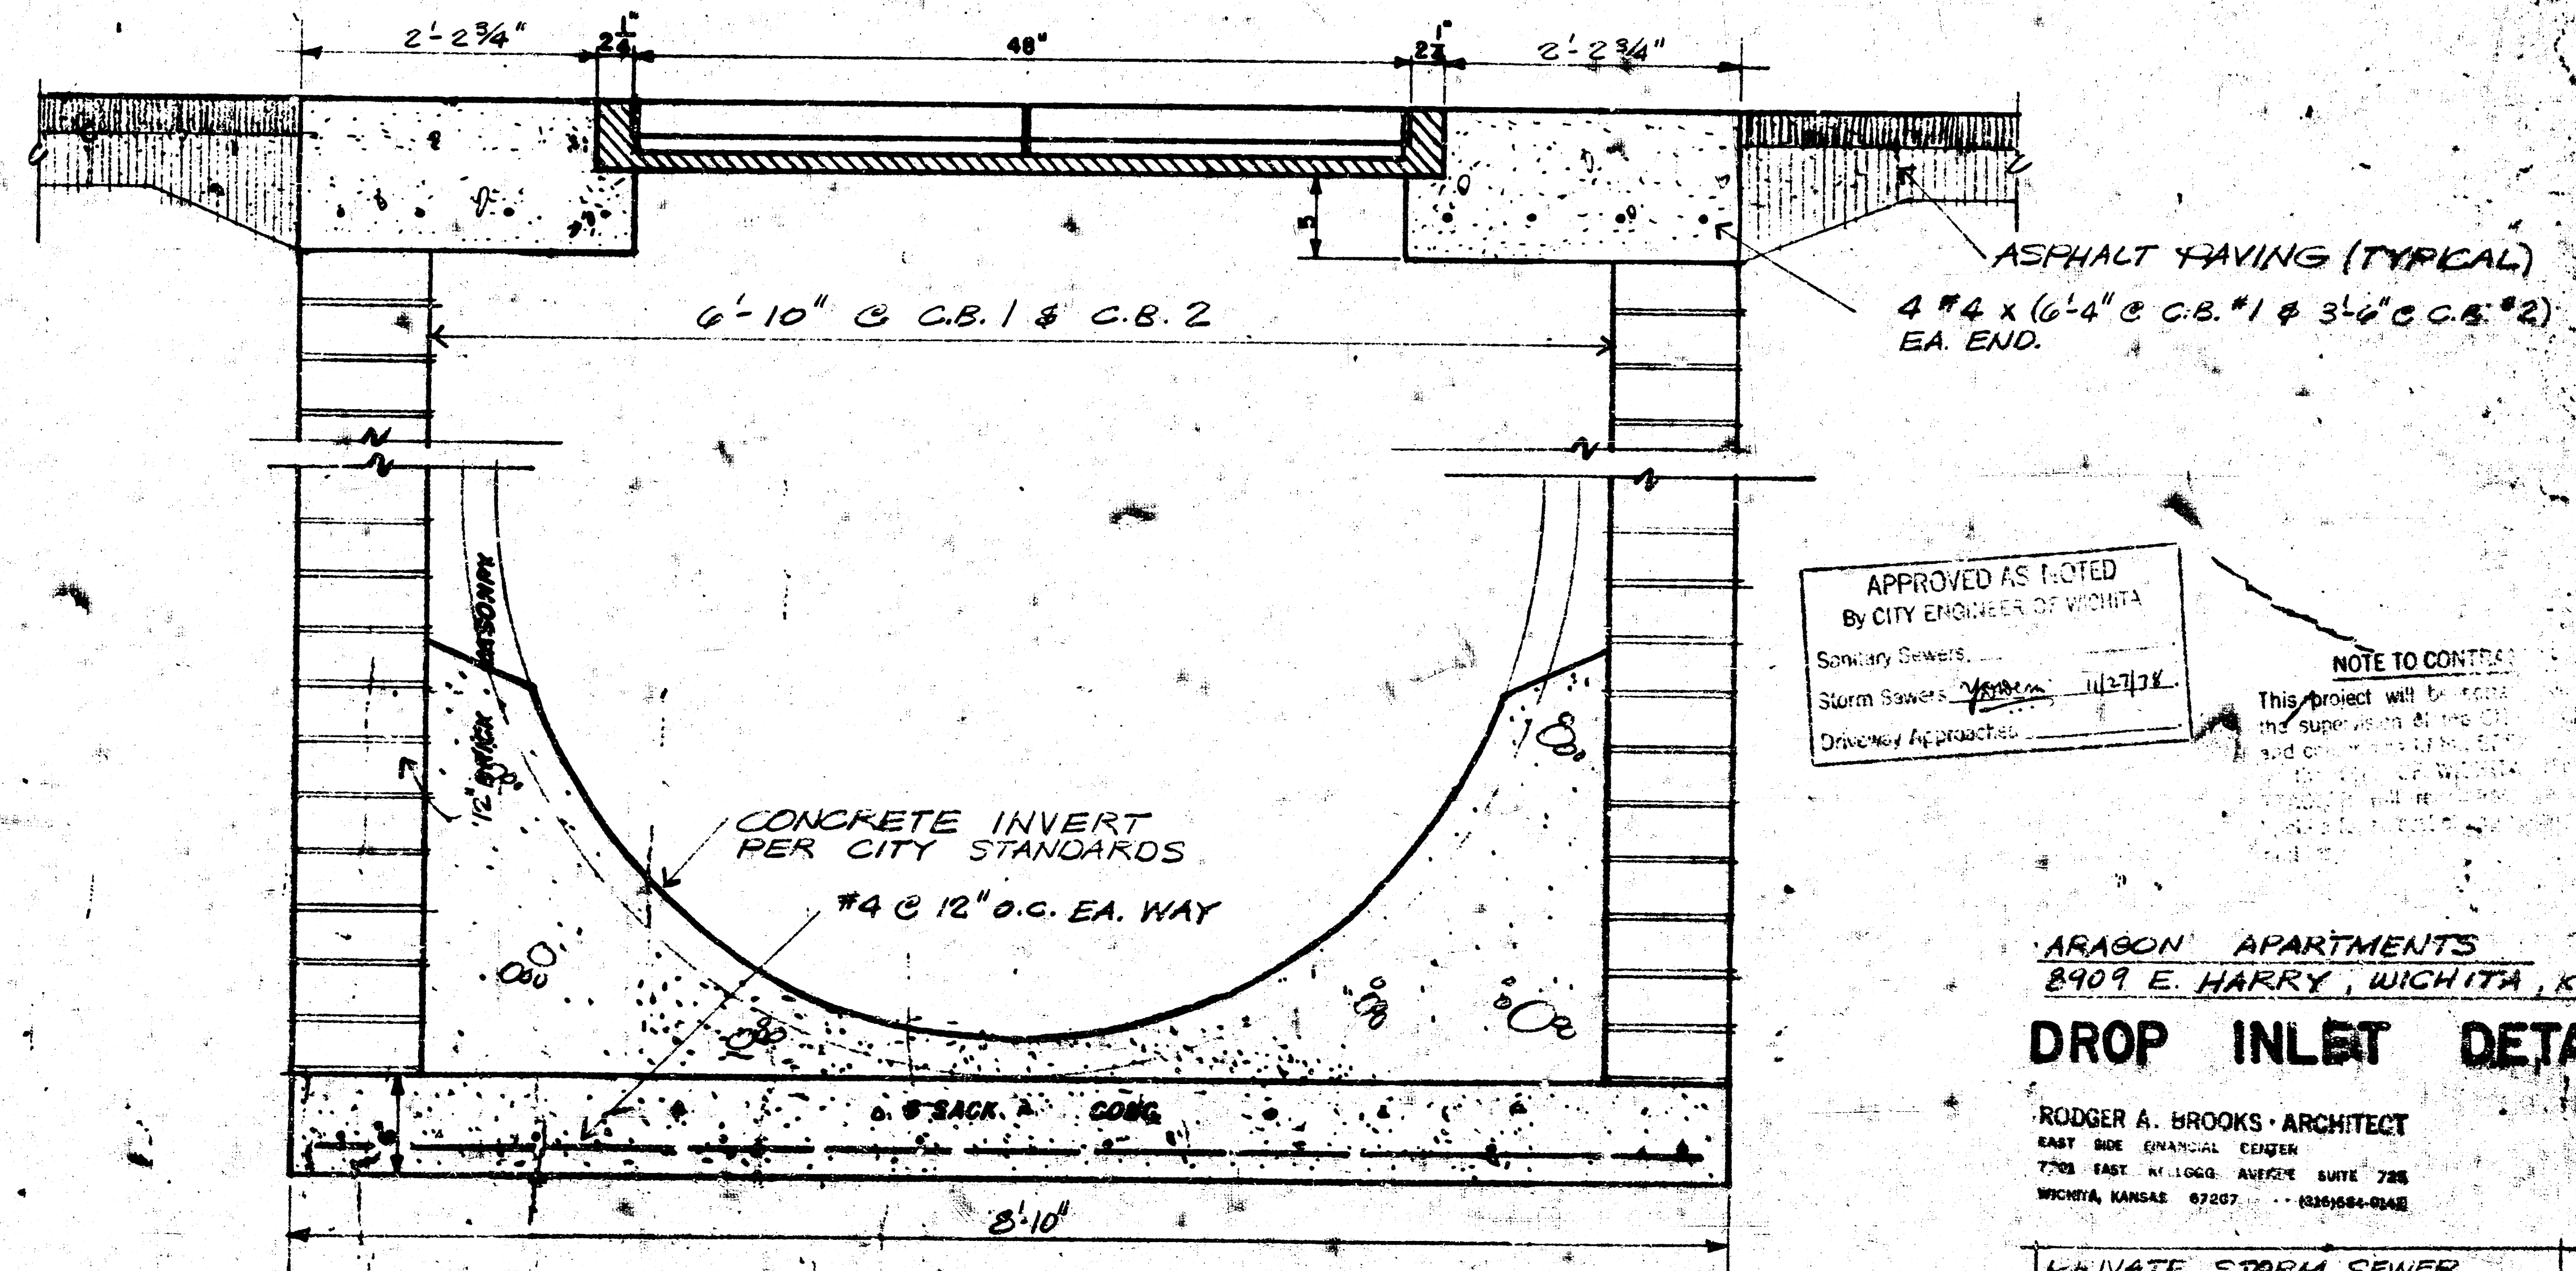

LONGITUDINAL SECTION (TYPICAL)

APPROVED AS NOTED
By CITY ENGINEER OF WICHITA
Sanitary Sewers...
Storm Sewers...
Drainage as projected

NOTE TO CONTRACTOR
This project will be under the supervision of the City Engineer of Wichita, Kansas. The contractor shall be responsible for the construction of the project in accordance with the plans and specifications.

ARABON APARTMENTS
8909 E. HARRY, WICHITA, KS.

DROP INLET DETAILS

RODGER A. BROOKS - ARCHITECT
EAST SIDE CHANCERY BUILDING
7708 EAST 41ST AVENUE SUITE 200
WICHITA, KANSAS 67207 (316) 266-0446

PRIVATE STORM SEWER
468-76-245-80663-000-000-000

Date: 11-21-78
Scale: NOT TO SCALE

C