
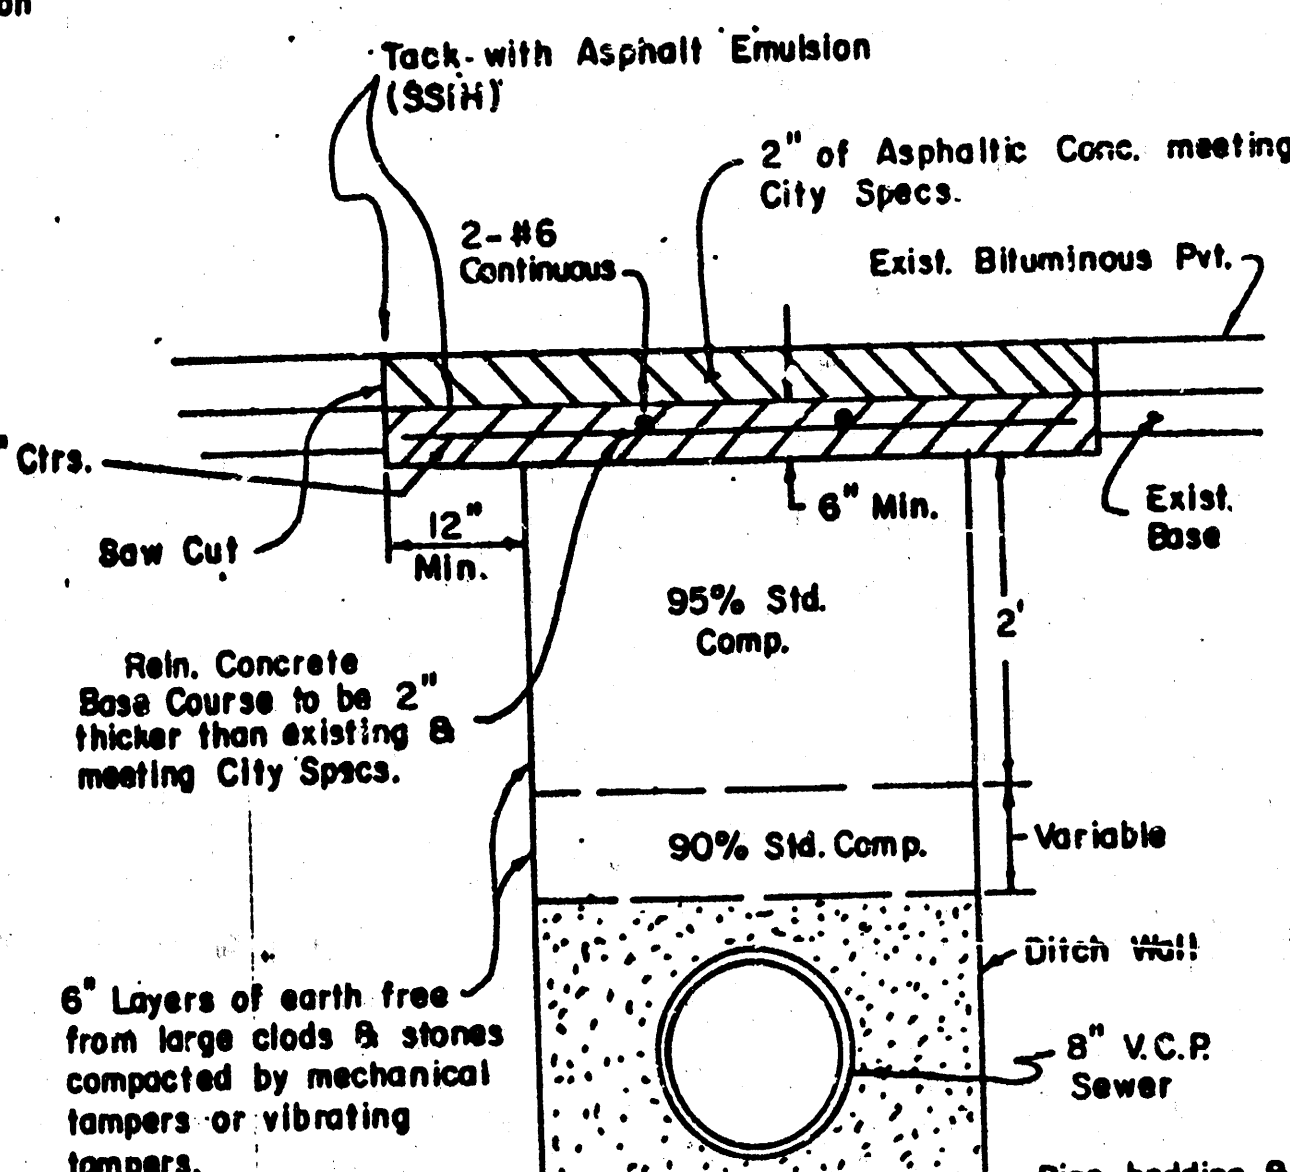
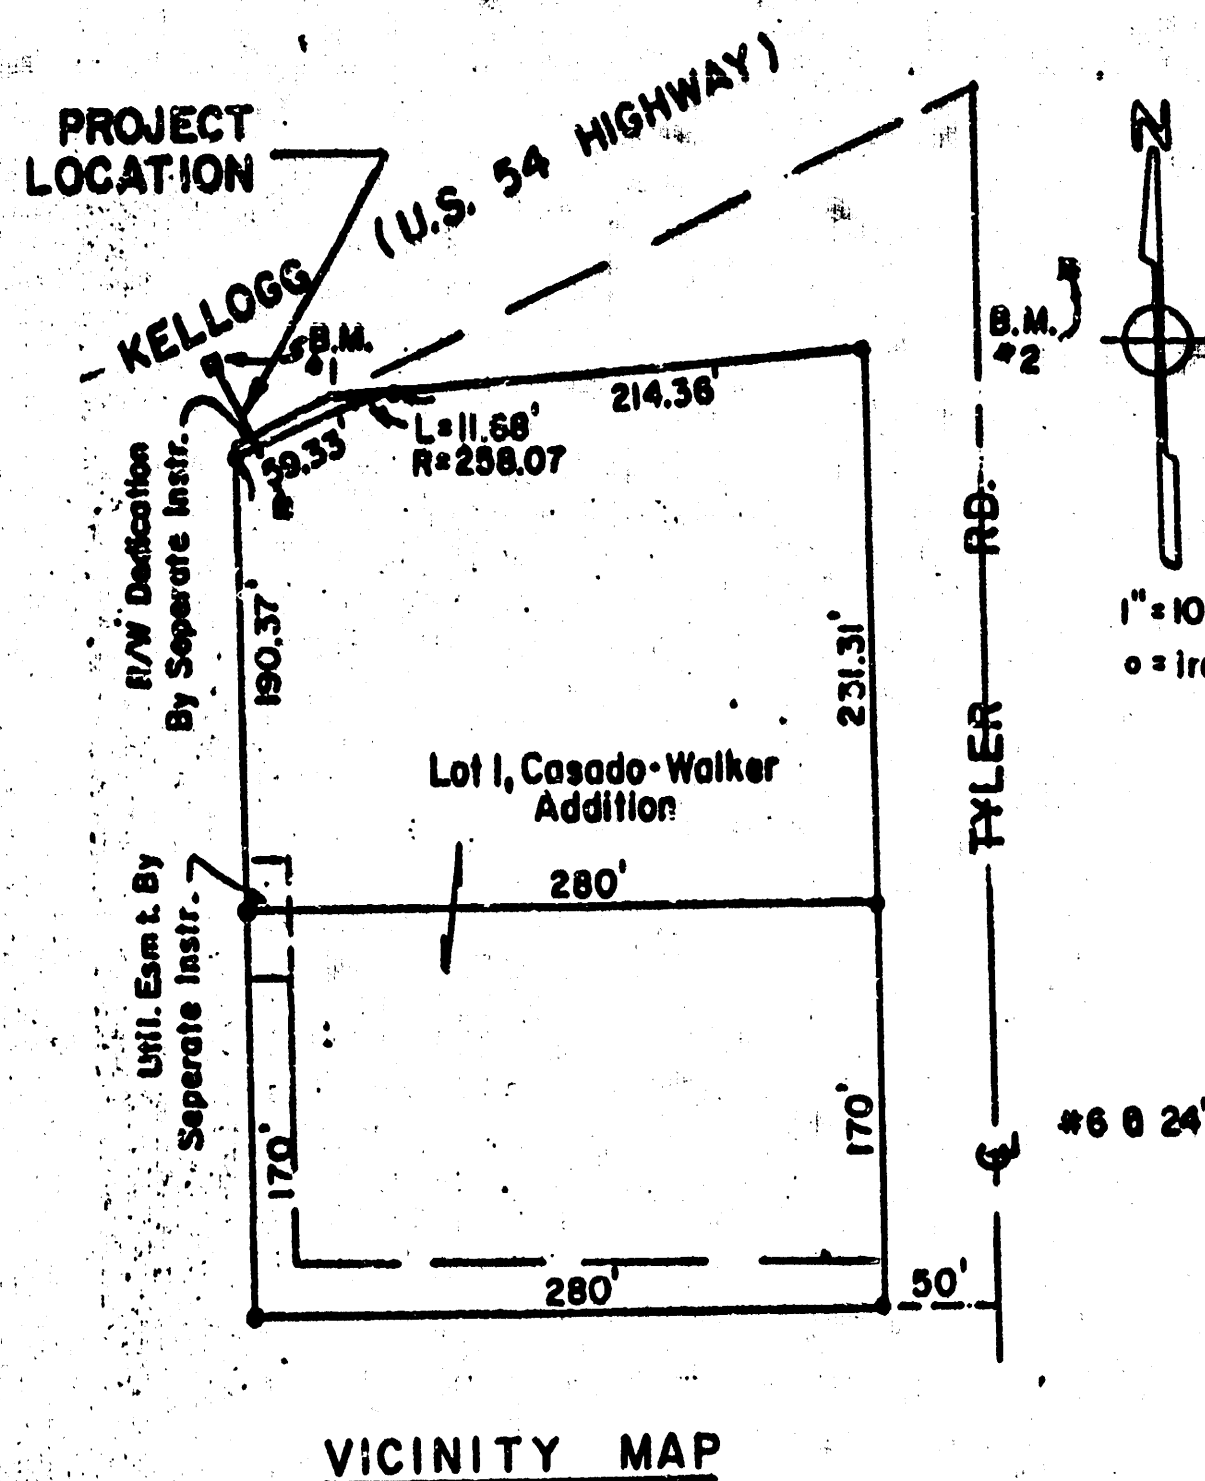


PLAN	DATE	BY
REVISIONS		
NO. 1		
NO. 2		
NO. 3		
NO. 4		
NO. 5		
NO. 6		
NO. 7		
NO. 8		
NO. 9		
NO. 10		

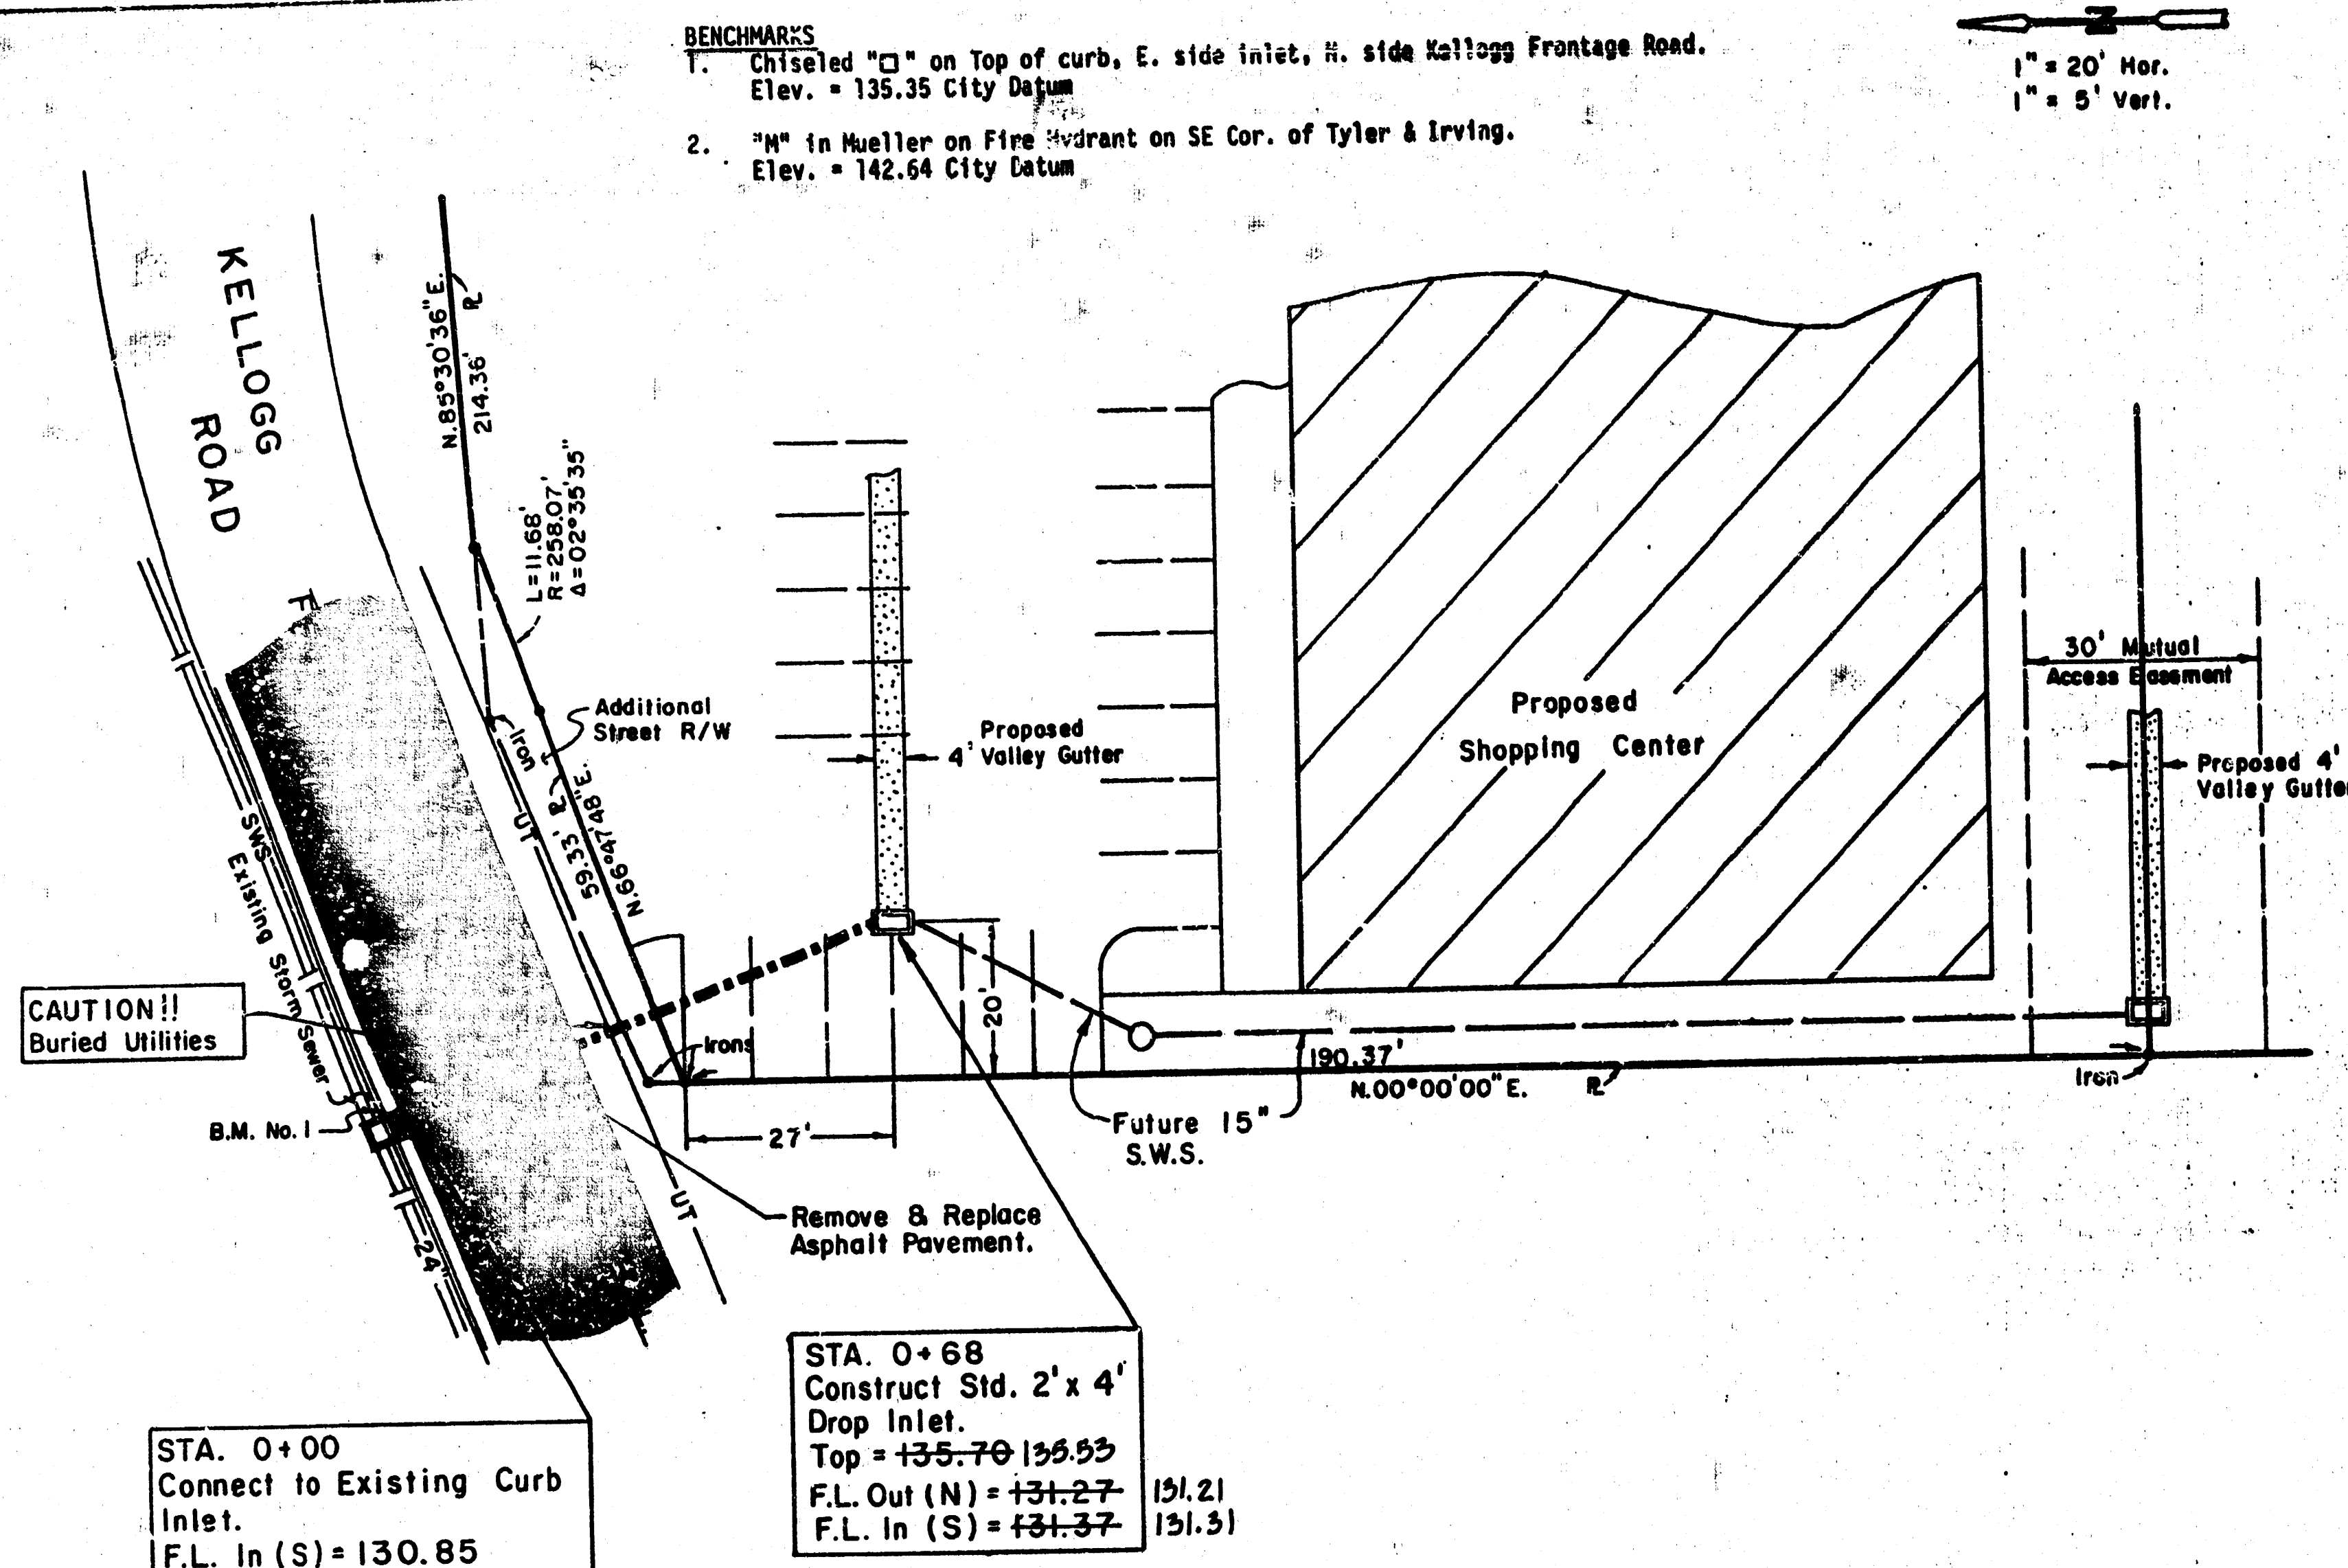


SPECIAL NOTE TO CONTRACTOR-
At each Street or Road Crossing, a minimum of one (1) Standard Density Test, as described in the latest addition of ASTM D698, shall be performed to verify the above requirements to the satisfaction of the Dept. of Engineering or the Dept. of Operations & Maintenance. All testing cost shall be included in the unit price bid for the pipe in place.

PAVEMENT R & R DETAIL

INDEX CODE 607861
USER CODE 208PPS

- NOTES:**
- CONTRACTOR WILL BE REQUIRED TO PROVIDE A MINIMUM ADVANCE NOTICE OF TWENTY-FOUR (24) HOURS TO UTILITY COMPANIES PRIOR TO STARTING ANY EXCAVATION AS FOLLOWS:
KANSAS ONE-CALL 682-2470
THE CONTRACTOR MUST NOTIFY THE FOLLOWING IN CASE OF AN EMERGENCY:
CABLEVISION 262-4270 OR 263-2061
K.P. & L. GAS SERVICE COMPANY 263-7511
KANSAS GAS & ELECTRIC 266-1141
SOUTHWESTERN BELL TELEPHONE COMPANY 1-571-2611
CITY OF WICHITA WATER DEPARTMENT 258-4908
CITY OF WICHITA SEWER MAINTENANCE 268-4071
 - CONTRACTOR SHALL CONSTRUCT ONE-HALF OF THE SEWER, WITHIN THE STREET RIGHT-OF-WAY, AT A TIME, ONE LANE OF TRAFFIC SHALL BE MAINTAINED OPEN DURING CONSTRUCTION.
 - UNDERGROUND UTILITY SERVICE LINES AND OVERHEAD UTILITY POLE LINES ARE TO BE ADJUSTED AS NECESSARY BY OTHERS PRIOR TO CONSTRUCTION UNLESS THE PLANS SPECIFICALLY CALL FOR THEIR ADJUSTMENT BY THE CONTRACTOR OR UNLESS THE PLANS SPECIFICALLY IDENTIFY A UTILITY TO BE ADJUSTED BY ITS OWNER DURING CONSTRUCTION. EXISTING UTILITIES AND THEIR LOCATION, AS SHOWN ON THE PLANS, REPRESENT THE BEST INFORMATION OBTAINABLE FOR DESIGN. LOCATION INFORMATION HAS BEEN OBTAINED FROM THE VARIOUS UTILITY COMPANIES AND IS EITHER FROM COMPANY RECORD DRAWINGS OR COMPANY PROVIDED FIELD LOCATIONS. THE CONTRACTOR WILL BE REQUIRED TO WORK AROUND EXISTING UTILITIES WITHIN THE RIGHT-OF-WAY WHICH DO NOT CONFLICT WITH PROPOSED CONSTRUCTION.
 - RUBBLE FROM THE REMOVAL OF MISCELLANEOUS STRUCTURES AND EXCESS EXCAVATION WHICH IS TO BE WASTED, SHALL BE DISPOSED OF ON SITES TO BE PROVIDED BY THE CONTRACTOR. SITES SHALL BE APPROVED BY THE ENGINEER AS TO SUITABILITY, APPEARANCE AND SITE LOCATION. LOCATIONS THAT, IN THE OPINION OF THE ENGINEER, WILL LEAVE AN UNGRACEFUL APPEARANCE WILL NOT BE APPROVED.
 - THE CONTRACTOR SHALL GIVE ALL PROPERTY OWNERS AND/OR TENANTS OF DEVELOPED PROPERTY DIRECTLY ADJACENT TO THE CONSTRUCTION OF THIS PROJECT A MINIMUM OF TEN (10) DAYS ADVANCE NOTICE PRIOR TO START OF CONSTRUCTION.
 - THE CONTRACTOR SHALL BE RESPONSIBLE FOR PRESERVING PROPERTY TREES. THE CONTRACTOR WILL BE REQUIRED TO RE-ESTABLISH ANY PROPERTY TREES WHICH ARE DAMAGED OR DESTROYED BY HIS CONSTRUCTION OPERATIONS. SUCH TREES SHALL BE RE-ESTABLISHED BY A LICENSED LAND SURVEYOR IN ACCORDANCE WITH STATE LAWS.
 - PAVEMENT REMOVAL AND/OR REPLACEMENT WILL BE MEASURED AND PAID FOR ON THE LINEAL FOOT BASIS AS MEASURED ALONG THE CENTERLINE OF THE SEWER REGARDLESS OF WIDTH. PAVEMENT TYPE AND/OR PAVEMENT THICKNESS. MINIMUM LIMITS OF SUCH PAVEMENT REMOVAL AND REPLACEMENT SHALL BE ONE FOOT BEYOND THE LIMITS OF THE EXCAVATION MADE FOR THE REMOVAL OF THE STRUCTURE EXCEPT WHEN SUCH LIMITS OF REMOVAL ARE WITHIN THREE (3) FEET OF AN EXISTING JOINT AND LIMITS OF REMOVAL SHALL BE EXTENDED TO THE EXISTING JOINT. REMOVAL AND REPLACEMENT OF EXISTING PAVEMENT SHALL CONFORM TO THE APPLICABLE SECTIONS OF THE CITY OF WICHITA STANDARD SPECIFICATIONS.

Revised As-built 7-16-89 TCR
PRIVATE STORM WATER SEWER EXTENSION
TO SERVE
LOT 1, EXCEPT THE SOUTH 170',
CASADO-WALKER ADDITION
CITY OF WICHITA, KANSAS
MOEHRING & ASSOCIATES
CONSULTING ENGINEERS
WICHITA

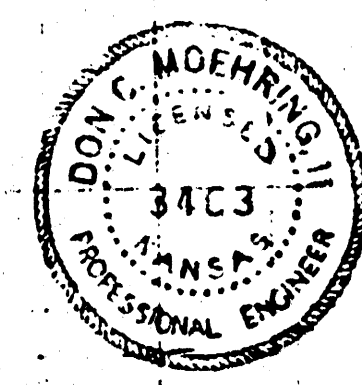

Booked
7-89
mg




Technical drawing of a square frame. The main view is a square with an outer dimension of 28" and an inner dimension of 24". The text inside the square reads: **#400F (Frame)** and **WEIGHT = 235 LBS.** There are four small circles at the corners of the inner square, each labeled 1/4". To the right is a cross-section view showing the frame's profile with dimensions 1/4", 1/2", 1/4", and 1/2". The cross-section is divided into two parts, each labeled 1/2".

Technical drawing of a rectangular frame structure. The front view shows a frame with internal vertical bars. Dimensions are indicated: a top horizontal bar with a width of $23\frac{1}{2}''$ and a height of $2\frac{1}{2}''$. The side view shows a frame with a height of $23\frac{1}{2}''$ and a width of $2\frac{1}{2}''$. The side view also shows a sloped section with a height of $2\frac{1}{2}''$ and a width of $2\frac{1}{2}''$.

24"x24" Frame & Grate Detail

Technical drawing of a rectangular frame. The overall dimensions are 48" wide and 32" high. The inner frame dimensions are 32 1/4" wide and 22 1/4" high. The text inside the frame reads: "USE 2-No. 400 G (Grates)" and "# 408F (Frame) WEIGHT=460 LBS". The drawing includes a side view on the right showing the frame's profile and a detail view of the corner connection.

Double 24"x24" Frame Detail

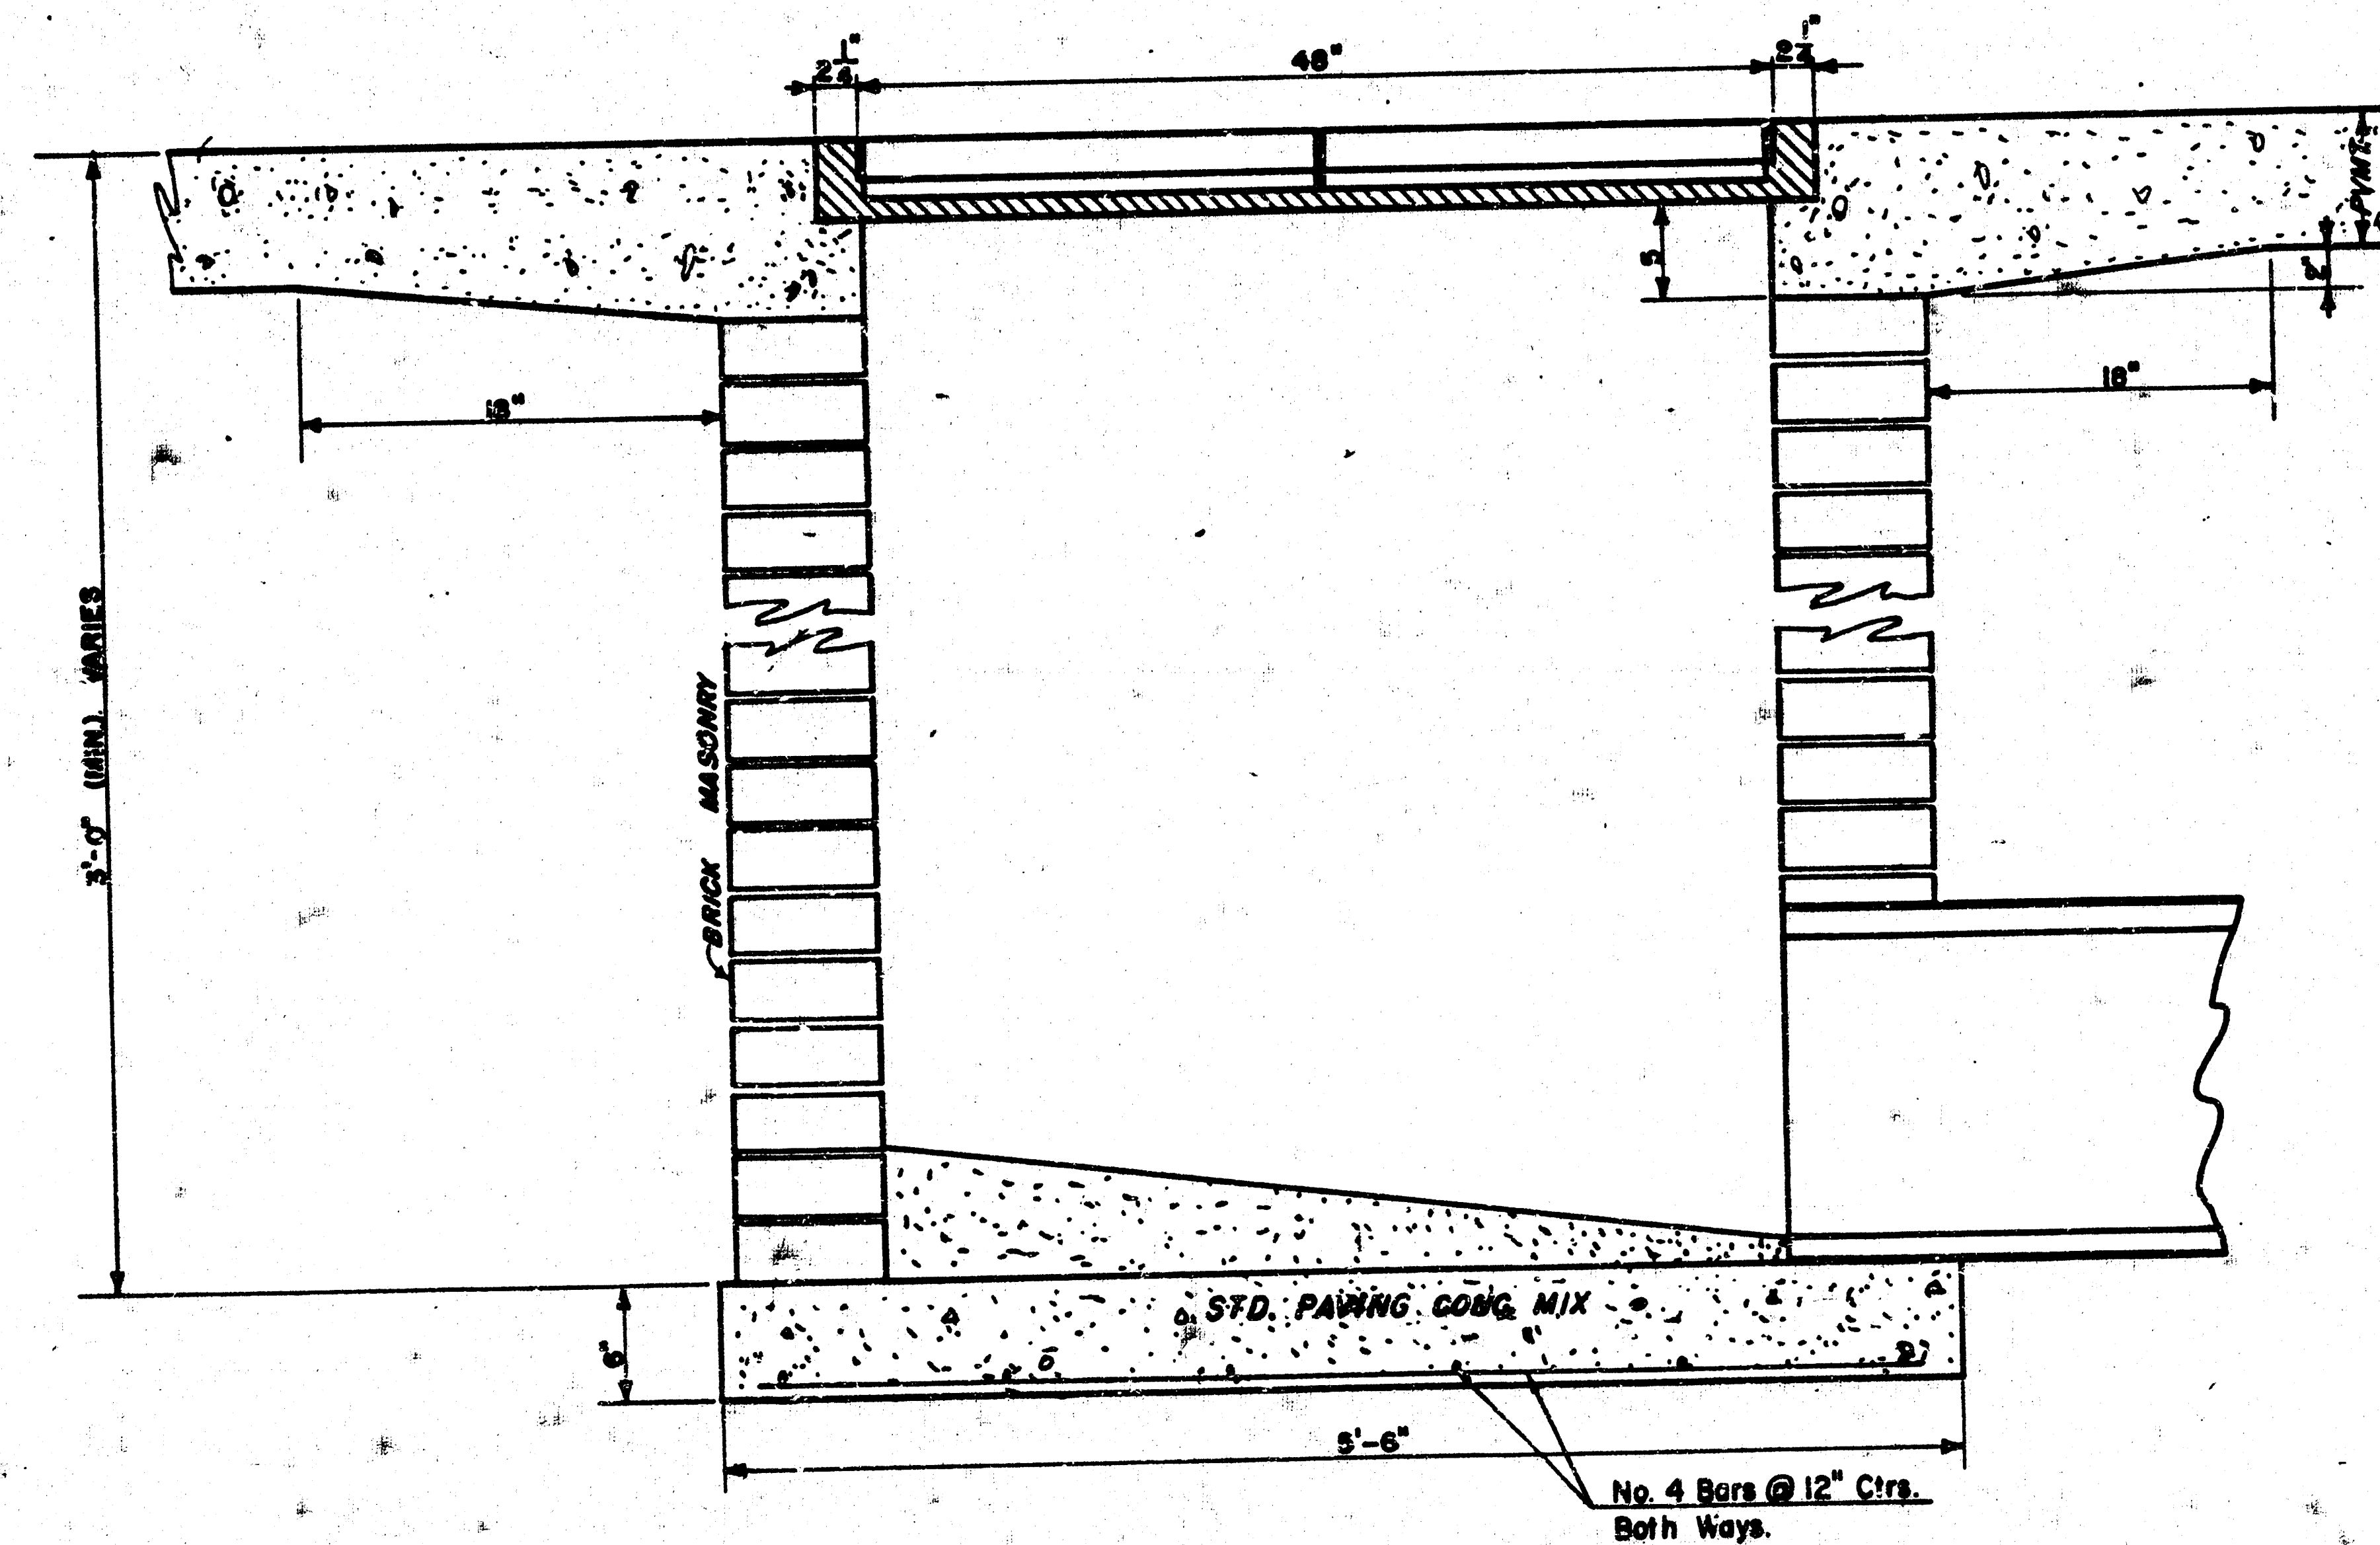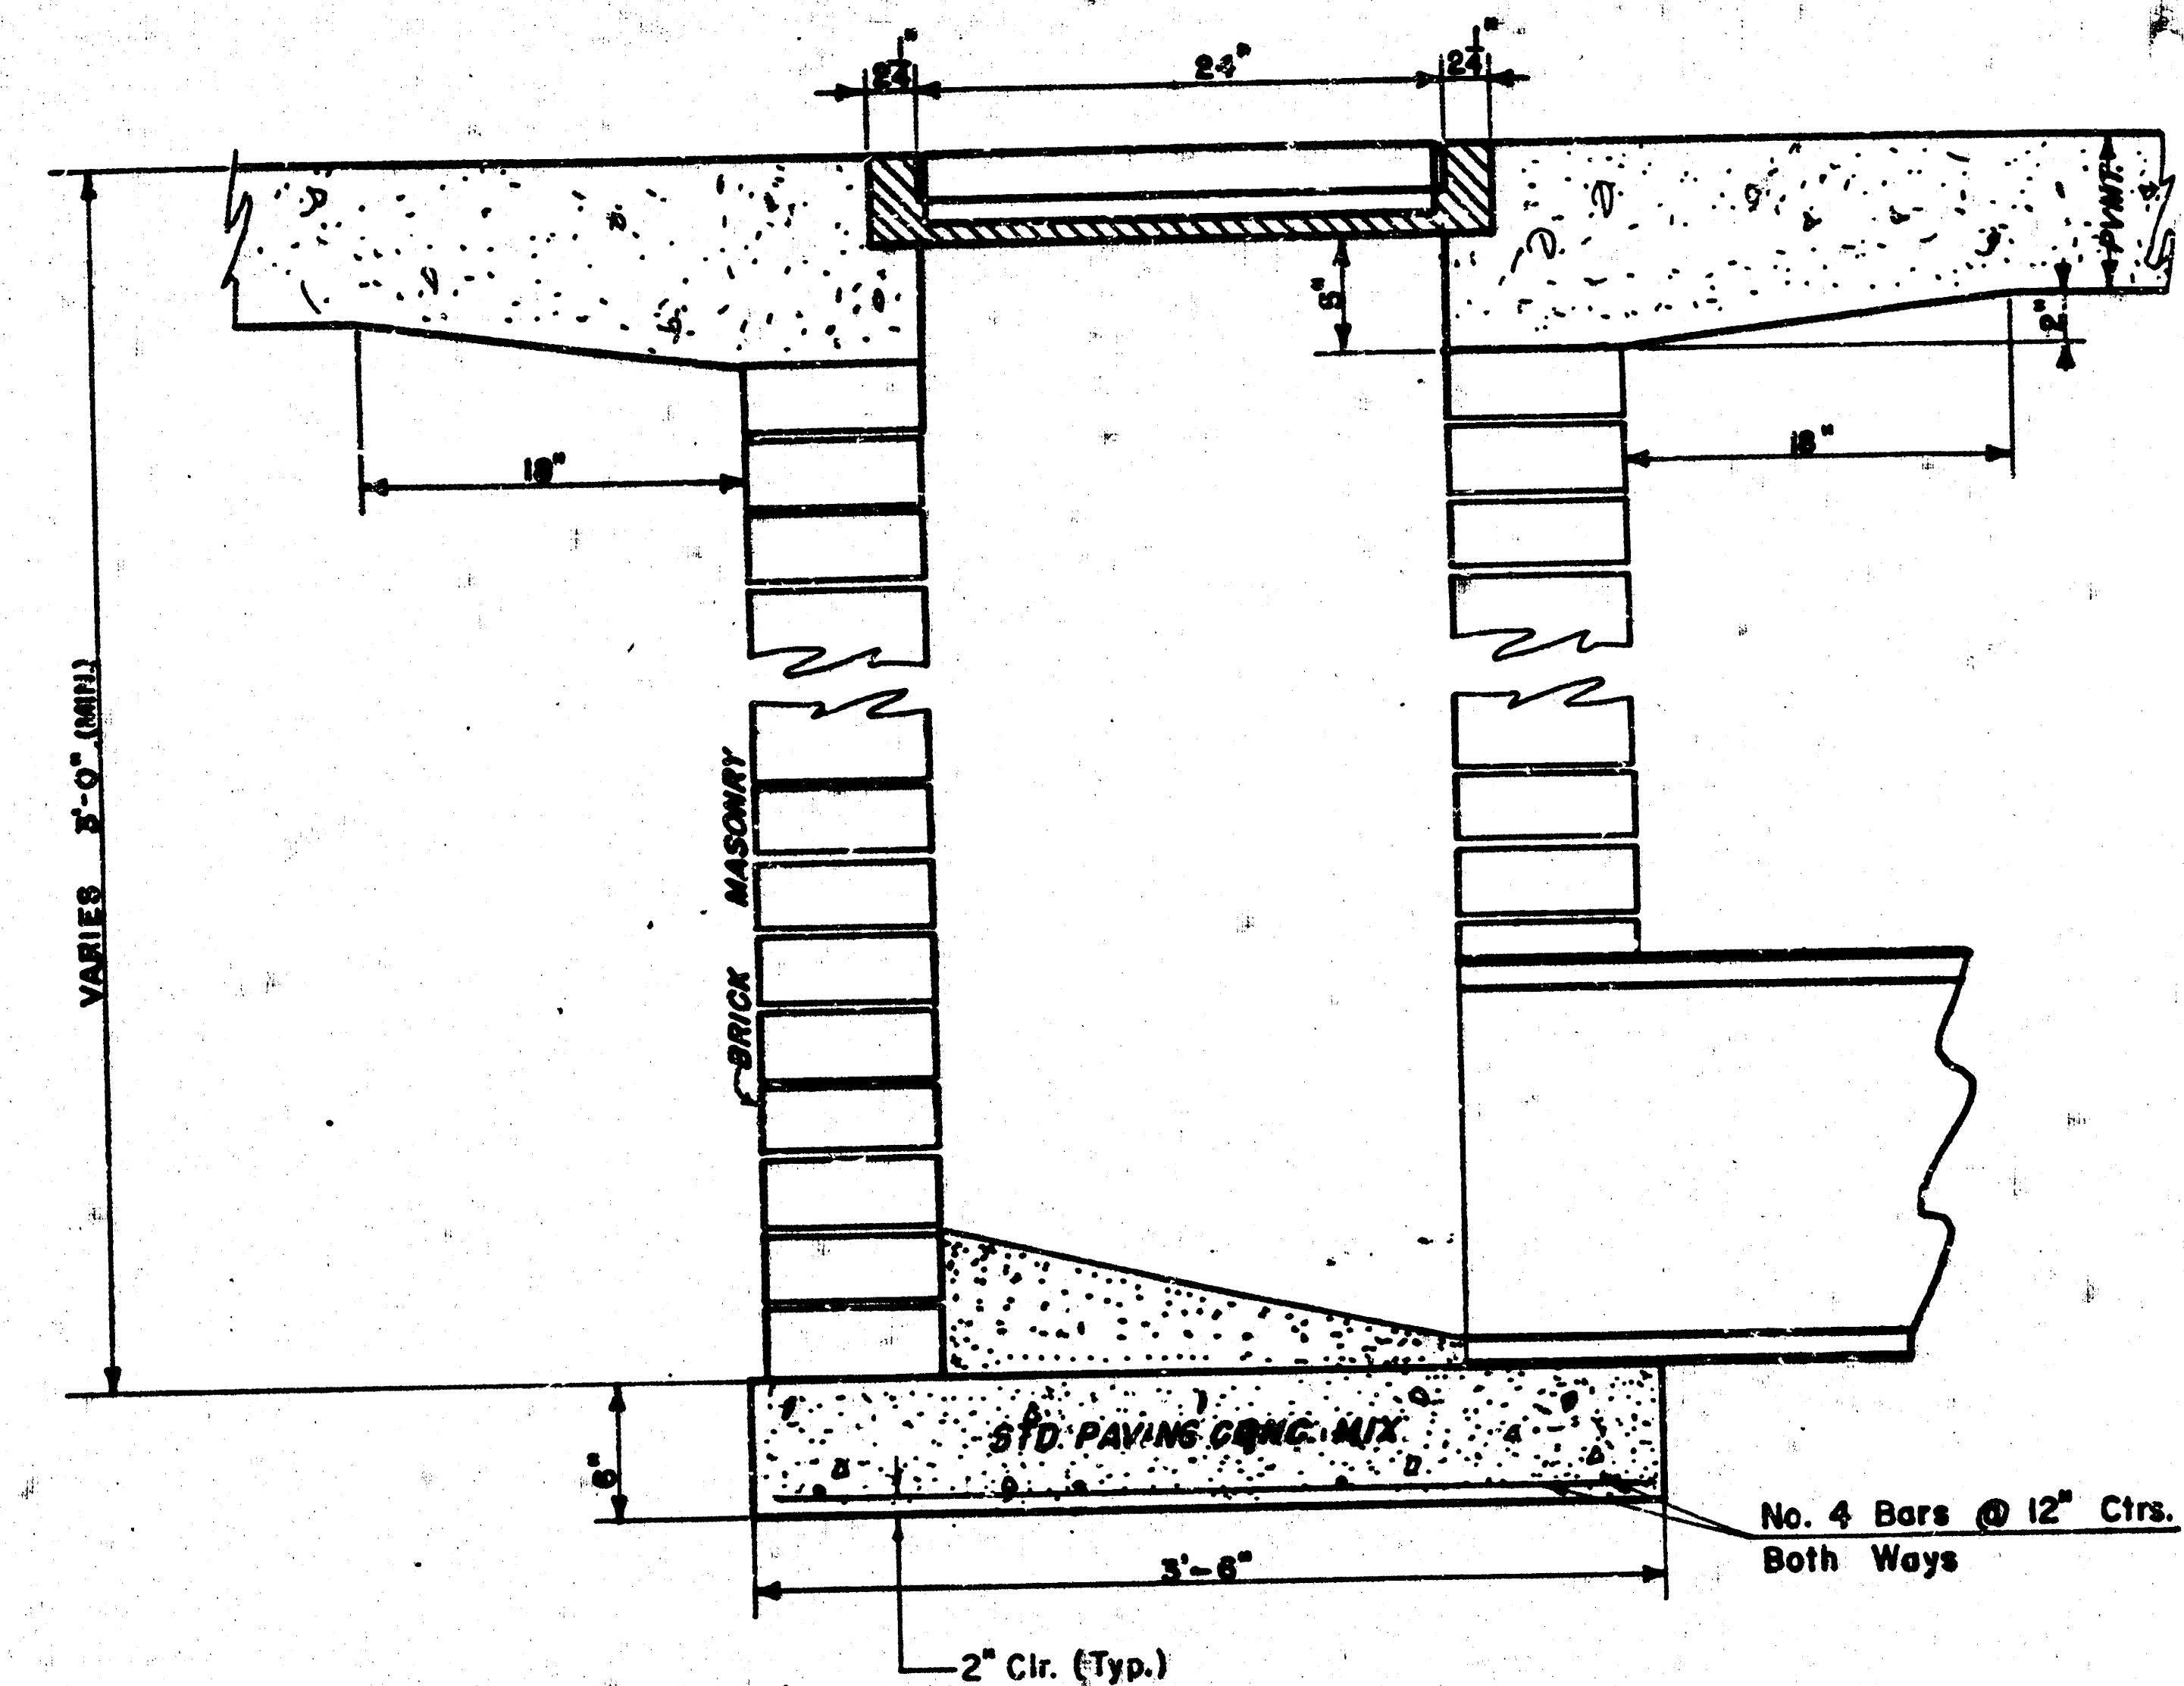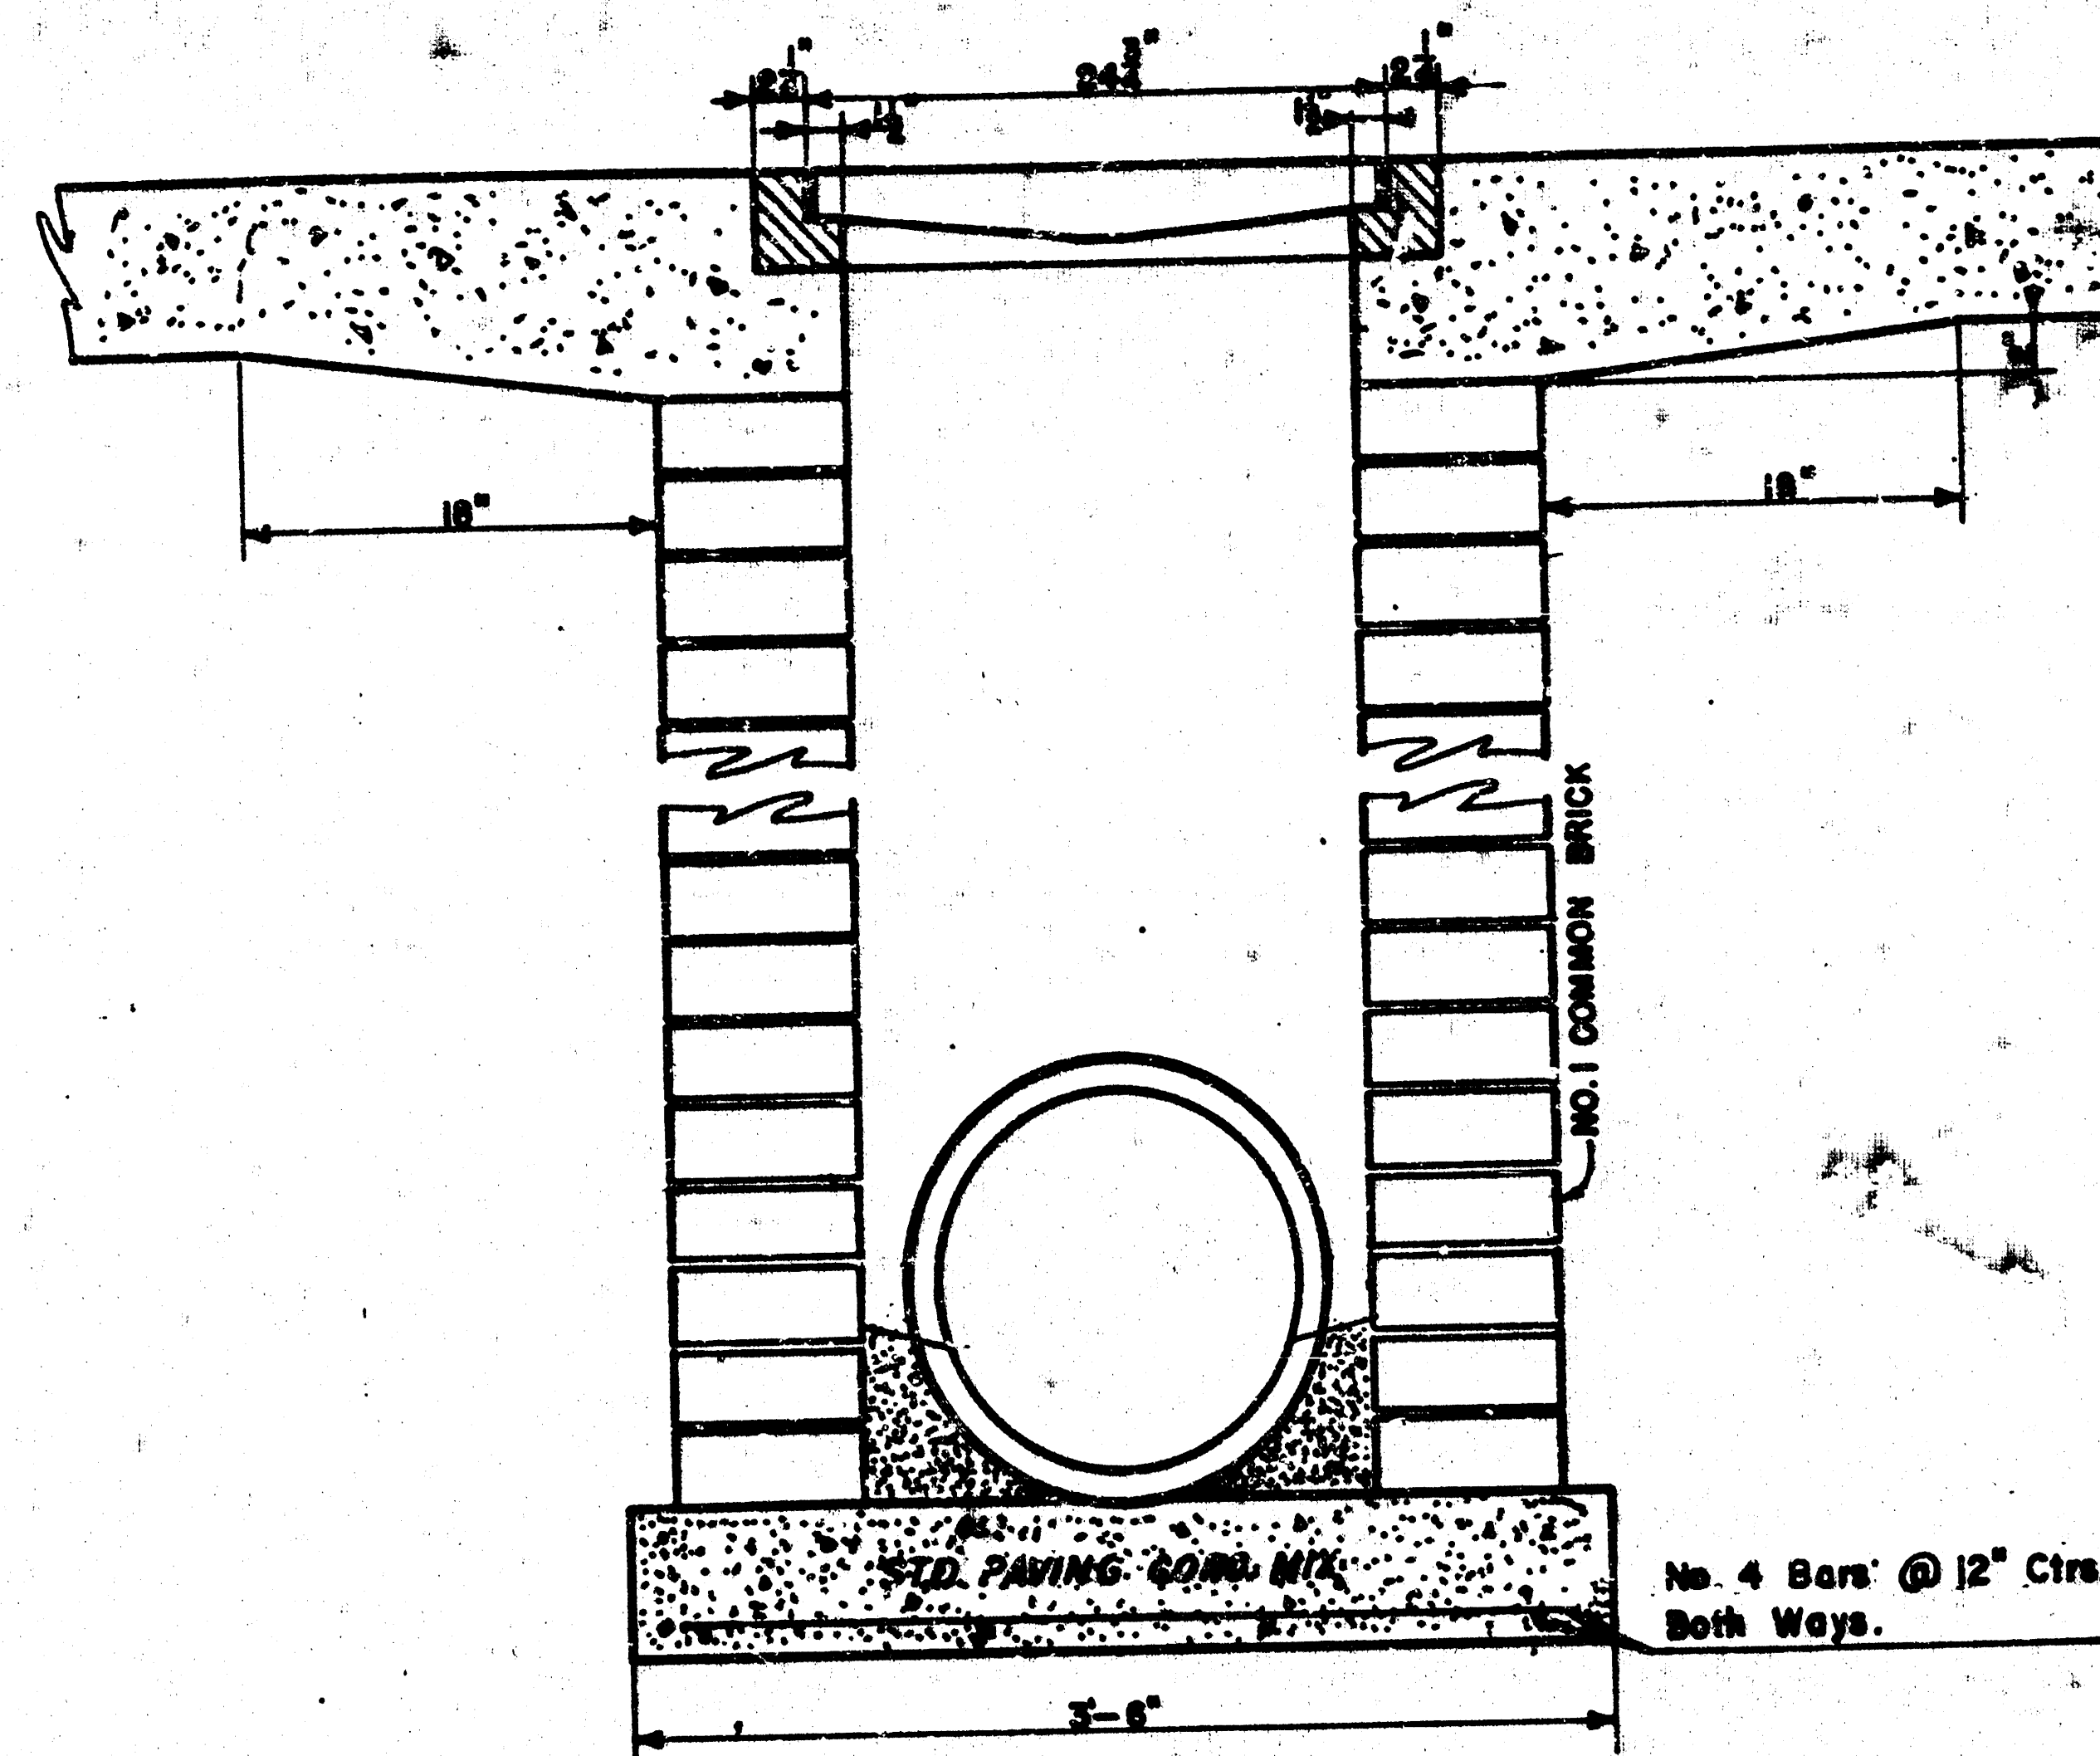

Date: 14 5 3 2012
Scale: 1-1/2" = 1'-0" Sheet 2 of 2

FILMED FROM THE BEST
AVAILABLE COPY