


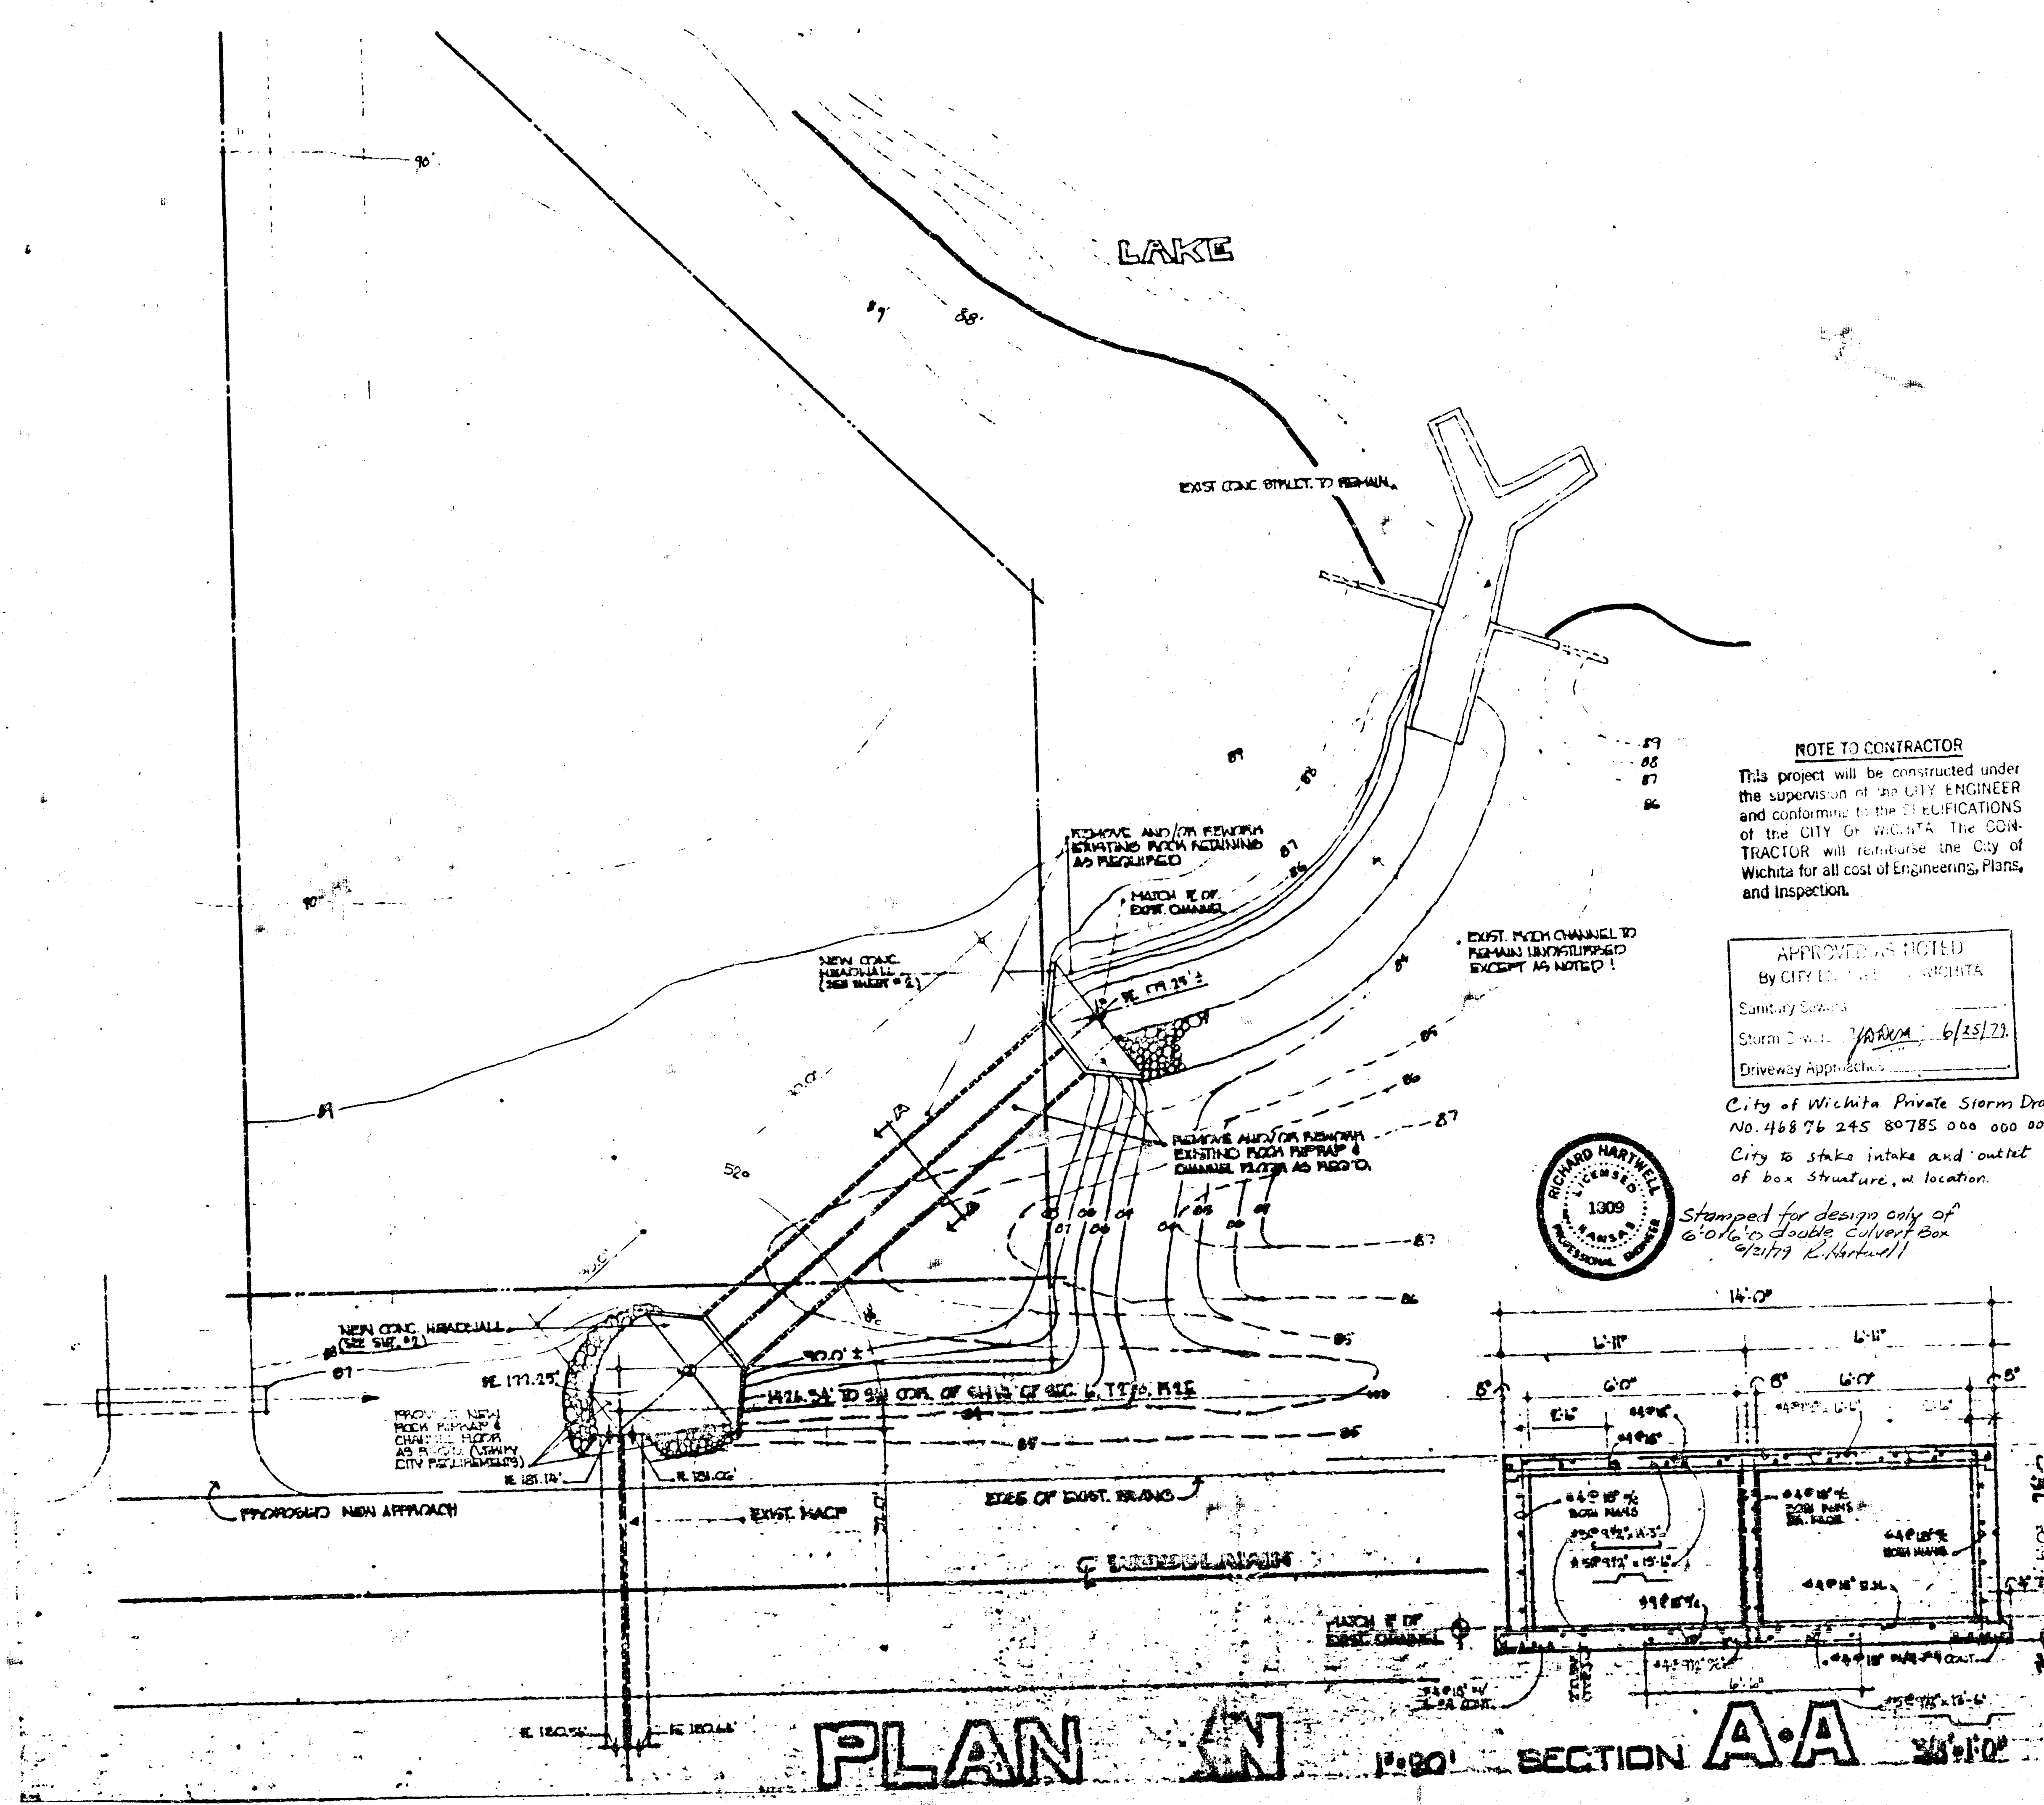

PLAN N 1"=20' **SECTION A-A** 30'-10'

NOTE TO CONTRACTOR
 This project will be constructed under the supervision of the CITY ENGINEER and conforming to the SPECIFICATIONS of the CITY OF WICHITA. The CONTRACTOR will reimburse the City of Wichita for all cost of Engineering, Plans, and Inspection.

APPROVED AS NOTED
 By CITY ENGINEER, WICHITA
 Sanitary Sewer
 Storm Drain: 1/2" DIA. 6/25/23
 Driveway Approaches

City of Wichita Private Storm Drain
 No. 46876 245 80785 000 000 008
 City to stake intake and outlet of box structure, w location.



Stamped for design only of
 6'-0" dia. double Culvert Box
 4/27/23 R. Hartwell

239 Patton	Suite 2	Wichita, Kansas • 67211	(316) • 263 - 8251
Architect, Planner, Commercial Consultants			
Keith Parker Associates, LLC			

PROPOSED DRAINAGE STRUCTURE FOR COMETARA ST. R.

10 MAY 24

1/2

