

B.M. = ELEV. 107.50 - TOP OF INLET AT SE CORNER OF PROPERTY.

K-42 HIGHWAY

MO. PAC. RAILROAD

RESURFACE DITCH AT 40.4%

ASPHALT

EXISTING BUILDING

PRIVATE STORM SEWER TO SERVE
COPELAND CORPORATION
3200 MAY
WICHITA, KANSAS 67213

PROJECT NO. 468-76-245-80001-000-000-004

APPROVED AS NOTED
By CITY ENGINEER OF WICHITA
Sanitary Sewers
Storm Sewers *EPB 2/1/85*
Driveway Approaches

PREPARED BY:

WILDCAT CONSTRUCTION CO.
4421 W. HARRY
WICHITA, KS




NOTE TO CONTRACTOR

This project will be constructed under the supervision of the CITY ENGINEER and conforming to the SPECIFICATIONS of the CITY OF WICHITA. The CONTRACTOR will prepay the City of Wichita for all costs of inspection.

SURVEYED BY:



LOWELL D. HIGH, L.S.
1542 S. ST. FRANCIS
WICHITA, KS 67211

*AS BUILT PLAN
8-13-85
GREENE*

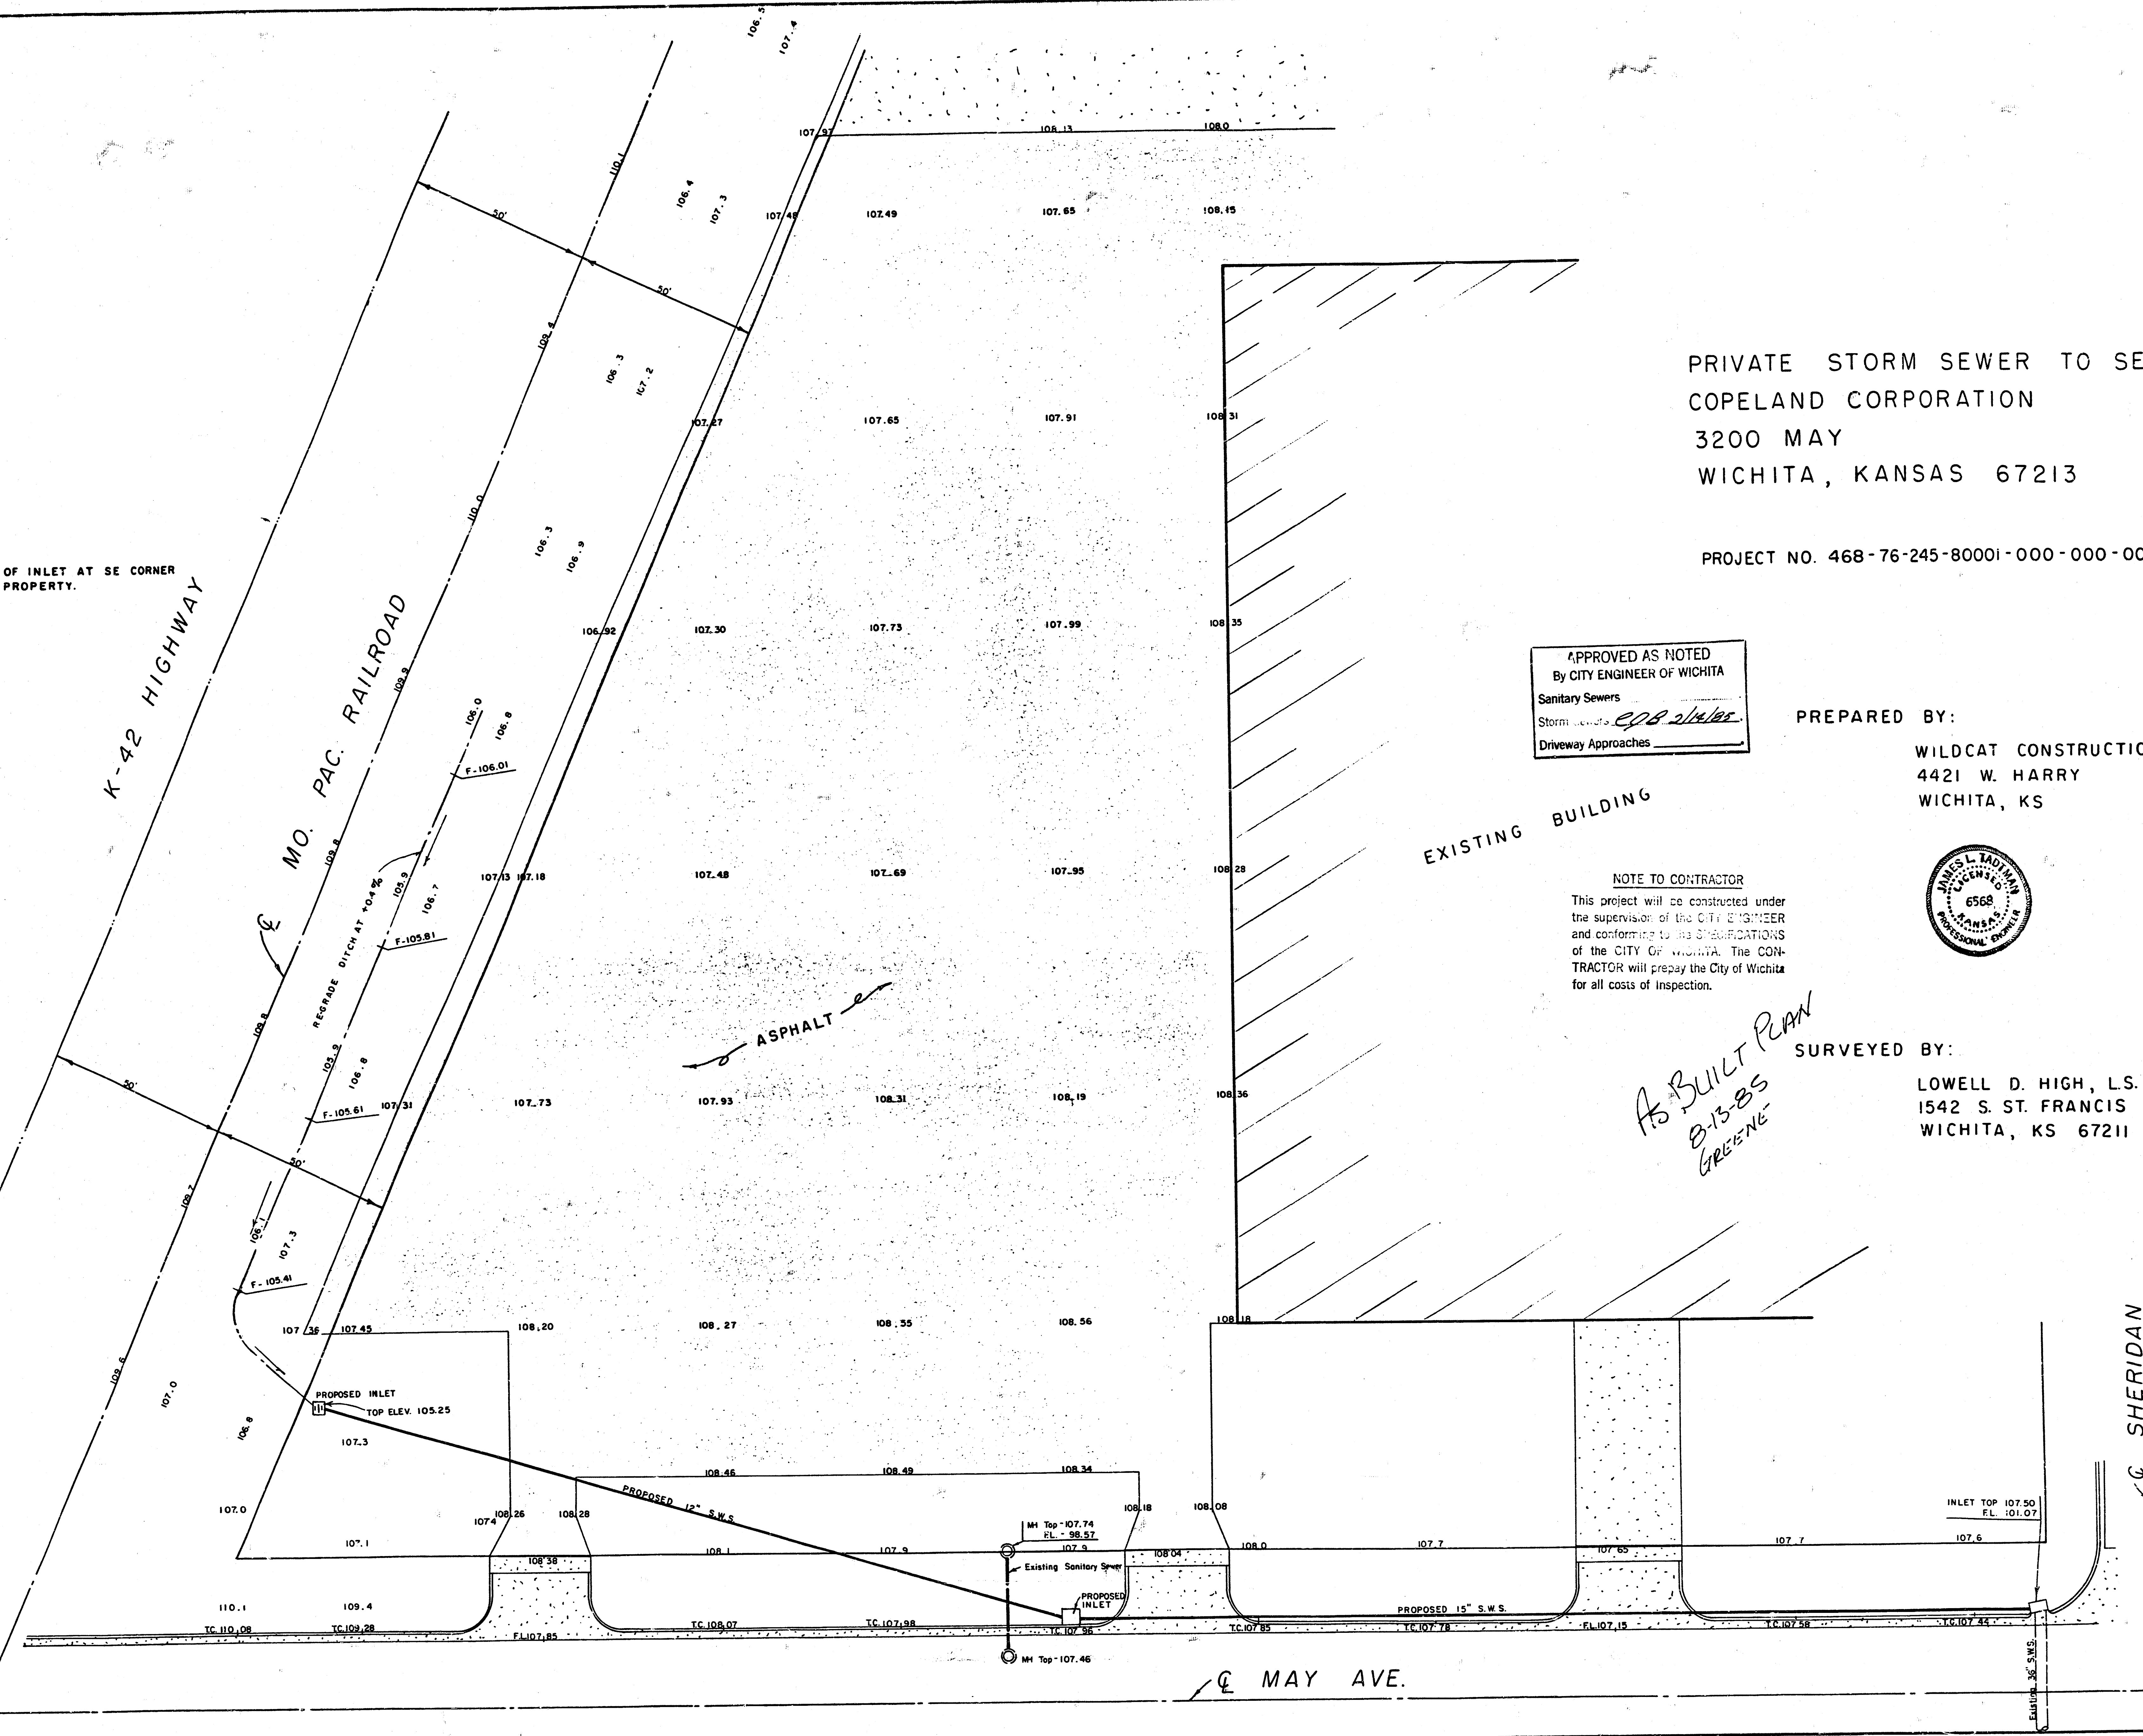

FILMED FROM THE BEST
AVAILABLE COPY.....

PLAN
NOTE BOOK
NO. 1
DATE
BY
CHECKED
APPROVED
PL. OF WAY RECORD

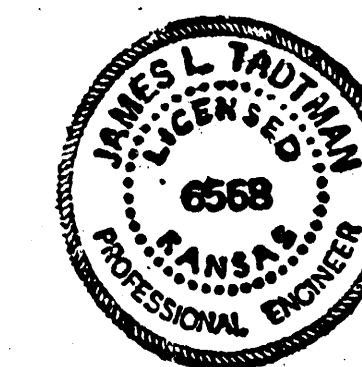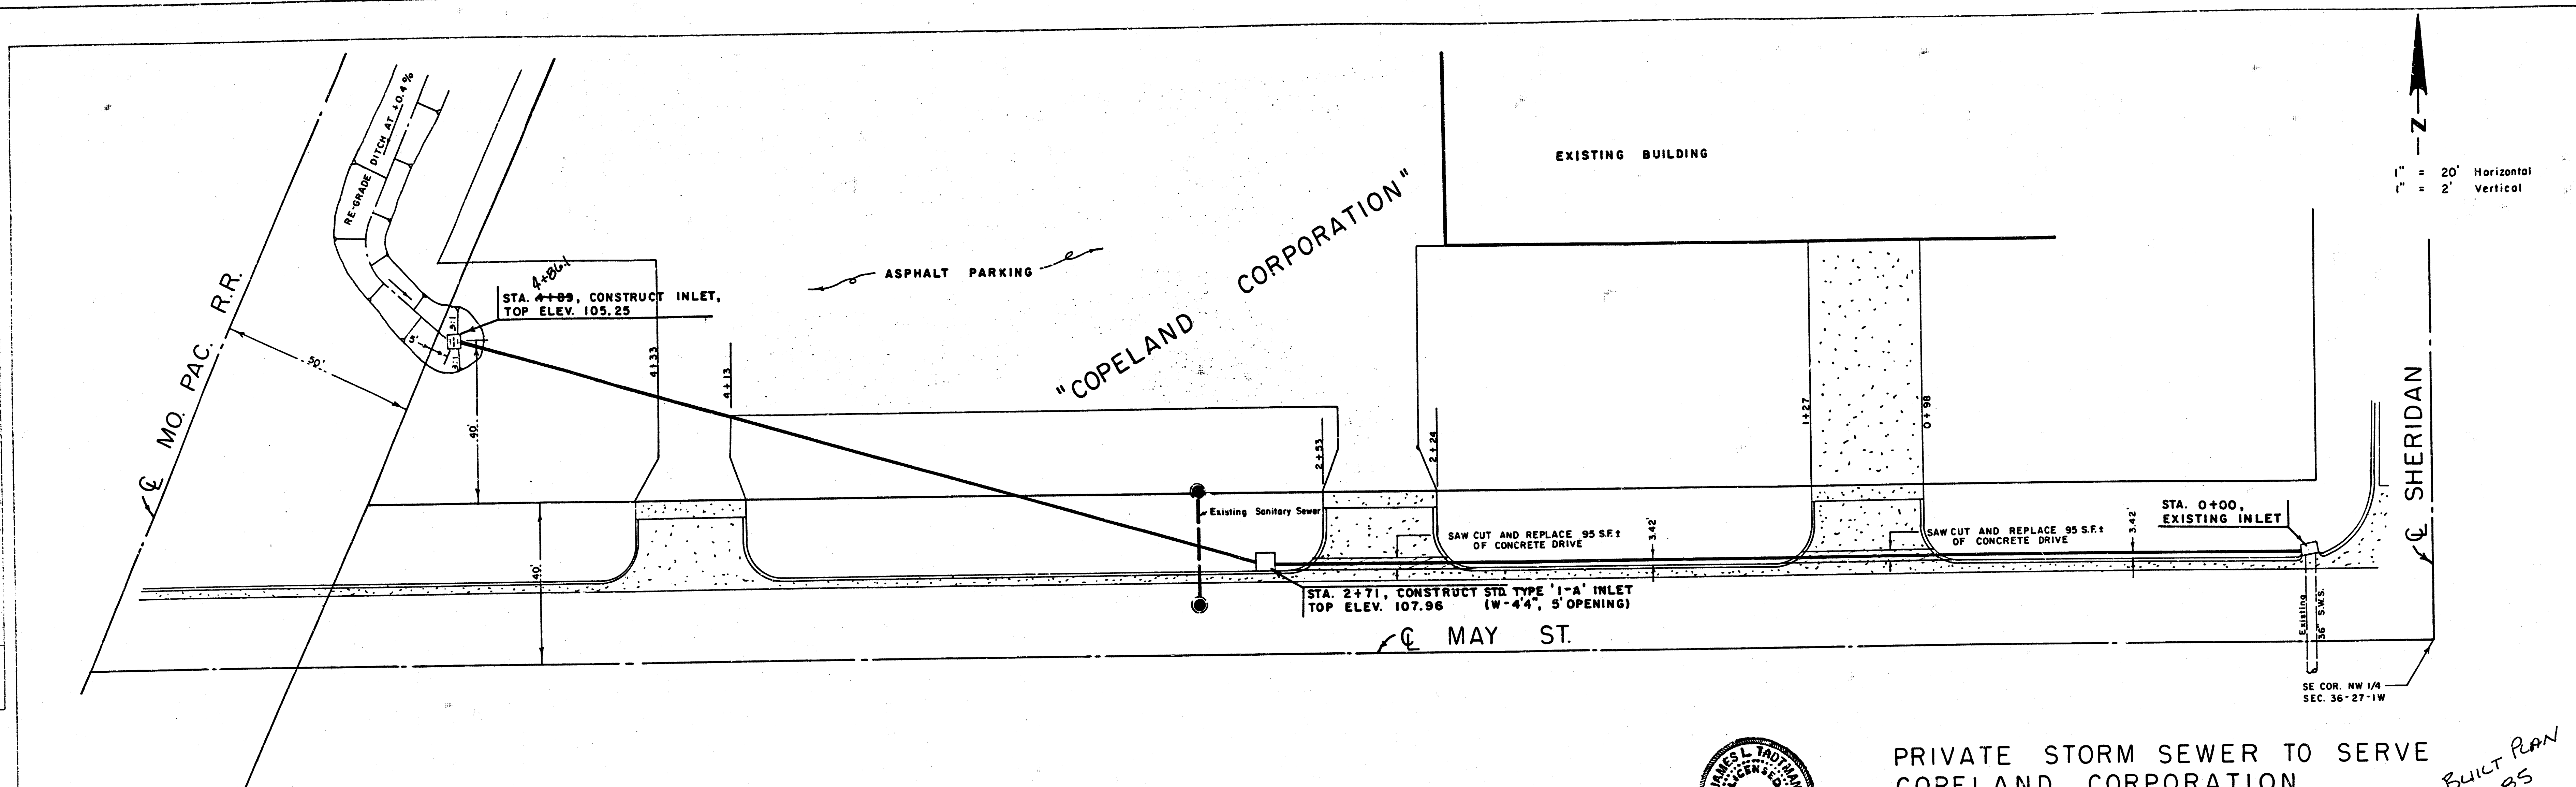

PRIVATE STORM SEWER TO SERVE
COPELAND CORPORATION

AS BUILT PLAN
8-13-85
GREENE

PROJECT NO. 468-76-245-80001-000-000-004

PROFILE
NOTE BOOK
NO. 1
DATE
BY
CHECKED
APPROVED
PL. OF WAY RECORD

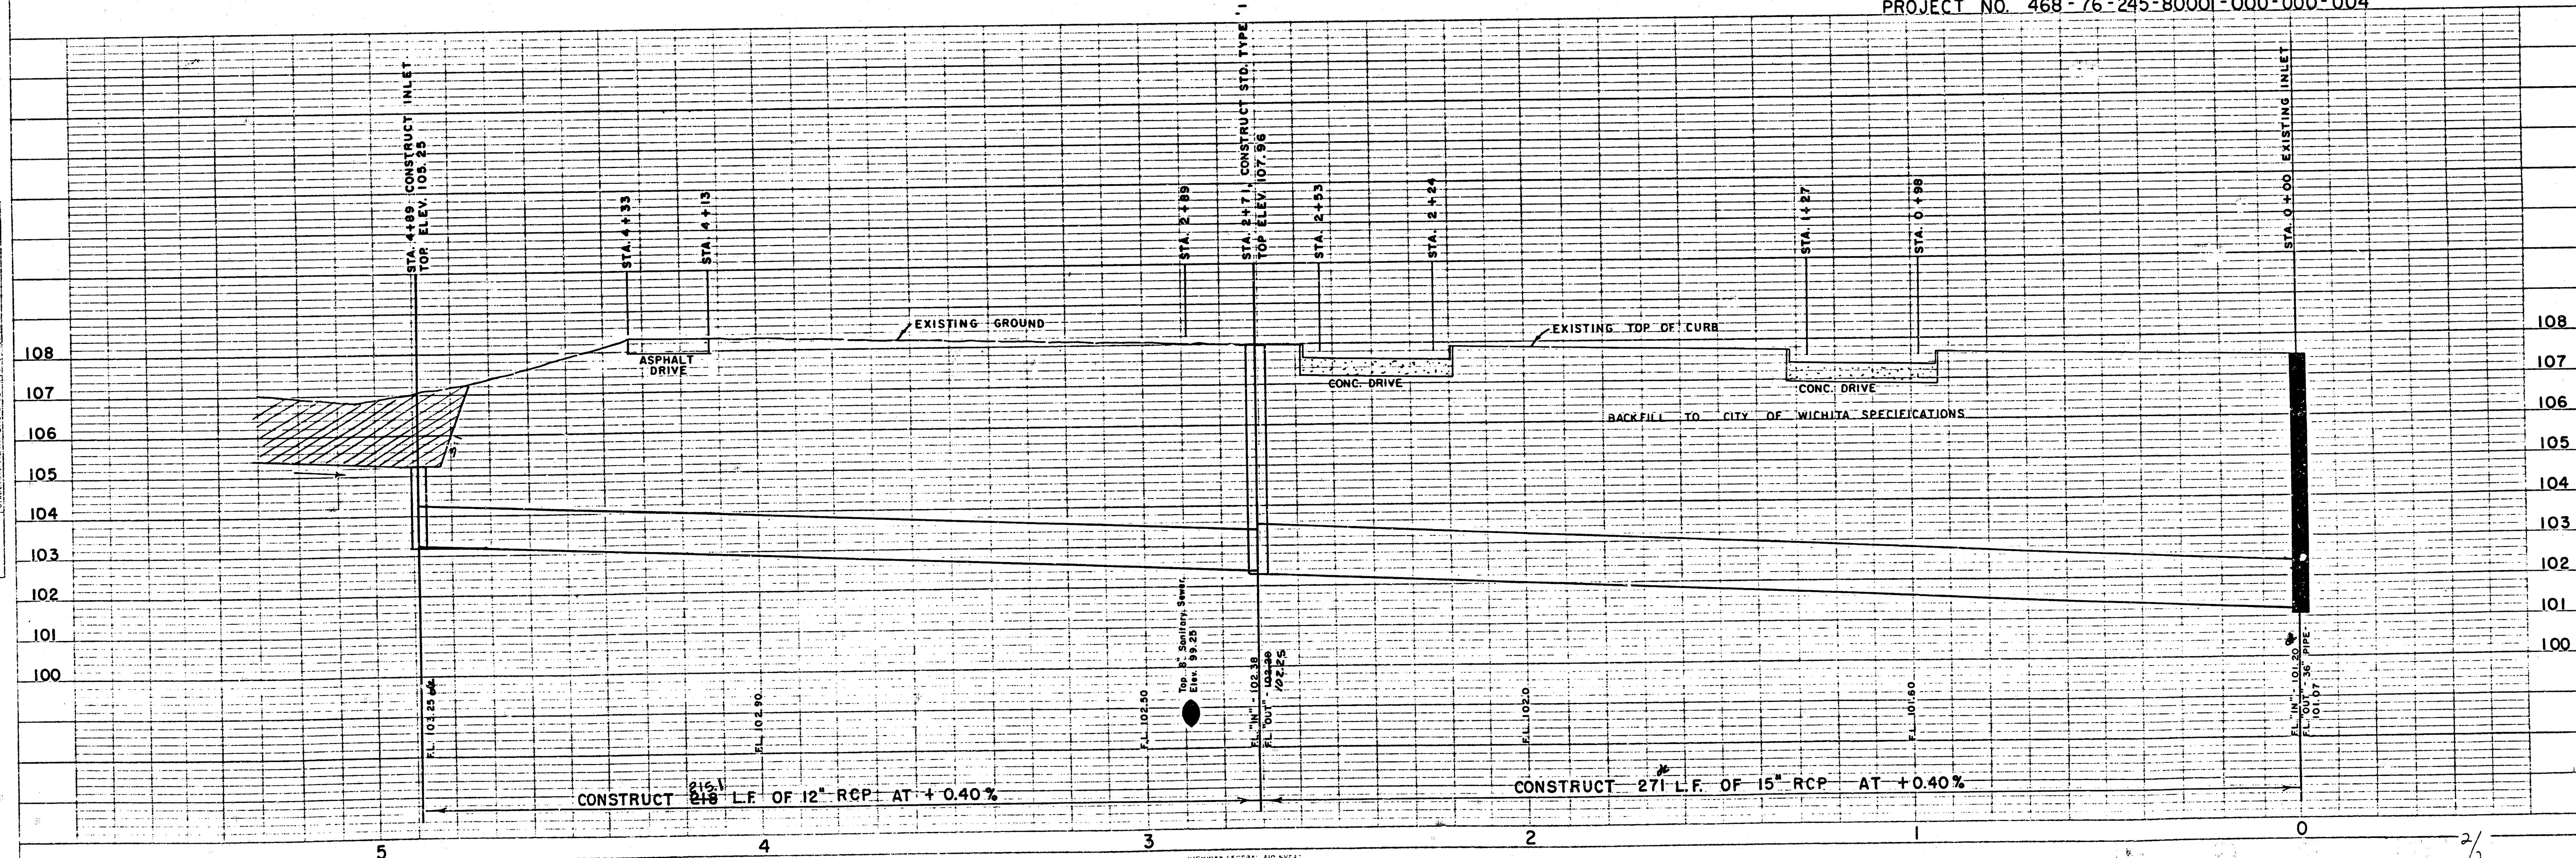


PLATE 1-SINGLE PLAN AND PROFILE FULL SIZE
PRINTED IN U.S.A.

FILMED FROM THE BEST
AVAILABLE COPY