
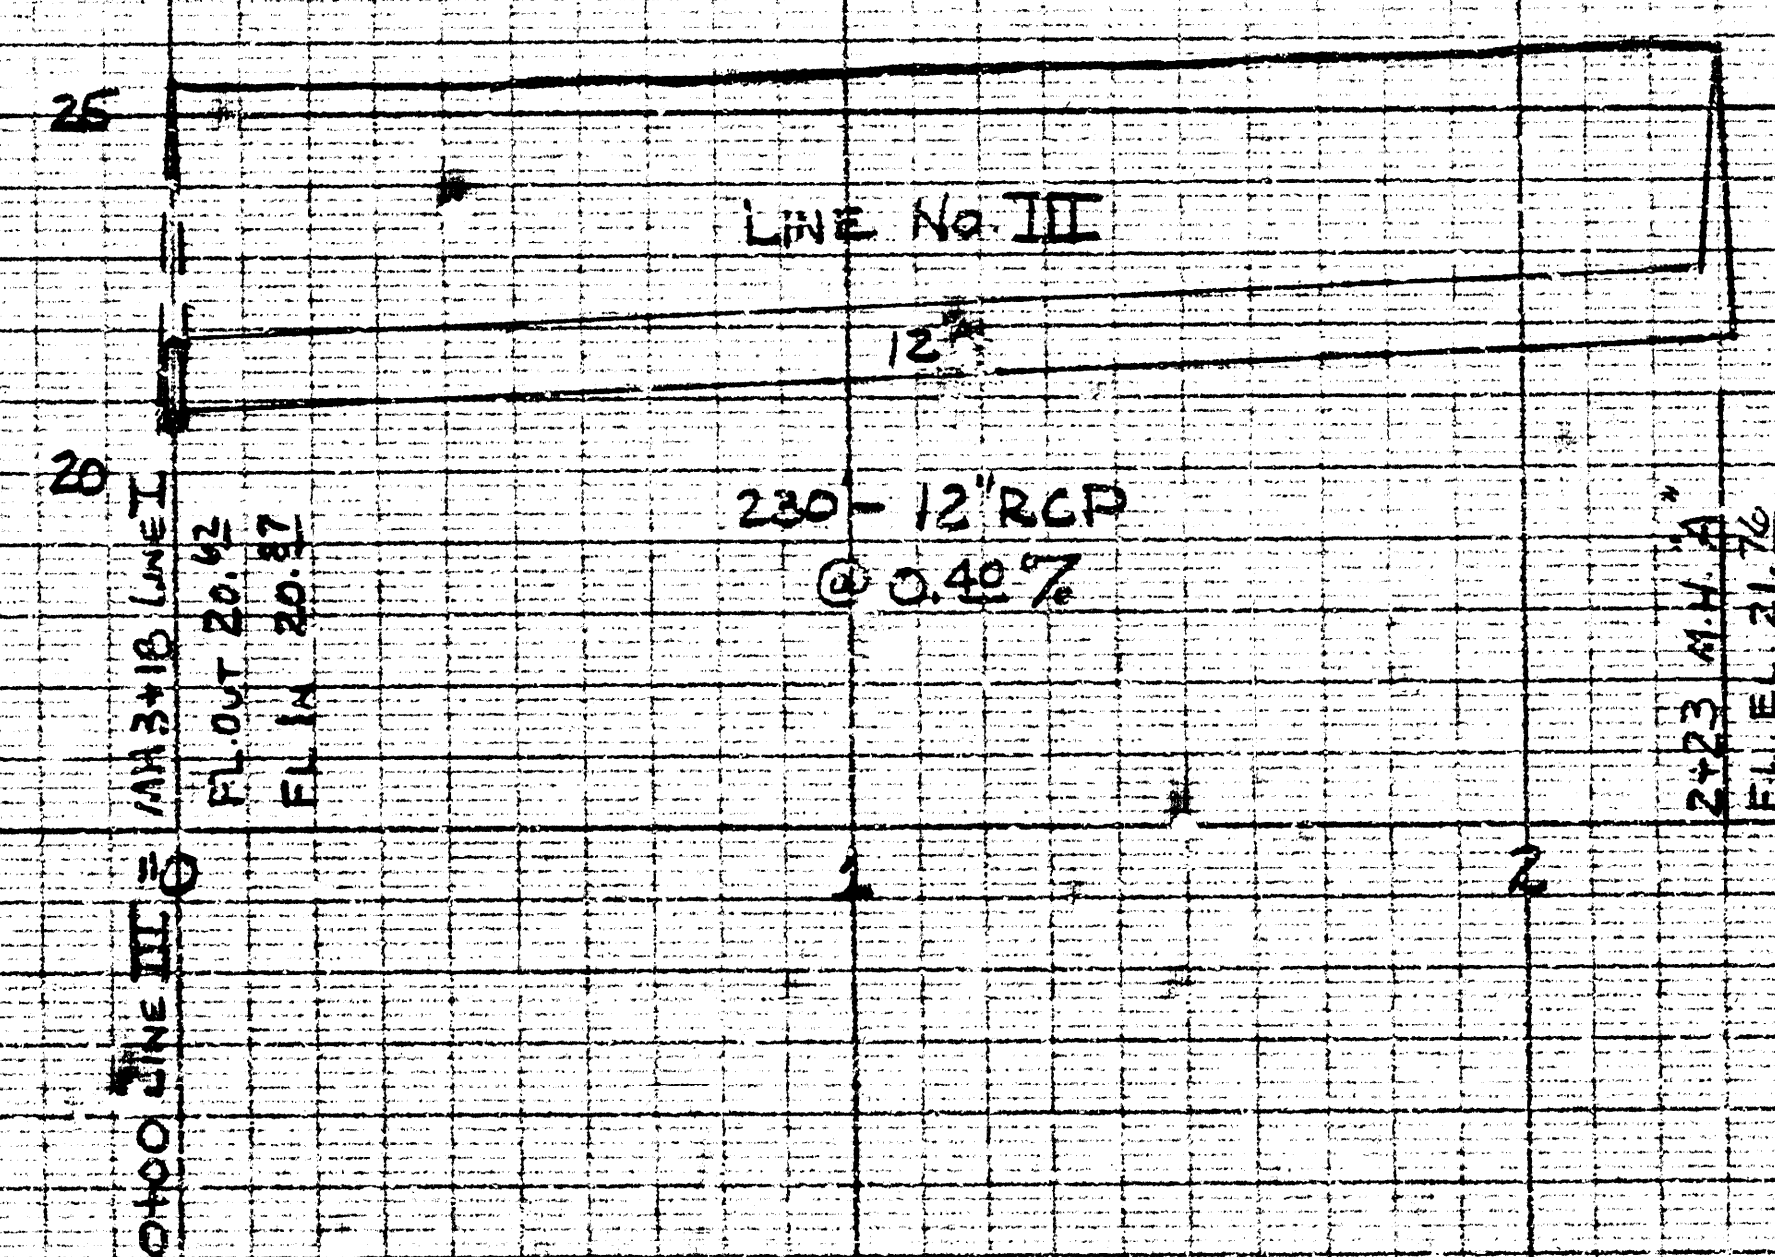
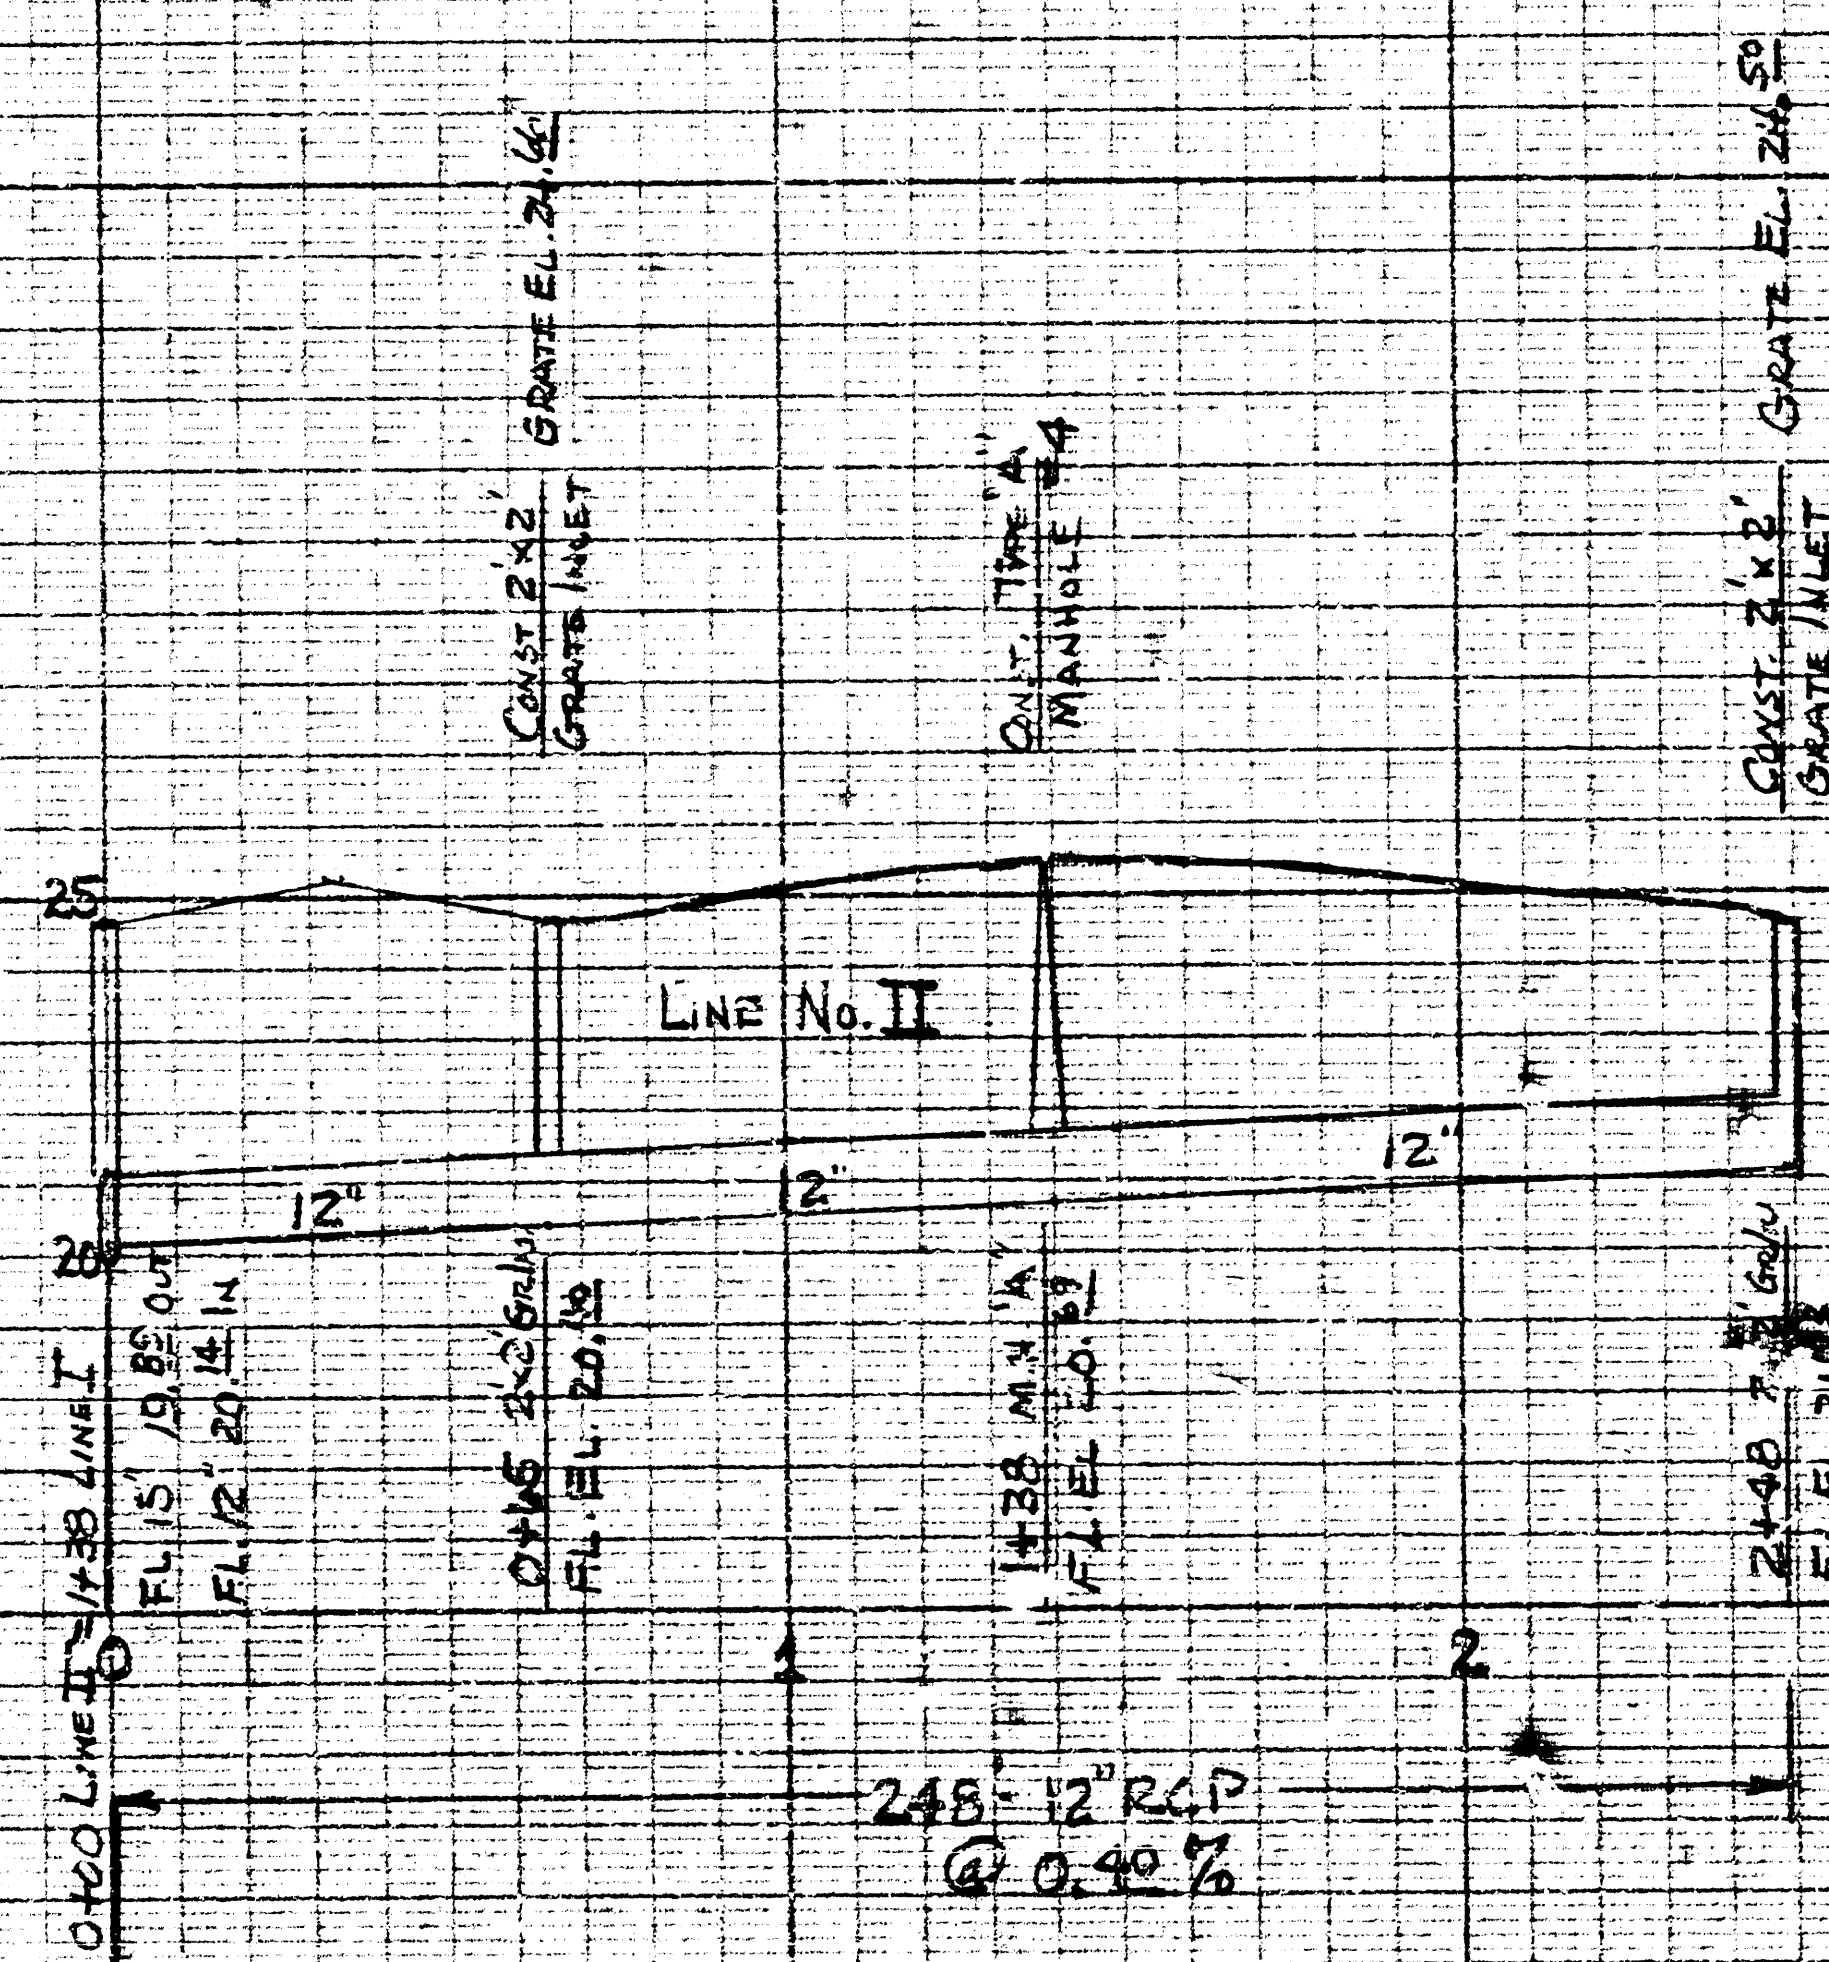


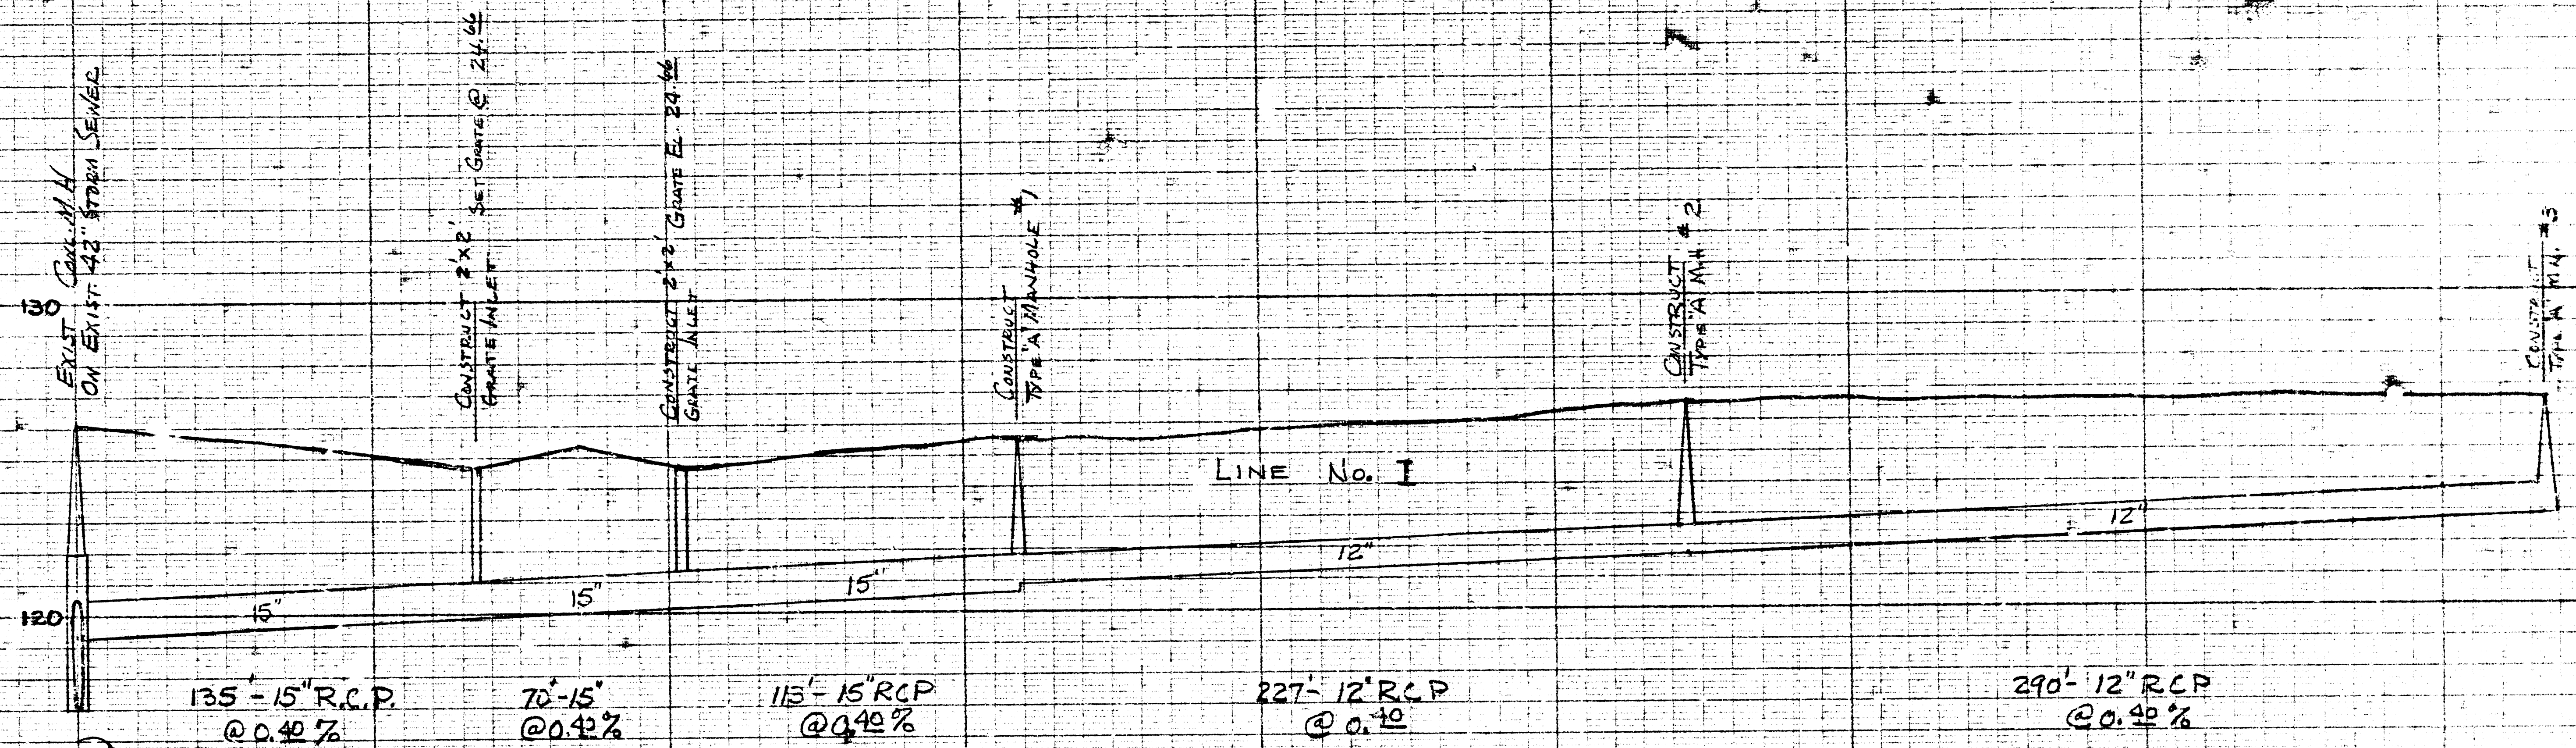


STORM SEWER PROFILES
DOLD PACKING
SEPT. 1973-NICHITA, KS

NO.	INLET		OUTLET		SLOPE	TOP OF COVER ELEVATION	REMARKS
	SIZE	INVERT	SIZE	INVERT			
1	12"	126.57'	15"	120.62'	0.40%	125.5'	See Notes 17, 18 & 19
2	12"	122.78'	12"	121.78'	"	126.5'	See Notes 17, 18 & 19 Pg. MK 1
3	"	"	12"	122.54'	"	"	See Notes 17, 18 & 19 Pg. MK 2
4	6"	120.69'	12"	120.62'	"	125.5'	See Notes 17, 18 & 19
5	12"	121.78'	12"	120.67'	"	125.75'	See Notes 17, 18 & 19 Pg. MK 2
6	15"	119.85'	48"	122.69'	"	Ground Elevation 126.15'	
7	6"	121.46'	6"	121.46'	1/8"/ft	124.50'	Proposed Cond. or Brack. Std. Dwg. PS-1 or PS-2 with Solid Cover
8	6"	119.79'	6"	119.79'	"	"	"
9	6"	119.71'	12"	119.71'	"	126.75'	"
10	12"	119.88'	12"	119.88'	"	126.00'	"

INLET SCHEDULE						
NO.	INLET		OUTLET	SLOPE	TOP OF COVER ELEVATION	REMARKS
	SIZE	INVERT				
1	12"	120.14'	15"	119.89'	0.60%	124.66'
2	15"	120.17'	"	"	"	"
3	12"	120.90'	"	"	"	"
4	12"	121.13'	"	"	"	124.50'


NOTE: All inlets shall have 2'x2' inlet grates. Inlets shall be similar to Std. Dwg. PS-2 (Detail "B"), except for grates.

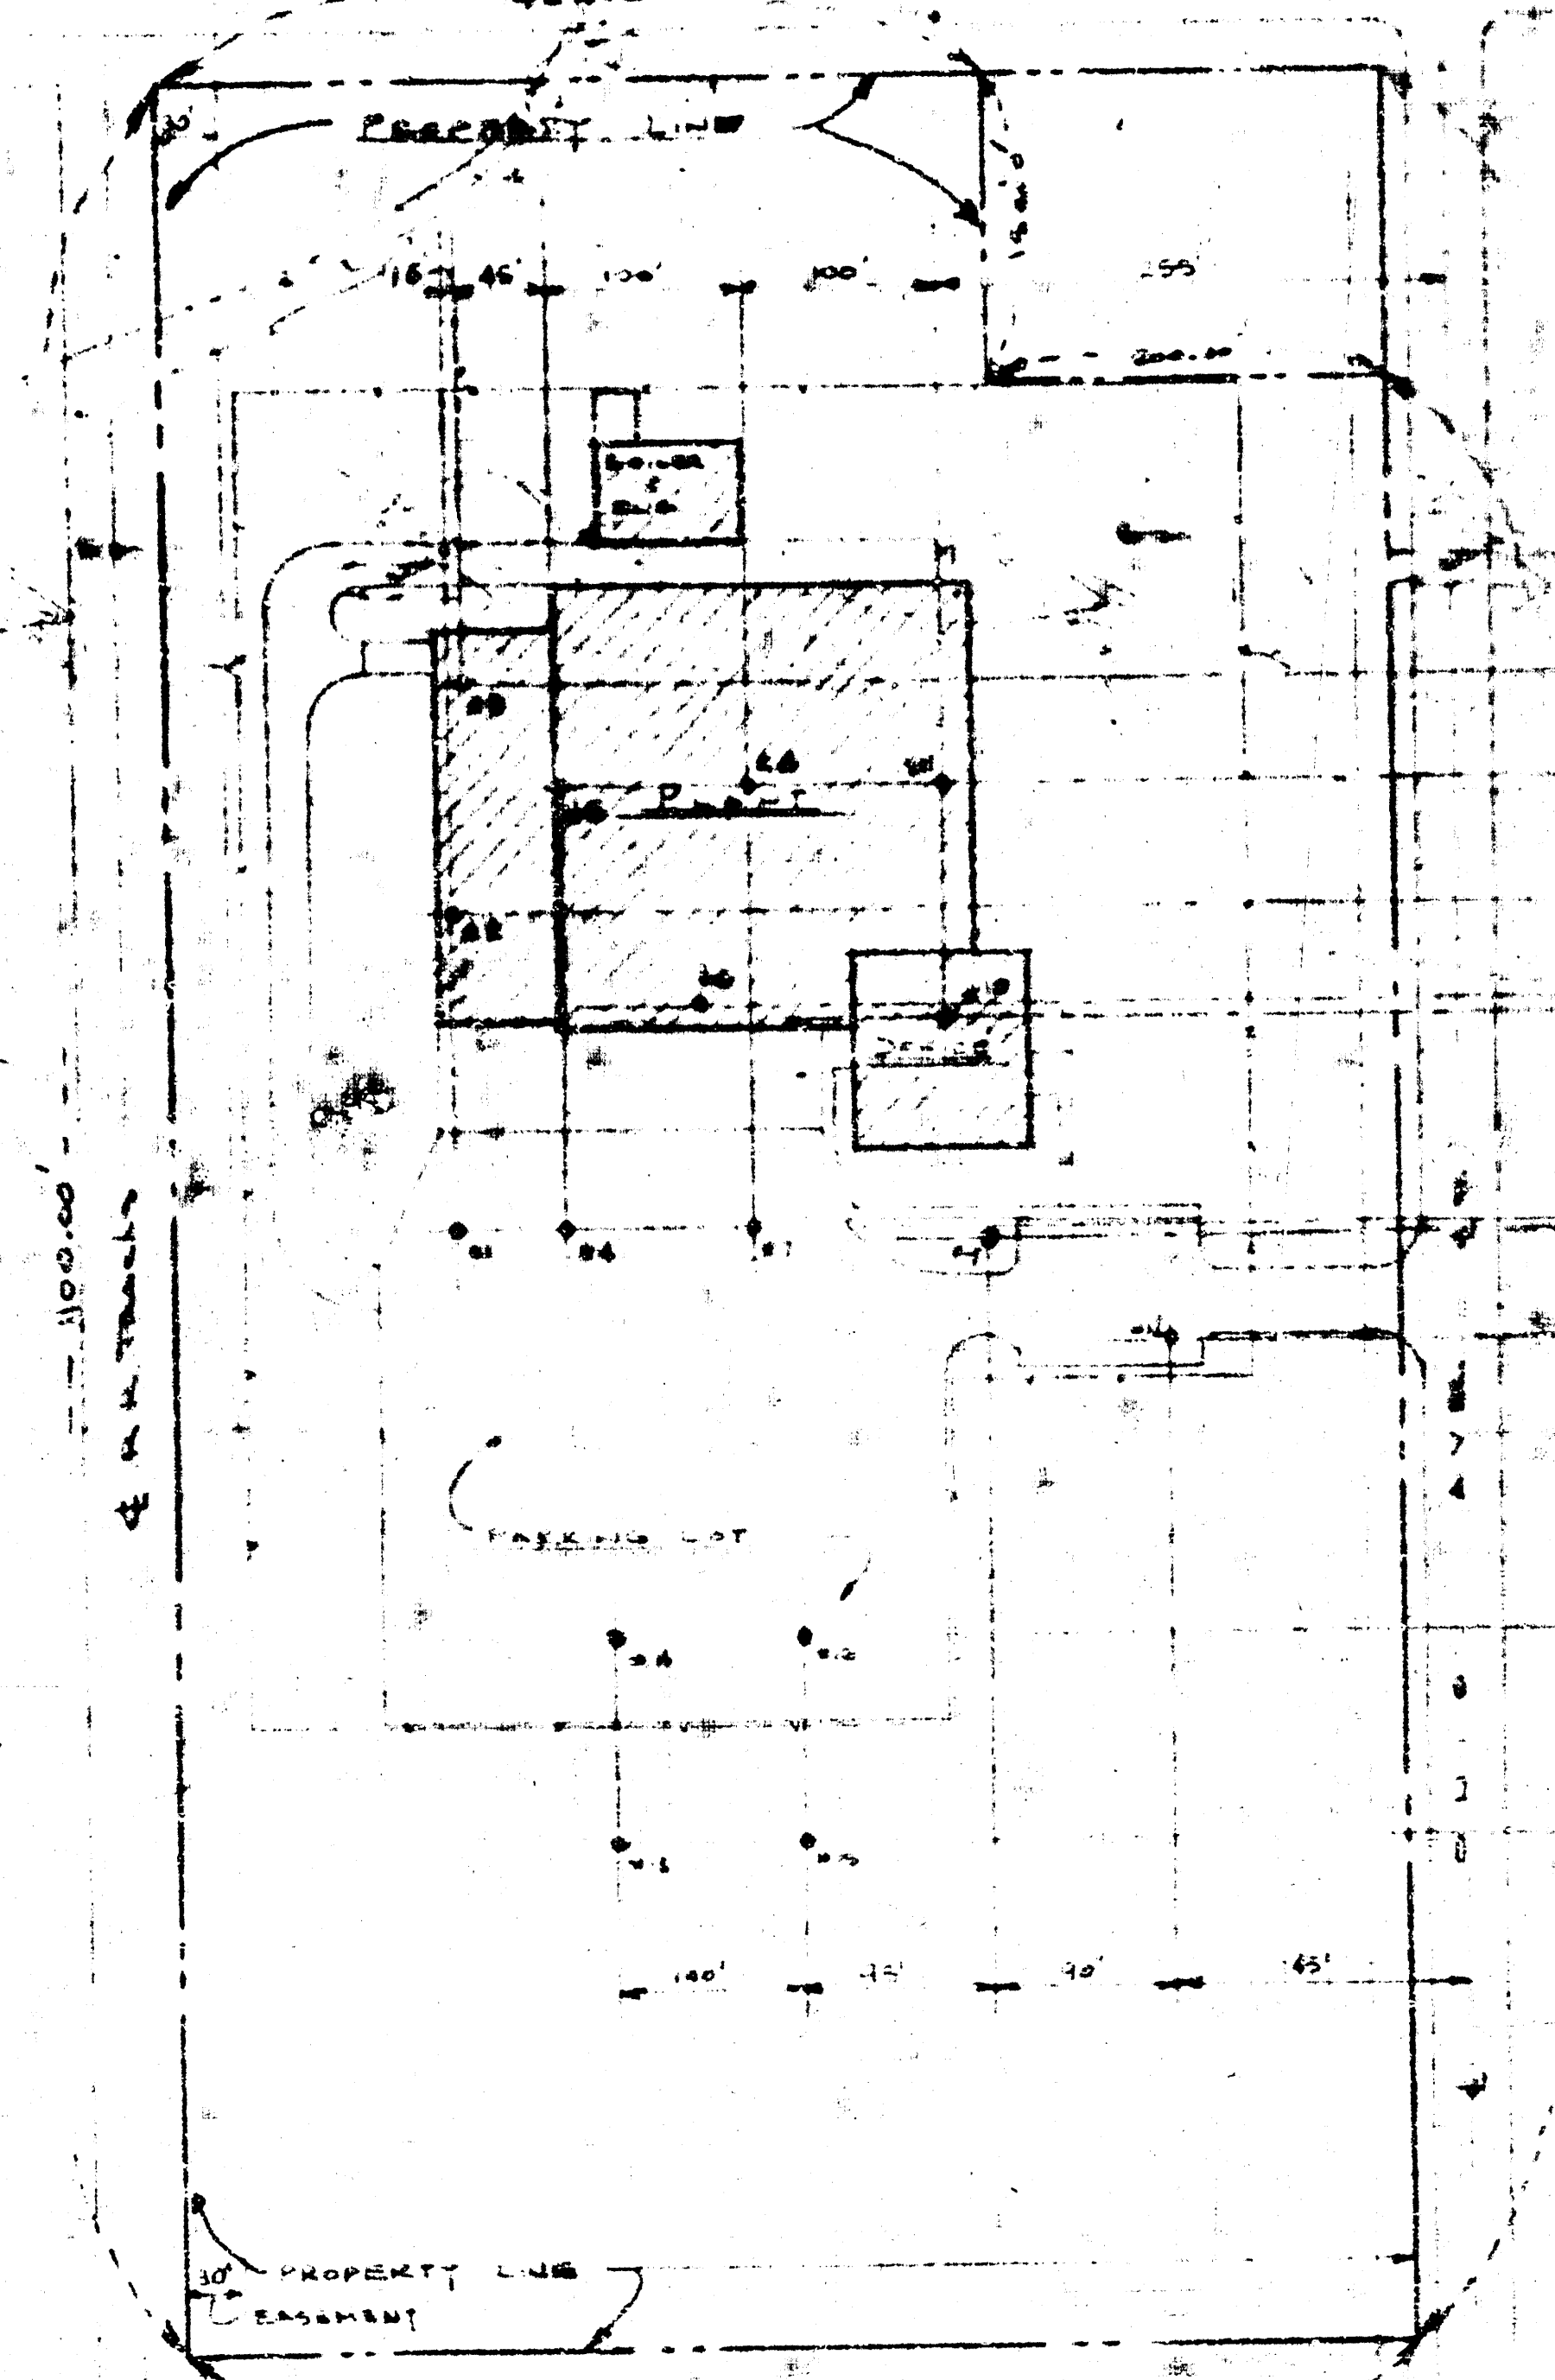

Private Storm Sewer
 Dold Packing Co.
 Proj. No. BHRB503059

14 6 1 ⑦

SCALE 1" = 100.0'

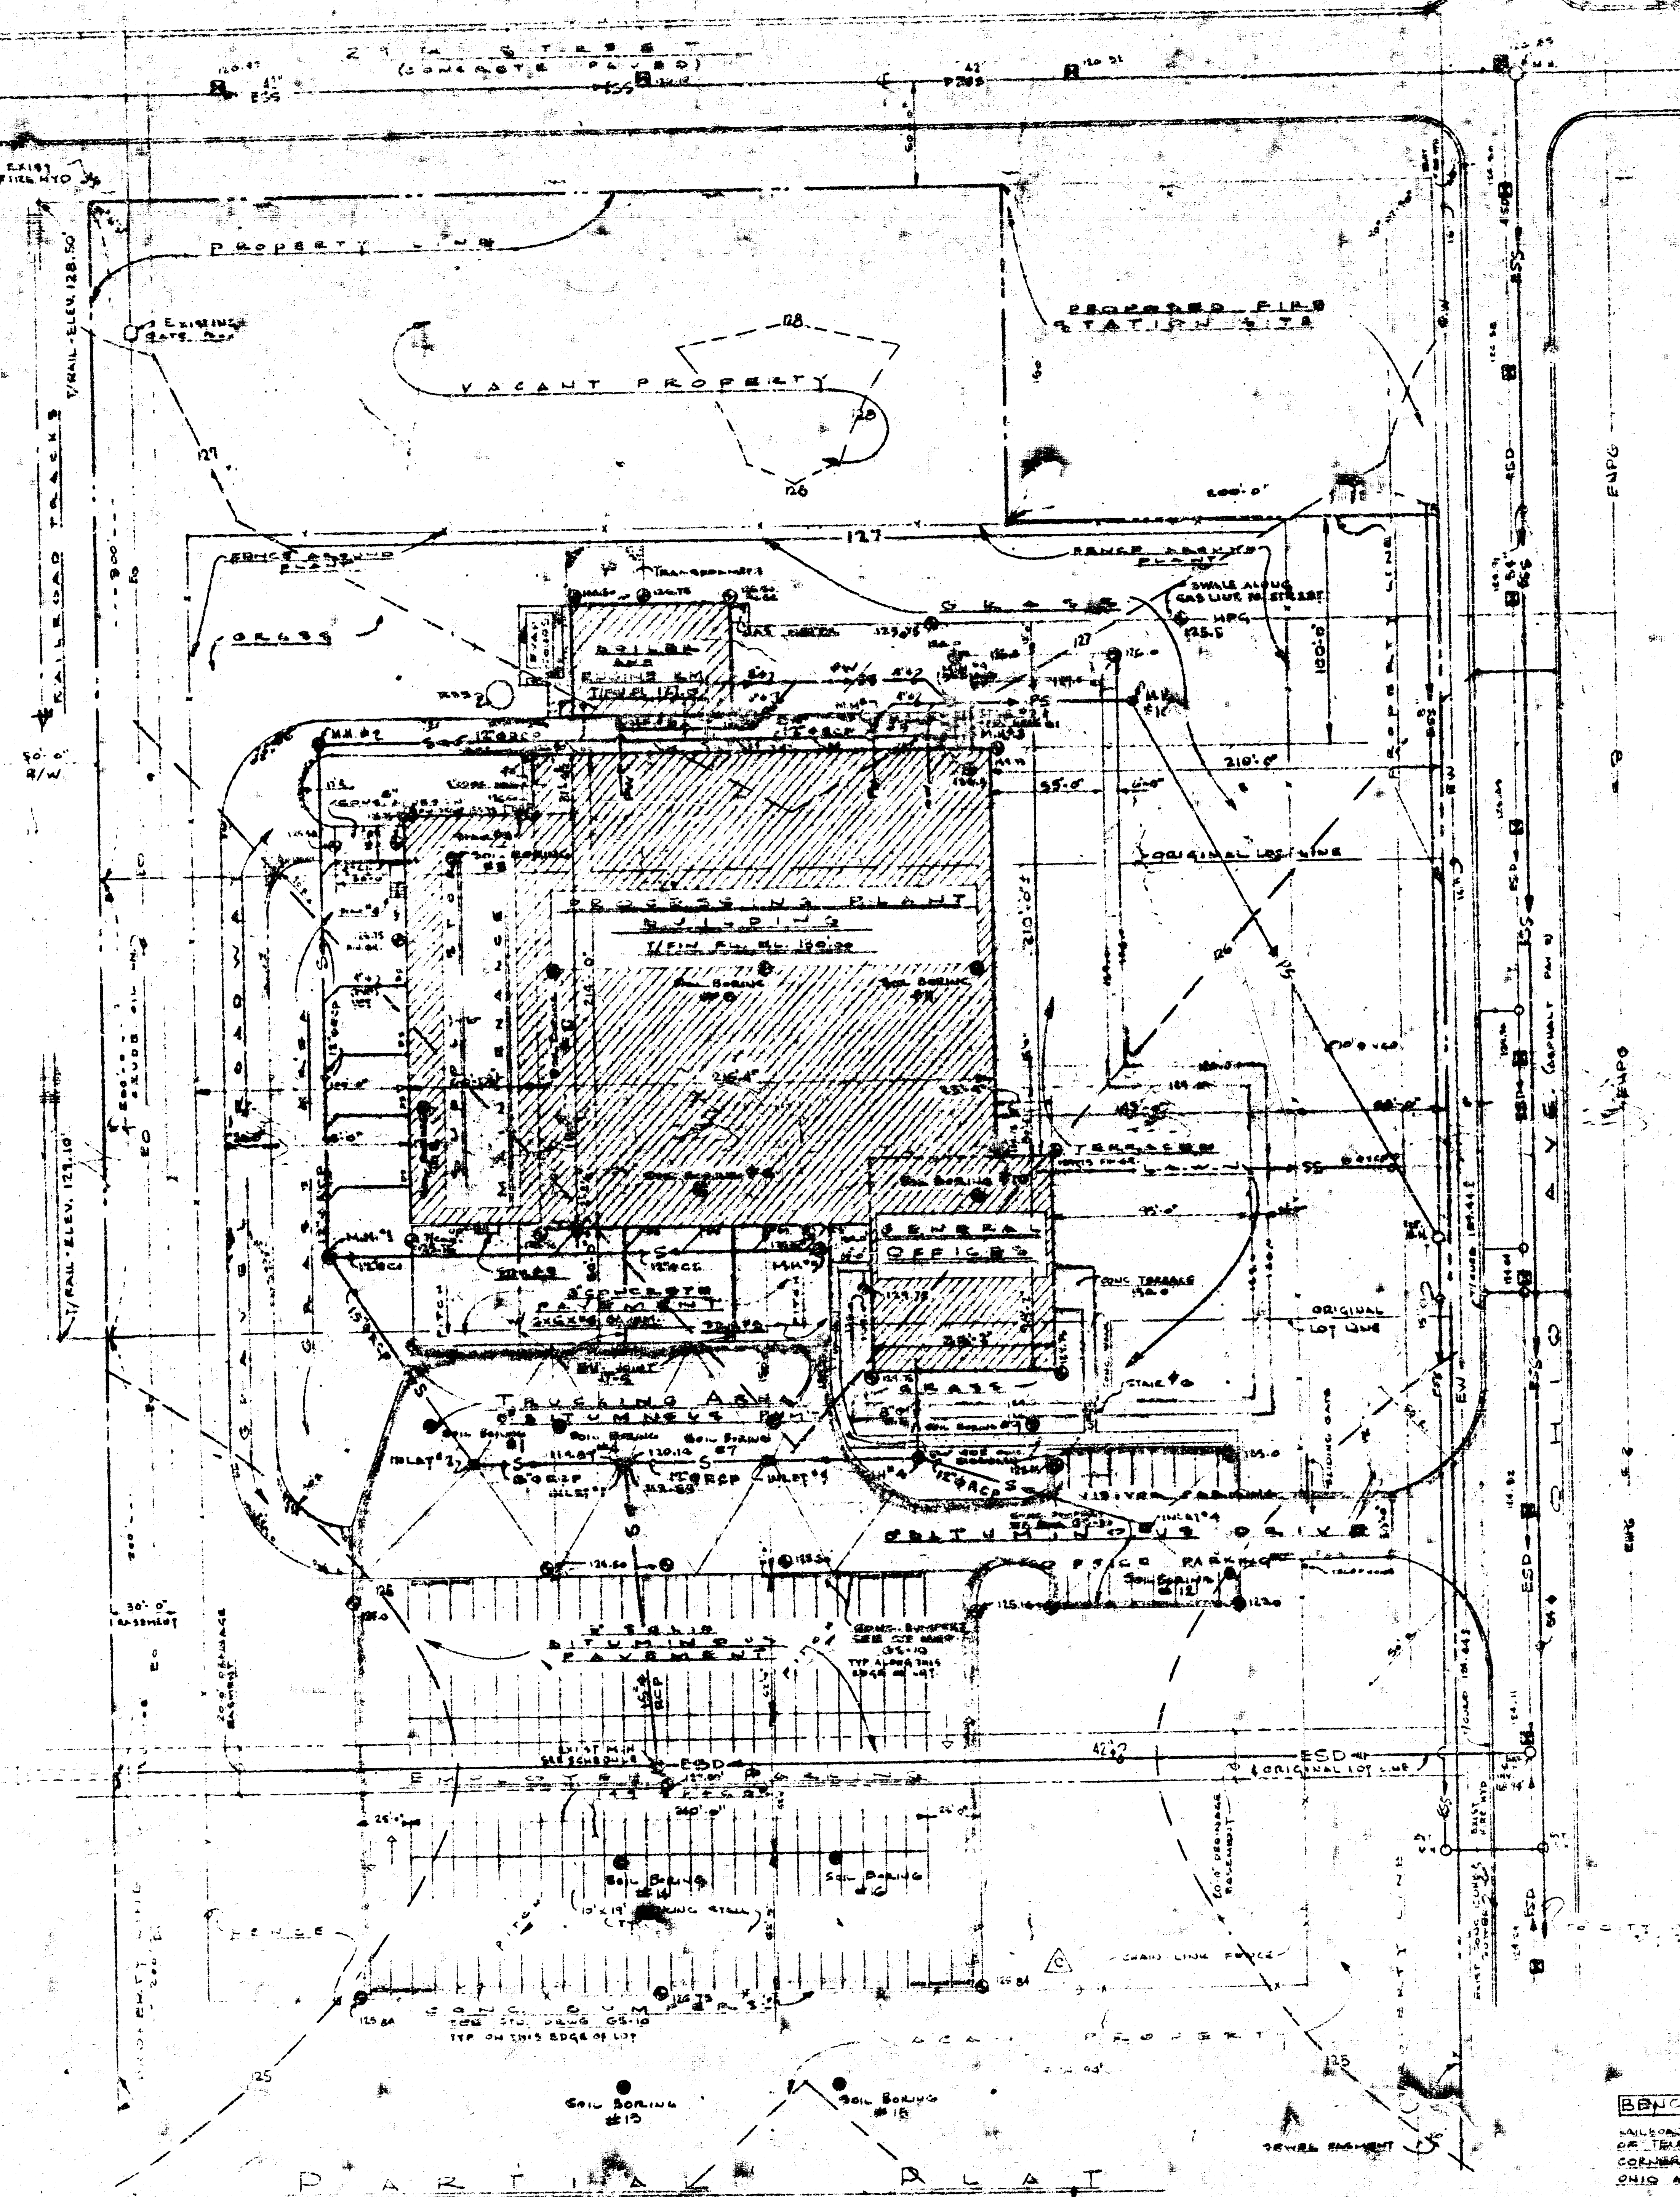

BENCH MARK
 SAILROAD SPIKE IN NORTH CORNER OF TRASHING POLE S.E. CORNER OF ENH ST & CHIO AVE. ELEV. 126.88'

10-10-73
 APPROVED AS NOTED
 By CITY ENGINEER OF WICHITA
 Sanitary Sewers
 Storm Sewers
 Driveway Approaches

NOTE TO CONTRACTOR
 This project will be constructed under the supervision of the CITY ENGINEER and conforming to the SPECIFICATIONS of the CITY OF WICHITA. The CONTRACTOR will reimburse the City of Wichita for all cost of Engineering, Plans, and Inspection.

IT IS NOTED THAT THE CITY ENGINEER HAS REVIEWED THE PLANS AND SPECIFICATIONS AND HAS APPROVED THEM AS NOTED. THE CONTRACTOR SHALL BE RESPONSIBLE FOR THE PROPER CONSTRUCTION AND MAINTENANCE OF THE PROJECT.