

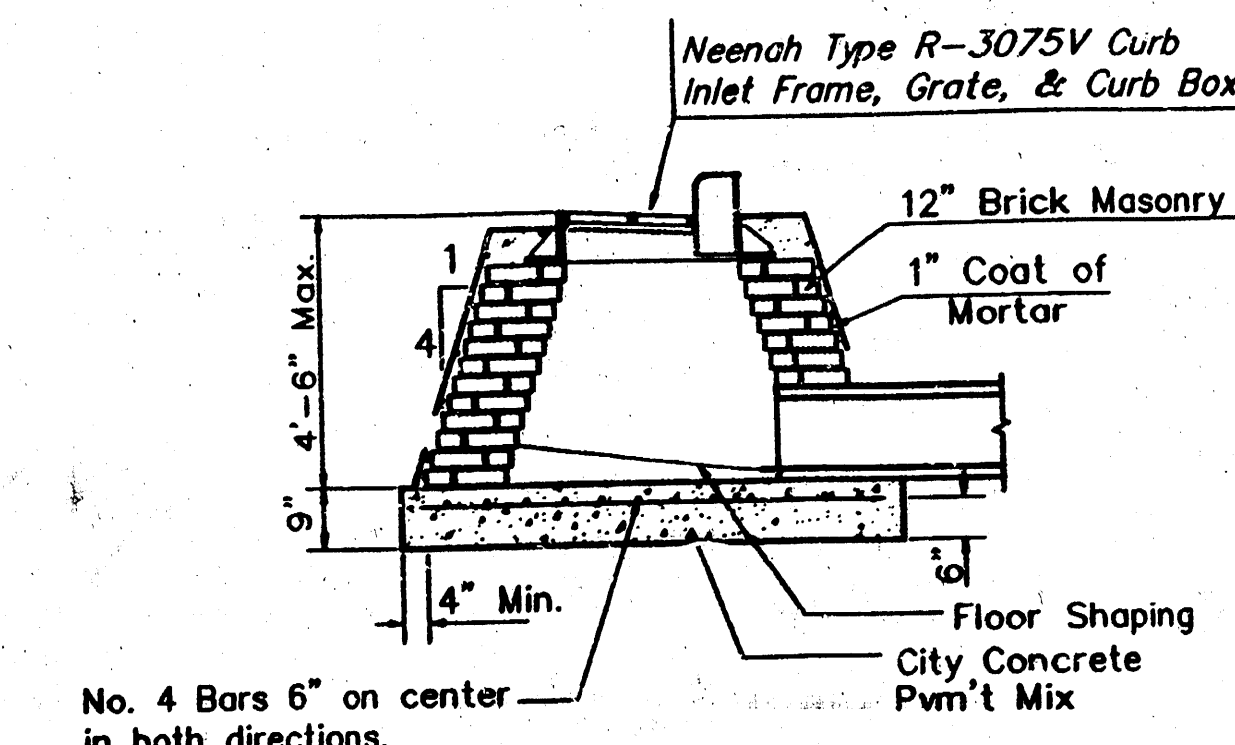
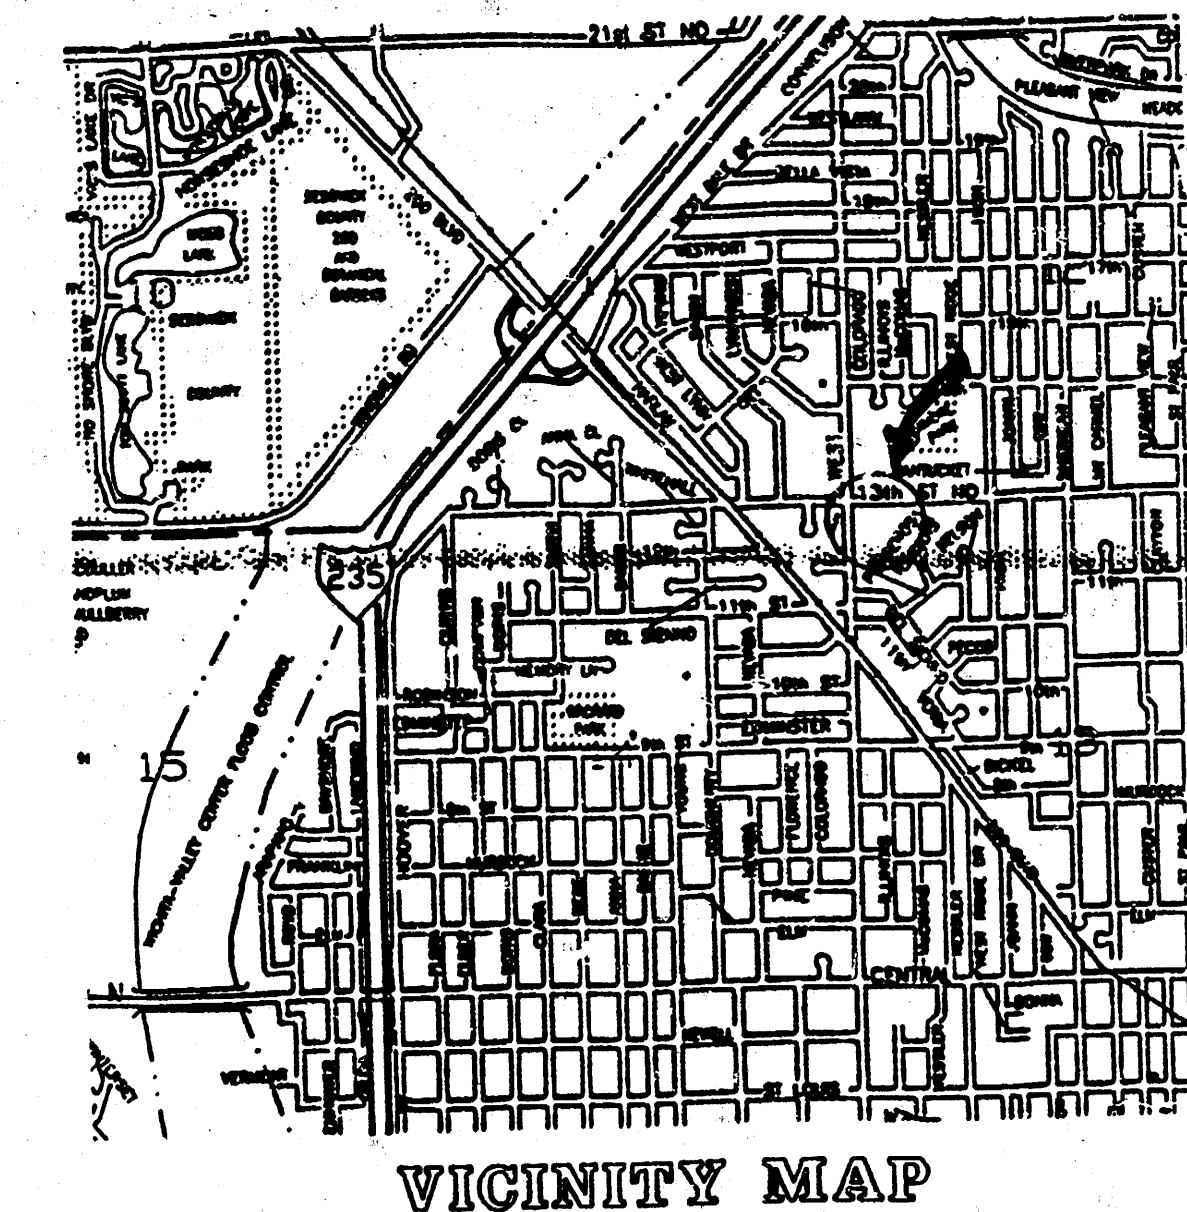


GENERAL NOTES

- Contractor will be required to provide notice to utility companies a minimum of twenty-four (24) hours prior to any excavation, as follows:
Kansas One-Call 687-2470
The Contractor must notify the following in case of an emergency:
Cablevision 262-4270
or 263-2081
K.P.L. Gas Service Company 263-7511
Kansas Gas & Electric Company 264-1141
Arkla Gas Company 942-8350
Southwestern Bell Telephone Company 1-571-2611
- Contractor shall not start work on the project until the project inspector is assigned to the project and is present on the site. Any work done without inspection will be required to be uncovered for inspection.
- Exist. utilities and their locations, as shown on the plans, represent the best information obtainable for design. Location information has been obtained from the various utility companies and is either from company record drawings or company-provided field locations. The Contractor will be required to work around existing utilities which do not conflict with proposed construction.
- Traffic affected by the construction on this project shall be handled in accordance with the latest edition of the Manual on Uniform Traffic Control Devices.
- The Contractor to verify utility locations prior to construction of this project.
- All disturbed areas shall be seeded with Rebel II fescue at the rate of 340 lbs. per acre. Fertilizer (13-13-13) shall be applied at the rate of 100 lbs. per acre.
- Storm sewer shown herein is to be privately maintained. The contractor shall obtain approval for Line 2 and Line 1 Sta. 0+43.8 to 2+35.2 from the Office of Central Inspection.
- Storm sewer may be constructed with either RCP, CMP, or PVC pipe at the election of the Contractor.

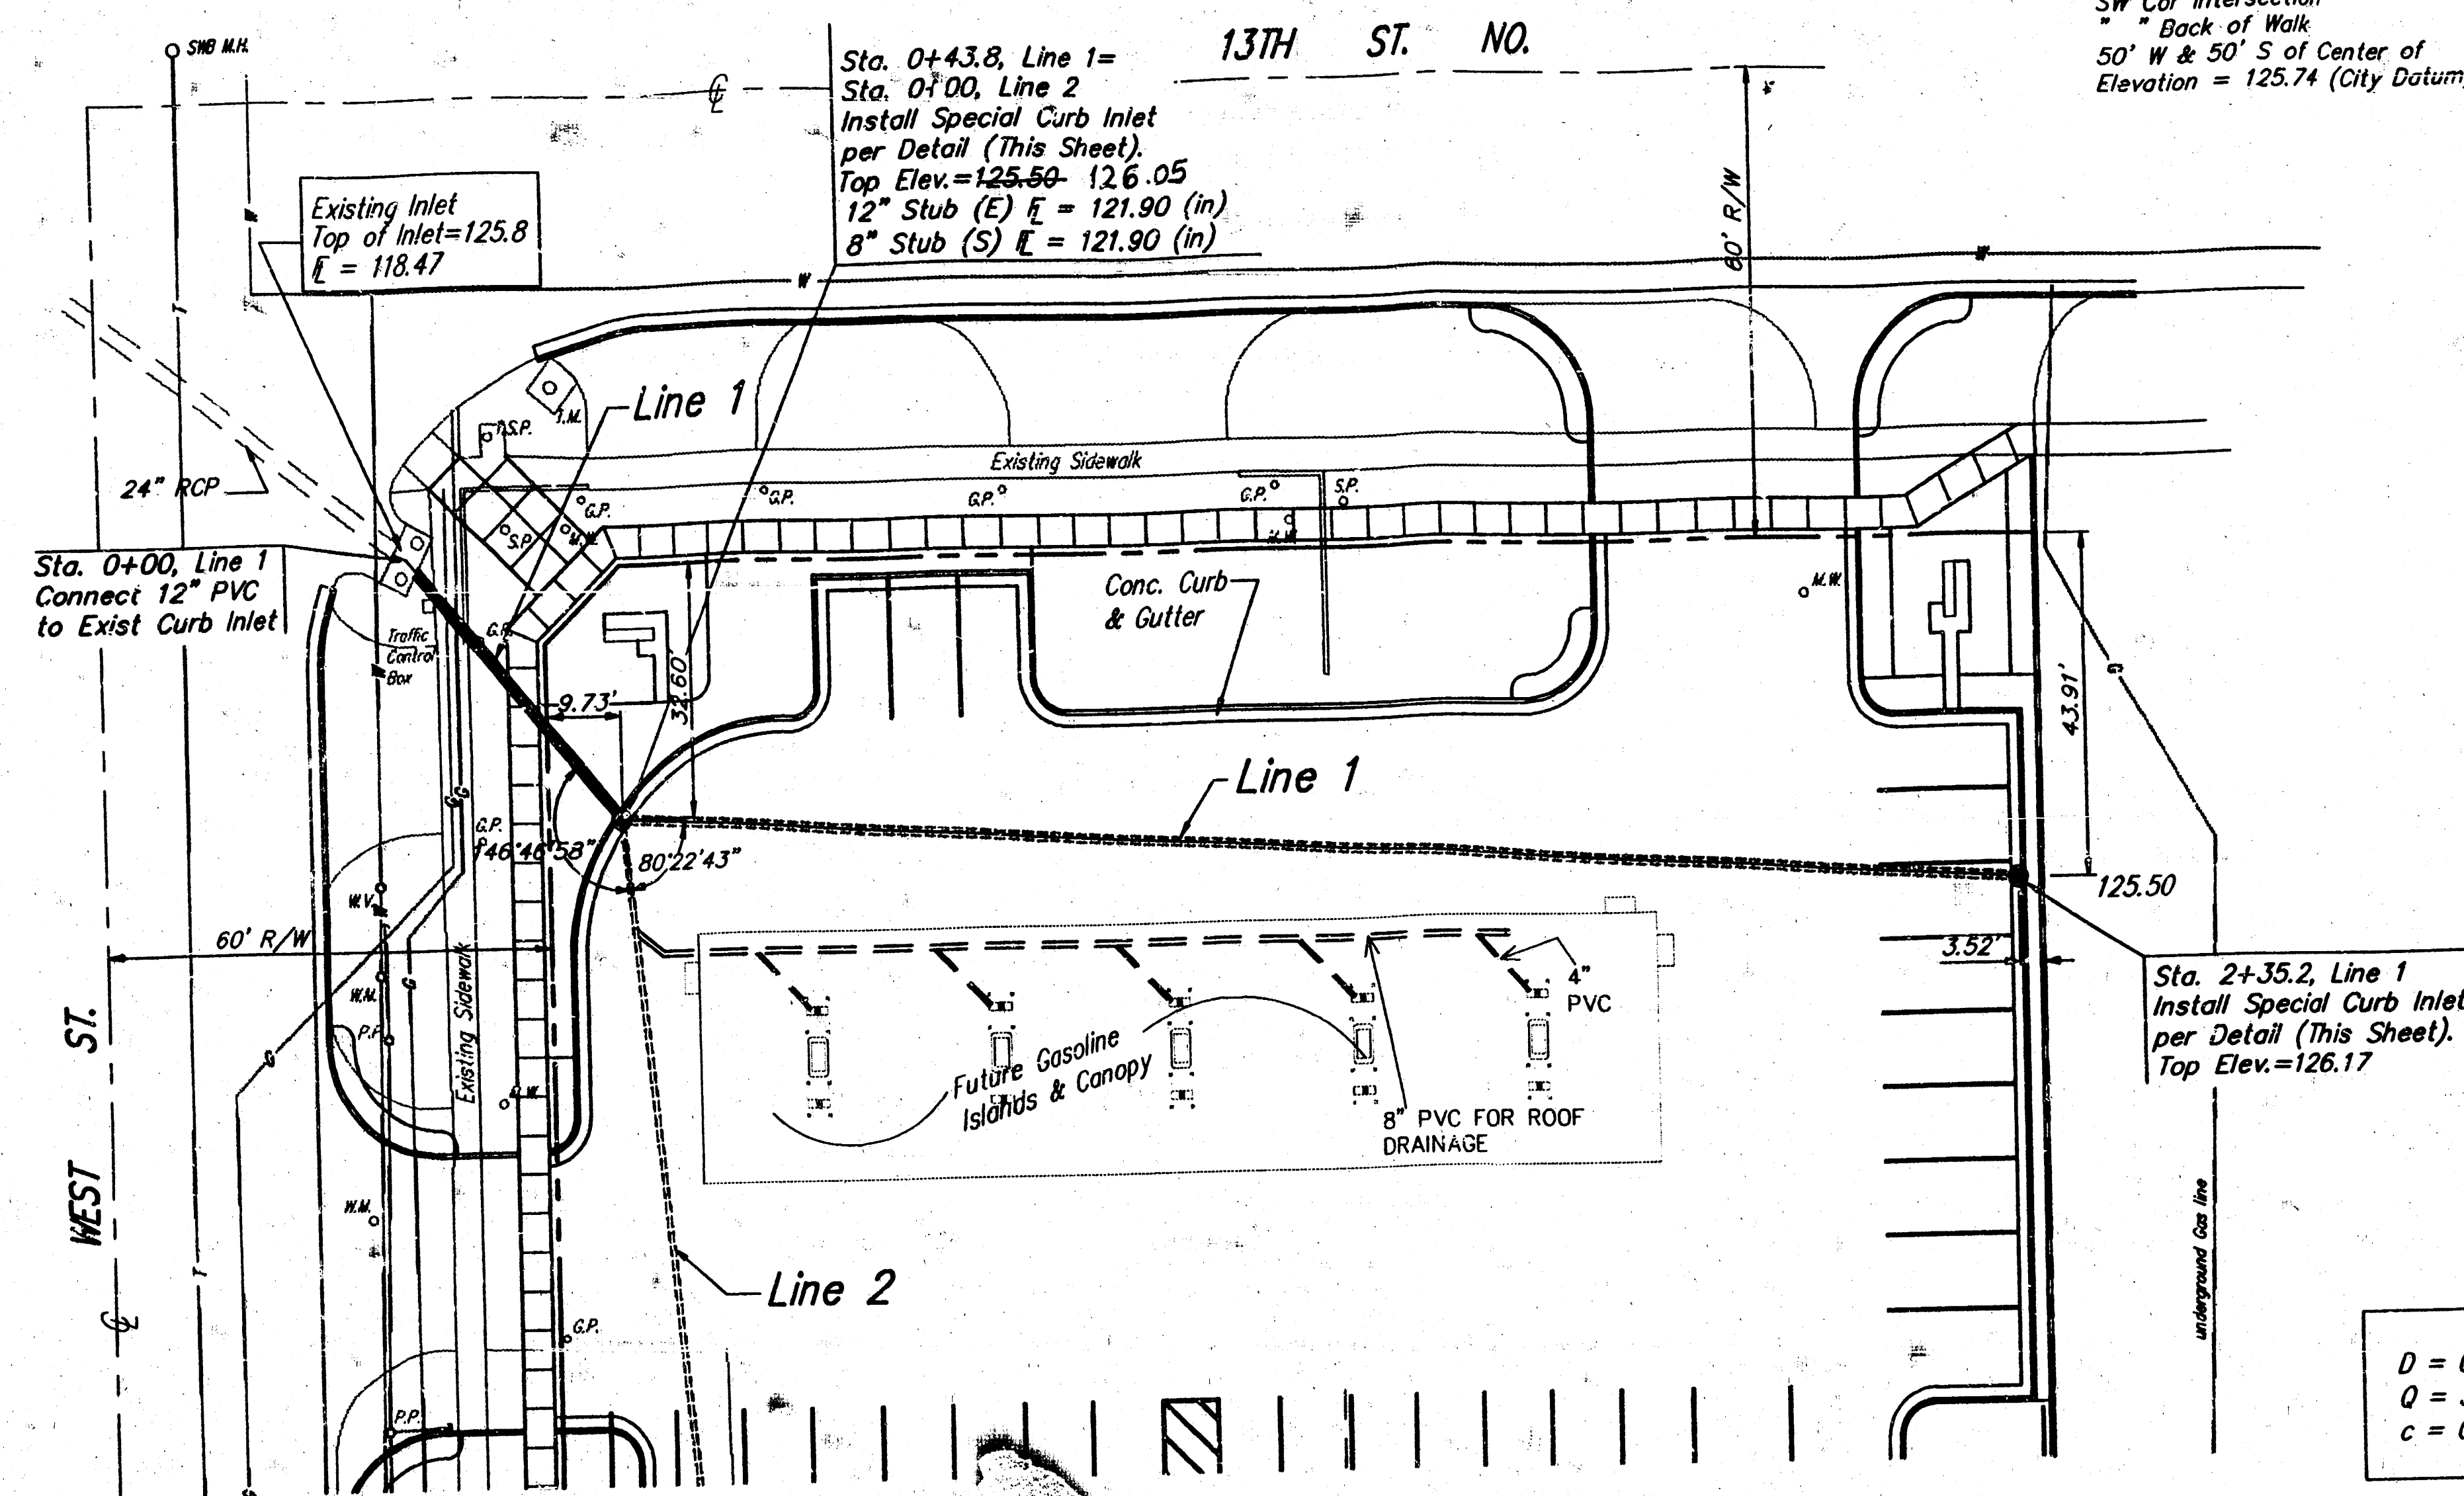

MODIFIED SPECIAL SHALLOW TYPE "B" MANHOLE

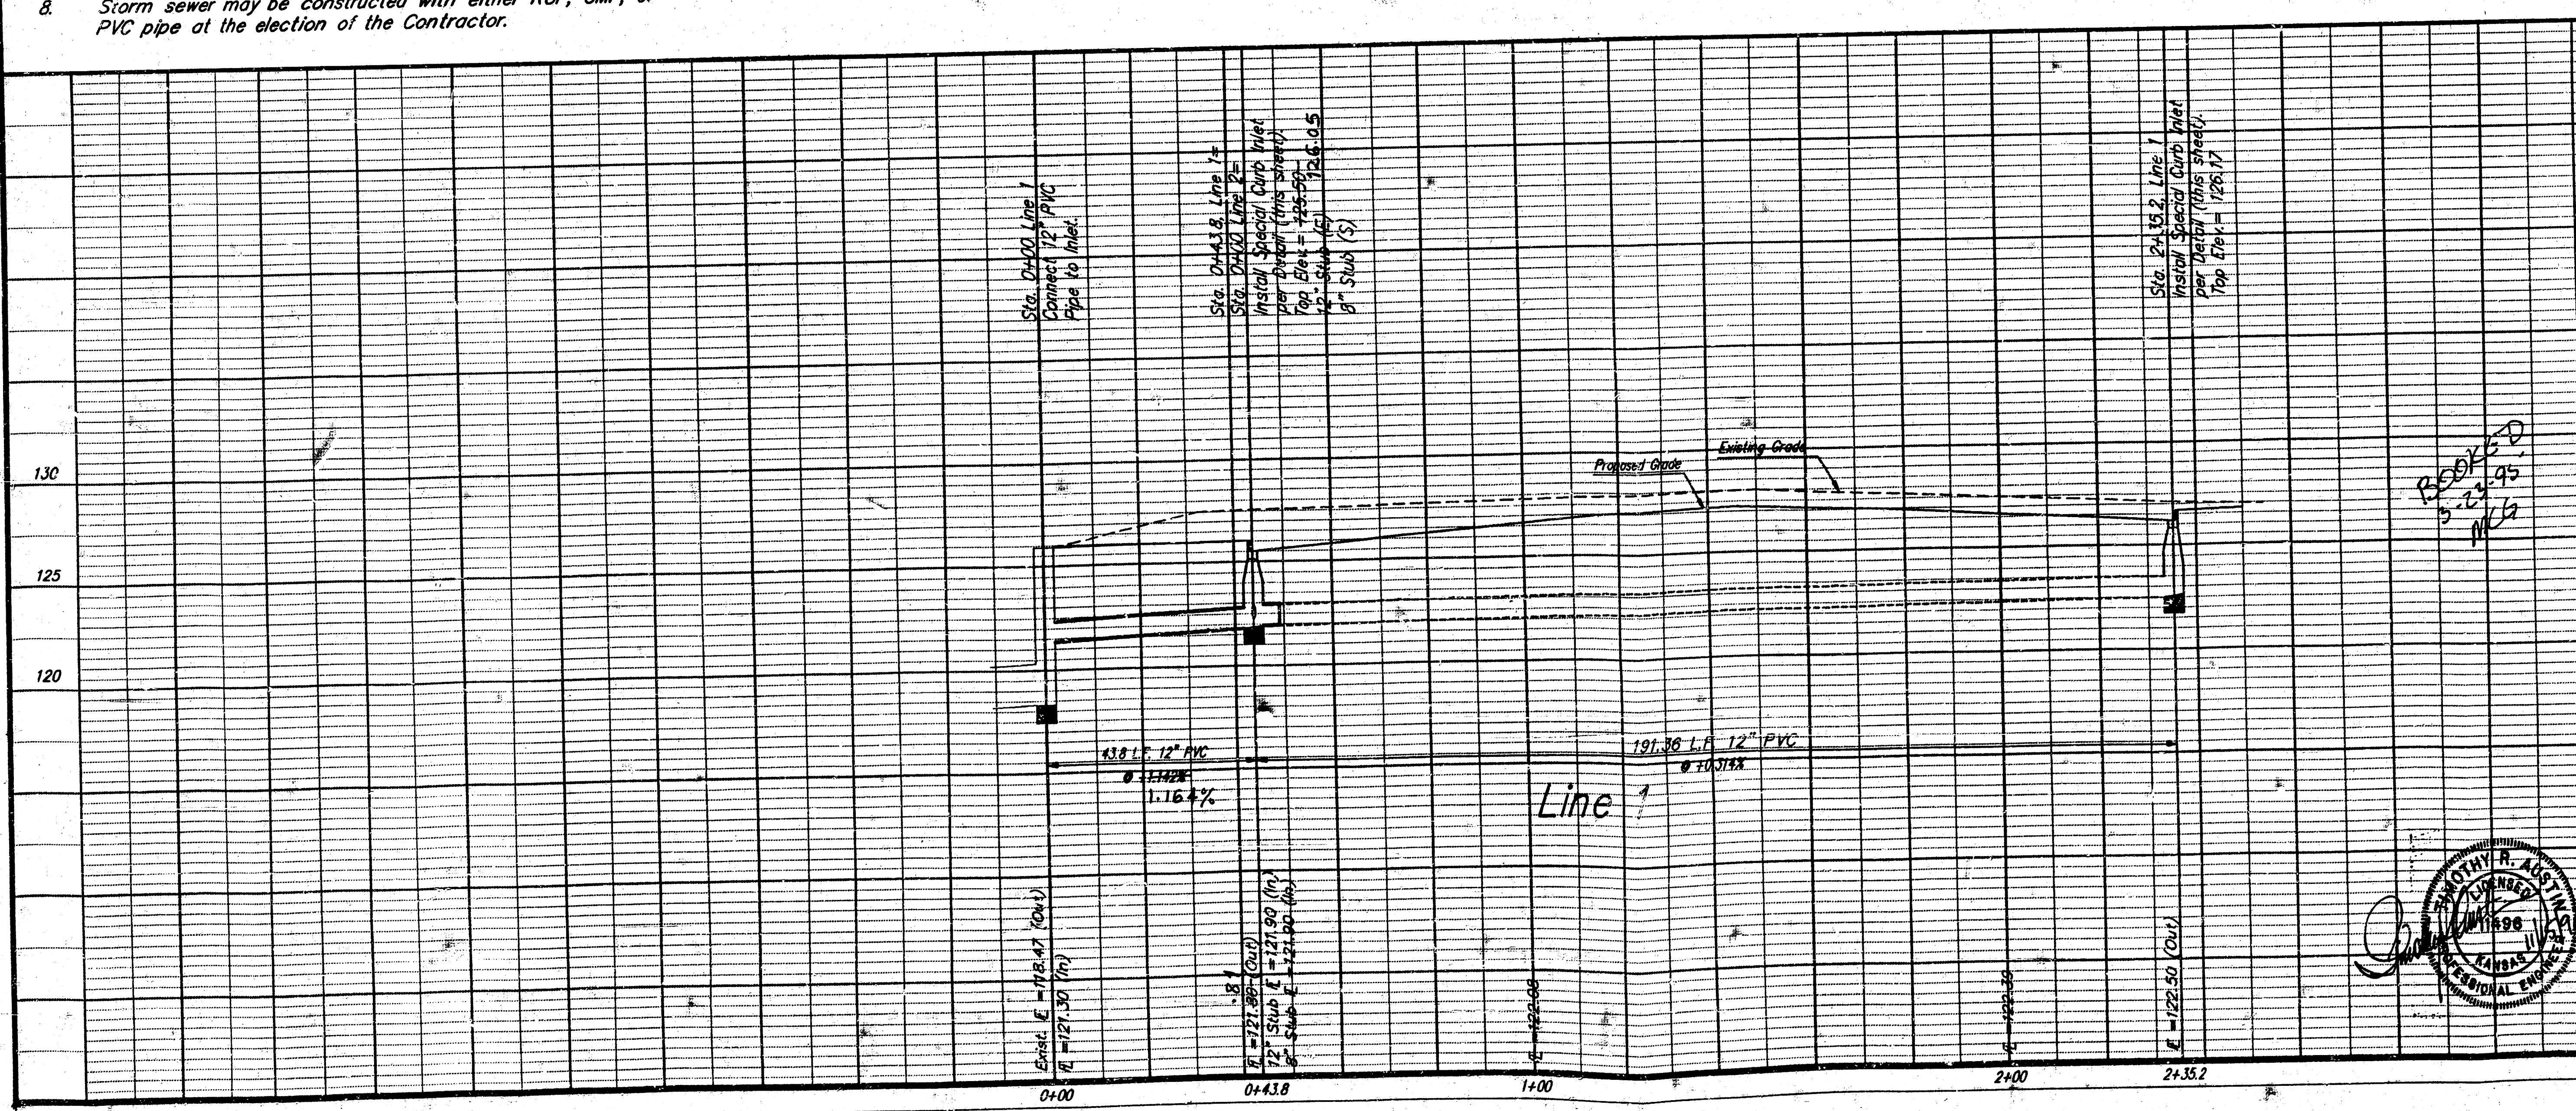

APPROVED AS NOTED
BY CITY ENGINEER OF WICHITA
Line 1 Sta. 0+00 to 0+43.8

Storm Sewers VRH 11/16/94

NOTE TO CONTRACTORS

Inspection and testing for this project is to be provided by a Licensed Consulting Engineering Firm under contract with the Owner/Developer. Said inspection to be in accordance with the City of Wichita standard construction engineering practices and certified by a Licensed Professional Engineer. No work shall be performed in dedicated easements or public right-of-way by the Contractor without such inspection nor shall any work be commenced without written authorization by the City Engineer. All Construction and Materials shall comply with the City of Wichita Specifications and Standards (on file and available in the City Engineer's Office).



As Built 1-3-95

STORMWATER SEWER IMPROVEMENTS
QUIKTRIP STORE 360
13TH ST. N. & WEST ST.

BAUGHMAN COMPANY P.A.
ENGINEERING, SURVEYING, & PLANNING
316-292-7271 • 315 8115 • WICHITA, KANSAS 67211

PROJECT NUMBER
510 PPS (607861)

DESIGN 1A DRAWN 1A APPROVED DATE NOV. 94 SCALE NOTED SHEET 1 OF 2

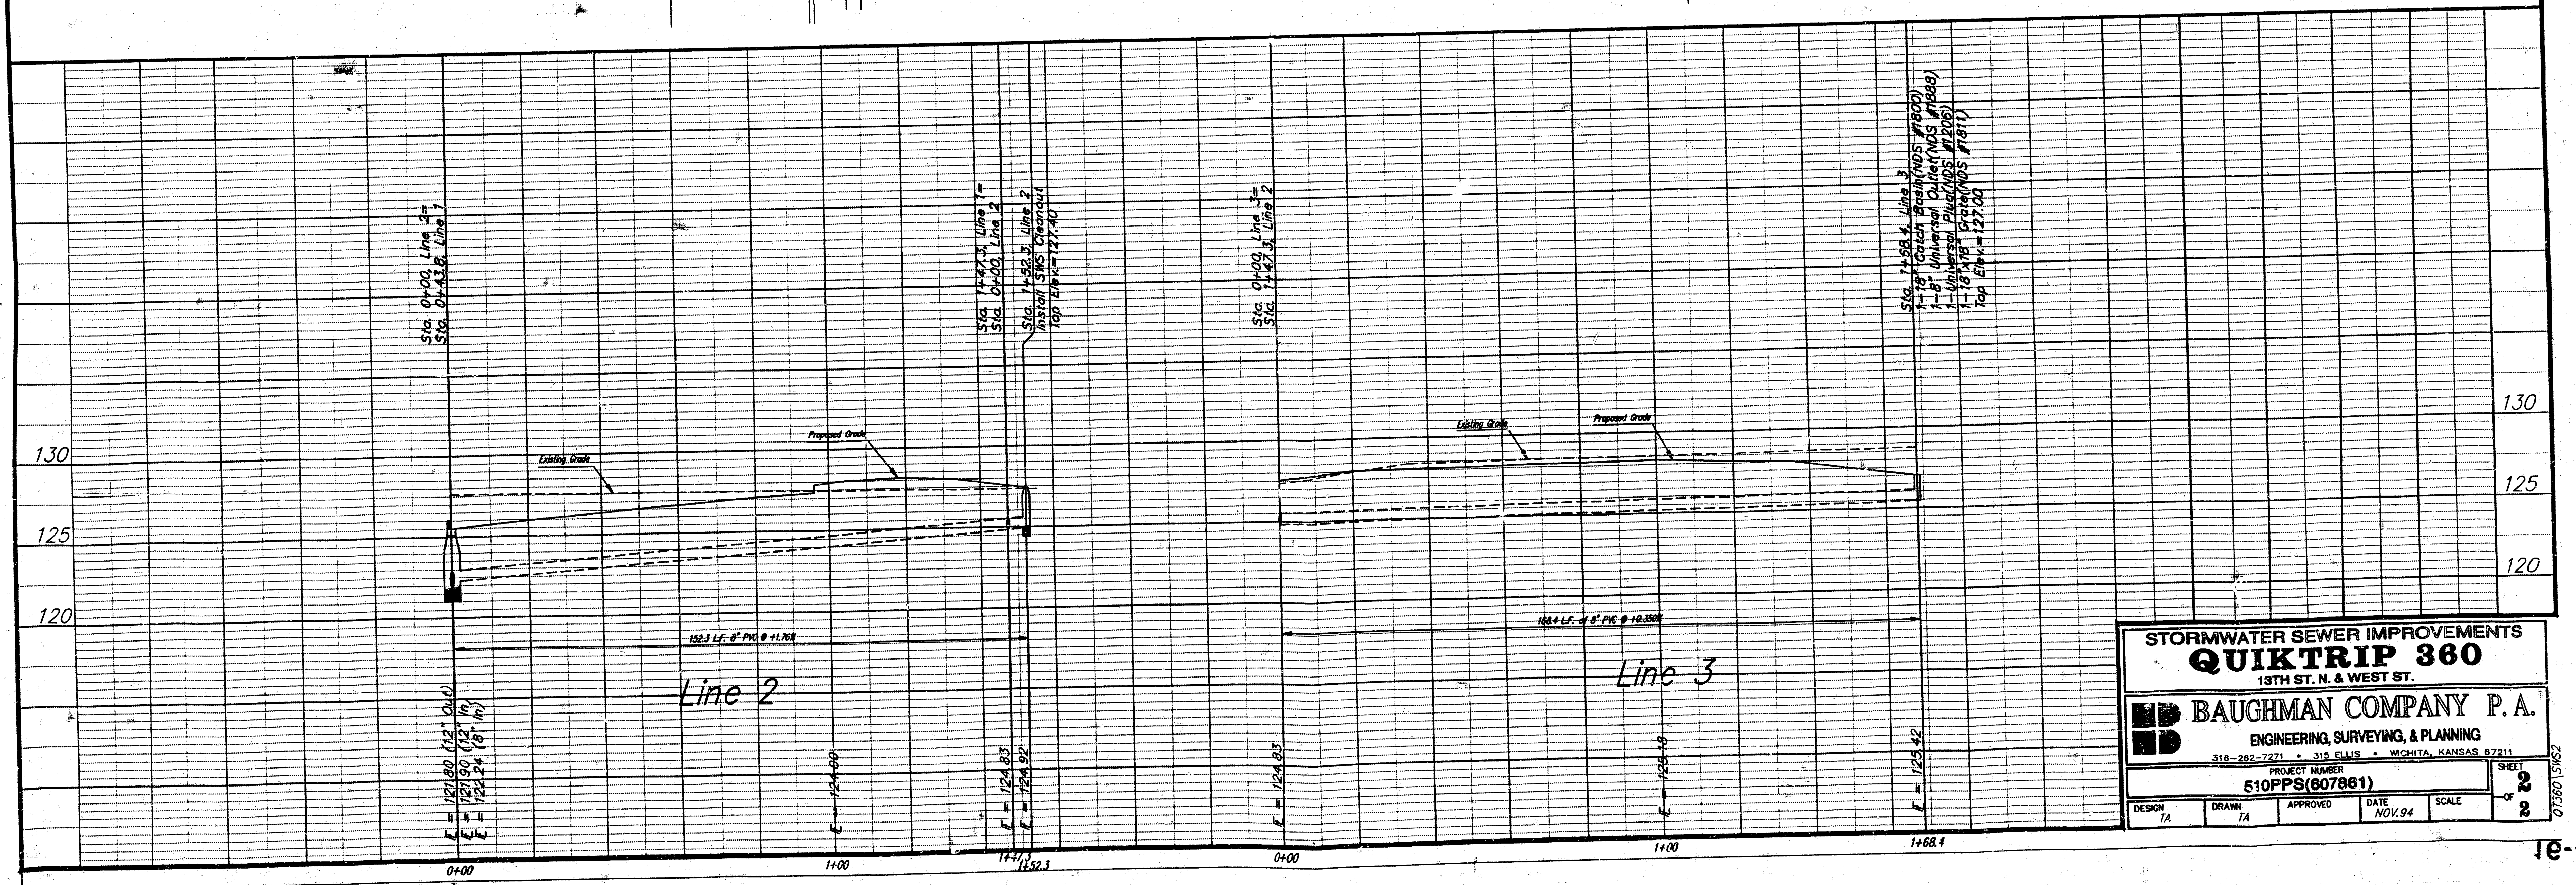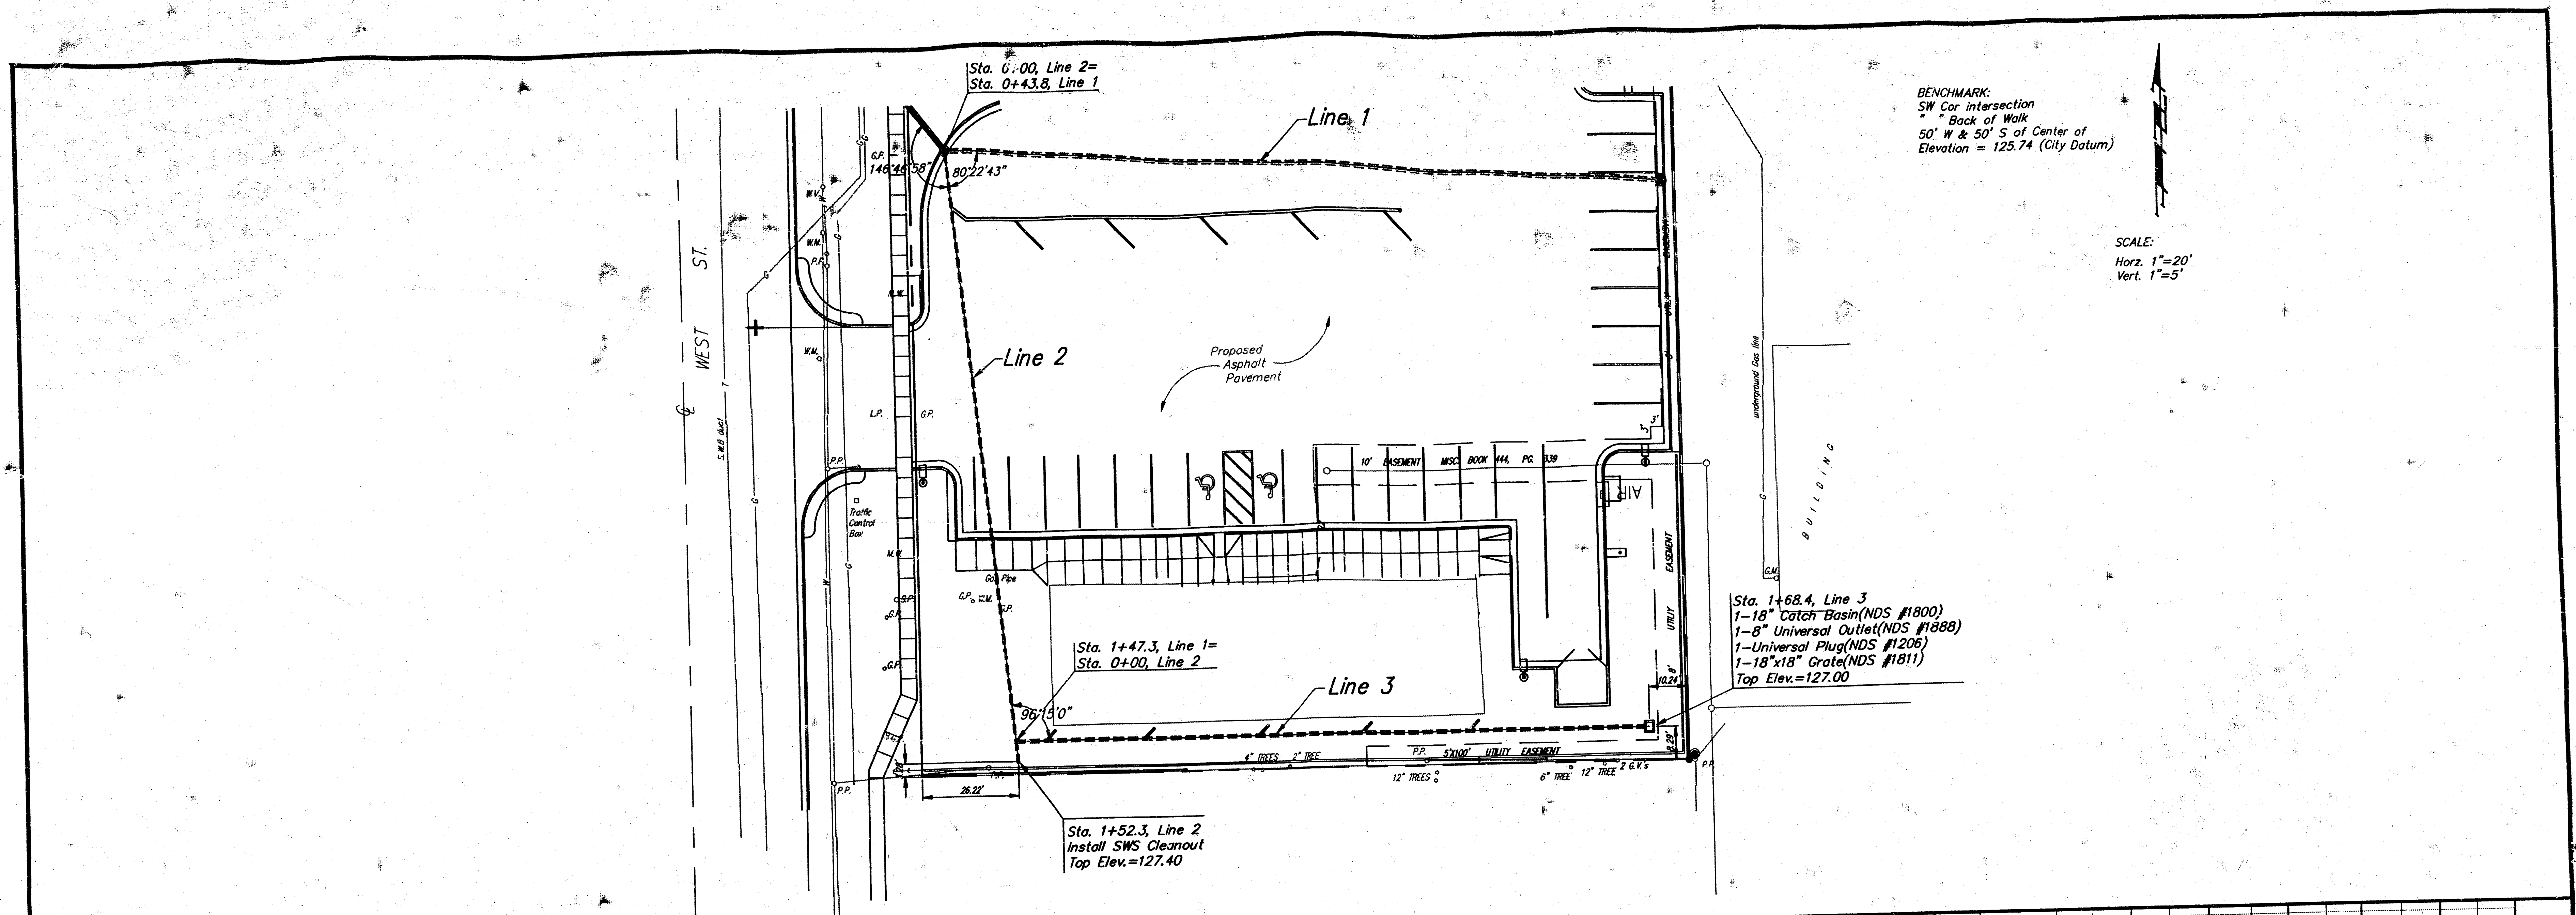

STORMWATER SEWER IMPROVEMENTS			
QUIKTRIP 360			
13TH ST. N. & WEST ST.			
BAUGHMAN COMPANY P. A.			
ENGINEERING, SURVEYING, & PLANNING			
318-261-7271 • 315 ELLIS • WICHITA, KANSAS 67211			
PROJECT NUMBER			
510PPS(607861)			
DESIGN	TA	DATE	NOV. 94
DRAWN	TA	SCALE	1"=20'
APPROVED			
SHEET			2
OF			2