


SCALE: HORIZONTAL - 1" = 50'-0"
 VERTICAL - 1" = 5'-0"

RIVERPARK II

STORM SEWER PLAN & PROFILES
 GENERAL CONTRACTOR - UTILITY CONTRACTORS INC.
 1977 U-1065


2' or 3" thick minimum
 concrete. Cradle around water pipe
 required. *Yes*

APPROVED AS NOTED
 BY CITY ENGINEER OF WICHITA
 Sanitary Sewers
 Storm Sewers *Yes 8/10/77*
 Driveway Approaches

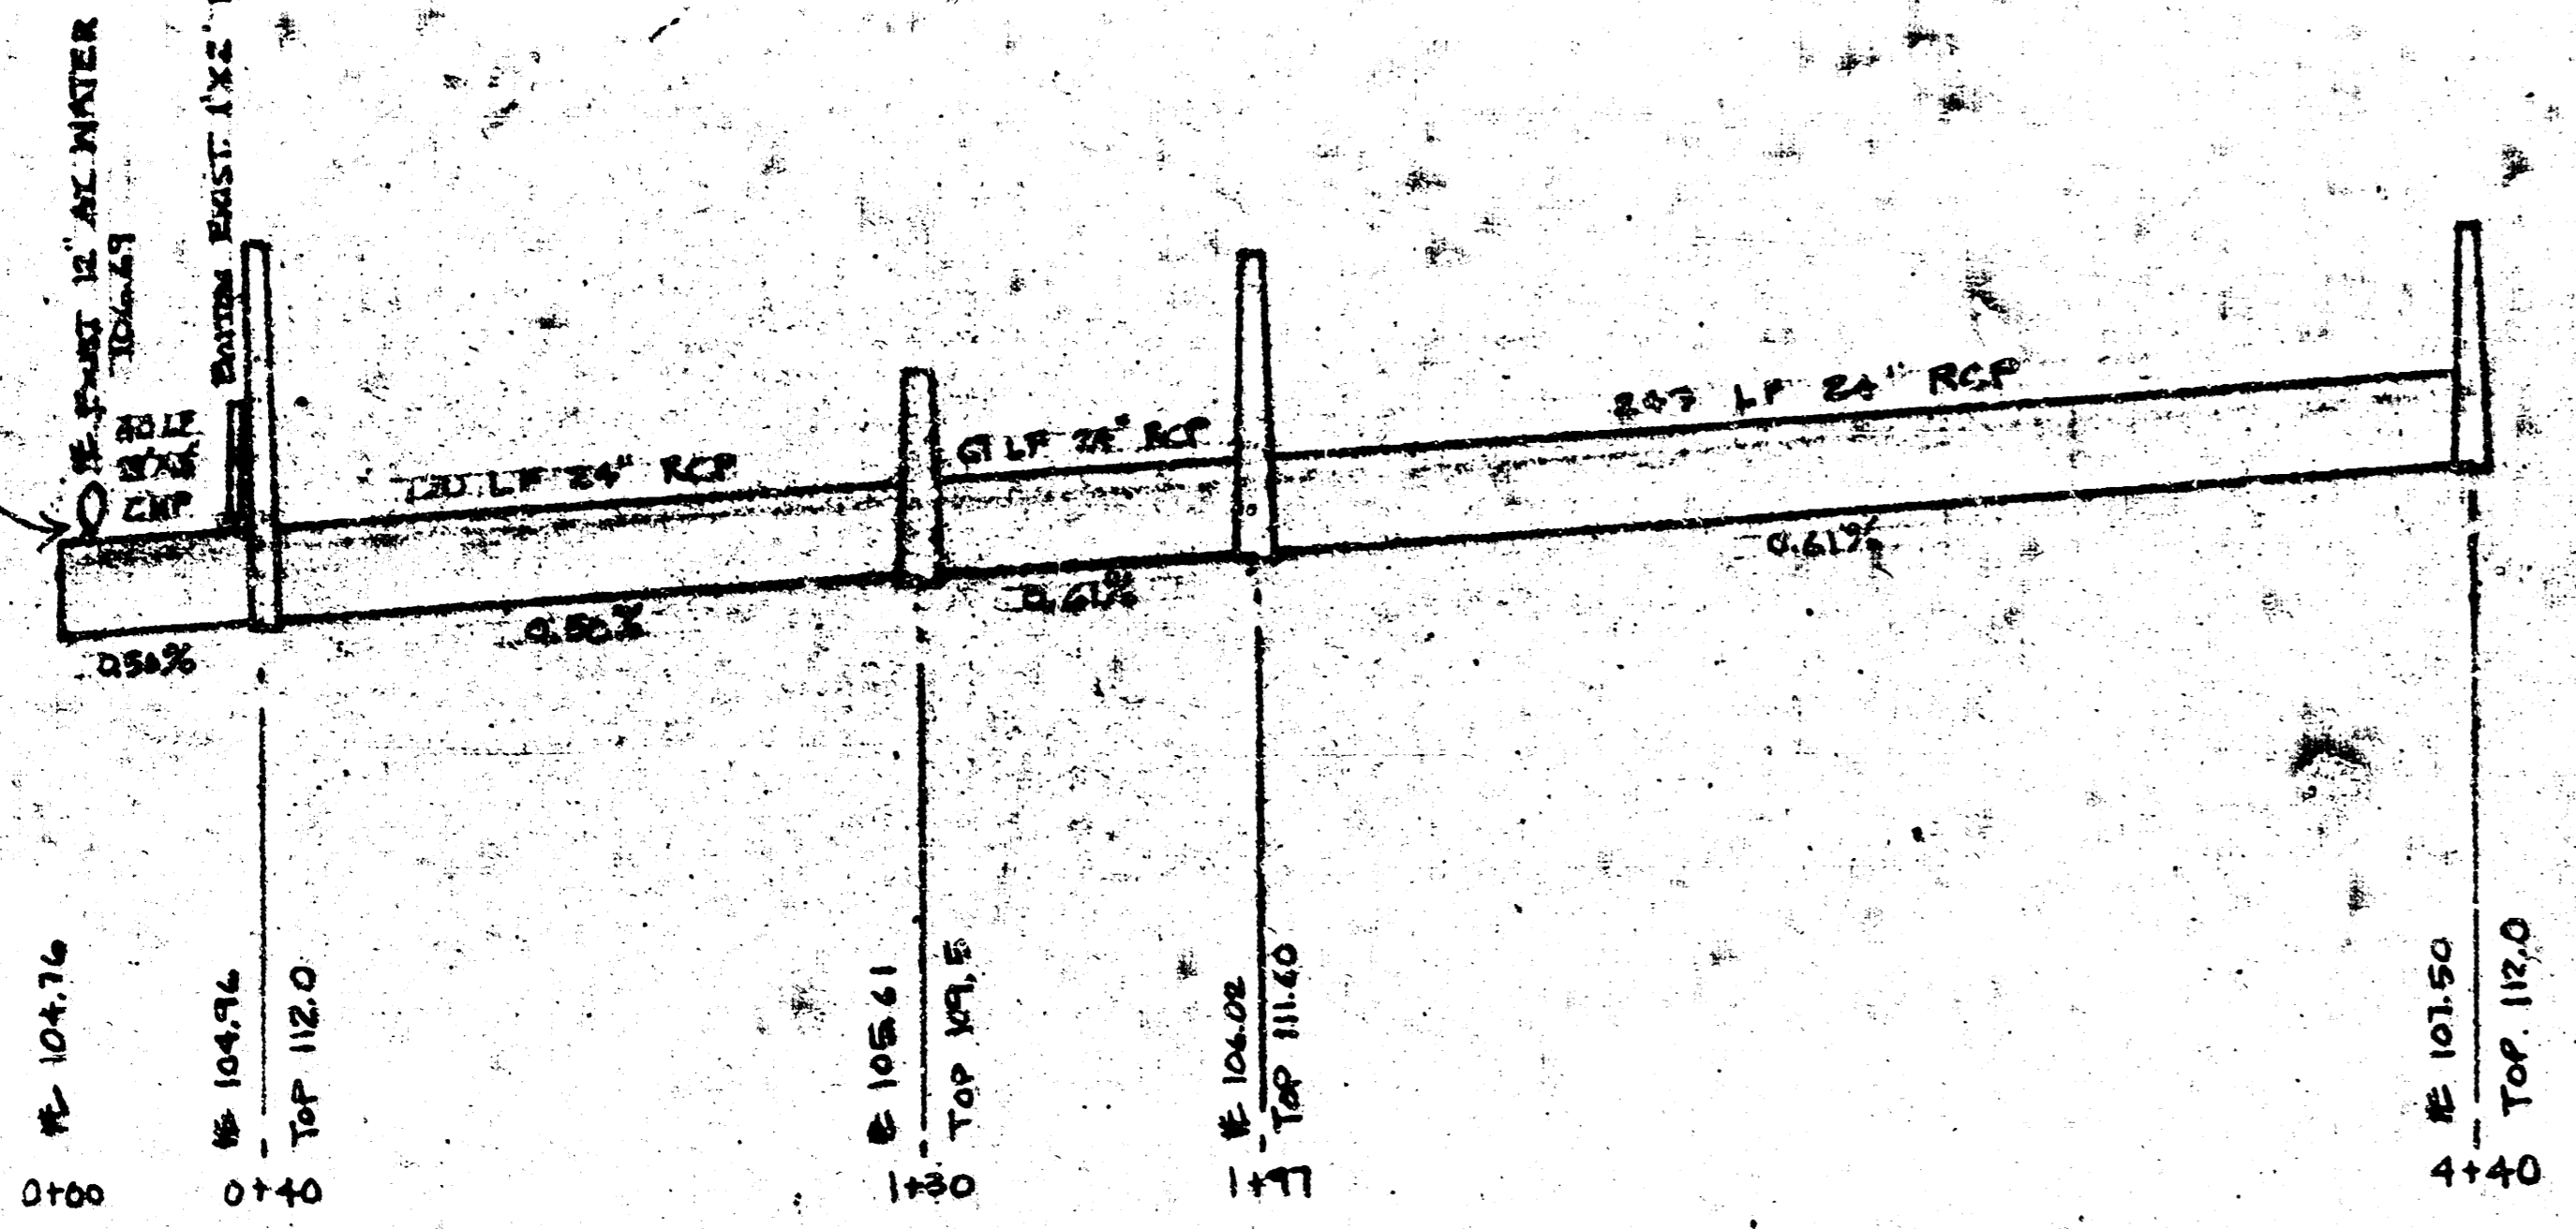


City of Wichita Private Storm Sewer No. DBKW 707043


LINE 1

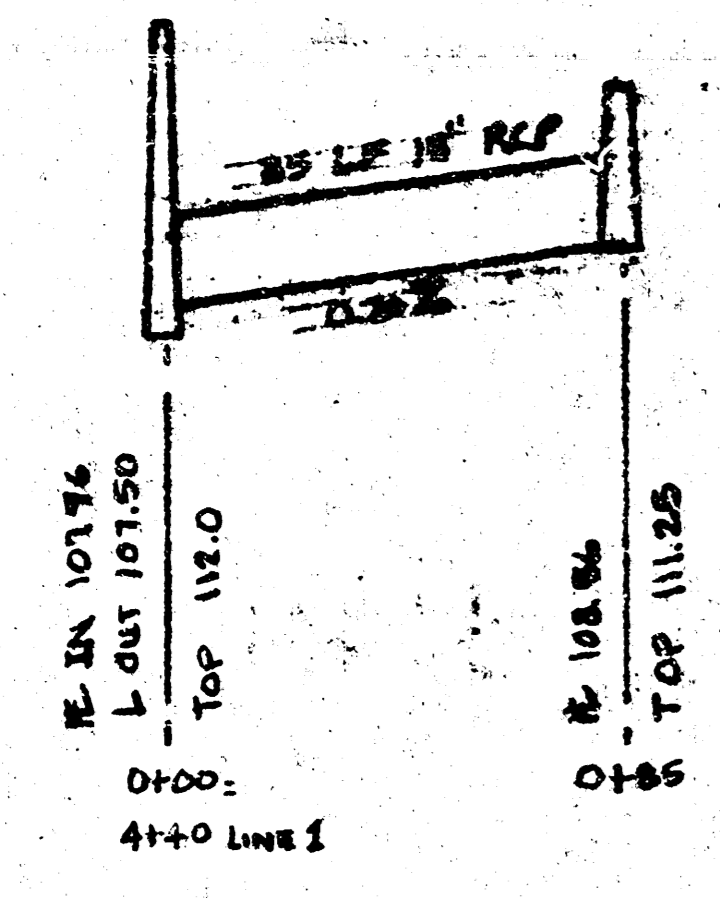


LINE 1A

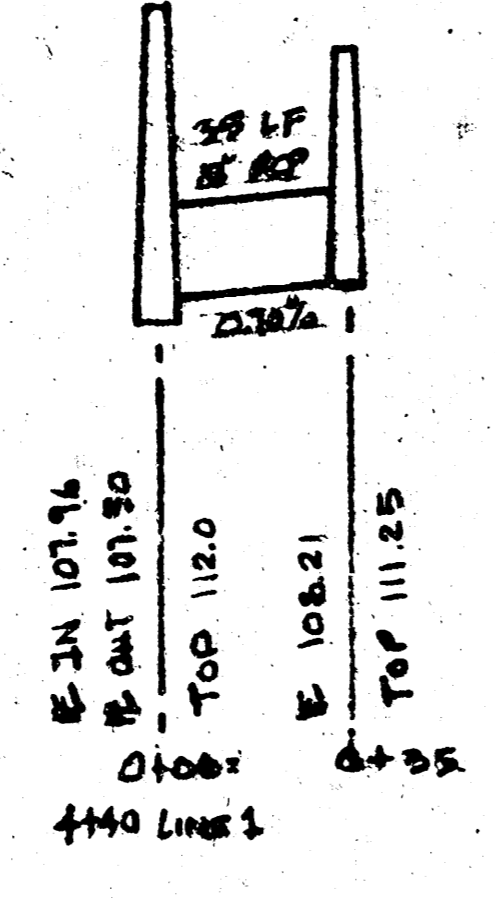


LINE 1B

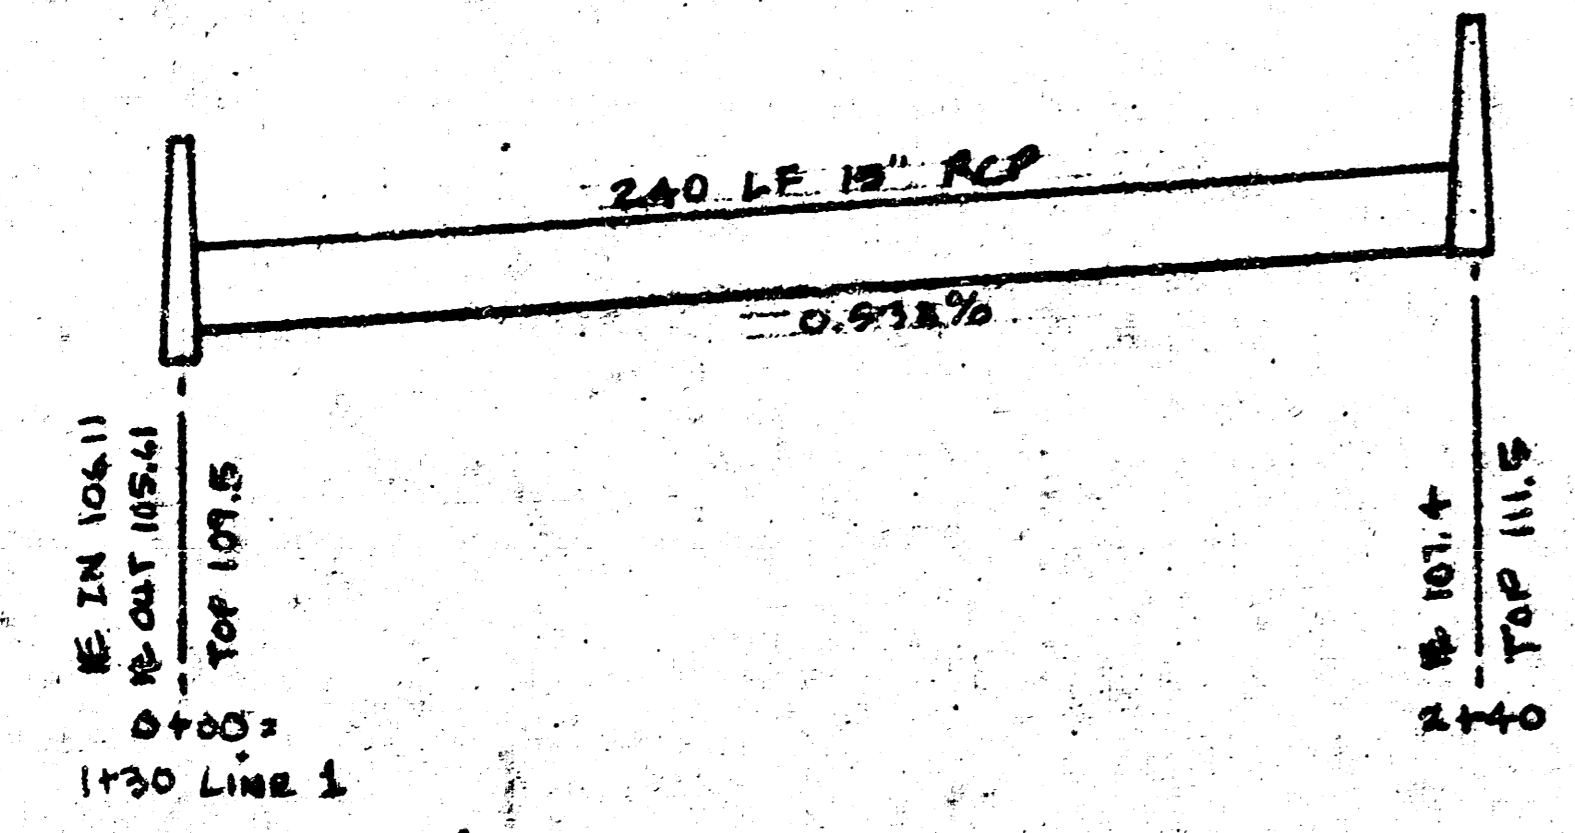


LINE 3

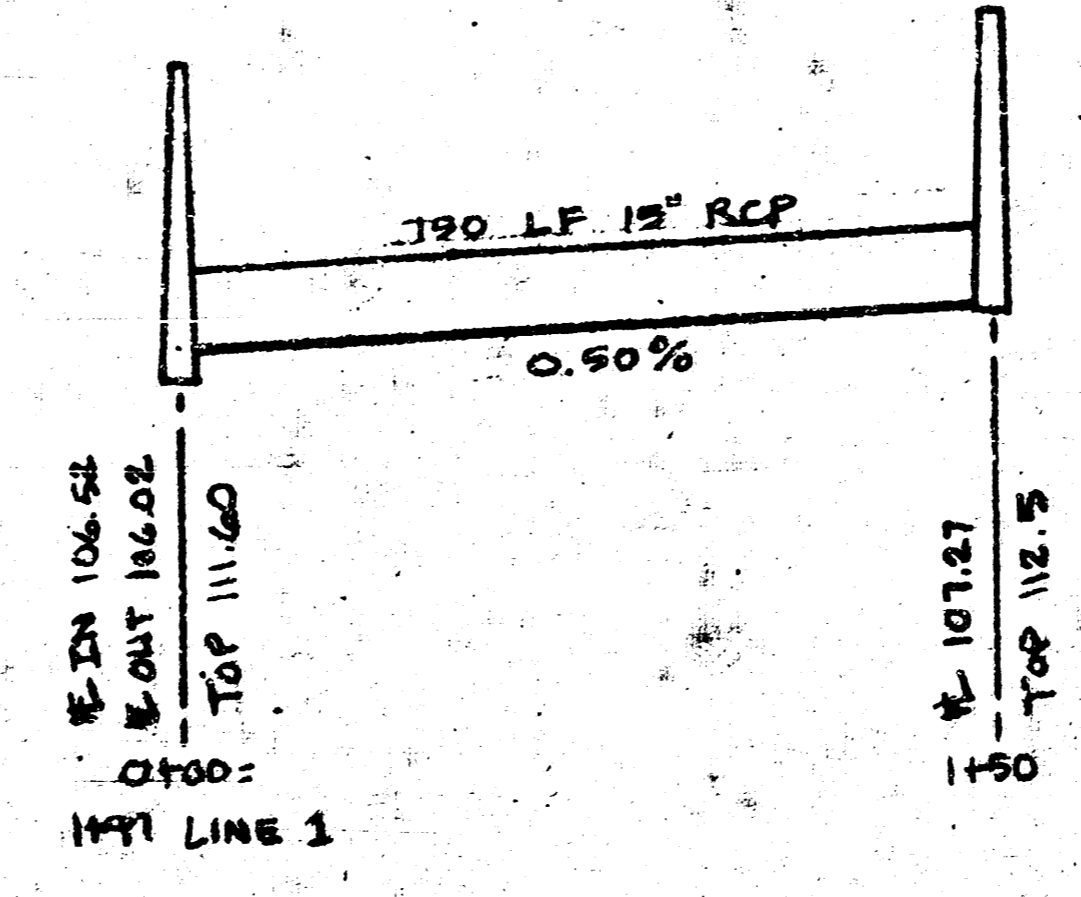


LINE 4

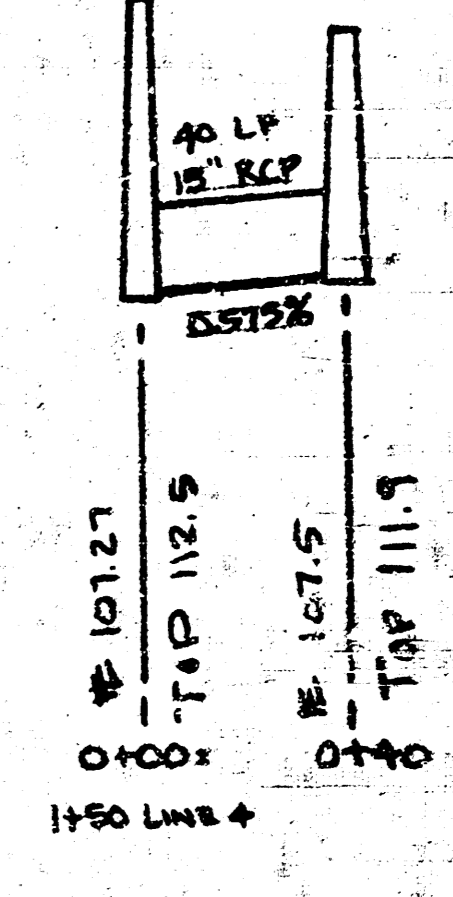

LINE 4A

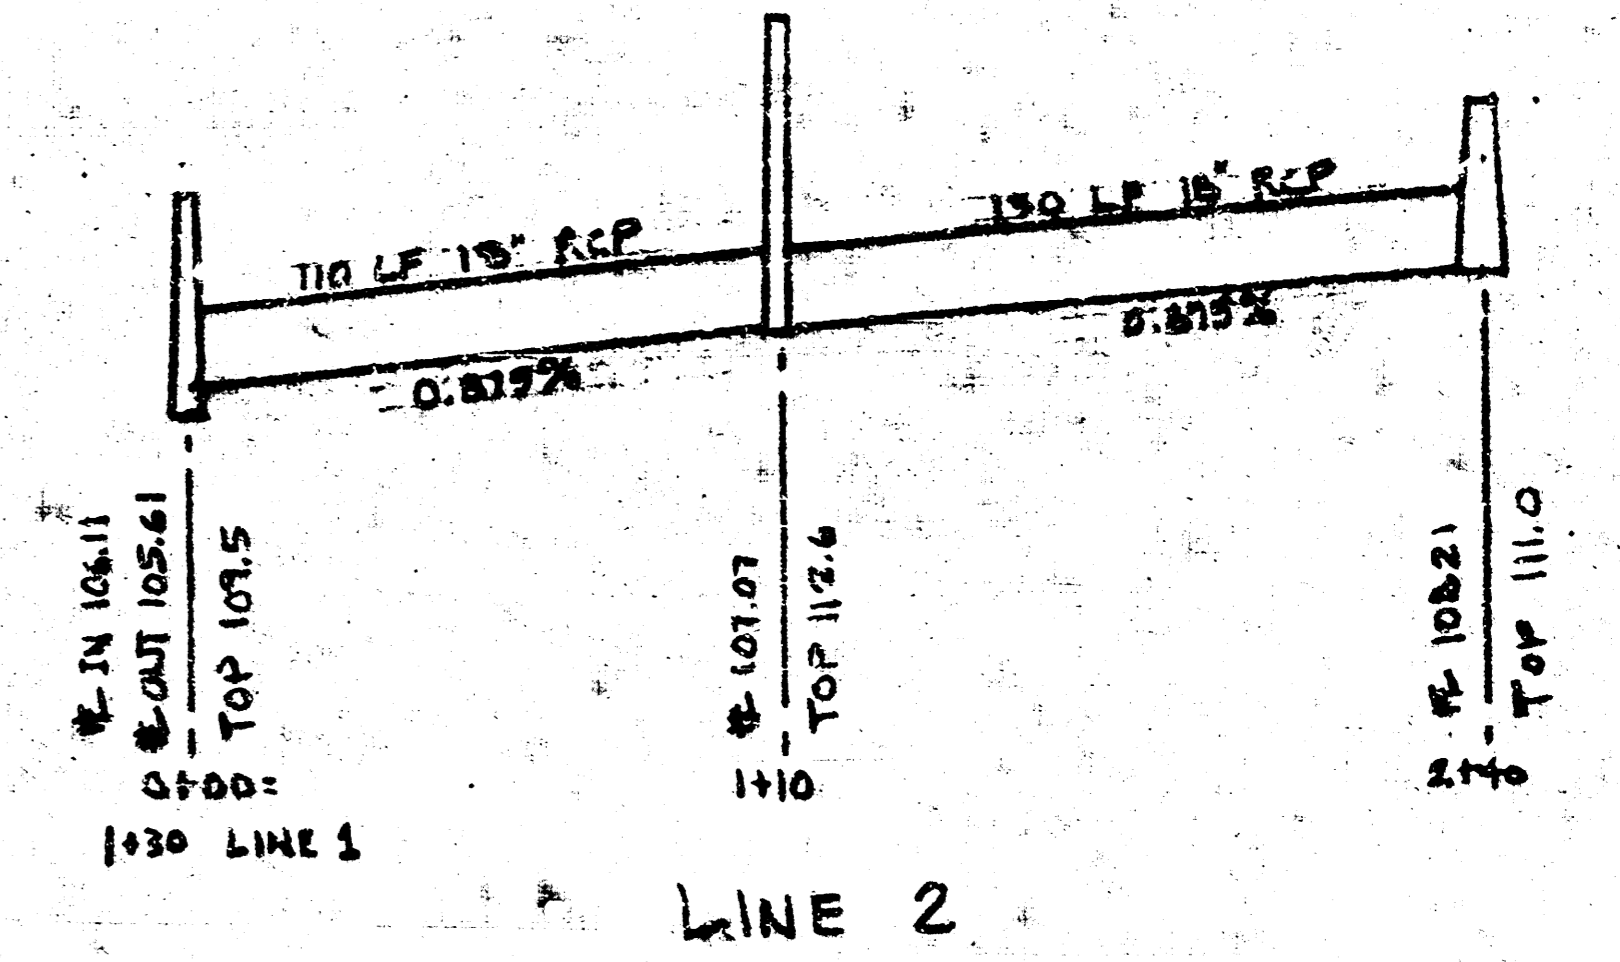

LINE 2

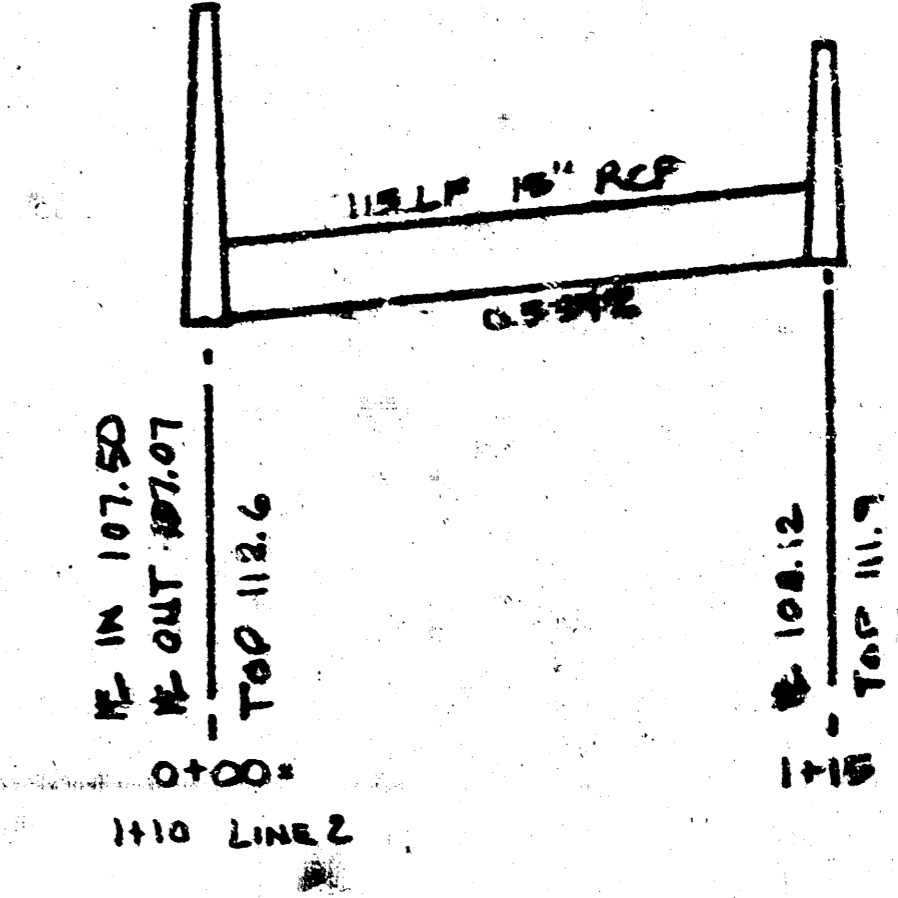

LINE 2

115

110

105

100

115

110

105

115

110

105

115

110

105

Scale Horiz. 1" = 50'
 Vert. 1" = 5'