
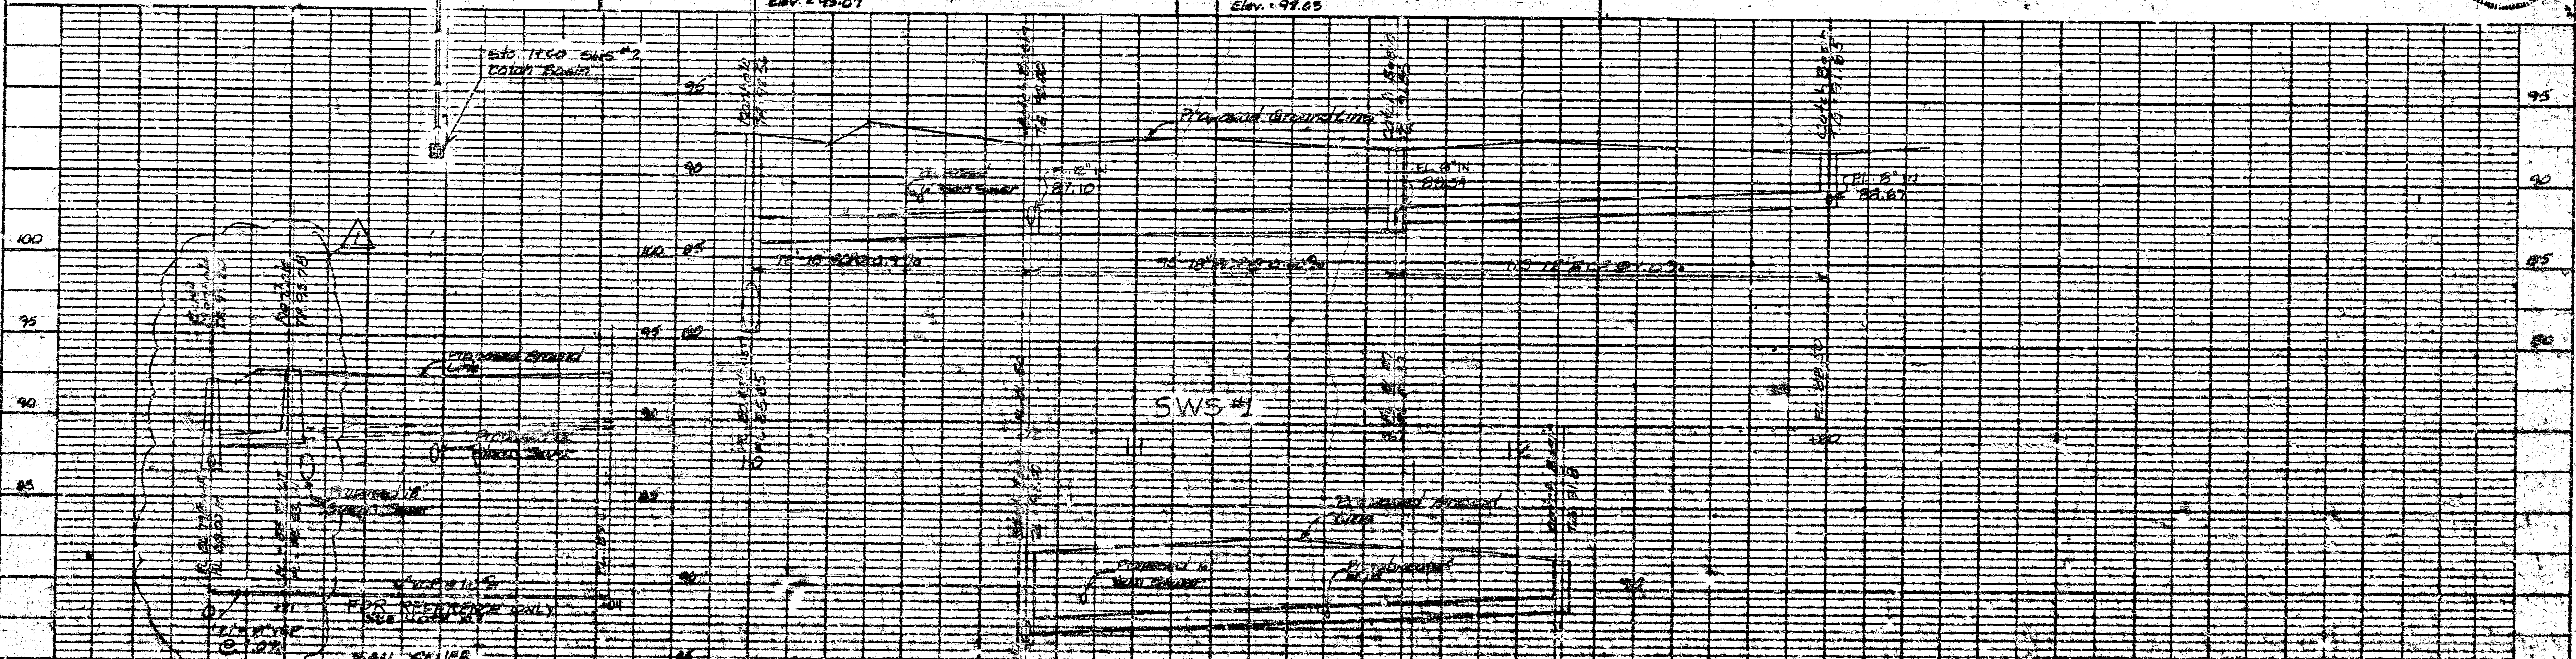


DATE	2/1/74
BY	W. J. KIRK
CHECKED	W. J. KIRK
APPROVED	W. J. KIRK
NO.	1

DATE	2/1/74
BY	W. J. KIRK
CHECKED	W. J. KIRK
APPROVED	W. J. KIRK
NO.	1

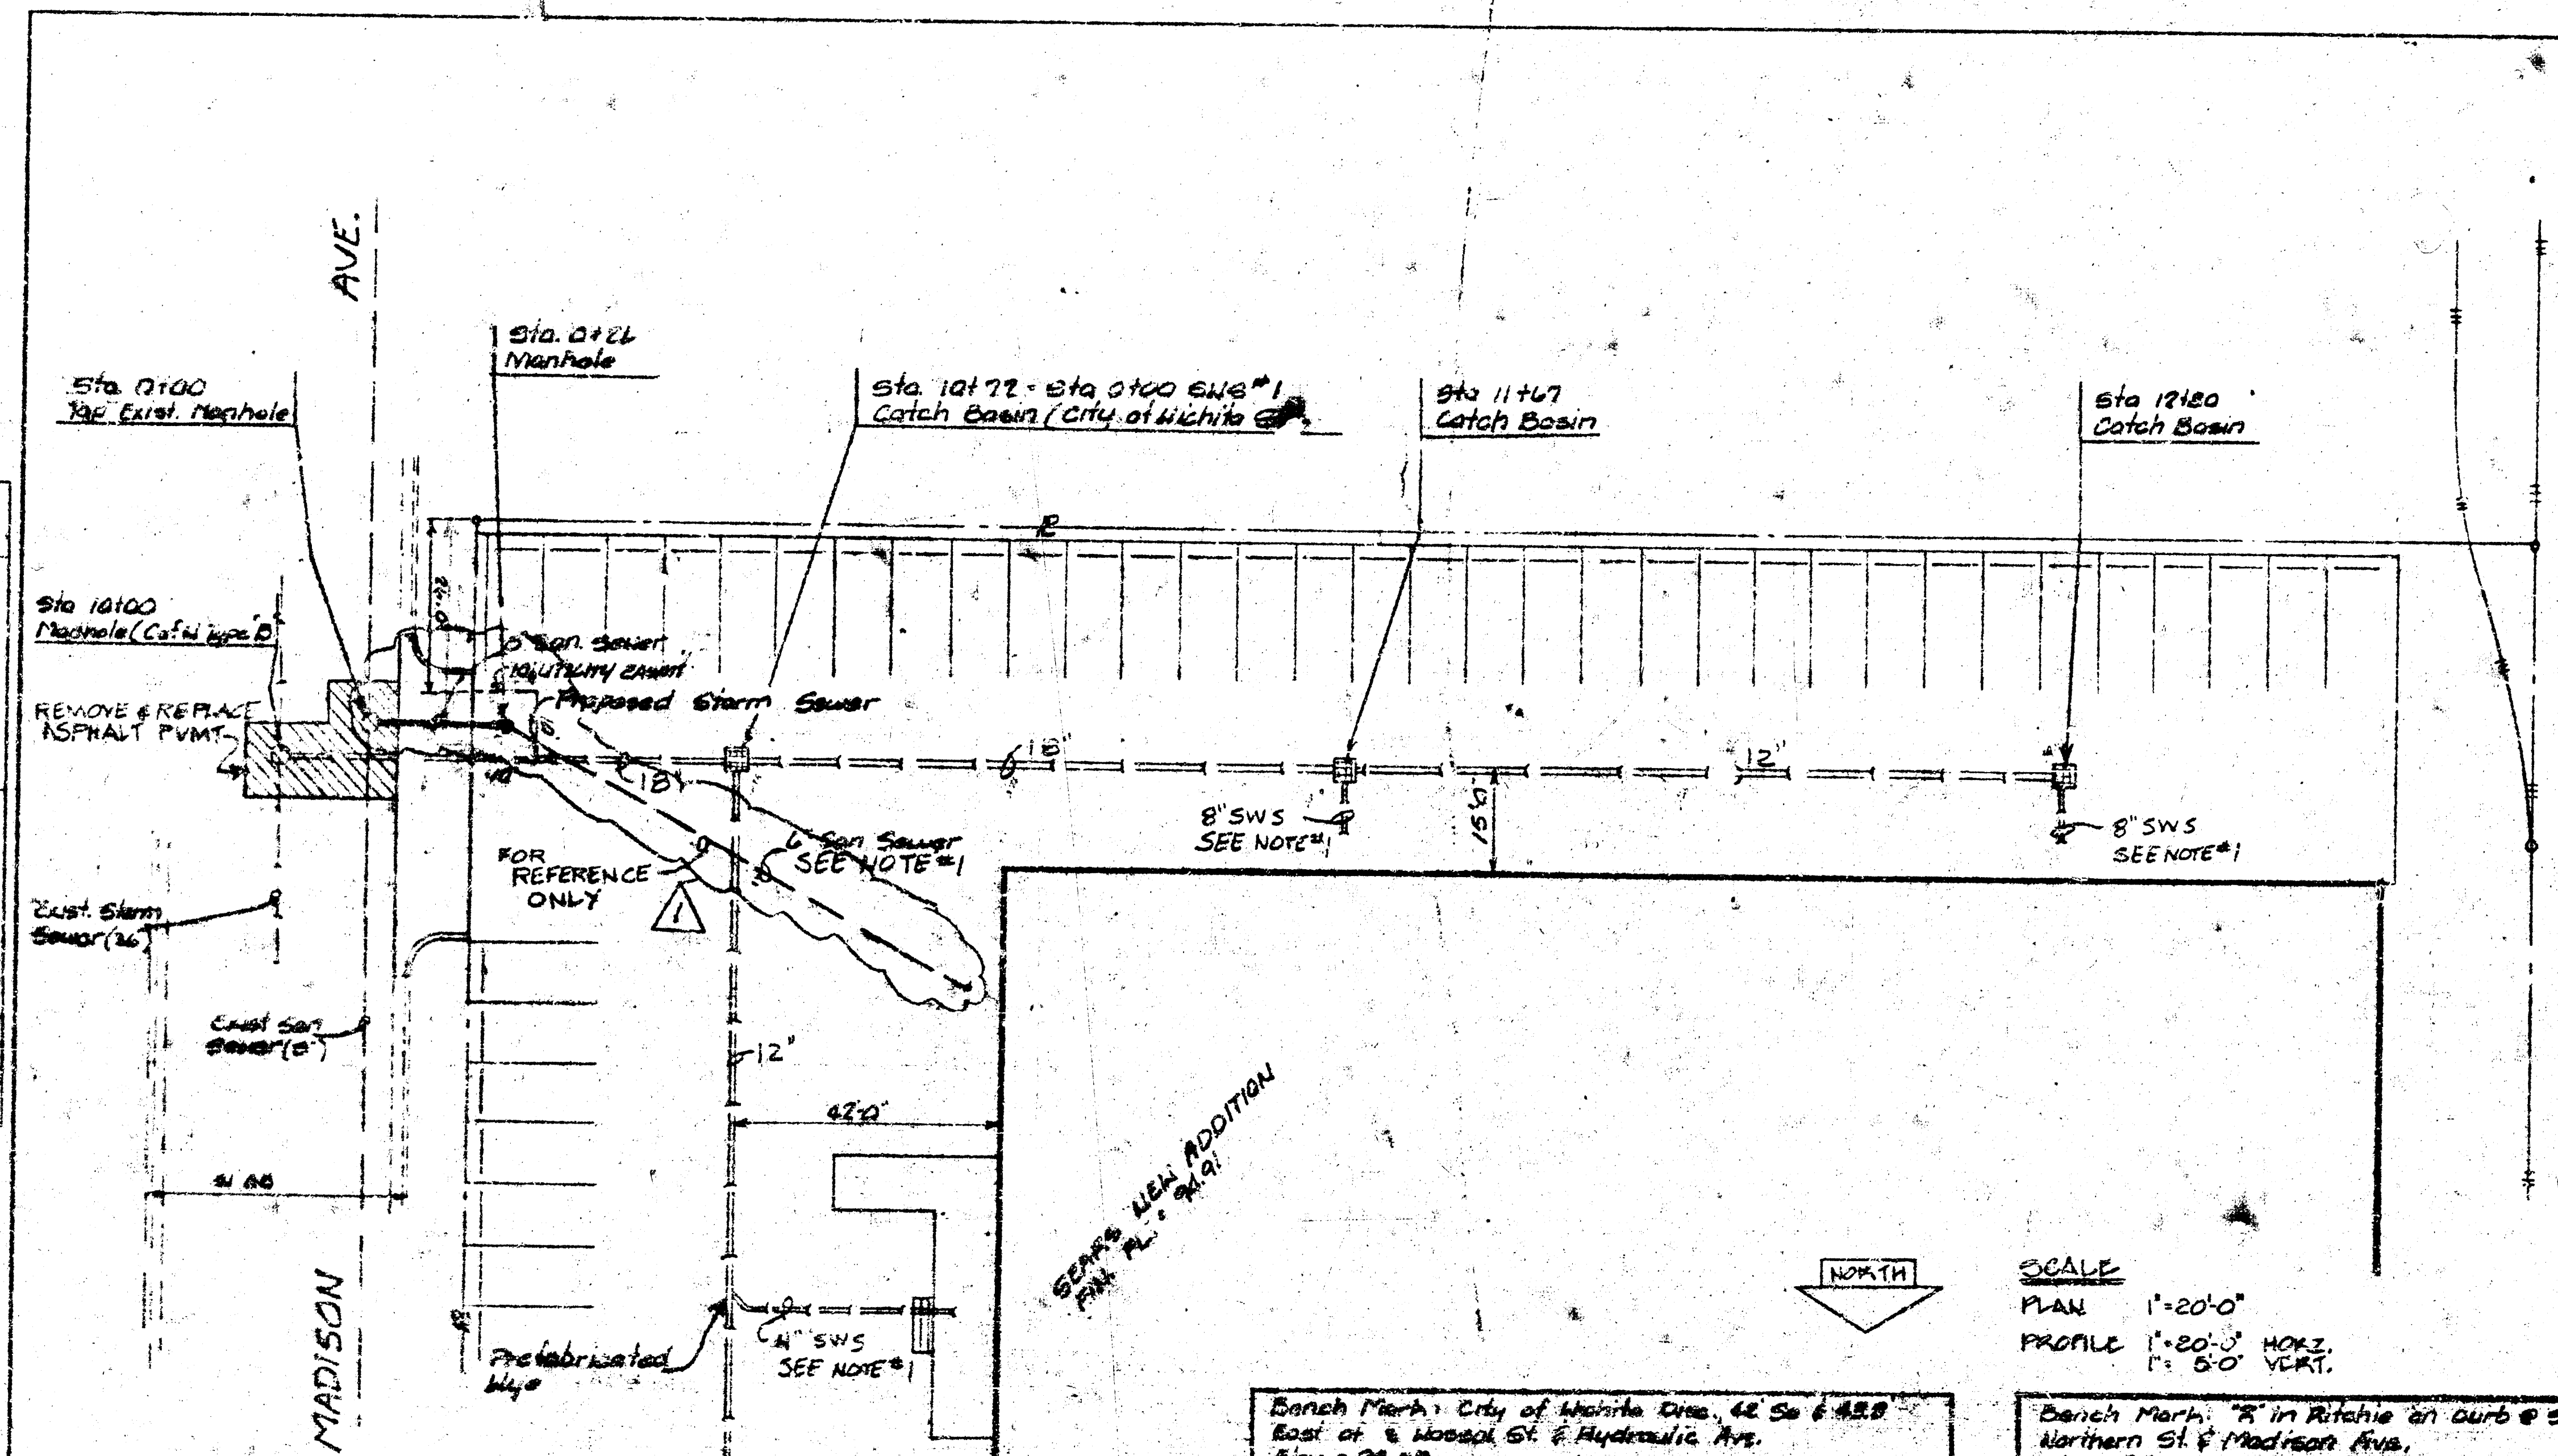


NOT TO CONSTRUCTION
This project was designed under the supervision of the City Engineer and is subject to the approval of the City Engineer.

10-7-74
APPROVED AS NOTED
By CITY ENGINEER
County Engineer: D.E.S.
Storm Sewer: D.E.S.
Sanitary Sewer: D.E.S.

NOTED:
REFER TO SHEET 28-1 FOR
SANITARY SEWER, 8" AND
4" STORM WATER SEWERS.

Proj. No. DBKW 704059

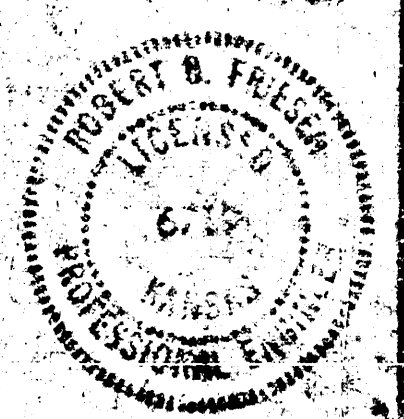


DATE	REVISION
2-1-74	1.0

FOR CONSTRUCTION

W. J. KIRK
Arch.
S.E.
WICHITA, KANS.

SEARS ROEBUCK
WAREHOUSE
REMODEL
WICHITA, KANS.

PROJECT NUMBER 74

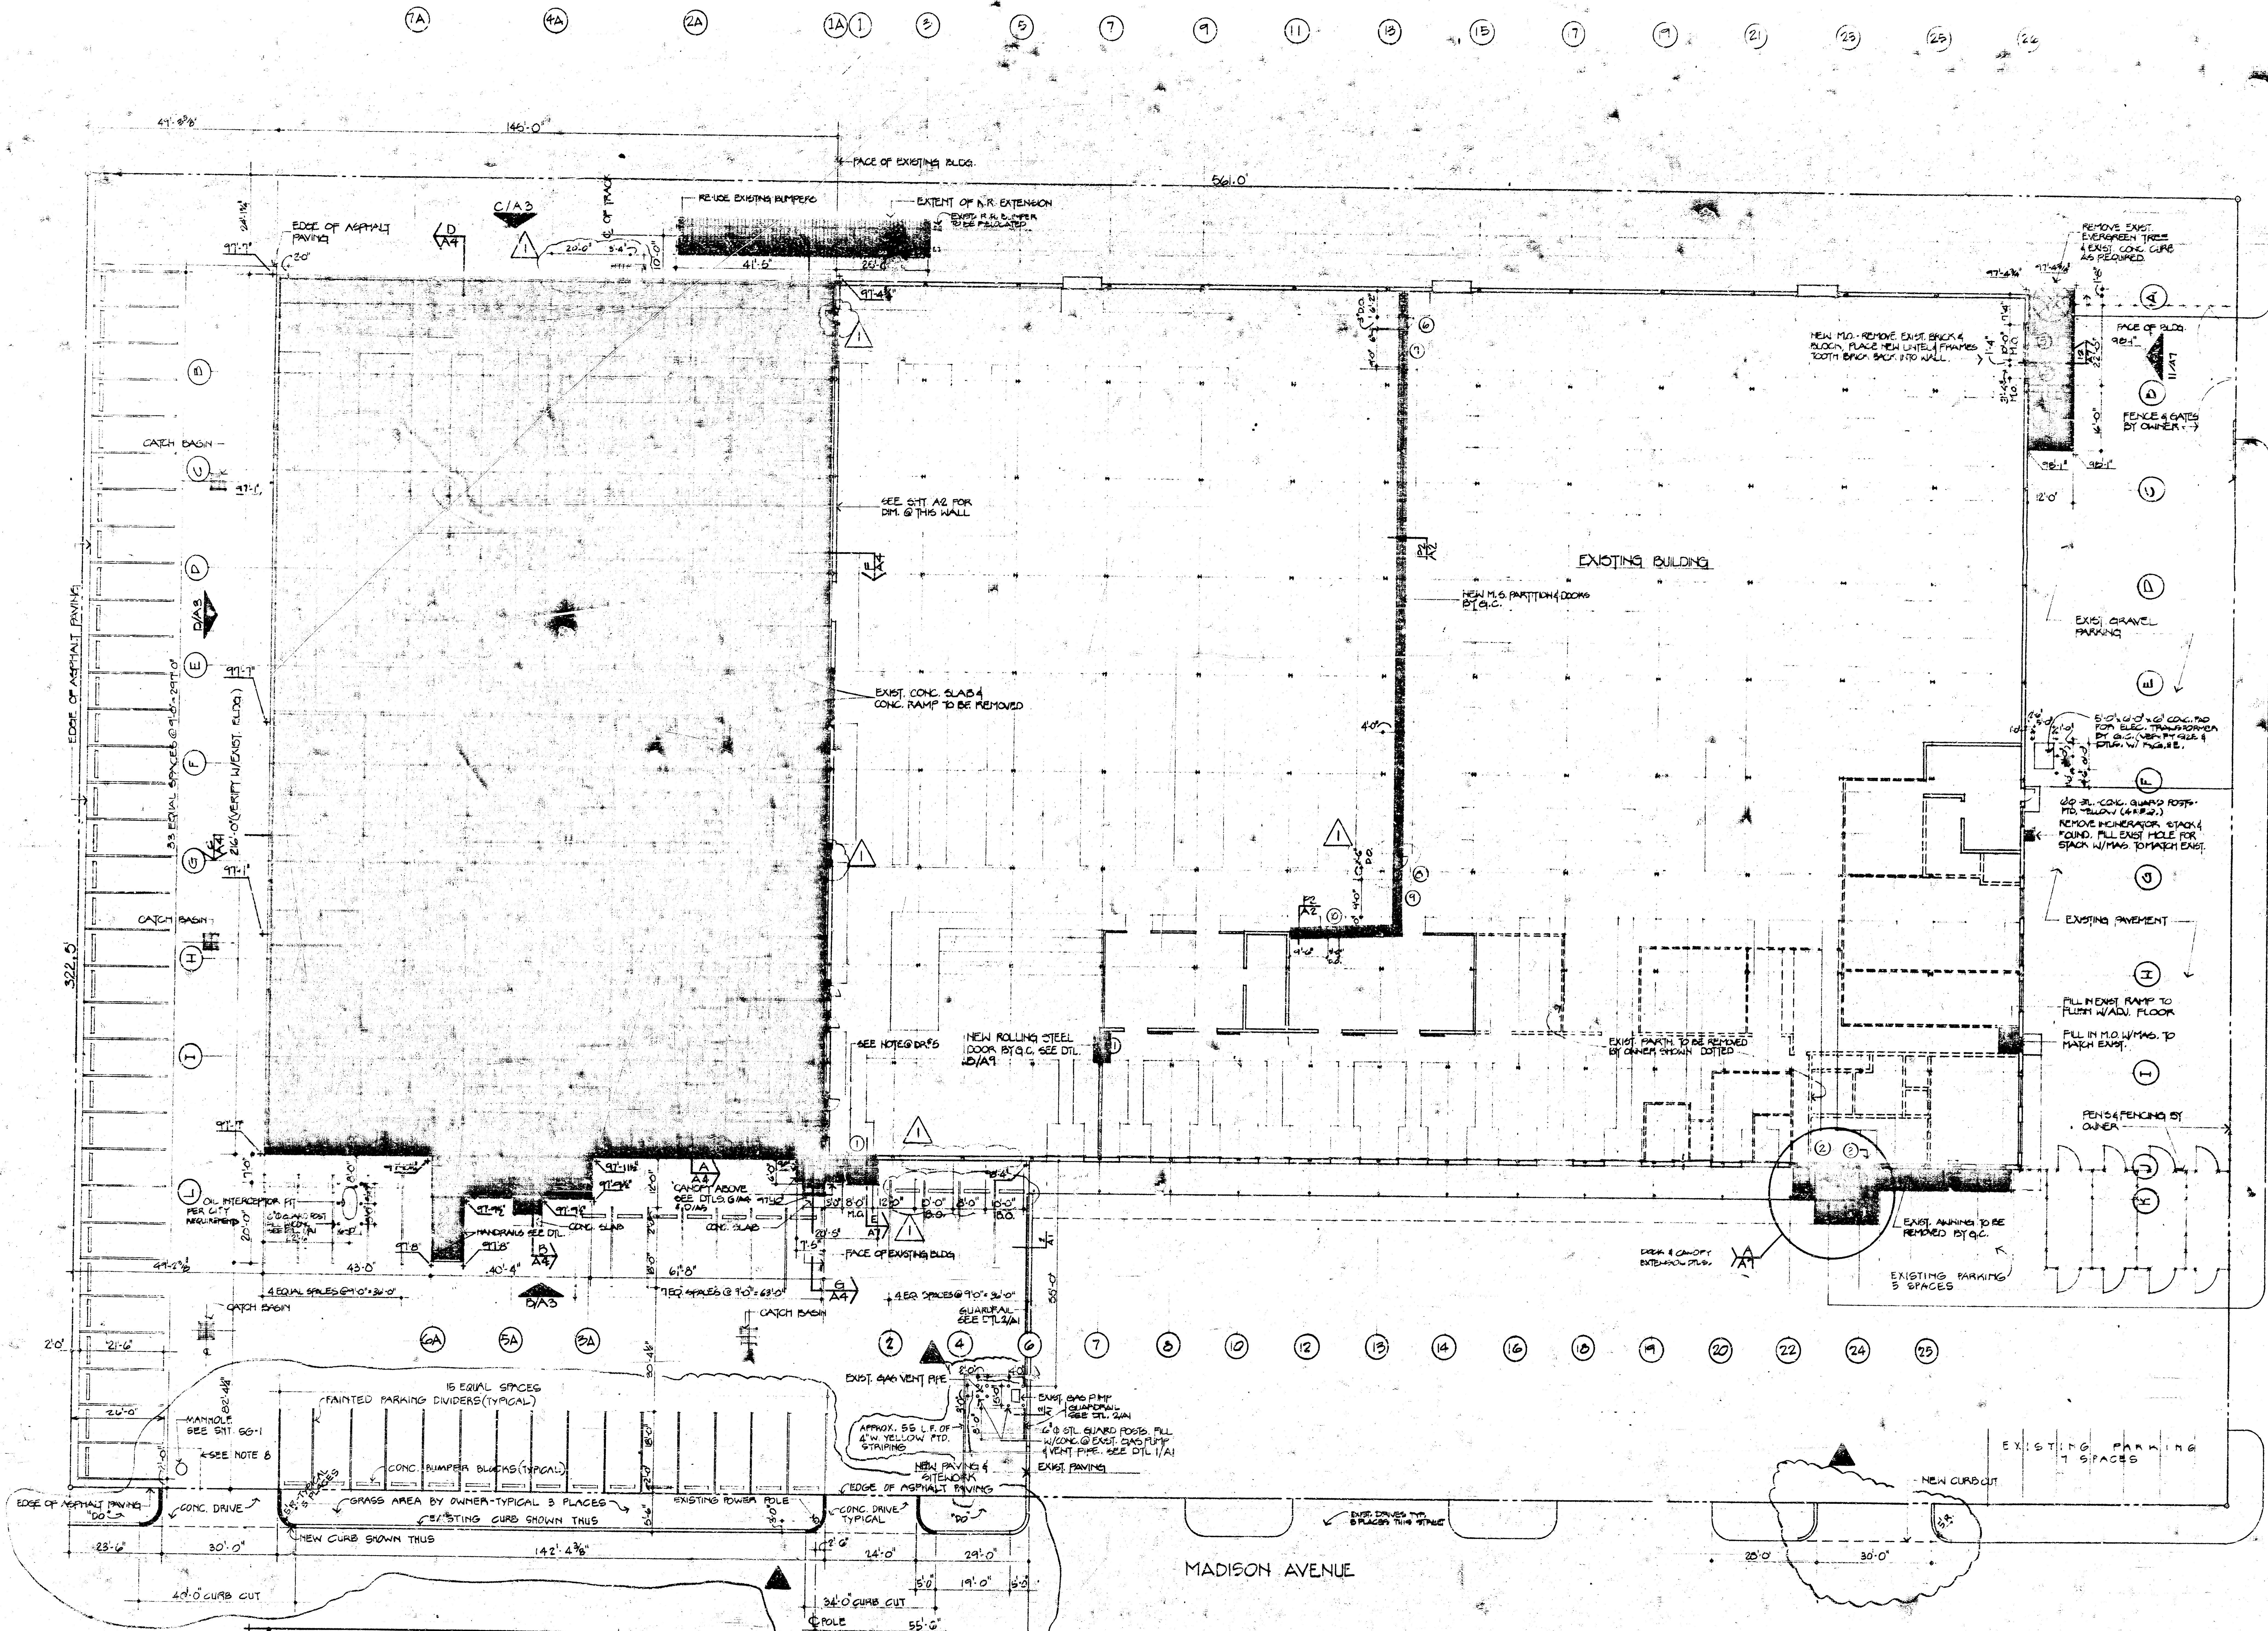


GENERAL NOTES

- 1. SHADED AREA INDICATES EXTENT OF NEW BLDG. CONST. & REMOVAL OF EXIST. BLDG. BY O.C.
- 2. EXIST. FENCE TO BE REMOVED & RELOCATED BY OWNER.

FOR CONSTRUCTION:

REVISIONS	
DATE	ITEM
7-6-74	PER O.C. & S.S. 200
10-1-74	REVISIONS TO 2000
	ADDED NOTE 18
	REMOVED CURB, SETBACK
	ADDED 15' SPACES @ 25'

B. J. KINGDON,
Architect
210 S. MARKET
WICHITA, KANSAS
(316) 262-2222

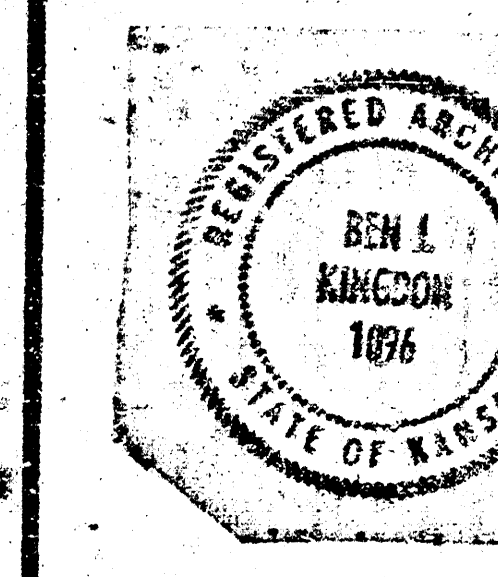

DRAWN	CHK
A/KW	REB

RELATED DRAWING

SHELL	
DETAILS	
STRUCTURE	
MECHANICAL	
ELECTRICAL	
OTHER	

SEQUENCE NUMBER
OF

SEARS ROEBUCK
WAREHOUSE ADD.
REMODEL
WICHITA, KANSAS
PROJECT NUMBER 74-0

KEY PLAN	

DATE

