


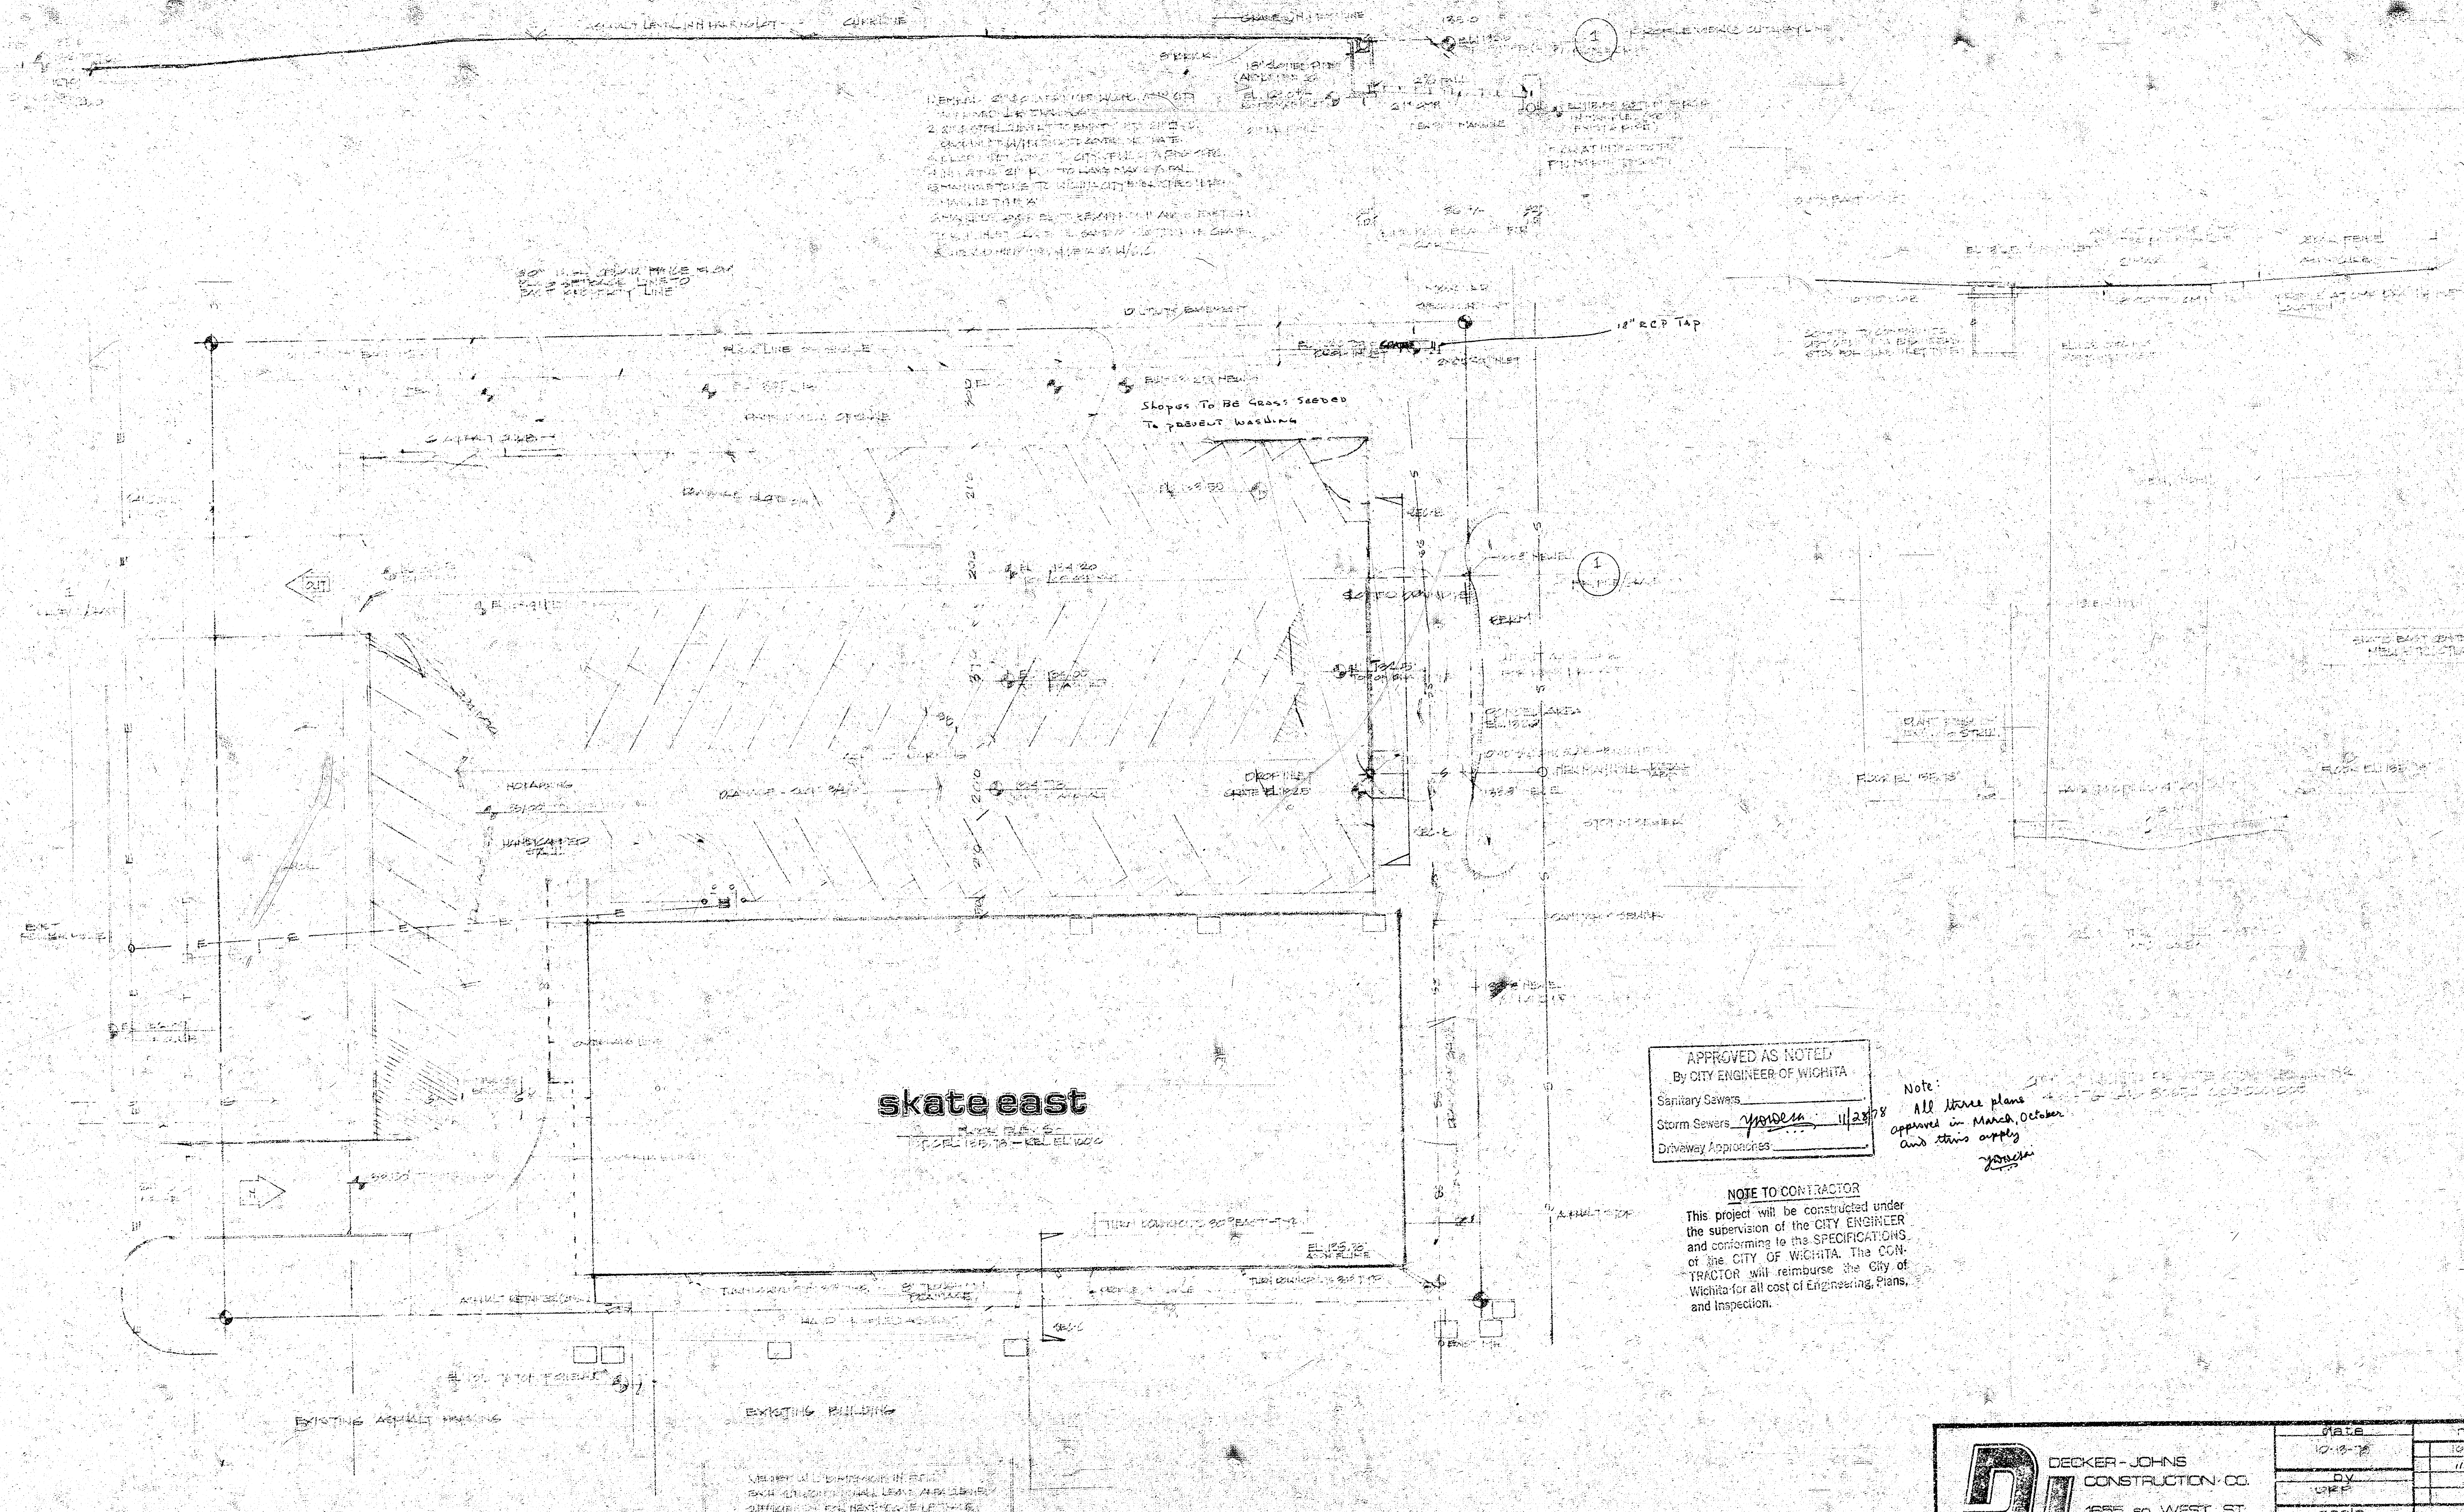

APPROVED AS NOTED
By CITY ENGINEER OF WICHITA
Sanitary Sewers _____
Storm Sewers Yoneda 11/28/78
Driveway Approaches _____


Note:
All three plans
approved in March, October,
and this copy
Yoneda

NOTE TO CONTRACTOR
This project will be constructed under the supervision of the CITY ENGINEER and conforming to the SPECIFICATIONS of the CITY OF WICHITA. The CONTRACTOR will reimburse the City of Wichita for all cost of Engineering, Plans, and Inspection.

DECKER - JOHNS
CONSTRUCTION CO.
1655 so WEST ST.
WICHITA, KS 67213
9439347

DATE		REVISED	
10-18-78		10-18-78	
BY		11-27-78	
CHK			
SCALE		sheet	
1"=20'		1/2	
APPROVED			
DR. RA.			

for: JIM WELLS - SKATE EAST - WICHITA

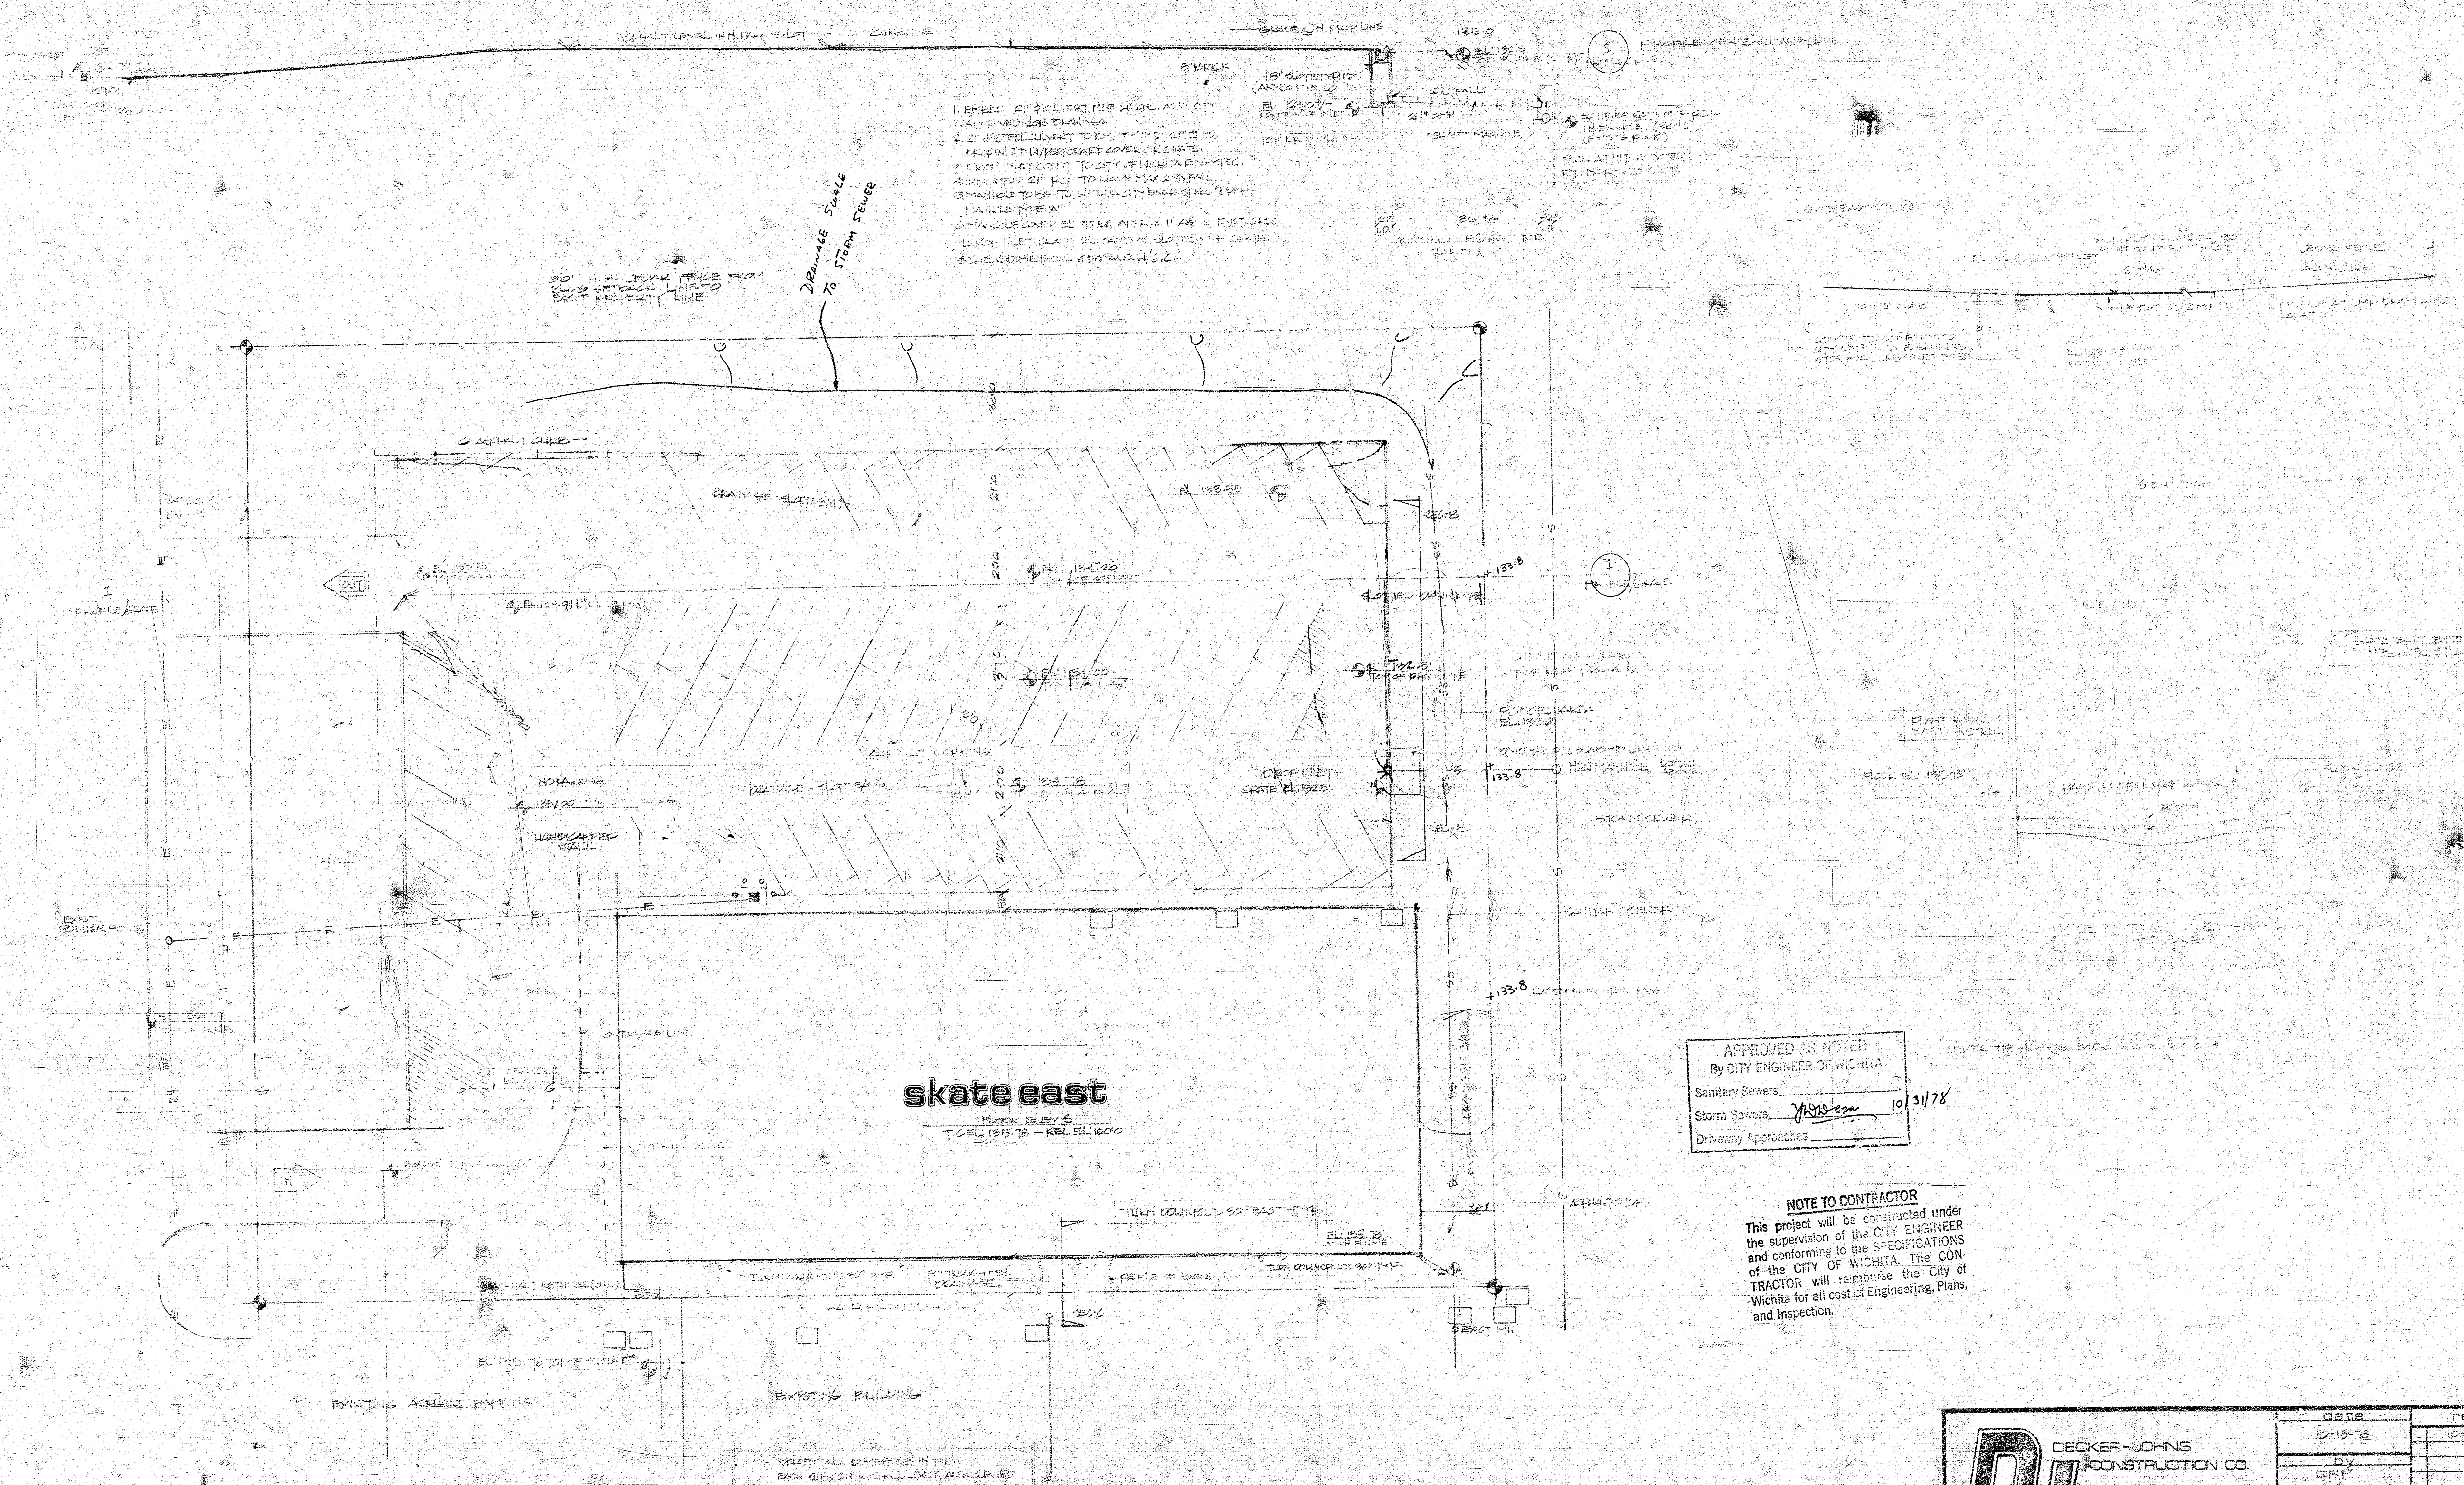

1. EREBIL SUBSTATION FOR WATER AND CITY
2. 24\"/>

APPROVED AS NOTED
By CITY ENGINEER OF WICHITA

Sanitary Sewers _____
Storm Sewers John 10/31/78
Driveway Approaches _____

NOTE TO CONTRACTOR
This project will be constructed under the supervision of the CITY ENGINEER and conforming to the SPECIFICATIONS of the CITY OF WICHITA. The CONTRACTOR will reimburse the City of Wichita for all cost of Engineering, Plans, and Inspection.

Drainage



**DECKER-JOHNS
CONSTRUCTION CO.**
1655 So. WEST ST.
WICHITA, KS. 67213
9439347

DATE		REVISION
12-18-78	by	10-18-78
1-1-79	by	
1-1-79	by	
Sheet

2/2

for: JIM WELLS - EXISTING - WICHITA