
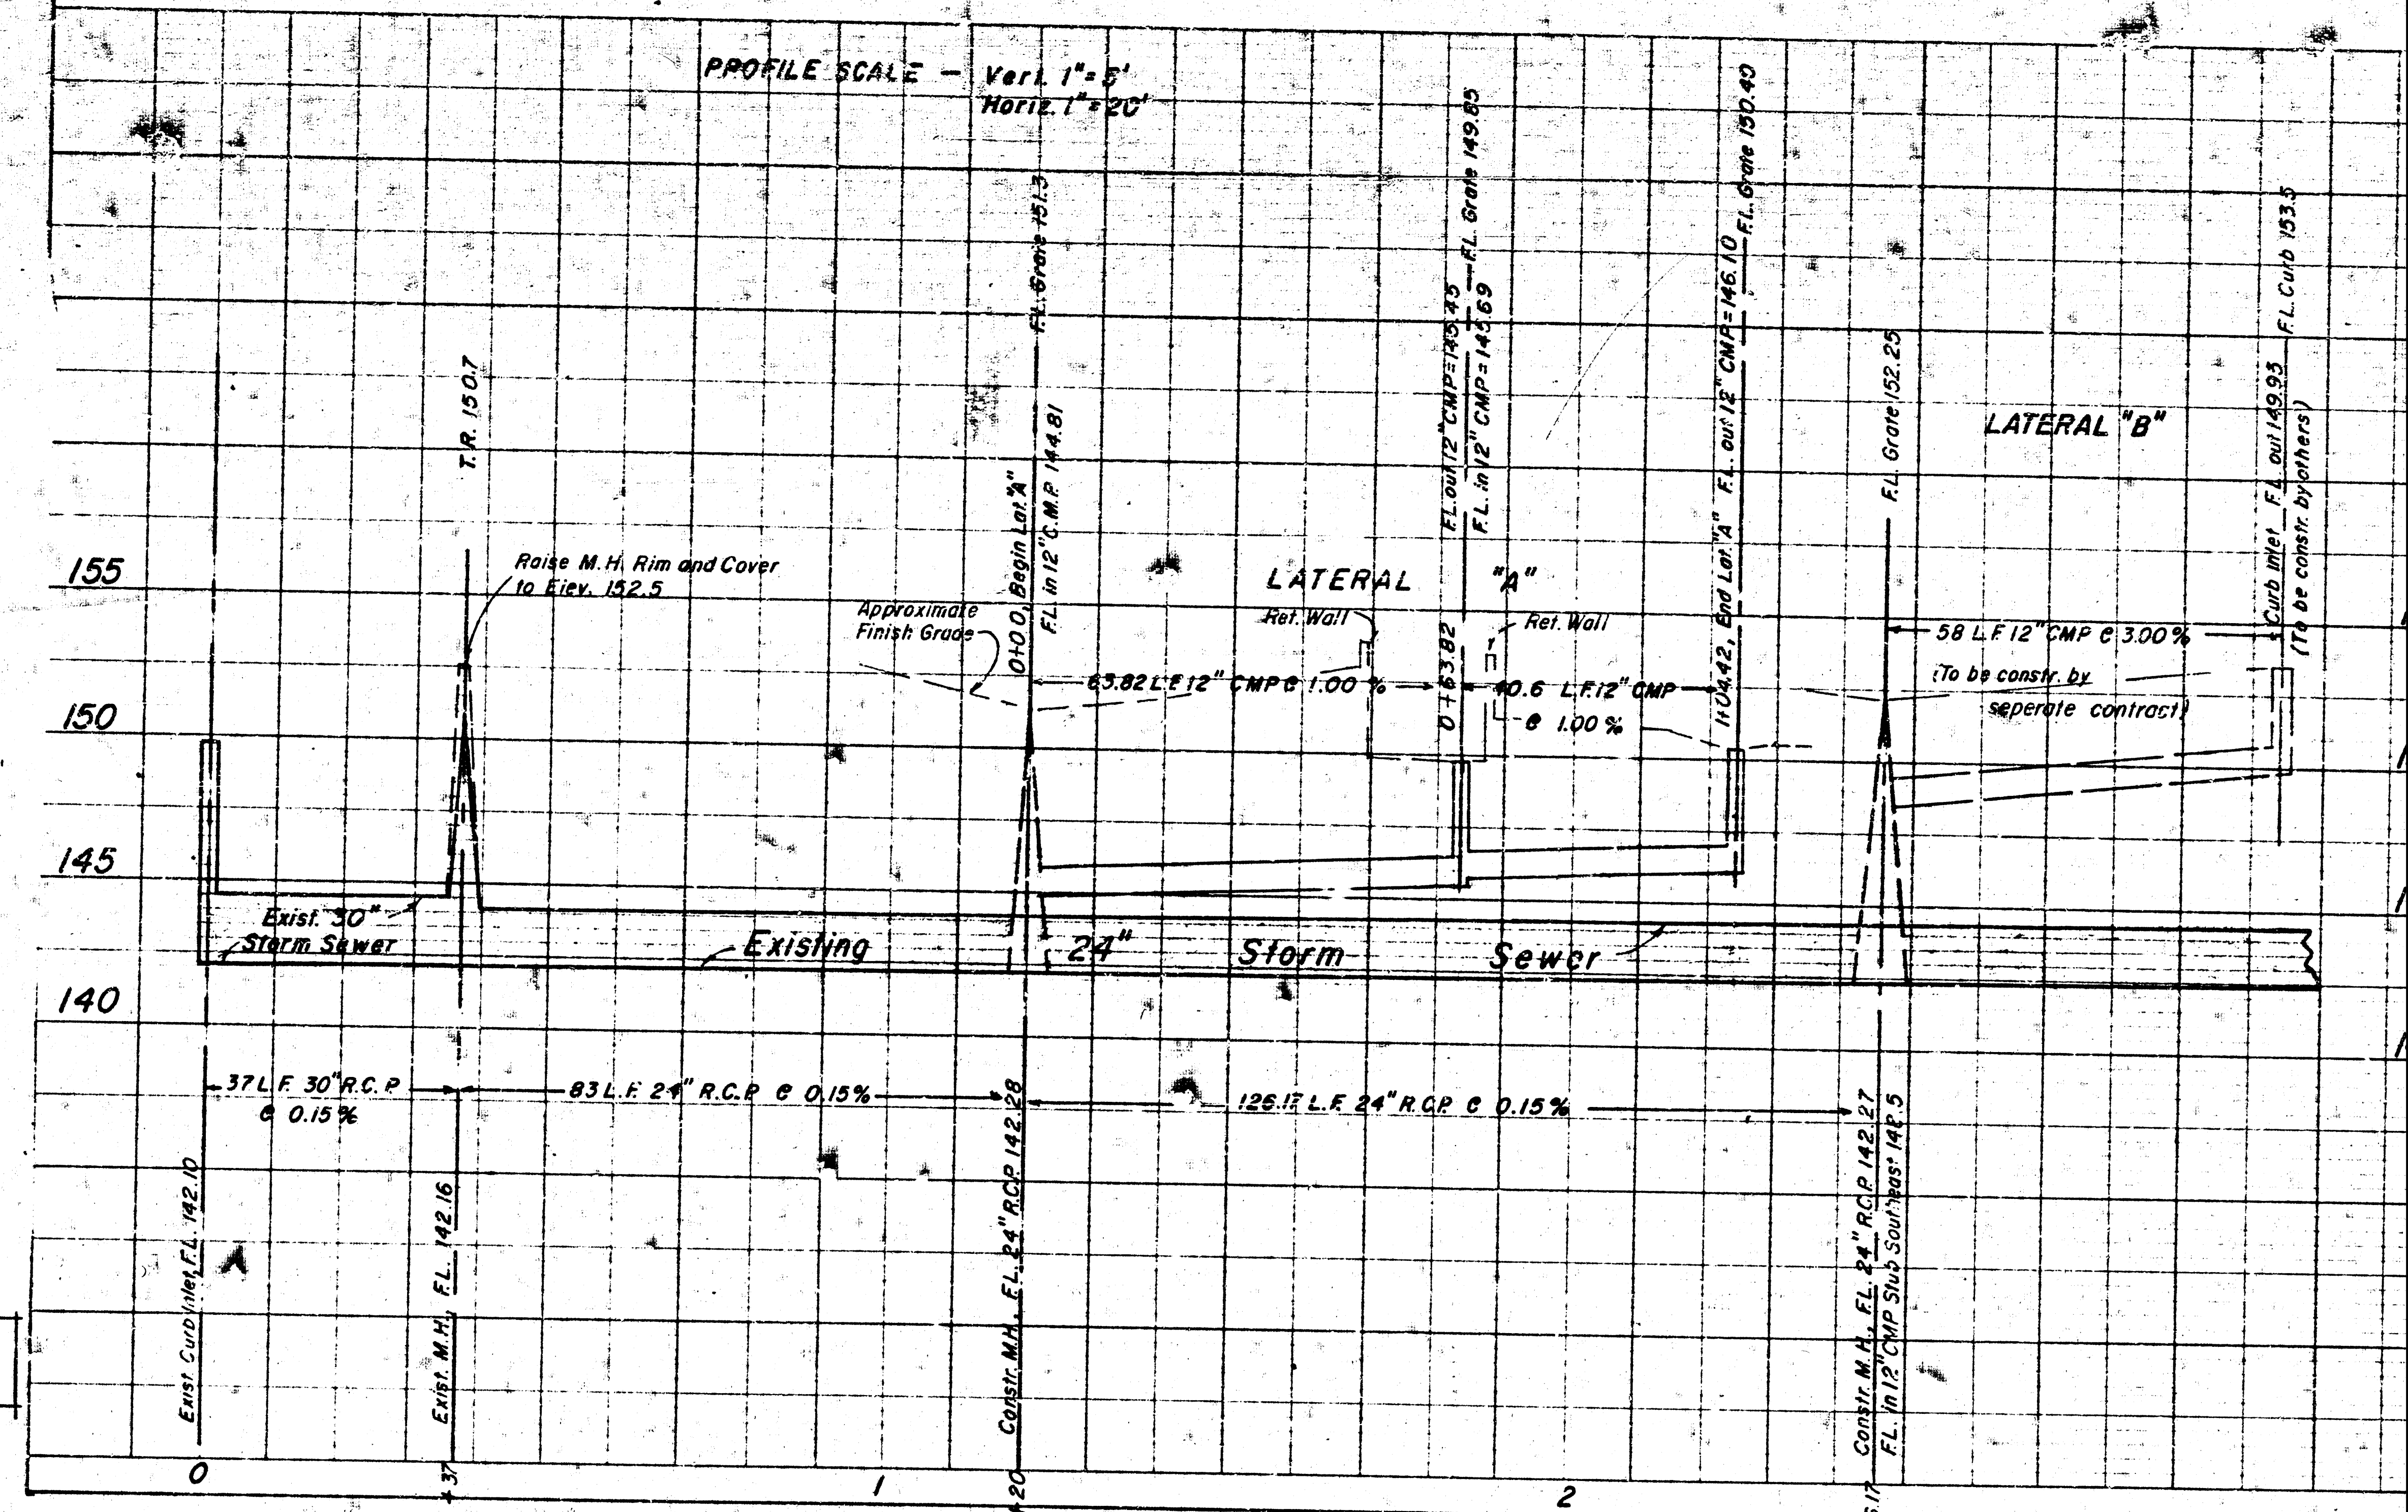


MURDOCK ST.

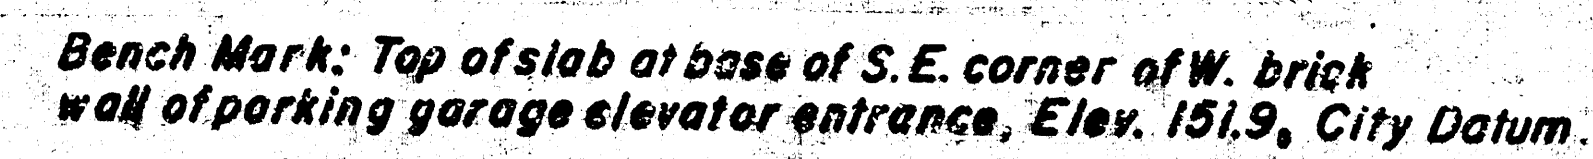

Approved By E. Schneider
Date 8-3-76


APPROVED AS NOTED
By **CITY ENGINEER OF WICHITA**


Sanitary Sewers _____
Storm Sewers 1. E. S. _____
Driveway Approaches _____

NOTE TO CONTRACTOR


This project will be constructed under the supervision of the CITY ENGINEER and conforming to the SPECIFICATIONS of the CITY OF WICHITA. The CONTRACTOR will reimburse the City of Wichita for all cost of ~~time and~~ ~~materials~~ and inspection.

**MOEHRING & ASSOCIATES
CONSULTING ENGINEERS
WICHITA**

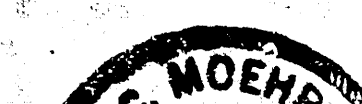

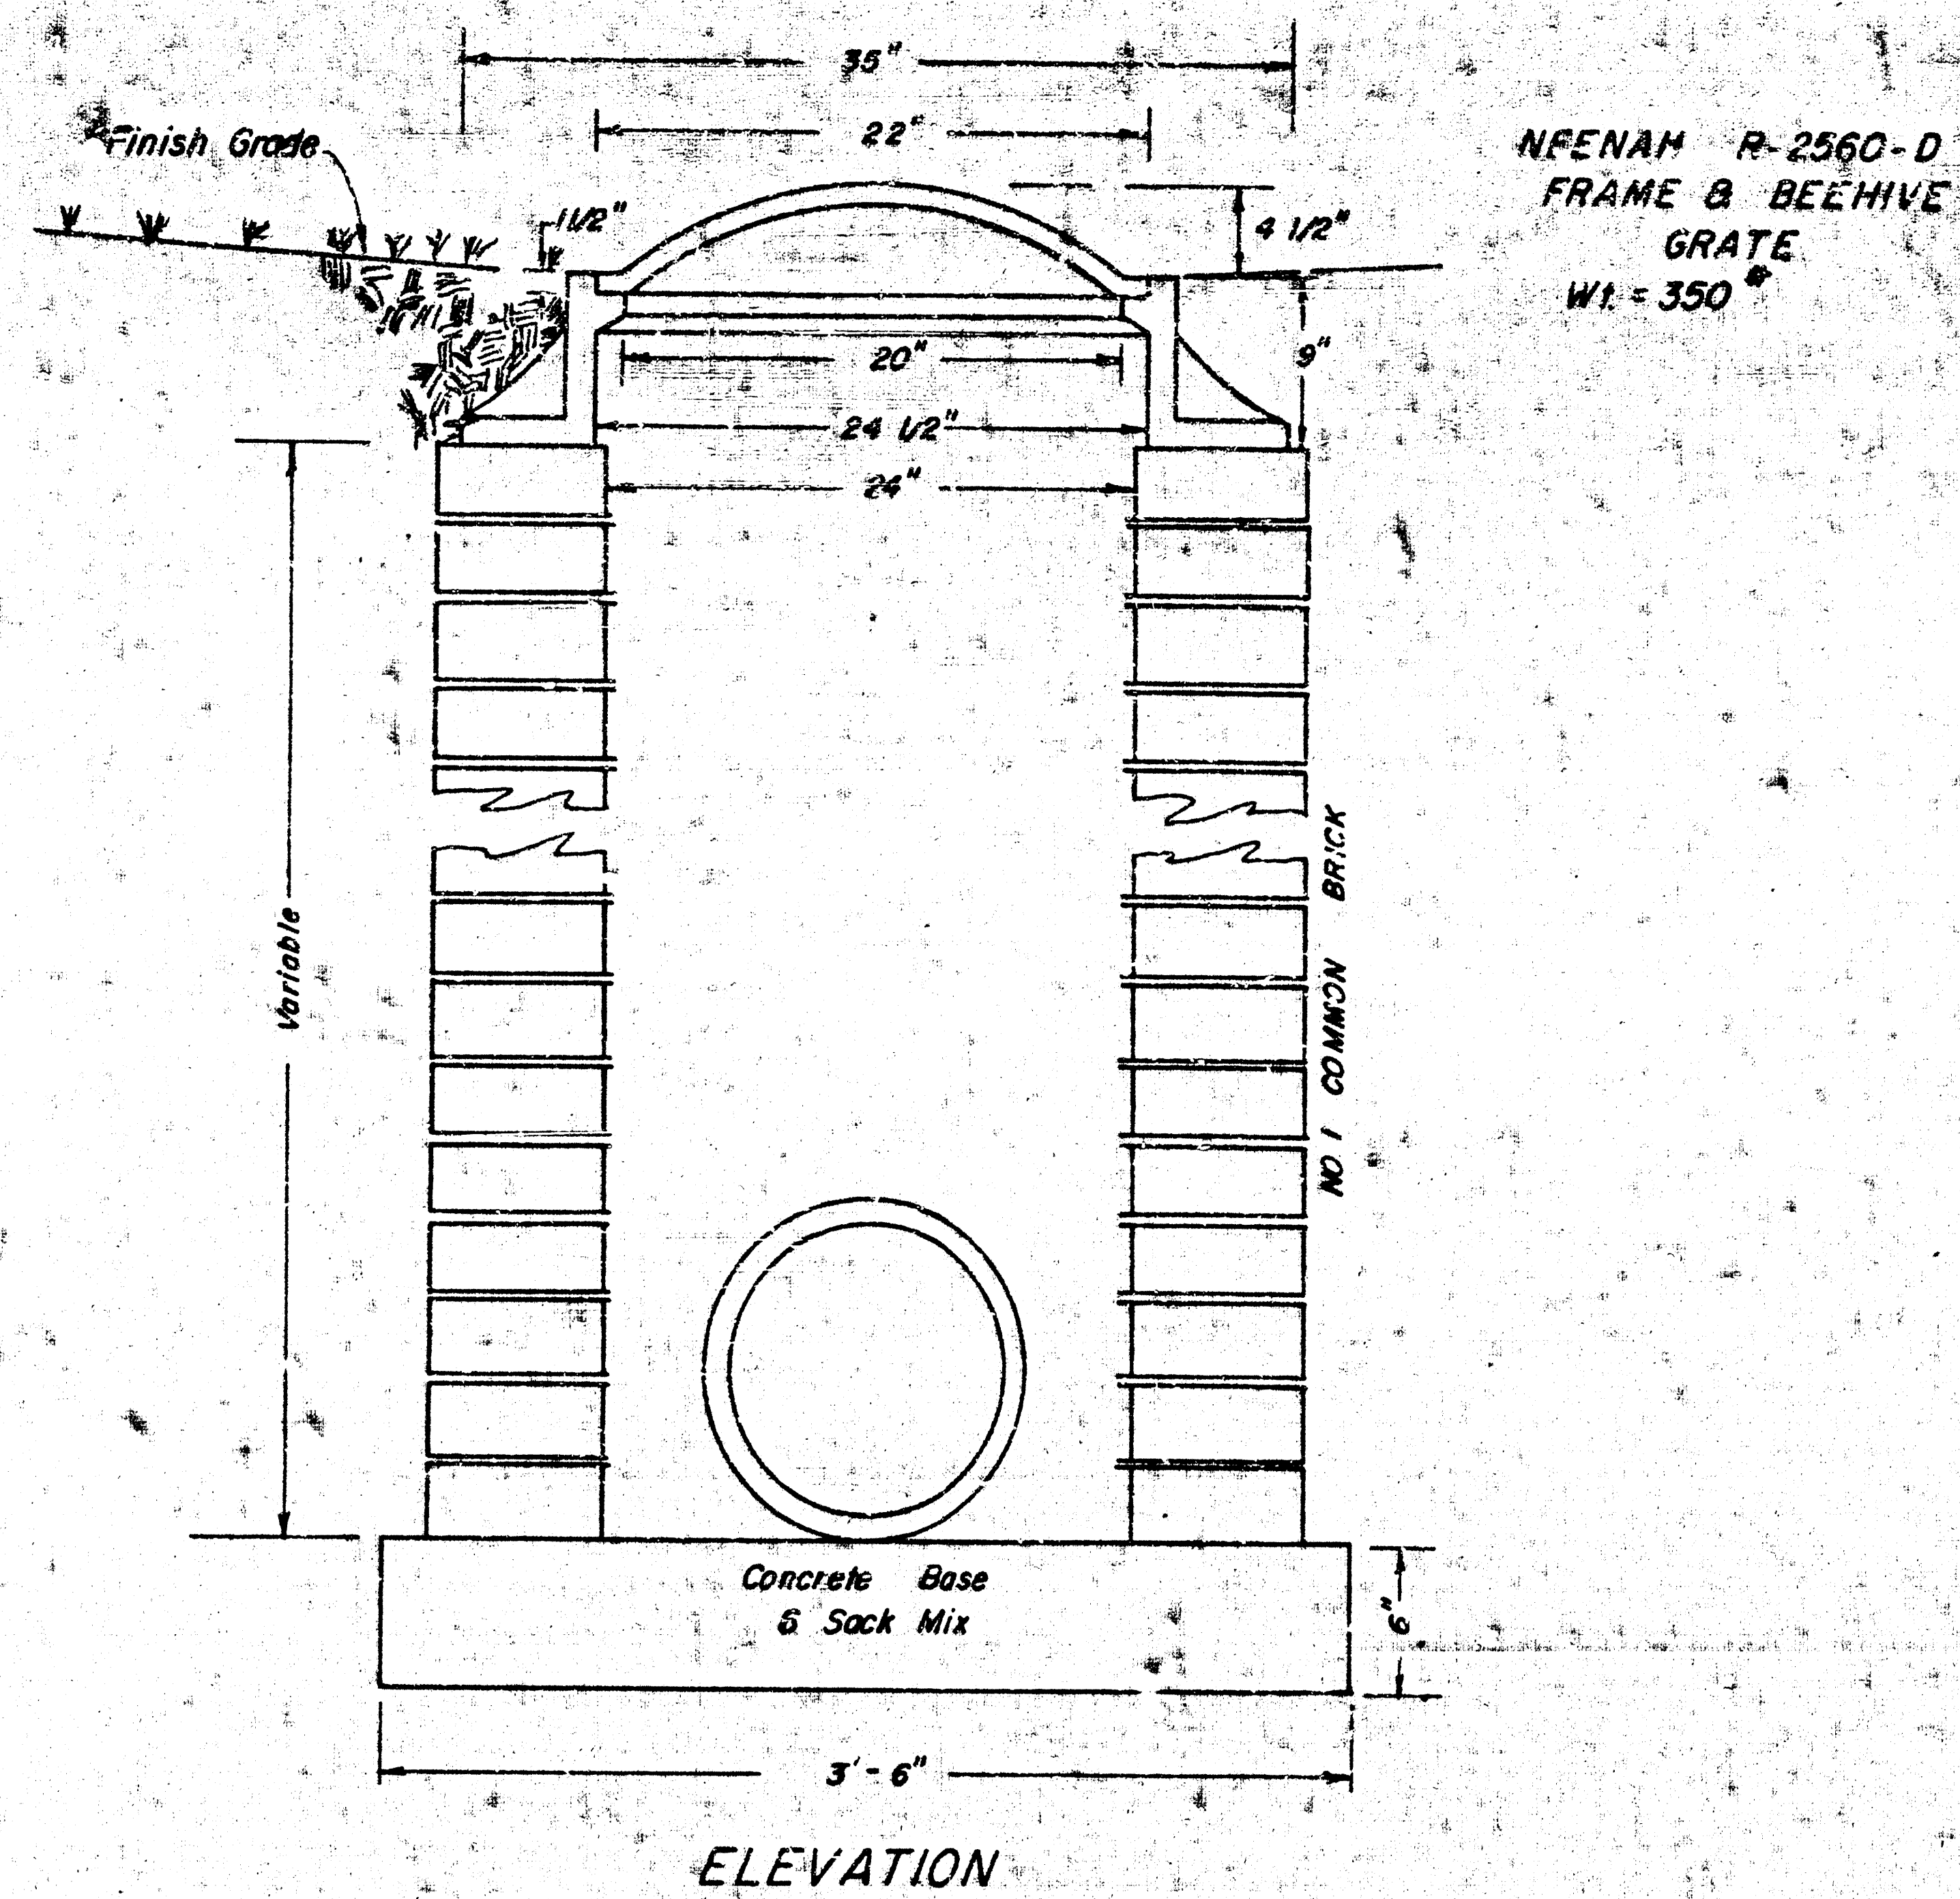

2' x 2' BRICK DROP INLET
WITH BEEHIVE GRATE

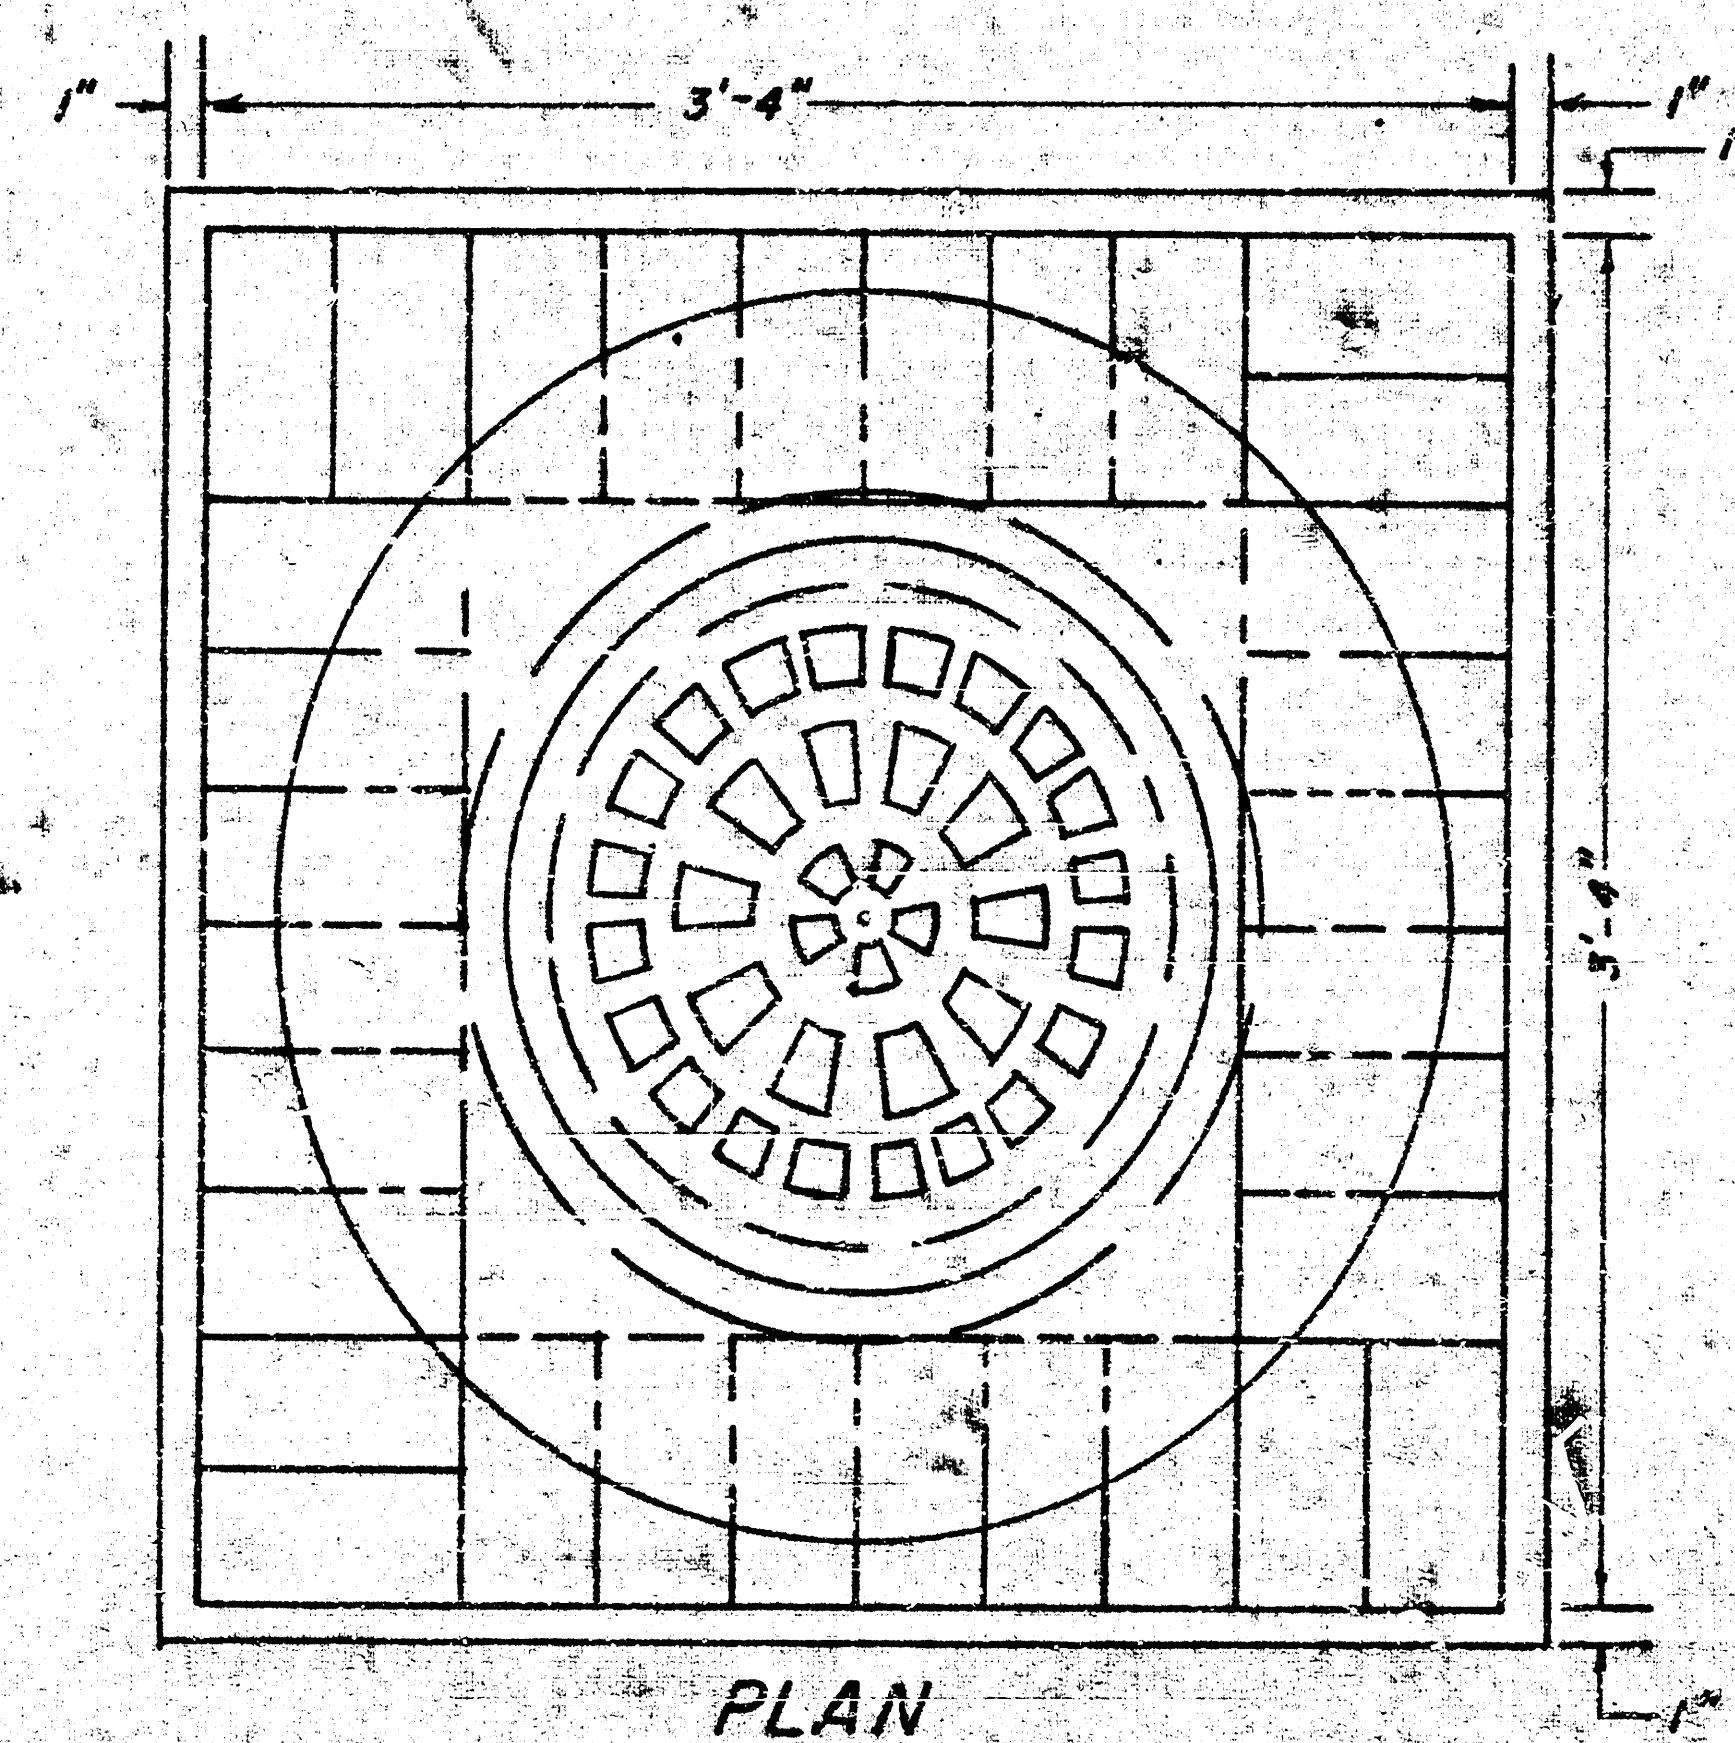

MOEHRING & ASSOCIATES
314 Brown Bldg.

CONSULTING ENGINEERS
Wichita, Kansas