


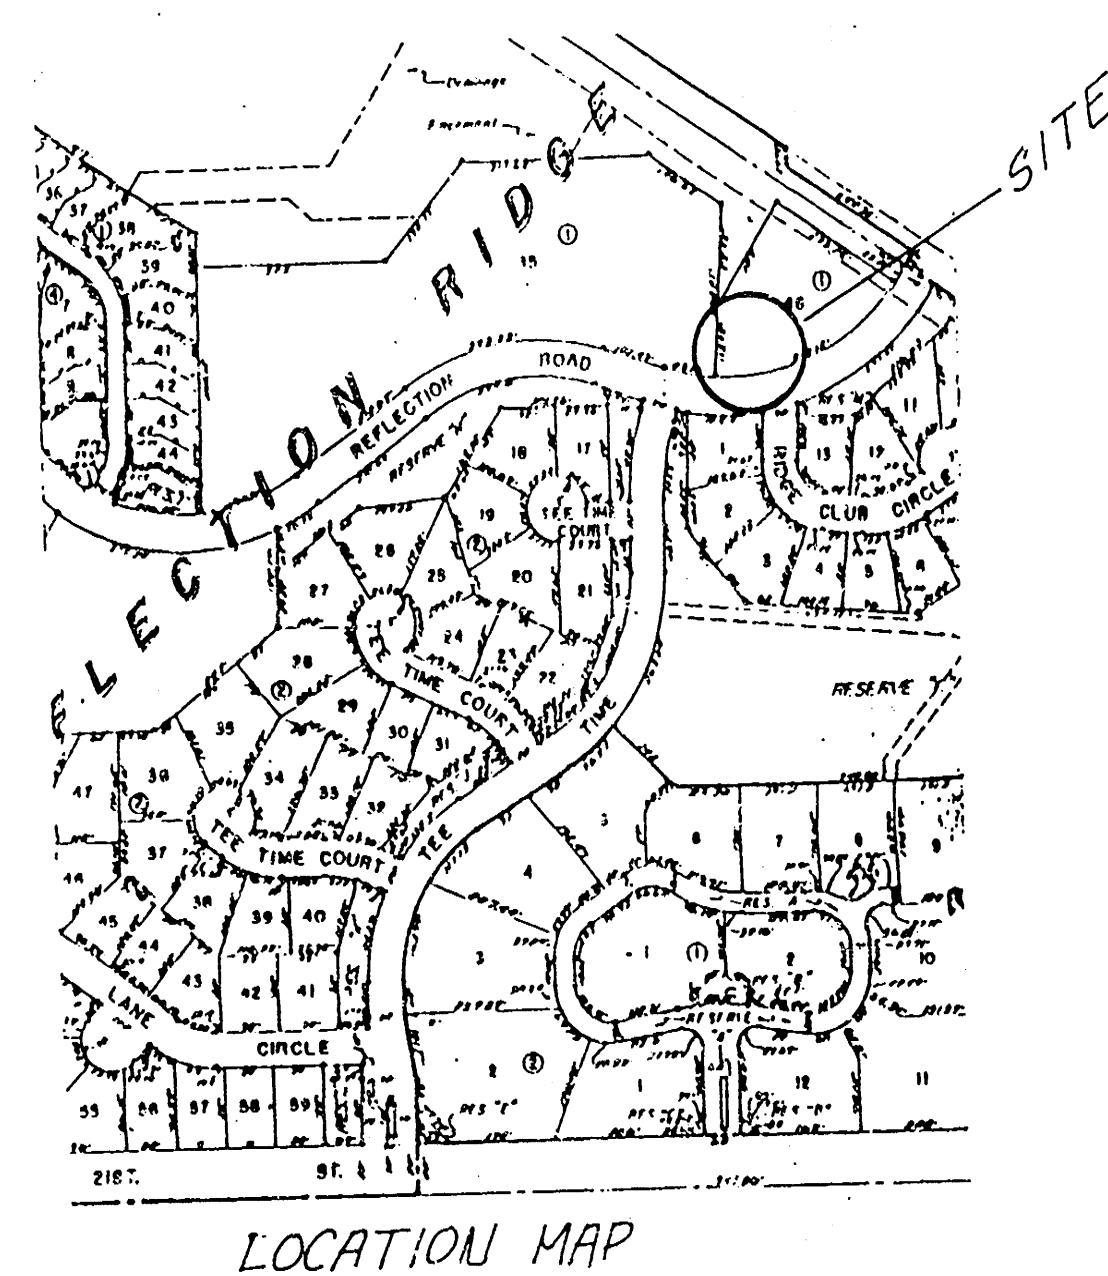

8" San. Sewer

REFLECTION ROAD

10' x 20' Utility Esm't.

Baseline = @ 10' Private Esm't.

126.02'

12'

28'00"

33.6'

Proposed Parking Lot Curb

LOT 46

LOT 45

Station 0+00 = @ Existing Type 1A Curb Inlet, Top elev. 143.19

Station 2+46.5 Construct Type 1A Curb Inlet, L = 6'-4", W = 4'-4", Top Elev. = 149.90


Asphalt Golf Cart Path

E. line Lot 45, Block 1

N

1" = 20'

Booked
MCG
D-117

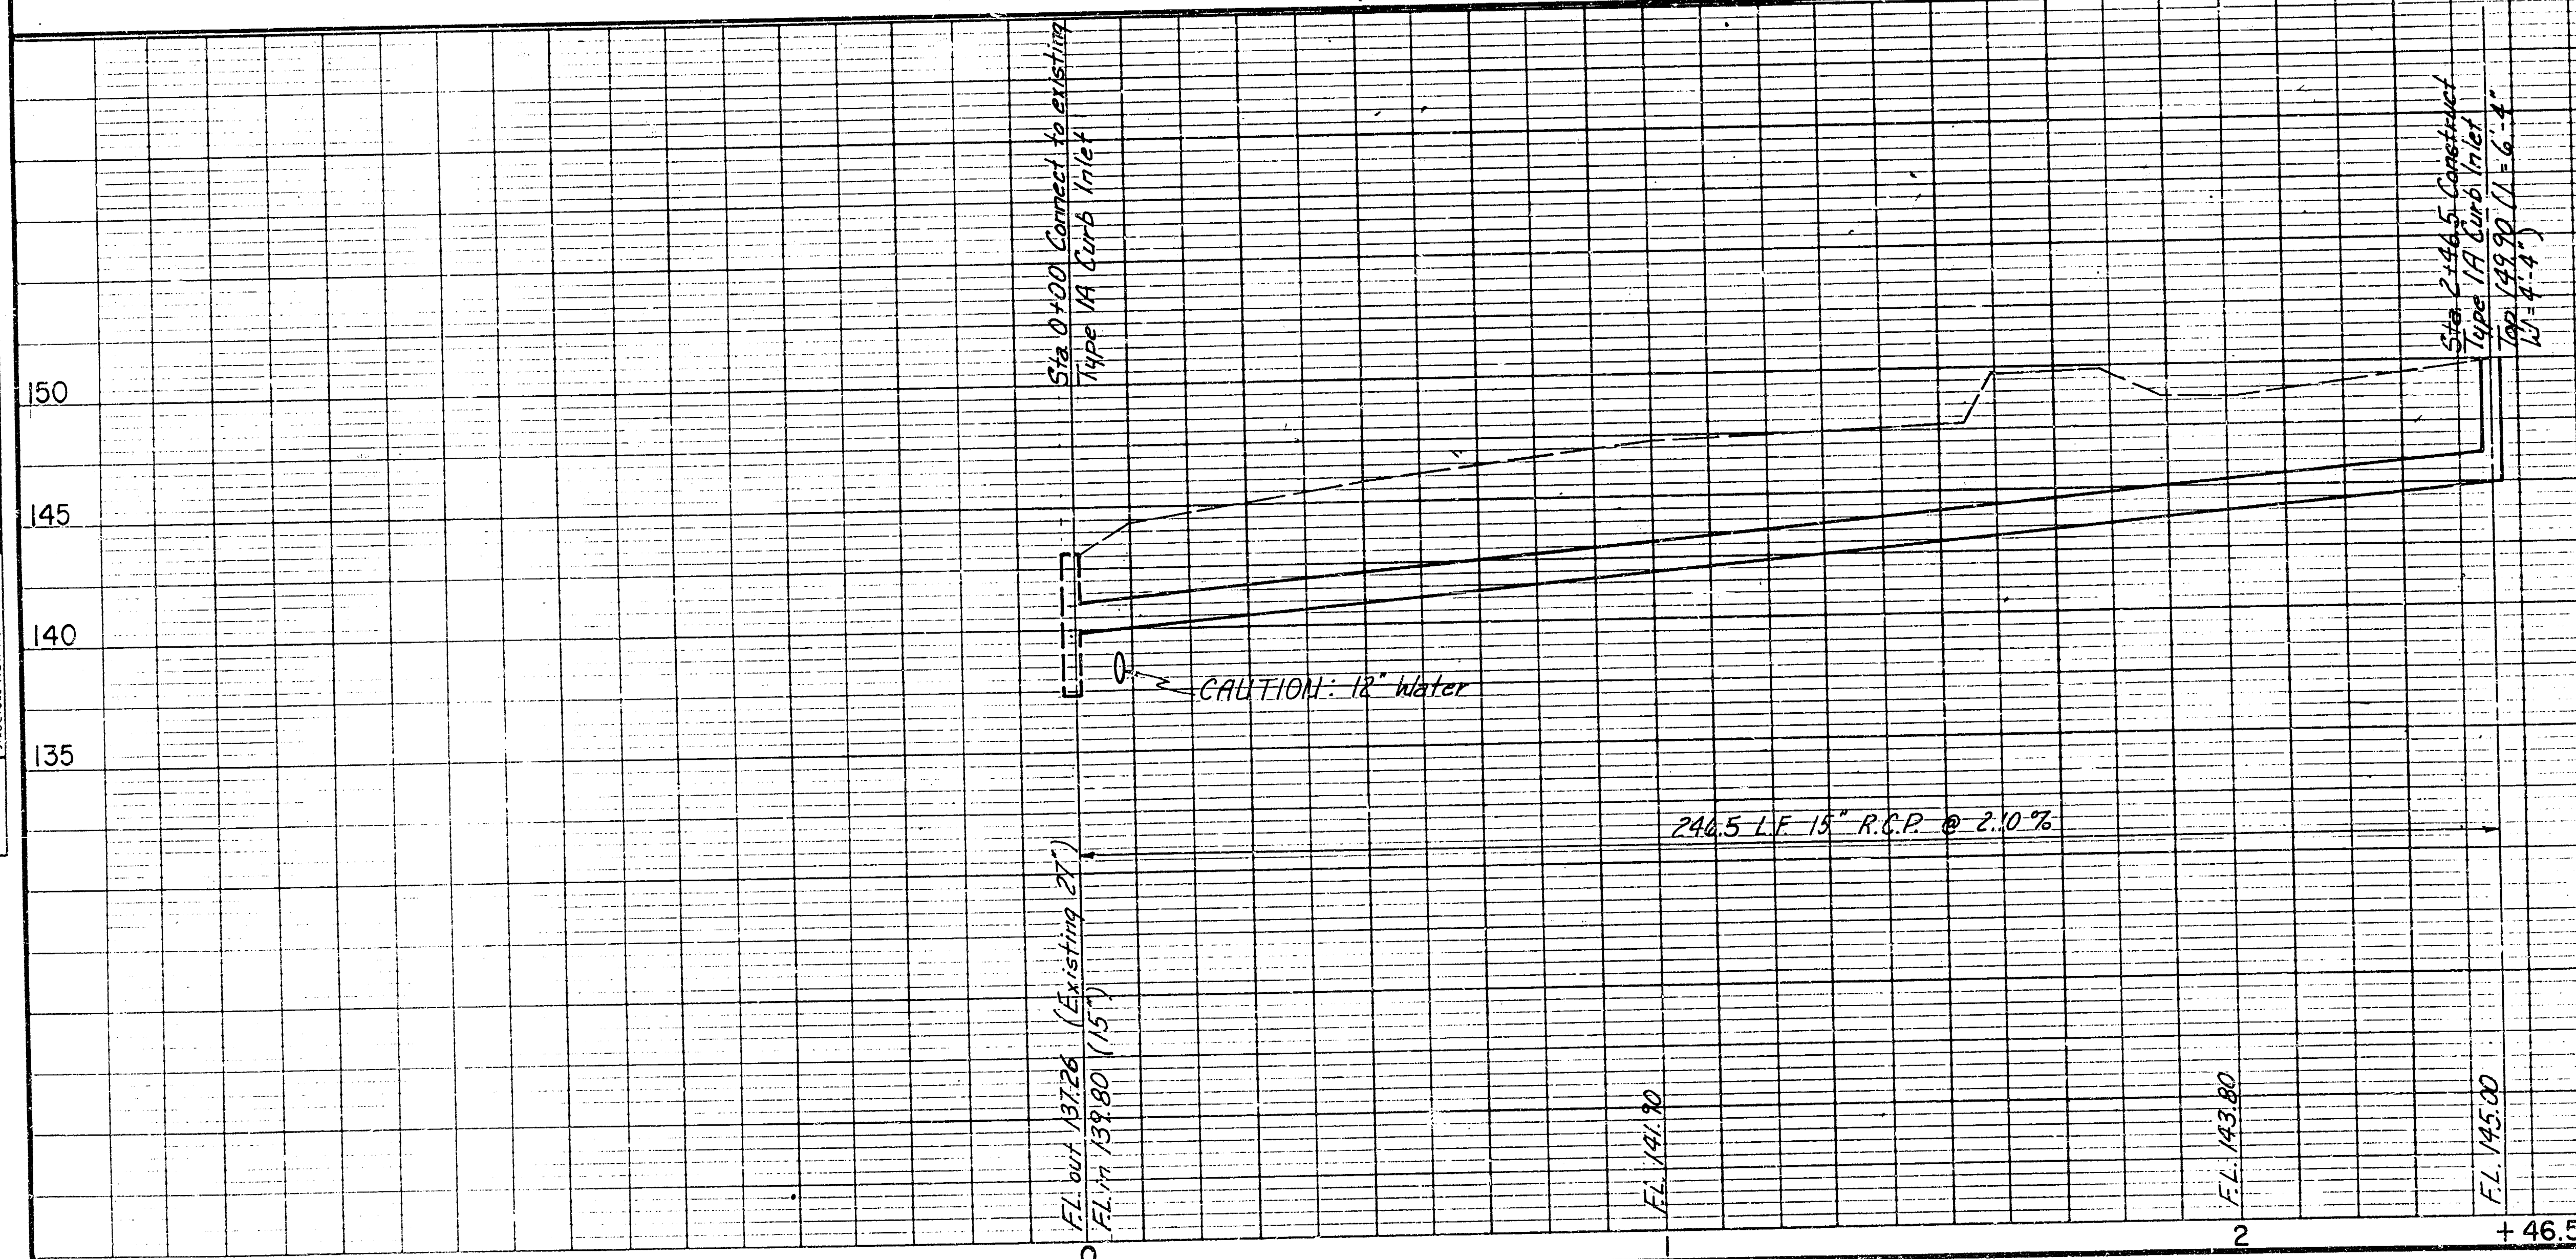

PROFILE SCALE
1" = 20' Horz.
1" = 5' Vert.


APPROVED AS NOTED
BY CITY ENGINEER OF WICHITA

Sanitary Sewers _____
Storm Sewers 276 3/5/6
Driveway Approaches _____
Water Mains _____
Paving _____

NOTE-TO-CONTRACTOR

INSPECTION AND TESTING FOR THIS PROJECT IS TO BE PROVIDED BY A LICENSED CONSULTING ENGINEERING FIRM UNDER CONTRACT WITH THE OWNER/DEVELOPER. SAID INSPECTION TO BE IN ACCORDANCE WITH THE CITY OF WICHITA STANDARD CONSTRUCTION ENGINEERING PRACTICES AND CERTIFIED BY A LICENSED PROFESSIONAL ENGINEER. NO WORK SHALL BE PERFORMED IN DEDICATED EASEMENTS OR PUBLIC RIGHT-OF-WAY BY THE CONTRACTOR WITHOUT SUCH INSPECTION NOR SHALL ANY WORK BE COMMENCED WITHOUT WRITTEN AUTHORIZATION BY THE CITY ENGINEER.

Revised easement 7-28-65

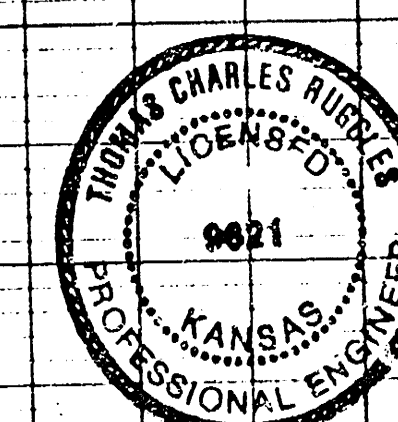

PRIVATE STORM WATER SEWER
REFLECTION RIDGE CLUBHOUSE
WICHITA, KANSAS
INDEX CODE: 220PPS 607853

INDEX CODE: 220FFS 007000
BAUGHMAN COMPANY, P.A

BROTHMAN & ASSOCIATES
SURVEYING & ENGINEERING
1000 WEST 10TH AVENUE, SUITE 1000, DENVER, CO 80202
(303) 733-1111


316/262-7271 • 315 ELLIS • WICHITA, KANSAS 67211

Design:	Drawn:	Approved:	Date:
TCB	DSN		7-6-89 1" = 20'




101	102	103	200
-----	-----	
[illegible]

Ind-4 Code: 220 PPS 607853

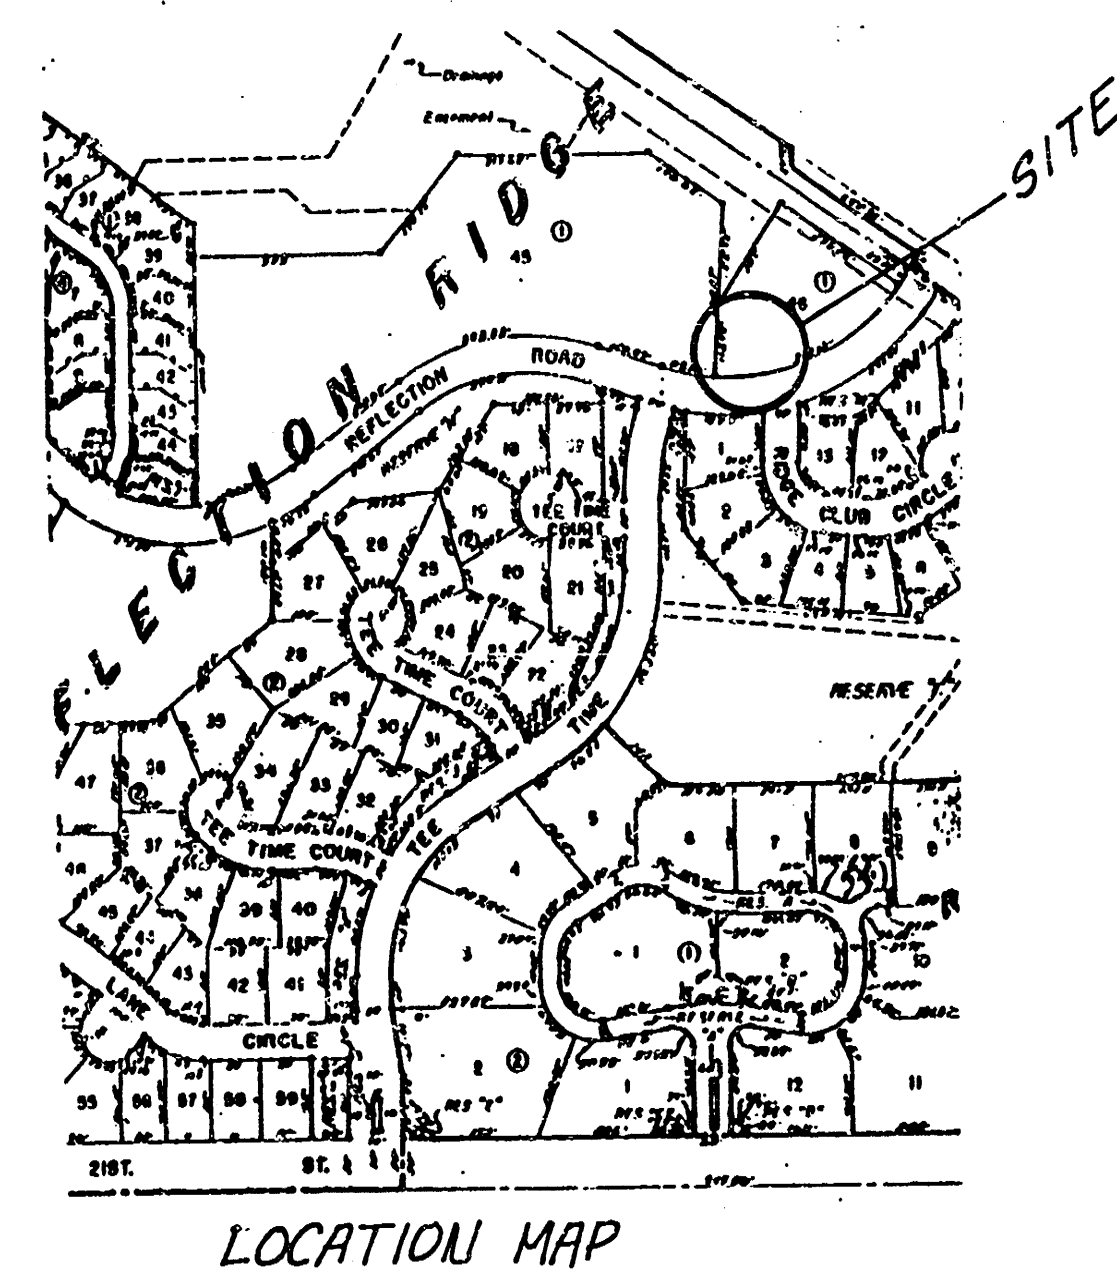

Bench Mark:
Chiseled "H" Cut Top of Curb
West of inlet
Elev. = 143.15

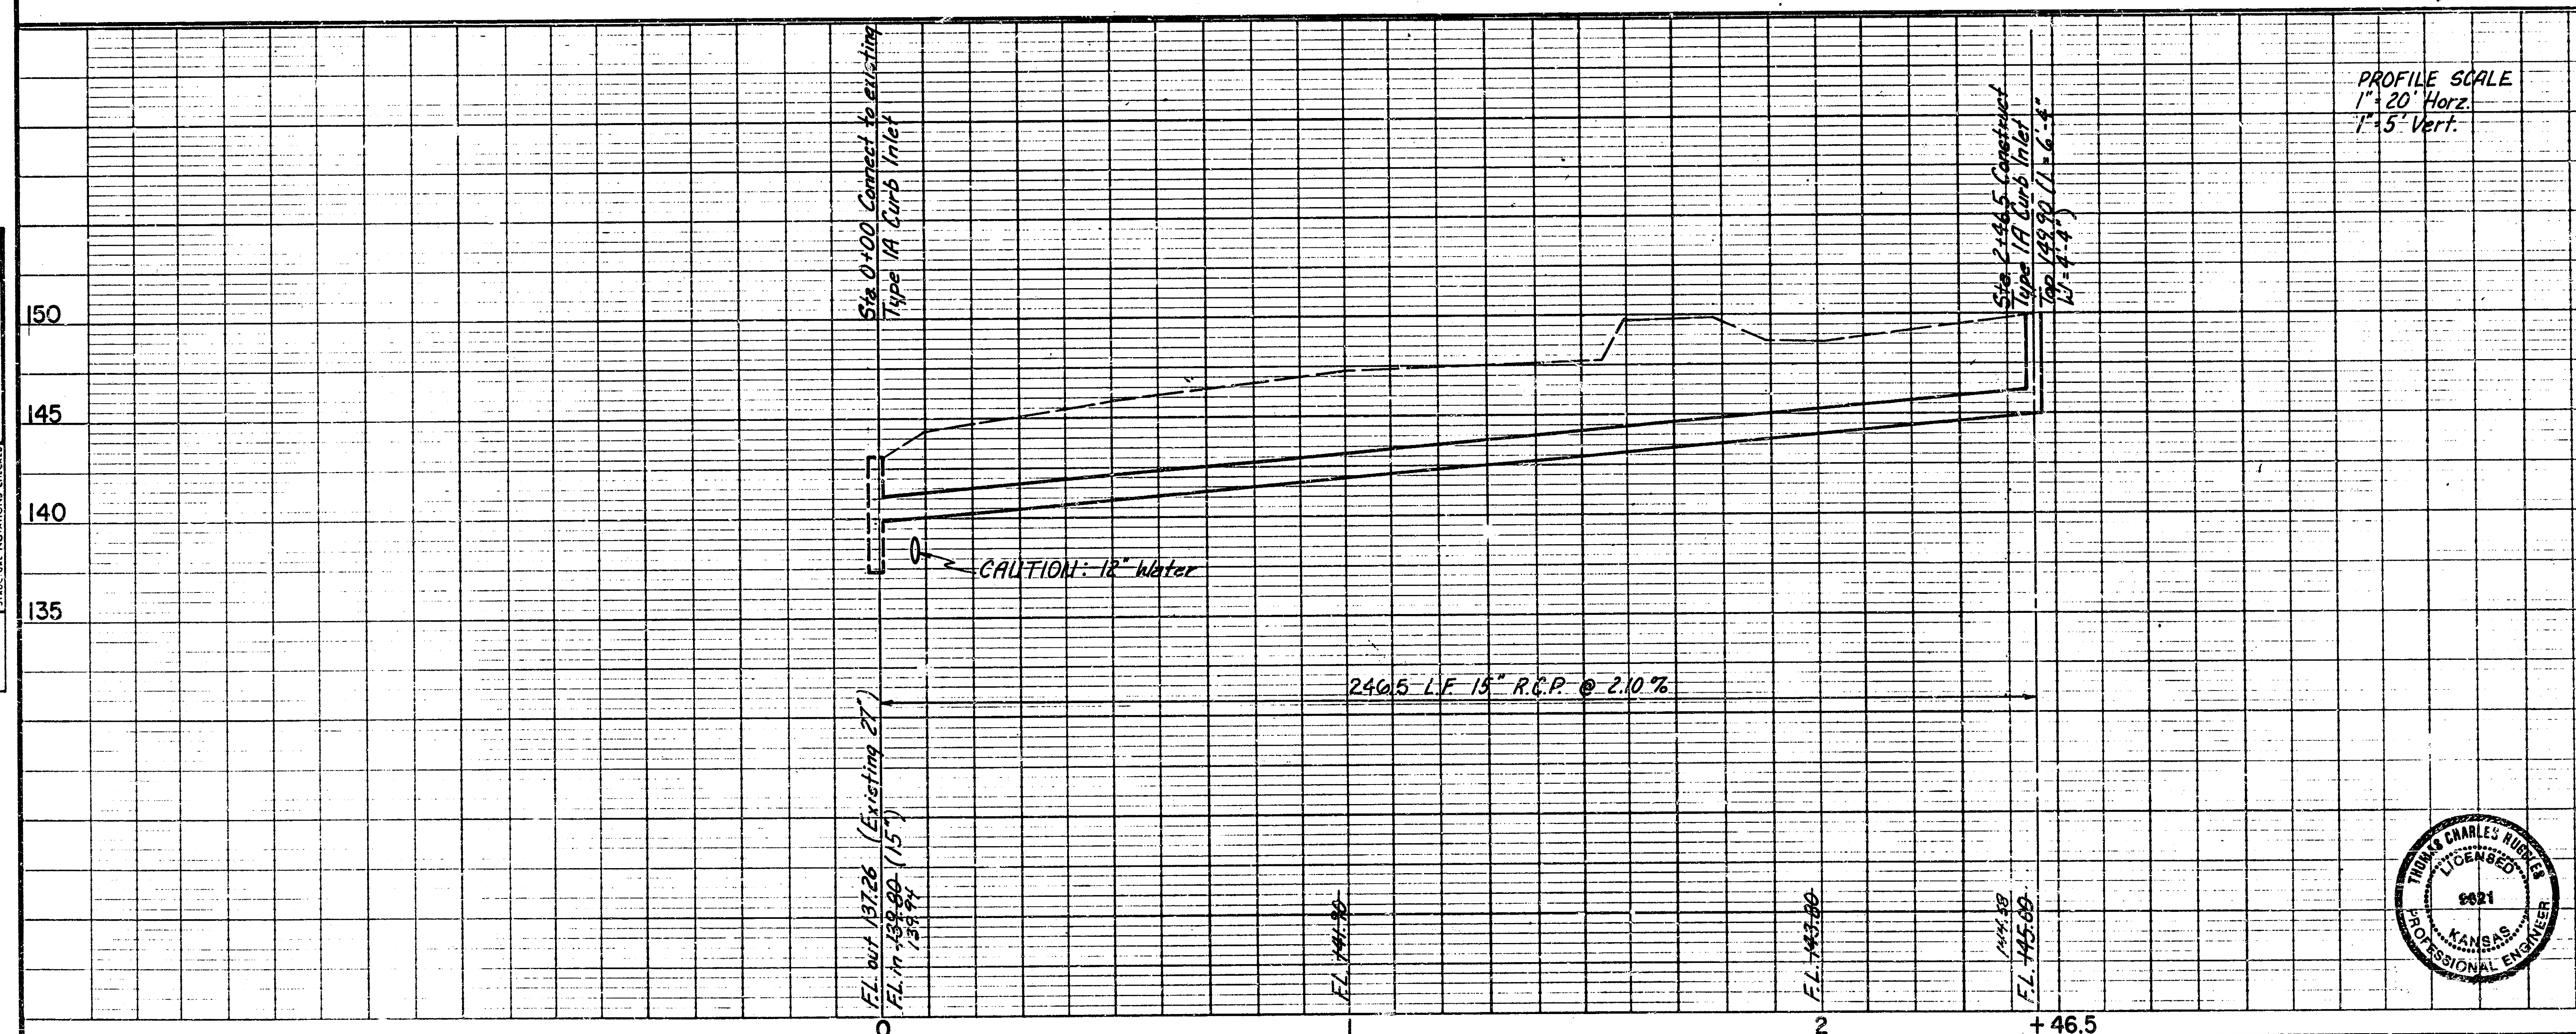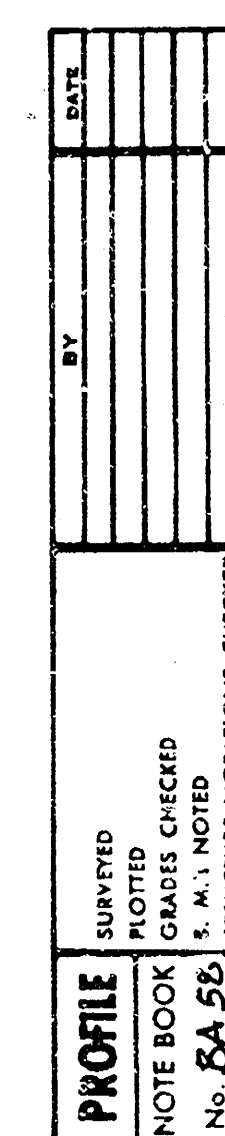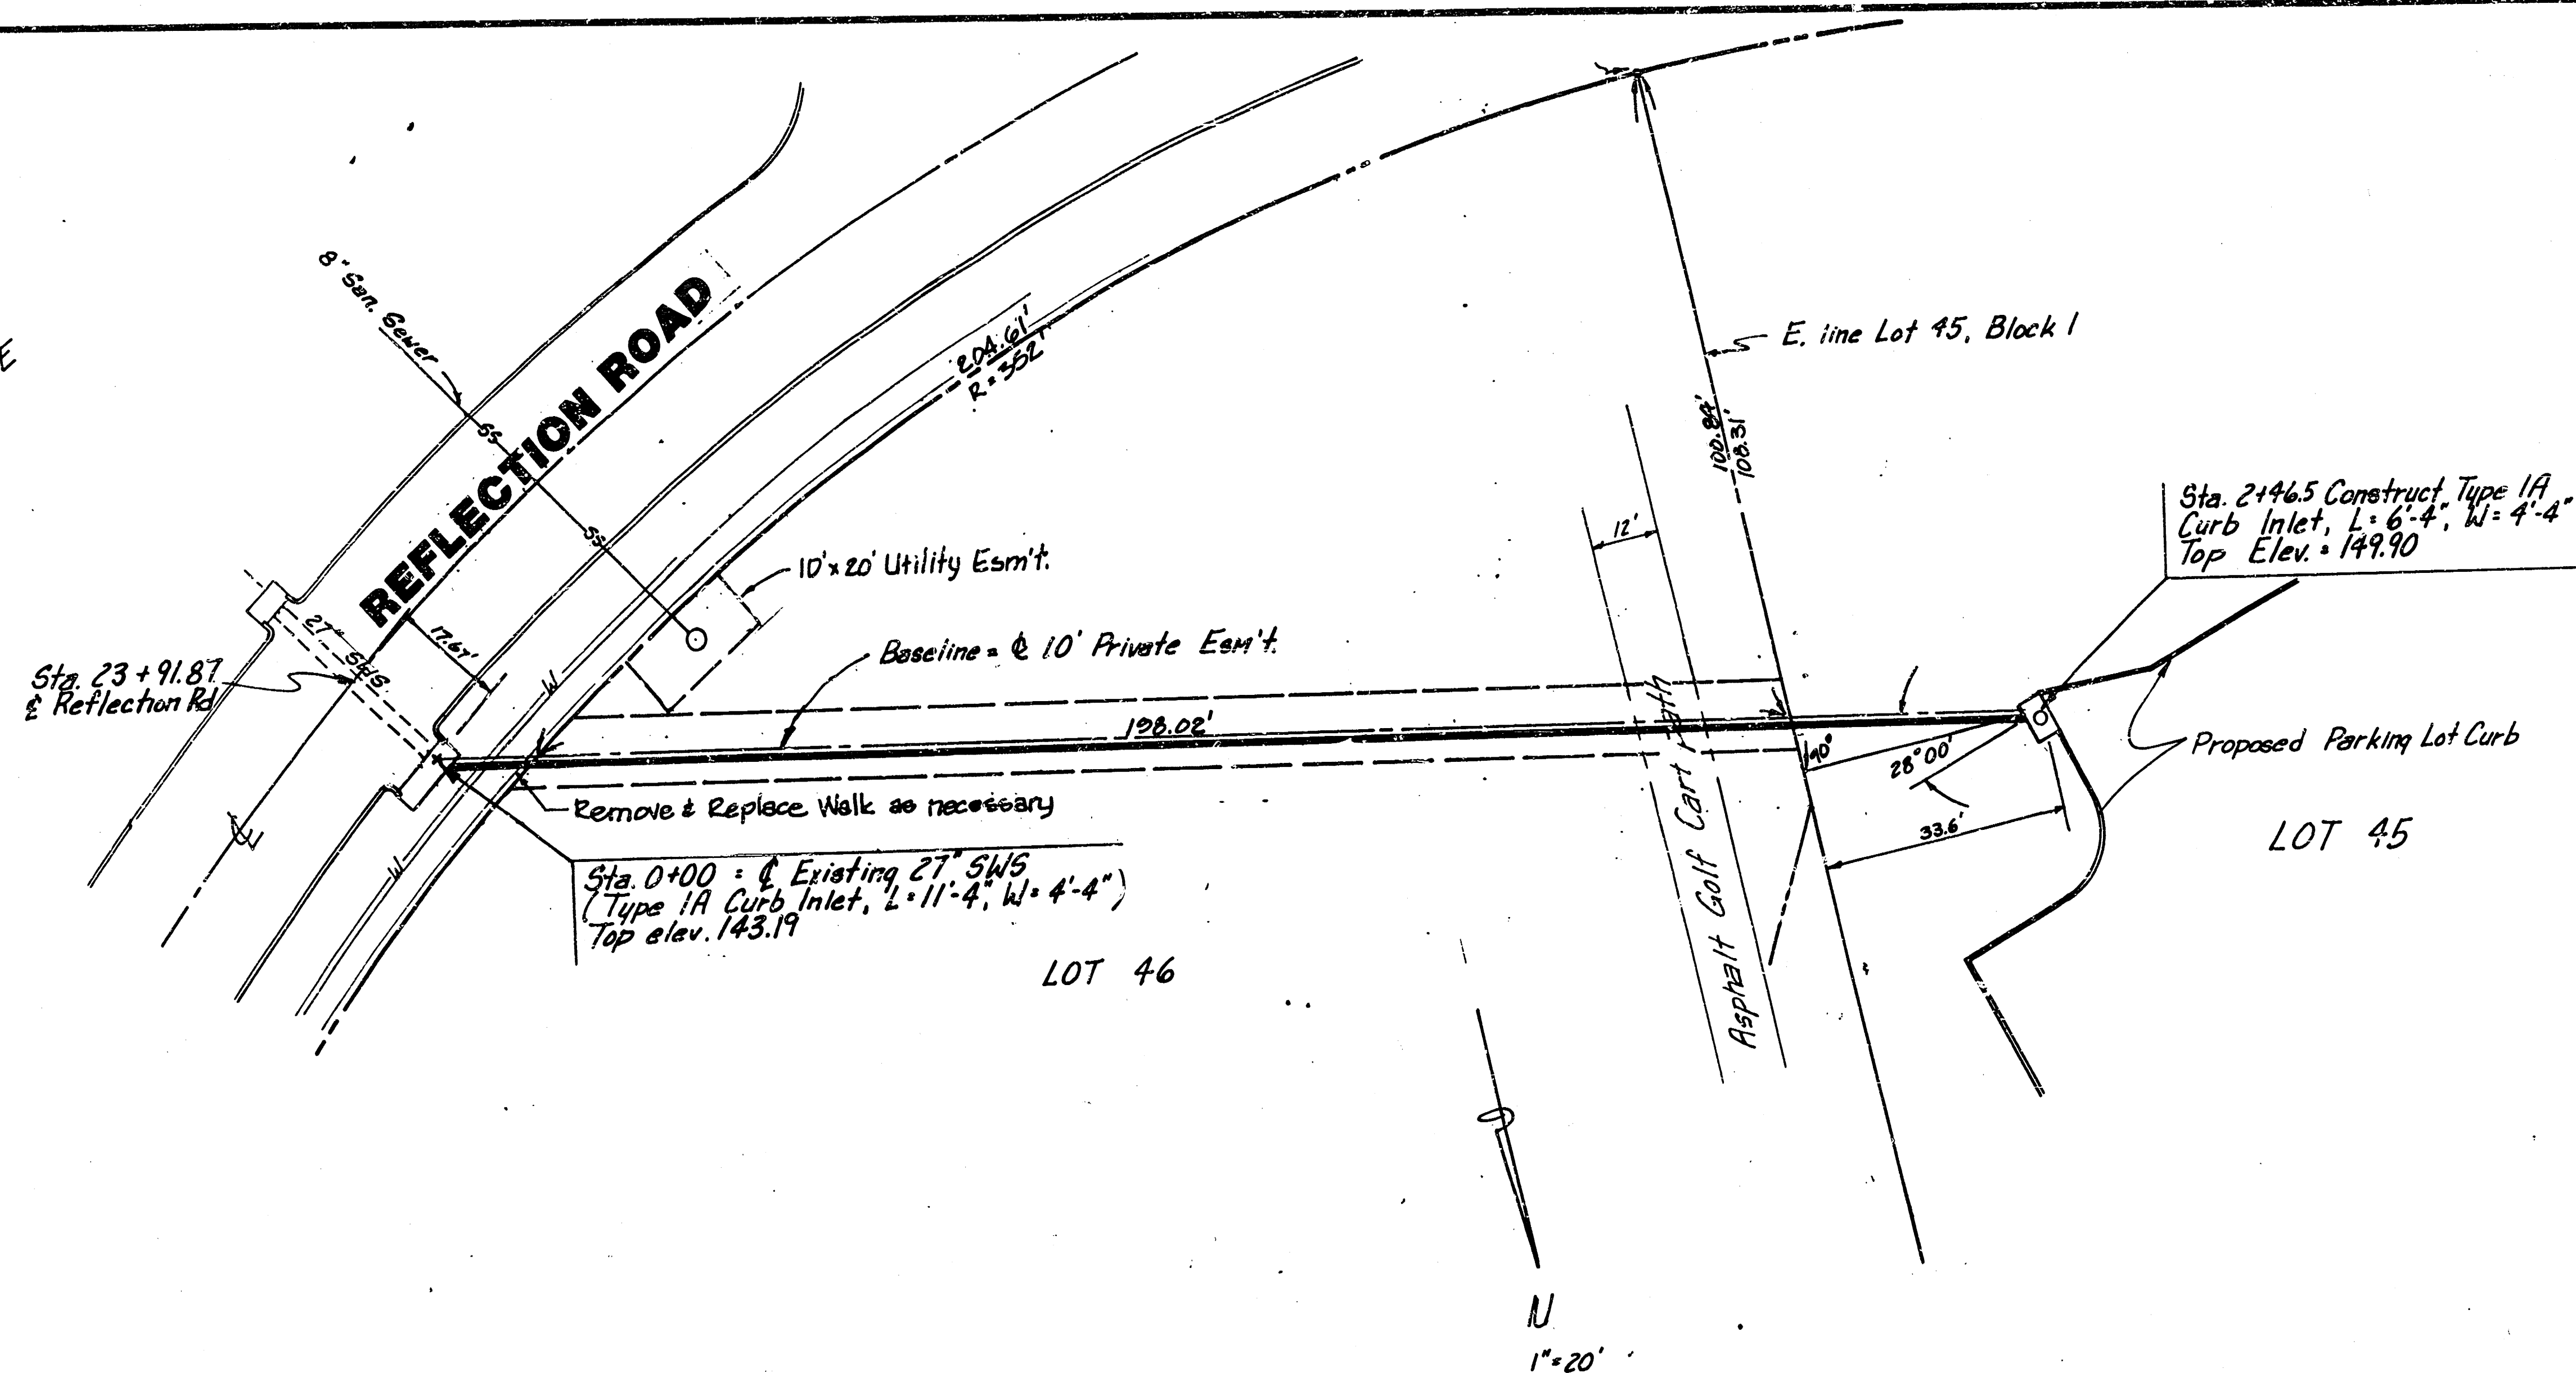

PROFILE SCALE
1" = 20' Horz.
1" = 5' Vert.


APPROVED AS NOTED
CITY ENGINEER OF WICHITA

Sanitary Sewers _____
Storm Sewers Sept 8/5/69
Driveway Approaches _____
Water Mains _____
Paving _____

NOTE TO CONTRACTOR

INSPECTION AND TESTING FOR THIS PROJECT IS TO BE PROVIDED BY A LICENSED CONSULTING ENGINEERING FIRM UNDER CONTRACT WITH THE OWNER/DEVELOPER. SAID INSPECTION TO BE IN ACCORDANCE WITH THE CITY OF WICHITA STANDARD CONSTRUCTION ENGINEERING PRACTICES AND CERTIFIED BY A LICENSED PROFESSIONAL ENGINEER. NO WORK SHALL BE PERFORMED IN DEDICATED EASEMENTS OR PULLED IN AREAS UNTIL THE FIRMER WITHOUT WRITTEN INSPECTION NOR SHALL ANY WORK BE COMENCED WITHOUT WRITTEN AUTHORIZATION BY THE CITY ENGINEER.

Revised as built 9-25-89
Revised easement 7-28-89

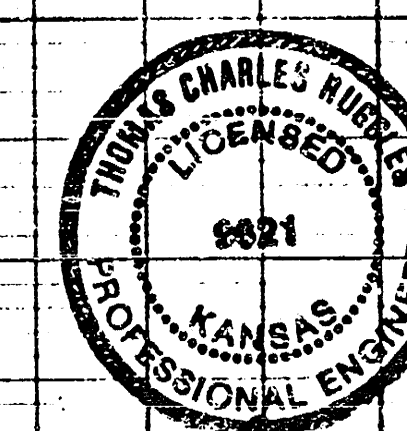

PRIVATE STORM WATER SEWER
REFLECTION RIDGE CLUBHOUSE
WICHITA, KANSAS
INDEX CODE: 220PPS 607853

BAIGHMAN COMPANY, P.A.

BROUGHTMAN COMPANY,
SURVEYING & ENGINEERING

316/262-7271 • 315 ELLIS • WICHITA, KANSAS 67211

Design:	Drawn:	Approved:	Date:	Scale:
TCR	DSN		7-6-89	1" = 20'